

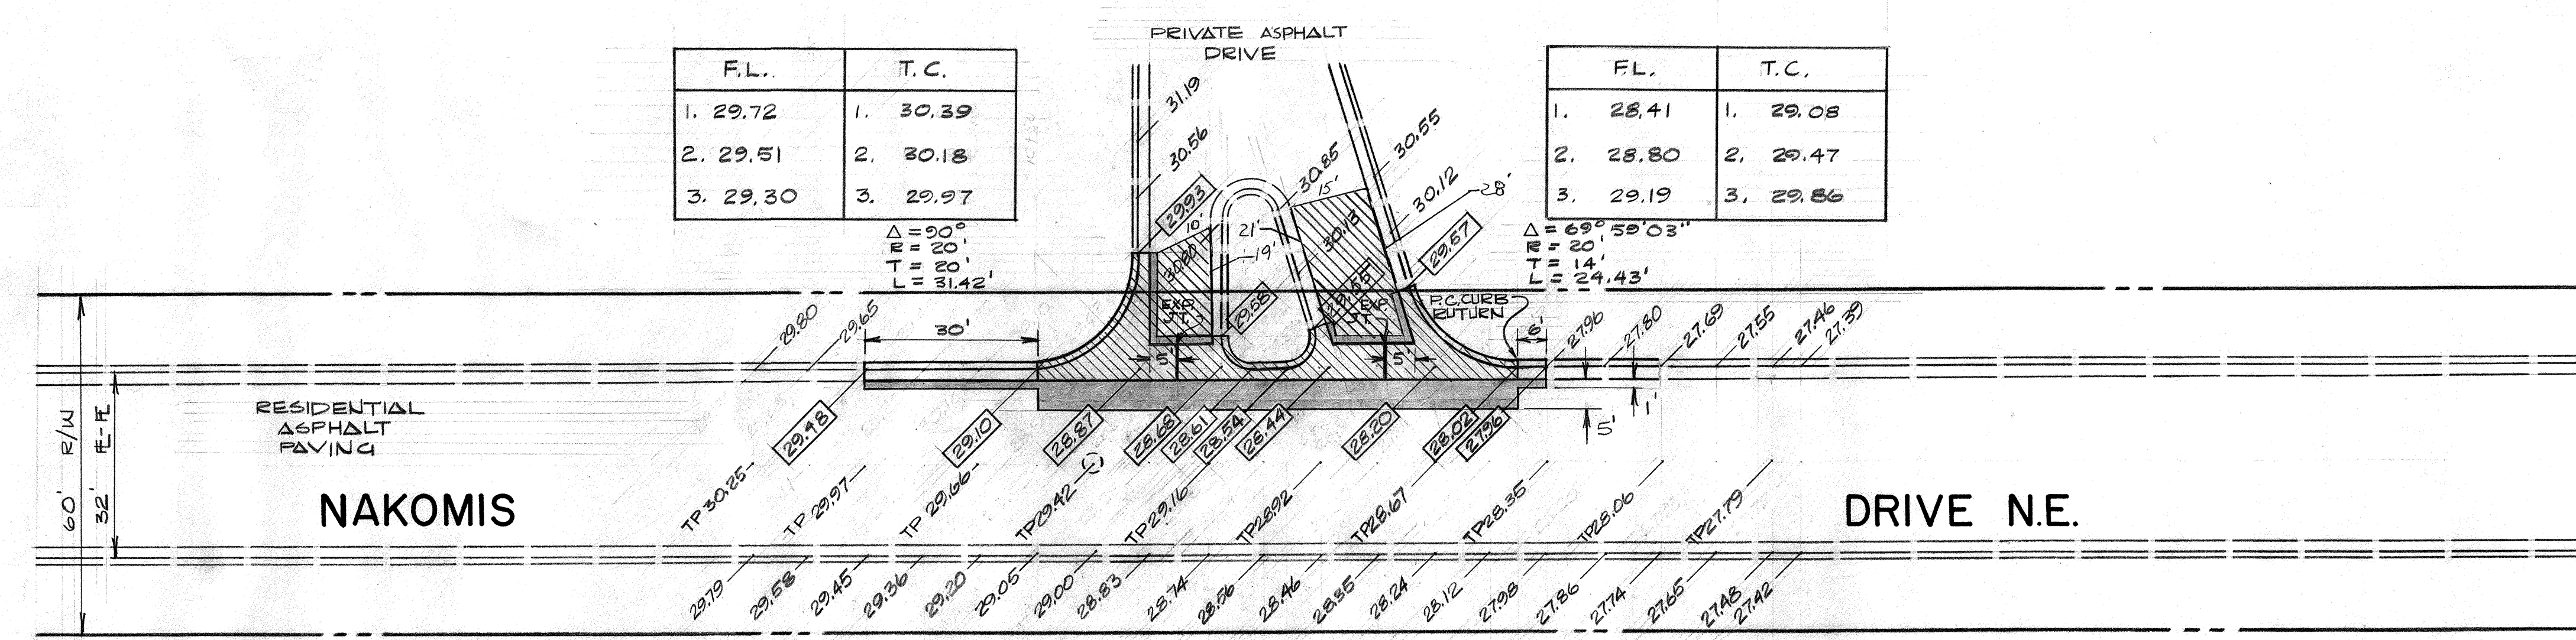


SCALE
HORIZ. 1"=20'
VERT. 1"=2'

CASA HERMOSA SUBD

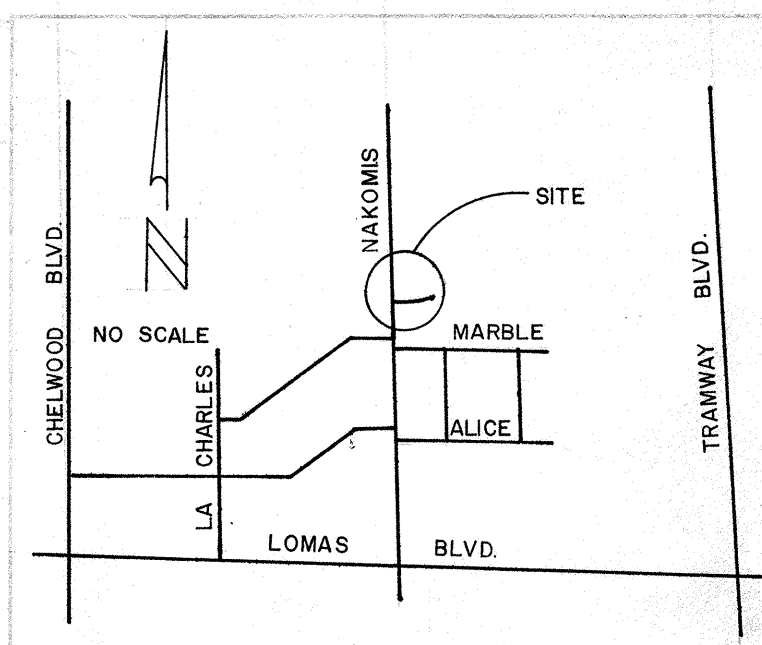

GRANDVIEW HEIGHTS

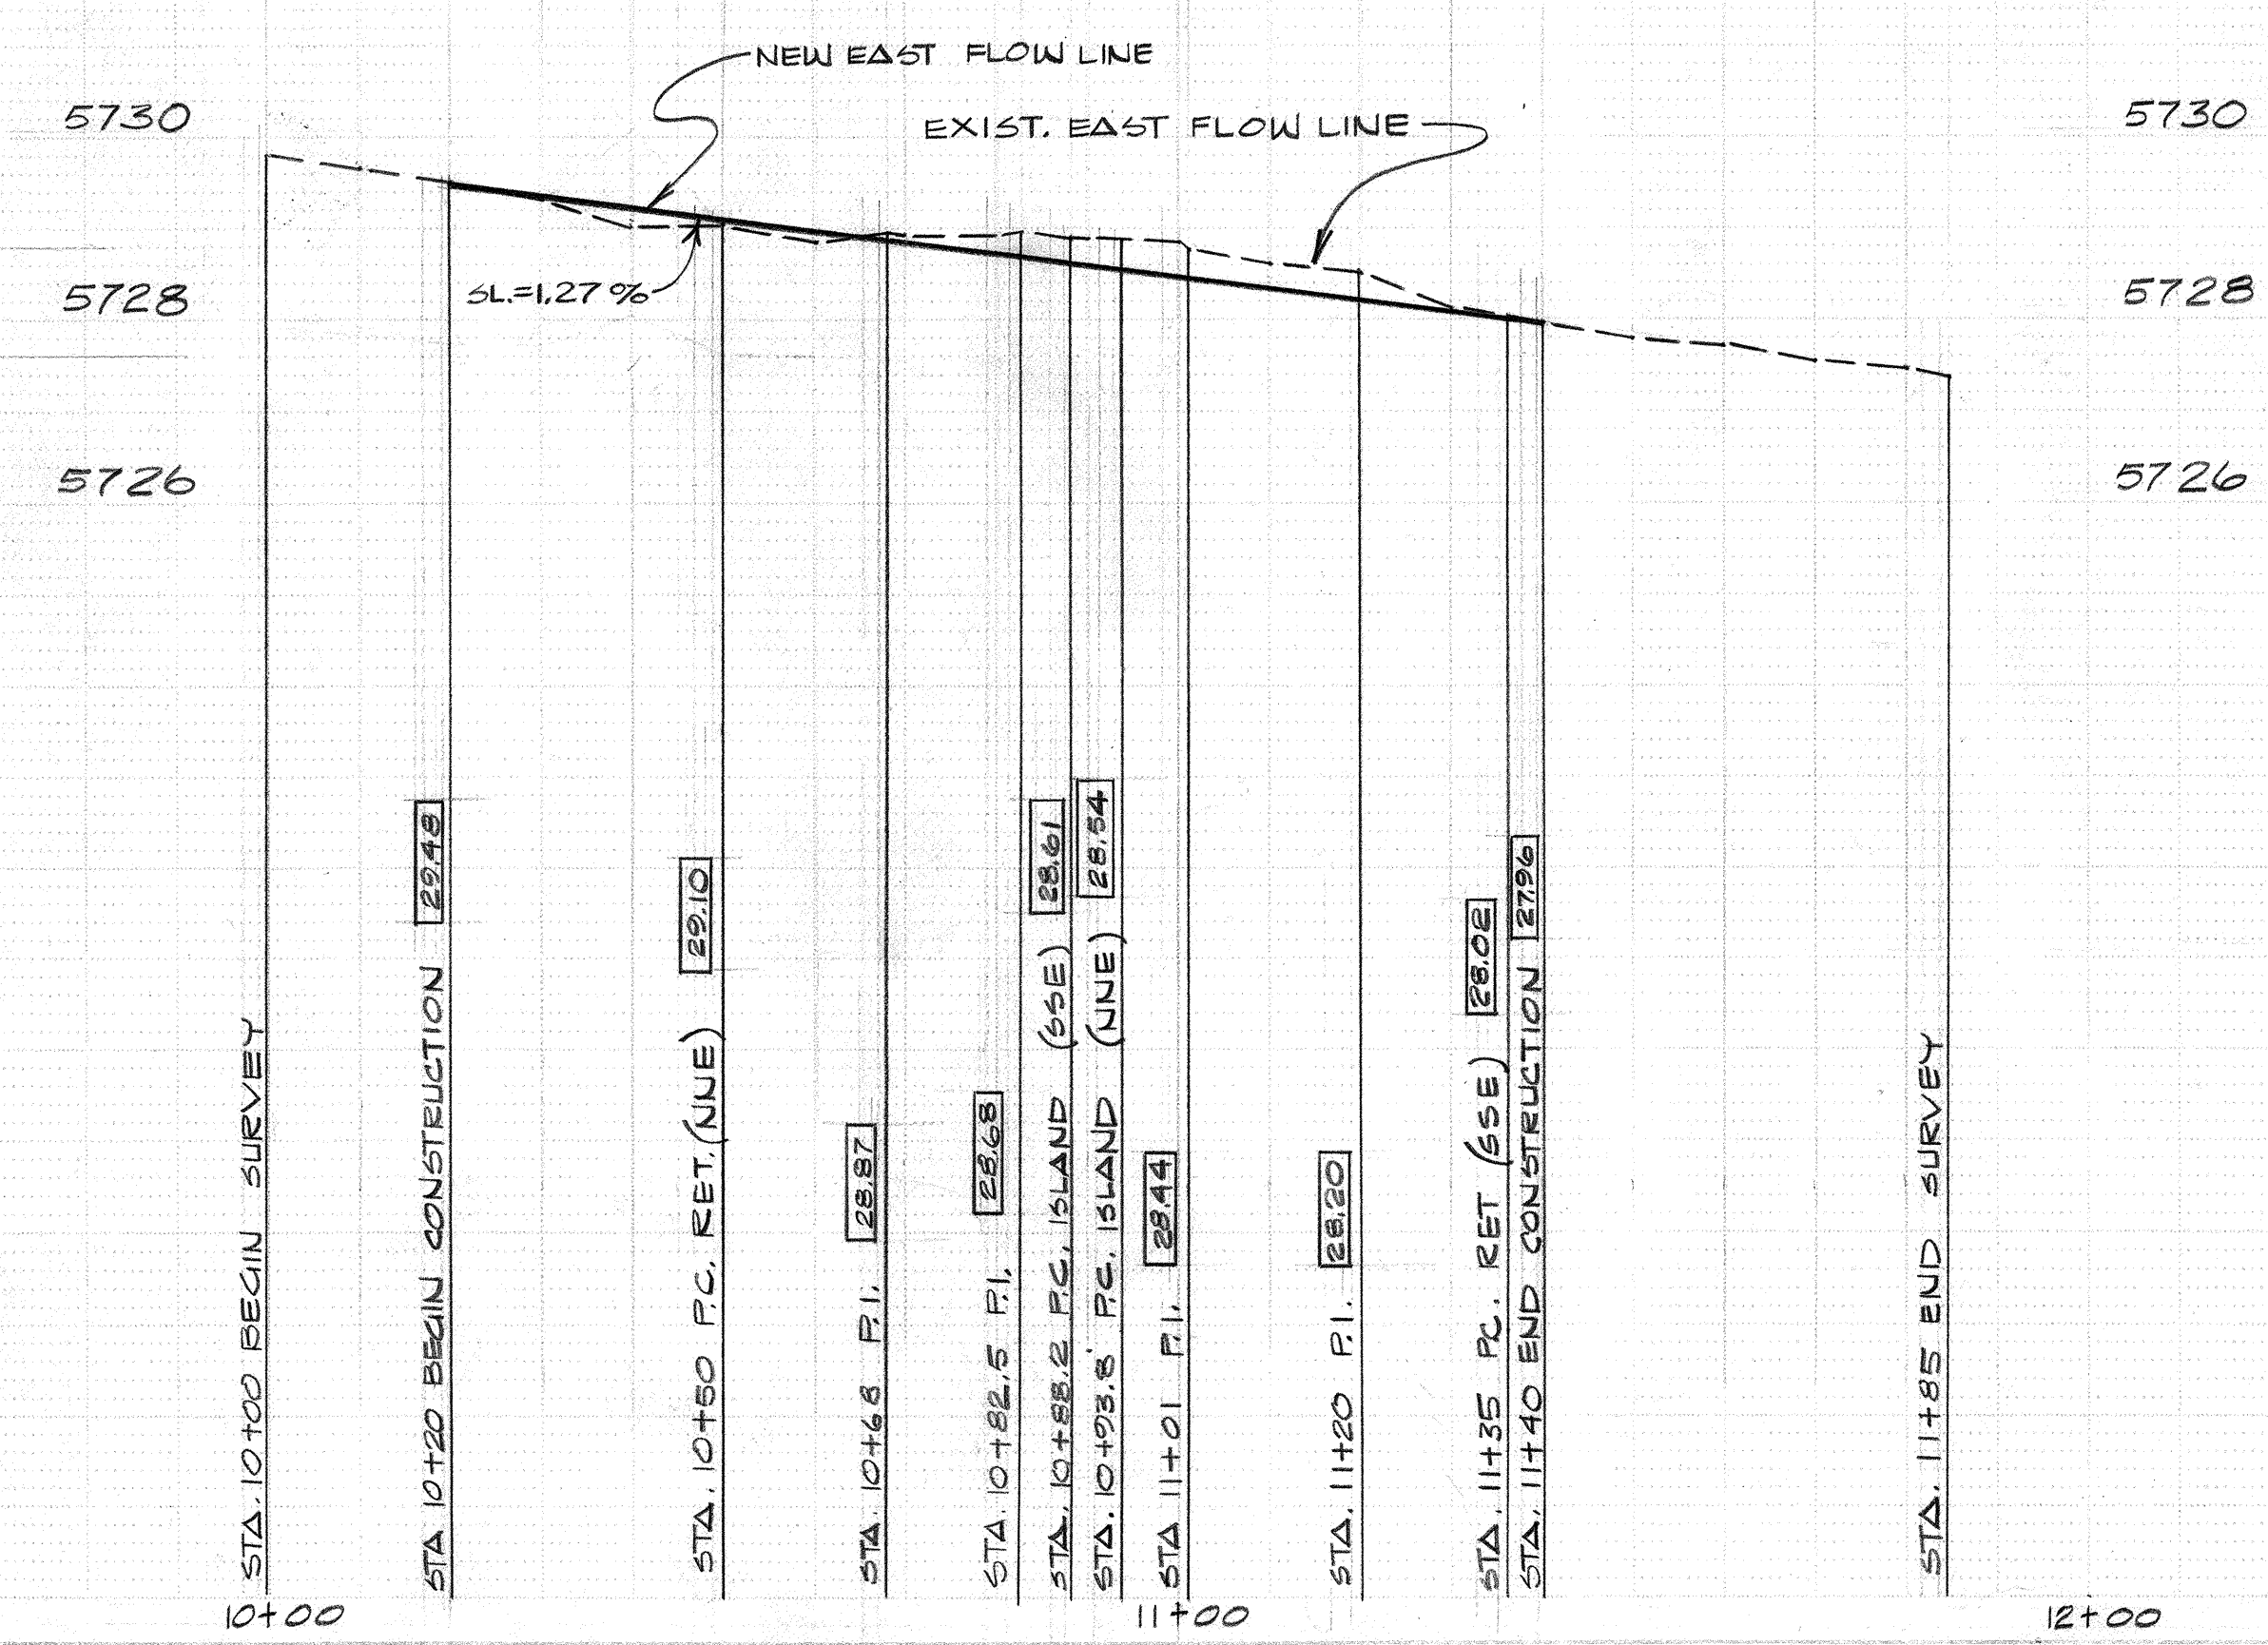

NOTICE TO CONTRACTORS

- 1) New Mexico Standard Specification for Public Works Construction - 1979 Edition will be referred to hereon as the "Standard Specification."
- 2) All work detailed on these plans to be performed under contract shall, except as otherwise stated or provided for hereon, be constructed in accordance with "Contract Documents for City-Wide Utilities and Cash Paving No. 30 and the Standard Specification."
- 3) Two working days prior to any excavation, contractor must contact Line Locating Service, 765-1234, for location of existing utilities.
- 4) Prior to construction, the contractor shall excavate and verify the horizontal and vertical locations of all obstructions. Should a conflict exist, the contractor shall notify the engineer or surveyor so that the conflict can be resolved with minimum amount of delay.

THE FOLLOWING NOTES APPLY WHEN CHECKED

- ☐ All utilities and utility service lines shall be installed prior to paving.
- ☒ Backfill compaction shall be according to specified street use.
- ☒ Tack coat requirements shall be determined by the City Engineer.
- ☐ Sidewalks and wheelchair ramps within the curb return shall be constructed wherever a new curb return is constructed.
- ☐ If curb is depressed for a driveway, the driveway shall be constructed prior to acceptance of the curb and gutter.
- ☐ All storm drainage facilities shall be completed prior to final acceptance.

LEGEND :

- 29.57 EXIST. FLOW LINE ELEV.
- 29.57 NEW FLOW LINE ELEV.
- NEW PAVING
- EXIST. CURB & GUTTER
- NEW CURB & GUTTER
- NEW VALLEY GUTTER
- TP 29.57 TOP OF PAVING ELEV.

NOTES
1. VALLEY GUTTER AS PER CITY STANDARD DWG P-9-1.
2. LEAVE HALF OF DRIVE OPEN AT ALL TIMES TO PERMIT ACCESS.

20 112249182

APPROVAL OF AS BUILT DRAWINGS
ASST. CITY ENGINEER - FIELD
DATE 6-1-82

CITY OF ALBUQUERQUE
MUNICIPAL DEVELOPMENT DEPARTMENT
ENGINEERING DIVISION

TITLE VALLEY GUTTER, CASA HERMOSA ENTRANCE ON NAKOMIS DRIVE N.E.

APPROVED FOR CONSTRUCTION
CITY ENGINEER
DATE 10/29/81

APPROVALS	ENGINEER	DATE	APPROVALS	ENGINEER	DATE
City Engineer	P. J. Kellish	5/20/81	Liquid Waste		
A.C.E. - Design			Traffic		
A.C.E. - Hydrology			Water		

DRAWING NO. 1224
SHEET 1 OF 1
J-22