

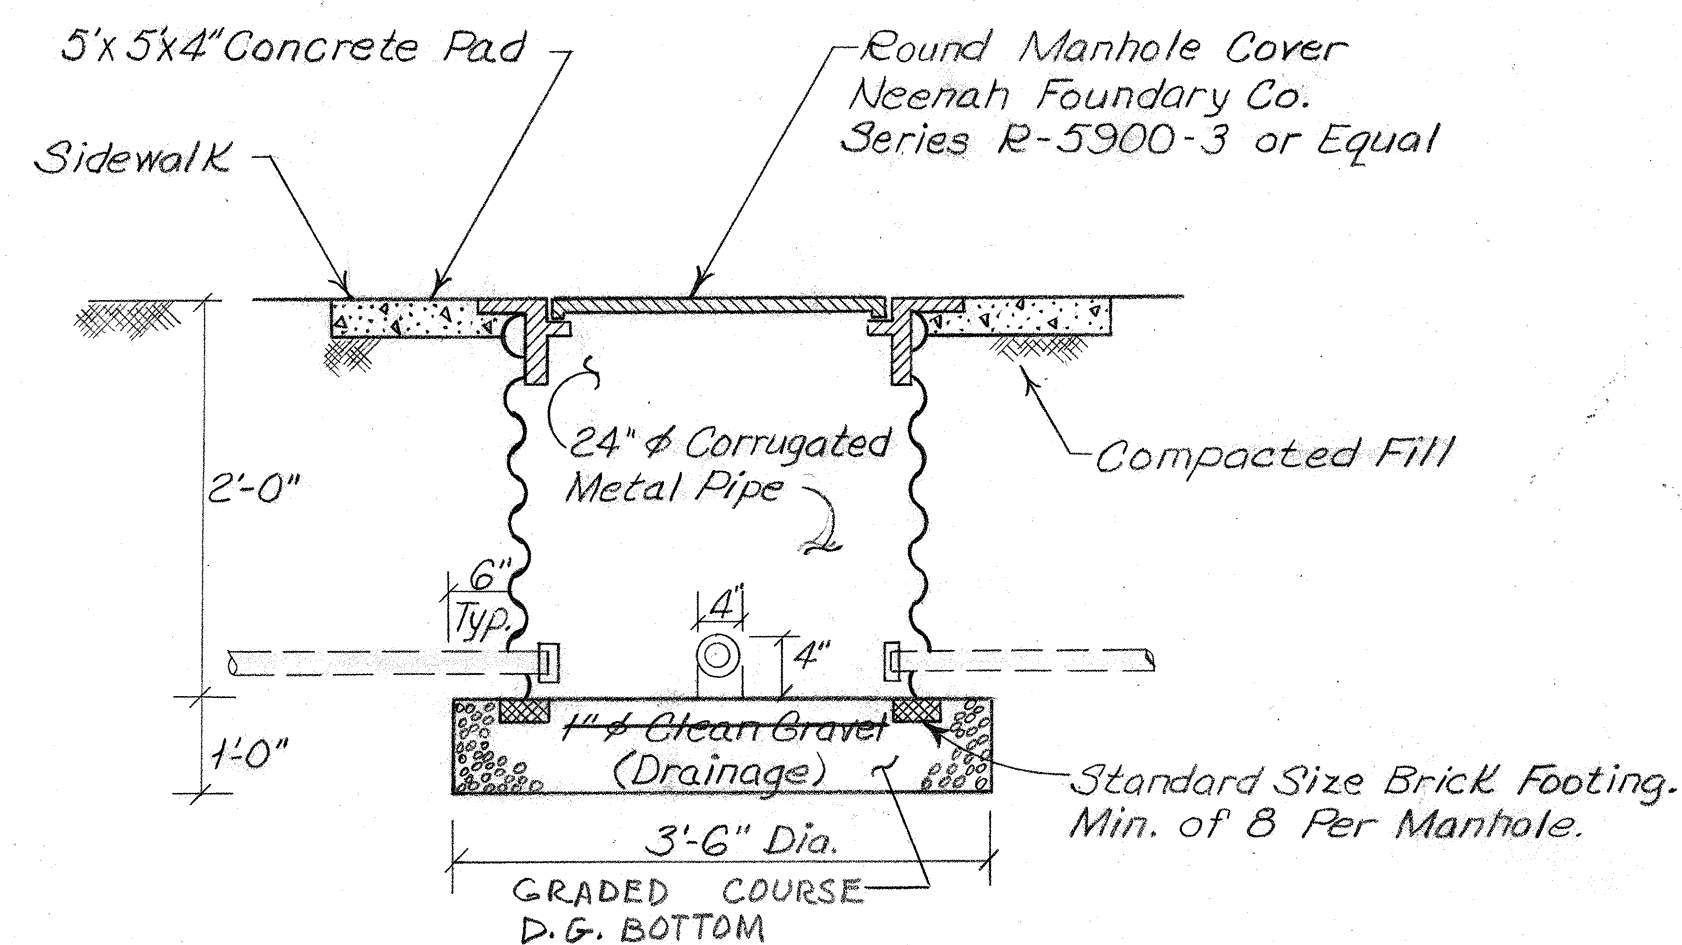
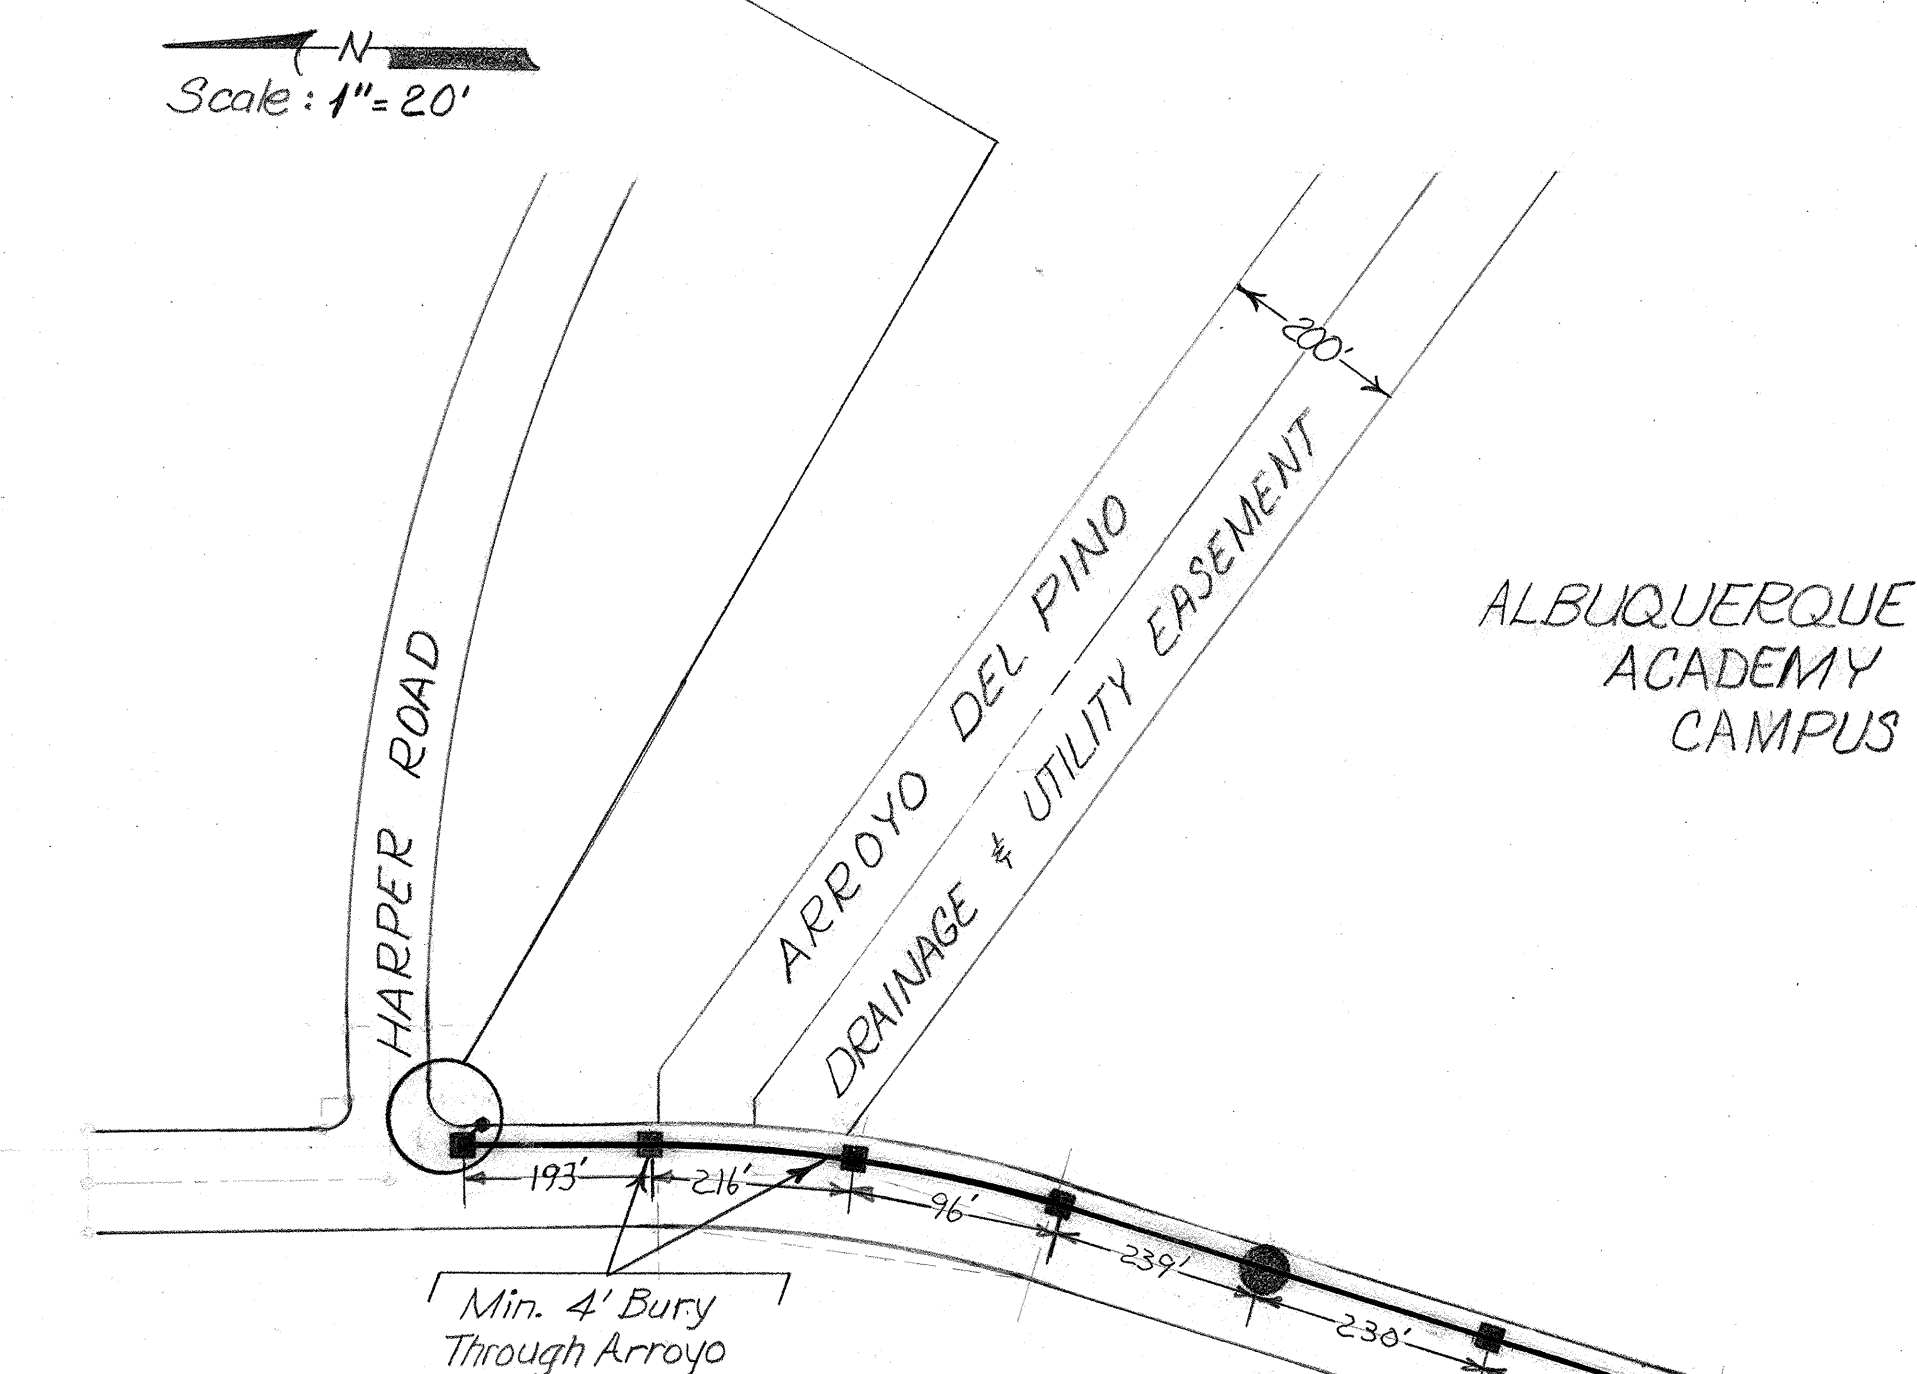


SCANNED BY LASON

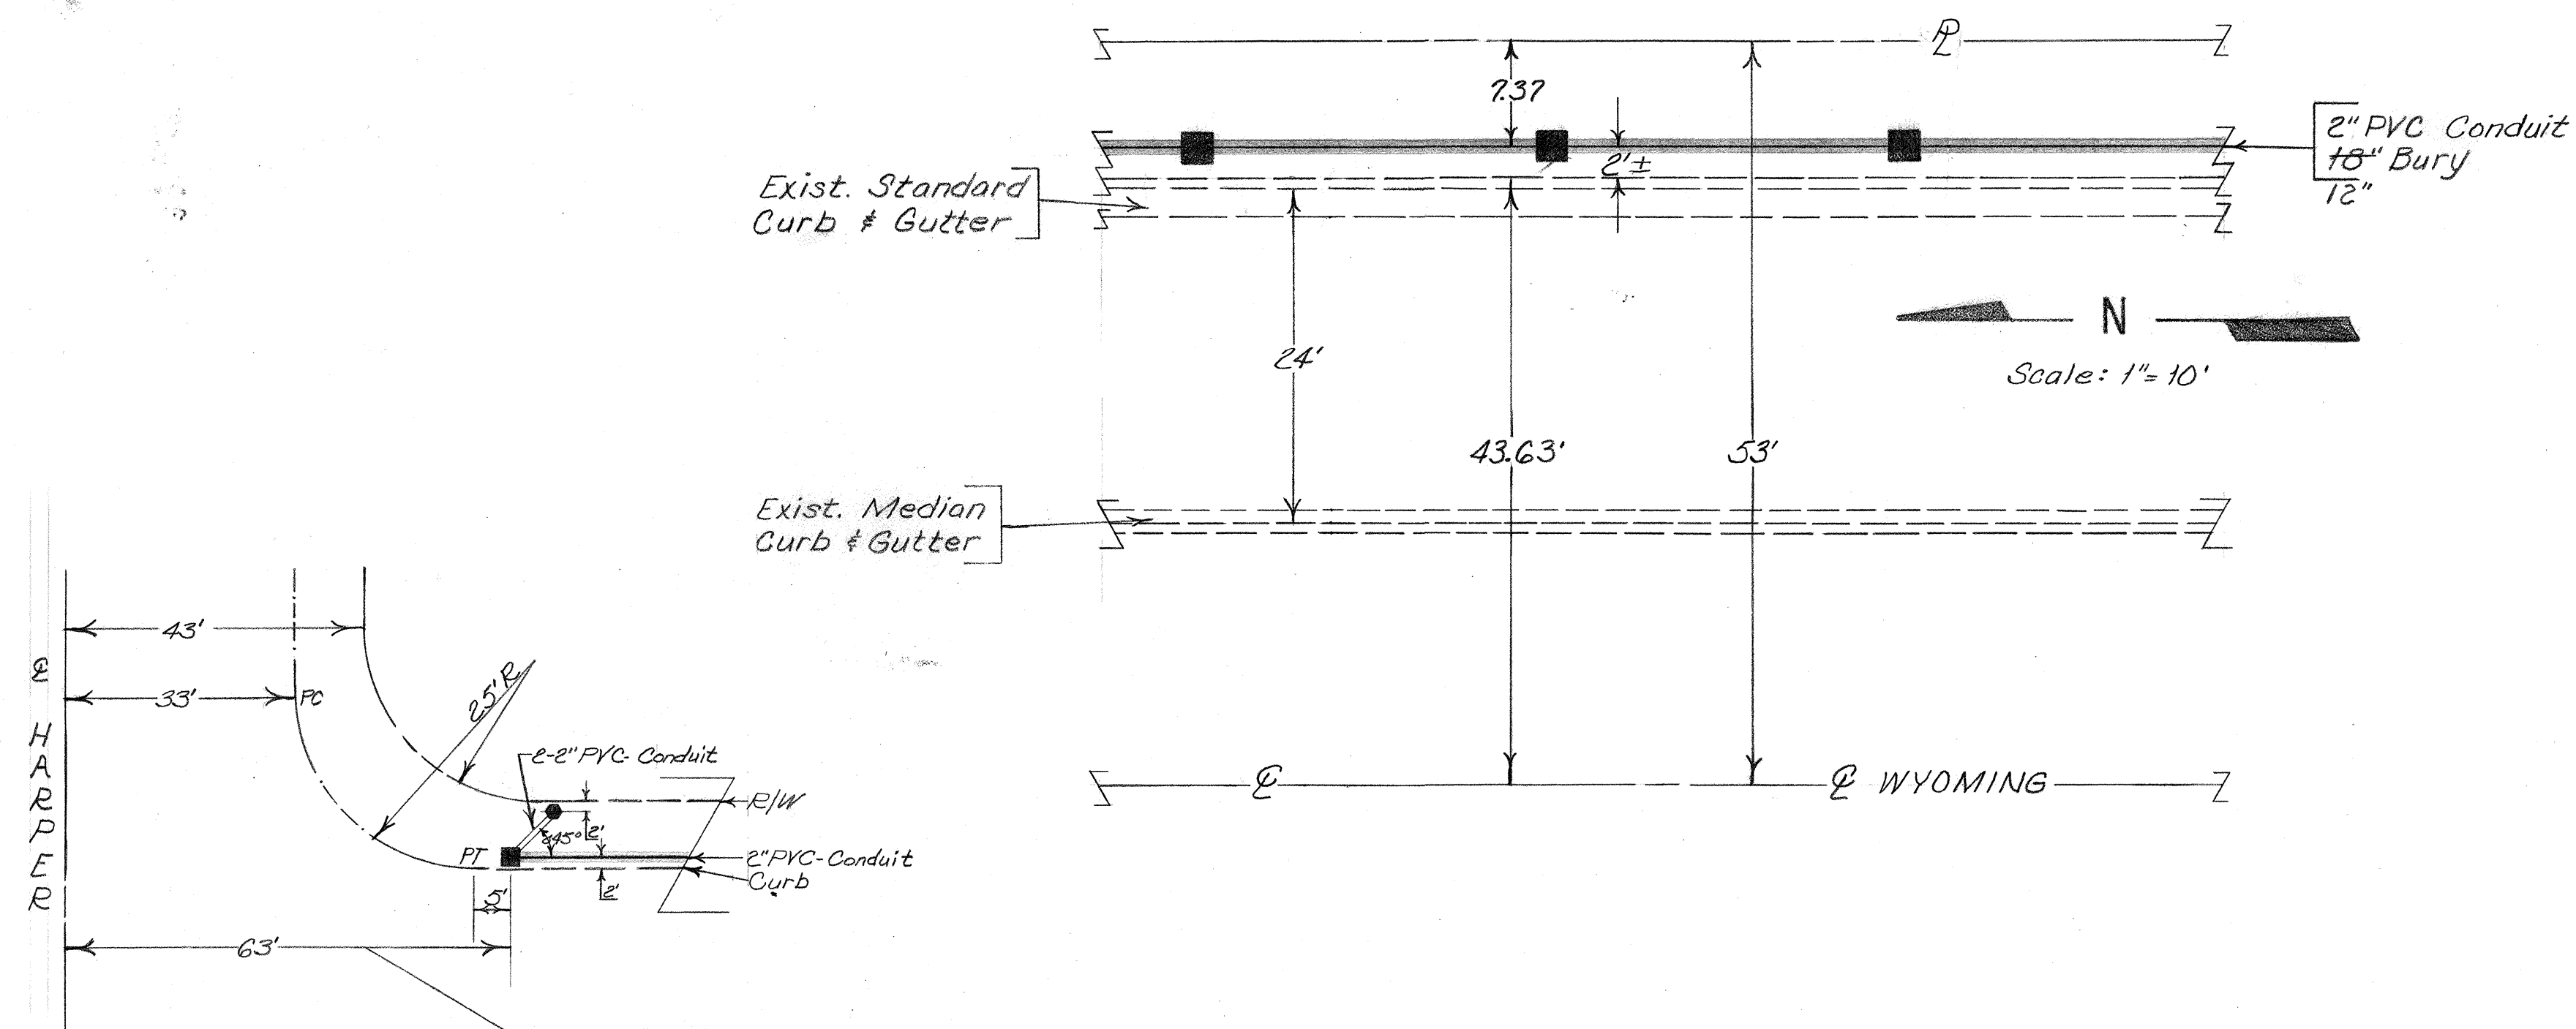

INTERCONNECT MANHOLE DETAIL
No Scale

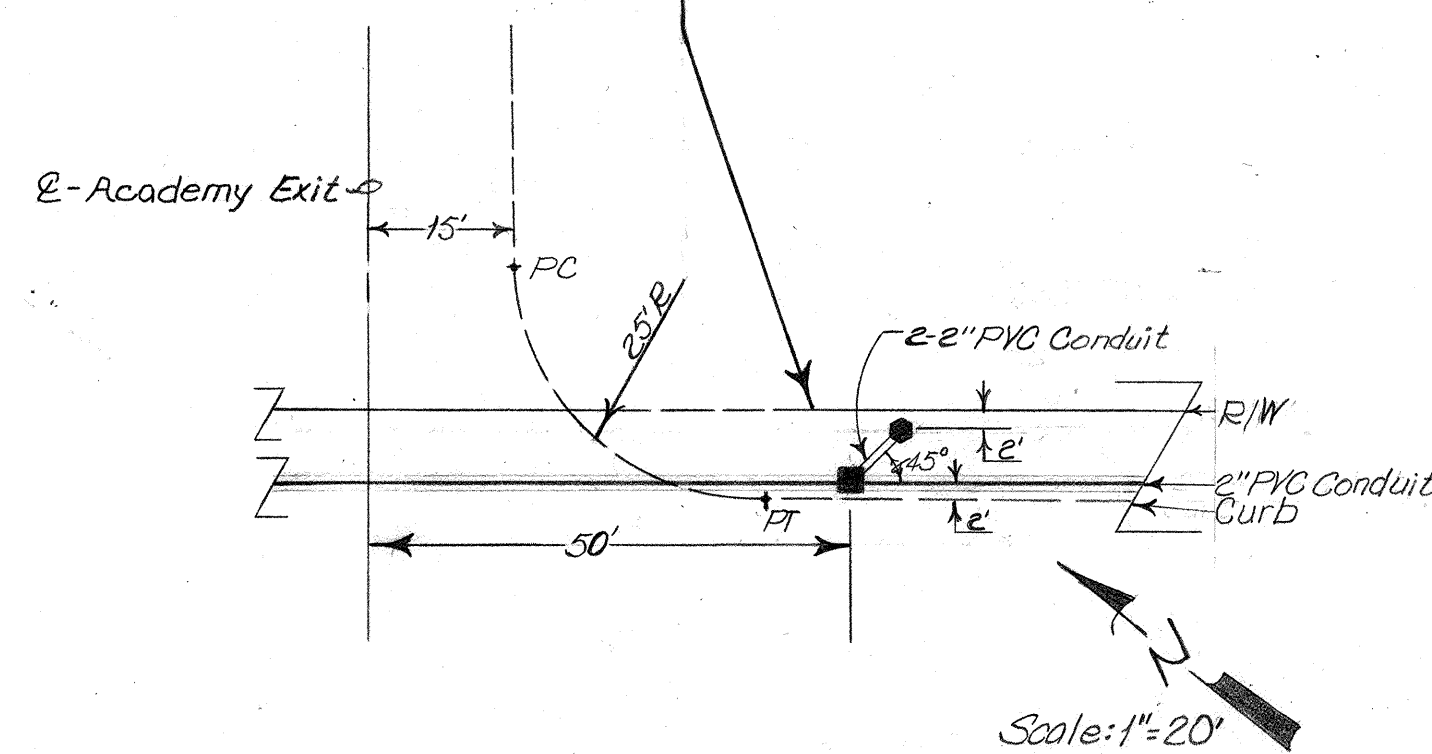


NOTES:

1. Install Standard Pull Boxes As Per City Standard Drawing - T-4. Spacing And Location To Be Determined By Traffic Engineer. Approx. 250'
2. Use 2" PVC Conduit. 18" Bury.
3. Traffic Engineer Will Furnish An Inspector For The Installation Of The Conduit, Pull Boxes, And Manholes. Field Engineer (OCE) Will Inspect The Remainder Of The Construction Work Associated With This Project.
4. Distances Between Pull Boxes & Interconnect Manholes Will Be Recorded On As-Built Drawings.

LEGEND:

- Interconnect Manhole
- Pull Boxes - City Dwg. T-4
- 2" PVC Schedule 40
- Controller & Splice Cabinet - Type II - City Dwg. T-5

APPROVED FOR
CONSTRUCTION
CITY ENGINEER
DATE 10/6/81

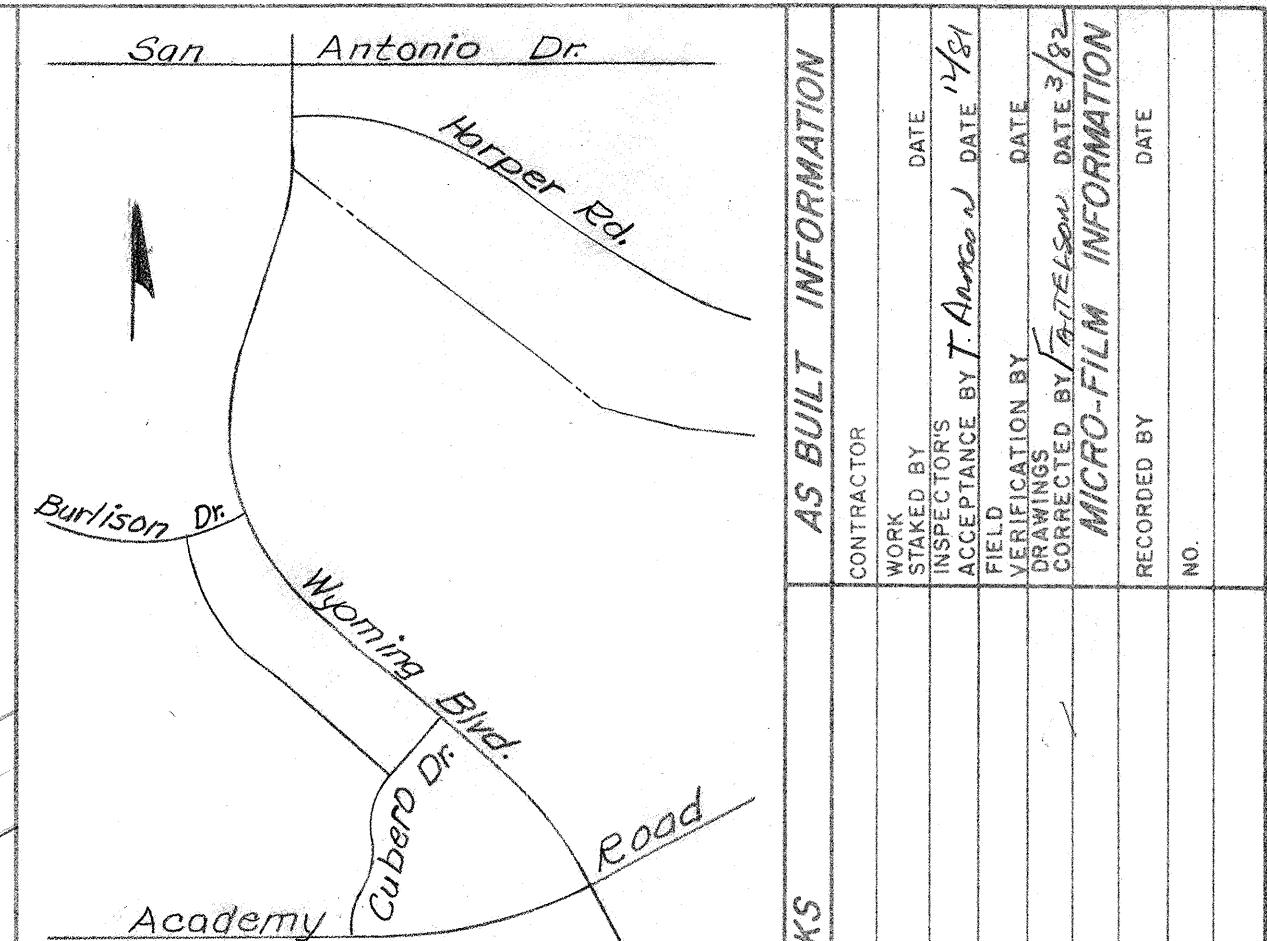

Location Map Zone Atlas E-19

"NOTICE TO CONTRACTORS"

- 1) New Mexico Standard Specification for Public Works Construction - 1979 Edition will be referred to hereon as the "Standard Specification."
- 2) All work detailed on these plans to be performed under contract shall, except as otherwise stated or provided for hereon, be constructed in accordance with "Contract Documents for City-Wide Utilities and Curb Paving No. 30, and the Standard Specification."
- 3) Two working days prior to any excavation, contractor must contact Line Locating Service, 765-1234, for location of existing utilities.
- 4) Prior to construction, the contractor shall excavate and verify the horizontal and vertical locations of all obstructions. Should a conflict exist, the contractor shall notify the engineer or surveyor so that the conflict can be resolved with minimum amount of delay.

THE FOLLOWING NOTES APPLY WHEN CHECKED

- ☐ All utilities and utility service lines shall be installed prior to paving.
- ☒ Backfill compaction shall be according to specified street use (Arterial Pavement).
- ☒ Tack coat requirements shall be determined by the City Engineer.
- ☐ Sidewalks and wheelchair ramps within the curb return shall be constructed wherever a new curb return is constructed.
- ☐ If curb is depressed for a driveway, the driveway shall be constructed prior to acceptance of the curb and gutter.
- ☐ All storm drainage facilities shall be completed prior to final acceptance.

APPROVAL OF AS-BUILT DRAWINGS
ASST. CITY ENGINEER - FIELD
DATE 9-3-82

20 1267 182

CITY OF ALBUQUERQUE
MUNICIPAL DEVELOPMENT DEPARTMENT
ENGINEERING DIVISION

TITLE: Traffic Conduit Installation In Wyoming Blvd. NE,
Wyoming Blvd. NE, & Academy Rd. & Harper Rd.

APPROVALS	ENGINEER	DATE	APPROVALS	ENGINEER	DATE
City Engineer	REDA	10/2/81	Liquid Waste		
A.C.E.-Design	GR Welch	23 Sep 81	Traffic	T. Kennedy	10/1/81
A.C.E.-Hydrology			Water		

DRAWING NO. 1267 MAP NO. E-19 SHEET 1 OF 1