



PROFILE	SURVEYED _____	BY _____	DATE _____
NOTE BOOK	PLOTTED _____		
	GRADES CHECKED _____		
	G. M.S. NOTED _____		
	STRUCTURE NOTAINS CH'KD _____		

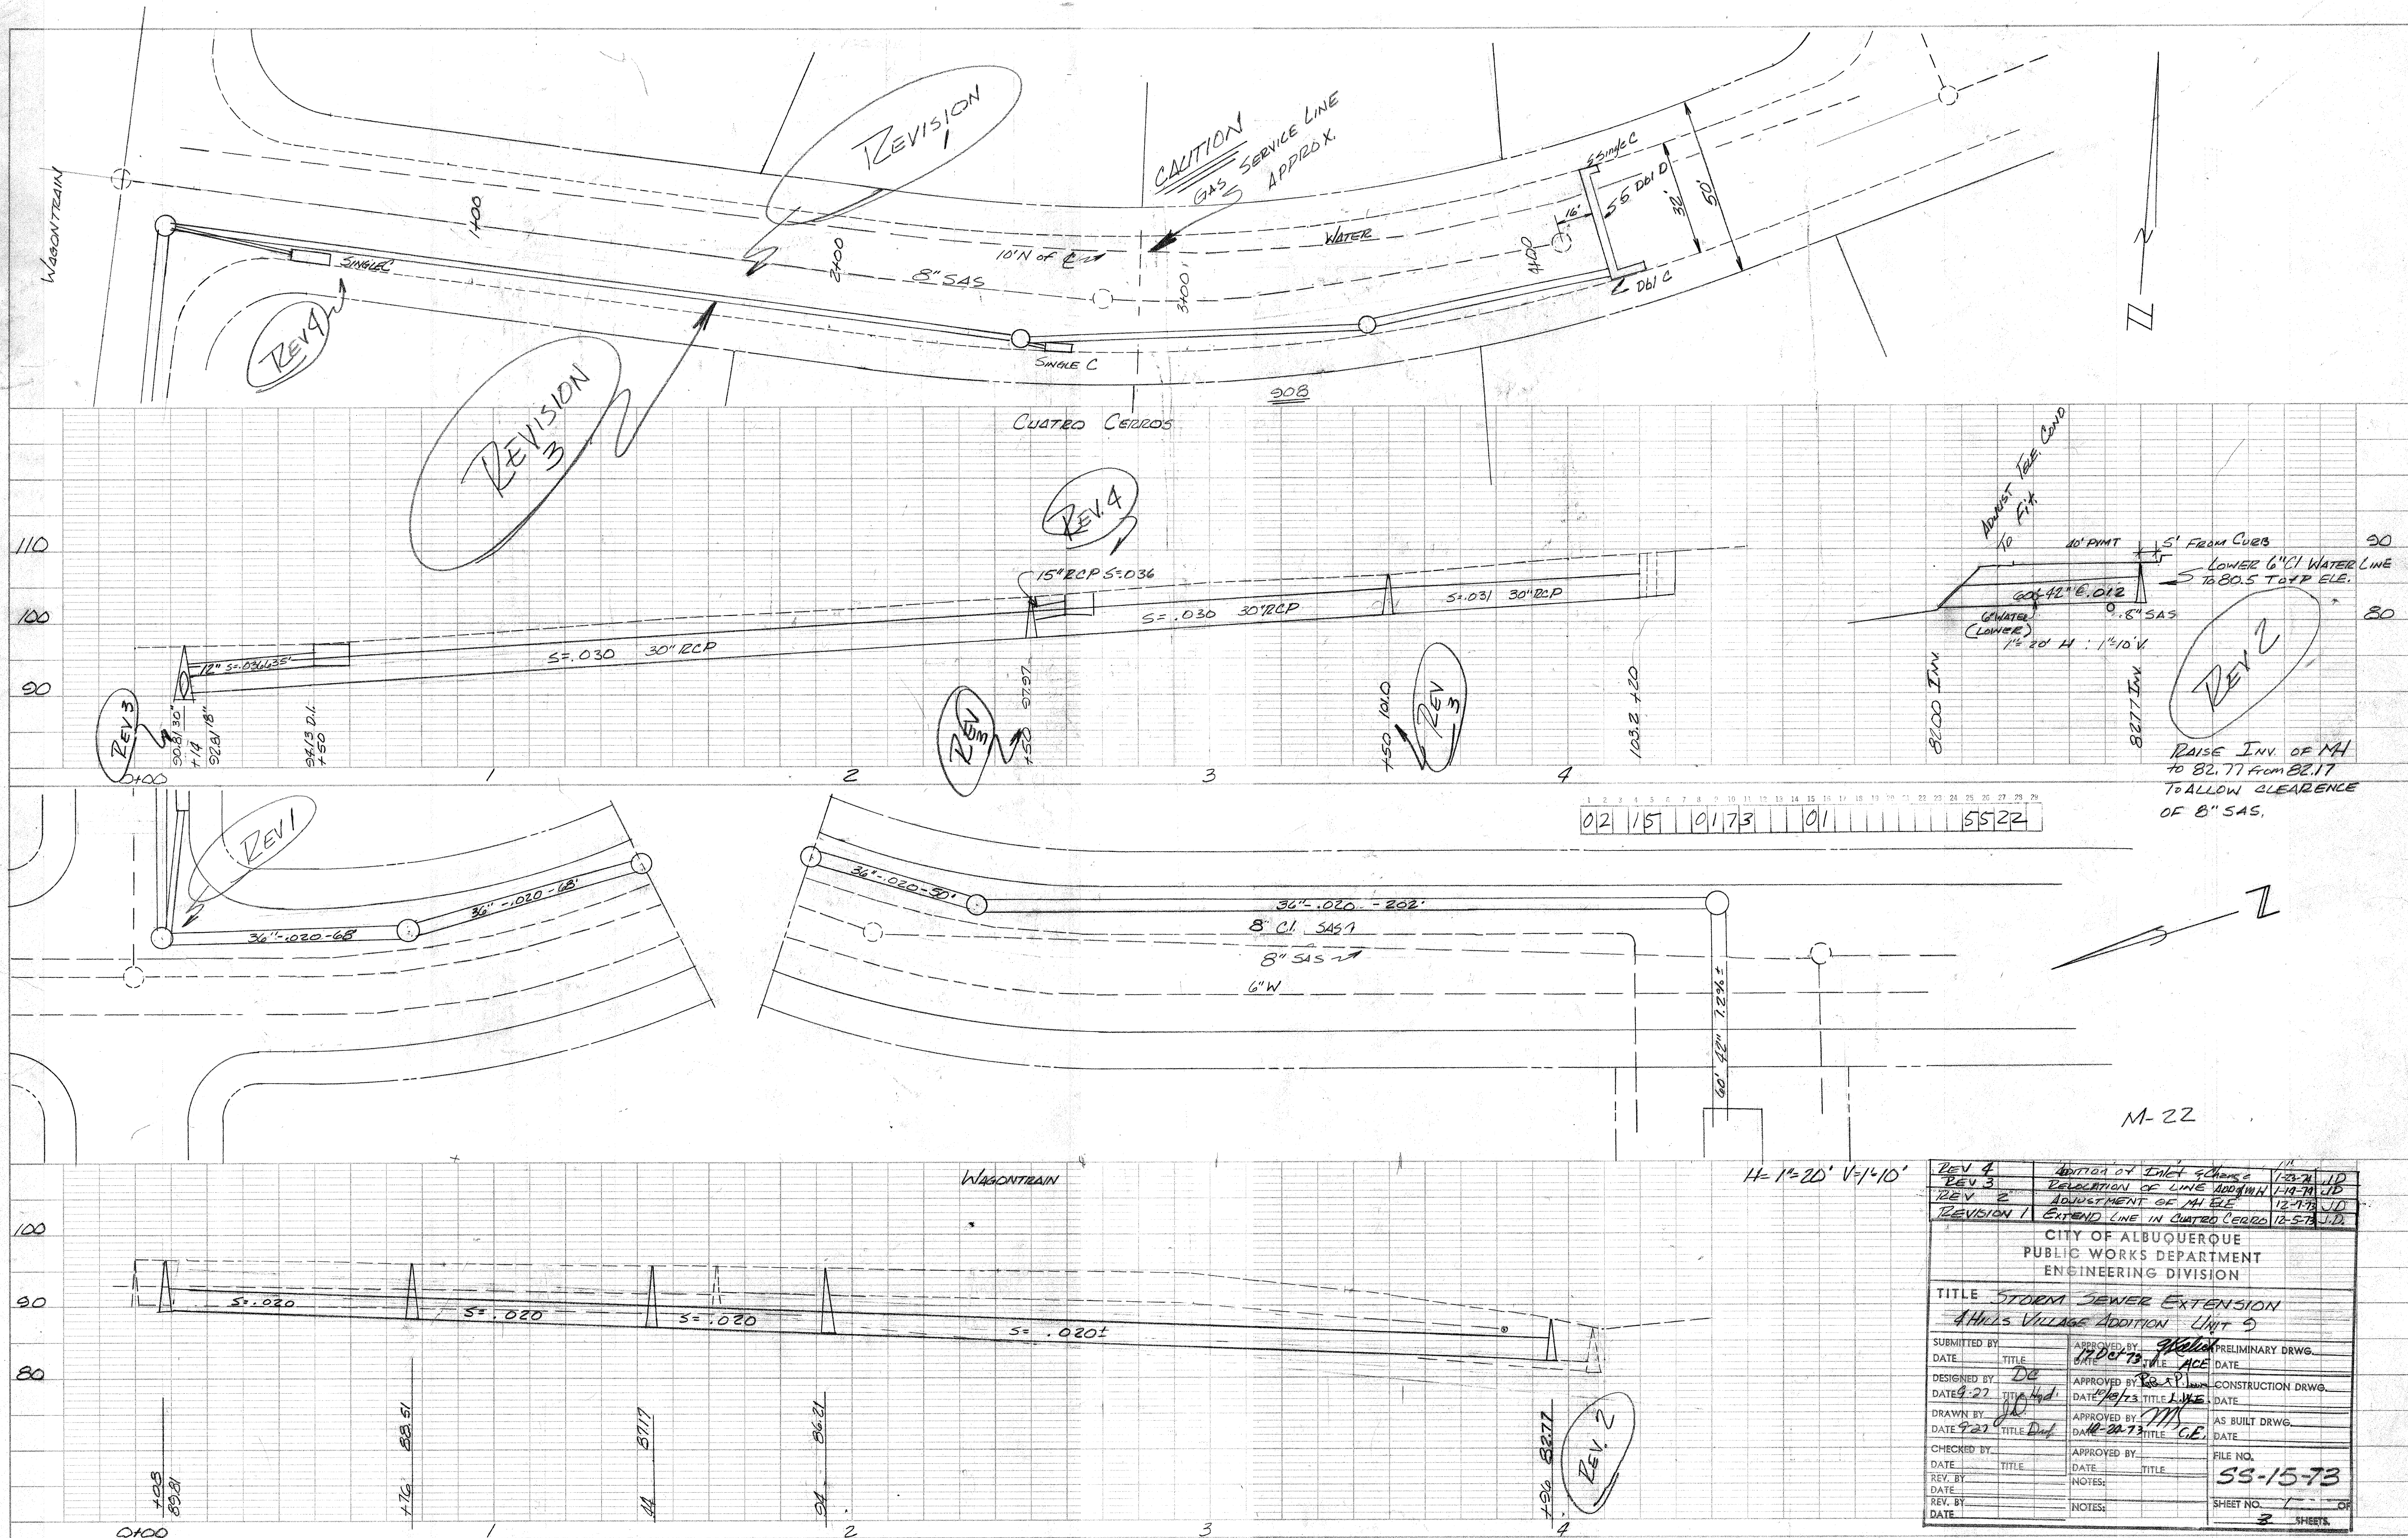

REV 4	ADDITION OF INLET CHANGE	12-21	JD
REV 3	RELOCATION OF LINE ADDITION	11-19-98	JD
REV 2	ADJUSTMENT OF MILE	12-1-73	JD
REVISION 1	EXTEND LINE IN CUATRO CERROS	12-5-73	JD
CITY OF ALBUQUERQUE			
PUBLIC WORKS DEPARTMENT			
ENGINEERING DIVISION			
TITLE STORM SEWER EXTENSION			
AT HILLS VILLAGE ADDITION UNIT 9			
SUBMITTED BY	APPROVED BY	PRELIMINARY DRWG.	
DATE	DATE	DATE	
DESIGNED BY	APPROVED BY	CONSTRUCTION DRWG.	
DATE	DATE	DATE	
DRAWN BY	APPROVED BY	AS BUILT DRWG.	
DATE	DATE	DATE	
CHECKED BY	APPROVED BY	FILE NO.	
DATE	DATE	DATE	
REV. BY	NOTES	DATE	
DATE	NOTES	DATE	
REV. BY	NOTES	DATE	
DATE	NOTES	DATE	


REV. 2

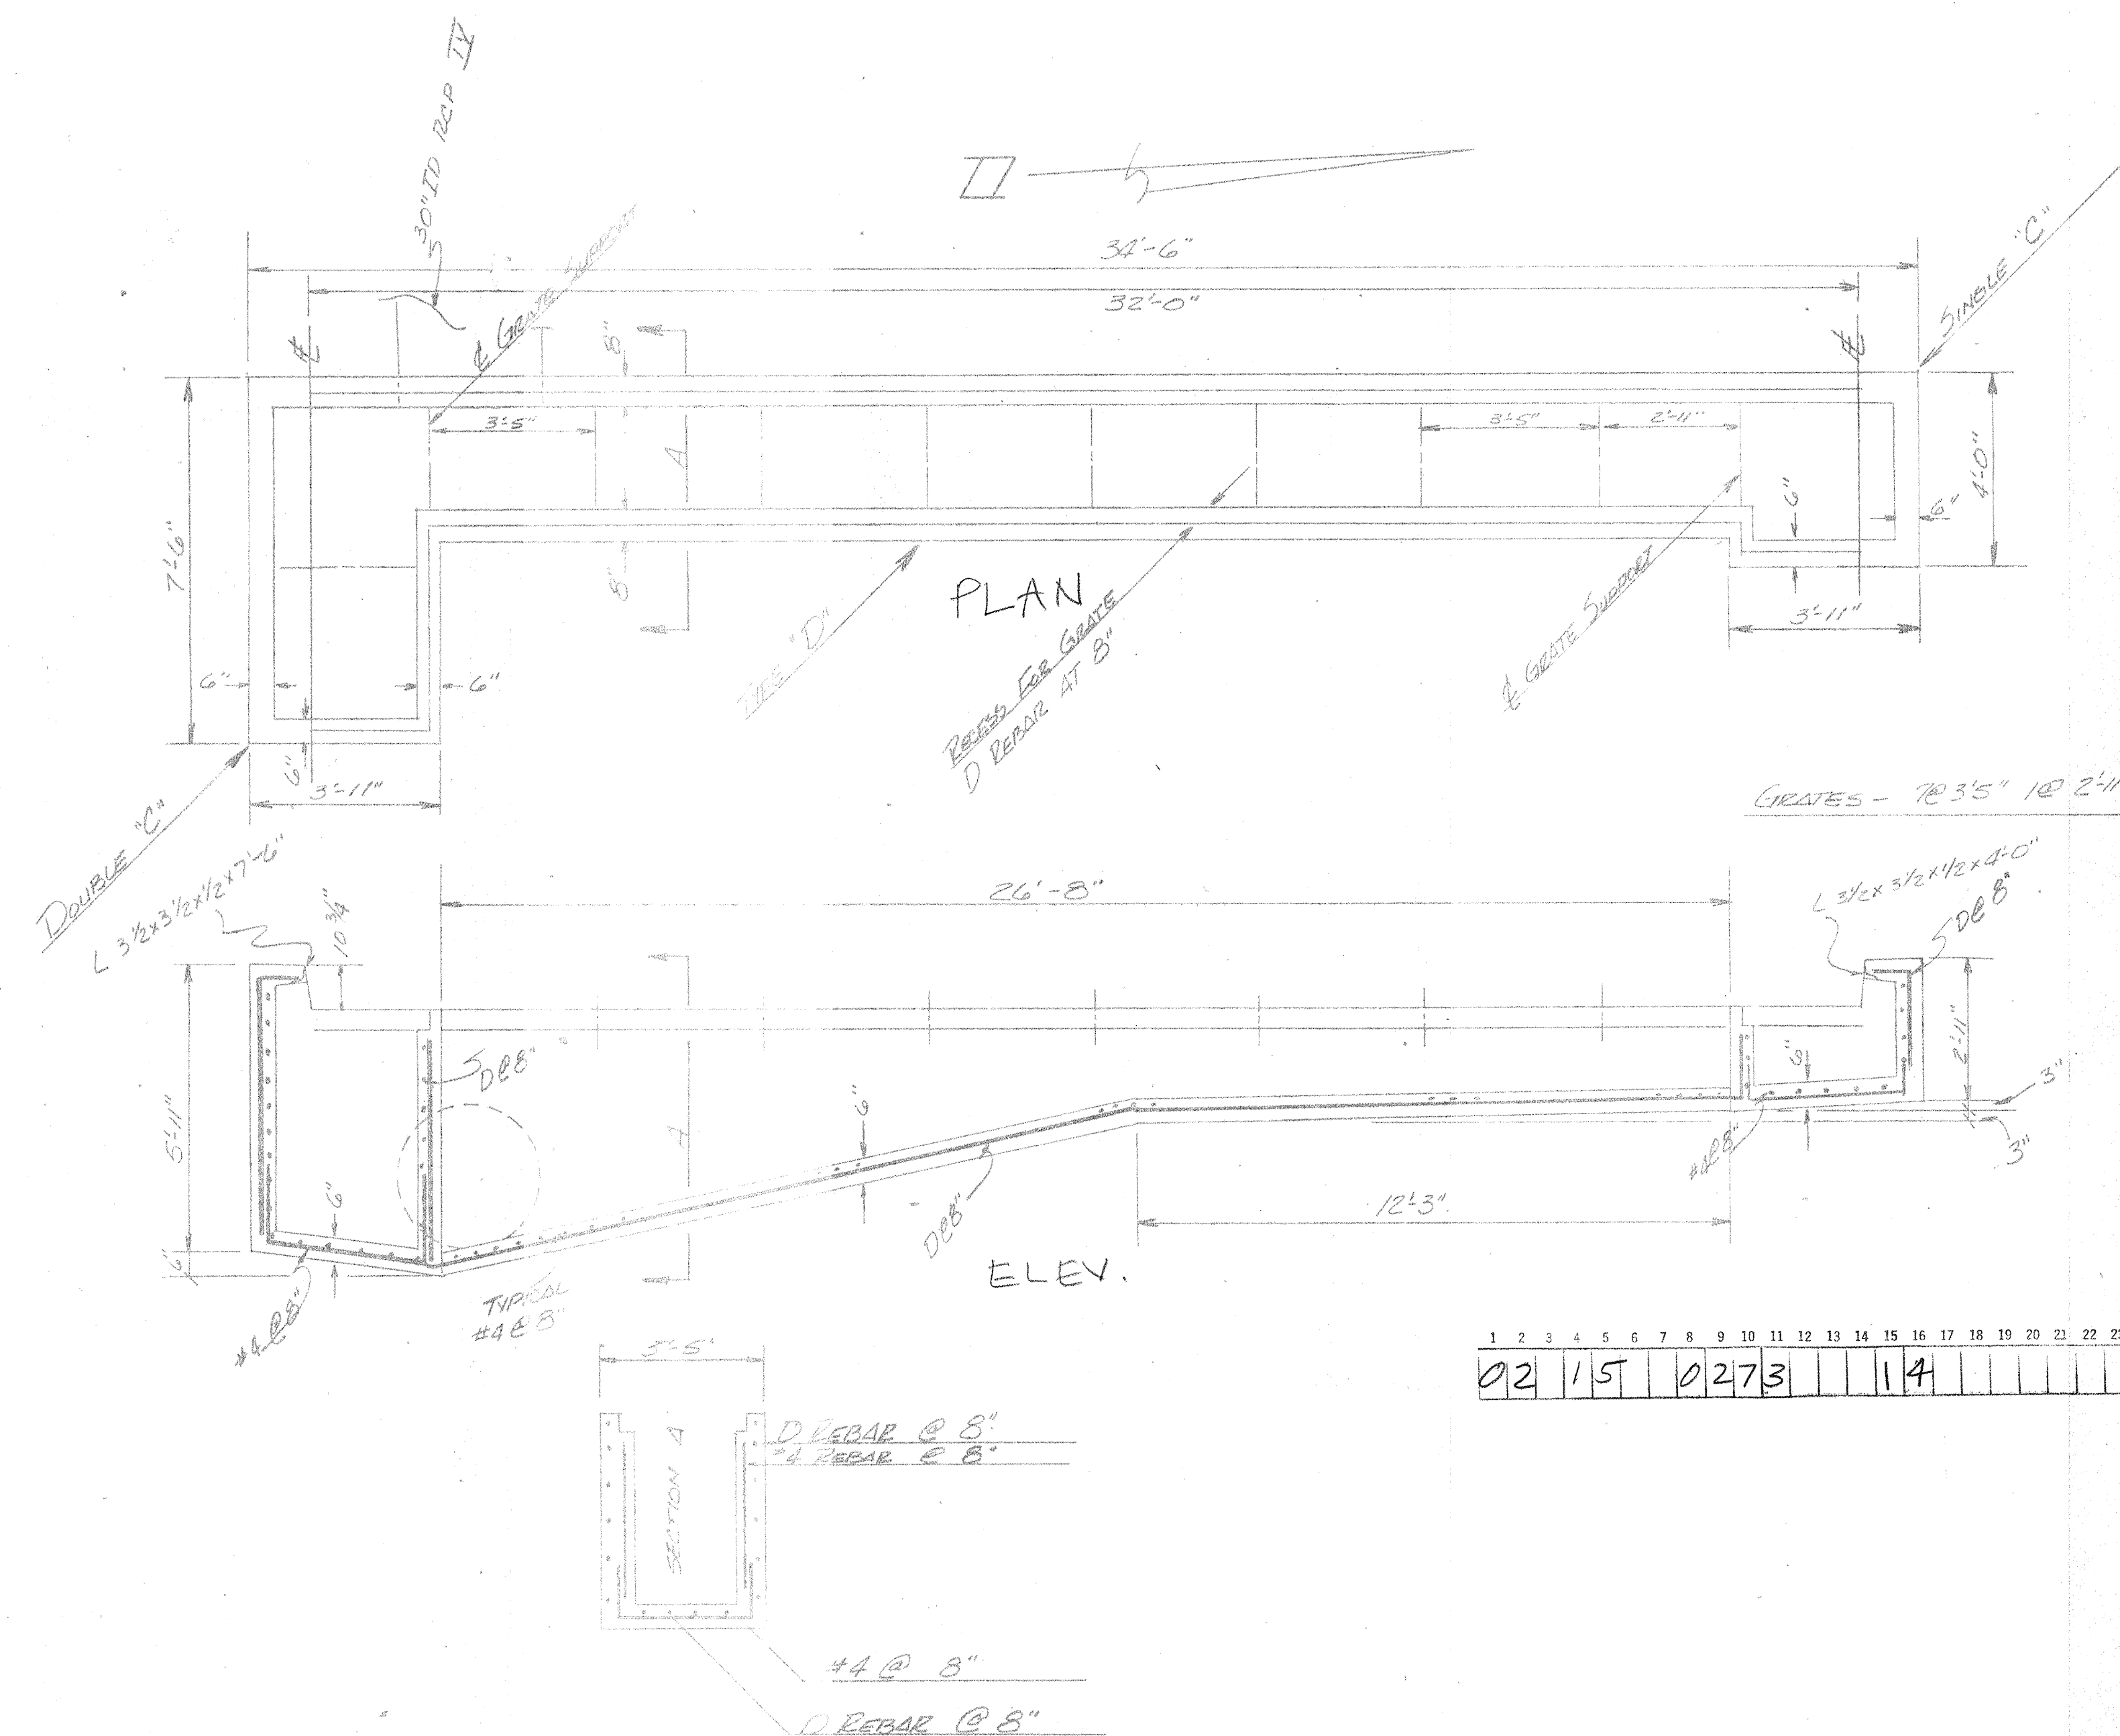

CATTLE GUARD CROSSING
CUATROS CERROS EXTENSION 4 HILLS

SS-15-73

SHEET 2 of 3

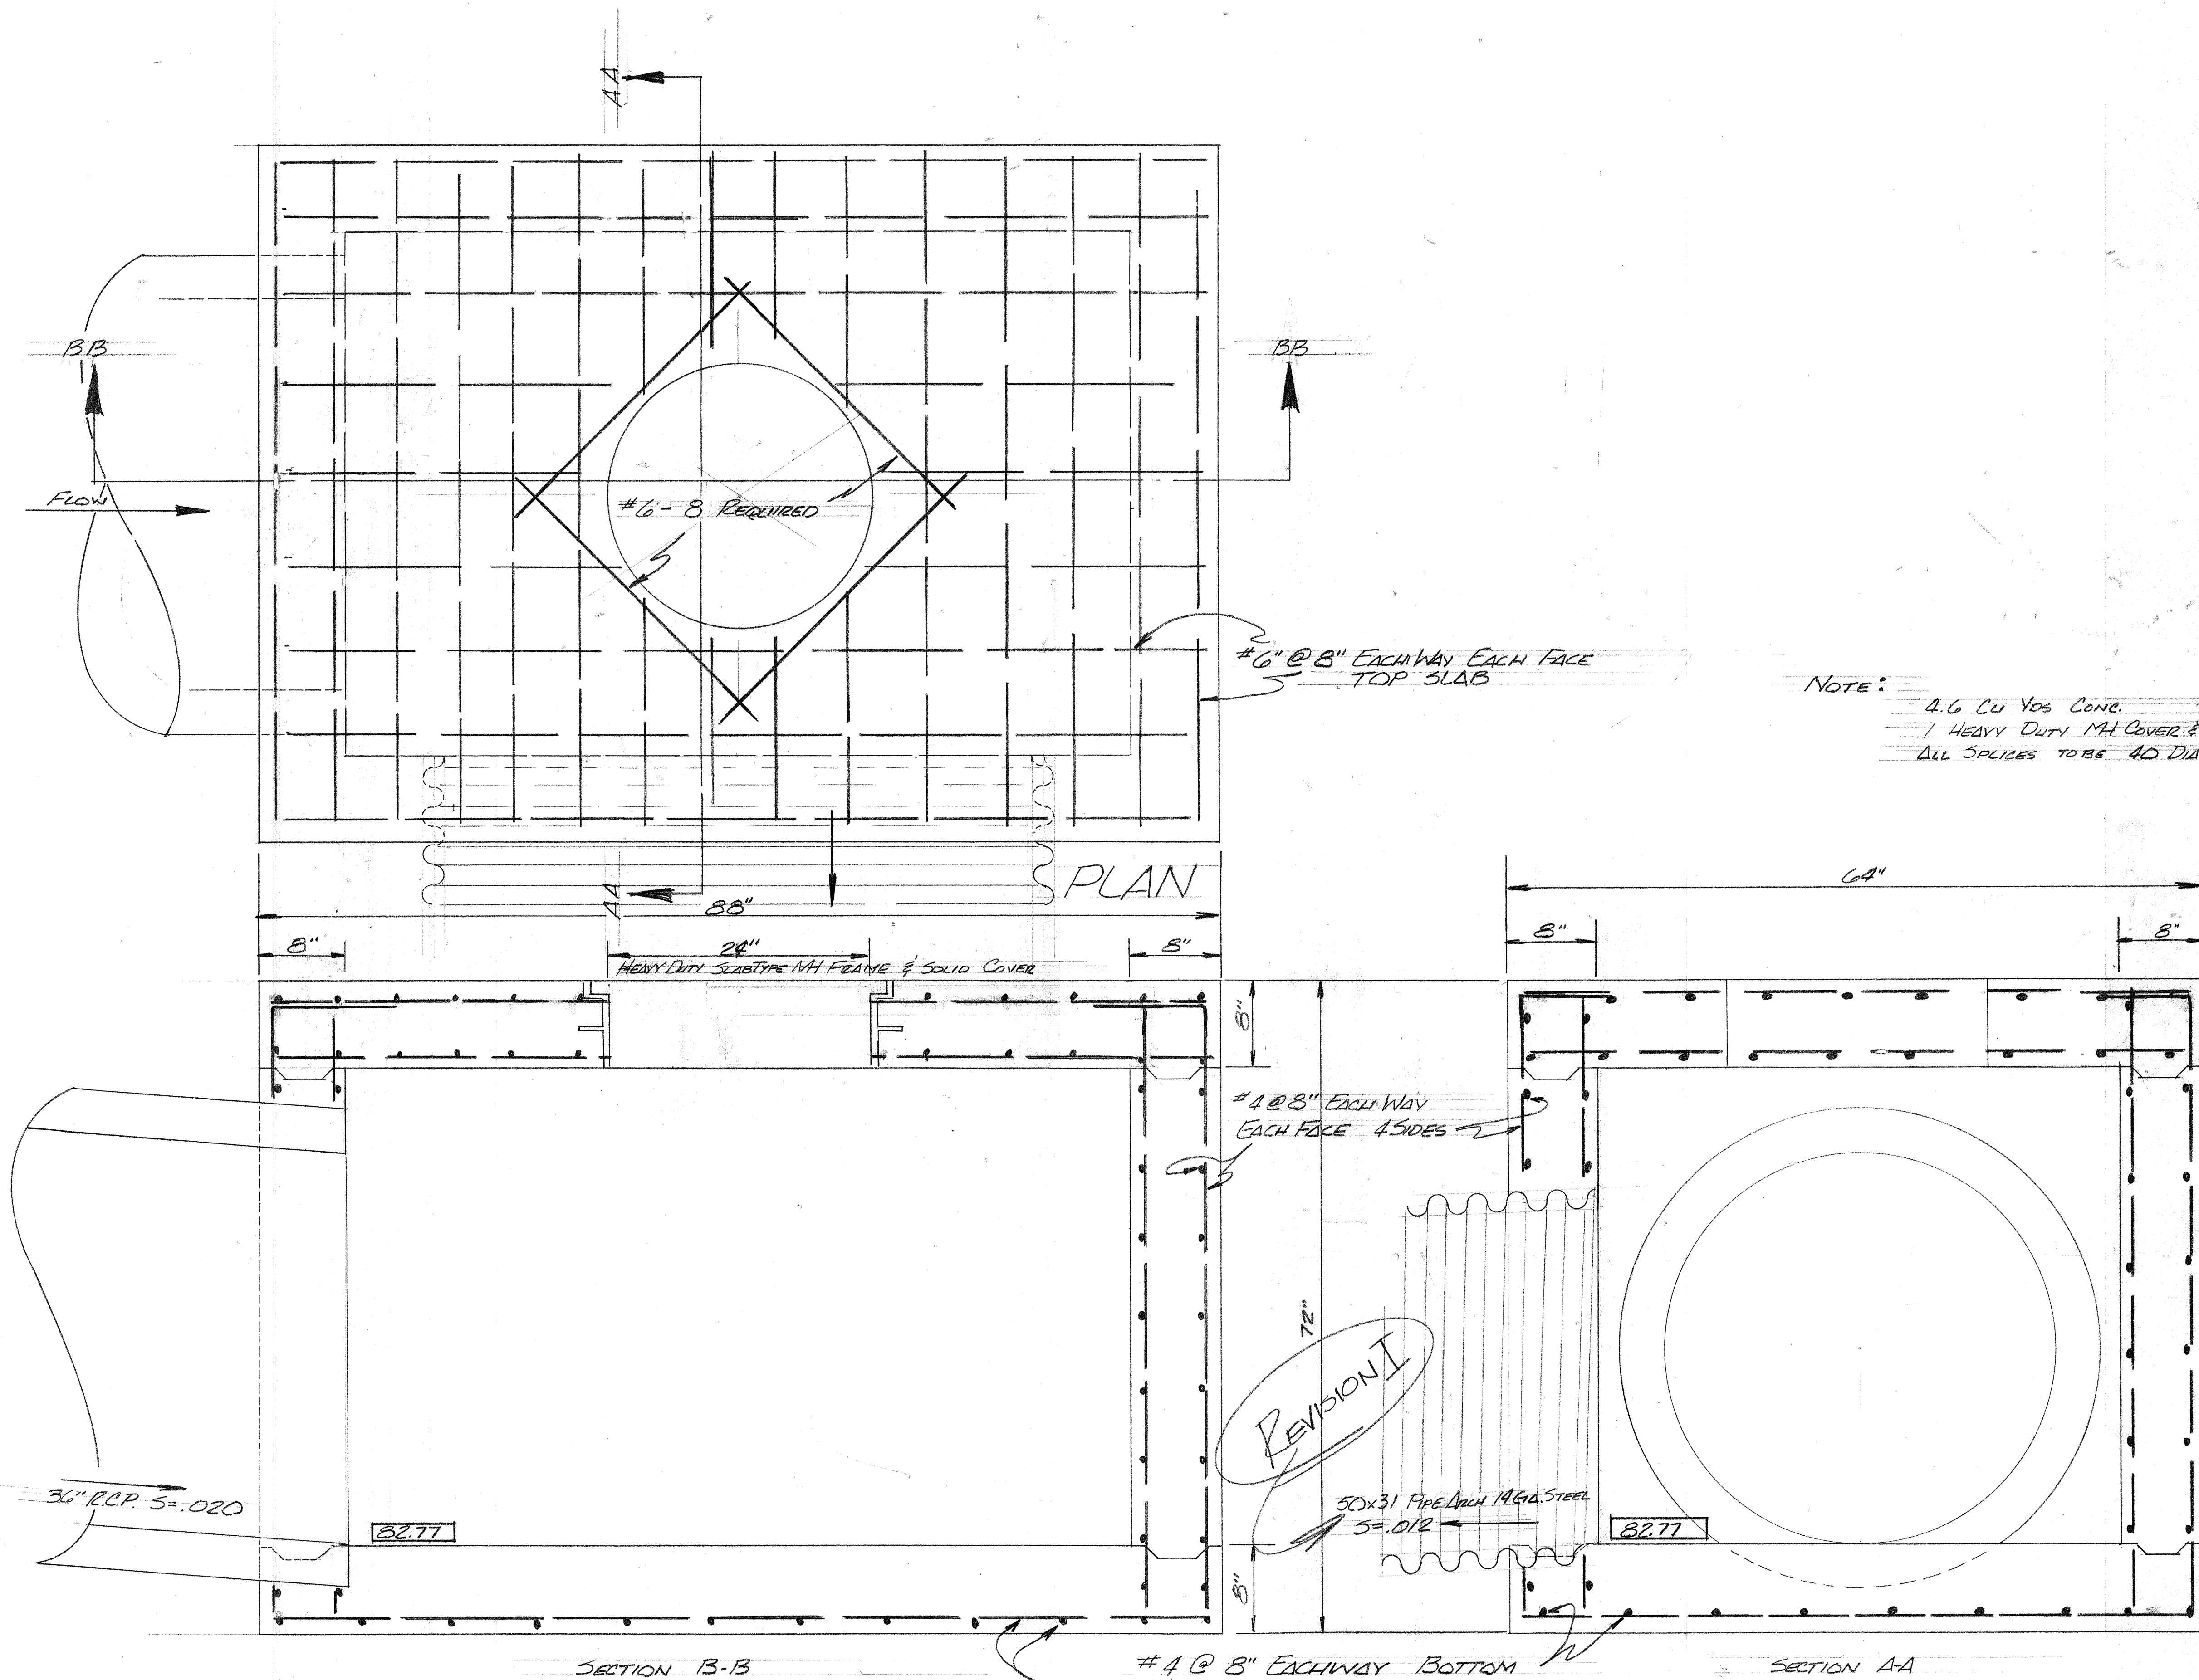

1	2	3	4	5	6	7	8	9	10	11	12	13	14	15	16	17	18	19	20	21	22	23	24	25	26	27	28	29
02	15										0373			10													5522	

SCALE 1 1/2" = 1'-0"

SS-15-73

REV I	1-11-74	PIPE SIZE	12"
CITY OF ALBUQUERQUE PUBLIC WORKS DEPARTMENT ENGINEERING DIVISION			
TITLE Junction Box Detail			
SUBMITTED BY	DATE	TITLE	PRELIMINARY DRWG.
DESIGNED BY	DATE	TITLE	CONSTRUCTION DRWG.
DRAWN BY	DATE	TITLE	AS BUILT DRWG.
CHECKED BY	DATE	TITLE	FILE NO.
REV. BY	DATE	TITLE	NOTES
REV. BY	DATE	TITLE	NOTES
SHEET NO. 3			OF 3 SHEETS