


RECORD DRAWING
I, Claude A.L. Pilley, N.M.P.E. & L.S. No. 4981,
hereby certify that this drawing has been
revised in accordance with information furnished
by KNC, Inc. Field surveys and that both the
revisions and field surveys were done under
my personal direction and control.

Claude A.L. Pilley
CLAUDE A.L. PILLEY

SCALE: 1" = 40'

APPROVAL OF AS BUILT DRAWINGS
ASSIST. CITY ENGINEER - FIELD
[Signature]
DATE: 4-27-84

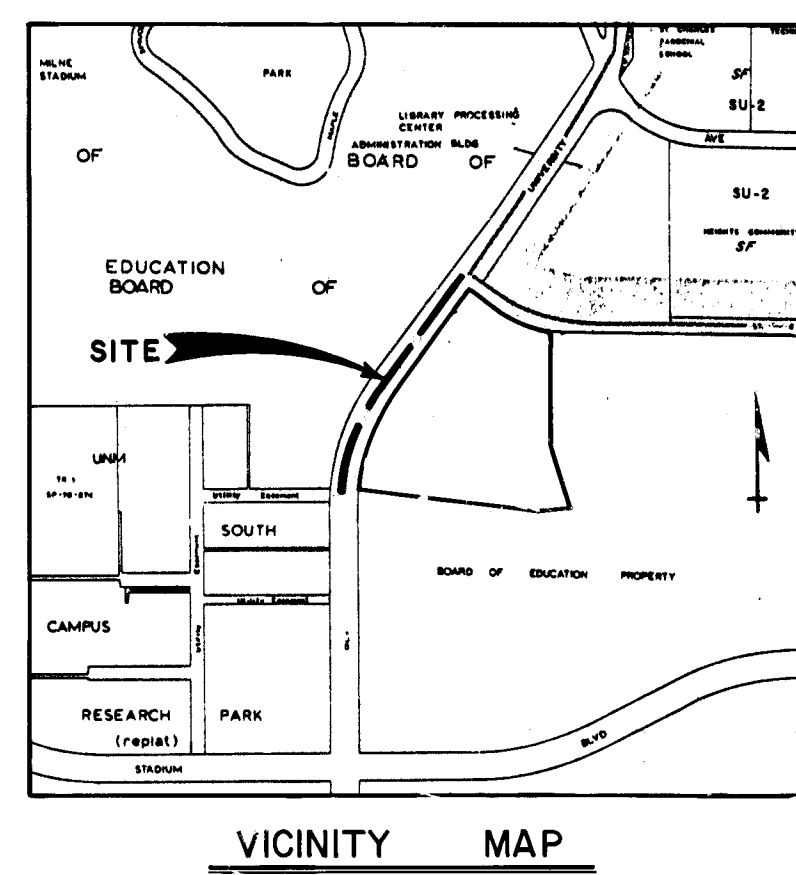

DESCRIPTION		NEW	EXISTING
CURB & GUTTER		=====	=====
SIDEWALK		=====	=====
WALL		=====	=====
POWER POLE		o	o
CHAIN LINK FENCE		o-o	o-o
SANITARY SEWER MANHOLE		o	o
DROP INLET		o	o
SPOT ELEVATION		o	o

NOTES:

- Turn lane to be 12' wide.
- See city standard paving detail p-7-2 for arterial paving and detail p-8-3 for median curb & gutter.
- Provide gravel between median curbs to match existing.
- Remove existing median curb & gutter.
- Match existing paving.
- Field verify length of existing median.
- All dimensions are to the face of curb.
- Vacated power pole to be removed by Contractor.
- A minimum 1' pavement should be removed adjacent to existing curb & gutter to provide a solid connection to existing pavement.

NOTICE TO CONTRACTORS

- New Mexico Standard Specifications for Public Works Construction-1979 Edition will be referred to hereon as the "Standard Specification".
- All work detailed on this plan to be performed under contract shall, except as otherwise stated or provided for hereon, be constructed in accordance with Public Works Contract Documents for City of Albuquerque, Contract No. 84-1.
- Two working days prior to any excavation, Contractor must contact Line Locating Service, 765-1234, for location of existing utilities.
- Prior to construction, the Contractor shall excavate and verify the horizontal and vertical locations of all obstructions. Should a conflict exist, the Contractor shall notify the engineer or Surveyor so that the conflict can be resolved with a minimum amount of delay.
- Backfill compaction shall be according to specified street use.
- Tack coat requirements shall be determined by the City Engineer.
- The requestor or developer shall be responsible for repair or replacement of all curb and gutter or sidewalk damaged after approval by the City Engineer of work completed by the Contractor.

26 2039 0184

C.A. Pilley

CITY OF ALBUQUERQUE
MUNICIPAL DEVELOPMENT DEPARTMENT
ENGINEERING DIVISION

TITLE: MEDIAN REVISION
UNIVERSITY BLVD. S.E. BETWEEN
COAL AVE. AND STADIUM BLVD.

APPROVALS	ENGINEER	DATE	APPROVALS	ENGINEER	DATE
City Engineer	<i>C.A. Pilley</i>	4/23/84	Liquid Waste		
A.C.E. - Design	<i>[Signature]</i>	4/23/84	Traffic	<i>[Signature]</i>	3/8/84
A.C.E. - Hydrology	<i>[Signature]</i>	2/19/84	Water Res.	<i>[Signature]</i>	2/8/84

DRAWING NO. 2039 MAP NO. L-15 SHEET 1 OF 1