



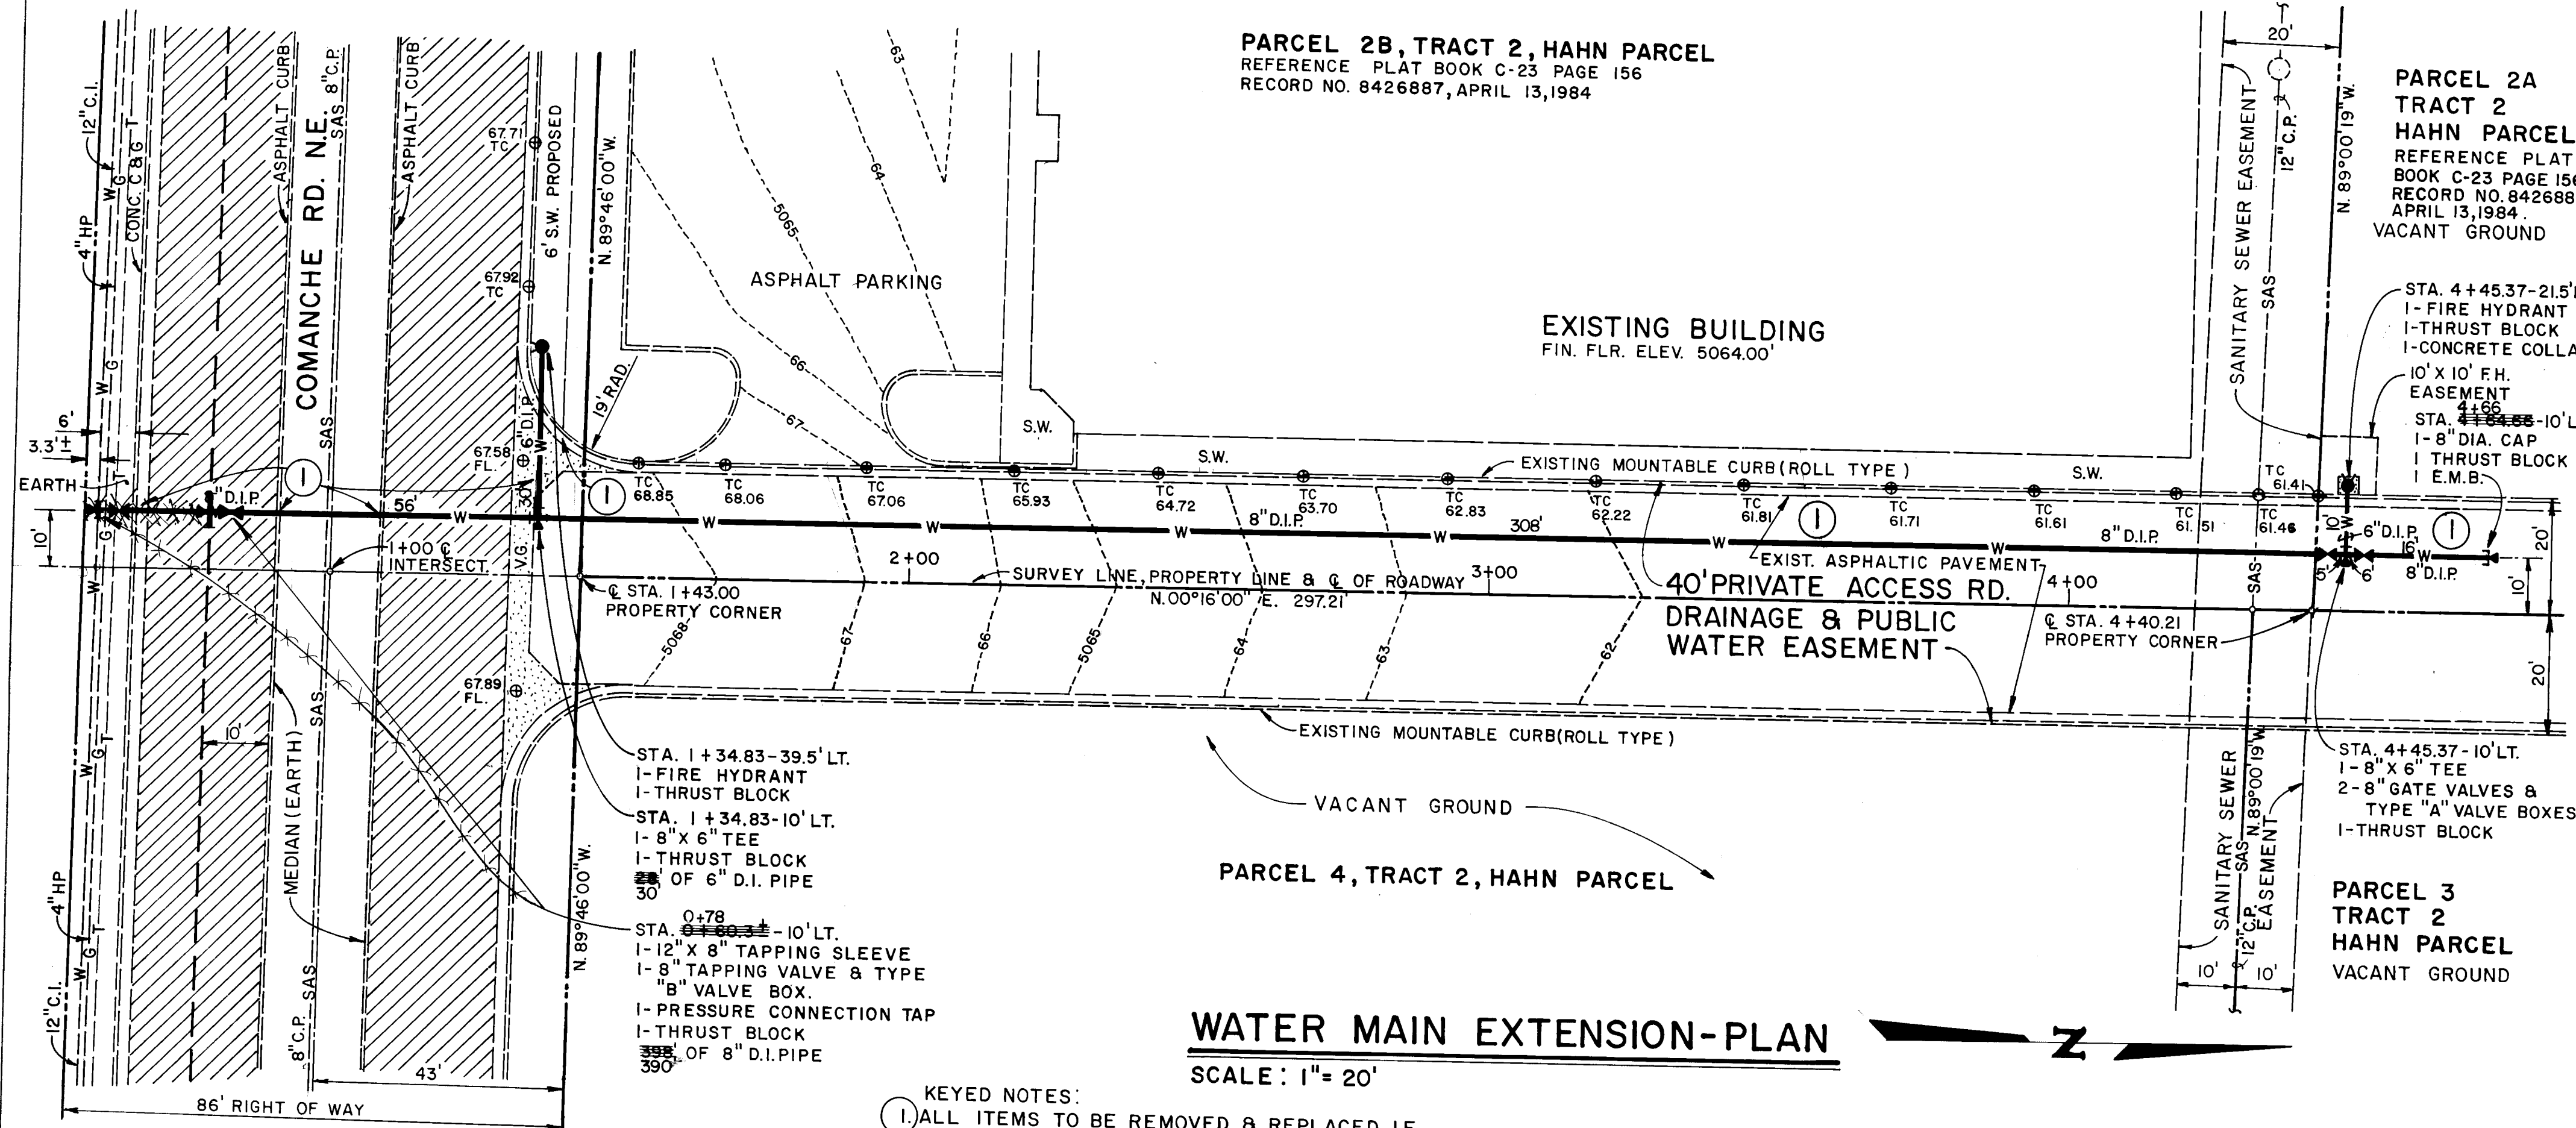

WATER MAIN EXTENSION-PLAN
SCALE: 1"= 20'

NOTE: PRIOR TO CONSTRUCTION THE CONTRACTOR SHALL SECURE A CITY OF ALBUQUERQUE BARRICADING &/OR DETOURING PERMIT AND AN EXCAVATION PERMIT.

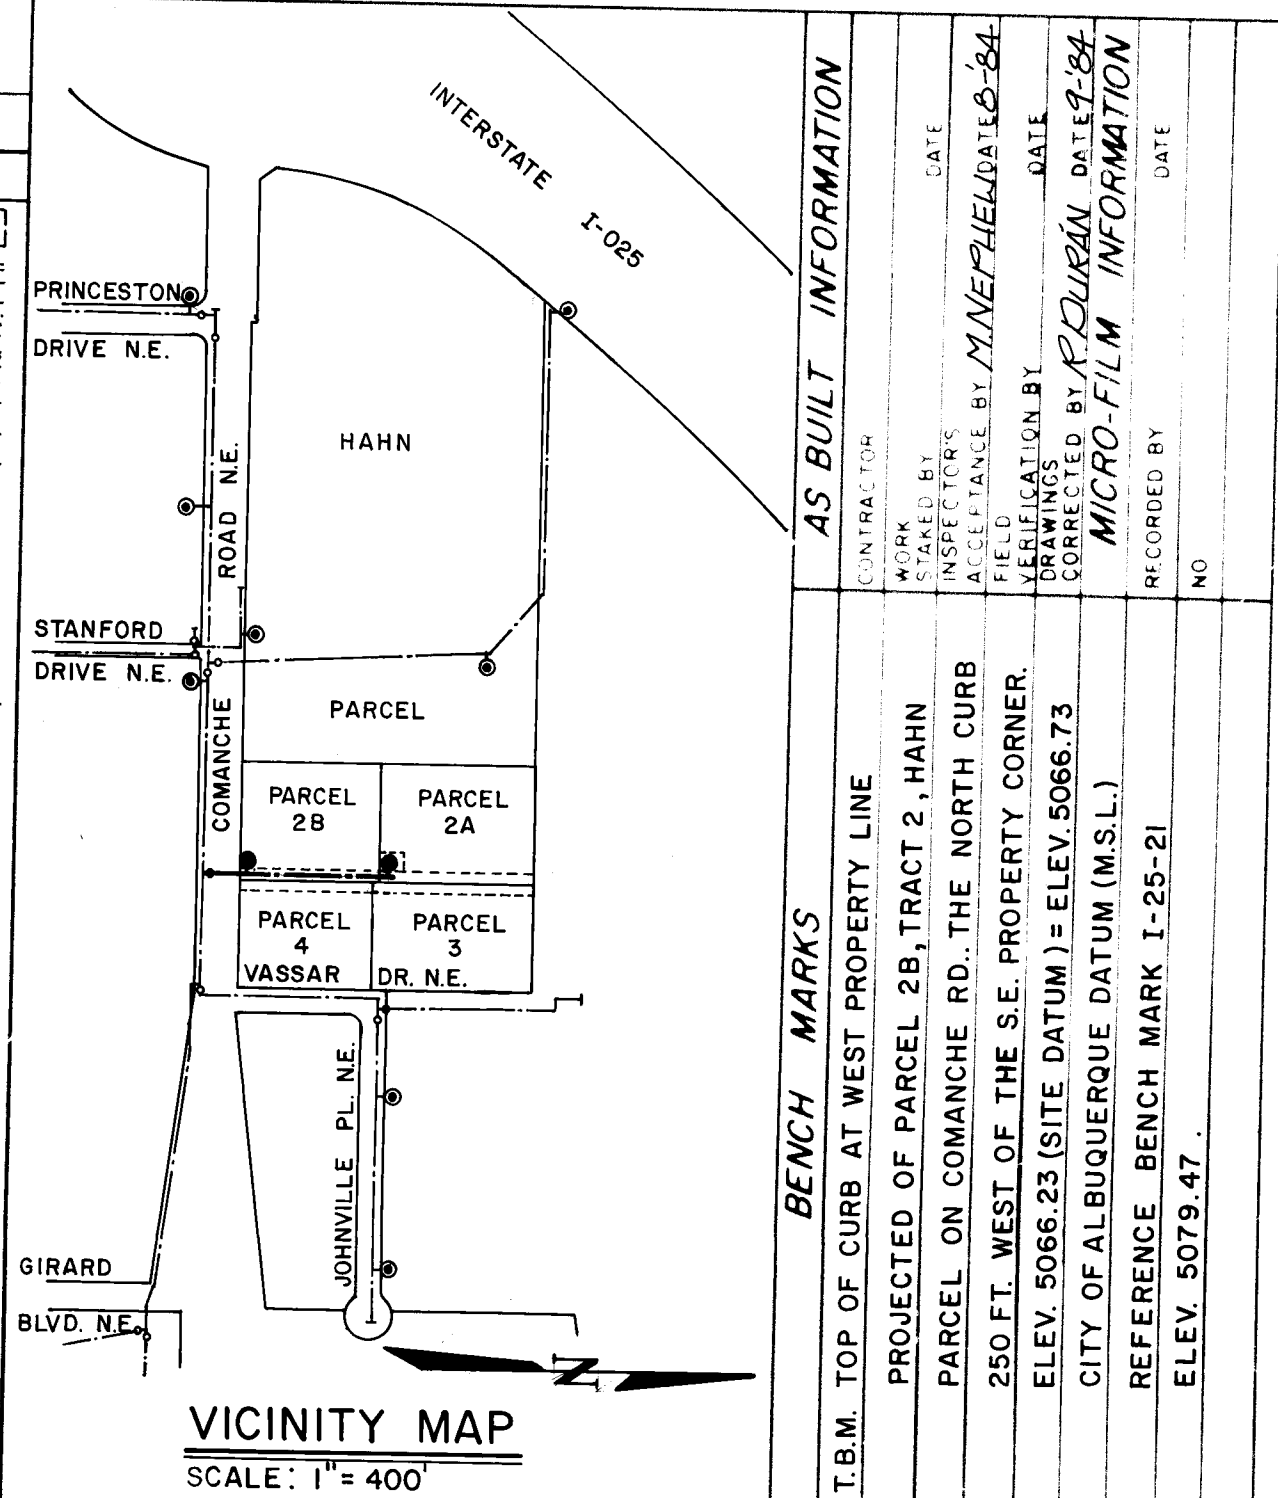

NOTICE TO CONTRACTORS

- ALL WORK DETAILED ON THESE PLANS TO BE PERFORMED UNDER CONTRACT SHALL, EXCEPT AS OTHERWISE STATED OR PROVIDED FOR HEREON, BE CONSTRUCTED IN ACCORDANCE WITH THE NEW MEXICO STANDARD SPECIFICATIONS FOR PUBLIC WORKS CONSTRUCTION, 1979 EDITION (REFERRED TO HEREIN AS THE STANDARD SPECIFICATIONS) AND THE CONTRACT DOCUMENTS FOR PUBLIC WORKS CONTRACT 84-1.
- TWO (2) WORKING DAYS PRIOR TO ANY EXCAVATION, THE CONTRACTOR MUST CONTACT LINE LOCATING SERVICE, 785-1234 FOR LOCATION OF EXISTING UTILITIES.
- PRIOR TO CONSTRUCTION, THE CONTRACTOR SHALL EXCAVATE AND VERIFY THE HORIZONTAL AND VERTICAL LOCATIONS OF ALL OBSTRUCTIONS. SHOULD A CONFLICT EXIST, THE CONTRACTOR SHALL NOTIFY THE ENGINEER OR SURVEYOR SO THAT THE CONFLICT CAN BE RESOLVED WITH MINIMUM AMOUNT OF DELAY.


THE FOLLOWING NOTES ALSO APPLY WHEN CHECKED

- ☐ ALL UTILITIES AND UTILITY SERVICE LINES SHALL BE INSTALLED PRIOR TO PAVING.
- ☒ BACKFILL COMPACTION SHALL BE ACCORDING TO SPECIFIED STREET USE.
- ☐ TACK COAT REQUIREMENTS SHALL BE DETERMINED BY THE CITY ENGINEER.
- ☐ SIDEWALKS AND WHEELCHAIR RAMPS WITHIN THE CURB RETURNS SHALL BE CONSTRUCTED WHEREVER A NEW CURB RETURN IS CONSTRUCTED.
- ☐ IF CURB IS DEPRESSED FOR A DRIVE-PAD OR A HANDICAP RAMP, THE DRIVE-PAD OR RAMP SHALL BE CONSTRUCTED PRIOR TO ACCEPTANCE OF THE CURB AND GUTTER.
- ☐ ALL STORM DRAINAGE FACILITIES SHALL BE COMPLETED PRIOR TO FINAL ACCEPTANCE.

CITY OF ALBUQUERQUE
MUNICIPAL DEVELOPMENT DEPARTMENT
ENGINEERING DIVISION
TITLE: HAHN PARCEL WATER MAIN EXTENSION

APPROVALS	ENGINEER	DATE	APPROVALS	ENGINEER	DATE
City Engineer	Chad H. H. H. H.	5/23/94	Liquid Waste	W. J. J. J.	5/23/94
ACE - Design	W. J. J. J.	5/23/94	Traffic	W. J. J. J.	5/23/94
ACE - Hydrology	W. J. J. J.	5/23/94	Water	W. J. J. J.	5/23/94

DRAWING NO.	2054	MAP NO.	G-16-Z	SHEET	1 OF 1
-------------	------	---------	--------	-------	--------

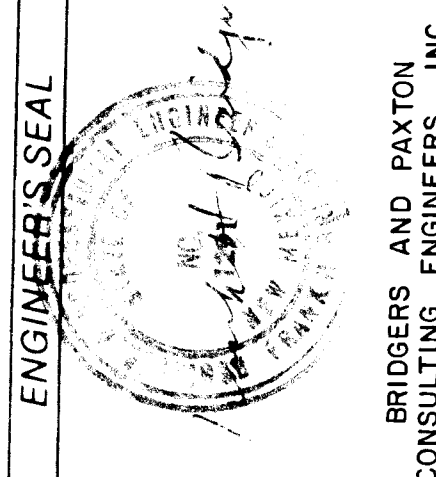

REVISIONS	NO.	DATE	BY	REMARKS
DESIGN				

DESIGNED BY	R.S.G.	DATE	APR. 2, 1984
DRAWN BY	R.S.G.	DATE	APR. 2, 1984
CHECKED BY	F.H.B.	DATE	APR. 2, 1984

DRAWING NO.	2054	MAP NO.	G-16-Z	SHEET	1 OF 1
-------------	------	---------	--------	-------	--------