


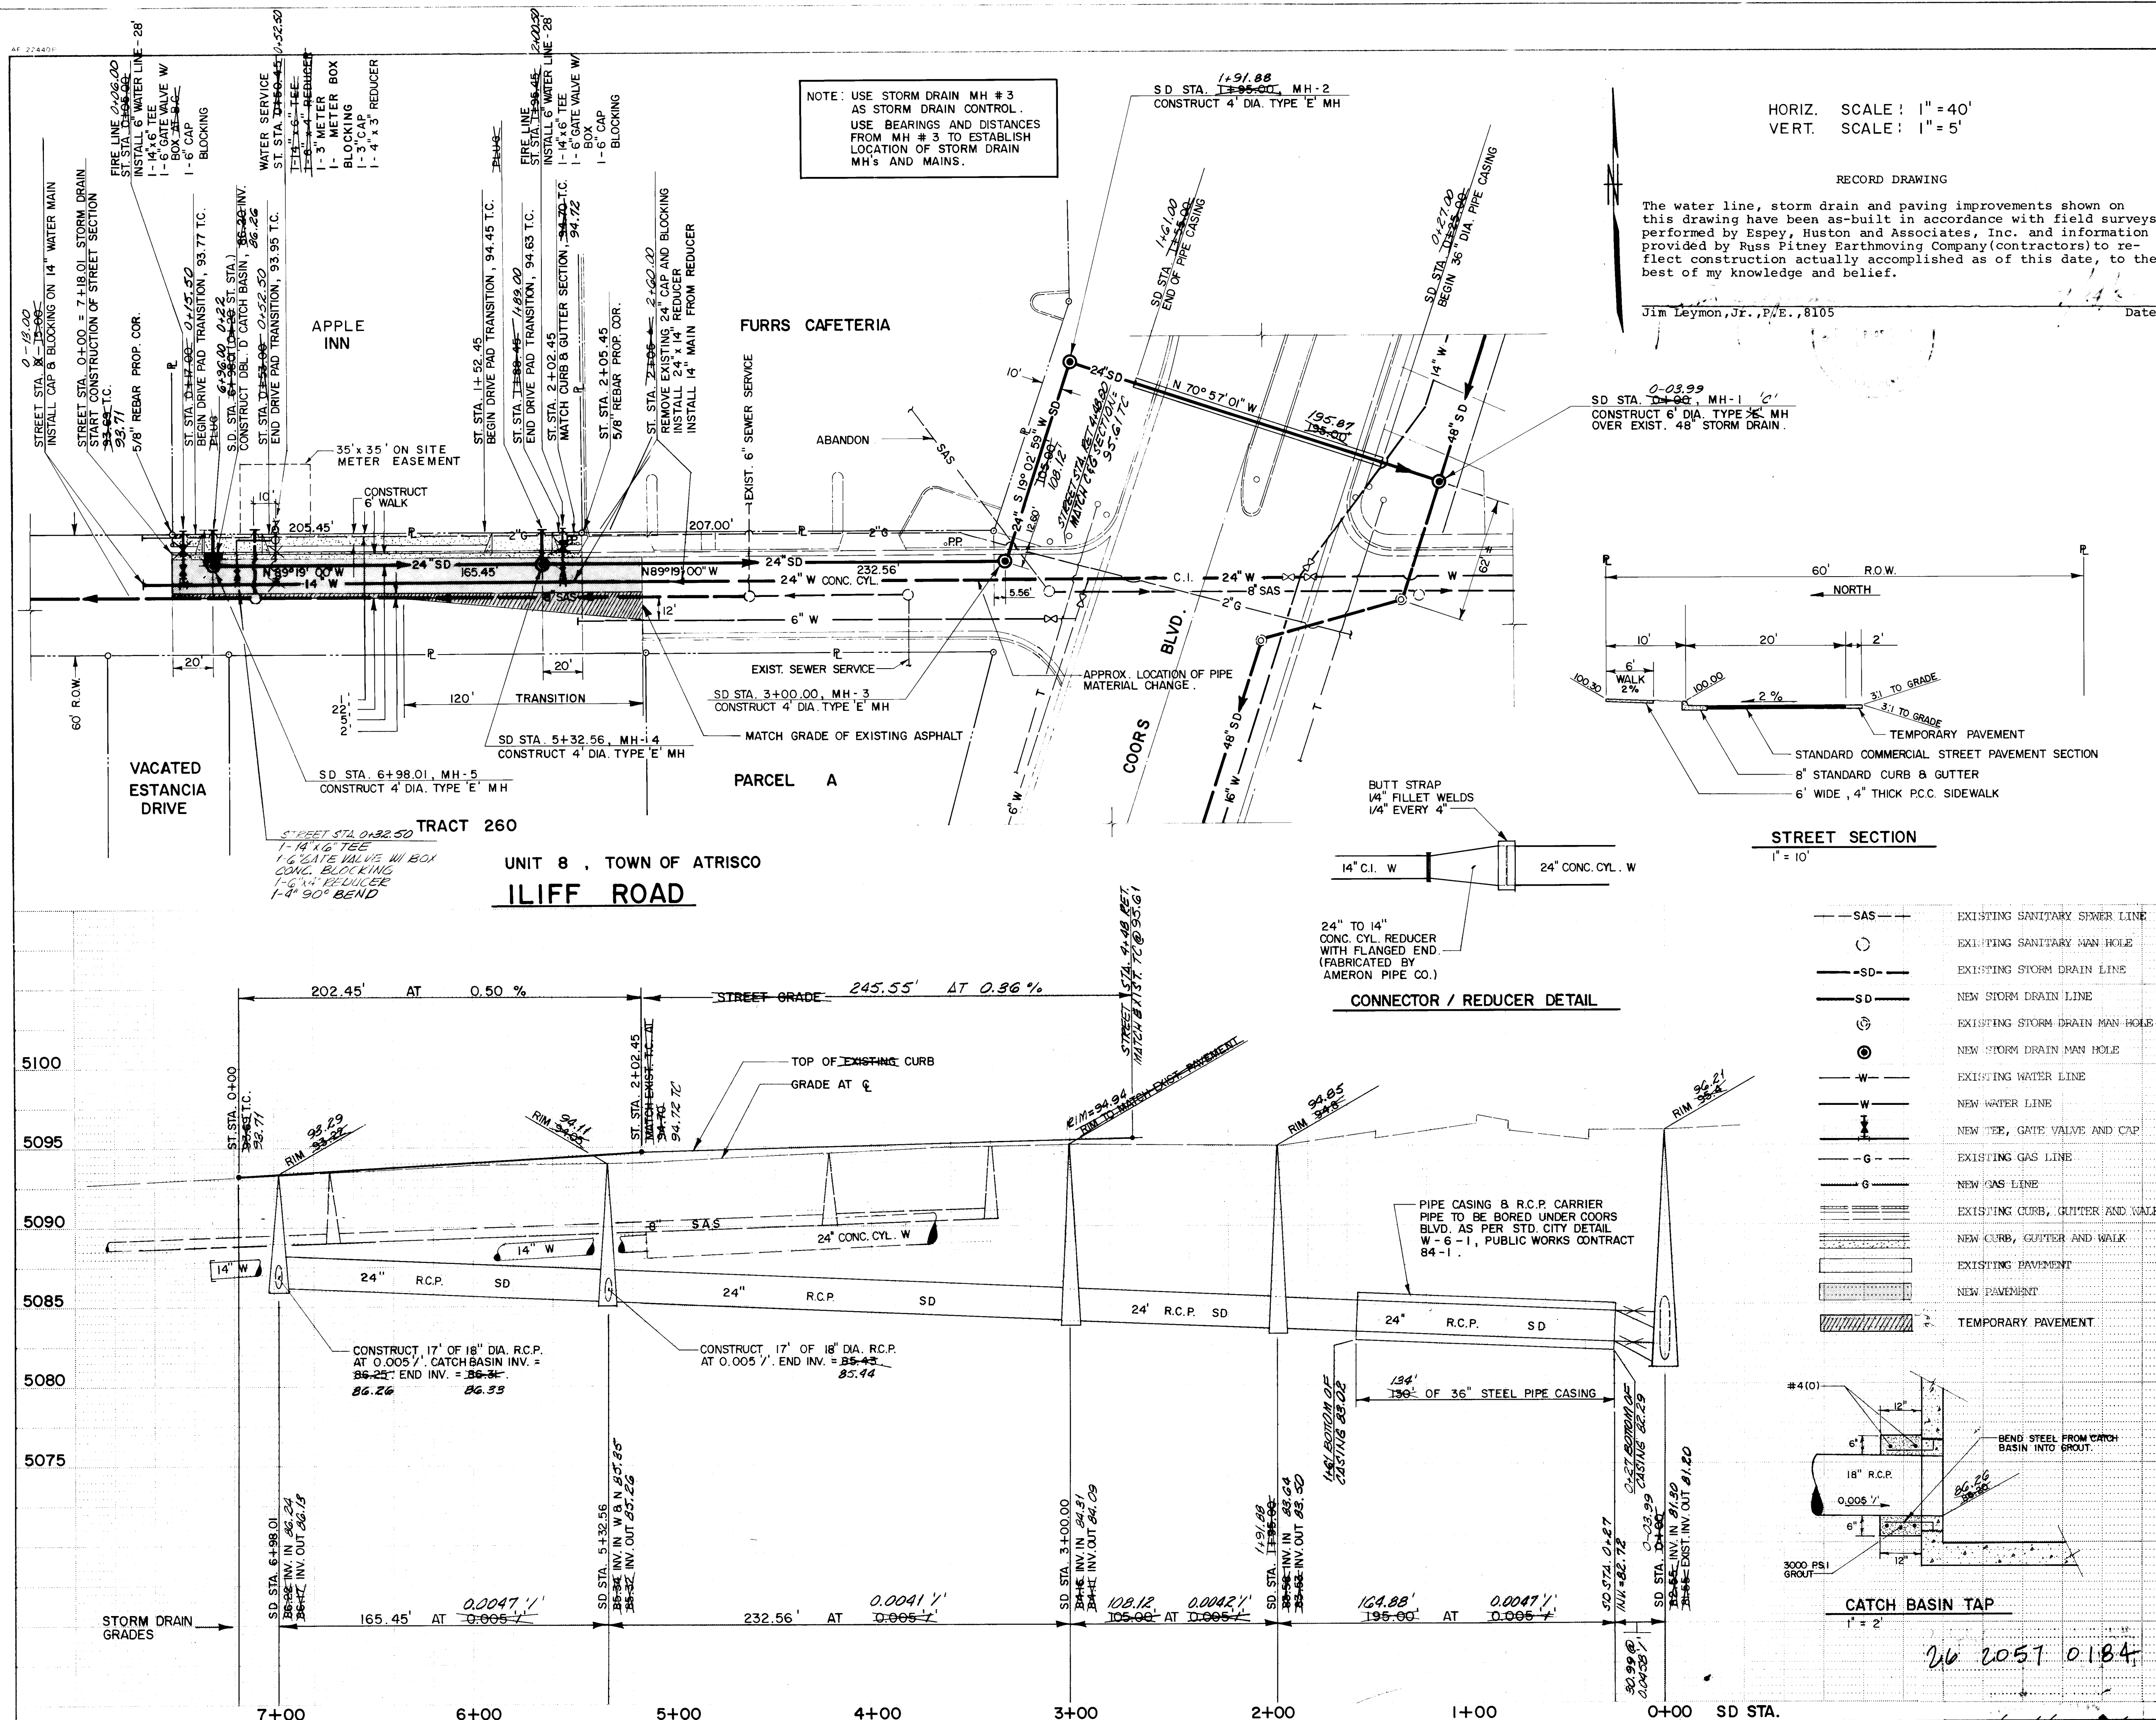


HORIZ. SCALE: 1" = 40'
VERT. SCALE: 1" = 5'

RECORD DRAWING

The water line, storm drain and paving improvements shown on this drawing have been as-built in accordance with field surveys performed by Espey, Huston and Associates, Inc. and information provided by Russ Pitney Earthmoving Company (contractors) to reflect construction actually accomplished as of this date, to the best of my knowledge and belief.

Jim Leymon, Jr., P.E., 8105

Date _____

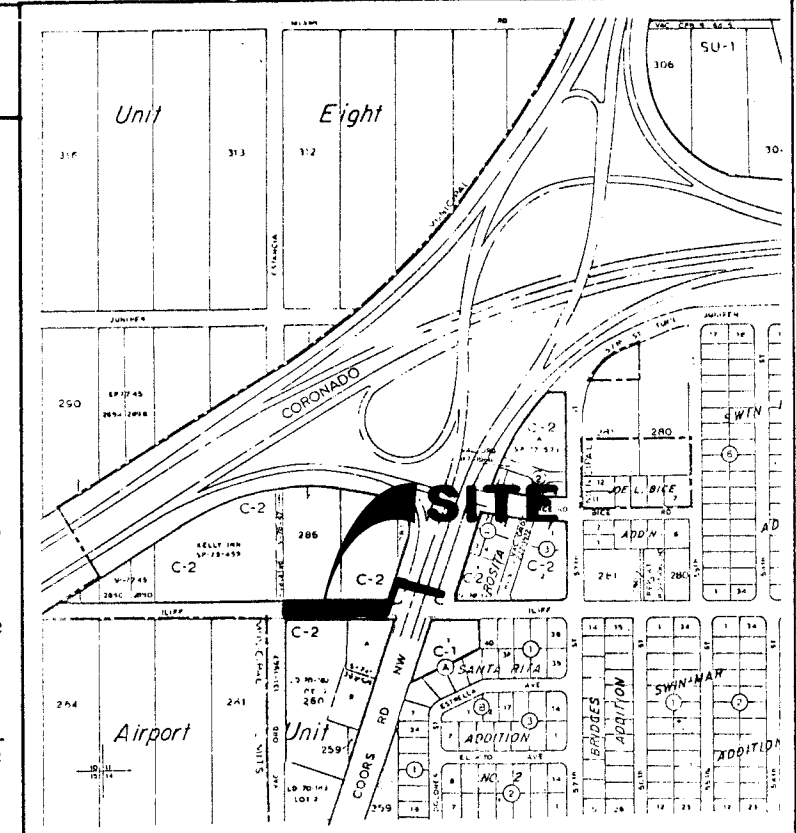

NOTICE TO CONTRACTORS

- 1) All work detailed on these plans to be performed under contract shall, except as otherwise stated or provided for herein, be constructed in accordance with the New Mexico Standard Specifications for Highway Construction, 1979 Edition (referred to herein as the Standard Specifications) and the Contract Documents for Public Works Contract 84-1.
- 2) The 2 working days prior to any excavation, contractor must contact Line Locating Service, 765-1234, for location of existing utilities.
- 3) Prior to construction, the contractor shall excavate and verify the horizontal and vertical locations of all obstructions. Should a conflict exist, the contractor shall notify the engineer or surveyor so that the conflict can be resolved with minimum amount of delay.

THE FOLLOWING NOTES APPLY WHEN CHECKED:

 
- ☒ All utilities and utility service lines shall be installed prior to paving.
- ☒ Backfill compaction shall be according to specified street use. **(COMMERCIAL)**
- ☒ Tack coat requirements shall be determined by the City Engineer.
- ☐ Sidewalks and wheelchair ramps within the curb returns shall be constructed wherever a new curb return is constructed.
- ☒ If curb is depressed for a driveway or a handicap ramp, the depressed or ramp shall be constructed prior to acceptance of the curb and gutter.
- ☒ All storm drainage facilities shall be completed prior to final acceptance.

NOTES :

- INSTALL EDM's AT ALL CAPS AND PLUGS .
- ALL MH's SHALL BE TYPE 'E' .

ALL VALVE BOXES SHALL BE TYPE 'B'

APPROVAL OF AS BUILT DRAWINGS
ASST. CHY ENG. JOHN FIELD
W. J. McFarlane
DATE 8/13/84



P.O. Box 142 (505) 266-3444
Sandia Park, New Mexico 87047

CITY OF ALBUQUERQUE
MUNICIPAL DEVELOPMENT DEPARTMENT
ENGINEERING DIVISION

TITLE: **ILIFF ROAD - WEST OF NORTH COORS**
PAVEMENT , WATER & STORM SEWER EXTENSIONS

APPROVALS	ENGINEER	DATE	APPROVALS	ENGINEER	DATE
City Engineer	<i>C. P. Shuman</i>	4/4/84	Liquid Waste	<i>NA</i>	<i>Jon E. Eidsgaard</i> 4/17/84
A C E - Design	<i>W. J. [unclear]</i>	4/20/84	Traffic	<i>Thomas Wilkerson</i>	4/4/84
A C E - Hydrology	<i>John G. [unclear]</i>	4/10/84	Water	<i>Jon E. Eidsgaard</i>	4/17/84

DRAWING NO.	2057	MAP NO. H - 11	SHEET 1	OF 1
----------------	------	-------------------	------------	---------