


"AS-BUILT" CERTIFICATION:



NOTE: ELEVATIONS SHOWN THUS "(19.76)", ARE "AS-BUILT" ELEVATIONS.

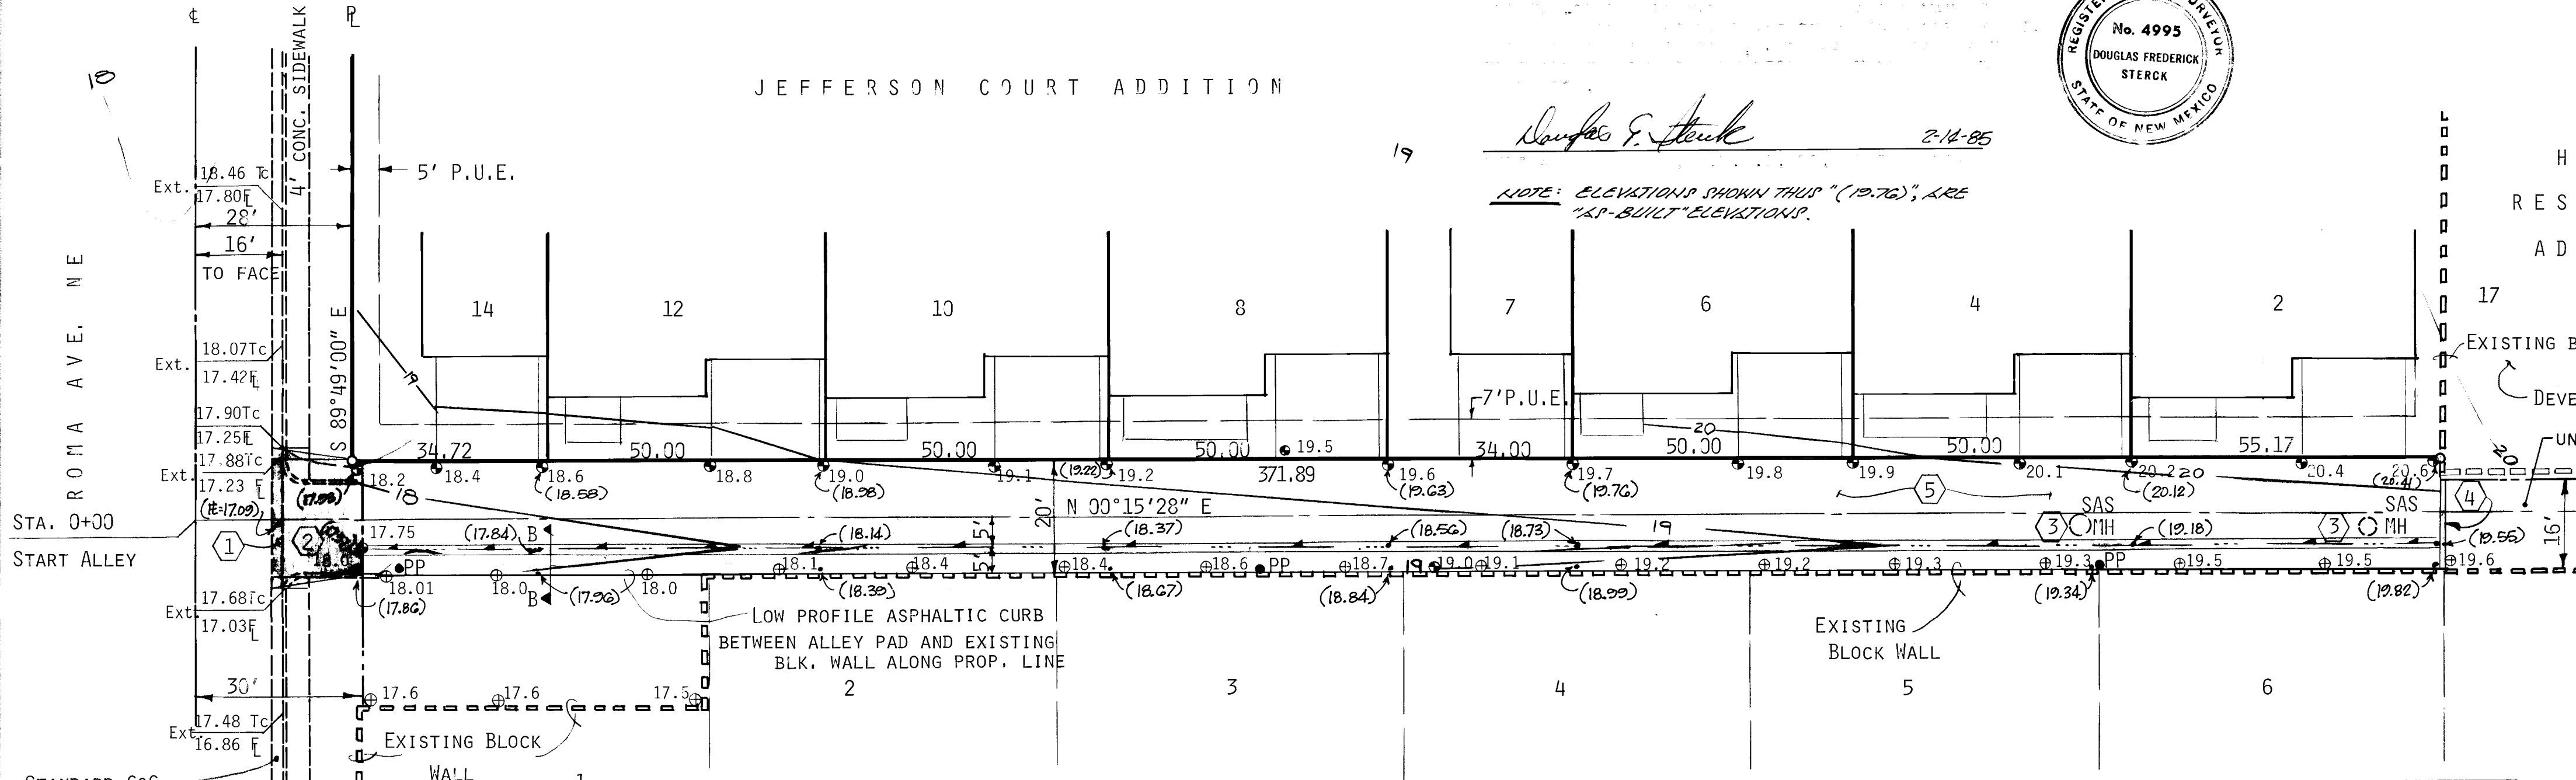

HEIGHTS
RESERVOIR
ADDITION

EXISTING BLOCK WALL
DEVELOPED LOT
UNIMPROVED ALLEY

NOTICE TO CONTRACTORS

- All work detailed on these plans to be performed under contract shall, except as otherwise stated, be provided for hereon, be constructed in accordance with the New Mexico Standard Specifications for Public Works Construction-1979 Edition (referred to herein as the Standard Specifications) and the Contract Documents for Public Works Contract 84-1.
- Two (2) working days prior to any excavation, the contractor must contact Line Locating Service, 765-1234, for location of existing utilities.
- Prior to construction, the contractor shall excavate and verify the horizontal and vertical locations of all obstructions. Should a conflict exist, the contractor shall notify the engineer or surveyor so that the conflict can be resolved with minimum amount of delay.

THE FOLLOWING NOTES ALSO APPLY WHEN CHECKED


- ☐ All utilities and utility service lines shall be installed prior to paving.
- ☐ Backfill compaction shall be according to specified street use.
- ☐ Tack coat requirements shall be determined by the City Engineer.
- ☐ Sidewalks and wheelchair ramps within the curb returns shall be constructed wherever a new curb return is constructed.
- ☐ If curb is depressed for a driveway or a handicap ramp, the driveway or ramp shall be constructed prior to acceptance of the curb and gutter.
- ☐ All storm drainage facilities shall be completed prior to final acceptance.

CONSTRUCTION NOTES


- REMOVE 26' OF CONCRETE GUTTER & CONCRETE RETURNS TO THE SOUTH
- CONSTRUCT ONE ALLEY INTERSECTION AS PER CITY STD. DWG. P-12-2
- ADJUST MANHOLE RIM TO GRADE
- 16' OF CONCRETE CUT-OFF-WALL AS PER CITY STD. DWG. P-8-3
- CONSTRUCT 20' ALLEY AS PER SECTION SHOWN ON THIS SHEET.

GENERAL NOTES


- BASIS OF BEARINGS:
THE SOUTH RIGHT-OF-WAY LINE OF ROMA AVE. BETWEEN THE ALLEY AND JEFFERSON ST.
BEARING: S 89°49'00" E

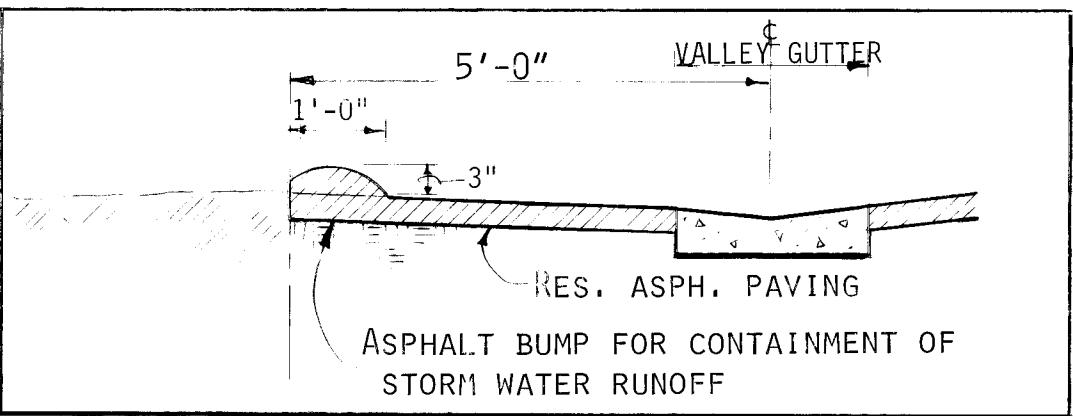


SECTION B-B EDGE OF ALLEY 1"=2'-0"

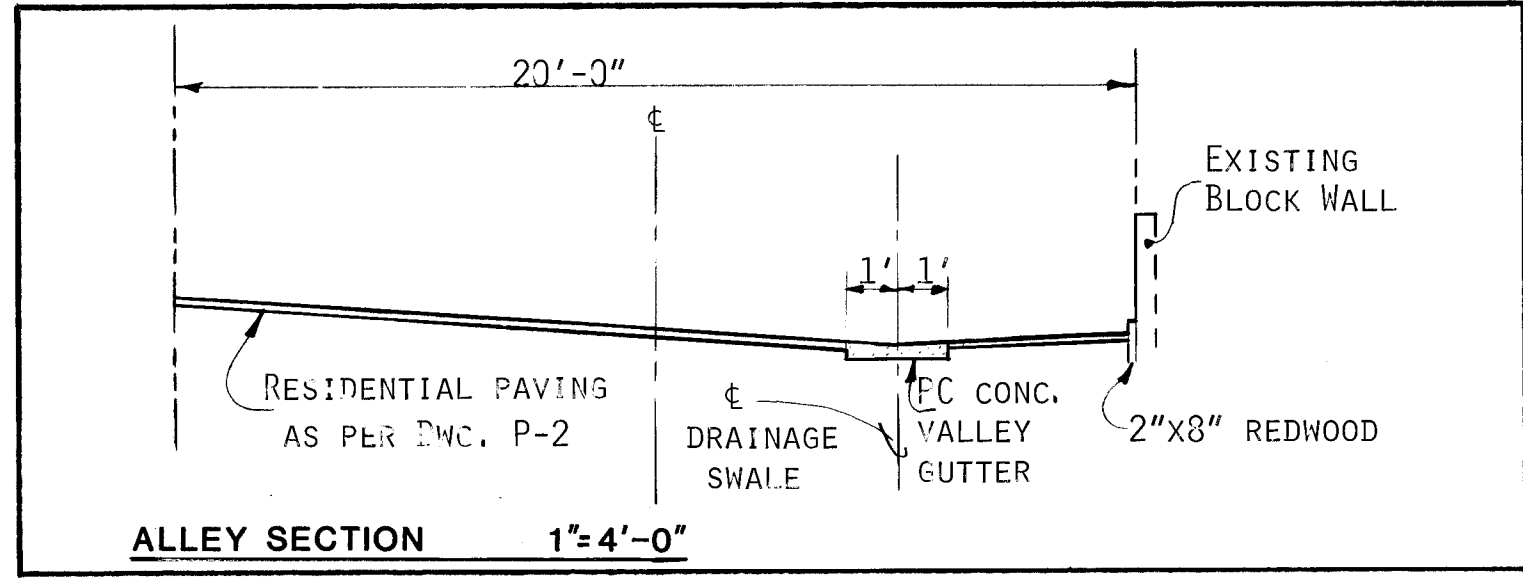

ALLEY SECTION 1"=4'-0"

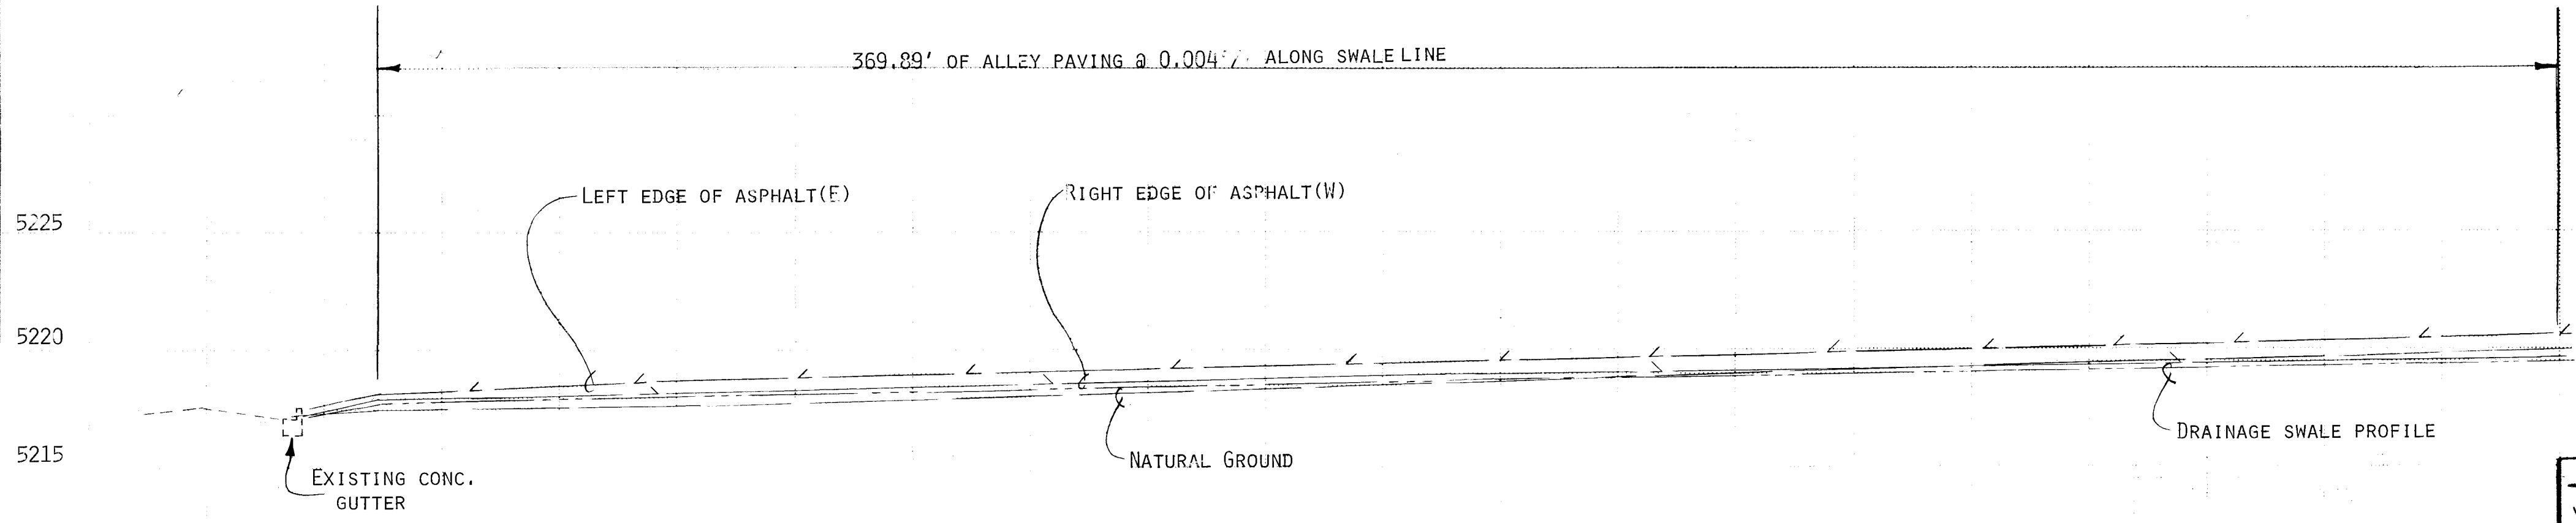

APPROVAL OF AS BUILT DRAWINGS
ASST. CITY ENGINEER-FIELD
W. F. McNamee
DATE 3-1-85

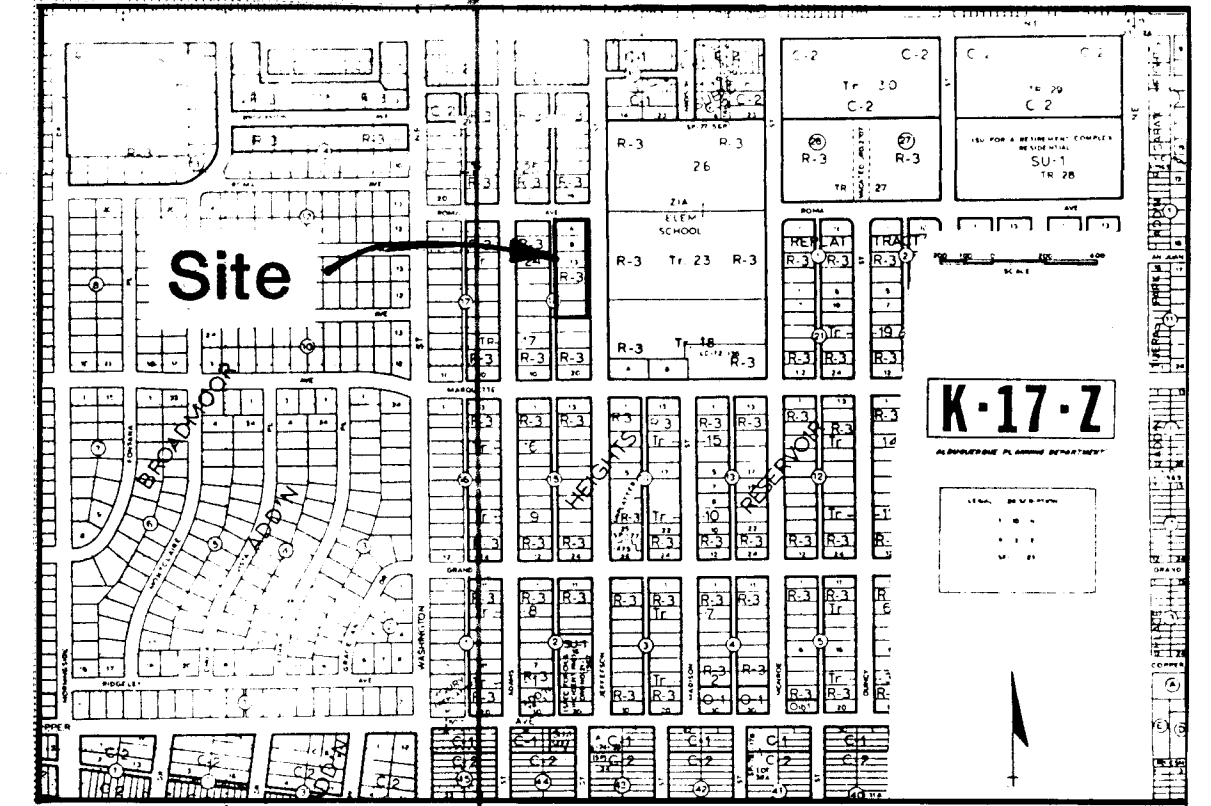

VICINITY MAP

CITY OF ALBUQUERQUE MUNICIPAL DEVELOPMENT DEPARTMENT ENGINEERING DIVISION			
TITLE JEFFERSON COURT ADDITION PUBLIC ALLEY IMPROVEMENTS			
APPROVALS	ENGINEER	DATE	APPROVED BY
City Engineer	<i>[Signature]</i>	2/15/84	<i>[Signature]</i>
ACE Design	<i>[Signature]</i>	16/1/84	
ACE Hydrology	<i>[Signature]</i>	2/15/84	
DRAWING NO. 2061		MAP NO. K-17	