


TWO WORKING DAYS PRIOR TO ANY EXCAVATION, CONTRACTOR MUST CONTACT LINE LOCATING SERVICE, 765-1234, FOR LOCATION OF EXISTING UTILITIES.

NOTICE TO CONTRACTOR
PRIOR TO EXCAVATION, THE CONTRACTOR SHALL EXCAVATE AND VERIFY THE HORIZONTAL AND VERTICAL LOCATIONS OF ALL OBSTRUCTIONS. SHOULD A CONFLICT EXIST, THE CONTRACTOR SHALL NOTIFY THE ENGINEER OR SURVEYOR SO THAT THE CONFLICT CAN BE RESOLVED WITH A MINIMUM AMOUNT OF DELAY.


NOTICE TO CONTRACTOR
IF CURB IS DEPRESSED FOR A DRIVEPAD, THE DRIVEPAD SHALL BE CONSTRUCTED PRIOR TO ACCEPTANCE OF THE CURB & GUTTER.

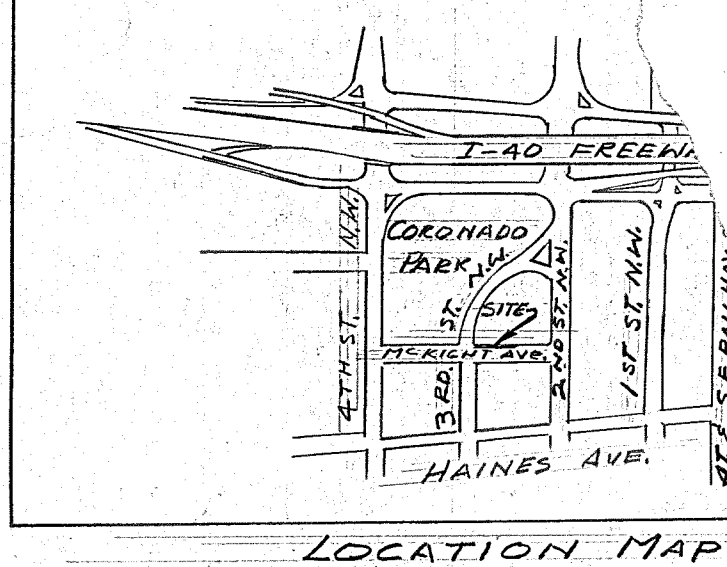

SCALE: 1" = 20' H.
1" = 5' V.

LEGEND

- E 59.31 EXIST. FLOWLINE ELEVATION
- E 59.23 FLOWLINE ELEVATION
- TA 59.21 EXISTING TOP OF ASPHALT
- EXISTING CURB & GUTTER
- STD. CURB & GUTTER
- LIMIT OF CONSTRUCTION

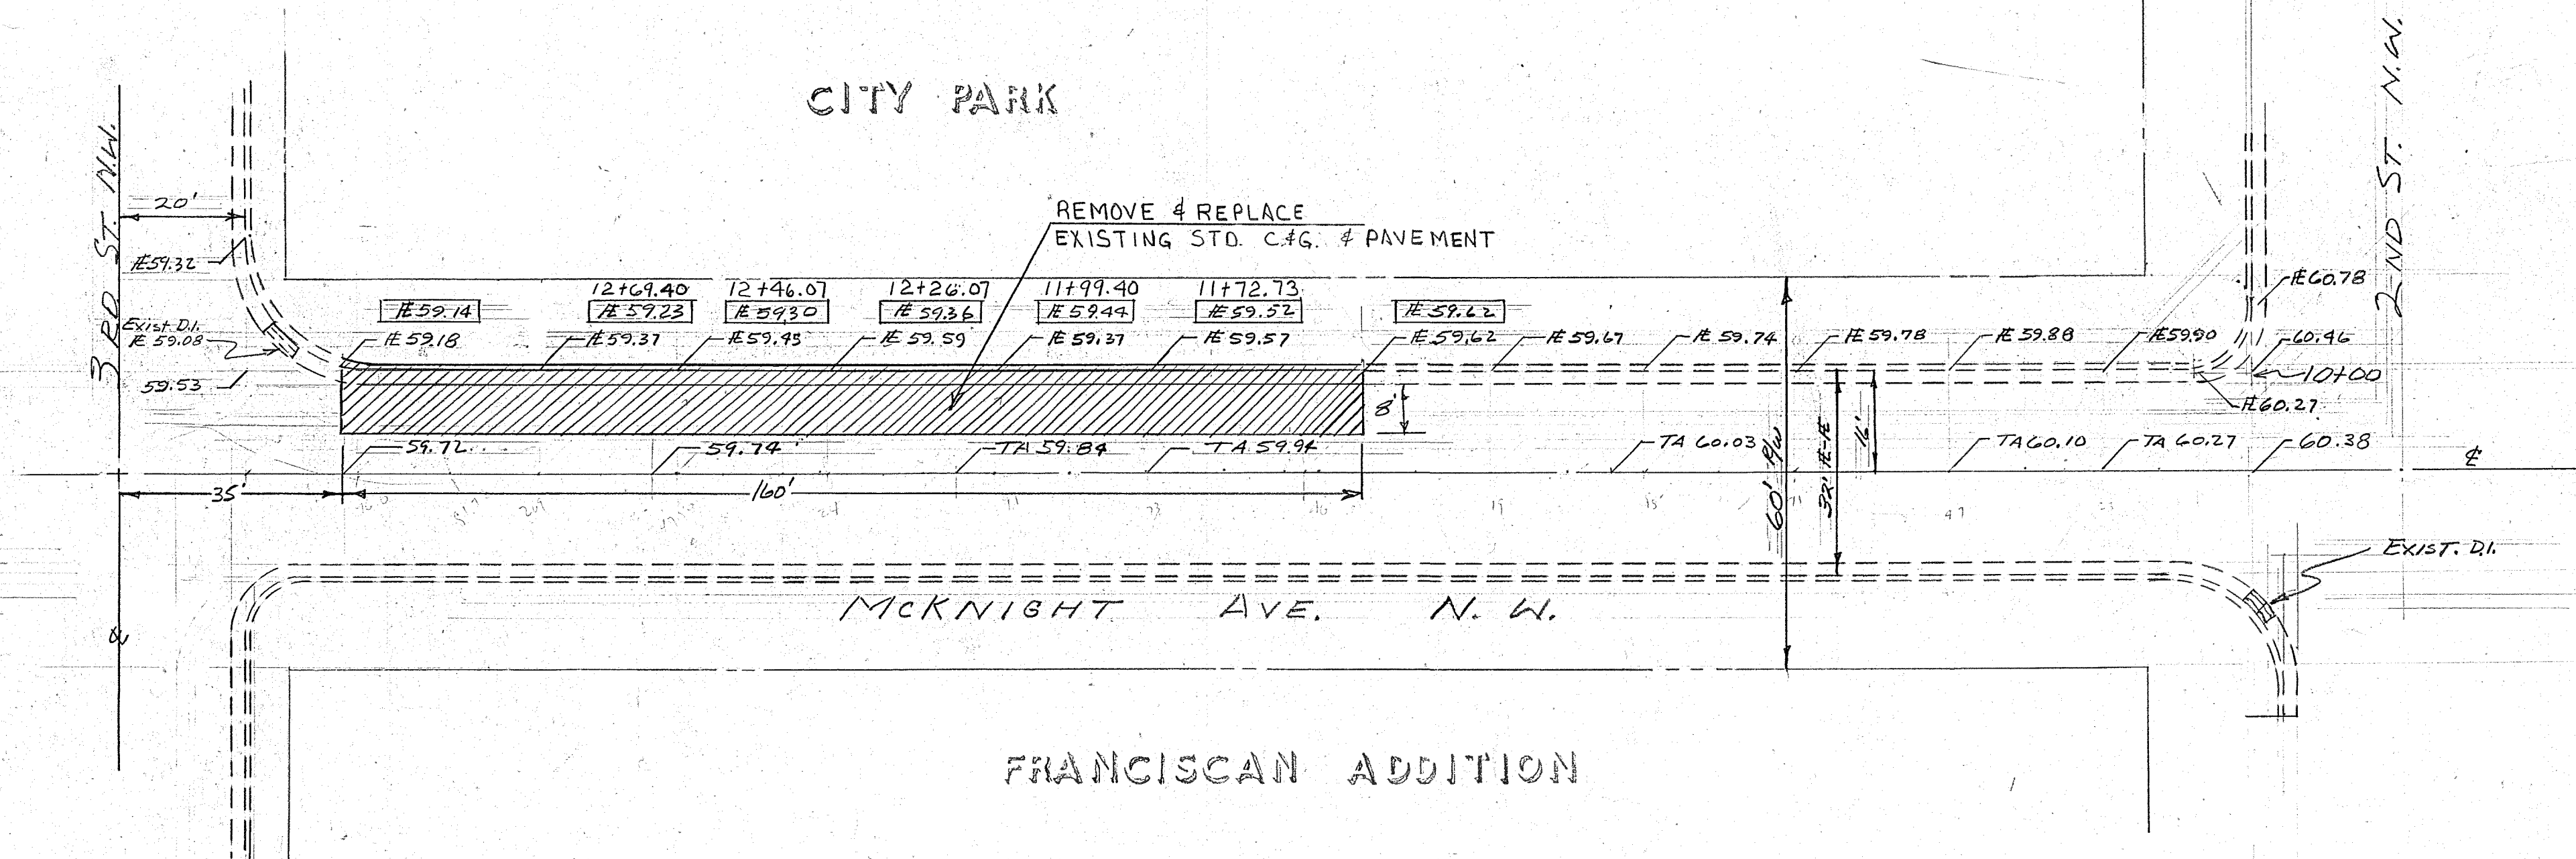

Note:
Pavement replacement shall be arterial standard.

EXIST. E PROFILE

EXIST. N. CURB PROFILE

FLOWLINE SLP 0.0030

4970

4965

4960

4955

4970

4965

4960

4955

24 064 0129

APPROVAL OF AS-BUILT DRAWINGS
ASST. CITY ENGINEER - FIELD
DATE 2-15-80

CITY OF ALBUQUERQUE PUBLIC WORKS DEPARTMENT ENGINEERING DIVISION					
TITLE: CORONADO PARK DRAINAGE IMPROVEMENT ON N. SIDE OF MCKNIGHT AVE. N.W. BETWEEN 2nd ST. N.W. & 3rd ST. N.W.					
APPROVALS	ENGINEER	DATE	APPROVALS	ENGINEER	DATE
City Engineer	R.S. Miller	3/5/80	Liquid Waste		
A.C.E. - Design	T. Sanchez	2/16/80	Traffic		
A.C.E. - Hydrology			Water		
DESIGNED BY: Orlan J. Torbin DATE: 2/19/80					
DRAWN BY: T. Sanchez DATE: 2-80					
CHECKED BY: DATE:					
PARKS & REC. LOCALS. H. M. R. 80 STREET MAINT. 3-6-80					
DRAWING NO. P-29-64 SHEET 1 OF 1					

APPROVED FOR CONSTRUCTION
R.S. Miller 3/24/80
CITY ENGINEER DATE

SURVEY INFORMATION		FIELD NOTES		DATE	
MAP NO.	H-14	EST. NO.	W.O. NO.	NO.	BY
		P-29-64			P. ANGEL
REVISIONS		REMARKS		DATE	
NO.	DATE	REVISIONS		DATE	
1		DESIGN		2/19/80	
2		CHECKED		2-80	