


924 RIO GRANDE BLVD.
PAVEMENT IMPROVEMENTS

CITY OF ALBUQUERQUE
NEW MEXICO

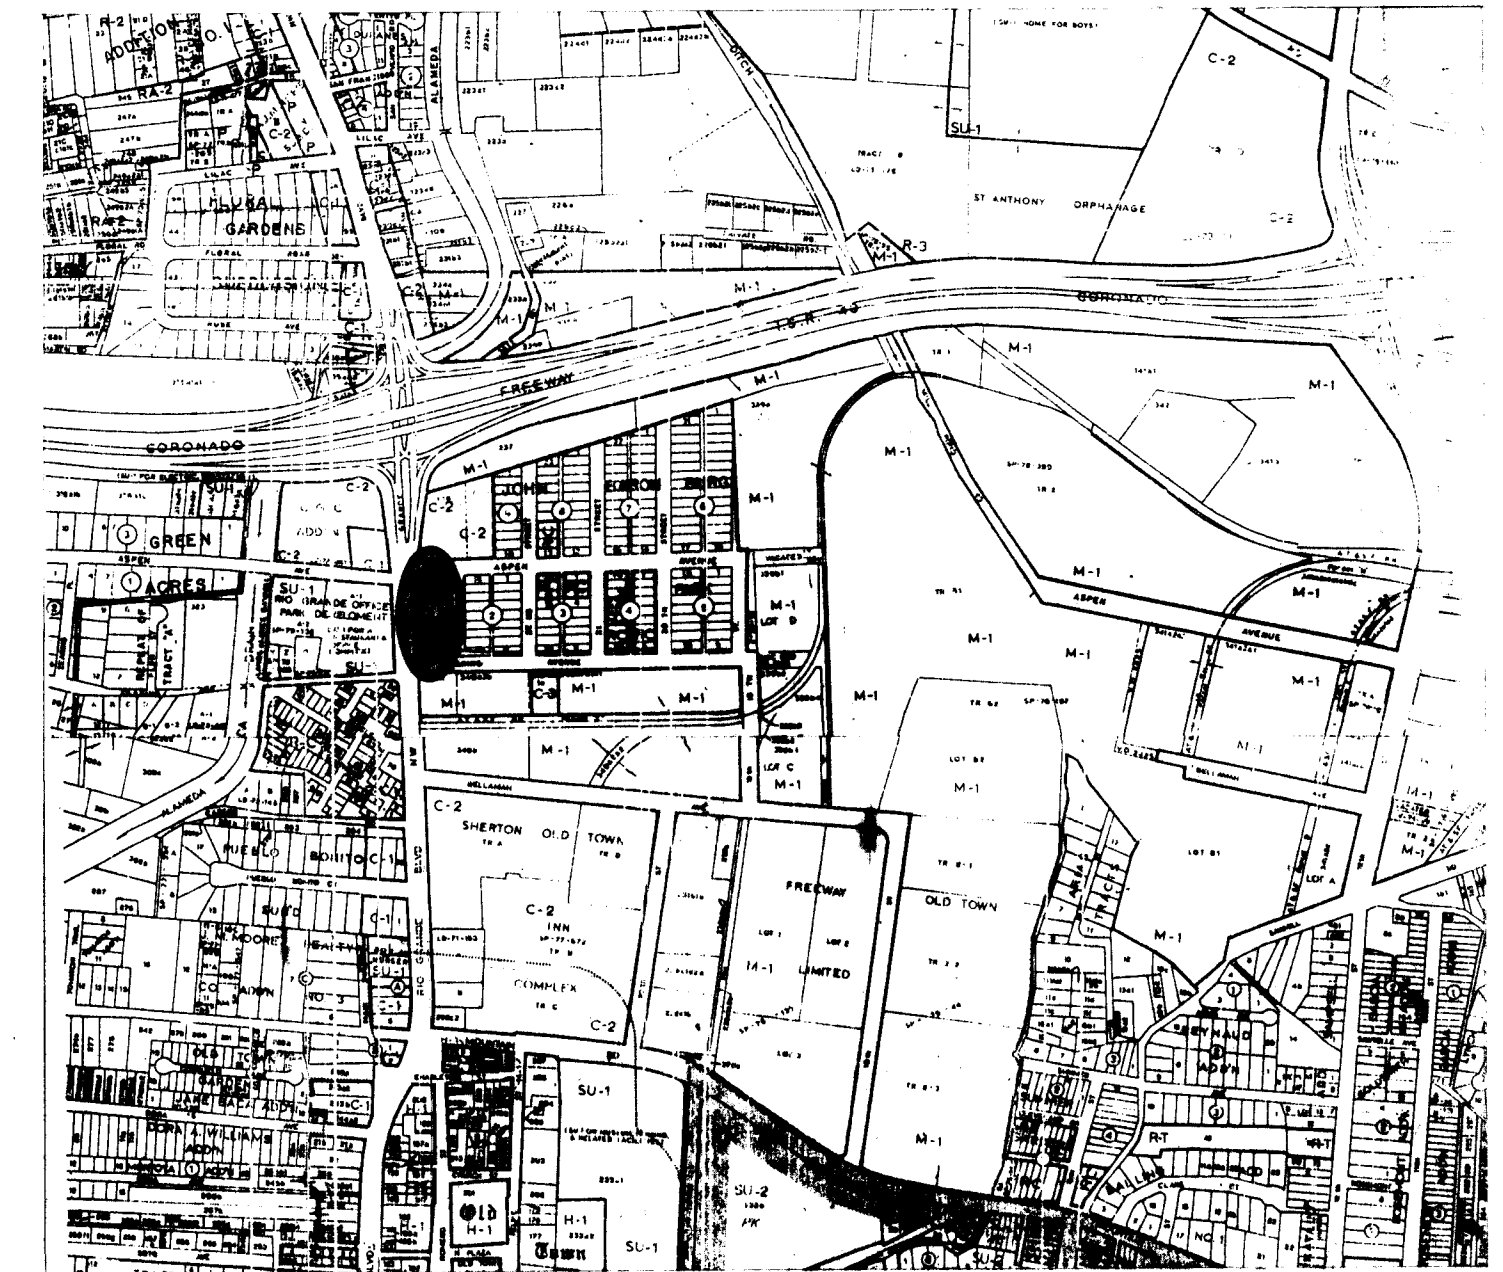

VICINITY MAP (H-13)

GENERAL NOTES:

1. New Mexico Standard Specifications for Public Works Construction-1970 Edition, will be referred to hereon as the "Standard Specifications".
2. All work detailed on these plans to be performed under contract shall, except as otherwise stated or provided for hereon, be constructed in accordance with "Contract Documents for PUBLIC WORKS CONTRACT NO. 85-1" Standard Specifications".
3. All utilities and utility lines shall be installed prior to paving.
4. Stations shown are centerline stations. Profile grades are top of curb. Distances shown are applicable to curb lot centerline.
5. If curb is depressed for a drivepad, the drivepad shall be constructed prior to acceptance of the curb and gutter.
6. Two working days prior to any excavation, contractor must contact Line Locating Service, 765-1234, for location of existing lines.
7. Prior to construction, the contractor shall excavate and verify the horizontal and vertical locations of all obstructions. Should a conflict exist, the contractor shall notify the engineer or surveyor so that the conflict can be resolved with a minimum amount of delay.
8. Sidewalks and wheelchair ramps within the curb returns shall be constructed wherever a new curb return is constructed.
9. This project shall be done in conjunction with project 1381.

INDEX

COVER SHEET	1
PLAT	2
PLAN & PROFILE SHEET	3

APPROVAL
W. J. McPherson
4/21/85

1	2	3	4	5	6	7	8	9	10	11	12
2	6	2	0	7	4	0	1	8	5		

REV.	SHEETS	CITY ENGINEER	DATE	USER	DEPT.	DATE	USER	DEPT.	DATE
APPROVAL OF REVISIONS									



DMJM /
ADAM, HAMLYN, ANDERSON
Consulting Engineers Inc.
4066 MONTGOMERY BOULEVARD, N.E.
ALBUQUERQUE, NEW MEXICO 87109
808-261-1888

APPROVED FOR
CONSTRUCTION


C.E.

2074

SHEET 1 OF 3

2105

4505

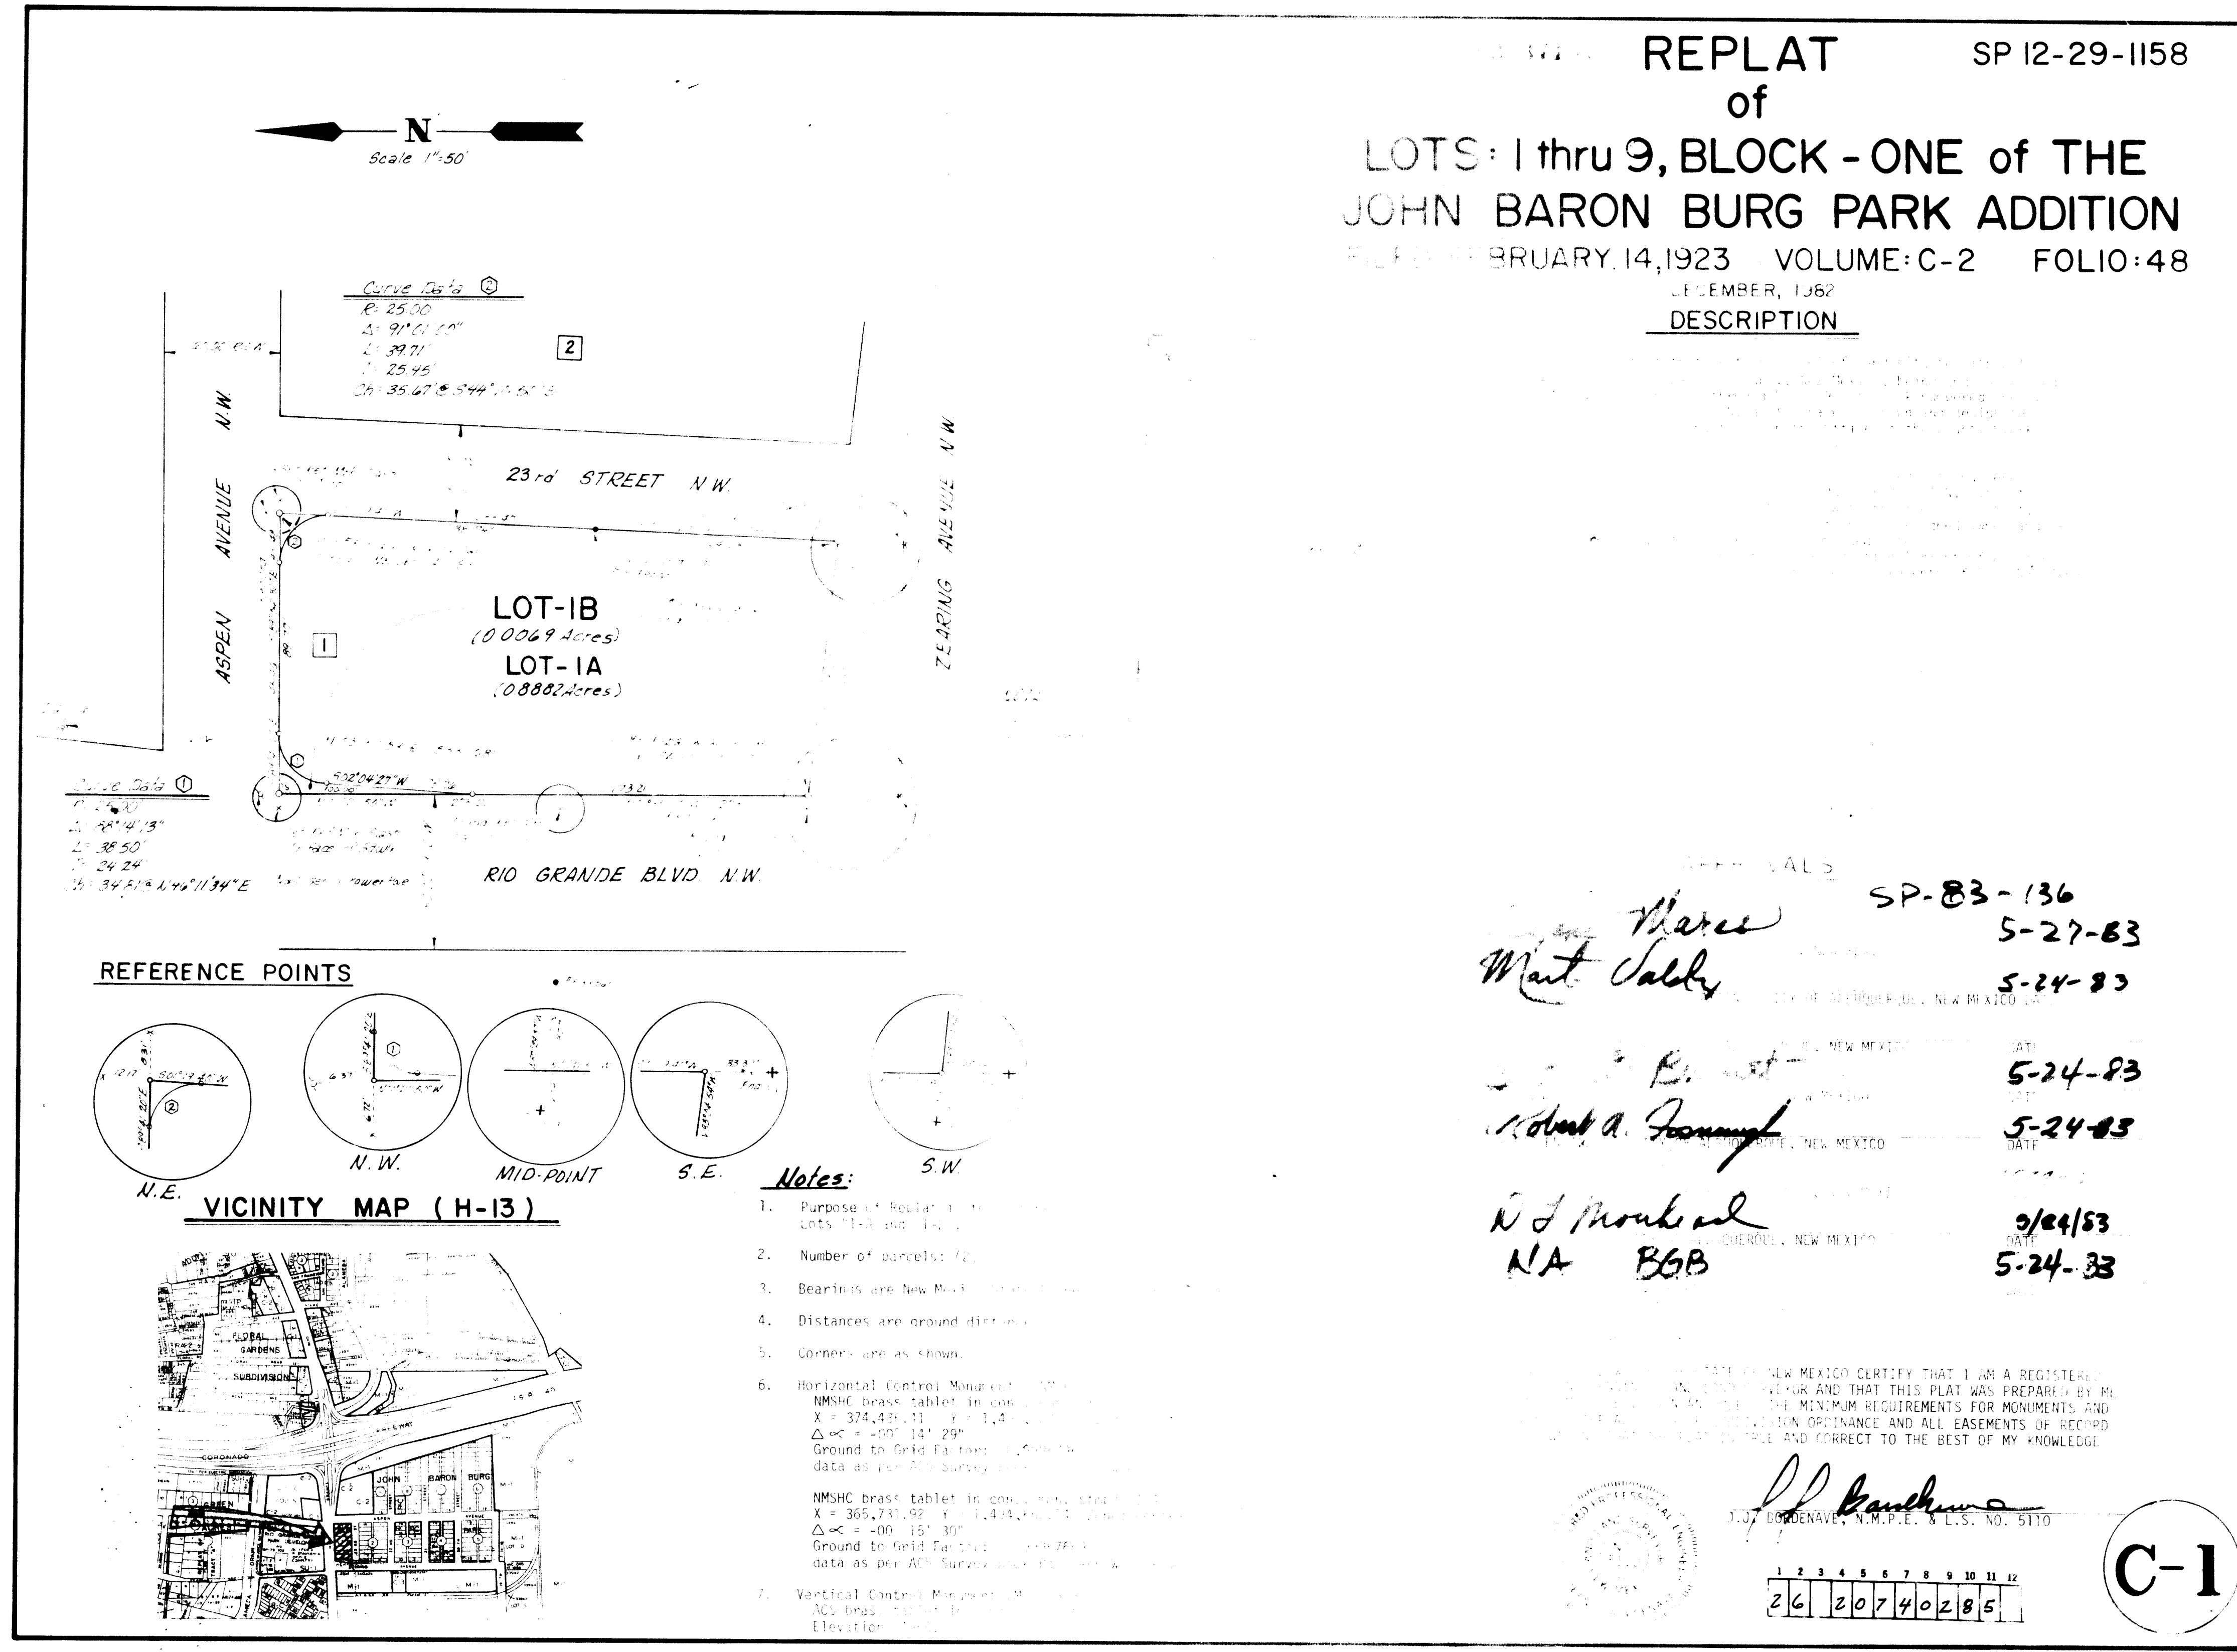


LASON 1-505-344-9404
BEST COPY AVAILABLE

Engineers File to 47-6

4505


Curb Return Data Δ
 $\Delta = 88^\circ 14' 13''$
 $R = 30.00'$
 $L = 46.20'$
 $T = 29.59'$
 $Ch = 41.77'$

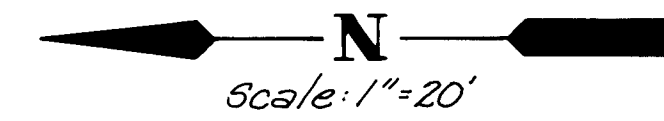

T.C. Δ
1/2 60.03 59.96
1/4 59.96 59.29
3/4 - 59.96

NOTE:
Traffic Engineering To Provide
Barricading Until Power Pole
Relocated.

New Valley Gutter

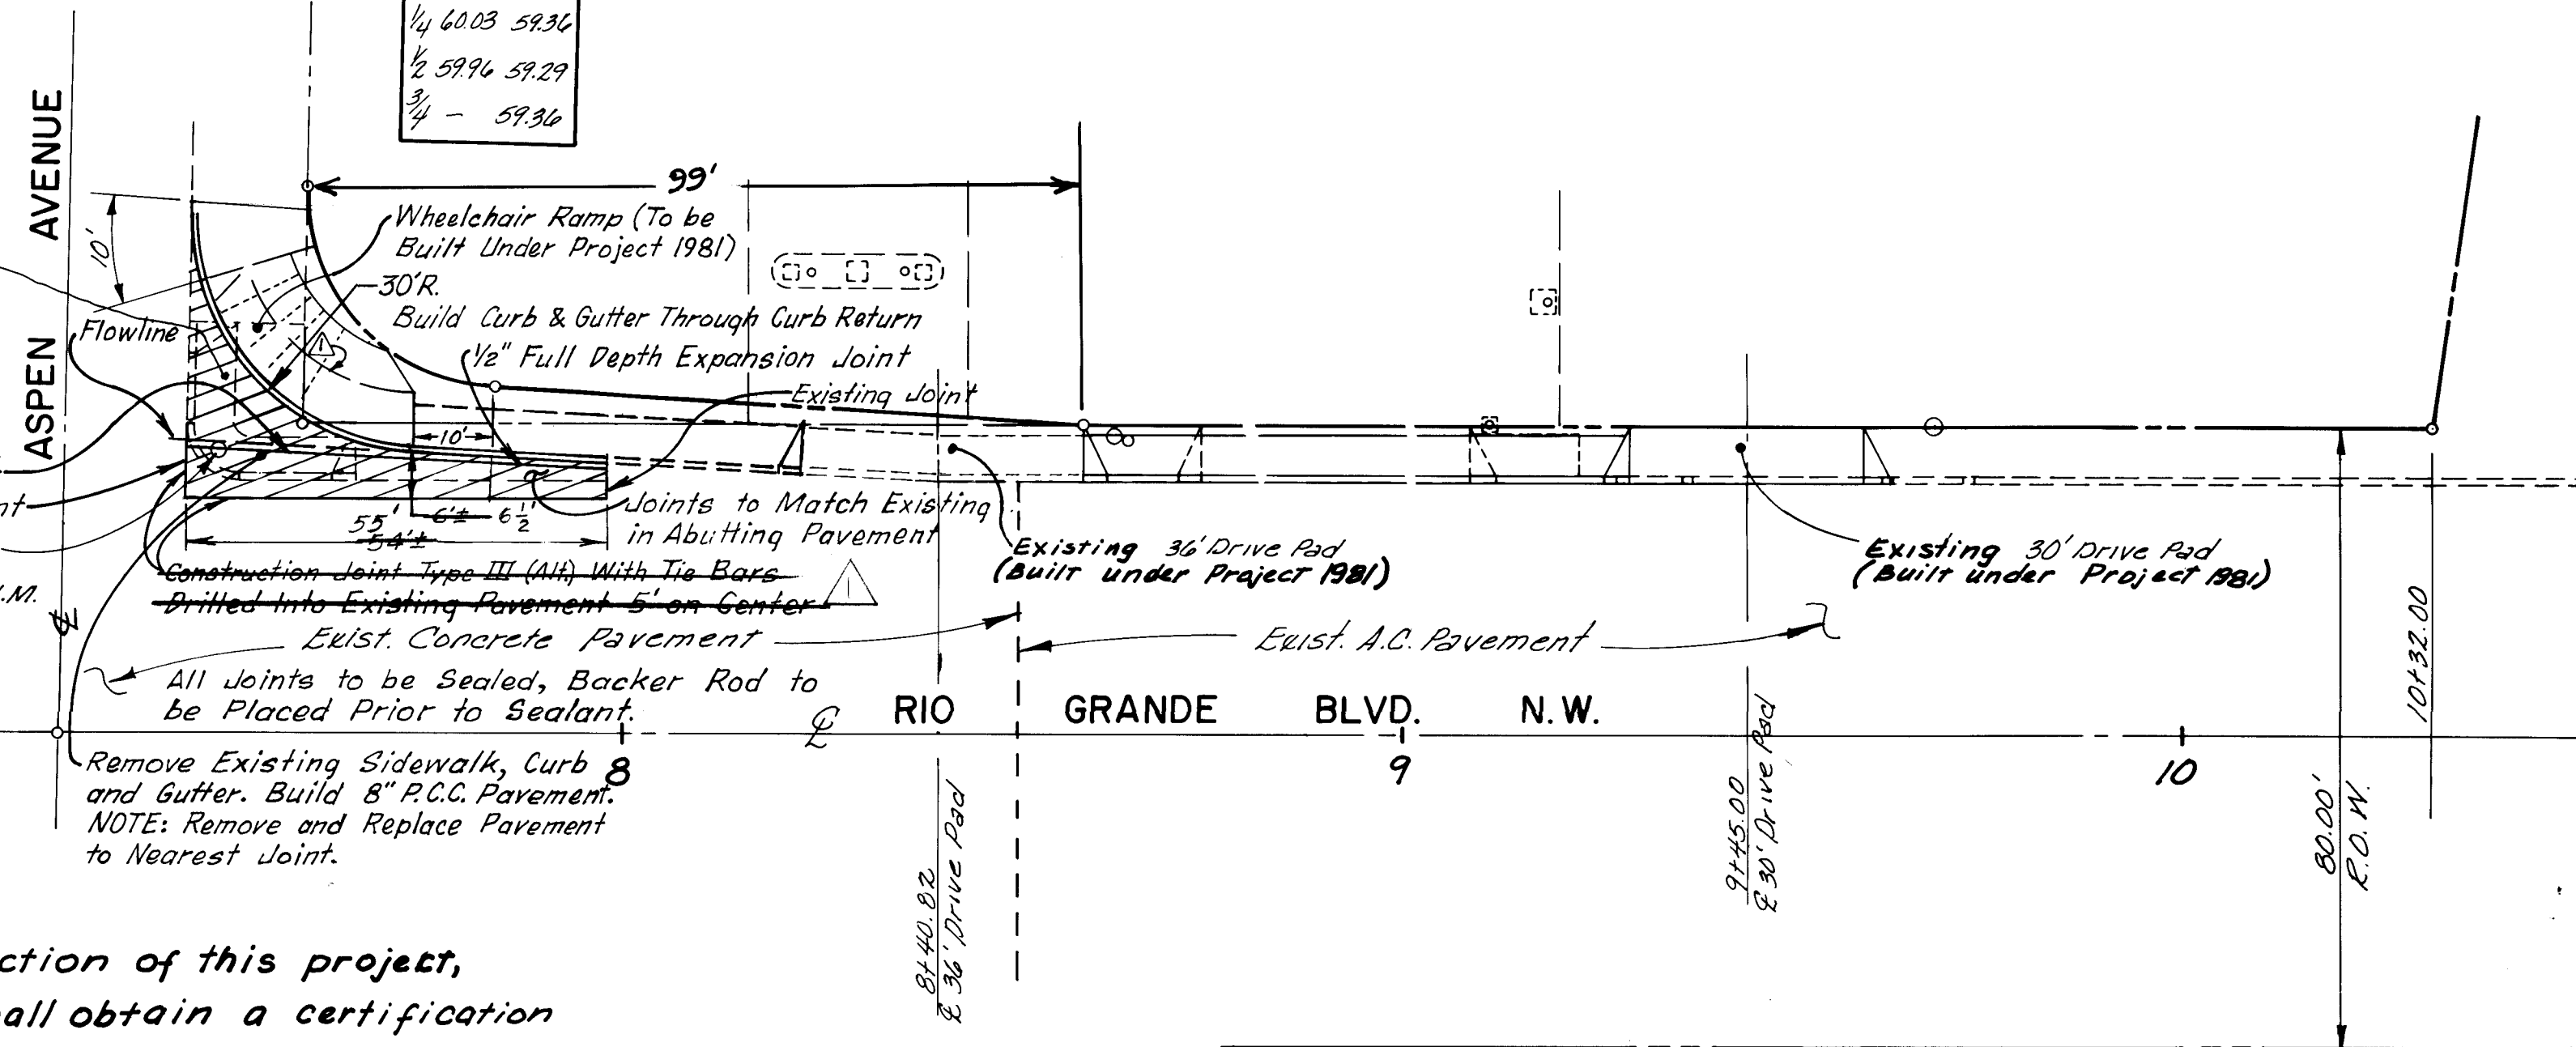


Important!

Prior to construction of this project,
the Contractor shall obtain a certification
from the City Engineer that the curb and
gutter, wheelchair ramp, and drivepads are
acceptable as built under Project 1981.

ASPEN AVENUE

RIO GRANDE BLVD.

SCALE 1"=20'

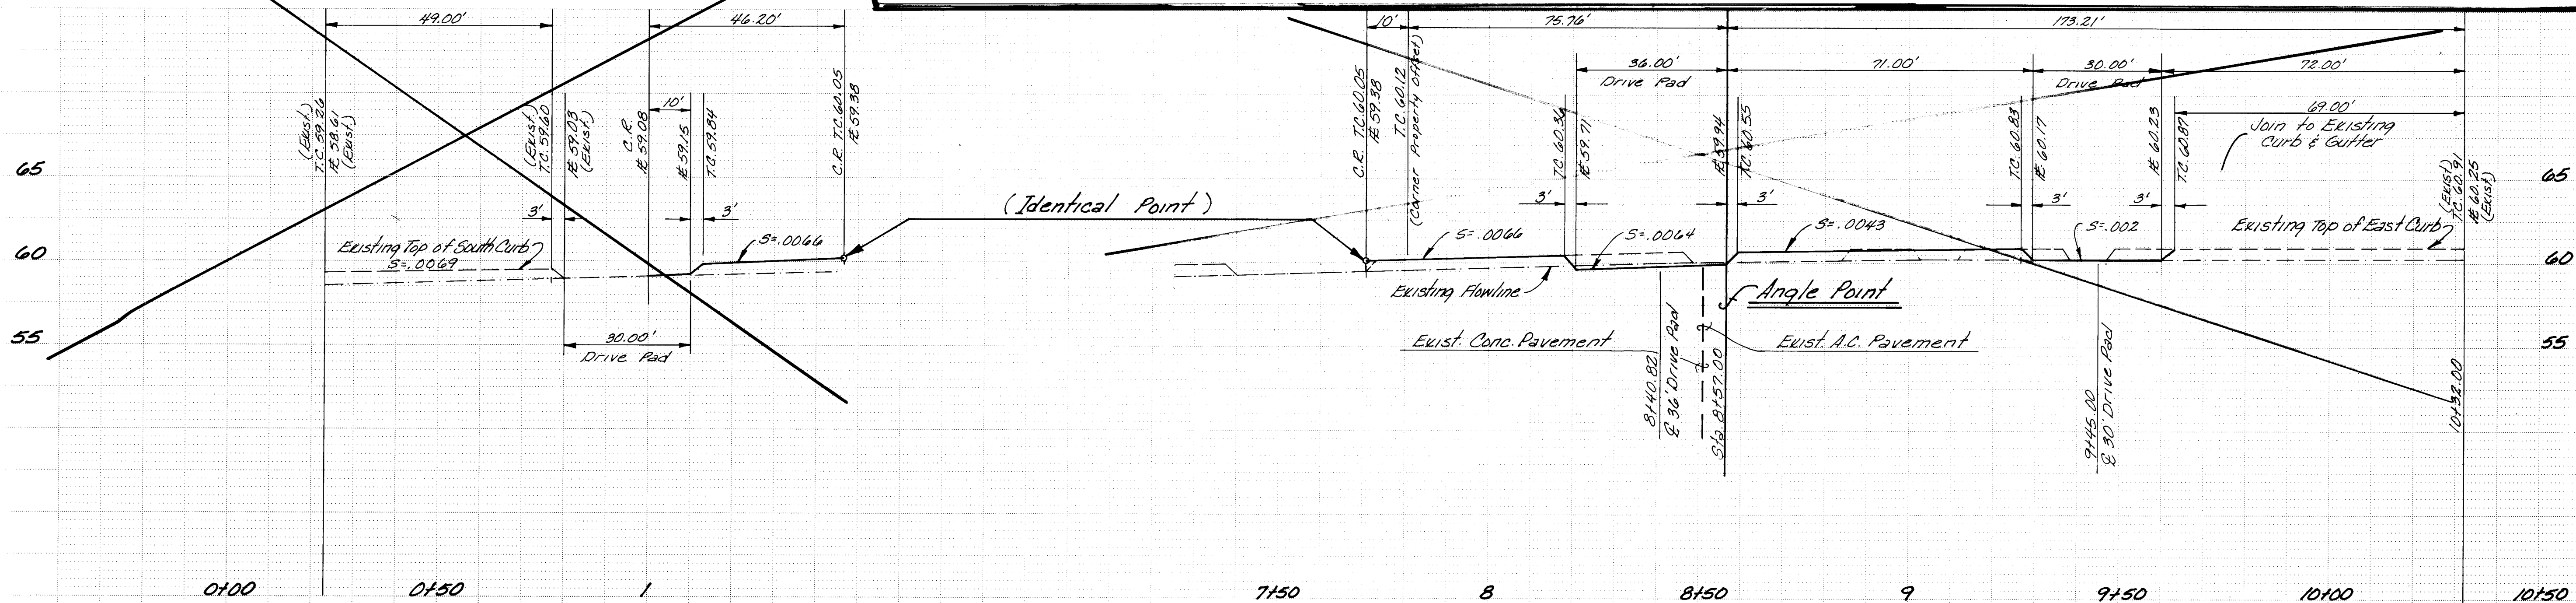

PLANS PREPARED UNDER THE DIRECTION OF		CITY OF ALBUQUERQUE PUBLIC WORKS DEPARTMENT ENGINEERING DIVISION	
APPROVED FOR CONSTRUCTION		TITLE: 924 RIO GRANDE BLVD. PAVEMENT RECONSTRUCTION	
CITY ENGINEER		DATE	
APPROVALS		APPROVALS	
ENGINEER		ENGINEER	
DATE		DATE	
APPROVED BY		APPROVED BY	
DATE		DATE	
DRAWING NO. 2074		SHEET 3 OF 3	