


NORTH PINO ARROYO CHANNEL

AT

HERITAGE HILLS PARK

DRAWING INDEX


TITLE	SHEET NO.
COVER SHEET	1
DRAINAGE PLAN	2
SITE PLAN	3(W)–4(E)
CHANNEL PLAN & PROFILE STA. 10+02 TO STA. 13+20	5
CHANNEL PLAN & PROFILE STA. 13+20 TO STA. 18+20	6
CHANNEL PLAN & PROFILE STA. 18+20 TO STA. 23+00	7
CHANNEL PLAN & PROFILE STA. 23+00 TO STA. 27+80	8
CHANNEL PLAN & PROFILE STA. 27+80 TO STA. 32+60	9
CHANNEL PLAN & PROFILE STA. 32+60 TO END	10
DETAILS	11–12
VENTURA STEET STORM DRAIN – PLAN & PROFILE	13
EXPANSION JOINT AND STORM DRAIN DETAILS	14
TRAFFIC CONTROL PLAN	15
CROSS SECTIONS	16

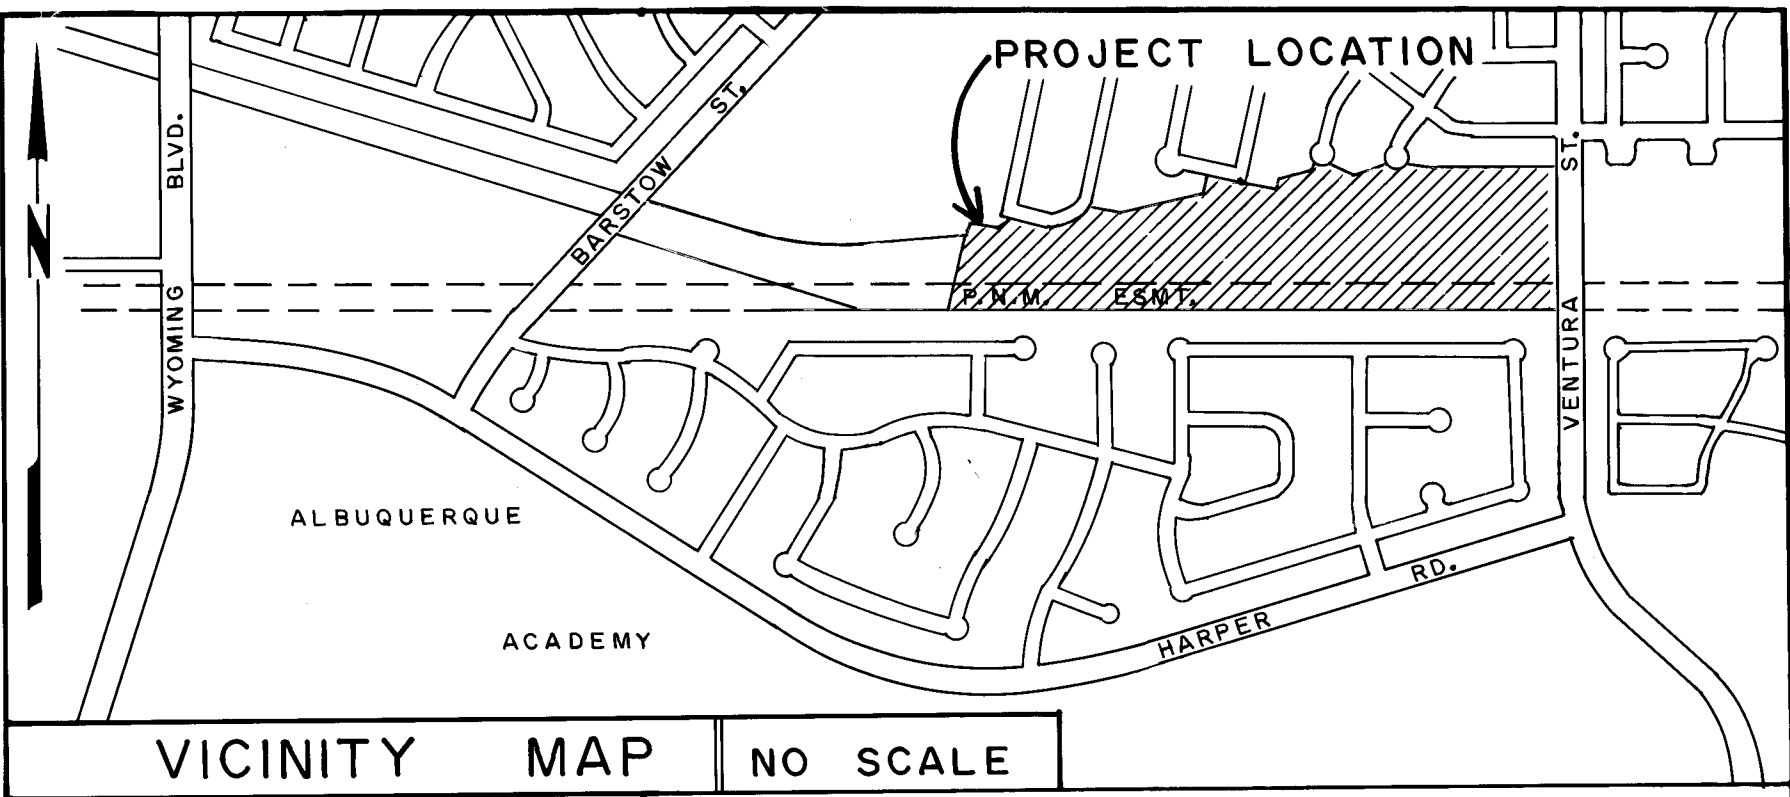

GENERAL NOTES

1. ALL WORK DETAILED ON THESE PLANS TO BE PERFORMED UNDER CONTRACT SHALL, EXCEPT AS OTHERWISE STATED OR PROVIDED FOR HEREON, BE CONSTRUCTED IN ACCORDANCE WITH CITY OF ALBUQUERQUE INTERIM STANDARD SPECIFICATIONS PUBLIC WORKS CONSTRUCTION 1985.
2. TWO (2) WORKING DAYS PRIOR TO ANY EXCAVATION, CONTRACTOR MUST CONTACT LINE LOCATING SERVICE, 765-1234, FOR LOCATION OF EXISTING UTILITIES.
3. PRIOR TO CONSTRUCTION, THE CONTRACTOR SHALL EXCAVATE AND VERIFY THE HORIZONTAL AND VERTICAL LOCATIONS OF ALL OBSTRUCTIONS. SHOULD A CONFLICT EXIST, THE CONTRACTOR SHALL NOTIFY THE ENGINEER OR SURVEYOR SO THAT THE CONFLICT CAN BE RESOLVED WITH MINIMUM AMOUNT OF DELAY.
4. PRIOR TO CONSTRUCTION, THE CONTRACTOR SHALL FIELD VERIFY ALL DIMENSIONS AND EXISTING CONDITIONS AND NOTIFY THE ENGINEER OF ANY DISCREPANCIES OR INCONSISTENCIES.


Eladio V. R.
5/15/86

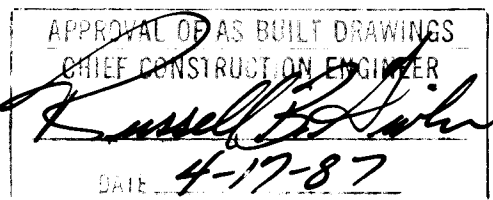

1	2	3	4	5	6	7	8	9	10	11	12
2	6	2	0	7	9	0	1	8	7		

REV.	SHEETS	CITY ENGR.	DATE	DATE	DATE
APPROVAL OF REVISIONS					

	PREPARED BY: RESOURCE TECHNOLOGY INCORPORATED	APPROVED FOR CONSTRUCTION <i>C. H. [Signature]</i> C.E.
	PROJECT NO. 2079	SHEET 1 OF 16


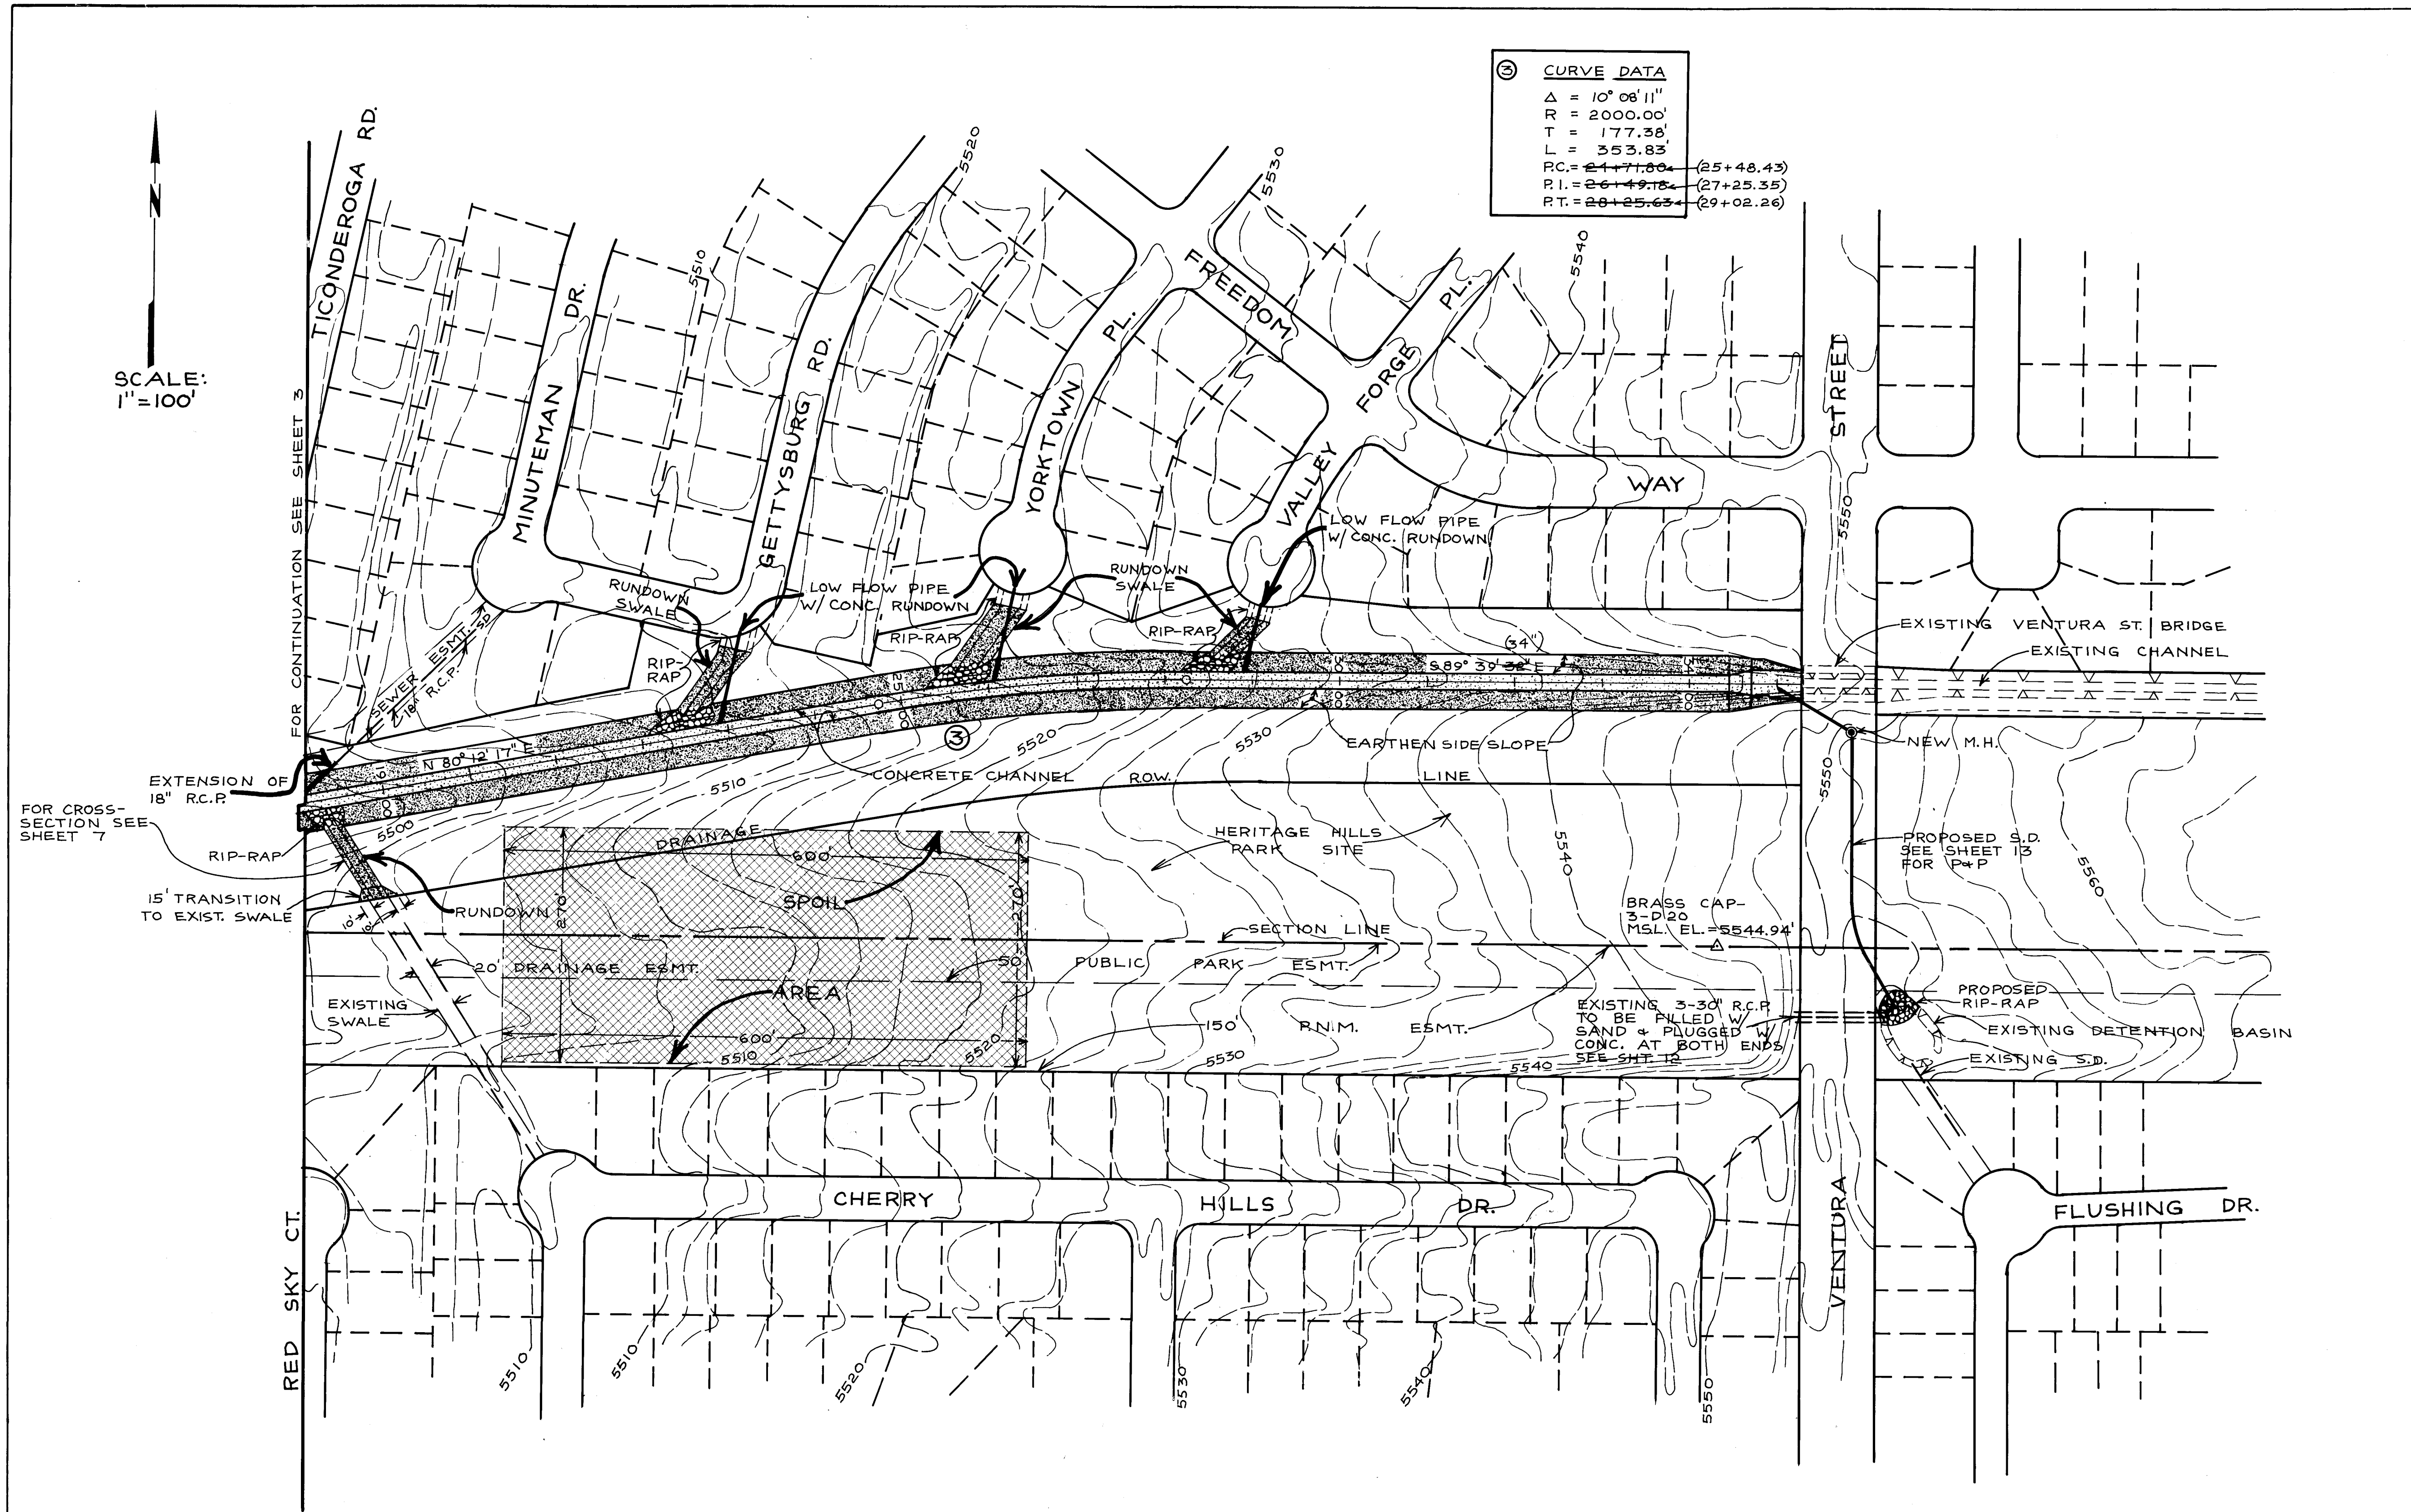


CITY OF ALBUQUERQUE
MUNICIPAL DEVELOPMENT DEPARTMENT
ENGINEERING DIVISION

TITLE:
SITE PLAN (EAST)

APPROVALS	ENGINEER	DATE	APPROVALS	ENGINEER	DATE
City Engineer	E. J. W. Jr.	8/21/85	Liquid Waste	R. J. H.	8/21/85
ACE - Design	M. J. H.	8/21/85	Traffic	R. J. H.	8/21/85
ACE - Hydrology	D. A. H.	8/21/85	Water	R. J. H.	8/21/85

DRAWING NO. 2079
MAP NO. D & E 20
SHEET 4 OF 16

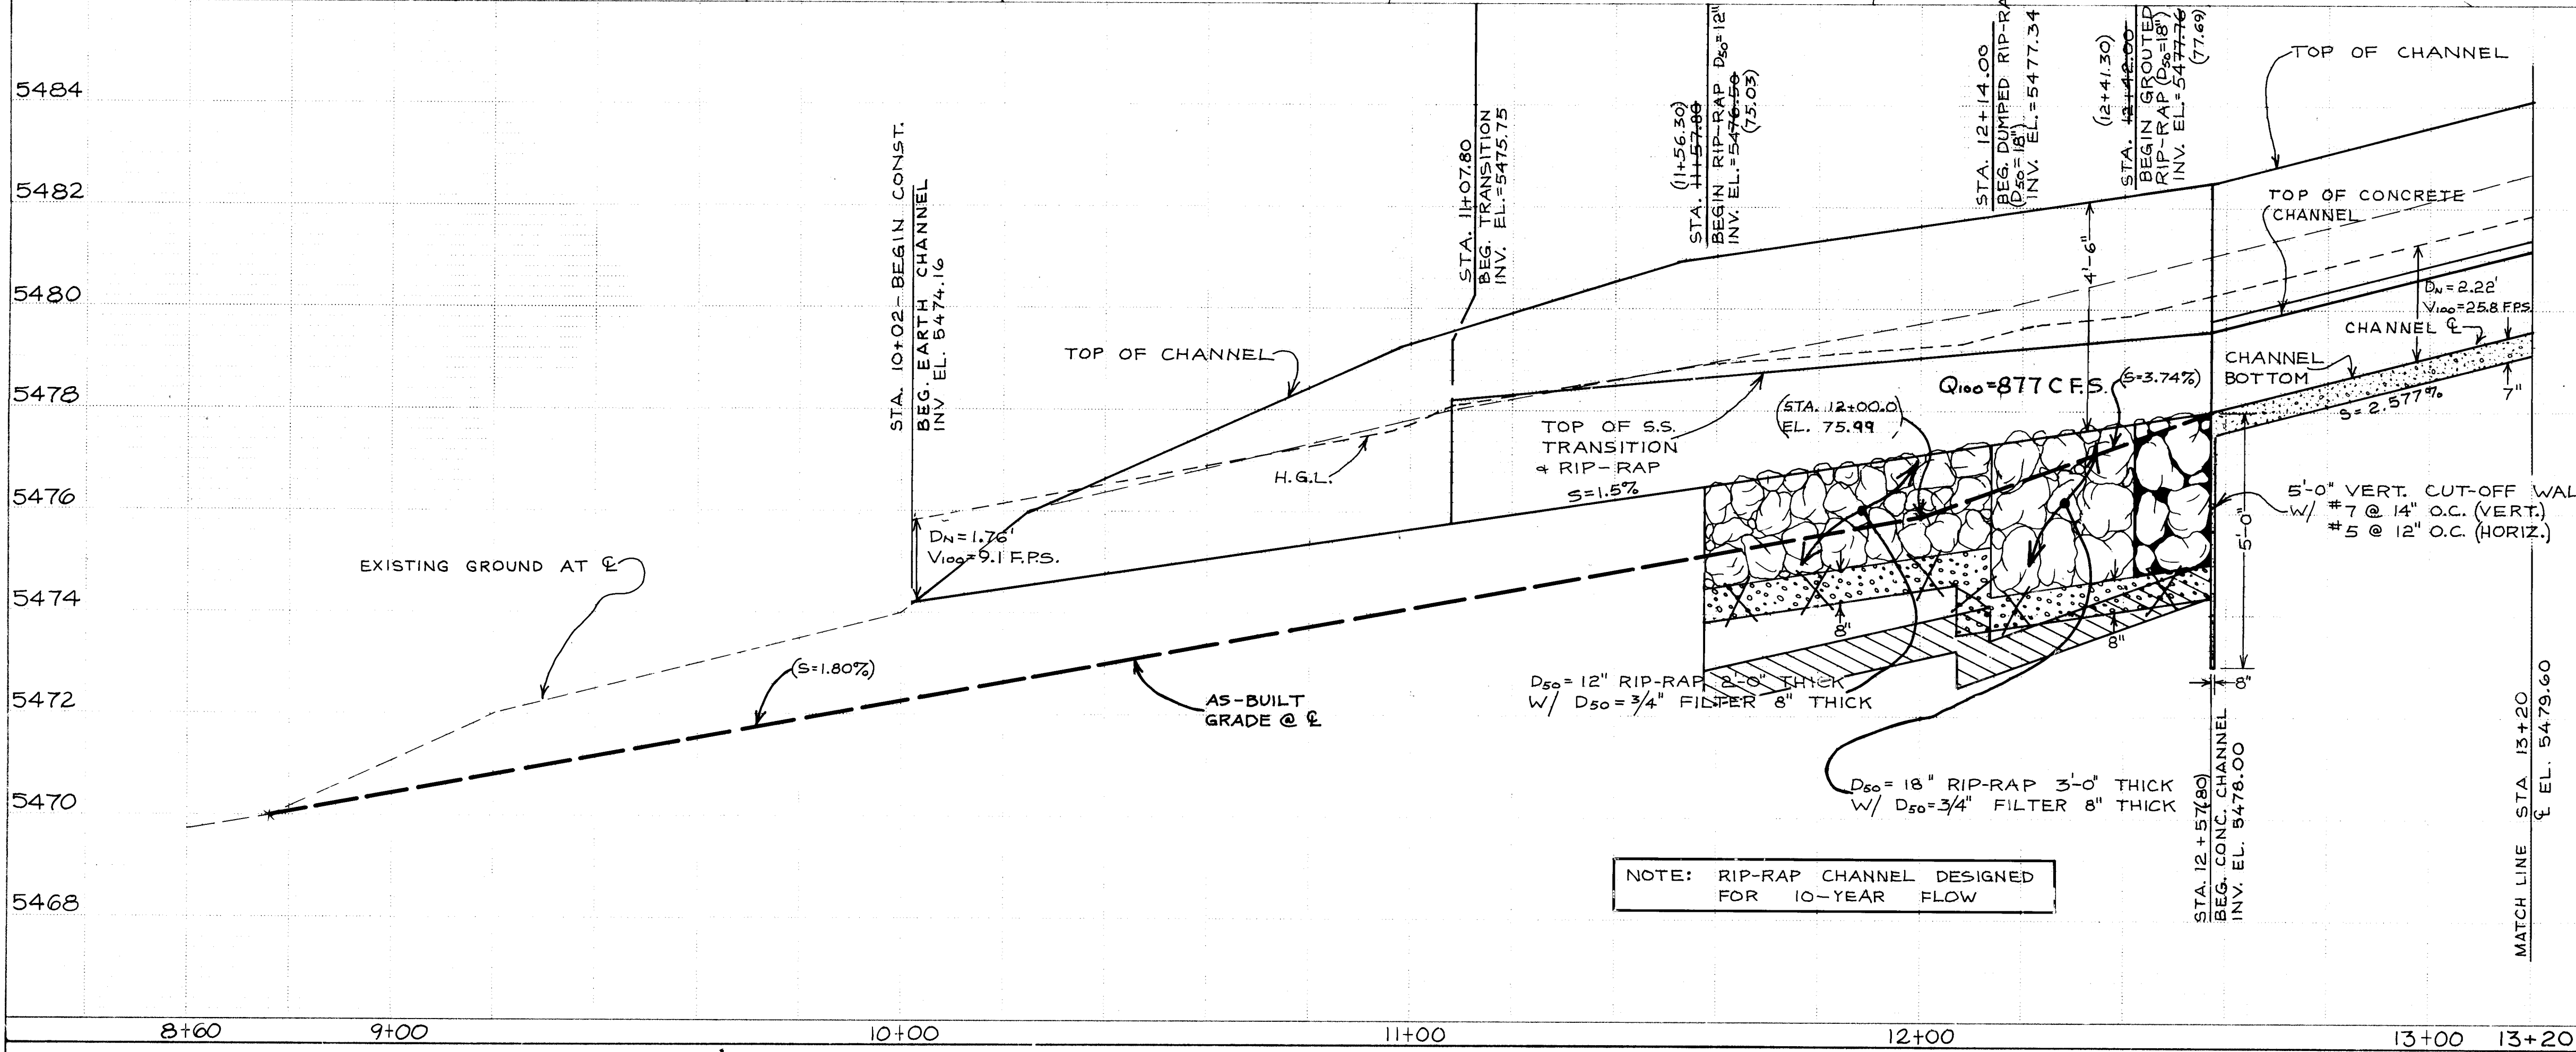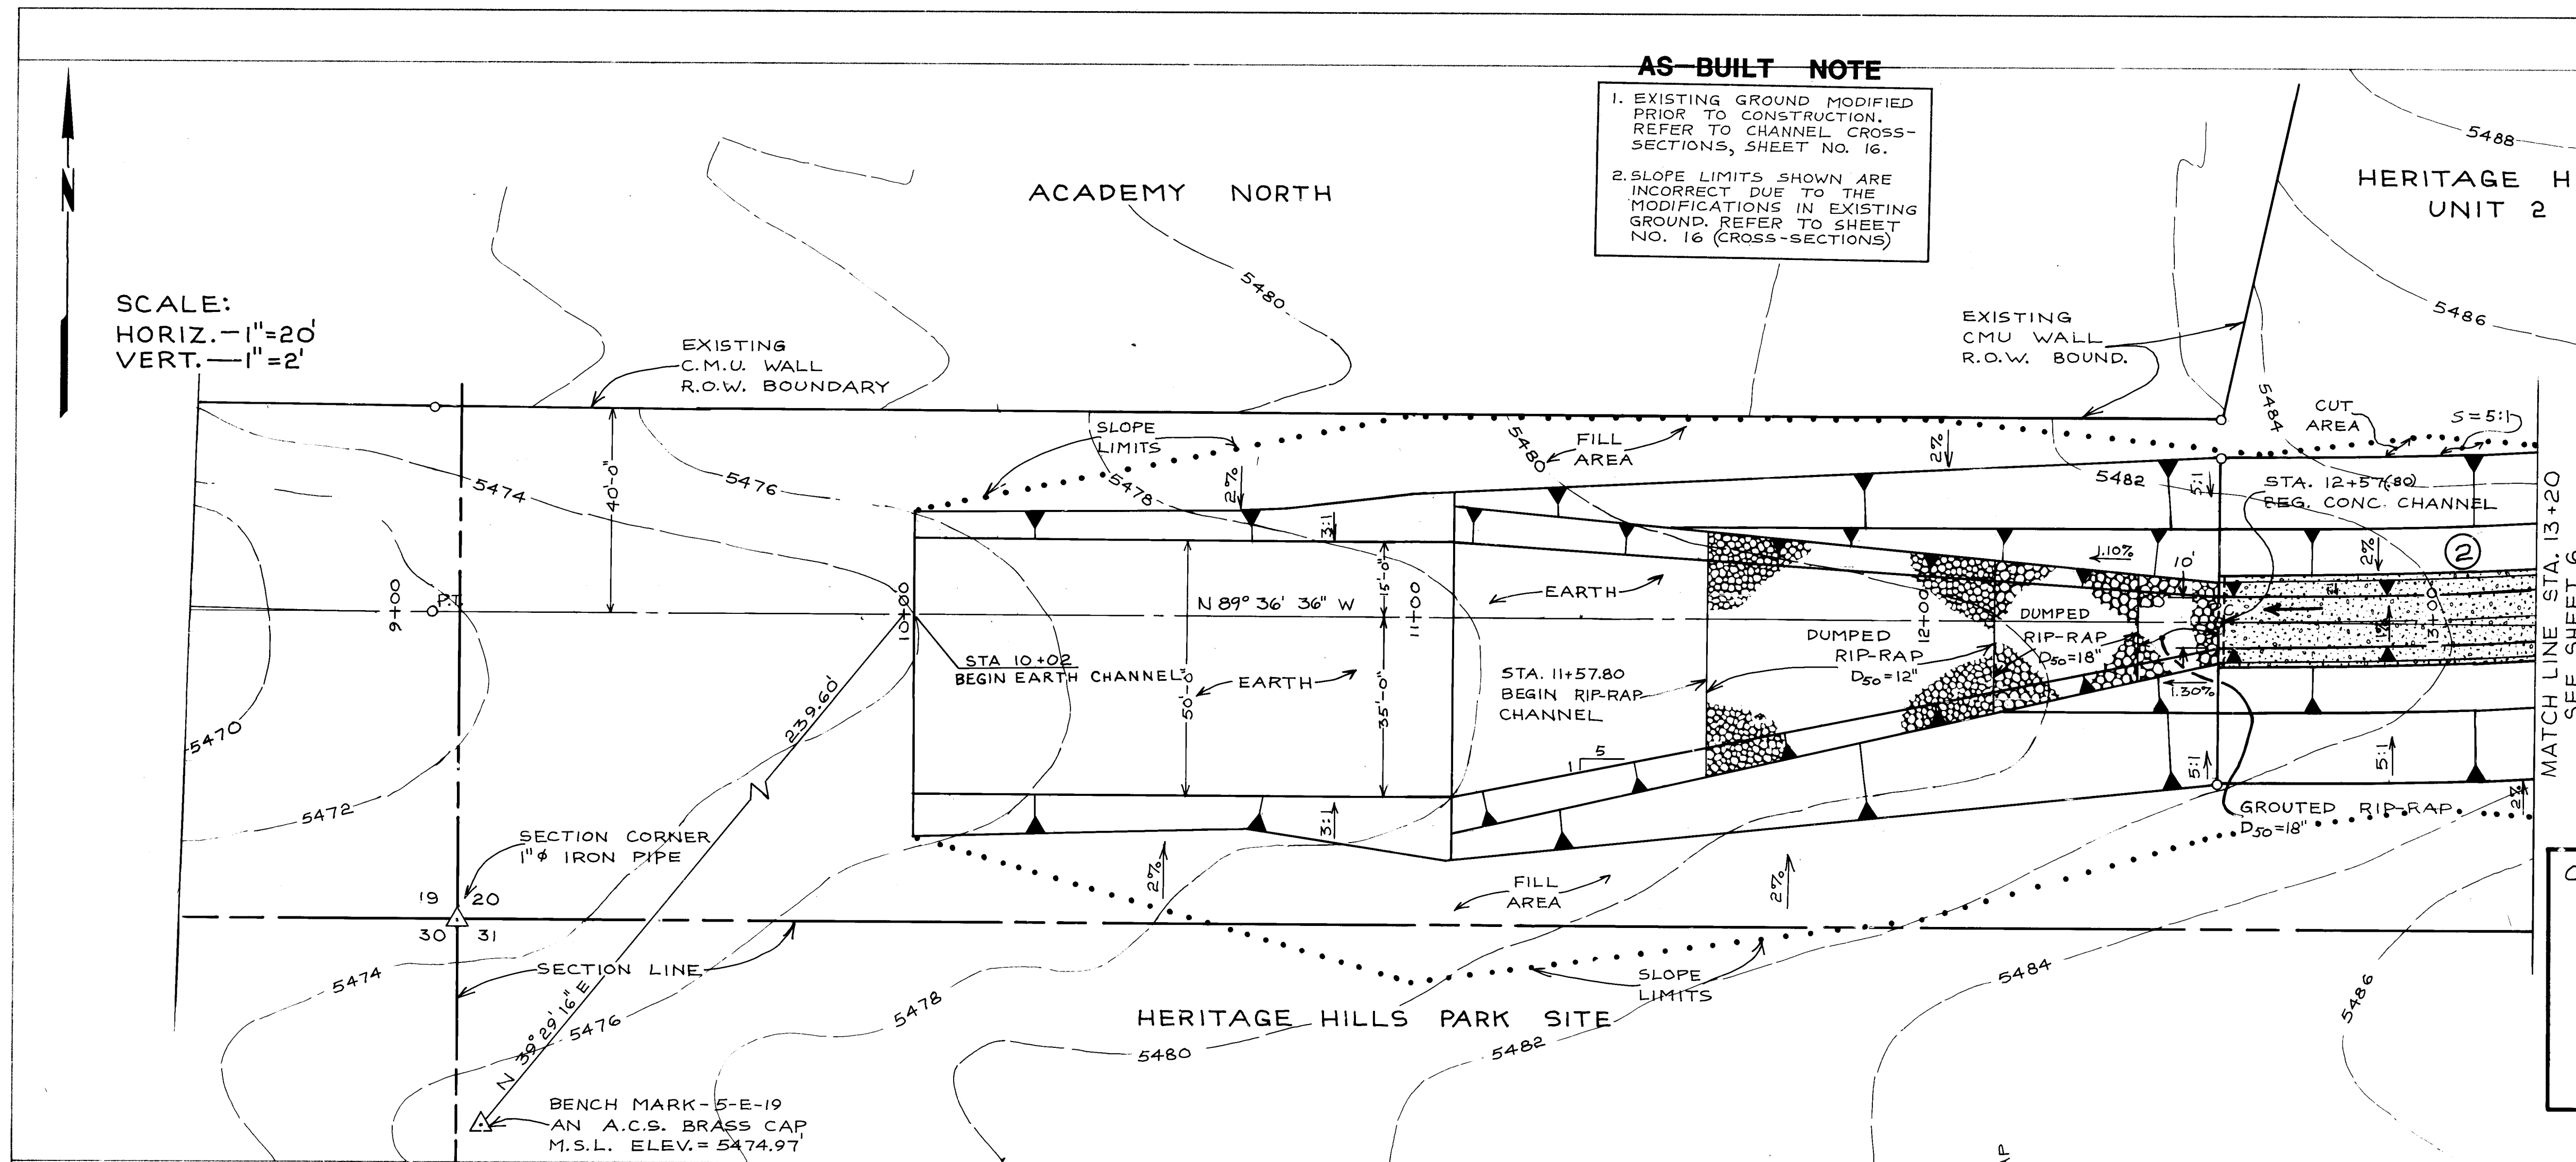

FURNISH TOOLED EDGE AT JOINT

EXTEND LONG STEEL 30" BEYOND KEY & OVERLAP 30" WITH STEEL IN NEXT POUR

SCALE: 1"=1'

TYPICAL CONSTRUCTION JOINT

AS BUILT INFORMATION

CONSTR. BY: LYNN SURVEYING

DATE: 8/21/85

RECORDED BY: J.C. LYNN

DATE: 8/21/85

FIELD CHECKED BY: J.C. LYNN

DATE: 8/21/85

APPROVED BY: J.C. LYNN

DATE: 8/21/85

ENGINEER'S SEAL

THE LIMIT OF CONSTRUCTION SHOWN ON THE PLANS IS AN APPROXIMATION TO SHOW AREAS OF ANTICIPATED PAVEMENT, CURB AND GUTTER AND/OR OTHER SURFACE REMOVAL. THE CONTRACTOR SHALL ENDEAVOR TO MINIMIZE THE ACTUAL CONSTRUCTION LIMITS BUT IN NO CASE SHALL SUCH LIMITS OF WORK RESTRICT THE CONTRACTORS WORK WHERE SAFETY WOULD BE IMPAIRED. THE CONTRACTOR IS REFERRED TO THE SPECIFICATIONS AS SUPPLEMENTED, ESPECIALLY SECTION 6 OF THE GENERAL CONDITIONS.

ALL DISTURBED CONSTRUCTION AREAS MUST BE RESEED AS PER SUP. TECH. SPEC. 915

REVISIONS

NO.	DATE	REMARKS
1		
2		
3		
4		
5		
6		
7		
8		
9		
10		
11		
12		

26 20790587

CITY OF ALBUQUERQUE
MUNICIPAL DEVELOPMENT DEPARTMENT
ENGINEERING DIVISION


TITLE: CHANNEL PLAN AND PROFILE
STA. 10+02 TO STA. 13+20


APPROVALS	ENGINEER	DATE	APPROVALS	ENGINEER	DATE
City Engineer	<i>[Signature]</i>	8/24/85	Water	<i>[Signature]</i>	8/24/85
ACE-Design	<i>[Signature]</i>	8/24/85	Traffic	<i>[Signature]</i>	8/21/85
ACE-Hydrology	<i>[Signature]</i>	8/24/85	Water	<i>[Signature]</i>	8/21/85

DRAWING NO. 2079

MAP NO. D & E 20

SHEET 5 OF 16

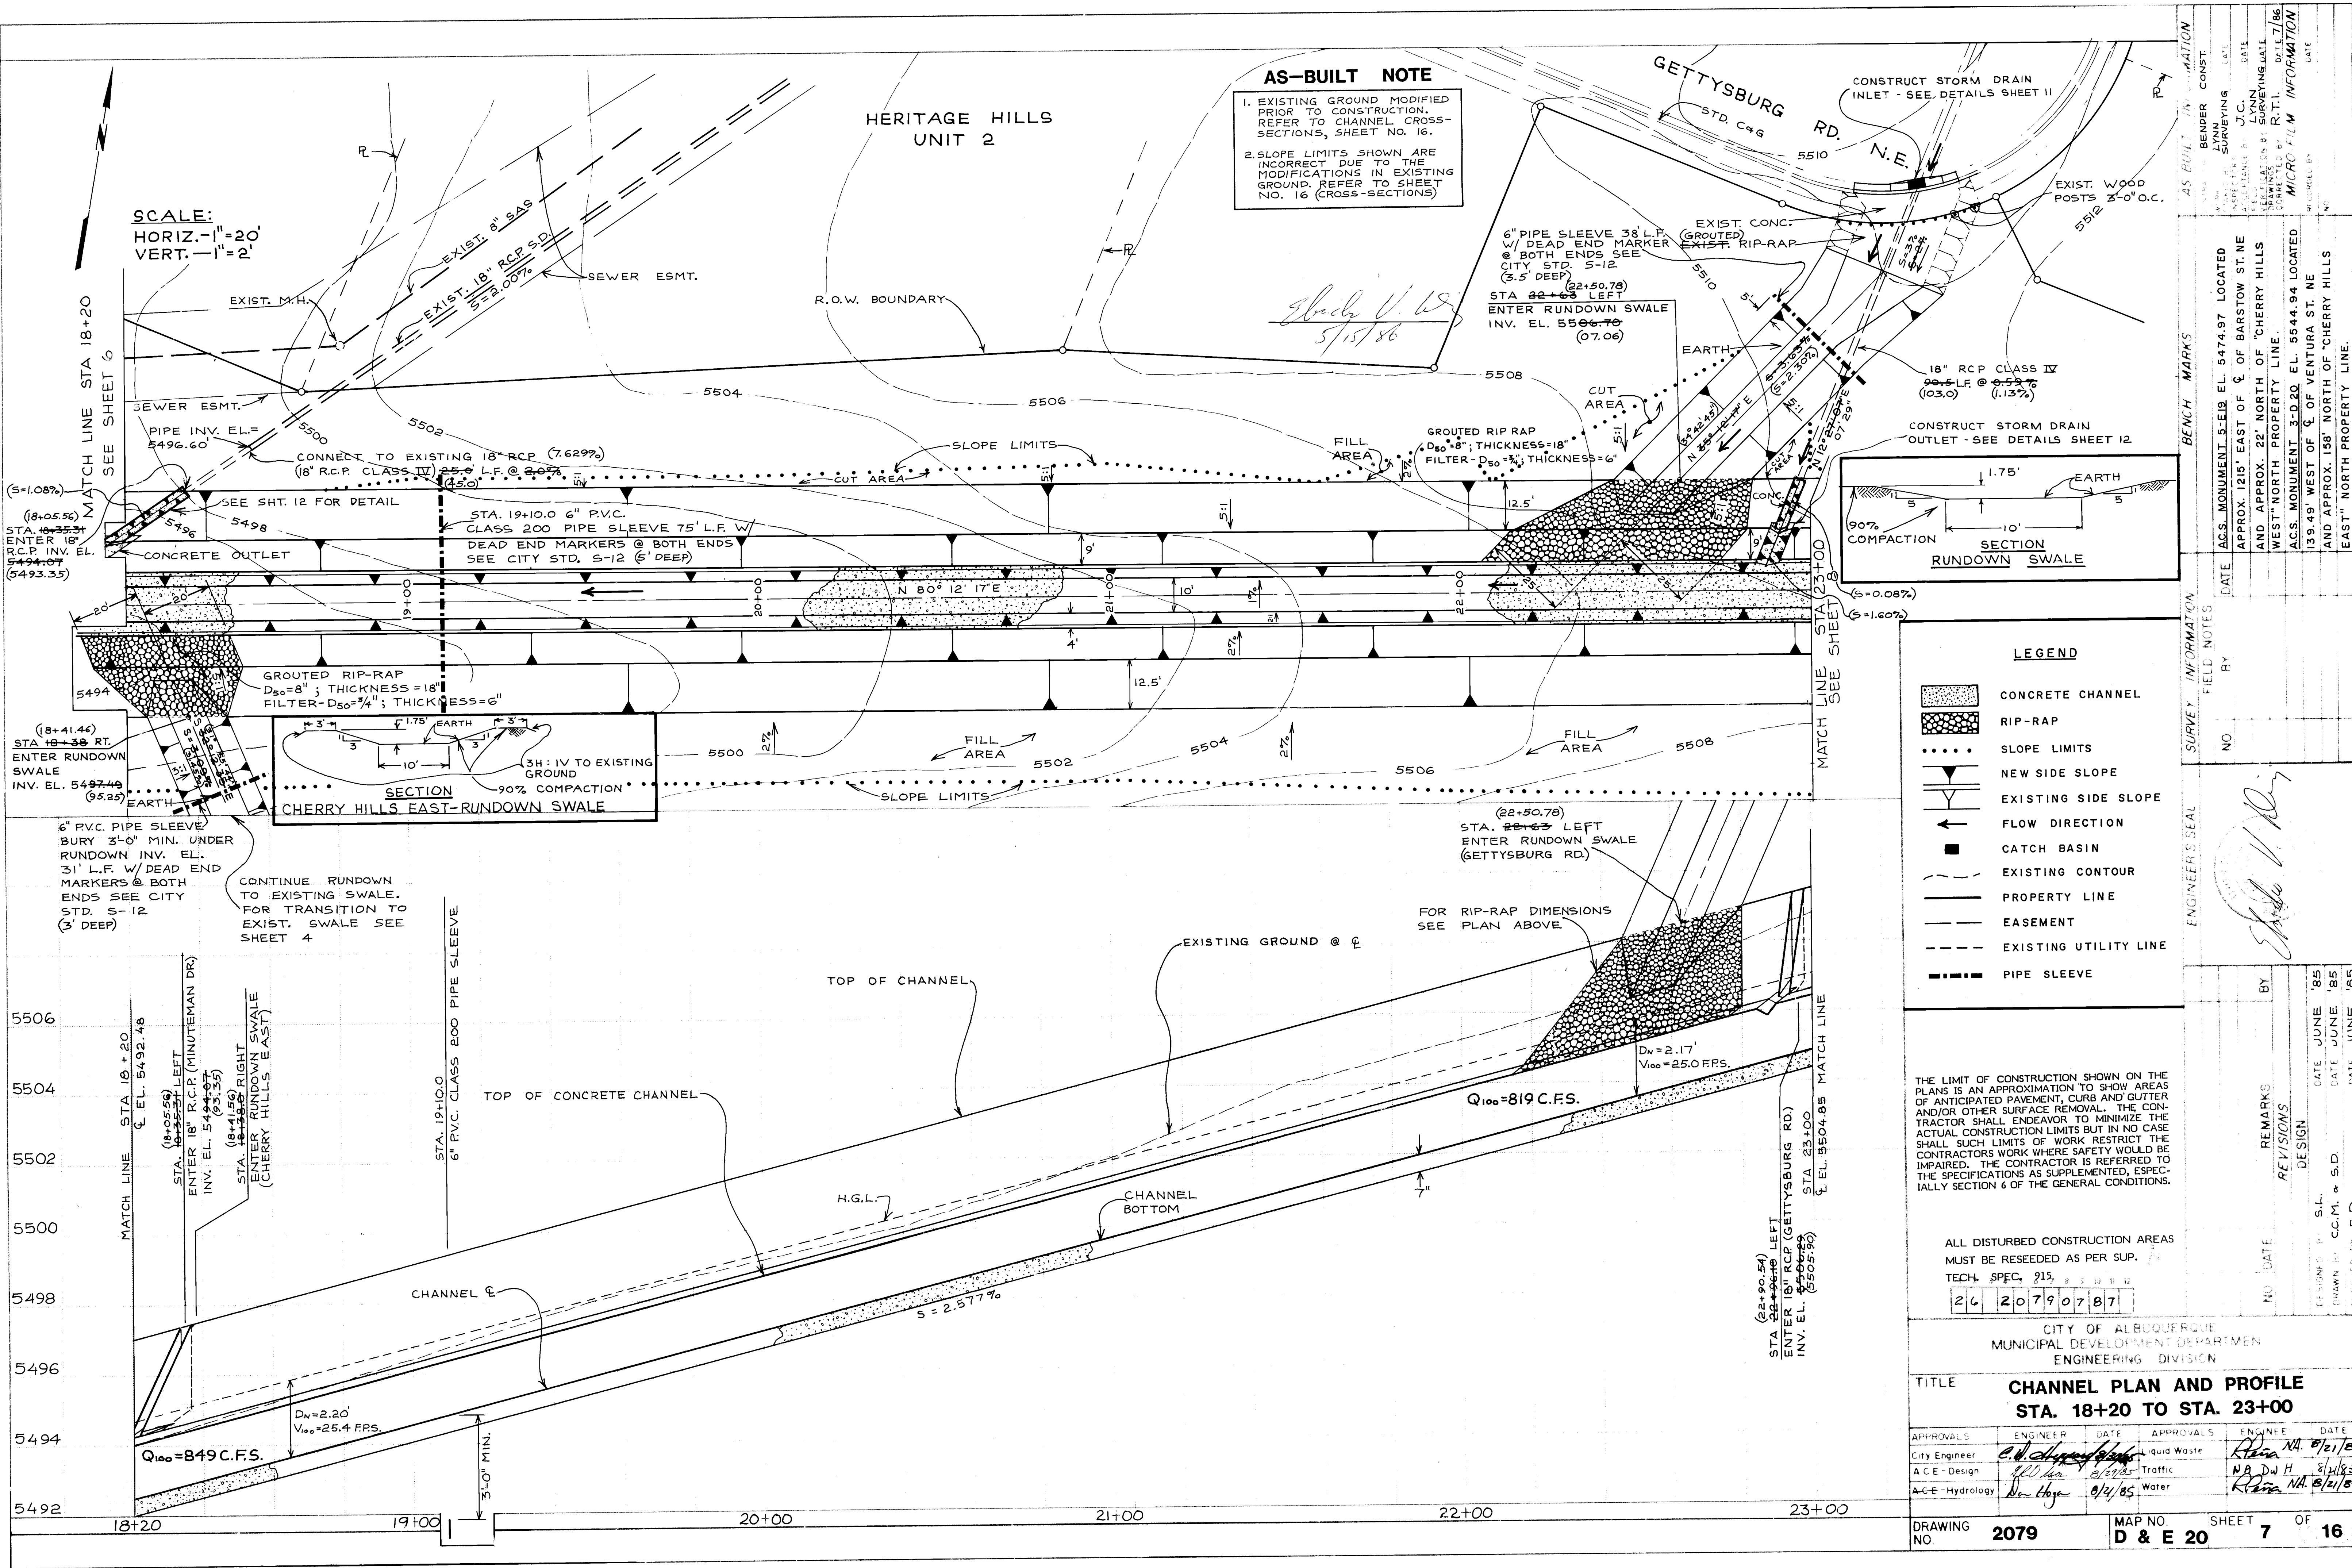

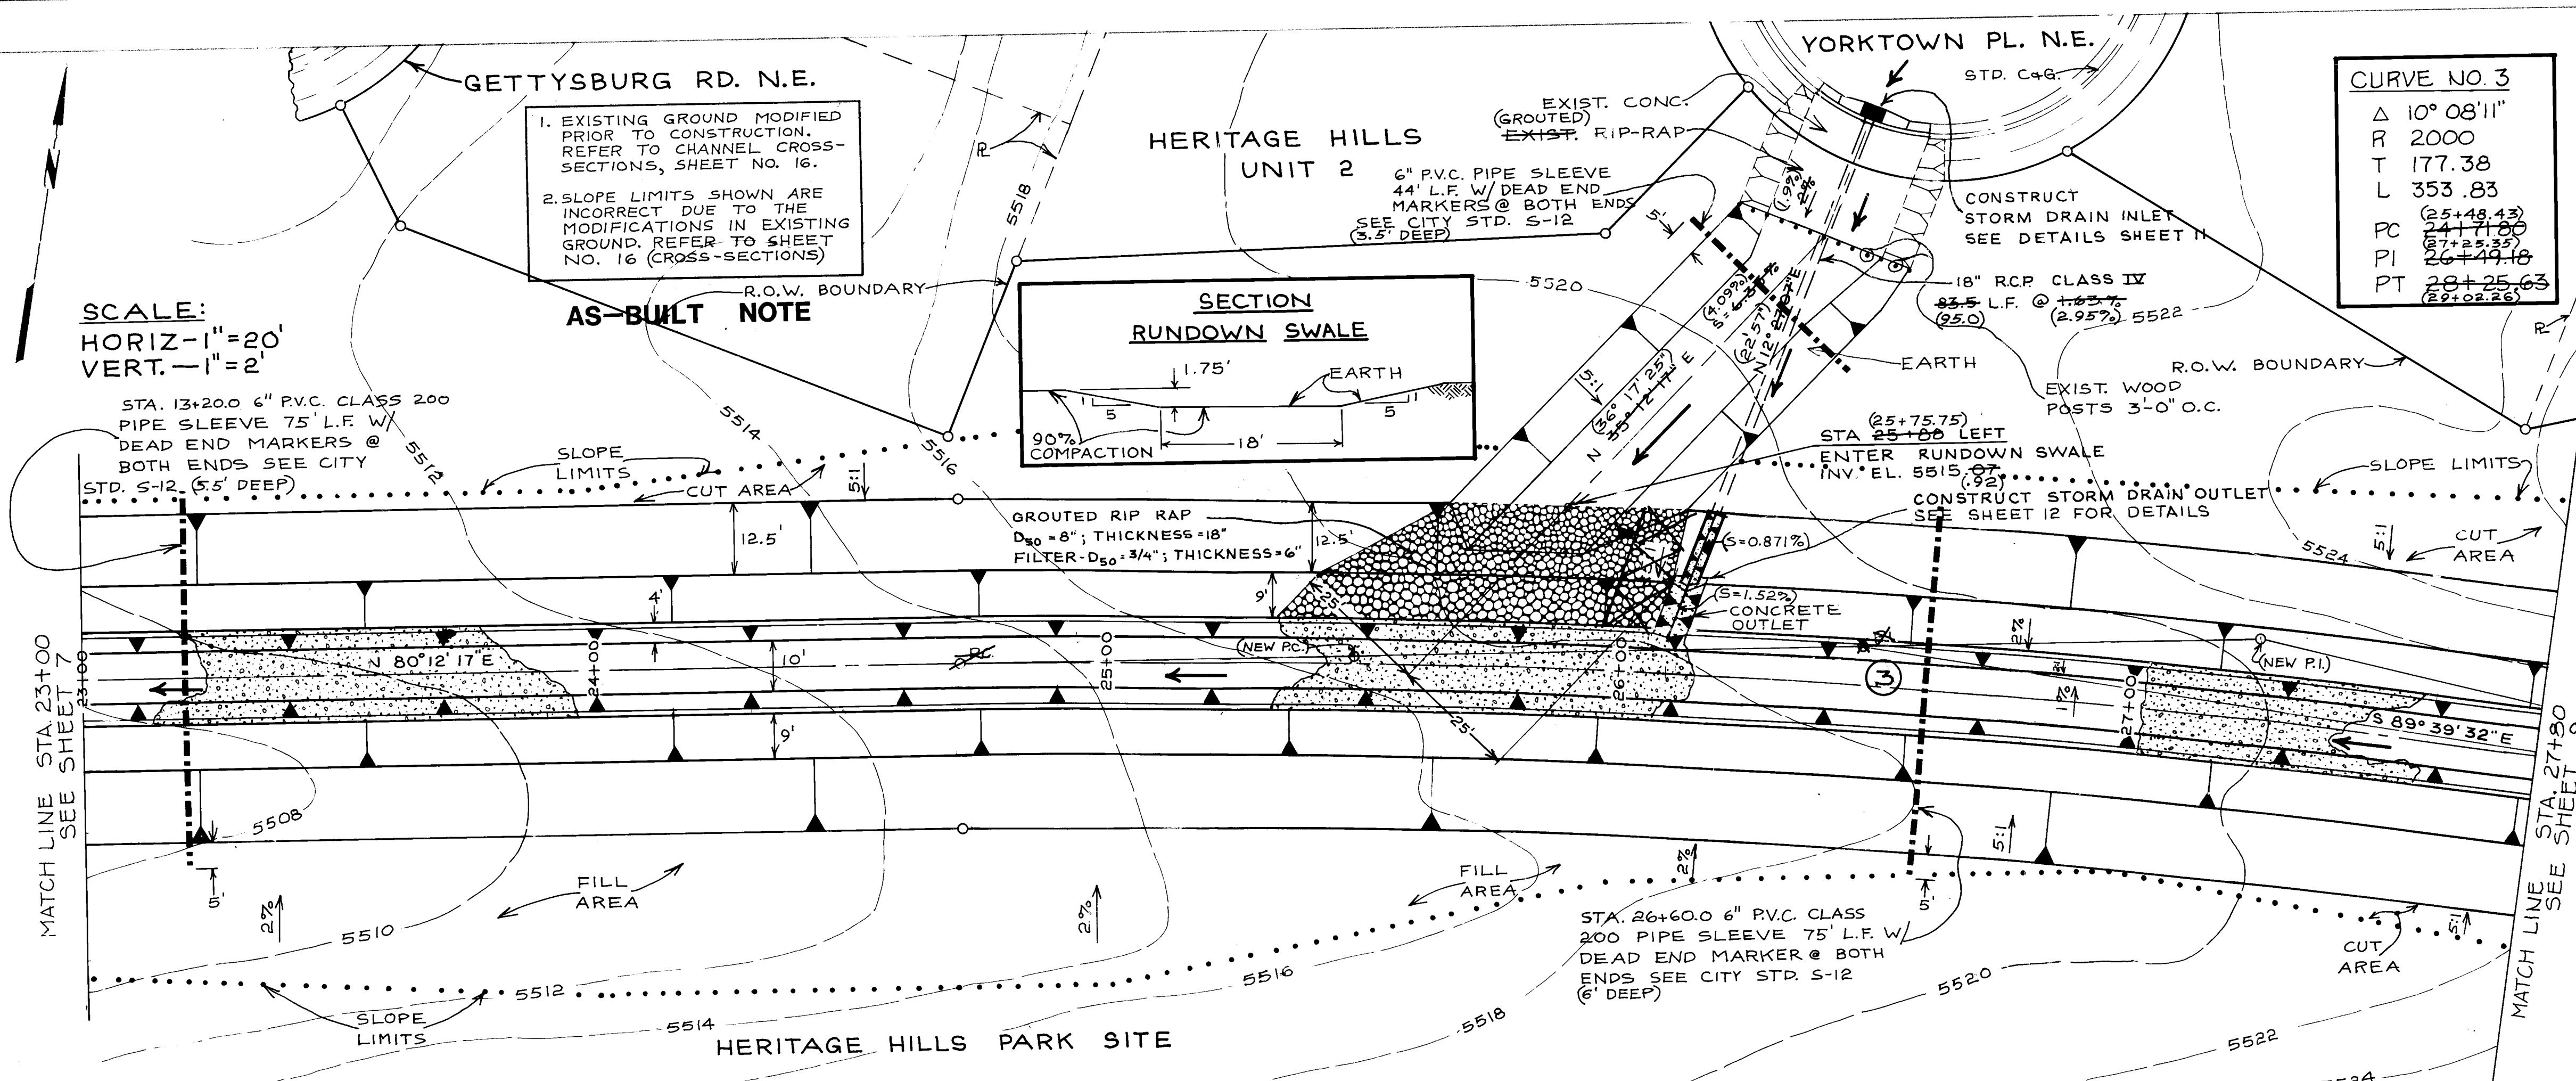

LEGEND

- CONCRETE CHANNEL
- RIP-RAP
- SLOPE LIMITS
- NEW SIDE SLOPE
- EXISTING SIDE SLOPE
- FLOW DIRECTION
- CATCH BASIN
- EXISTING CONTOUR
- PROPERTY LINE
- EASEMENT
- EXISTING UTILITY LINE
- PIPE SLEEVE

AS-BUILT INFORMATION

BENCH MARKS

ACCS. MONUMENT 5-ELB EL. 5474.97 LOCATED APPROX. 1215' EAST OF E. OF BARSTOW ST. NE AND APPROX. 22' NORTH OF 'CHERRY HILLS' WEST-NORTH PROPERTY LINE.

ACCS. MONUMENT 3-D-20 EL. 5544.94 LOCATED APPROX. 158' NORTH OF 'CHERRY HILLS' EAST-NORTH PROPERTY LINE.

ENGINEER'S SEAL

DATE: 5/15/86

BY: [Signature]

REVISIONS

NO.	DATE	REMARKS
1	5/15/86	DESIGN

CITY OF ALBUQUERQUE
MUNICIPAL DEVELOPMENT DEPARTMENT
ENGINEERING DIVISION


TITLE
CHANNEL PLAN AND PROFILE
STA. 23+00 TO STA. 27+80







APPROVALS	ENGINEER	DATE	APPROVALS	ENGINEER	DATE
City Engineer	[Signature]	5/15/86	City Engineer	[Signature]	5/15/86
ACE Design	[Signature]	5/15/86	ACE Design	[Signature]	5/15/86
ACE Hydrology	[Signature]	5/15/86	ACE Hydrology	[Signature]	5/15/86

DRAWING NO. 2079 **MAP NO.** D & E 20 **SHEET** 8 **OF** 16

THE LIMIT OF CONSTRUCTION SHOWN ON THE PLANS IS AN APPROXIMATION TO SHOW AREAS OF ANTICIPATED PAVEMENT, CURB AND GUTTER AND/OR OTHER SURFACE REMOVAL. THE CONTRACTOR SHALL ENDEAVOR TO MINIMIZE THE ACTUAL CONSTRUCTION LIMITS BUT IN NO CASE SHALL SUCH LIMITS OF WORK RESTRICT THE CONTRACTORS WORK WHERE SAFETY WOULD BE IMPAIRED. THE CONTRACTOR IS REFERRED TO THE SPECIFICATIONS AS SUPPLEMENTED, ESPECIALLY SECTION 6 OF THE GENERAL CONDITIONS.

ALL DISTURBED CONSTRUCTION AREAS MUST BE RESEED AS PER SUP. TECH. SPEC. 915

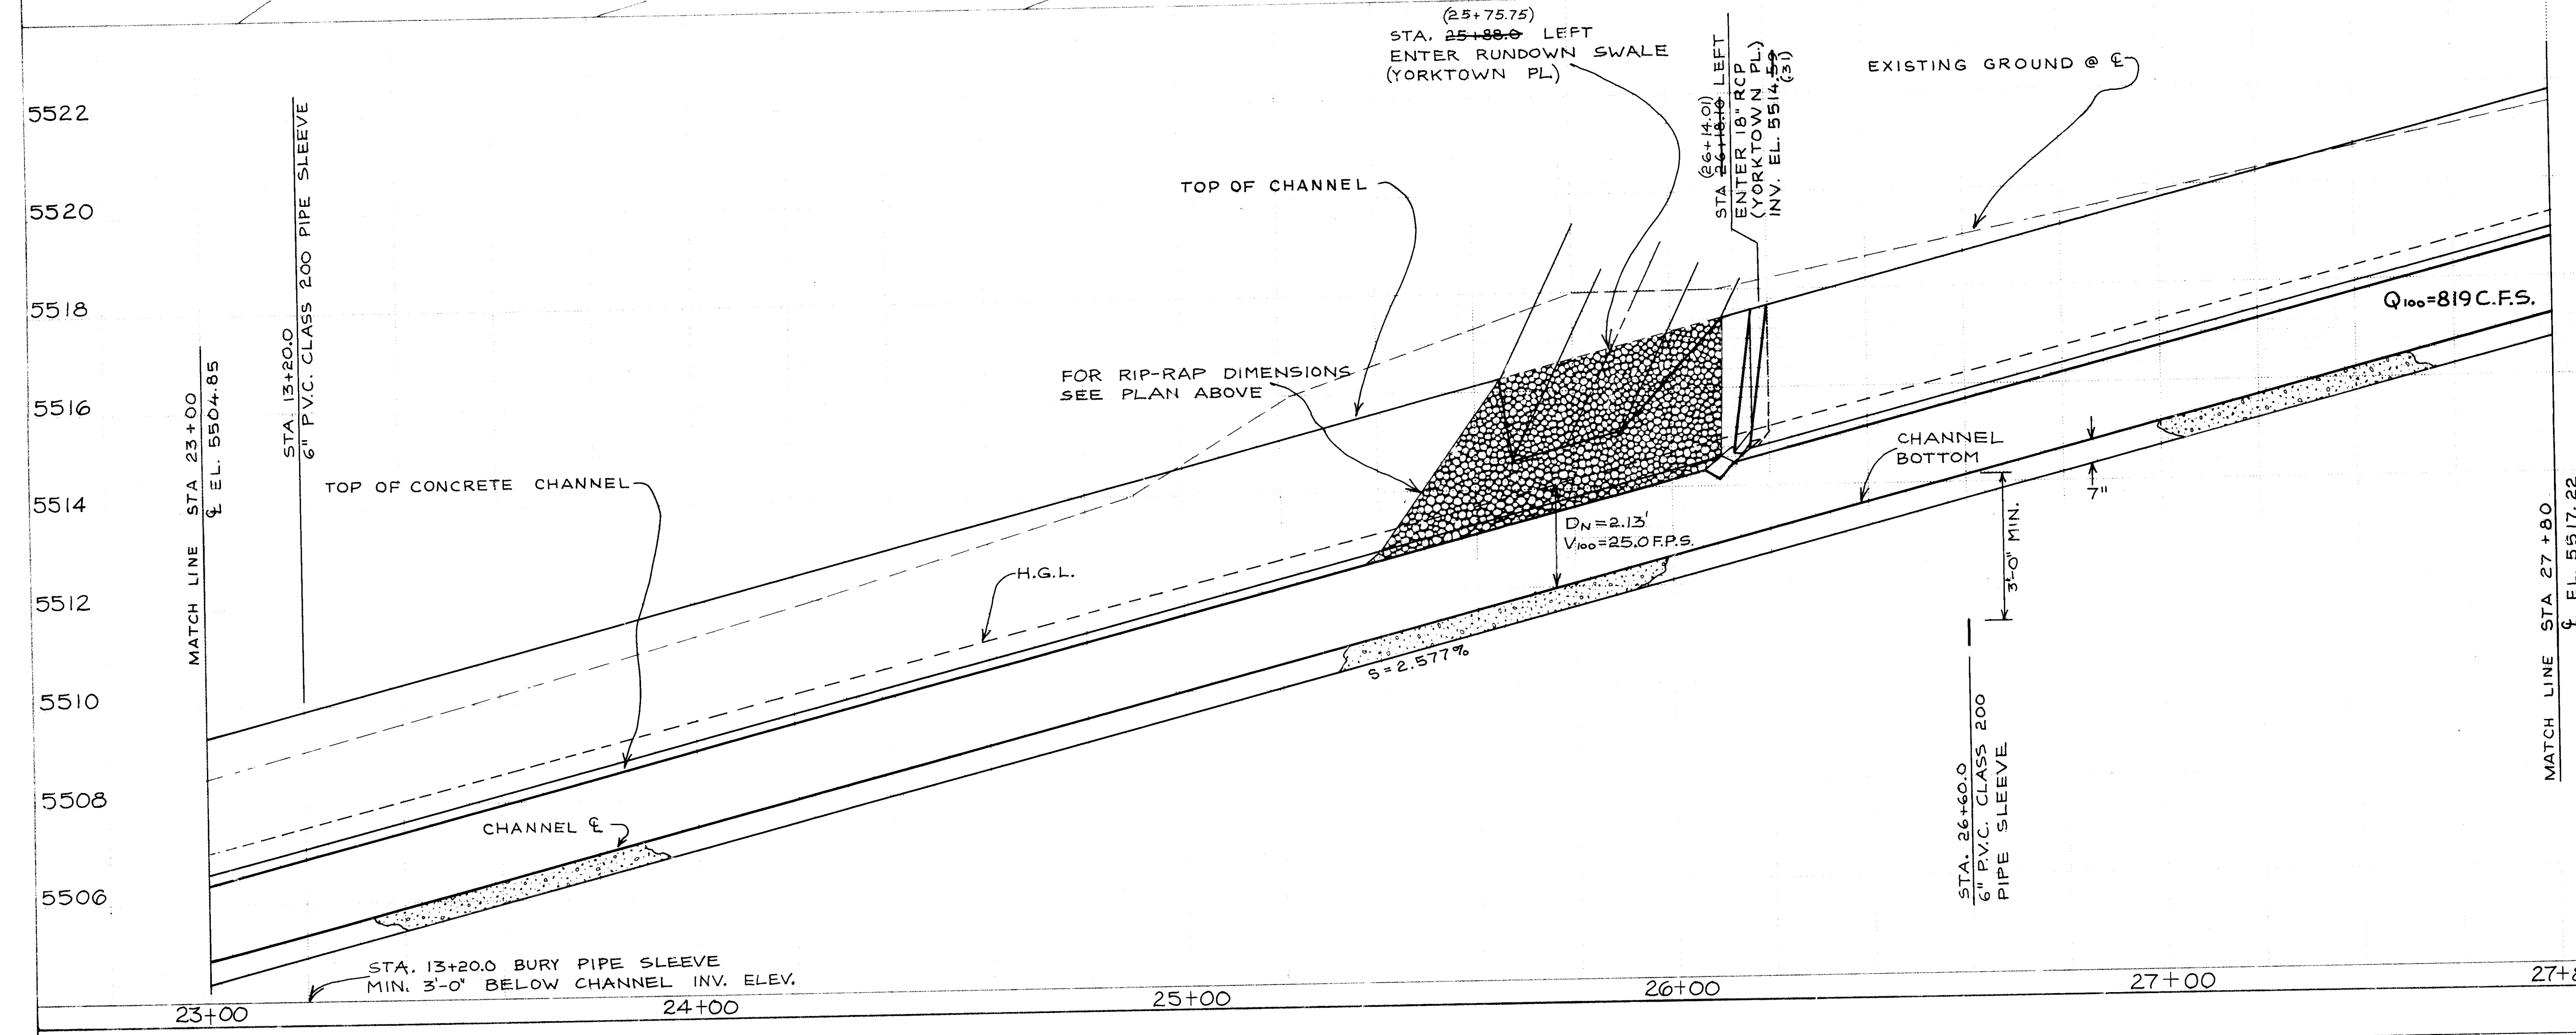

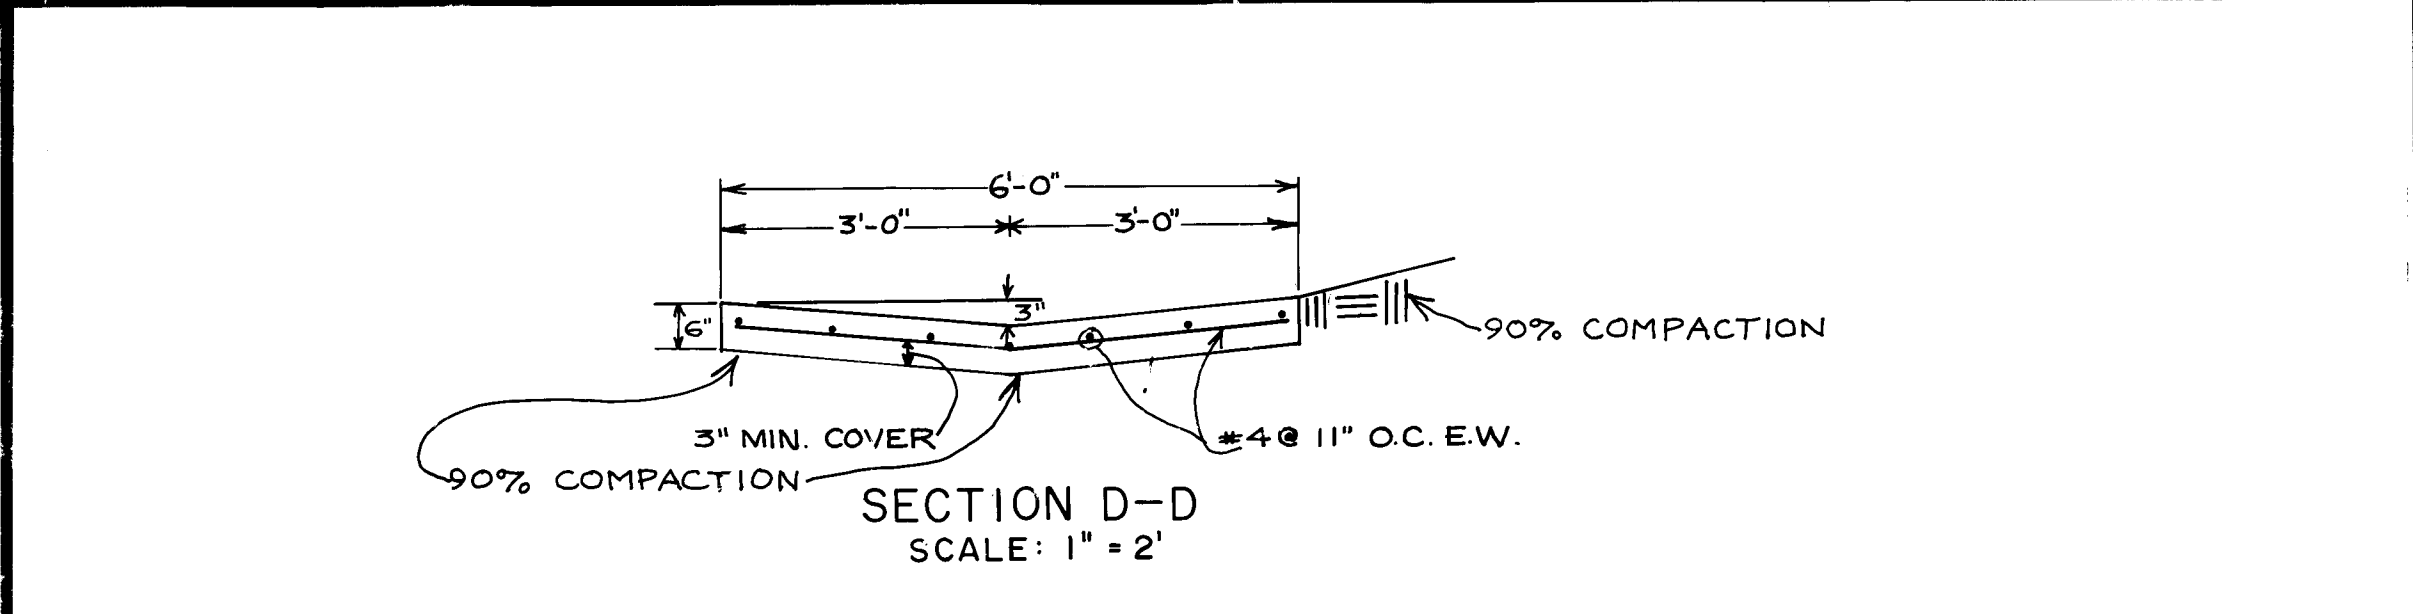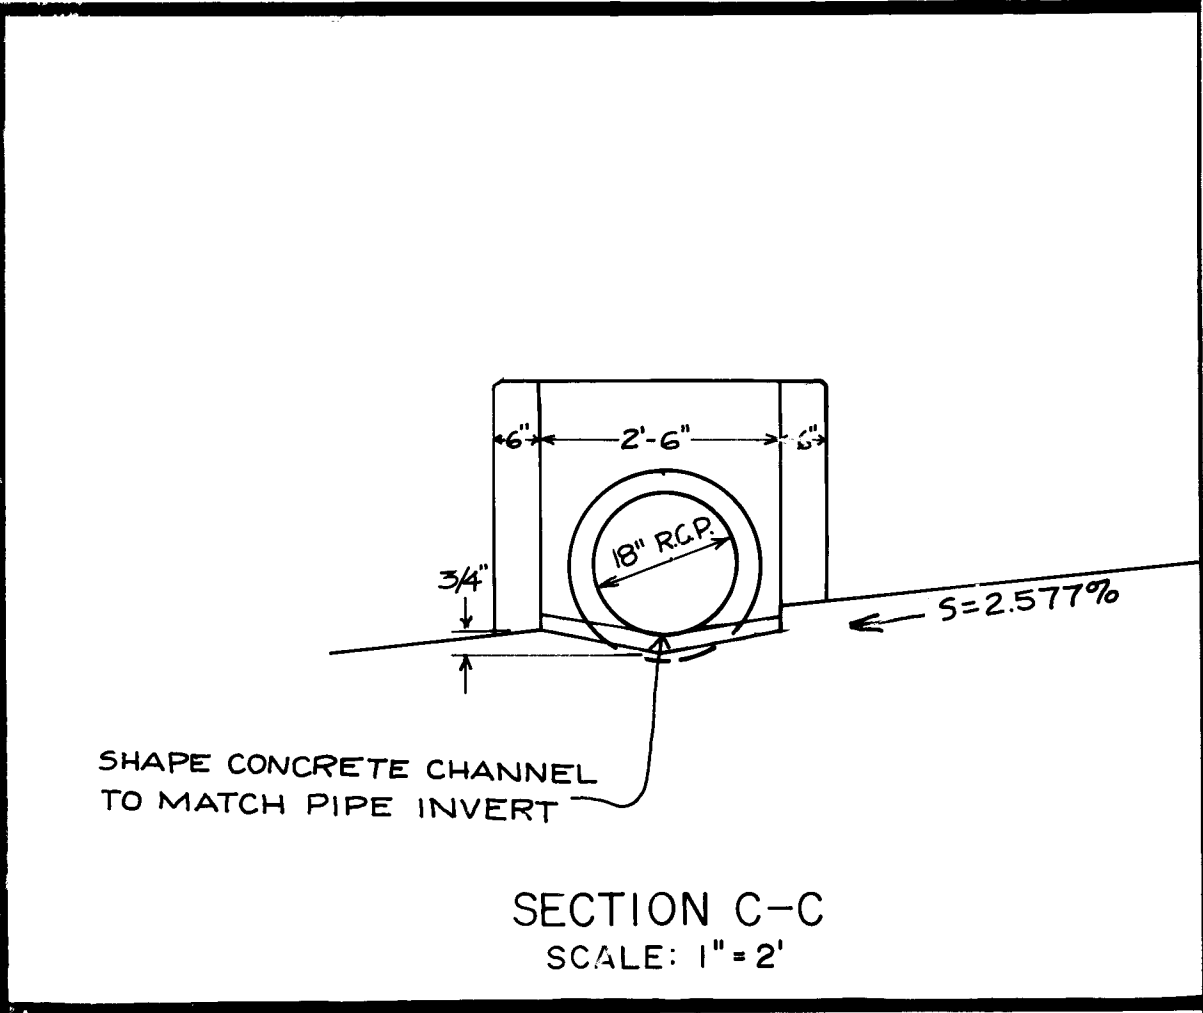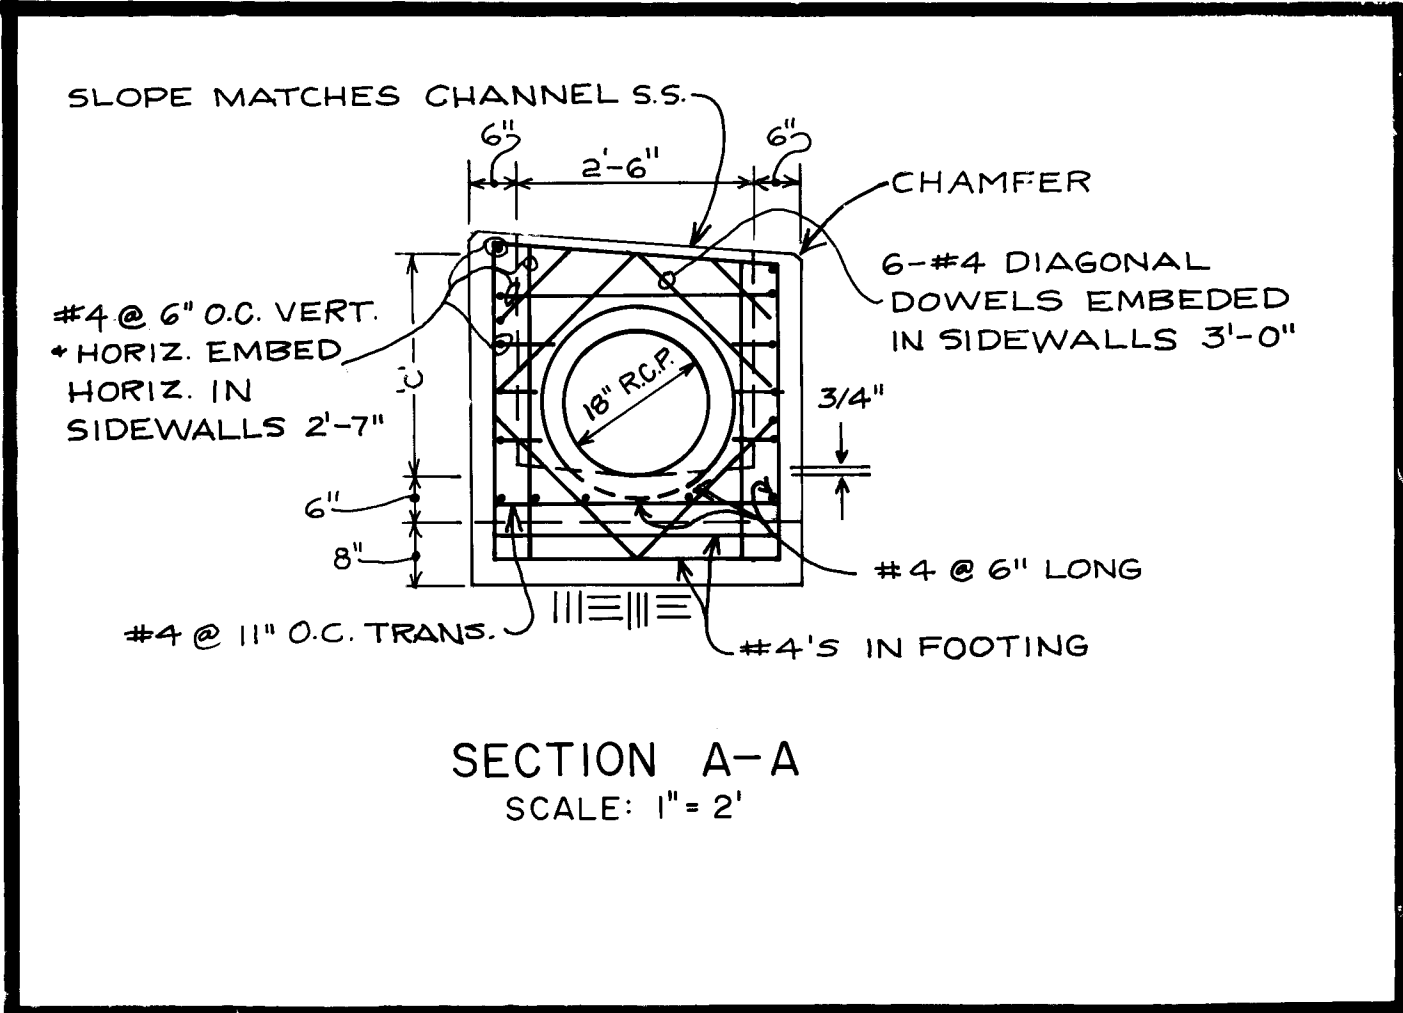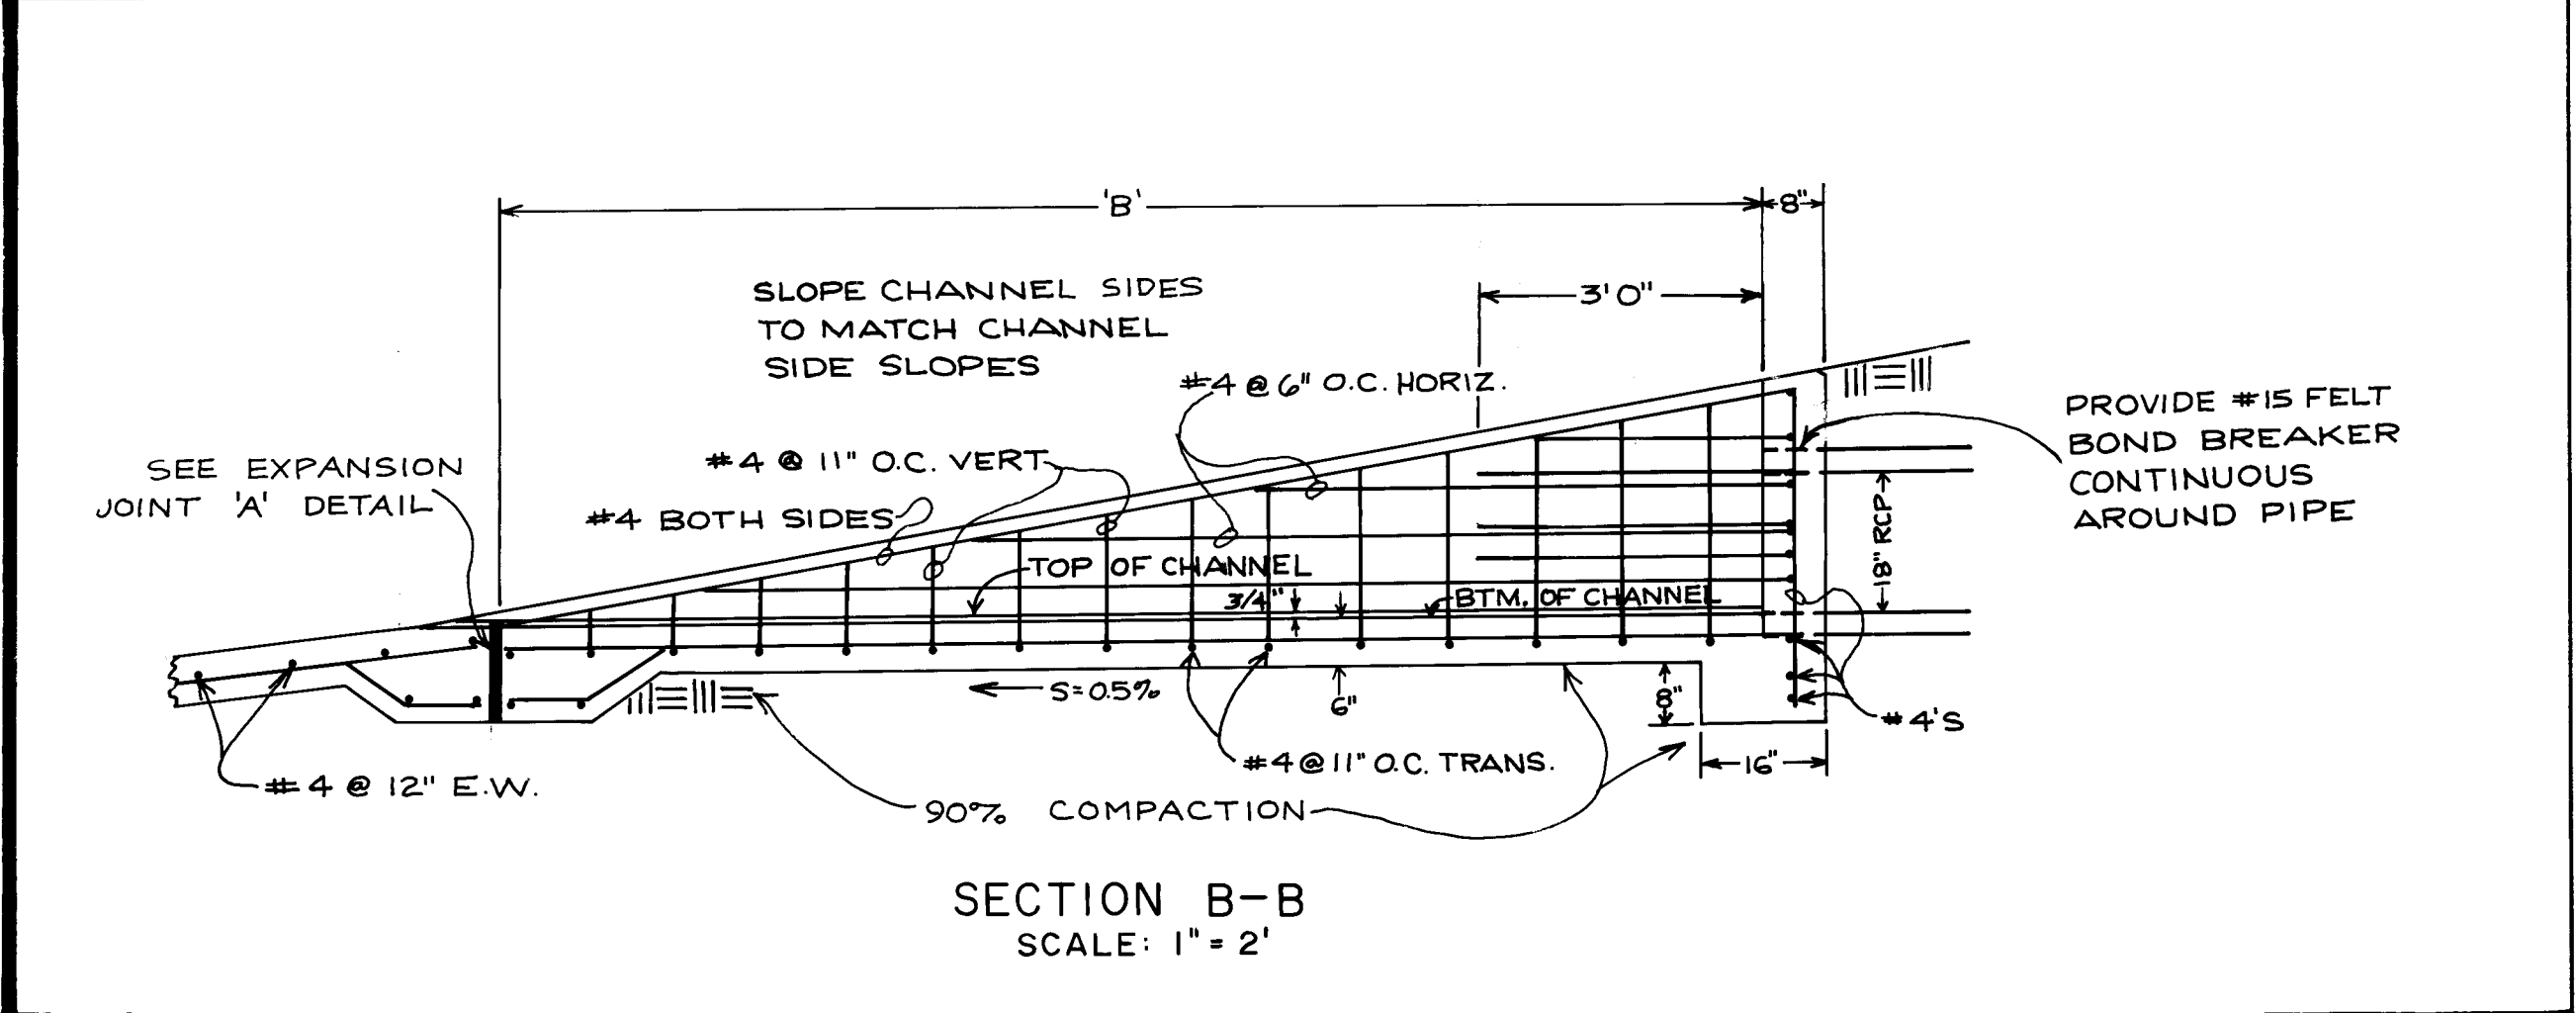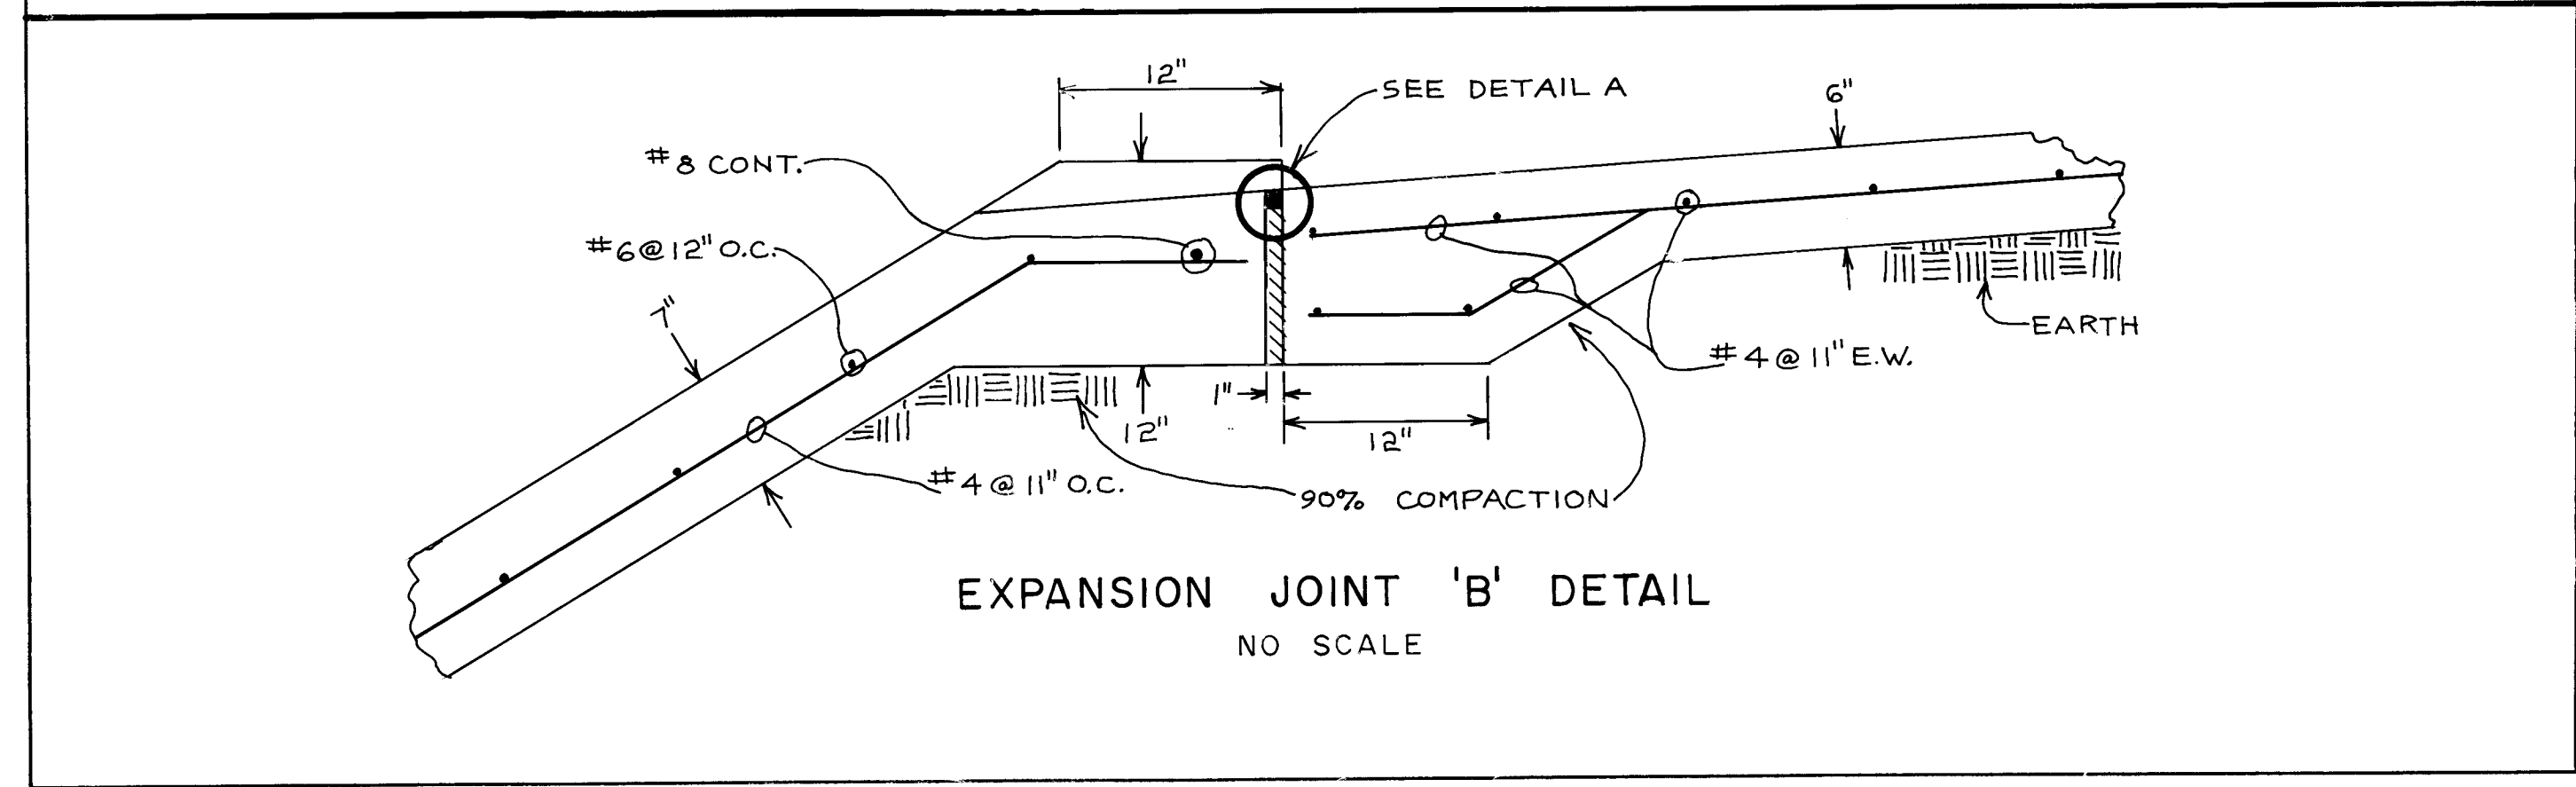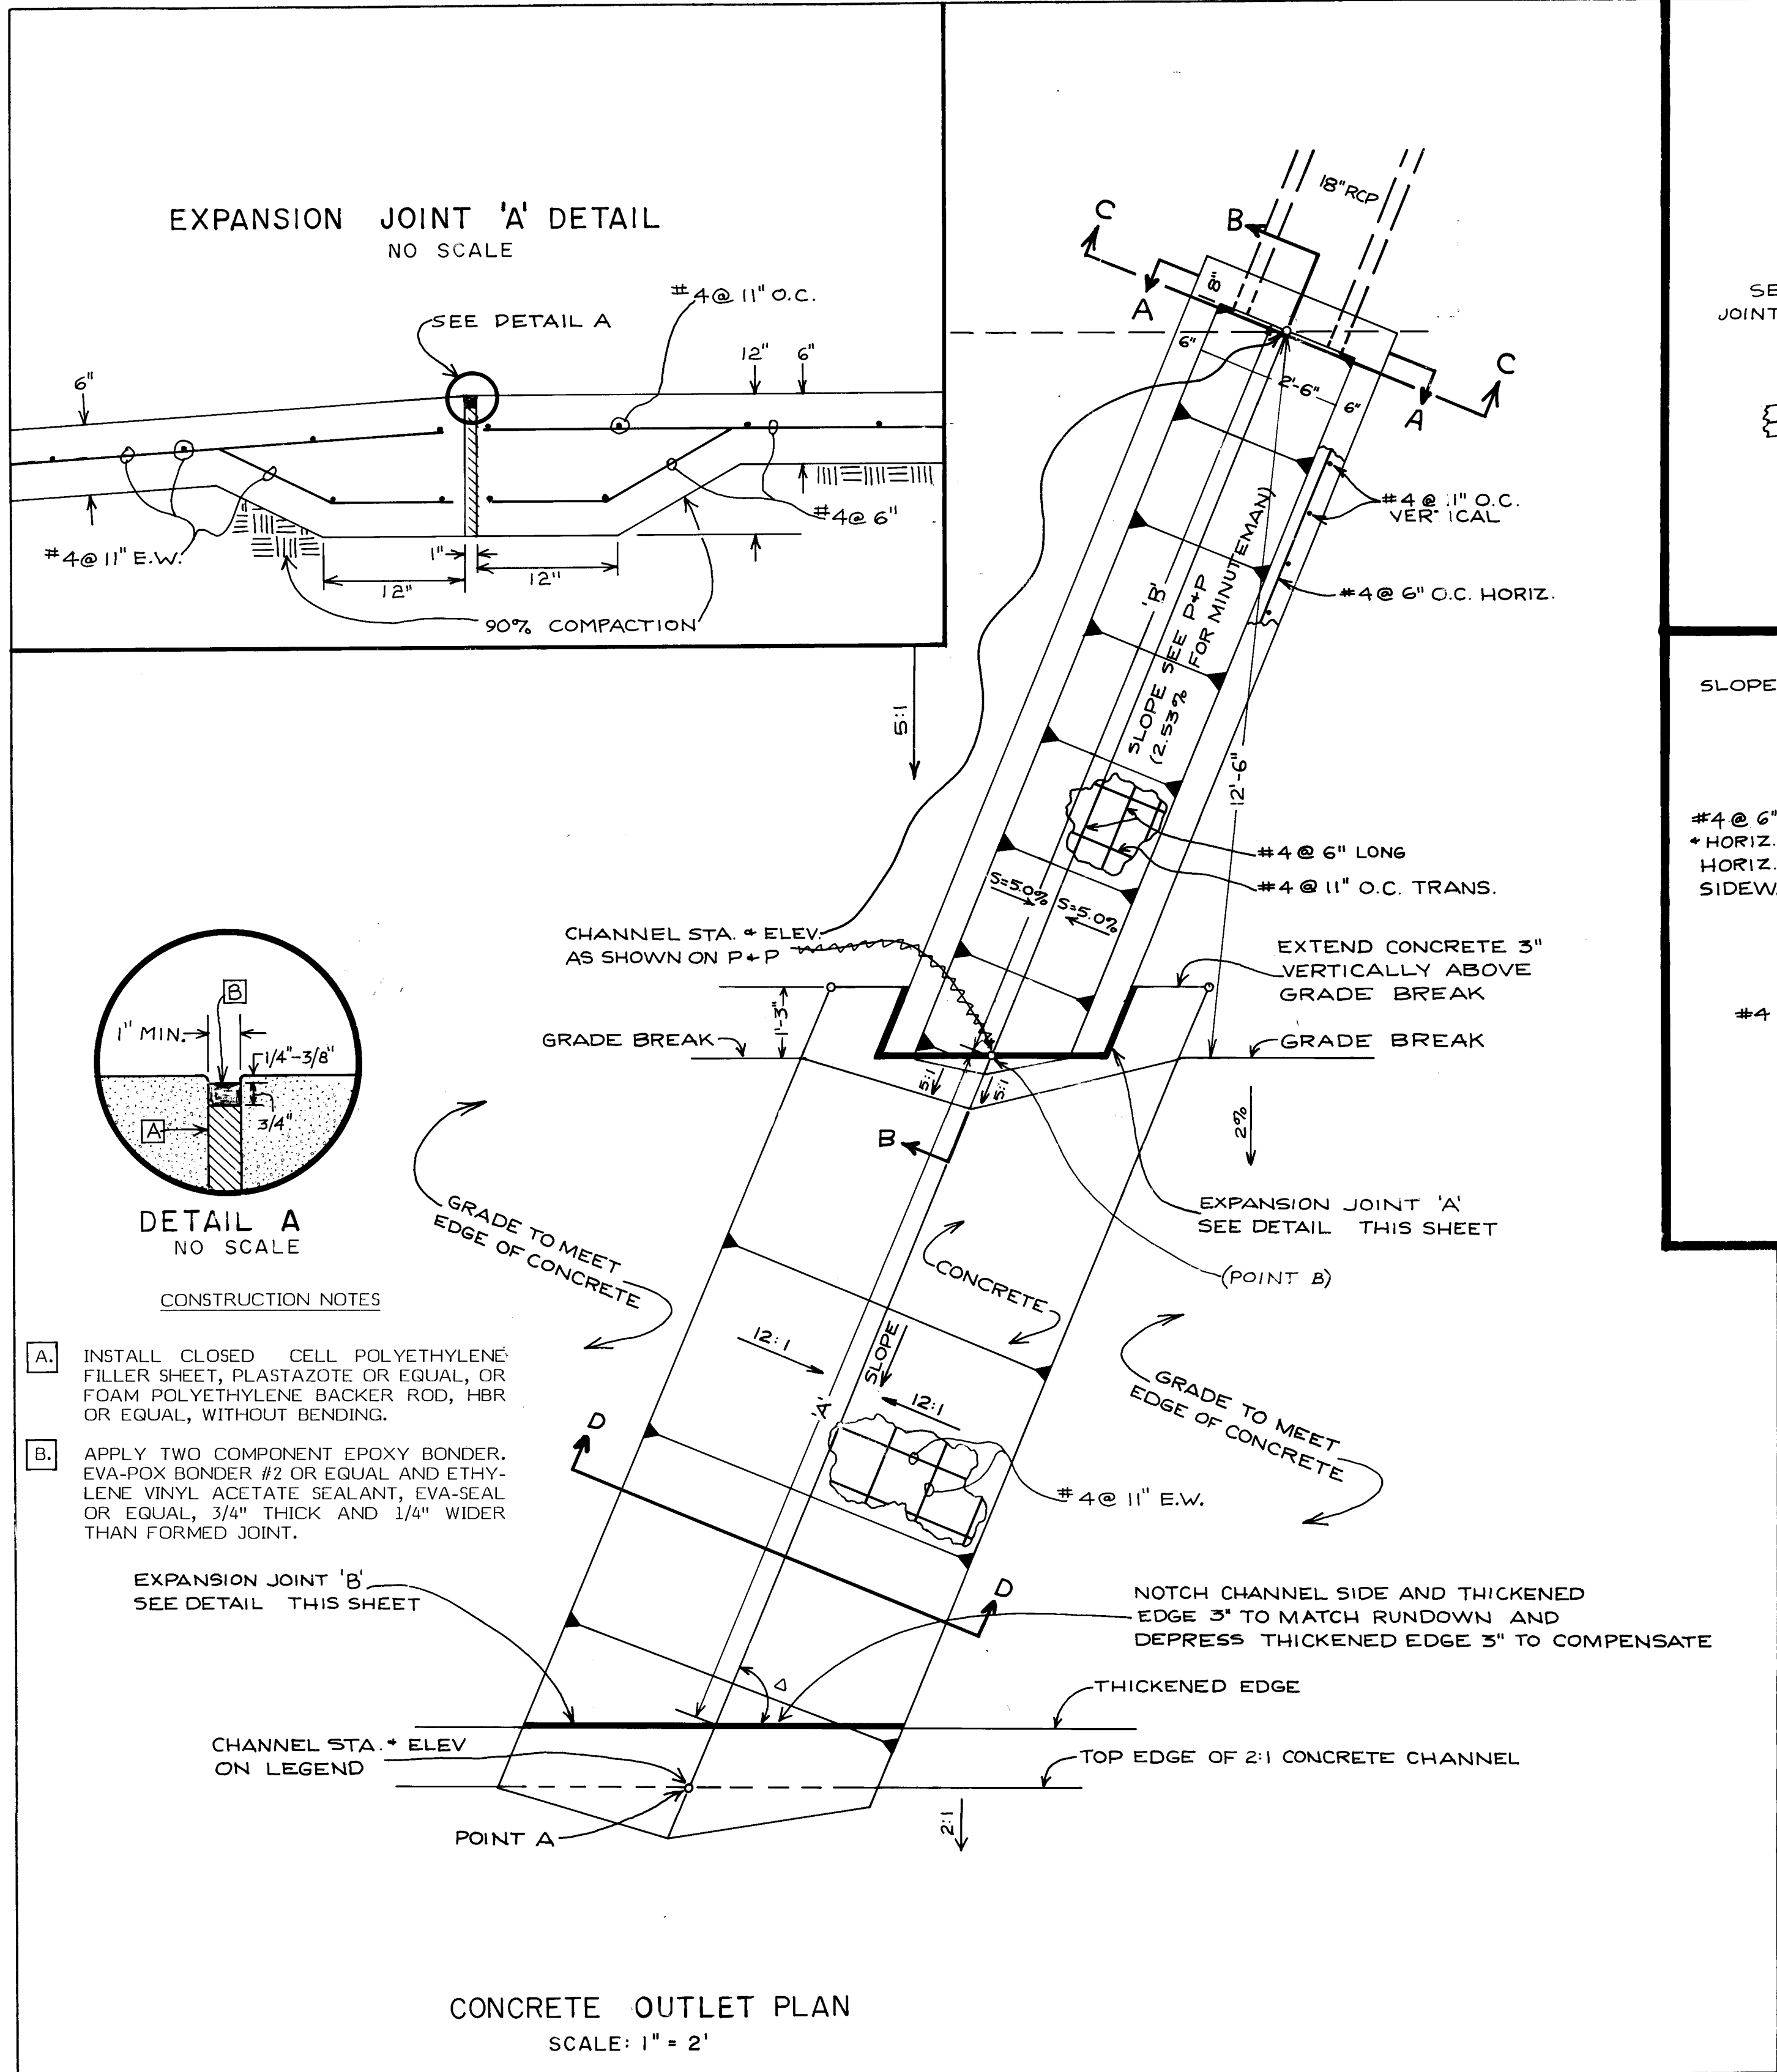

LEGEND							
Pipe Location	Station	Point A	W. Tangent (Δ)	Dim. 'A'	Dim. 'B'	Inv. El. Point B	Dim. 'C'
Capitol Drive	(4+52.24) 14+60.91	5484.45 (33)	(67.98) 67.75	(8.92) 9'-0 11/16"	(14.03) 13'-1 5/8"	(5484.45) 5485.12	(2.48) 2'-6"
Minuteman Drive	(7+70.60) 18+02.30	(92.68) 5493.19	34.23°	(18.52) 18'-0"	(19.53) 22'-2 1/4"	(5493.14) 5495.40	(2.31) 2'-3 3/4"
Gettysburg Drive	(22+81.99) 22+86.91	5505.73 (68.08)	(9.97) 67.75	(12.93) 9'-0 11/16"	(12.93) 13'-1 5/8"	(5505.89) 5506.37	(2.53) 2'-6"
Yorktown Place	(26+05.78) 26+08.91	5514.03 (14)	(67.82) 67.75	(10.03) 9'-0 11/16"	(12.63) 13'-1 5/8"	(5514.20) 5506.01	(2.5) 2'-6"
Valley Forge Place	(29+00.59) 29+04.59	5521.47 (68)	(77.84) 76.44	(9.10) 9'-0 11/16"	(12.53) 12'-1 1/2"	(5521.87) 5522.16	(2.4) 2'-4 1/2"

AS BUILT INFORMATION				BENCH MARKS				SURVEY INFORMATION				ENGINEER'S SEAL			
CONTRACTOR	BENDER	CONST.		ACCS. MONUMENT	5-E19	EL. 5474.97	LOCATED	NO.	BY	DATE		NO.	BY	DATE	
WORK	BY	DATE		APPROX. 1215'	EAST OF	Q. OF BARSTOW ST. NE									
INSPECTOR'S	DATE			AND APPROX. 22'	NORTH OF	'CHERRY HILLS									
ACCEPTANCE BY	DATE			WEST NORTH	PROPERTY LINE.										
VERIFICATION BY	DATE			ACCS. MONUMENT	3-D-20	EL. 5344.94	LOCATED								
DATE				139.49'	WEST OF	Q. OF VENTURA ST. NE									
RECORDED BY	DATE			AND APPROX. 158'	NORTH OF	'CHERRY HILLS									
NO				EAST	NORTH	PROPERTY LINE.									


26 2079 1287

CITY OF ALBUQUERQUE
MUNICIPAL DEVELOPMENT DEPARTMENT
ENGINEERING DIVISION

TITLE: DETAILS

APPROVALS	ENGINEER	DATE	APPROVALS	ENGINEER	DATE
City Engineer	<i>[Signature]</i>	8/21/85	Liquid Waste	<i>[Signature]</i>	8/21/85
A.C.E. - Design	<i>[Signature]</i>	8/21/85	Traffic	<i>[Signature]</i>	8/21/85
A.C.E. - Hydrology	<i>[Signature]</i>	8/21/85	Water	<i>[Signature]</i>	8/21/85

DRAWING NO. 2079 MAP NO. D & E 20 SHEET 12 OF 16

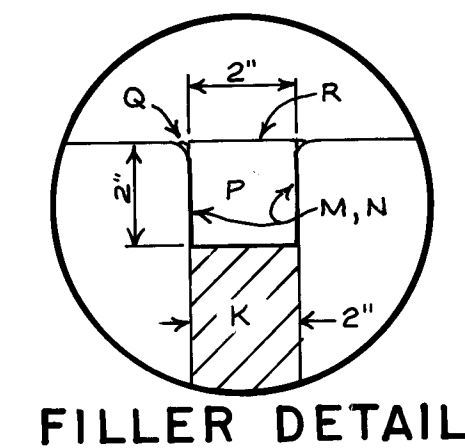

EXPANSION JOINT DETAILS

STEP TYPE

SCALE · 1" = 1'




- A. EXISTING CONCRETE STRUCTURE TO REMAIN.
- B. EXISTING REINFORCING STEEL TO REMAIN.
- C. COMPACT SUBGRADE TO MINIMUM 90% PER ASTM D 1557. SHAPE TO DIMENSIONS SHOWN.
- D. TIE STEEL AS SHOWN: 18" SPACING PARALLEL TO CHANNEL. OTHER STEEL SIZE AND SPACING PER DETAIL. LOCATE TIE STEEL AREA GREATER THAN .005 TIMES CONC. AREA; TRANSVERSE STEEL AREA GREATER THAN .0025 TIMES CONC. AREA. SEE DETAIL FOR 2 BAR THIS SHEET. SECURELY TIE ALL CONNECTIONS. SUPPORT SLEEPER MAT WITH PREFORMED CONCRETE CHAIRS. STEEL SHALL BE FREE OF FERRIC OXIDE (BLACK RUST SCALE).
- E. FORM AND POUR FLY ASH CONCRETE SURFACE. STEEL TROWEL BEARING SURFACE SIDE ONLY. RECOMPACT ADJACENT SOIL.
- F. POLYETHYLENE BEARING PLATE, 1/4" X 2", LOW DENSITY, PLACED FLAT ON SAME GRADE AS CHANNEL. CARE SHALL BE TAKEN NOT TO LOCK EDGE OF PLATE WITH CONCRETE FILLED HOLES OR FLASHING. COMPACT SOIL TO TOP PLANE OF PLATE.
- G. SANDBLAST EDGE OF EXISTING CONCRETE STRUCTURE AND APPLY CEMENTITIOUS GROUT PRIOR TO PLACING NEW CONCRETE.
- H. FORM AND POUR DOWNSTREAM CONCRETE SECTION AS SHOWN WITH FLY ASH CONCRETE WITH ALUMINUM FLOAT AND DRY BROOM FINISH. STEEL TROWEL BEARING PLATE SURFACE ONLY. BEARING PLATE SURFACE MUST BE PARALLEL TO BEARING PLATE SURFACE ON SLEEPER. FORMS TO REMAIN IN PLACE UNTIL NEXT DAY FOLLOWING POUR.
- I. PLACE 1/4" X 6" LOW DENSITY POLYETHYLENE BEARING PLATE AS SHOWN BETWEEN THE TWO FILLER SECTIONS.
- J. PLACE POLYETHYLENE FOAM FILLERS AS SHOWN, PLASTAZOTE OR APPROVED EQUAL. DO NOT ANCHOR WITH NAILS OR BONDING AGENT. KEEP WITH FRESH CONCRETE. DO NOT POUR CONCRETE INTO JOINT. DO NOT ALLOW FRESH CONCRETE BETWEEN PLASTAZOTE AND POURED CONCRETE SECTION.
- K. POUR UPSTREAM SECTION WITH FLY ASH CONCRETE. VERTICAL SIDES OF FORM SHALL TO BLOCK OUT SPACE FOR SEALANT SHALL BE SMOOTH, CLEAN MATERIAL TO AVOID NOSING CONTAMINATION AND FOR EASE OF REMOVAL. CONCRETE SHALL BE CURED TO MINIMUM 80% OF DESIGN STRENGTH BEFORE INSTALLING SEALANT.
- L. PREPARE VERTICAL NOSING FOR BONDER BY SANDBLASTING. BLOW ALL SAND OUT OF THE JOINT BEFORE APPLYING BONDER.
- M. APPLY 2 COMPONENT EPOXY EVA-POX, FRESH CONCRETE BONDER, OR APPROVED EQUAL TO VERTICAL CONCRETE FACES AND VERTICAL SEALANT FACES.
- N. IMMEDIATELY INSTALL ETHYLENE VINYL ACETATE FOAM SEALANT, EVA-SEAL OR APPROVED EQUAL, TO JOINT. SEALANT SHALL BE AS SHOWN. FOAM SEALANT MUST BE COMPRESSED INTO JOINT. IMMEDIATELY REMOVE ALL BONDER FROM TOP SURFACE OF SEALANT.
- O. BONDER BEAD IN GROOVE BETWEEN TOOLED RADIUS AND SEALANT IS TO REMAIN.
- P. SAND SURFACE OF SEALANT FLUSH TO TOP OF CONCRETE. APPLY ULTRA VIOLET CURING, 2 COATS, FLEXCOAT 19 OR APPROVED EQUAL.

26 20791487

CITY OF ALBUQUERQUE
MUNICIPAL DEVELOPMENT DEPARTMENT
ENGINEERING DIVISION

TITLE: **EXPANSION JOINT
AND STORM DRAIN DETAILS**

APPROVALS	ENGINEER	DATE	APPROVALS	ENGINEER	DATE
City Engineer	<i>C. H. Chapman</i>	8/29/05	Liquid Waste	<i>R. Davis</i> N.A.	8/21/05
A C E - Design	<i>Neilson</i>	8/29/05	Traffic	<i>N.A.</i> D.H	8/21/05
A C E - Hydrology	<i>Na. Hogg</i>	8/29/05	Water	<i>K. Hogg</i> N.A.	8/21/05
DRAWING NO.	2079	MAP NO.	D & E 20	SHEET OF	14 16

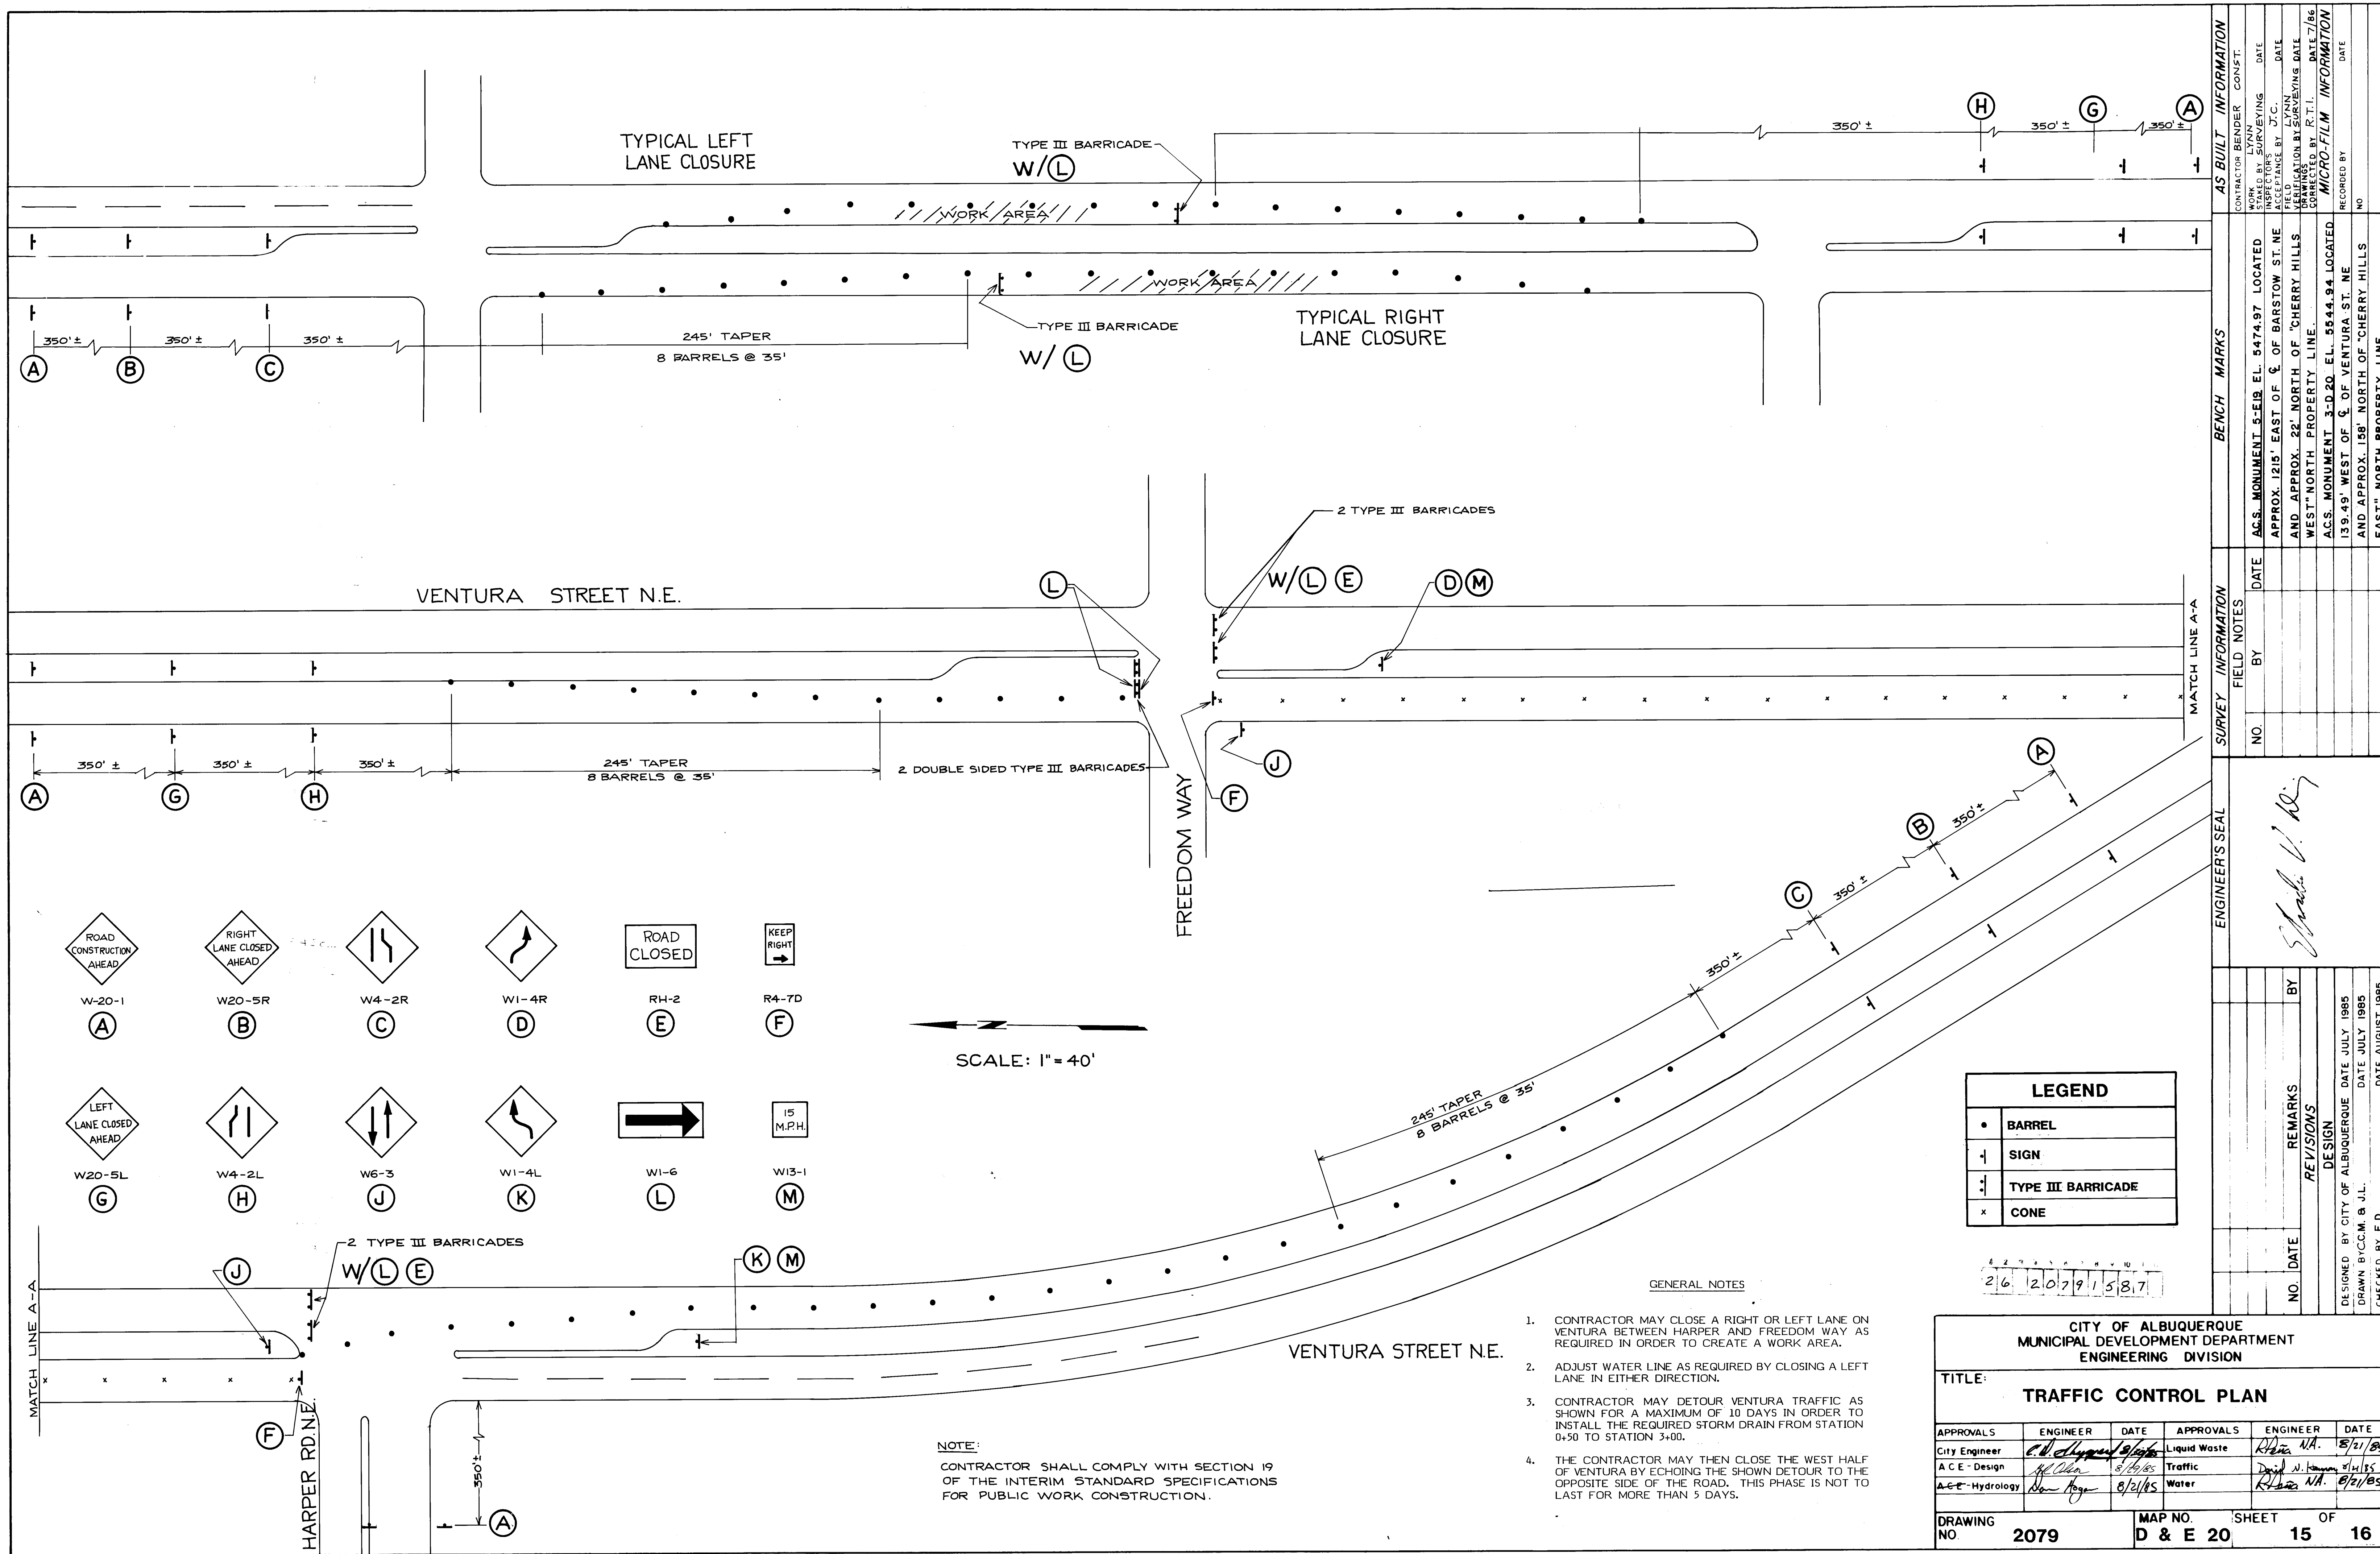

AS BUILT INFORMATION	
CONTRACTOR BENDER	CONSTR.
LYNN	DATE
WORK BY SURVEYING	DATE
INSPECTORS	DATE
ACCEPTANCE BY J.C.	DATE
VERIFICATION BY SURVEYING DATE	DATE
DRAWINGS BY R.T.I.	DATE 7/86
RECORDING BY	DATE
NO	

BENCH MARKS	
AC.S. MONUMENT 5-FEB EL. 5474.97 LOCATED APPROX. 1215' EAST OF E. OF BARSTOW ST. NE AND APPROX. 22' NORTH OF 'CHERRY HILLS' WEST" NORTH PROPERTY LINE.	DATE
AC.S. MONUMENT 3-D-20 EL. 5544.94 LOCATED APPROX. 158' NORTH OF 'CHERRY HILLS' EAST" NORTH PROPERTY LINE.	DATE

SURVEY INFORMATION	
NO	BY
DATE	

ENGINEER'S SEAL	
DATE	BY
DATE	

REVISIONS	
NO	DATE
DATE	
DATE	
DATE	


LEGEND	
•	BARREL
+	SIGN
+	TYPE III BARRICADE
x	CONE

2	6	2	0	7	9	1	5	8	7
---	---	---	---	---	---	---	---	---	---


- GENERAL NOTES
- CONTRACTOR MAY CLOSE A RIGHT OR LEFT LANE ON VENTURA BETWEEN HARPER AND FREEDOM WAY AS REQUIRED IN ORDER TO CREATE A WORK AREA.
 - ADJUST WATER LINE AS REQUIRED BY CLOSING A LEFT LANE IN EITHER DIRECTION.
 - CONTRACTOR MAY DETOUR VENTURA TRAFFIC AS SHOWN FOR A MAXIMUM OF 10 DAYS IN ORDER TO INSTALL THE REQUIRED STORM DRAIN FROM STATION 0+50 TO STATION 3+00.
 - THE CONTRACTOR MAY THEN CLOSE THE WEST HALF OF VENTURA BY ECHOING THE SHOWN DETOUR TO THE OPPOSITE SIDE OF THE ROAD. THIS PHASE IS NOT TO LAST FOR MORE THAN 5 DAYS.

NOTE:
CONTRACTOR SHALL COMPLY WITH SECTION 19 OF THE INTERIM STANDARD SPECIFICATIONS FOR PUBLIC WORK CONSTRUCTION.

CITY OF ALBUQUERQUE MUNICIPAL DEVELOPMENT DEPARTMENT ENGINEERING DIVISION					
TITLE: TRAFFIC CONTROL PLAN					
APPROVALS	ENGINEER	DATE	APPROVALS	ENGINEER	DATE
City Engineer	<i>[Signature]</i>	8/21/85	Liquid Waste	<i>[Signature]</i>	8/21/85
A.C.E. - Design	<i>[Signature]</i>	8/21/85	Traffic	<i>[Signature]</i>	8/21/85
A.C.E. - Hydrology	<i>[Signature]</i>	8/21/85	Water	<i>[Signature]</i>	8/21/85
DRAWING NO.	2079	MAP NO.	D & E 20	SHEET	15 OF 16

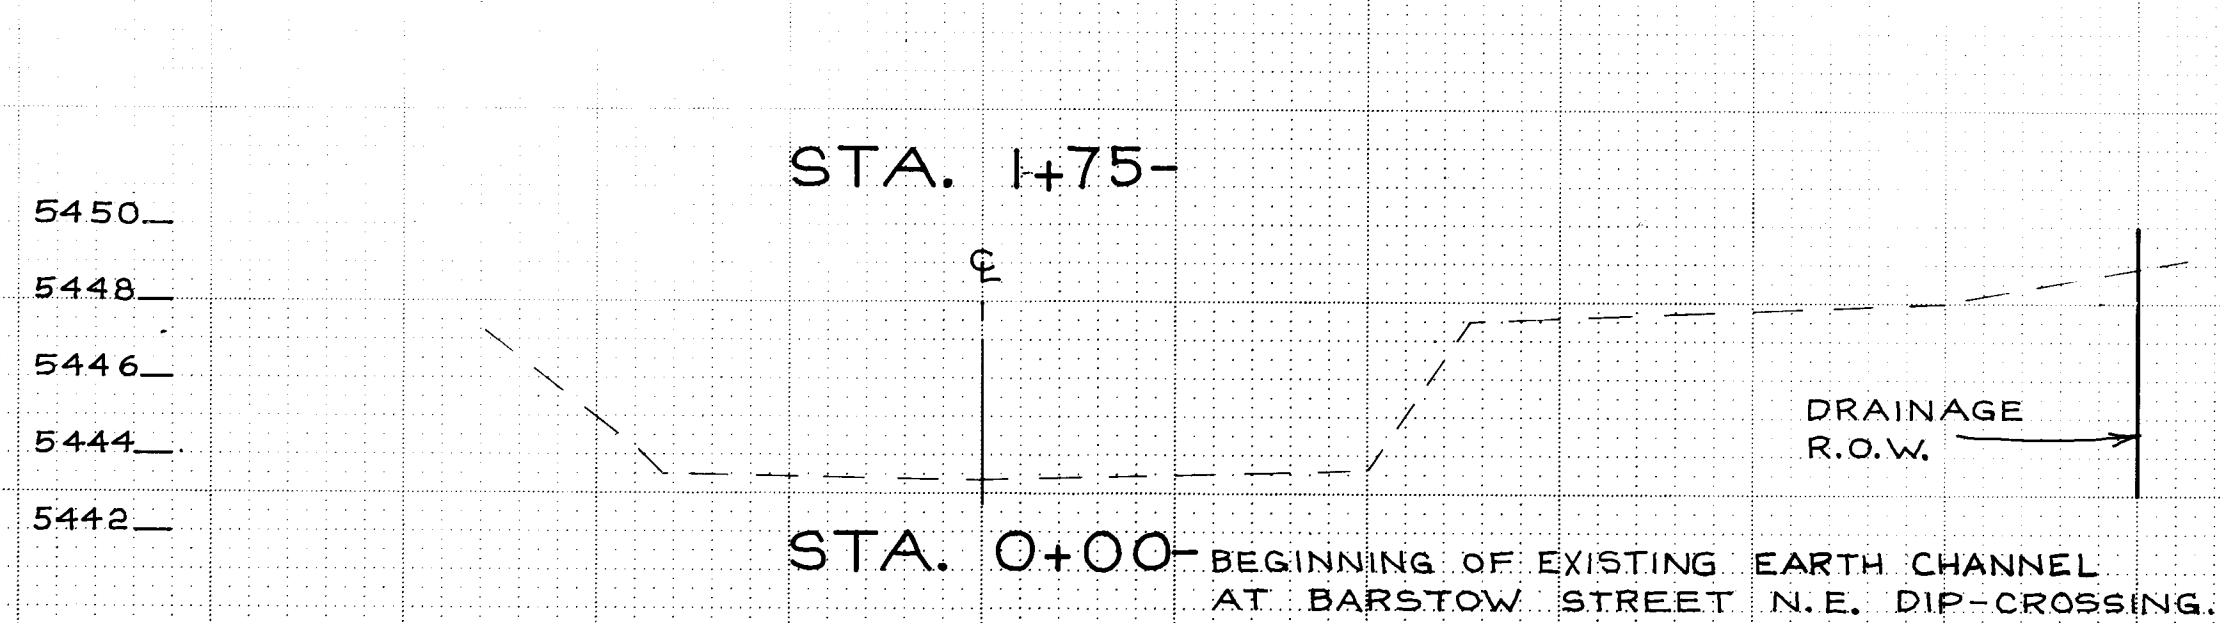

HORIZONTAL: $1'' = 20'$
VERTICAL: $1'' = 5'$

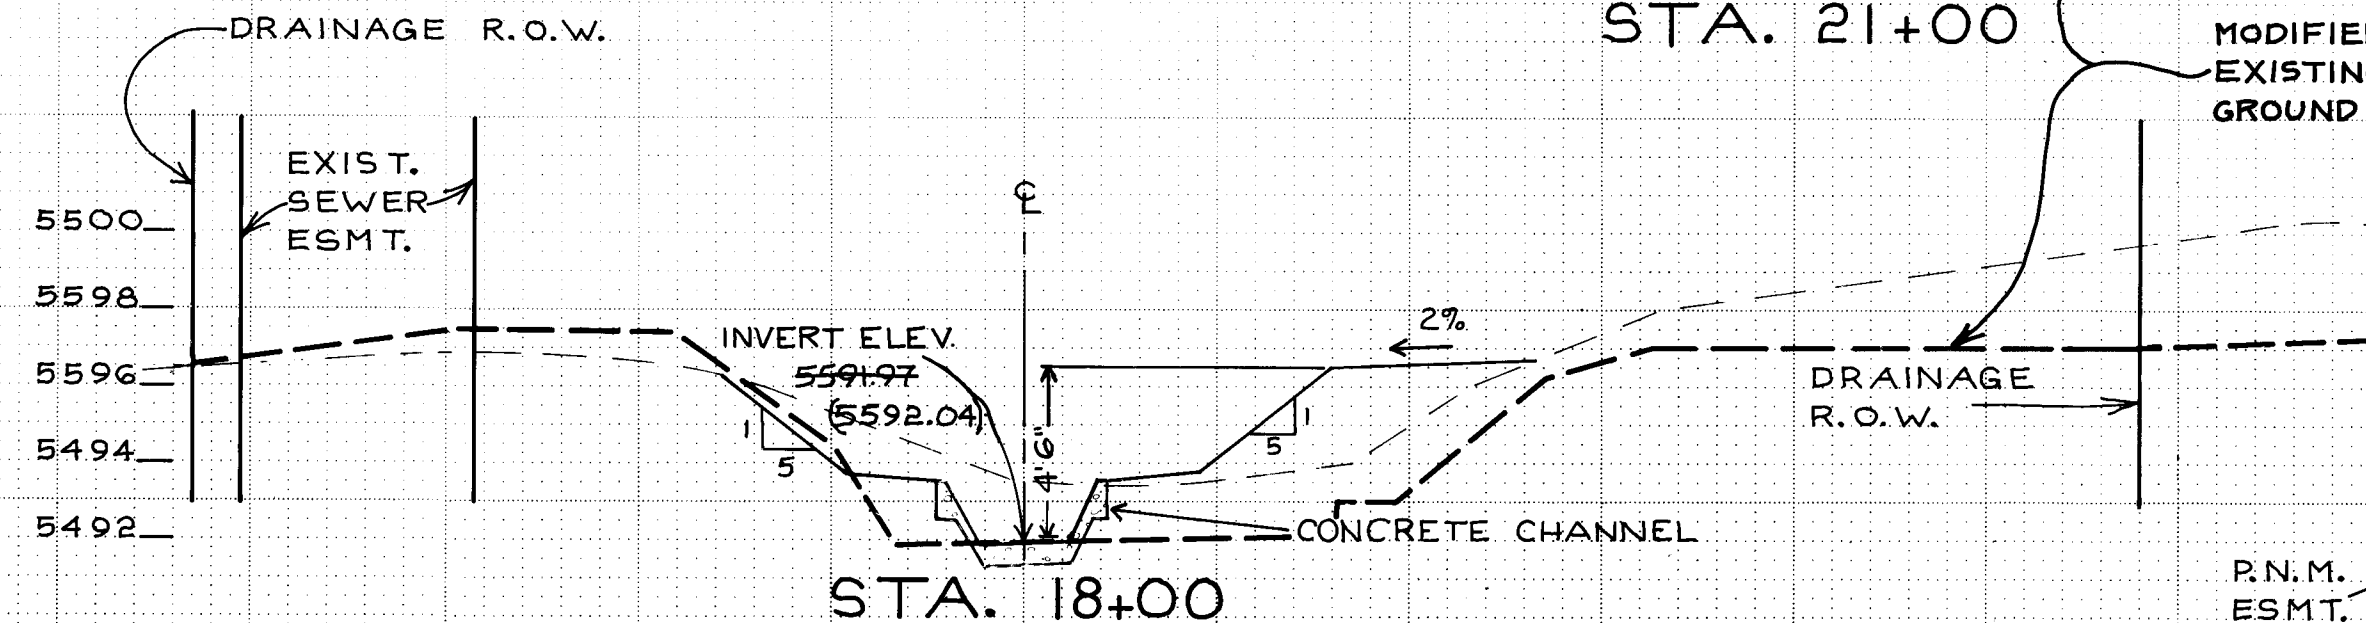

CITY OF ALBUQUERQUE MUNICIPAL DEVELOPMENT DEPARTMENT ENGINEERING DIVISION					
TITLE:					
CHANNEL CROSS SECTIONS					
APPROVALS	ENGINEER	DATE	APPROVALS	ENGINEER	DATE
City Engineer	<i>E. Valdez</i>	5/21/85	Liquid Waste	<i>R. Davis</i> NA.	5/21/85
A.C.E. - Design	<i>R. L. Lora</i>	5/21/85	Traffic	NA with	5/21/85
A.C.E. - Hydrology	<i>W. L. Lora</i>	5/21/85	Water	<i>R. L. Lora</i> NA.	5/21/85
DRAWING NO. 2079			SHEET OF 16 16		