


Scale: 1" = 20'

NOTE

EXISTING ELECTRICAL CONDUIT IN MEDIAN. DO NOT DISTURB!
CONTACT TRAFFIC ENGINEERING AT 766-4754 BEFORE
EXCAVATING.

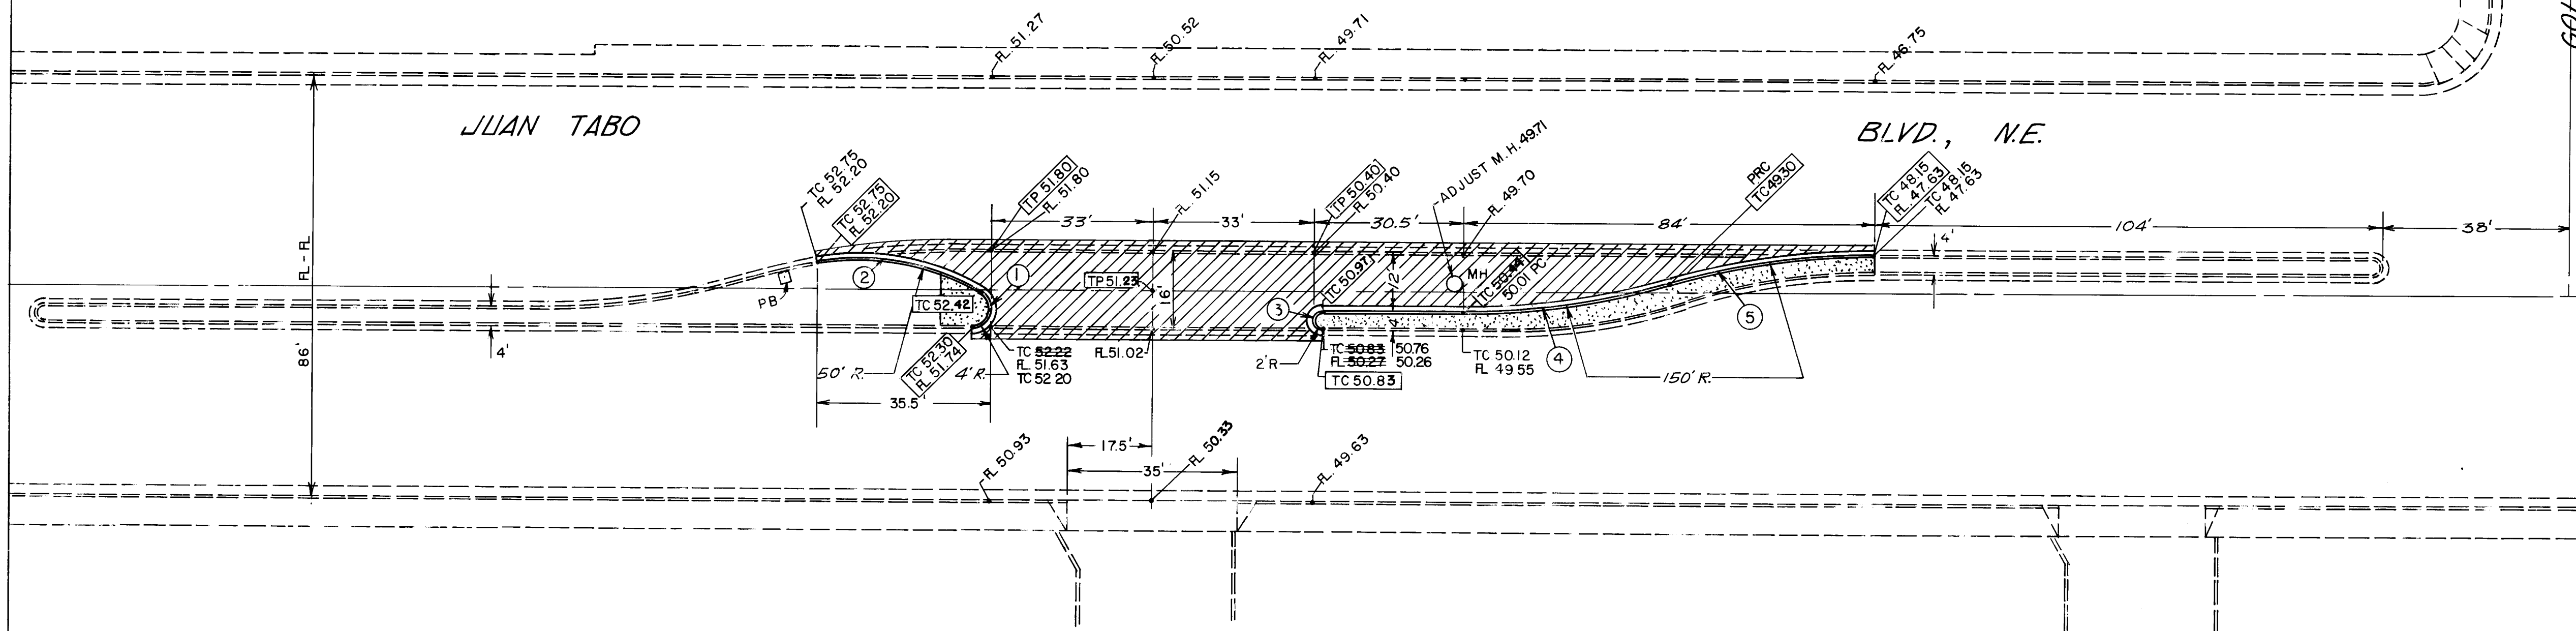

TRAFFIC HANDLING NOTES


1. CONTRACTOR MUST SUBMIT A CONSTRUCTION SIGNING AND BARRICADING PLAN TO TRAFFIC ENGINEERING DIVISION AND RECEIVE A BARRICADING PERMIT PRIOR TO CONSTRUCTION.
2. ALL CONSTRUCTION SIGNING AND BARRICADING TO COMPLY WITH MANUAL ON UNIFORM TRAFFIC CONTROL DEVICES, 1978 EDITION AND SUBSEQUENT REVISIONS.
3. CONTRACTOR'S OPERATION, BARRICADING AND SIGNING SHALL NOT AFFECT THRU LANES OF JUAN TABO BLVD BETWEEN 7 AM AND 9 AM OR 4 PM AND 6 PM.

JUAN TABO LIBRARY

CURVE DATA				
	R	Δ	T	L
①	4'	153°42'16"	17.12'	10.73'
②	50'	39°58'11"	18.18'	34.88'
③	2'	180°00'00"	—	6.28'
④	150'	16°15'38"	21.43'	42.57'
⑤	150'	16°15'38"	21.43'	42.57'

LEGEND

- CONCRETE MEDIAN NOSE, SIDEWALK STANDARD
- NEW ARTERIAL PAVING
- EXISTING MEDIAN CURB
- NEW MEDIAN CURB
- NEW ELEVATION
- EXISTING ELEVATION

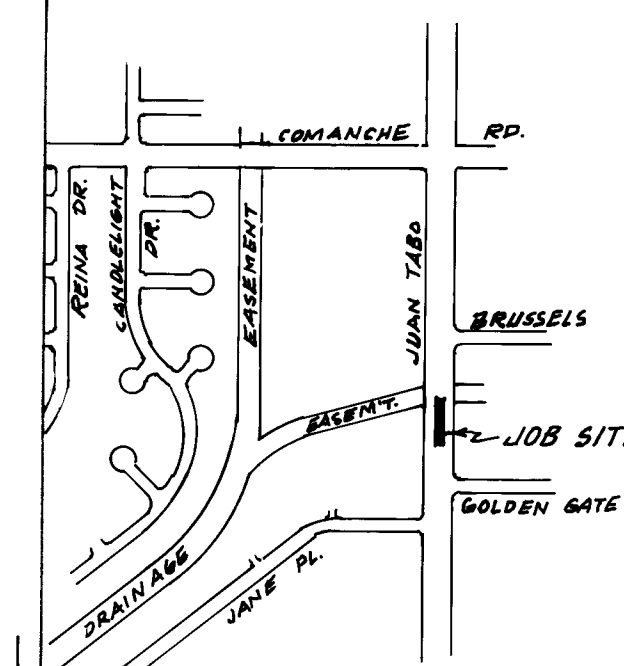

NOTICE TO CONTRACTORS

1. All work detailed on these plans to be performed under contract shall, except as otherwise stated or provided for herein, be constructed in accordance with the New Mexico Standard Specifications for Public Works Construction-1979 Edition (referred to herein as the Standard Specifications) and the Contract Documents for Public Works Contract 84-2.
2. Two (2) working days prior to any excavation, the contractor must contact Line Locating Service, 765-1234, for location of existing utilities.
3. Prior to construction, the contractor shall excavate and verify the horizontal and vertical locations of all obstructions. Should a conflict exist, the contractor shall notify the engineer or surveyor so that the conflict can be resolved with minimum amount of delay.

THE FOLLOWING NOTES ALSO APPLY WHEN CHECKED

- ☐ All utilities and utility service lines shall be installed prior to paving.
- ☒ Backfill compaction shall be according to specified street use. (ARTERIAL)
- ☒ Tack coat requirements shall be determined by the City Engineer.
- ☐ Sidewalks and wheelchair ramps within the curb returns shall be constructed wherever a new curb return is constructed.
- ☐ If curb is depressed for a driveway or a handicap ramp, the driveway or ramp shall be constructed prior to acceptance of the curb and gutter.
- ☐ All storm drainage facilities shall be completed prior to final acceptance.

W. J. Myer
8/21/84

20 2080 0184

CITY OF ALBUQUERQUE
MUNICIPAL DEVELOPMENT DEPARTMENT
ENGINEERING DIVISION

MR 84-1

TITLE
MEDIAN REVISION ON JUAN TABO NORTH OF
GOLDEN GATE FOR JUAN TABO LIBRARY

APPROVALS	ENGINEER	DATE	APPROVALS	ENGINEER	DATE
City Engineer	<i>[Signature]</i>	4/1/84	Liquid Waste	NA	3/21/84
A.C.E. Design	<i>[Signature]</i>	8/1/84	Traffic	NA	3/21/84
A.C.E. Hydrology	<i>[Signature]</i>	4/21/84	Water	NA	3/21/84

DRAWING NO	2080	MAP NO	6-21	SHEET	1	OF	1
------------	------	--------	------	-------	---	----	---