
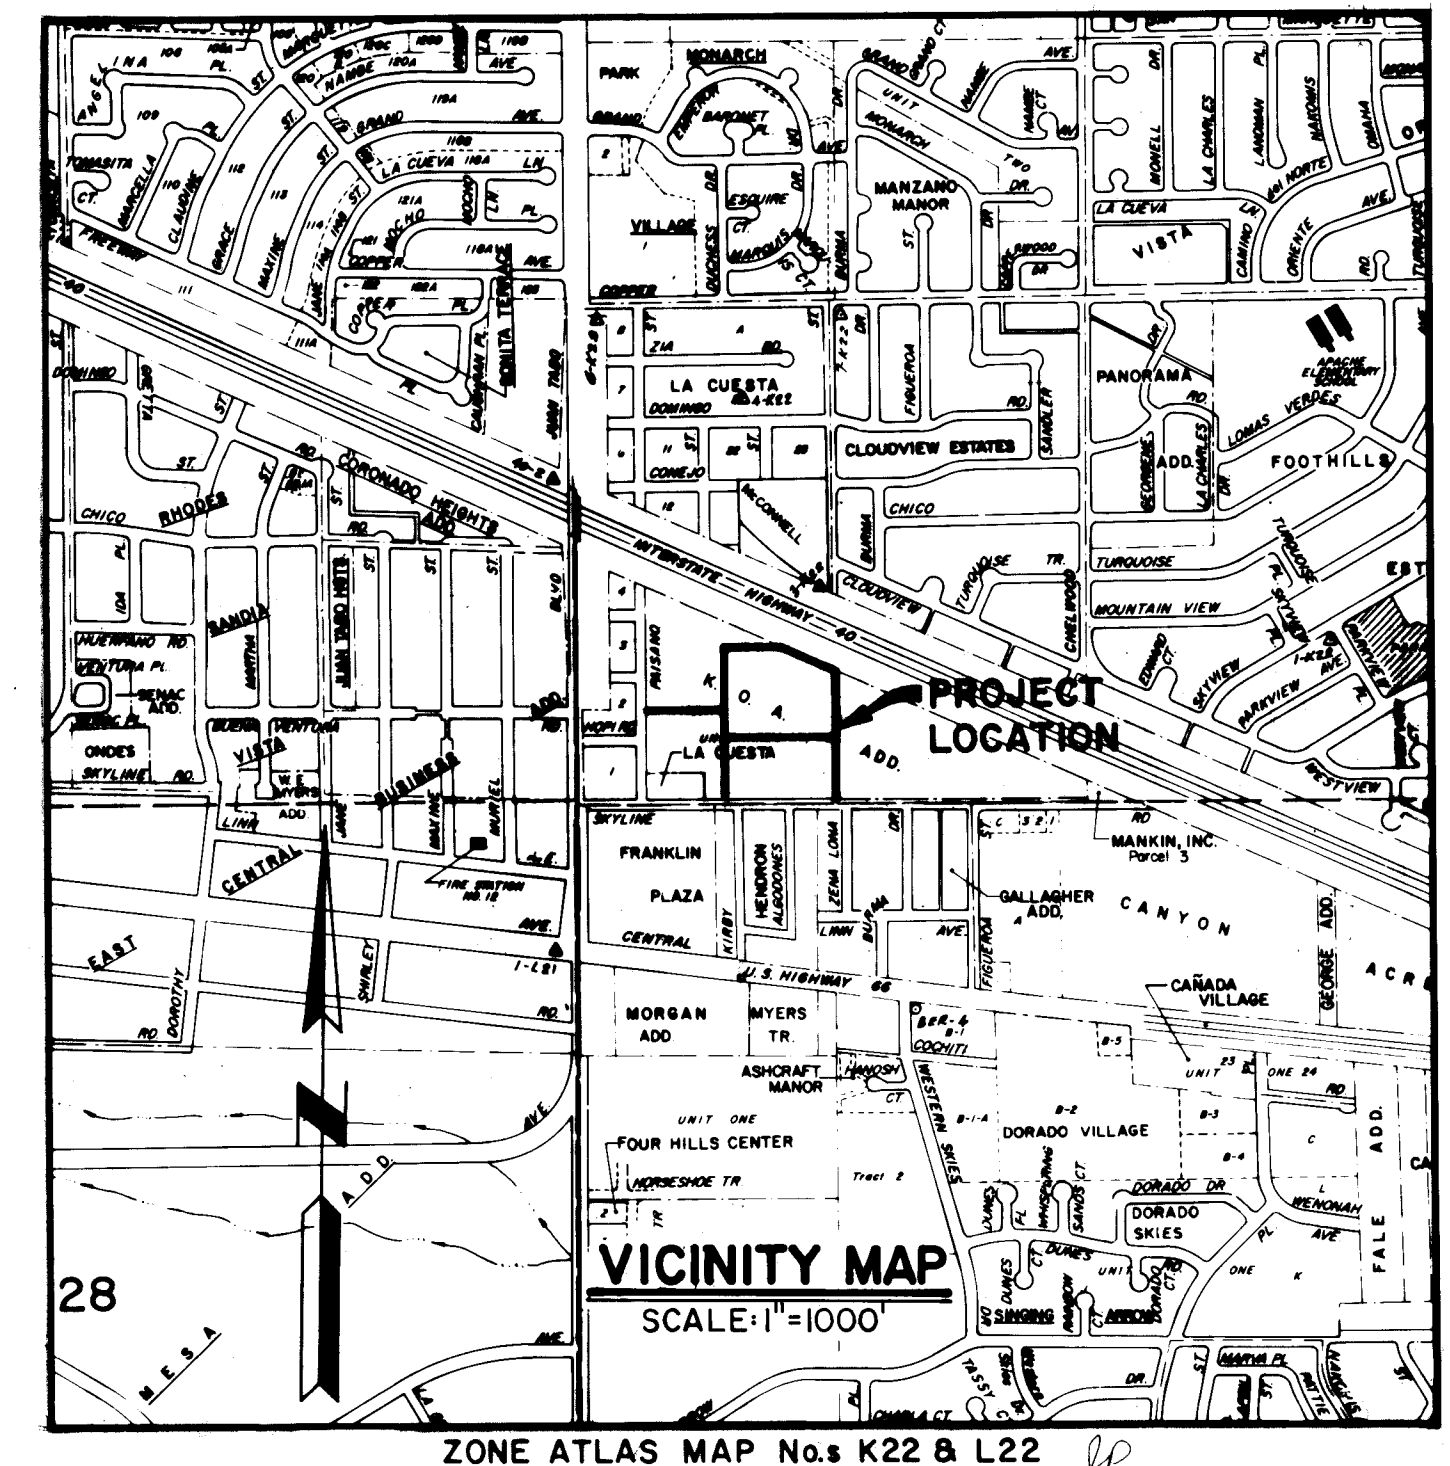
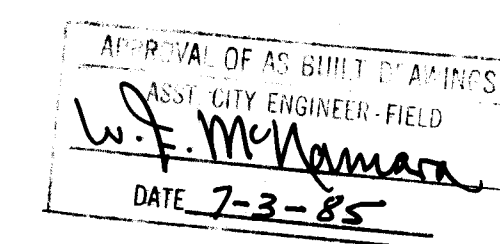


CITY OF ALBUQUERQUE NEW MEXICO WATER RESOURCES DEPARTMENT

SANDIA RIDGE WATERLINE EXTENSIONS

ANDREWS, ASBURY & ROBERT, INC.
CONSULTING ENGINEERS
ALBUQUERQUE NEW MEXICO

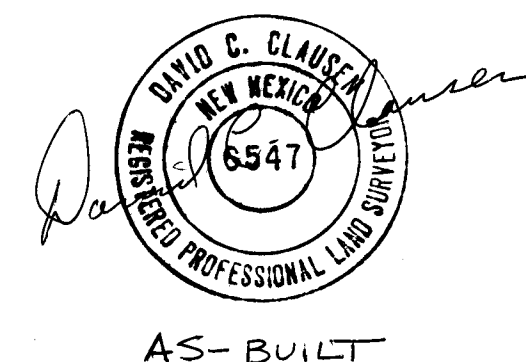

ZONE ATLAS MAP Nos K22 & L22

INDEX

DESCRIPTION	SHEET No.
TITLE SHEET & INDEX	1
SUBDIVISION PLAT	2
WATERLINE PLANS & GENERAL NOTES	3
WATERLINE 'A' PLAN & PROFILE STA. 4+44.76 TO STA. 9+00	4
STA. 9+00 TO STA. 18+43±	5
WATERLINE 'B' PLAN & PROFILE	6
WATERLINES 'C' & 'D' PLAN & PROFILE	7

26 20970185


APPROVED FOR
CONSTRUCTION
C.A. Andrews 7/4/85
CITY ENGINEER DATE

REV	SHEETS	CITY ENGINEER	DATE	USER DEPARTMENT	DATE	USER DEPARTMENT	DATE
Δ	567	<i>C.A. Andrews</i>	7/4/85	WRD	7/5/85		
APPROVAL OF REVISIONS							
ENGR'S FILE No. 84-367							


2097

SHEET 1 OF 7

5081

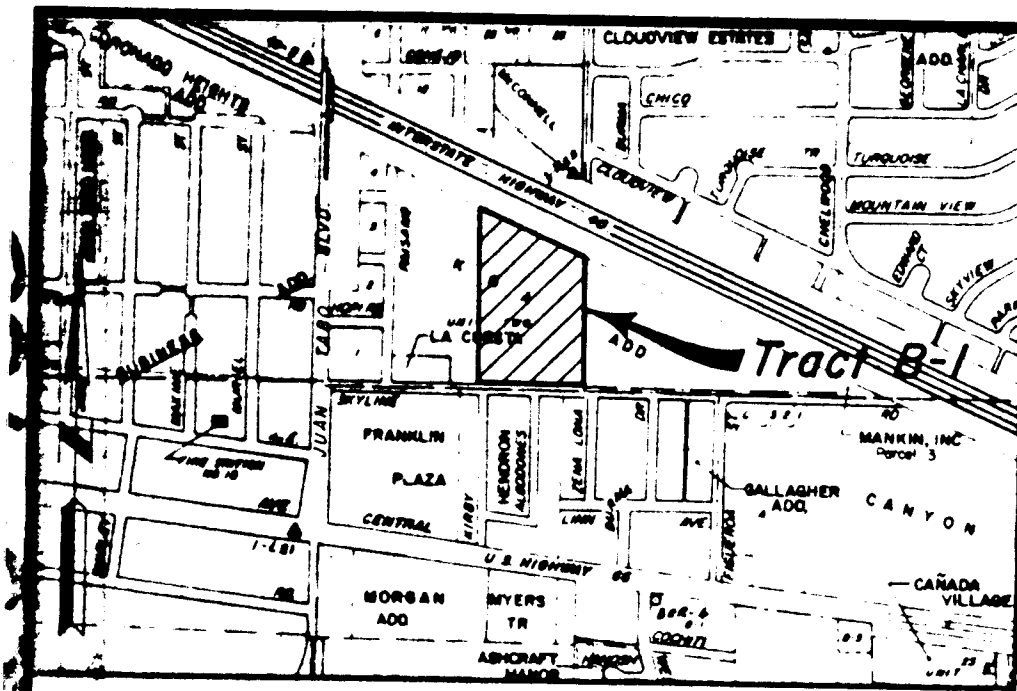

LOCATION MAP
Scale: 1" = 2000'

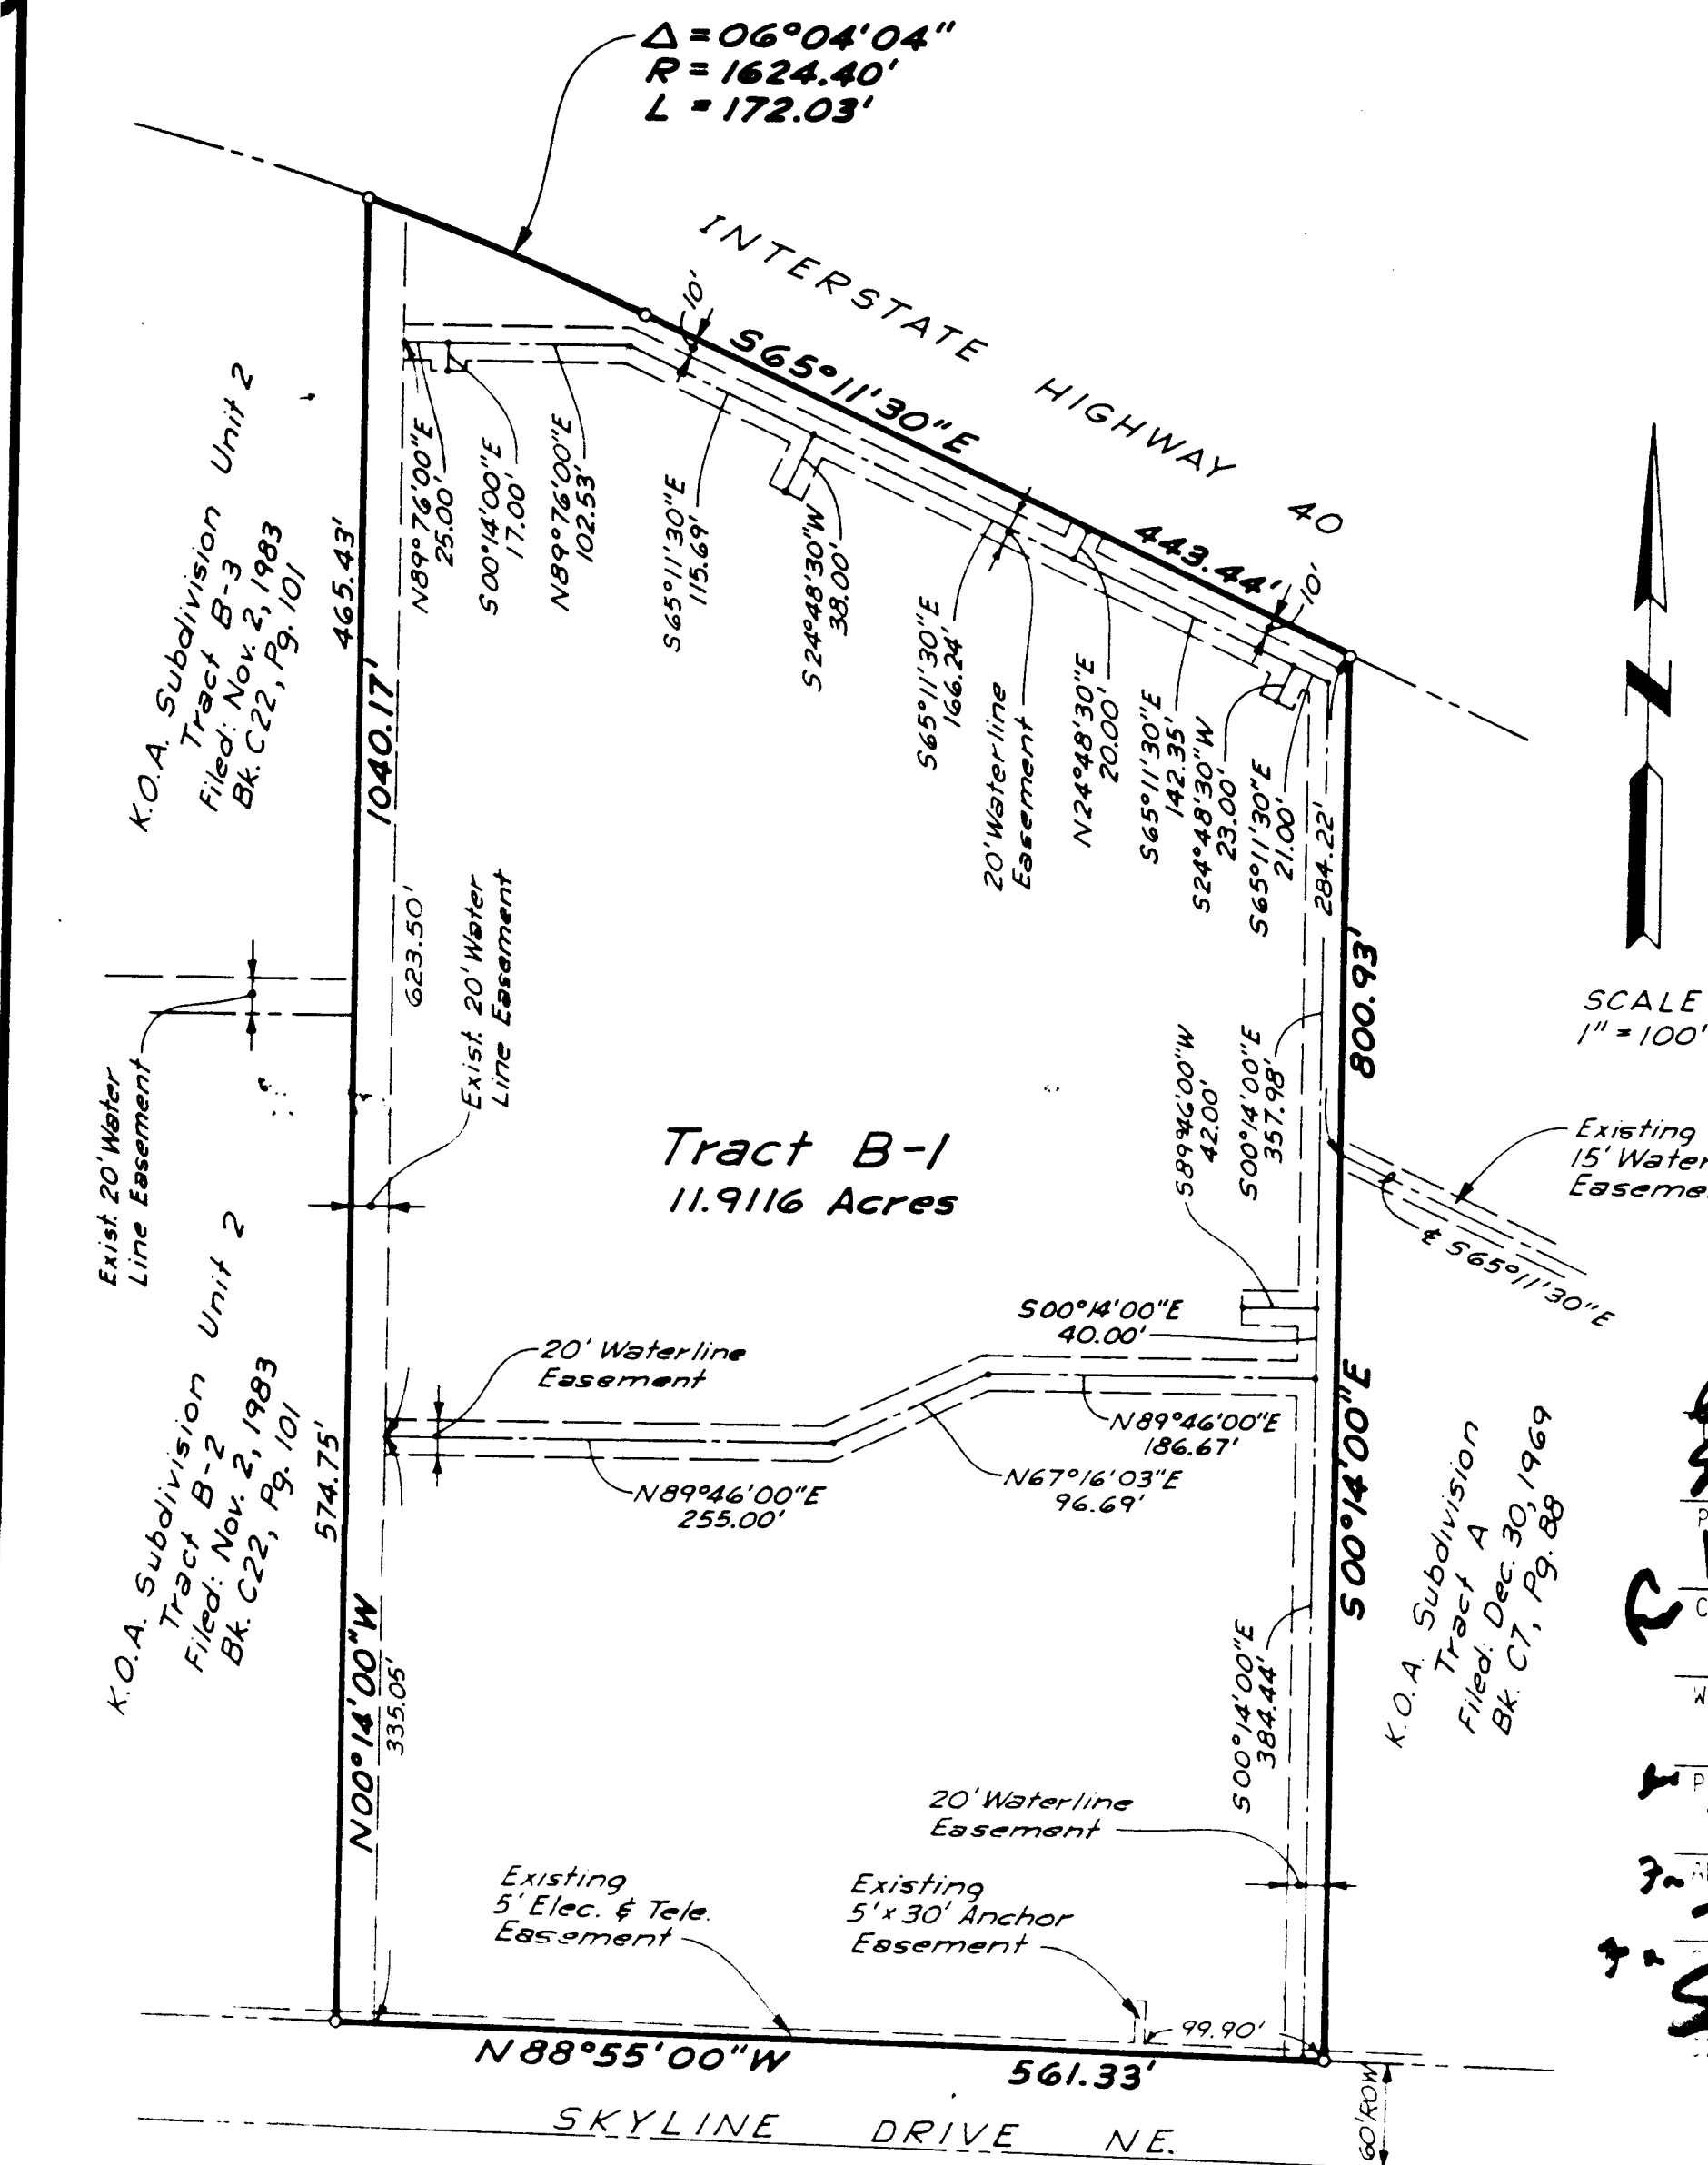

PURPOSE OF PLAT

THIS PLAT IS PREPARED TO DELINEATE AND GRANT THE EASEMENTS FOR CITY WATERLINES SHOWN HEREON.

84 25227

NOTES:

1. BEARINGS AND DISTANCES ARE AS SHOWN ON THE SUMMARY PLAT OF TRACT B, K.O.A. SUBDIVISION, UNIT 2 FILED NOVEMBER 2, 1983.
2. ALL WATERLINE EASEMENTS GRANTED BY THIS PLAT ARE 20 FEET IN WIDTH, BEING 10 FEET EACH SIDE OF THE DIMENSIONED CENTERLINES.
3. NO FIELD WORK WAS PERFORMED AND NO PROPERTY CORNERS WERE SET IN PREPARATION OF THIS PLAT.
4. THE WATERLINE EASEMENT AS SHOWN HEREON SHALL INCLUDE THE EXCLUSIVE RIGHT TO THE CITY OF ALBUQUERQUE TO PLACE UNDERGROUND UTILITIES WITHIN FIVE (5) FEET EACH SIDE OF A WATERLINE, EXCEPT FOR PERPENDICULAR CROSSINGS OR WHERE WRITTEN APPROVAL HAS BEEN OBTAINED FROM THE WATER RESOURCES DEPARTMENT.

REPLAT OF TRACT B-1 OF TRACT B, K.O.A. SUBDIVISION UNIT 2 TO SANDIA RIDGE WITHIN SECTION 22, T10N, R4E, N.M.P.M. ALBUQUERQUE, NEW MEXICO MARCH, 1984

LEGAL DESCRIPTION

A PARCEL OF LAND SITUATE WITHIN SECTION 22, TOWNSHIP 10 NORTH, RANGE 4 EAST, N.M.P.M., IN THE CITY OF ALBUQUERQUE, BERNALILLO COUNTY, NEW MEXICO, BEING TRACT B-1 OF TRACT B, K.O.A. SUBDIVISION, UNIT 2 AS THE SAME IS SHOWN AND DESIGNATED ON THE SUMMARY PLAT THEREOF FILED IN THE OFFICE OF THE COUNTY CLERK OF BERNALILLO COUNTY, NEW MEXICO ON NOVEMBER 2, 1983, IN BOOK C-22, PAGE 101, AND BEING MORE PARTICULARLY DESCRIBED AS FOLLOWS:

BEGINNING AT THE SOUTHWEST CORNER OF SAID TRACT B-1; THENCE,

N 00°14'00" W, A DISTANCE OF 1040.17 FEET TO THE NORTHWEST CORNER OF SAID TRACT B-1, A POINT ON CURVE; THENCE,

EASTERLY, A DISTANCE OF 172.03 FEET ALONG THE ARC OF A CURVE BEARING TO THE RIGHT HAVING A RADIUS OF 1624.40 FEET AND A CENTRAL ANGLE OF 6°04'04" TO A POINT OF TANGENCY; THENCE,

S 65°11'30" E, A DISTANCE OF 443.44 FEET TO THE NORTHEAST CORNER OF SAID TRACT B-1; THENCE,

S 00°14'00" E, A DISTANCE OF 800.93 FEET TO THE SOUTHEAST CORNER OF SAID TRACT B-1; THENCE,

N 88°55'00" W, A DISTANCE OF 561.33 FEET TO THE POINT OF BEGINNING AND CONTAINING 11.9116 ACRES, MORE OR LESS.

OWNER'S CERTIFICATE

SURVEYED AND PLATTED AS SHOWN HEREON IS WITH THE FREE CONSENT AND IN ACCORDANCE WITH THE WISHES AND DESIRES OF THE UNDERSIGNED OWNERS IN FEE SIMPLE OF THE PROPERTY SHOWN HEREON, AND SAID OWNERS DO HEREBY GRANT TO THE CITY OF ALBUQUERQUE IN PERPETUITY THE WATERLINE EASEMENTS SHOWN HEREON INCLUDING THE RIGHT TO CONSTRUCT AND MAINTAIN WATERLINE THEREIN WITH THE RIGHTS OF INGRESS AND EGRESS AND THE RIGHT TO TRIM INTERFERING TREES, AND SAID OWNERS CONSENT TO THE FOREGOING AND DO HEREBY REPRESENT THAT WE ARE AUTHORIZED TO SO ACT.

SANDIA RIDGE PARTNERS, LTD., A NEW MEXICO LIMITED PARTNERSHIP
BY: GREENER & SUMNER, INC., GENERAL PARTNER

ALAN R. SUMNER, VICE PRESIDENT

ACKNOWLEDGEMENT

STATE OF TEXAS

COUNTY OF DALLAS } SS.

SUBSCRIBED AND SWORN TO BEFORE ME THIS 13TH DAY OF March, 1984, BY ALAN R. SUMNER, THE VICE PRESIDENT OF GREENER & SUMNER, INC., A TEXAS CORPORATION.

MY COMMISSION EXPIRES:

NOTARY PUBLIC

SURVEYOR'S CERTIFICATE

I, GAYLE JEWELL, DO HEREBY CERTIFY THAT I AM A REGISTERED LAND SURVEYOR UNDER THE LAWS OF THE STATE OF NEW MEXICO, AND THAT THIS PLAT WAS PREPARED BY ME OR UNDER MY SUPERVISION, SHOWS ALL EASEMENTS OF RECORD, MEETS THE MINIMUM REQUIREMENTS FOR MONUMENTATION AND SURVEYS OF THE ALBUQUERQUE SUBDIVISION ORDINANCE, AND IS TRUE AND CORRECT TO THE BEST OF MY KNOWLEDGE AND BELIEF.

GAYLE JEWELL, L.S. NO. 4071

DATE

APPROVALS

APPROVALS
CITY ENGINEER, TRANSPORTATION DEPARTMENT
CITY ENGINEER, PARKS AND RECREATION DEPARTMENT
CITY ENGINEER, ENGINEERING DIVISION
CITY ENGINEER, WATER RESOURCES DEPARTMENT
CITY ENGINEER, PROPERTY MANAGEMENT
CITY ENGINEER, ALBUQUERQUE METROPOLITAN ARROYO FLOOD CONTROL AUTHORITY
CITY ENGINEER, ENGINEERING DIVISION
CITY ENGINEER, ALBUQUERQUE/BERNALILLO COUNTY PLANNING DIVISION

SP-84-145

ANDREWS, ASBURY & ROBERT, INC.
ALBUQUERQUE CONSULTING ENGINEERS
NEW MEXICO



AS-BUILT

AS BUILT INFORMATION		BENCH MARKS		SURVEY INFORMATION		FIELD NOTES		ENGINEER'S SEAL		REVISIONS		DESIGN		DRAWN BY		CHECKED BY	
CONTRACTOR	DATE	STANDARD	ELEVATION	NO.	BY	DATE	DATE	NO.	DATE	NO.	DATE	NO.	DATE	NO.	DATE	NO.	DATE
AS-BUILT	1-1-121	RESET	5534.54	1	BY	DATE	DATE	1	DATE	1	DATE	1	DATE	1	DATE	1	DATE
INSPECTOR'S	DATE	STANDARD	ELEVATION	NO.	BY	DATE	DATE	1	DATE	1	DATE	1	DATE	1	DATE	1	DATE
FIELD	DATE	STANDARD	ELEVATION	NO.	BY	DATE	DATE	1	DATE	1	DATE	1	DATE	1	DATE	1	DATE
VERIFICATION	DATE	STANDARD	ELEVATION	NO.	BY	DATE	DATE	1	DATE	1	DATE	1	DATE	1	DATE	1	DATE
CORRECTION	DATE	STANDARD	ELEVATION	NO.	BY	DATE	DATE	1	DATE	1	DATE	1	DATE	1	DATE	1	DATE
RECORDED	DATE	STANDARD	ELEVATION	NO.	BY	DATE	DATE	1	DATE	1	DATE	1	DATE	1	DATE	1	DATE
NO.	DATE	STANDARD	ELEVATION	NO.	BY	DATE	DATE	1	DATE	1	DATE	1	DATE	1	DATE	1	DATE


1 2 3 4 5 6 7 8 9 10 11 12
26 20970285

CITY OF ALBUQUERQUE
WATER RESOURCES DEPARTMENT
ENGINEERING DIVISION


SANDIA RIDGE WATERLINE EXTENSIONS SUBDIVISION PLAT

APPROVALS	ENGINEER	DATE	APPROVALS	ENGINEER	DATE
City Engineer	David C. Clausen	7/25/84	Liquid Waste	R. D. D.	7/25/84
A.C.E. - Design	N.A. A.P.S.	7/25/84	Traffic	N.A. D.H.	7/25/84
A.C.E. - Hydrology	N.A. A.P.S.	7/25/84	Water	R. D. D.	7/25/84

DRAWING NO. 2097 MAP NO. K-22 & L-22 SHEET 2 OF 7

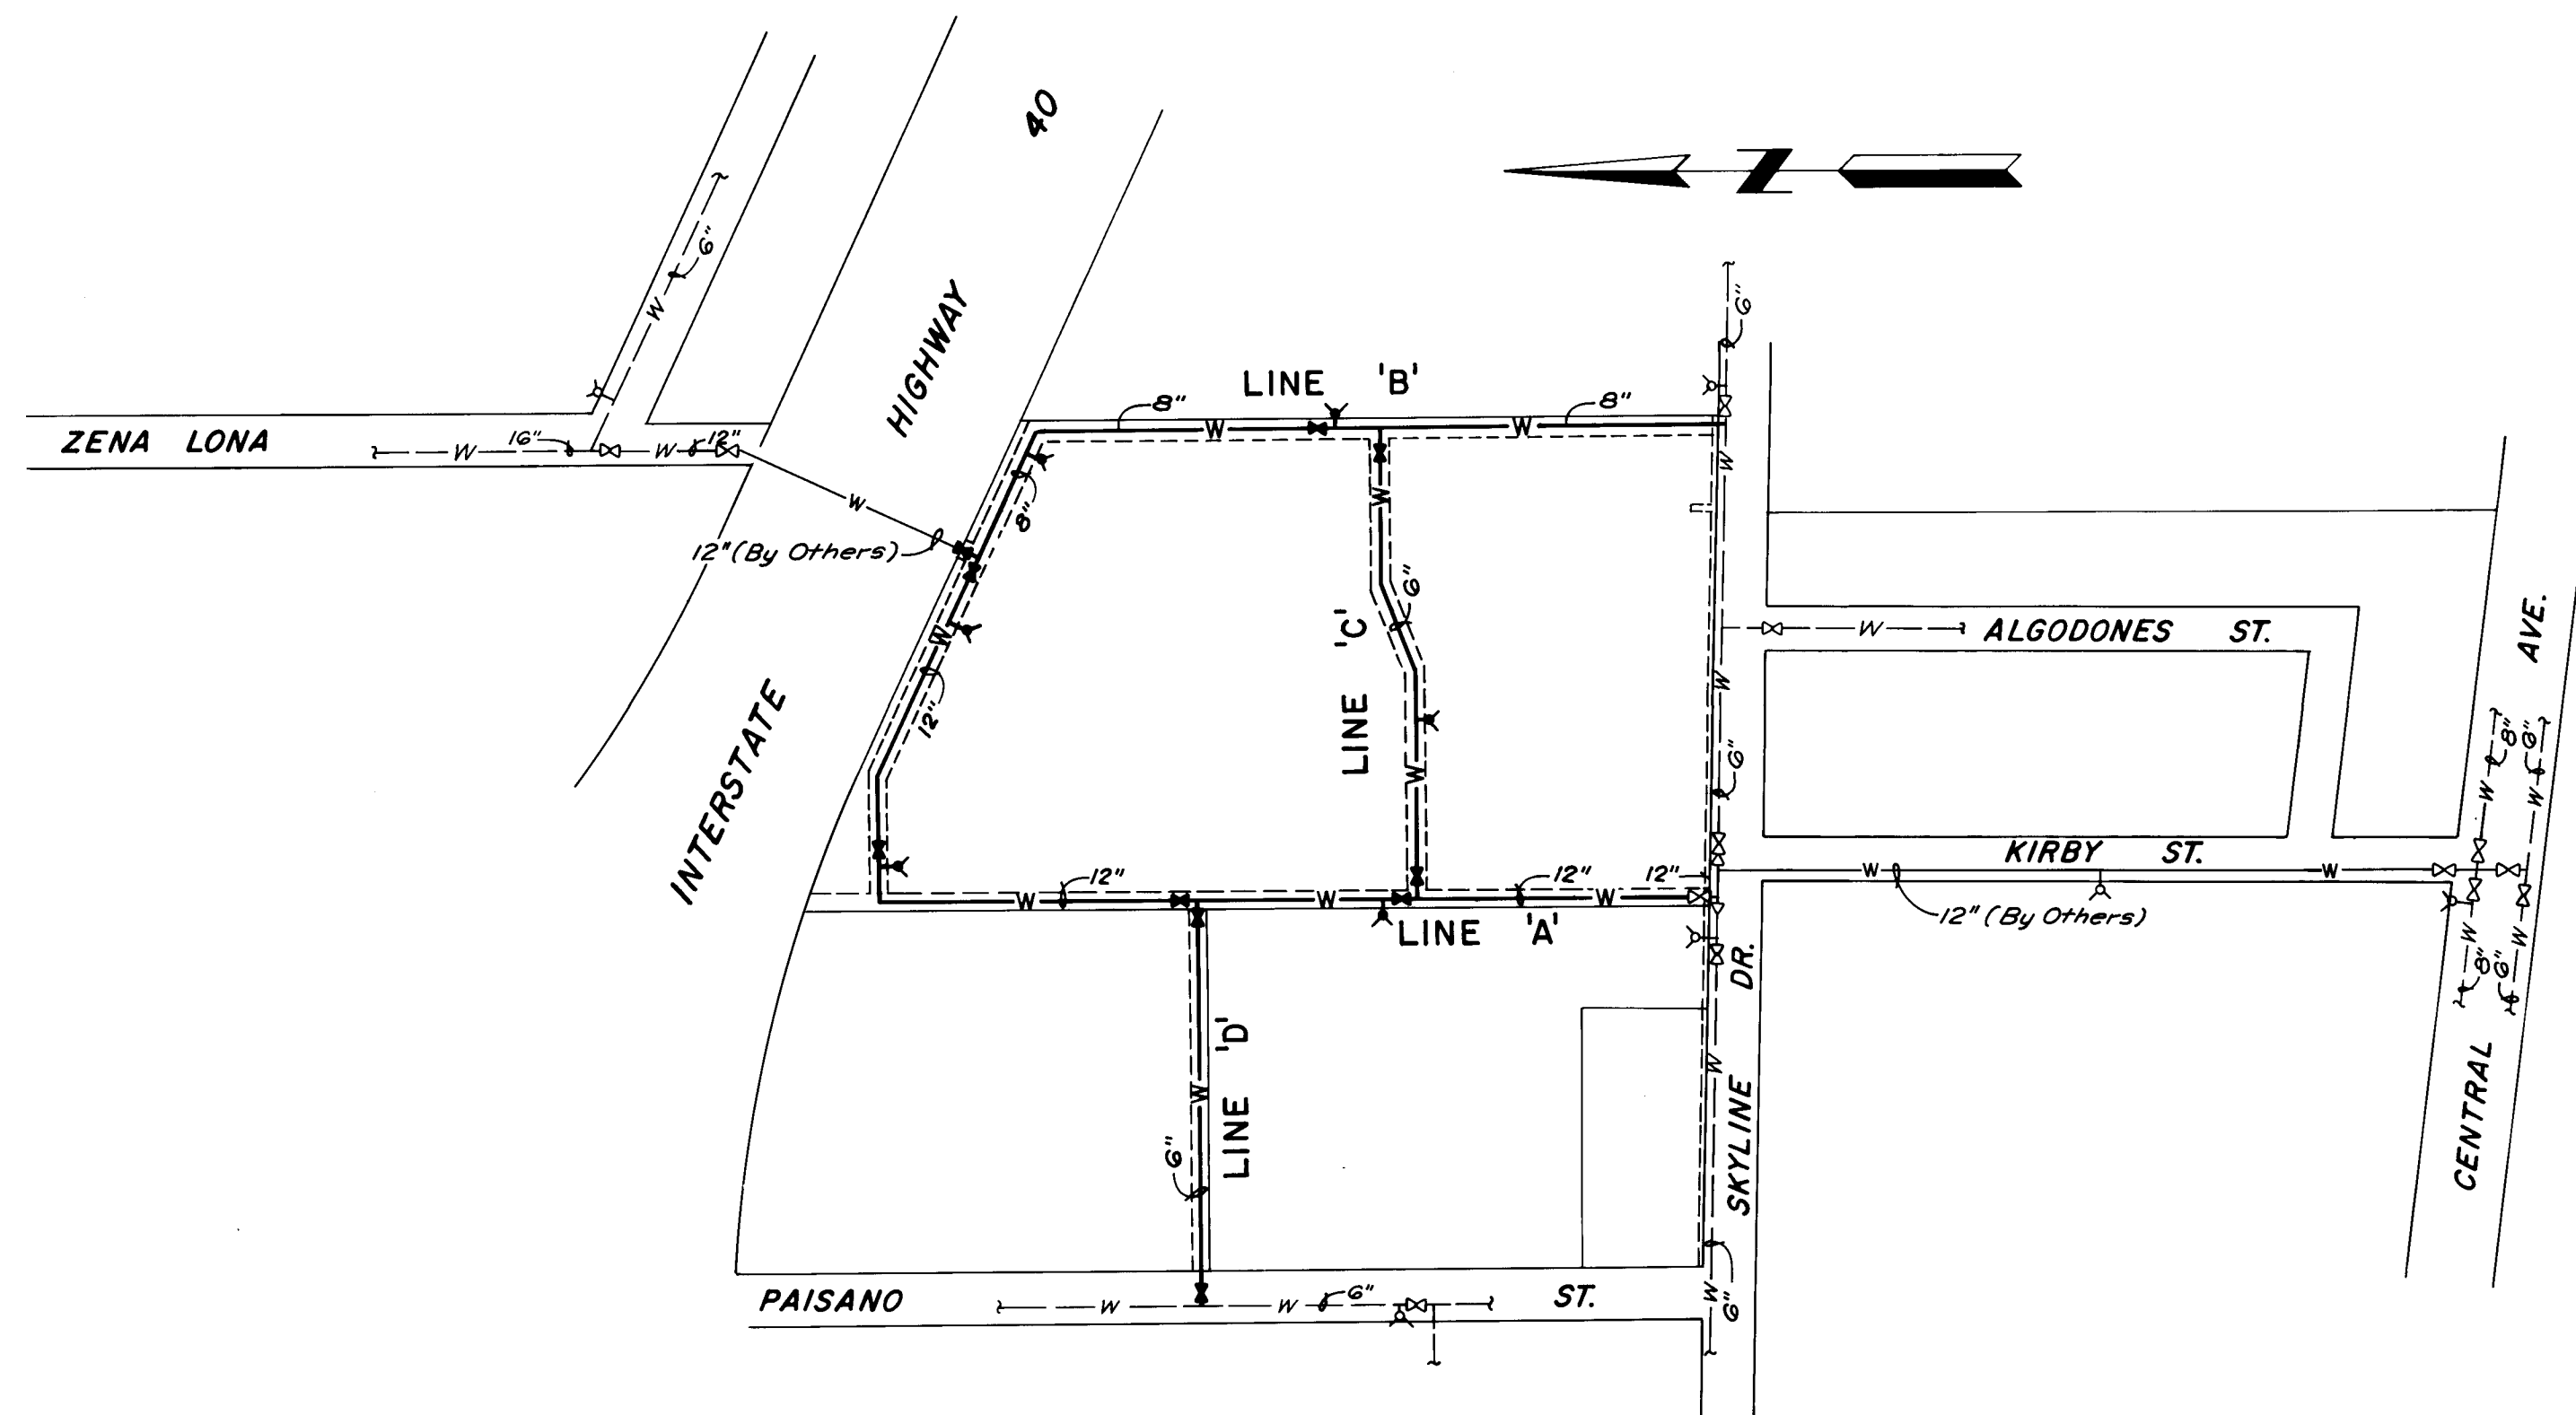


WATERLINE PLAN
SCALE: 1" = 200'

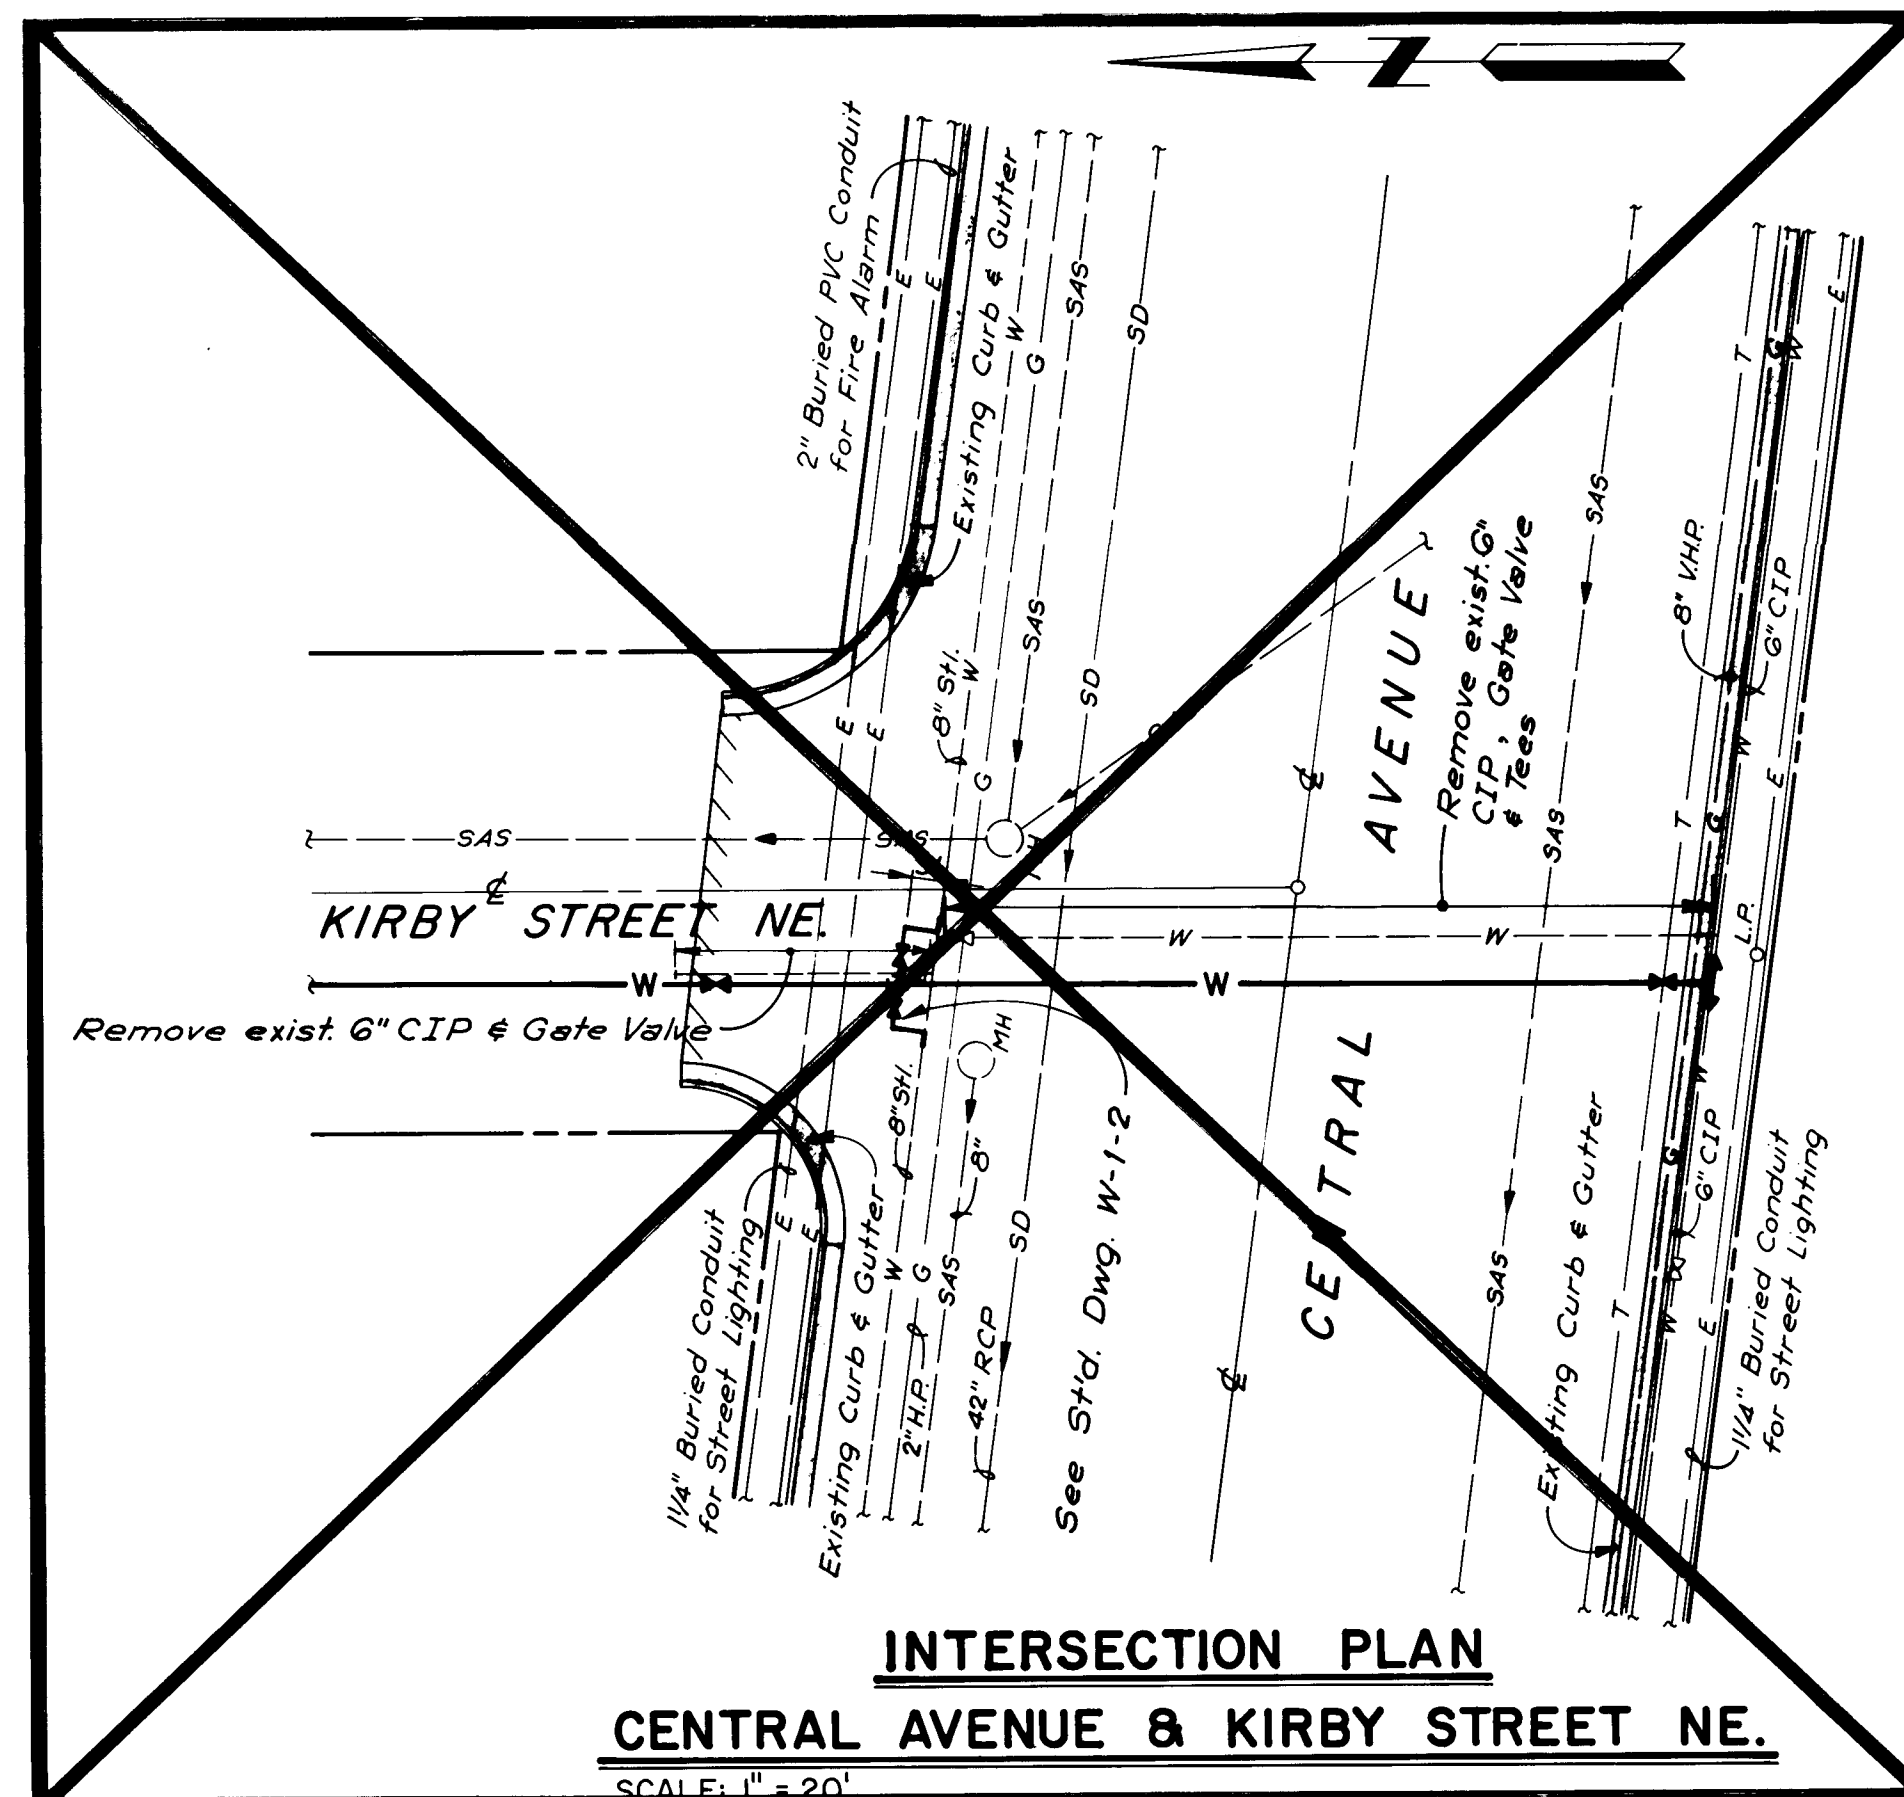

INTERSECTION PLAN
CENTRAL AVENUE & KIRBY STREET NE.
SCALE: 1" = 20'

GENERAL NOTES

- NEW MEXICO STANDARD SPECIFICATIONS FOR PUBLIC WORKS CONSTRUCTION - 1979 EDITION WILL BE REFERRED TO HEREON AS THE "STANDARD SPECIFICATION".
- ALL WORK DETAILED ON THESE PLANS TO BE PERFORMED UNDER THIS CONTRACT SHALL, EXCEPT AS OTHERWISE STATED OR PROVIDED FOR HEREON, BE CONSTRUCTED IN ACCORDANCE WITH THE CITY OF ALBUQUERQUE, PUBLIC WORKS CONTRACT NO. 84-1.
- REFERENCES MADE TO STANDARD DRAWINGS REFER TO CITY OF ALBUQUERQUE STANDARD DRAWINGS.
- TWO WORKING DAYS PRIOR TO ANY EXCAVATION, CONTRACTOR MUST CONTACT LINE LOCATING SERVICE, 765-1234, FOR LOCATION OF EXISTING UTILITIES.
- PRIOR TO CONSTRUCTION, THE CONTRACTOR SHALL EXCAVATE AND VERIFY THE HORIZONTAL AND VERTICAL LOCATIONS OF ALL OBSTRUCTIONS. SHOULD A CONFLICT EXIST, THE CONTRACTOR SHALL NOTIFY THE ENGINEER OR SURVEYOR SO THAT THE CONFLICT CAN BE RESOLVED WITH A MINIMUM AMOUNT OF DELAY.
- ALL UTILITIES AND UTILITY SERVICE LINES SHALL BE INSTALLED PRIOR TO PAVING.
BACKFILL COMPACTION SHALL BE ACCORDING TO SPECIFIED STREET USE.
TACK COAT REQUIREMENTS SHALL BE DETERMINED BY THE ENGINEER.
CONTRACTOR SHALL PROVIDE 12" SUBGRADE PREPARATION UNDER ALL NEW PAVEMENT, CURBS & GUTTERS, VALLEY GUTTERS, AND CONCRETE FILLETS.
- SUBGRADE PREPARATION UNDER CURB AND GUTTER (INCLUDING ONE FOOT BEHIND BACK OF CURB, UNDER VALLEY GUTTERS, UNDER CONCRETE MEDIAN PAVEMENT AND SIDEWALKS SHALL BE CONSIDERED INCIDENTAL TO THE CONSTRUCTION OF SUCH AND SHALL BE INCLUDED IN THE BID ITEM PRICE FOR SUCH ITEMS).
- WHEN ABUTTING NEW PAVEMENT TO EXISTING, CUT BACK EXISTING PAVEMENT TO A NEAT STRAIGHT LINE AS REQUIRED TO REMOVE ANY BROKEN OR CRACKED PAVEMENT, AND MATCH NEW TO EXISTING. NO SEPARATE PAYMENT SHALL BE MADE FOR SUCH CUTTING OF EXISTING PAVEMENT BUT SHALL BE CONSIDERED INCIDENTAL TO THE PROJECT. CUTTING OF PAVEMENT SHALL BE IN CONFORMANCE WITH THE SPECIFICATIONS.
- CURB AND GUTTER SHOWN AS EXISTING AND NOT TO BE REMOVED UNDER THE CONTRACT WHICH IS DAMAGED OR DISPLACED BY THE CONTRACTOR SHALL BE REMOVED AND REPLACED BY THE CONTRACTOR AT HIS EXPENSE.
- ALL WATER VALVE BOXES AND SEWER MANHOLES IN THE CONSTRUCTION AREA ARE TO BE ADJUSTED TO FINISH GRADE UNDER THIS CONTRACT.
- A DISPOSAL SITE FOR ALL EXCESS EARTH MATERIAL AND FOR REMOVAL ITEMS SHALL BE OBTAINED BY THE CONTRACTOR. THE SITE SHALL BE IN COMPLIANCE WITH APPLICABLE ENVIRONMENTAL REGULATIONS AND APPROVED BY THE CITY ENGINEERING DEPARTMENT. ALL COSTS INCURRED IN OBTAINING AN ACCEPTABLE SITE AND HAUL THERE TO SHALL BE CONSIDERED INCIDENTAL TO CONSTRUCTION AND NO DIRECT PAYMENT WILL BE MADE THEREFOR.
- EXCAVATION AND BACKFILL FOR STRUCTURES WILL NOT BE MEASURED AND PAID FOR SEPARATELY BUT SHALL BE INCLUDED IN THE BID ITEM FOR WHICH THE WORK APPLIES.
- MEASUREMENT FOR PAYMENT OF VALLEY GUTTER SHALL BE MADE PER SQUARE FOOT OF HORIZONTAL SURFACE AREA. PAYMENT PER SQUARE FOOT SHALL INCLUDE STEEL REINFORCEMENT.
- ALL PERMANENT PAVEMENT MARKING AND TRAFFIC SIGNING WILL BE PERFORMED BY THE CITY OF ALBUQUERQUE TRAFFIC ENGINEERING DEPARTMENT.
- ALL FITTINGS ON WATERLINES SHALL HAVE CONCRETE BLOCKING EXCEPT WHERE SPECIFICALLY INDICATED TO HAVE LOCKED MECHANICAL JOINTS. SEE STANDARD DRAWING W-22. NO SEPARATE PAYMENT WILL BE MADE FOR BLOCKING OR FOR LOCKED MECHANICAL JOINTS.
- ELECTRONIC MARKER DISCS SHALL BE PLACED IN ACCORDANCE WITH SECTION 131 OF THE CITY OF ALBUQUERQUE - PUBLIC WORKS CONTRACT NO. 84-1. NO SEPARATE PAYMENT WILL BE MADE FOR ELECTRONIC MARKER DISCS.
- CONTRACTOR SHALL ASSIST THE ENGINEER/INSPECTOR IN THE RECORDING OF DATA ON ALL UTILITY LINES & ACCESSORIES AS REQUIRED BY THE CITY OF ALBUQUERQUE FOR THE PREPARATION OF "AS CONSTRUCTED" DRAWINGS. CONTRACTOR SHALL NOT COVER UTILITY LINES & ACCESSORIES UNTIL ALL DATA HAS BEEN RECORDED.
- WATERLINES MAY BE DUCTILE IRON OR PVC EXCEPT WHERE SPECIFICALLY INDICATED TO BE DUCTILE IRON.
- ALL FIRE HYDRANTS SHALL HAVE 3' x 3' CONCRETE PAD. SEE STANDARD DRAWING W20-1.

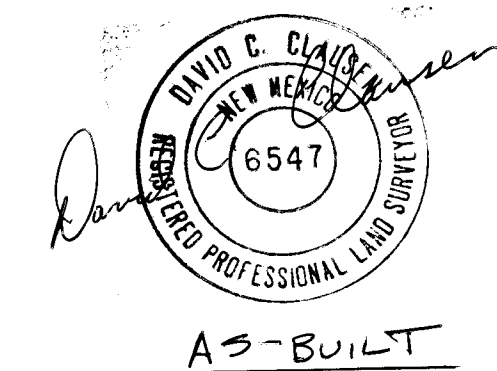

AS-BUILT


26 20970385





CITY OF ALBUQUERQUE
WATER RESOURCES DEPARTMENT
ENGINEERING DIVISION

SANDIA RIDGE WATERLINE EXTENSIONS WATERLINE PLANS & GENERAL NOTES

APPROVALS	ENGINEER	DATE	APPROVALS	ENGINEER	DATE
City Engineer	<i>R. Pina</i>	7/25/84	Liquid Waste	<i>R. Pina</i>	7/25/84
A C E - Design	<i>N.A. D.M.H.</i>	7/25/84	Traffic	<i>N.A. D.M.H.</i>	7/25/84
A C E - Hydrology	<i>N.A. A.G.A.</i>	7/25/84	Water	<i>R. Pina</i>	7/25/84

DRAWING NO.	2097	MAP NO.	K-22 & L-22	SHEET	3	OF	7
-------------	------	---------	-------------	-------	---	----	---

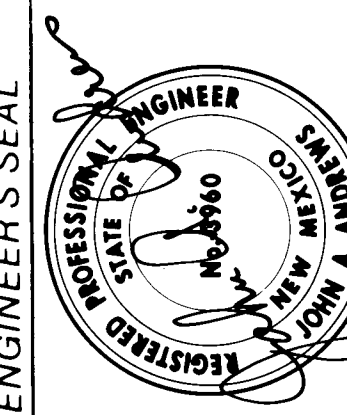AS BUILT INFORMATION		BENCH MARKS		SURVEY INFORMATION		ENGINEER'S SEAL		REVISIONS	
CONTRACTOR		DATE		NO.	BY	 ANDREWS ASSURANCE & ROBERT INC. ALBUQUERQUE CONSULTING ENGINEERS ALBUQUERQUE, NEW MEXICO 84-357		NO.	DATE
INSPECTOR'S		DATE						DESIGNED BY	DATE
FIELD ENGINEER		DATE				ELEV = 5534.54 FEET (MSLD) STANDARD ACS BRASS CAP STAMPED "1-121 RESET 1974" LOCATED IN TOP OF MEDIAN CURB 5' NORTH OF CENTERLINE OF CENTRAL AVENUE & 81' WEST OF JUAN TABO BOULEVARD CENTERLINE		DRAWN BY	DATE
RECORDED BY		DATE						CHECKED BY	DATE

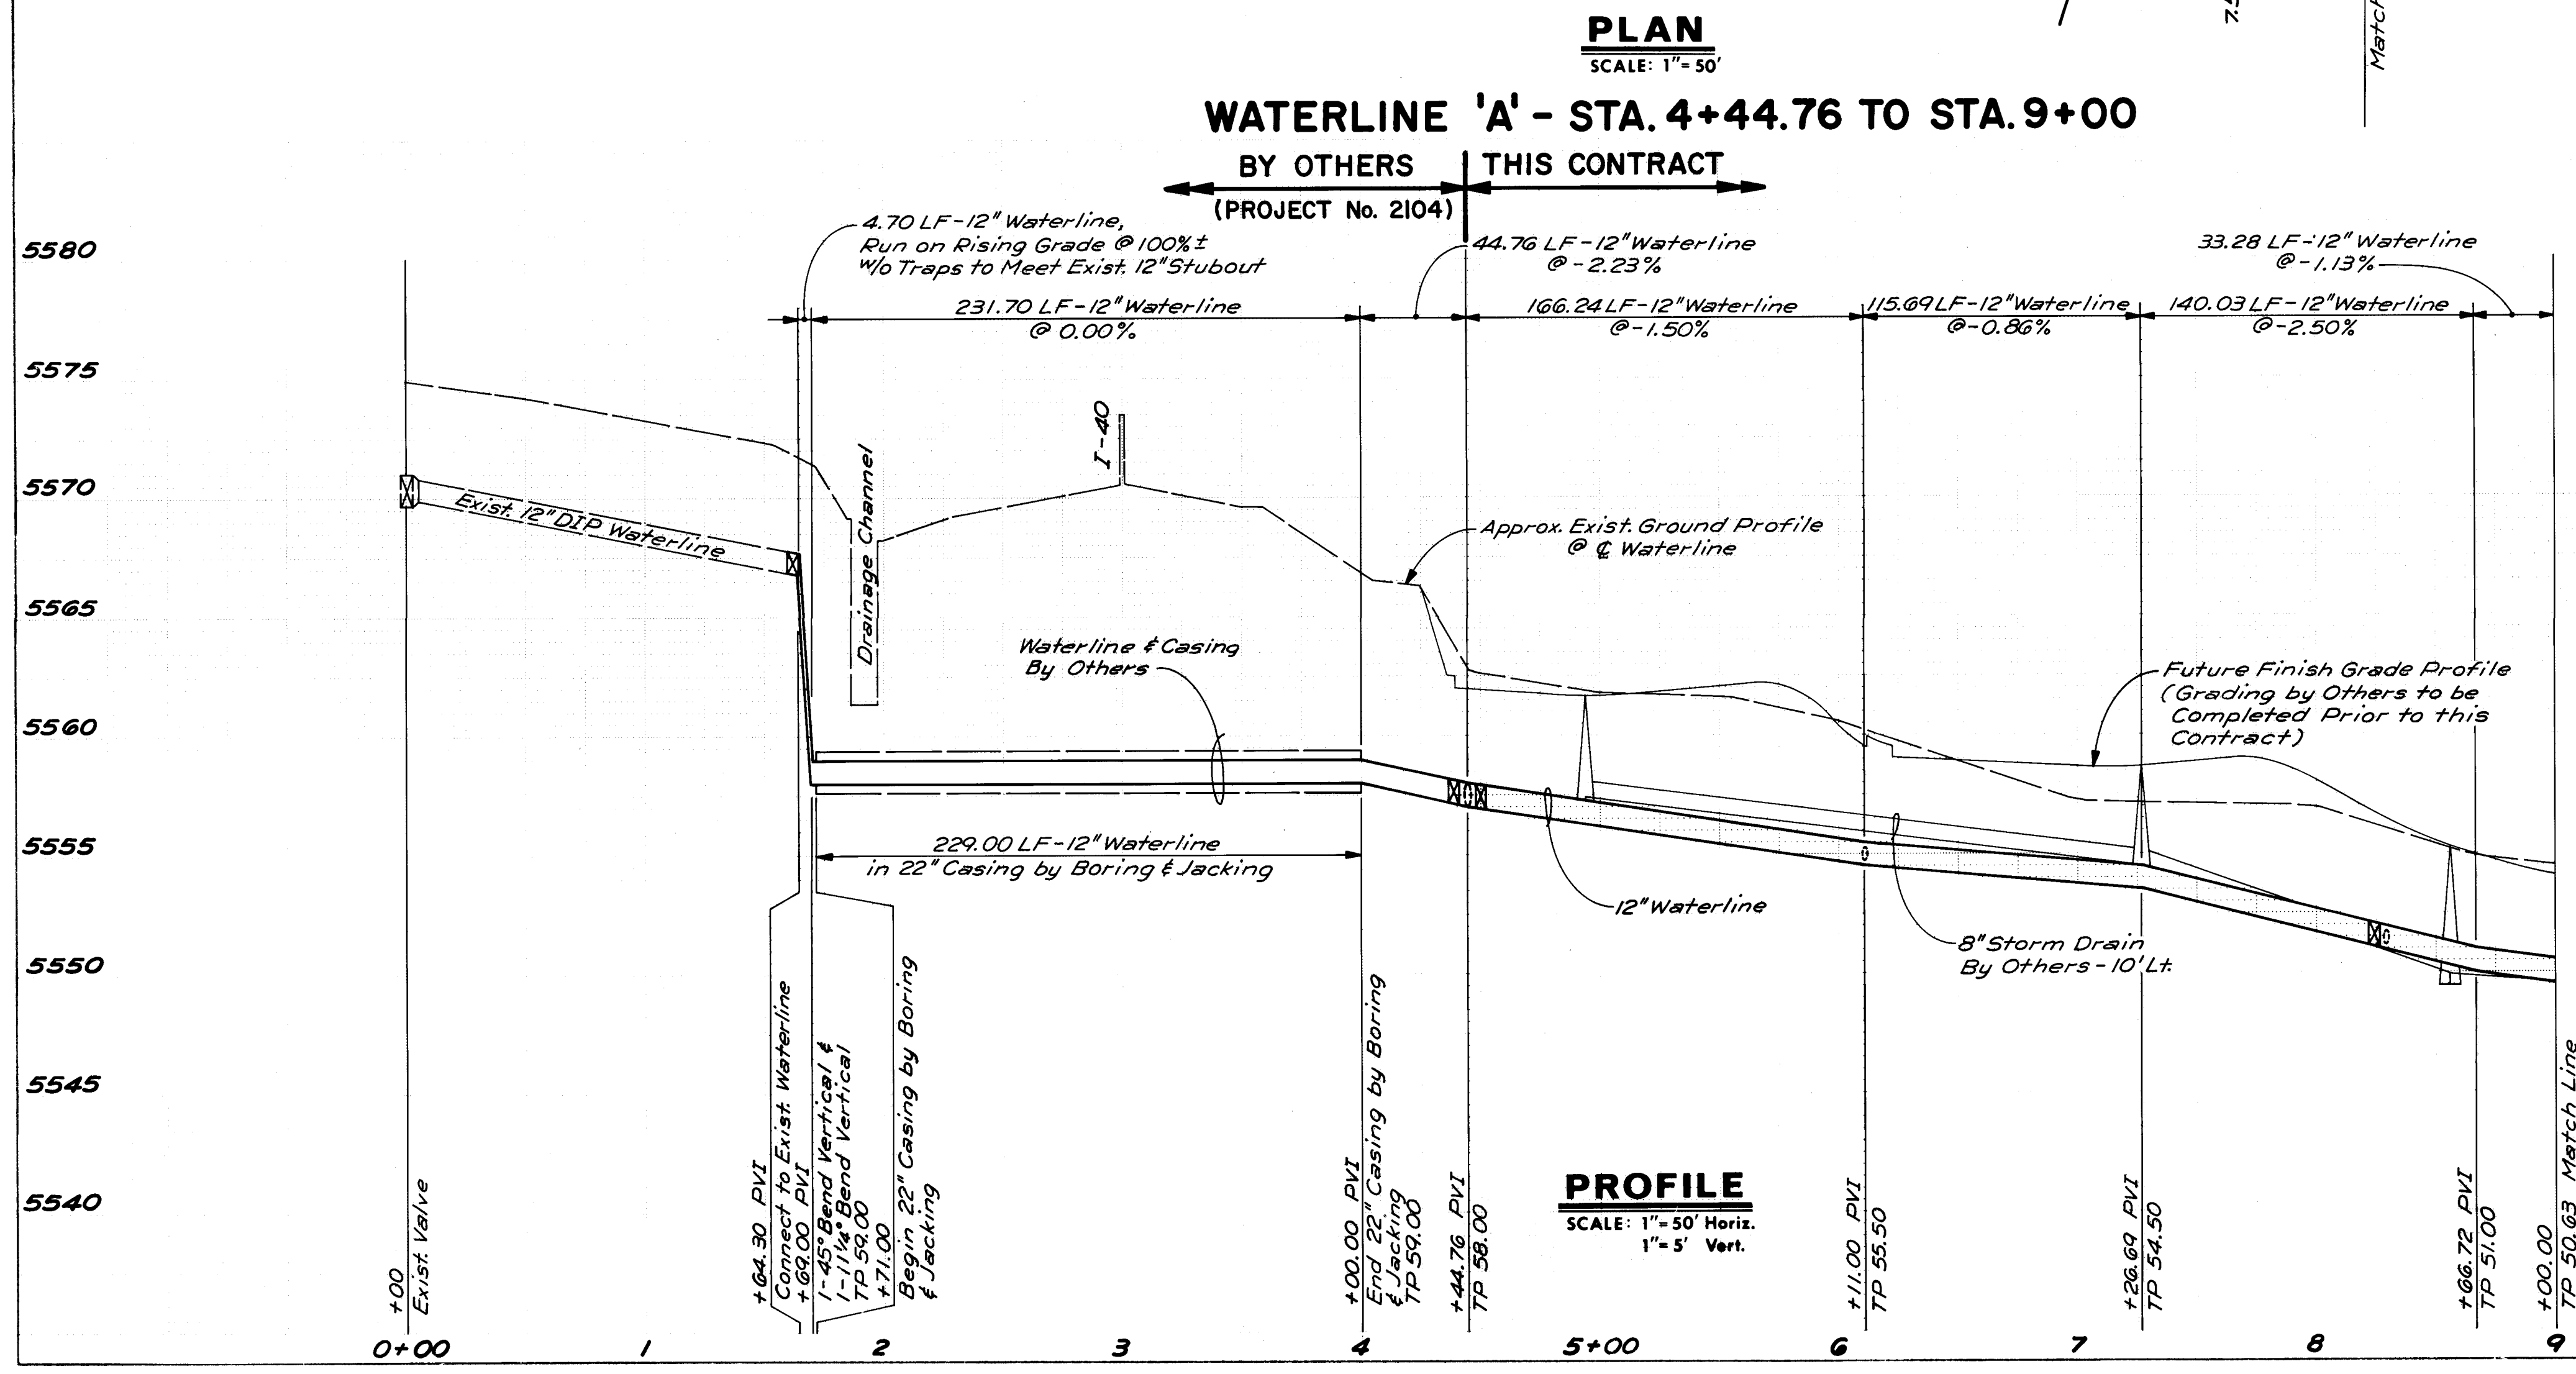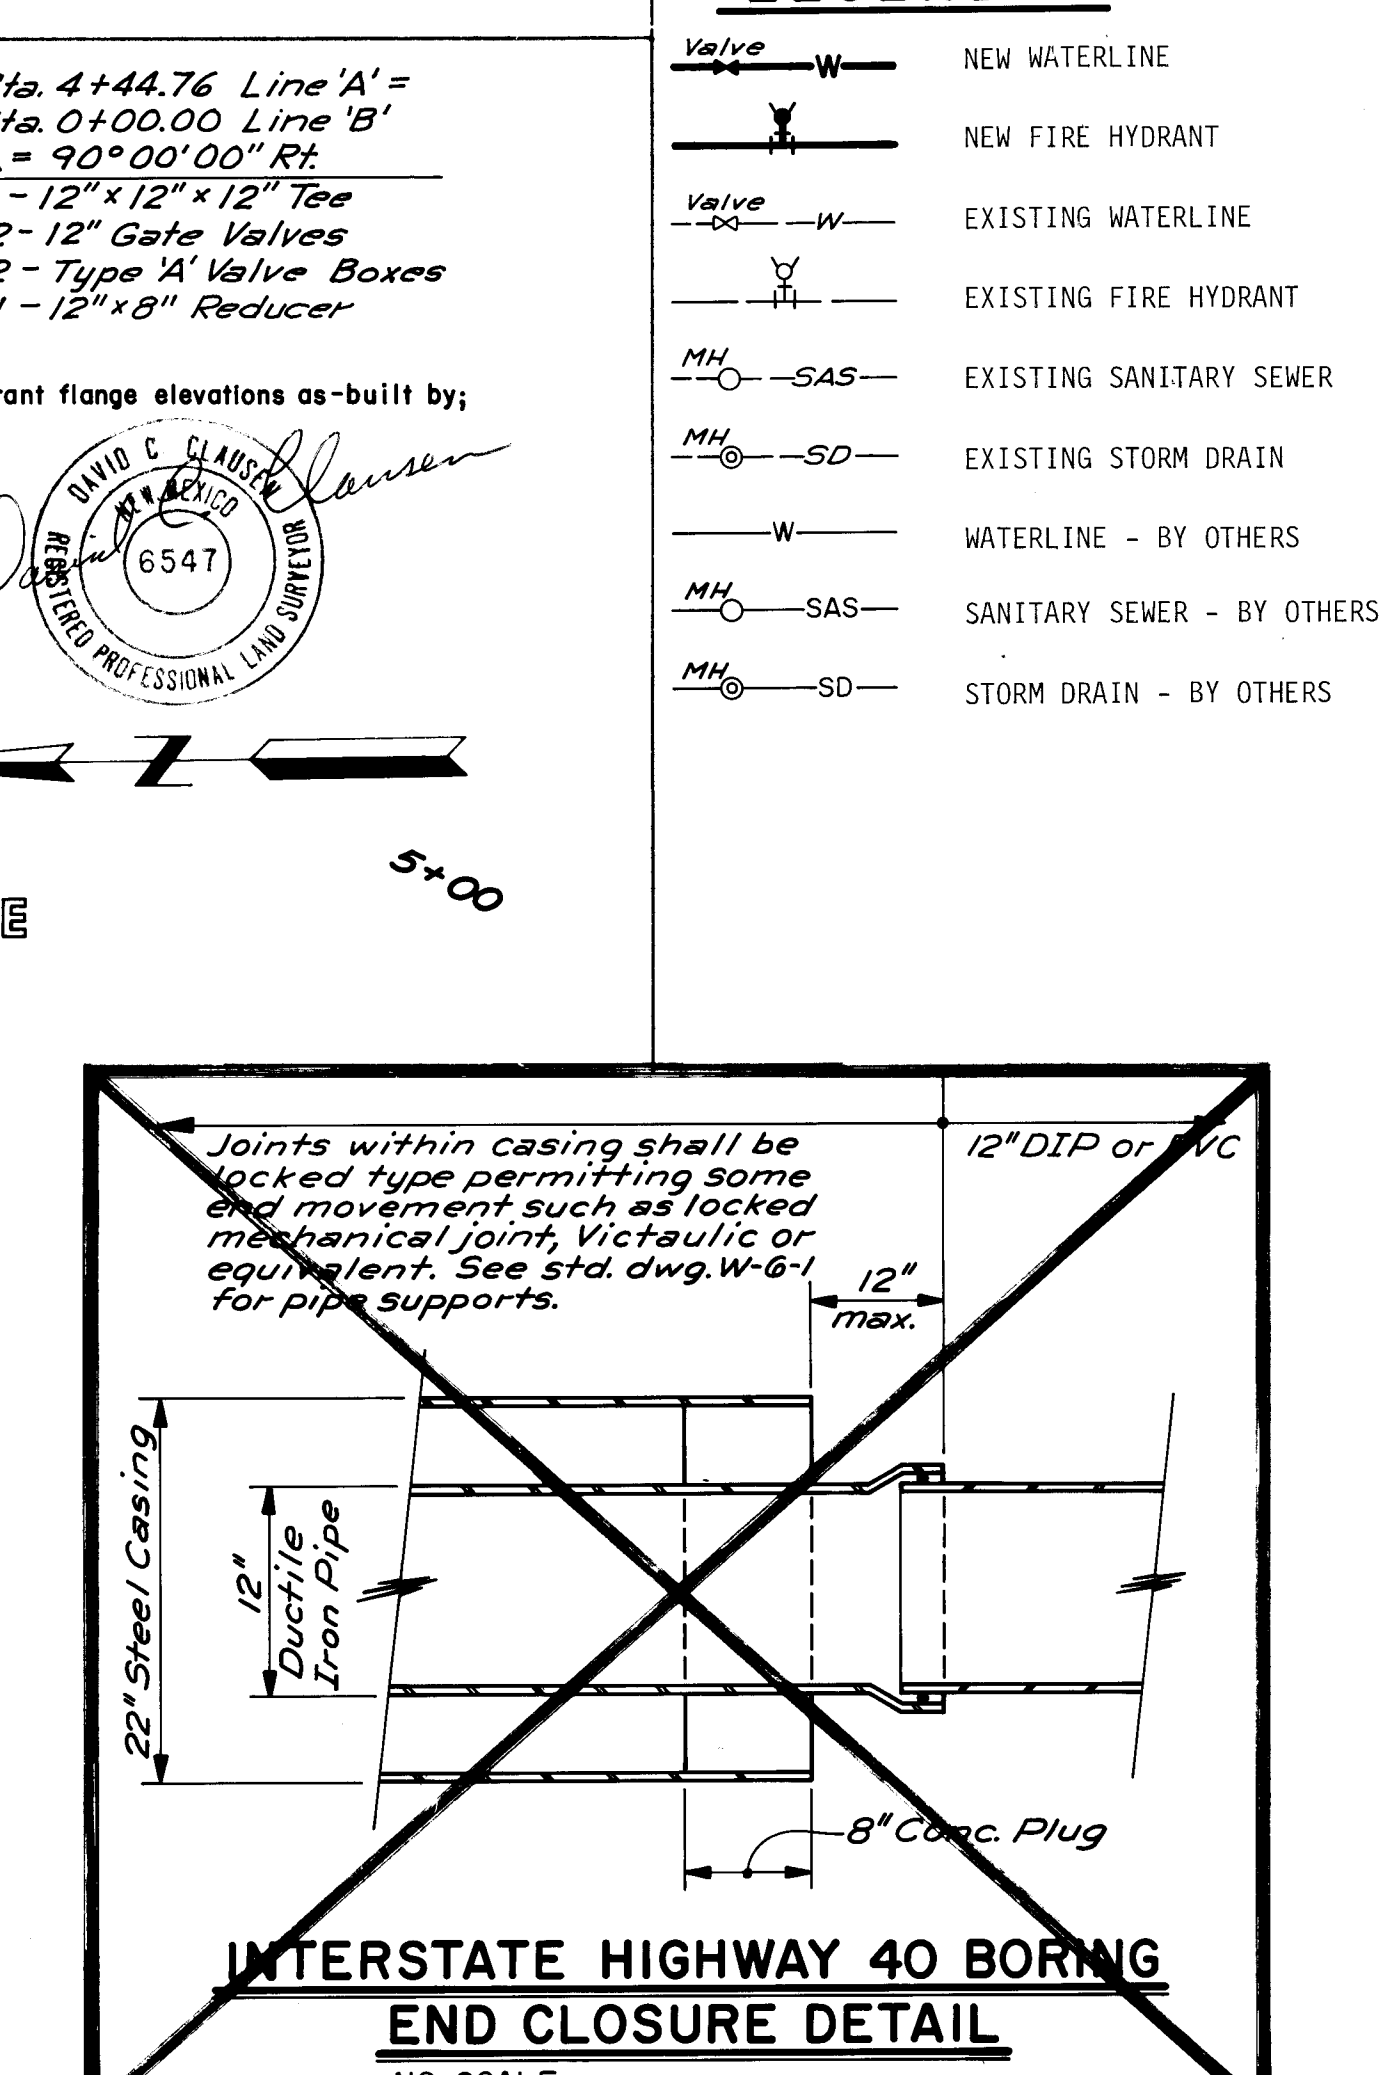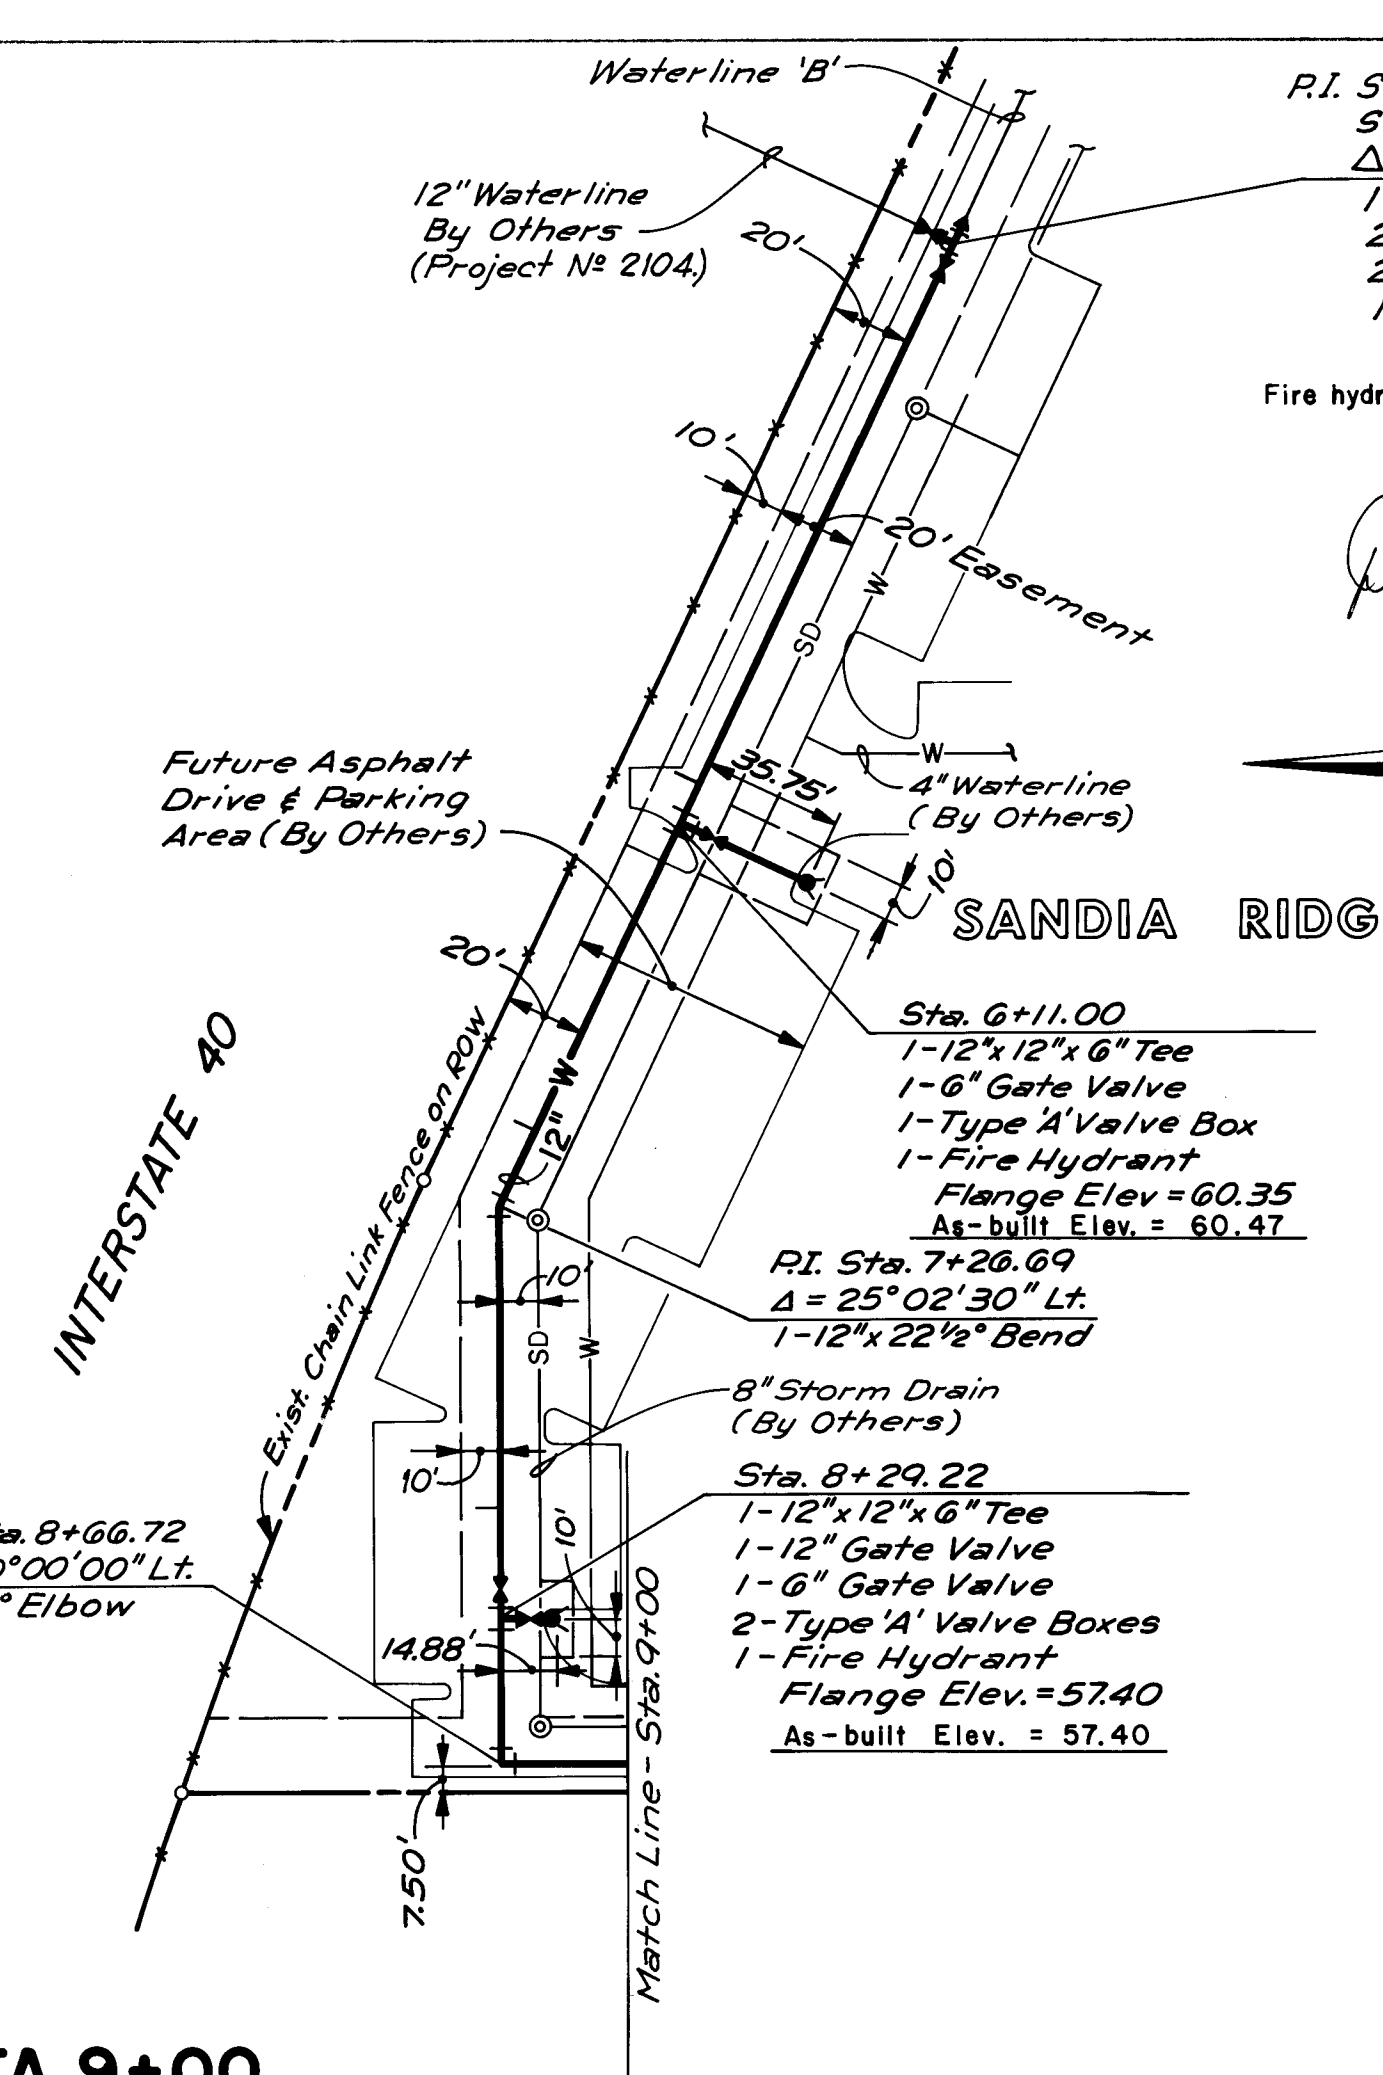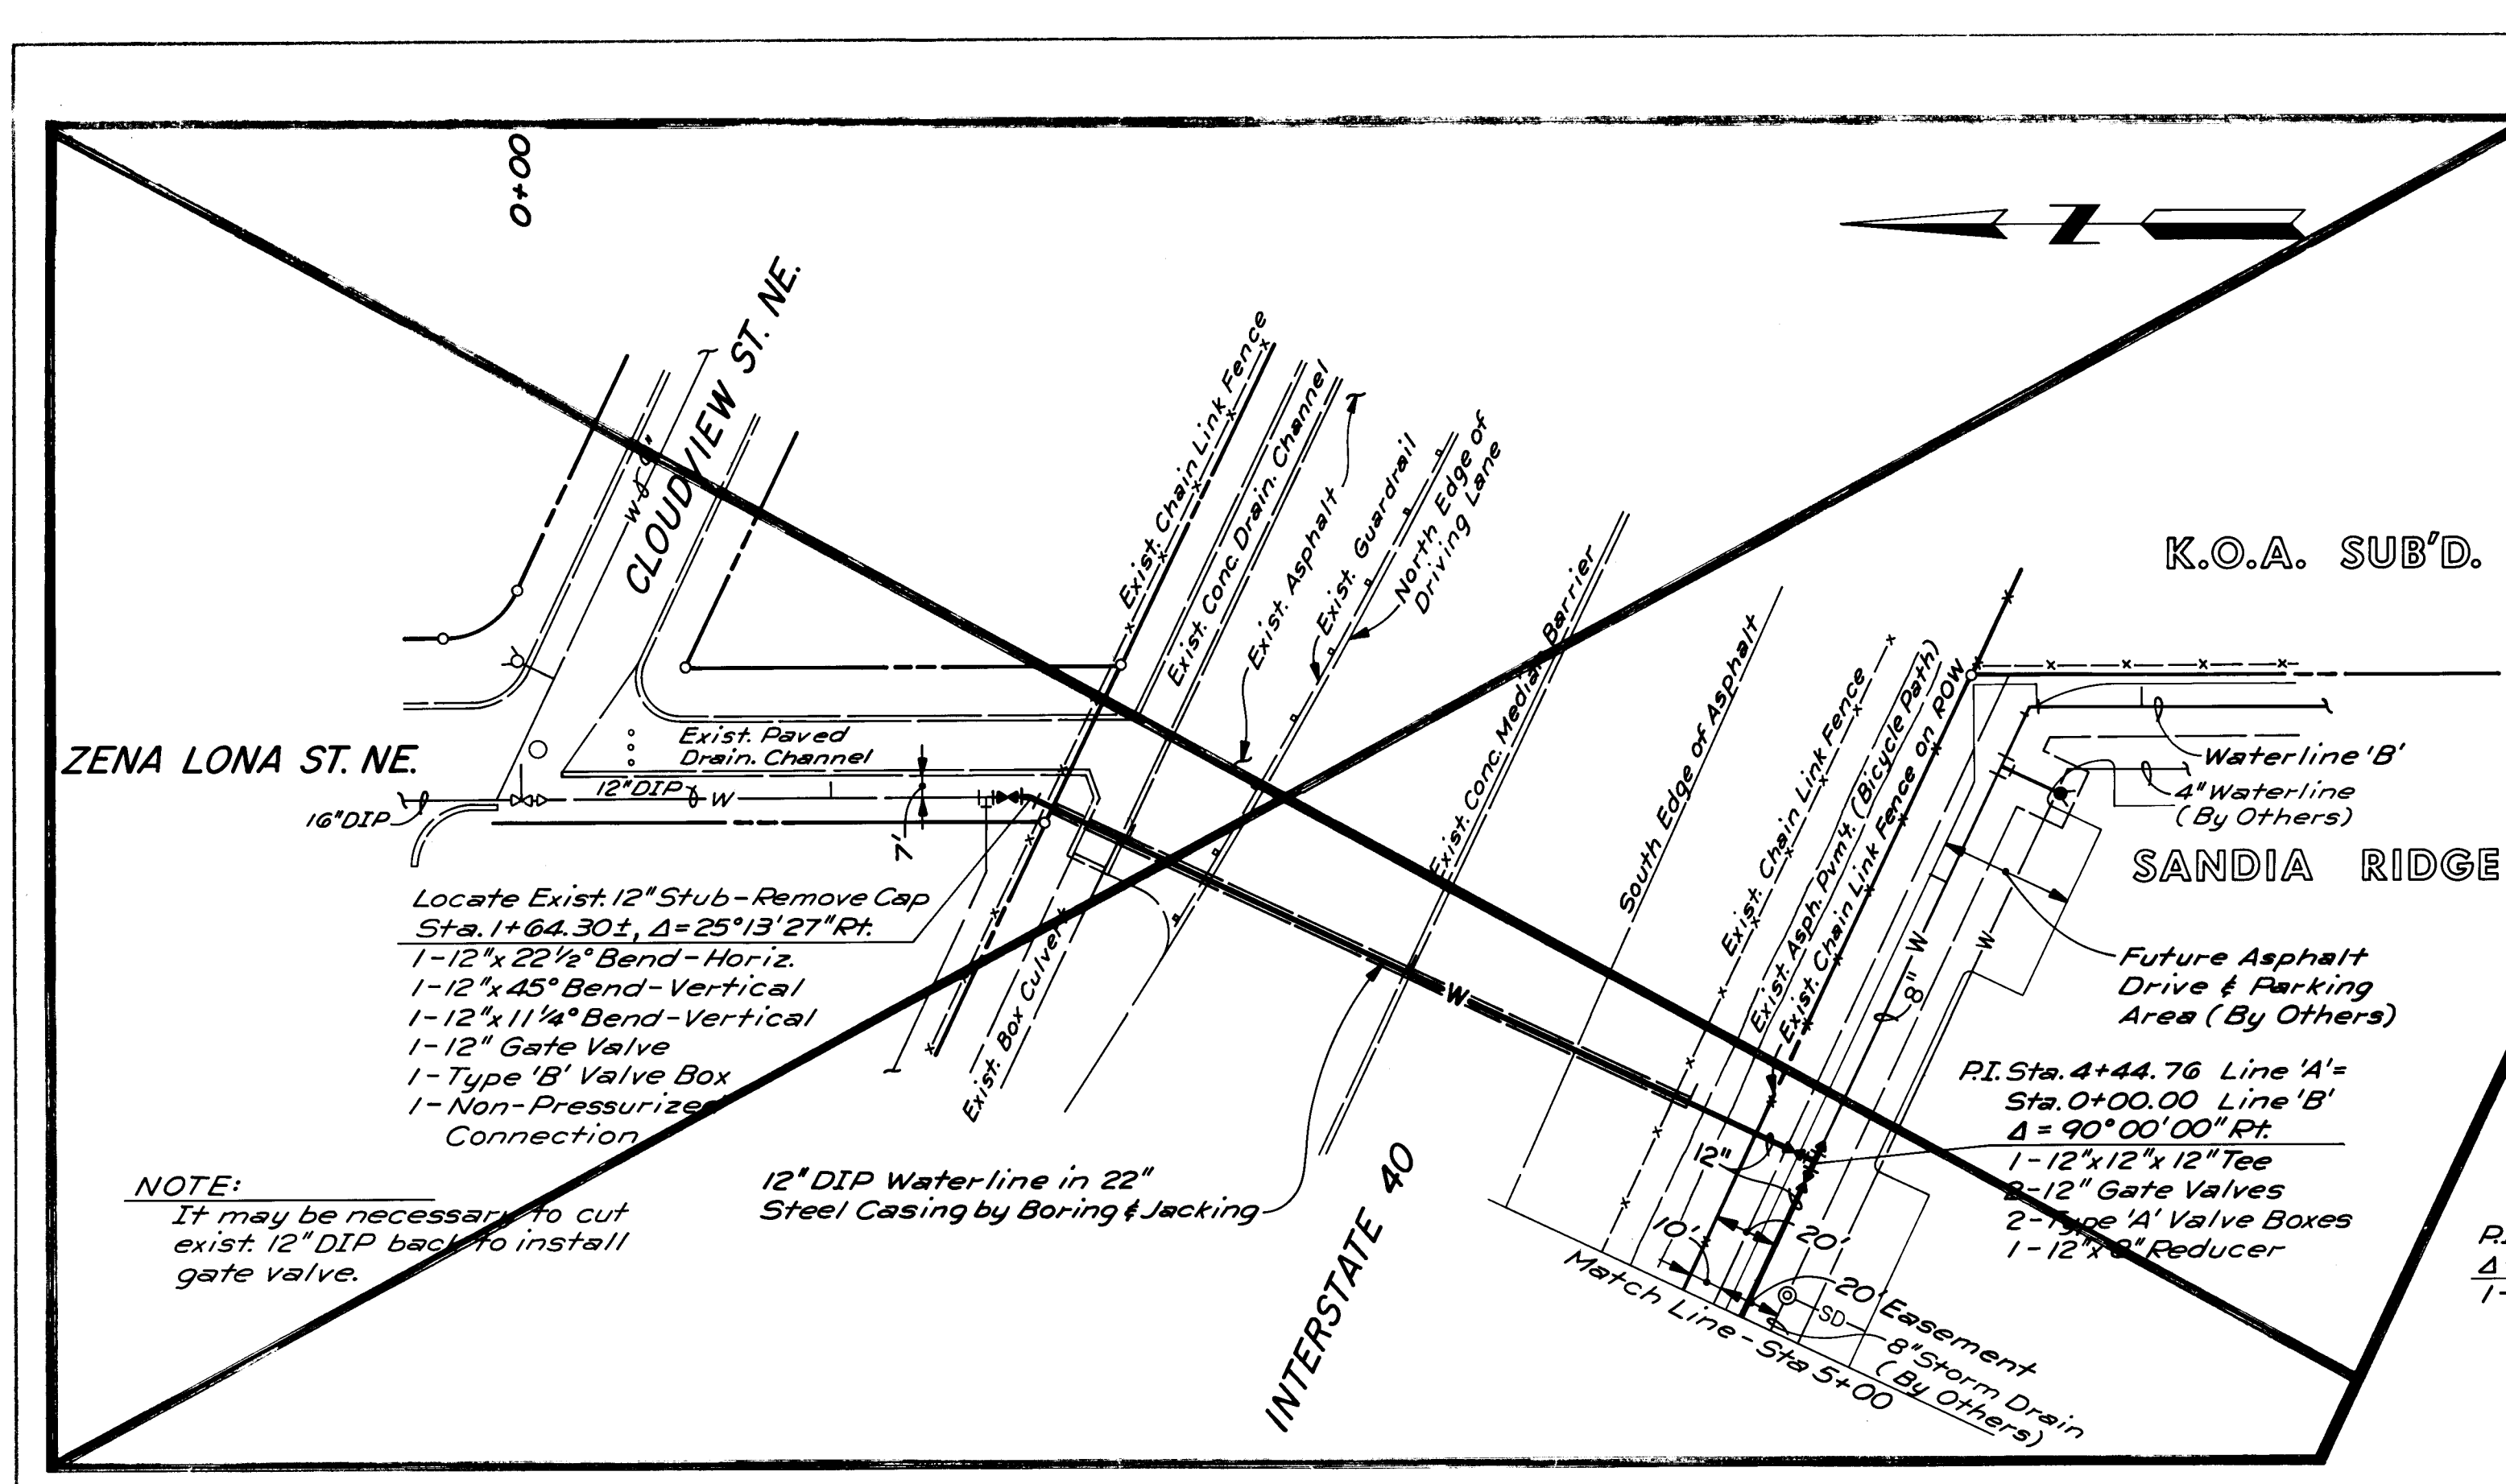

LEGEND

Valve W NEW WATERLINE
Valve W NEW FIRE HYDRANT
Valve W EXISTING WATERLINE
MH SAS EXISTING FIRE HYDRANT
MH SD EXISTING SANITARY SEWER
MH SD EXISTING STORM DRAIN
W WATERLINE - BY OTHERS
MH SAS SANITARY SEWER - BY OTHERS
MH SD STORM DRAIN - BY OTHERS

Fire hydrant flange elevations as-built by;
DAVID E. CLAUER
6547
REGISTERED PROFESSIONAL LAND SURVEYOR
NEW MEXICO

**INTERSTATE HIGHWAY 40 BORING
END CLOSURE DETAIL**
NO SCALE

NOTE:
STORM DRAINS & WATERLINES INDICATED TO BE BY OTHERS ARE PRIVATE LINES WITH THE SINGLE EXCEPTION OF WATERLINE INDICATED TO BE PROJECT NO. 2104. MOST WILL BE COMPLETED PRIOR TO CONSTRUCTION UNDER THIS CONTRACT; HOWEVER, IT IS POSSIBLE THAT SOME CONCURRENT CONSTRUCTION MAY TAKE PLACE.

DAVID E. CLAUER
6547
REGISTERED PROFESSIONAL LAND SURVEYOR
NEW MEXICO


AS-BUILT
26 20970485

CITY OF ALBUQUERQUE
WATER RESOURCES DEPARTMENT
ENGINEERING DIVISION

**SANDIA RIDGE WATERLINE EXTENSIONS
WATERLINE 'A' PLAN & PROFILE
STA. 4+44.76 TO STA. 9+00**


APPROVALS	ENGINEER	DATE	APPROVALS	ENGINEER	DATE
City Engineer	<i>[Signature]</i>	7/25/84	Liquid Waste	<i>R. Lora</i>	7/25/84
A C E - Design	<i>[Signature]</i>	8/25/84	Traffic	<i>N.P. Doh</i>	7/25/84
A C E - Hydrology	<i>N.A. Agla</i>	7/25/84	Water	<i>R. Lora</i>	7/25/84

DRAWING NO. **2097** MAP NO. K-22 & L-22 SHEET 4 OF 7

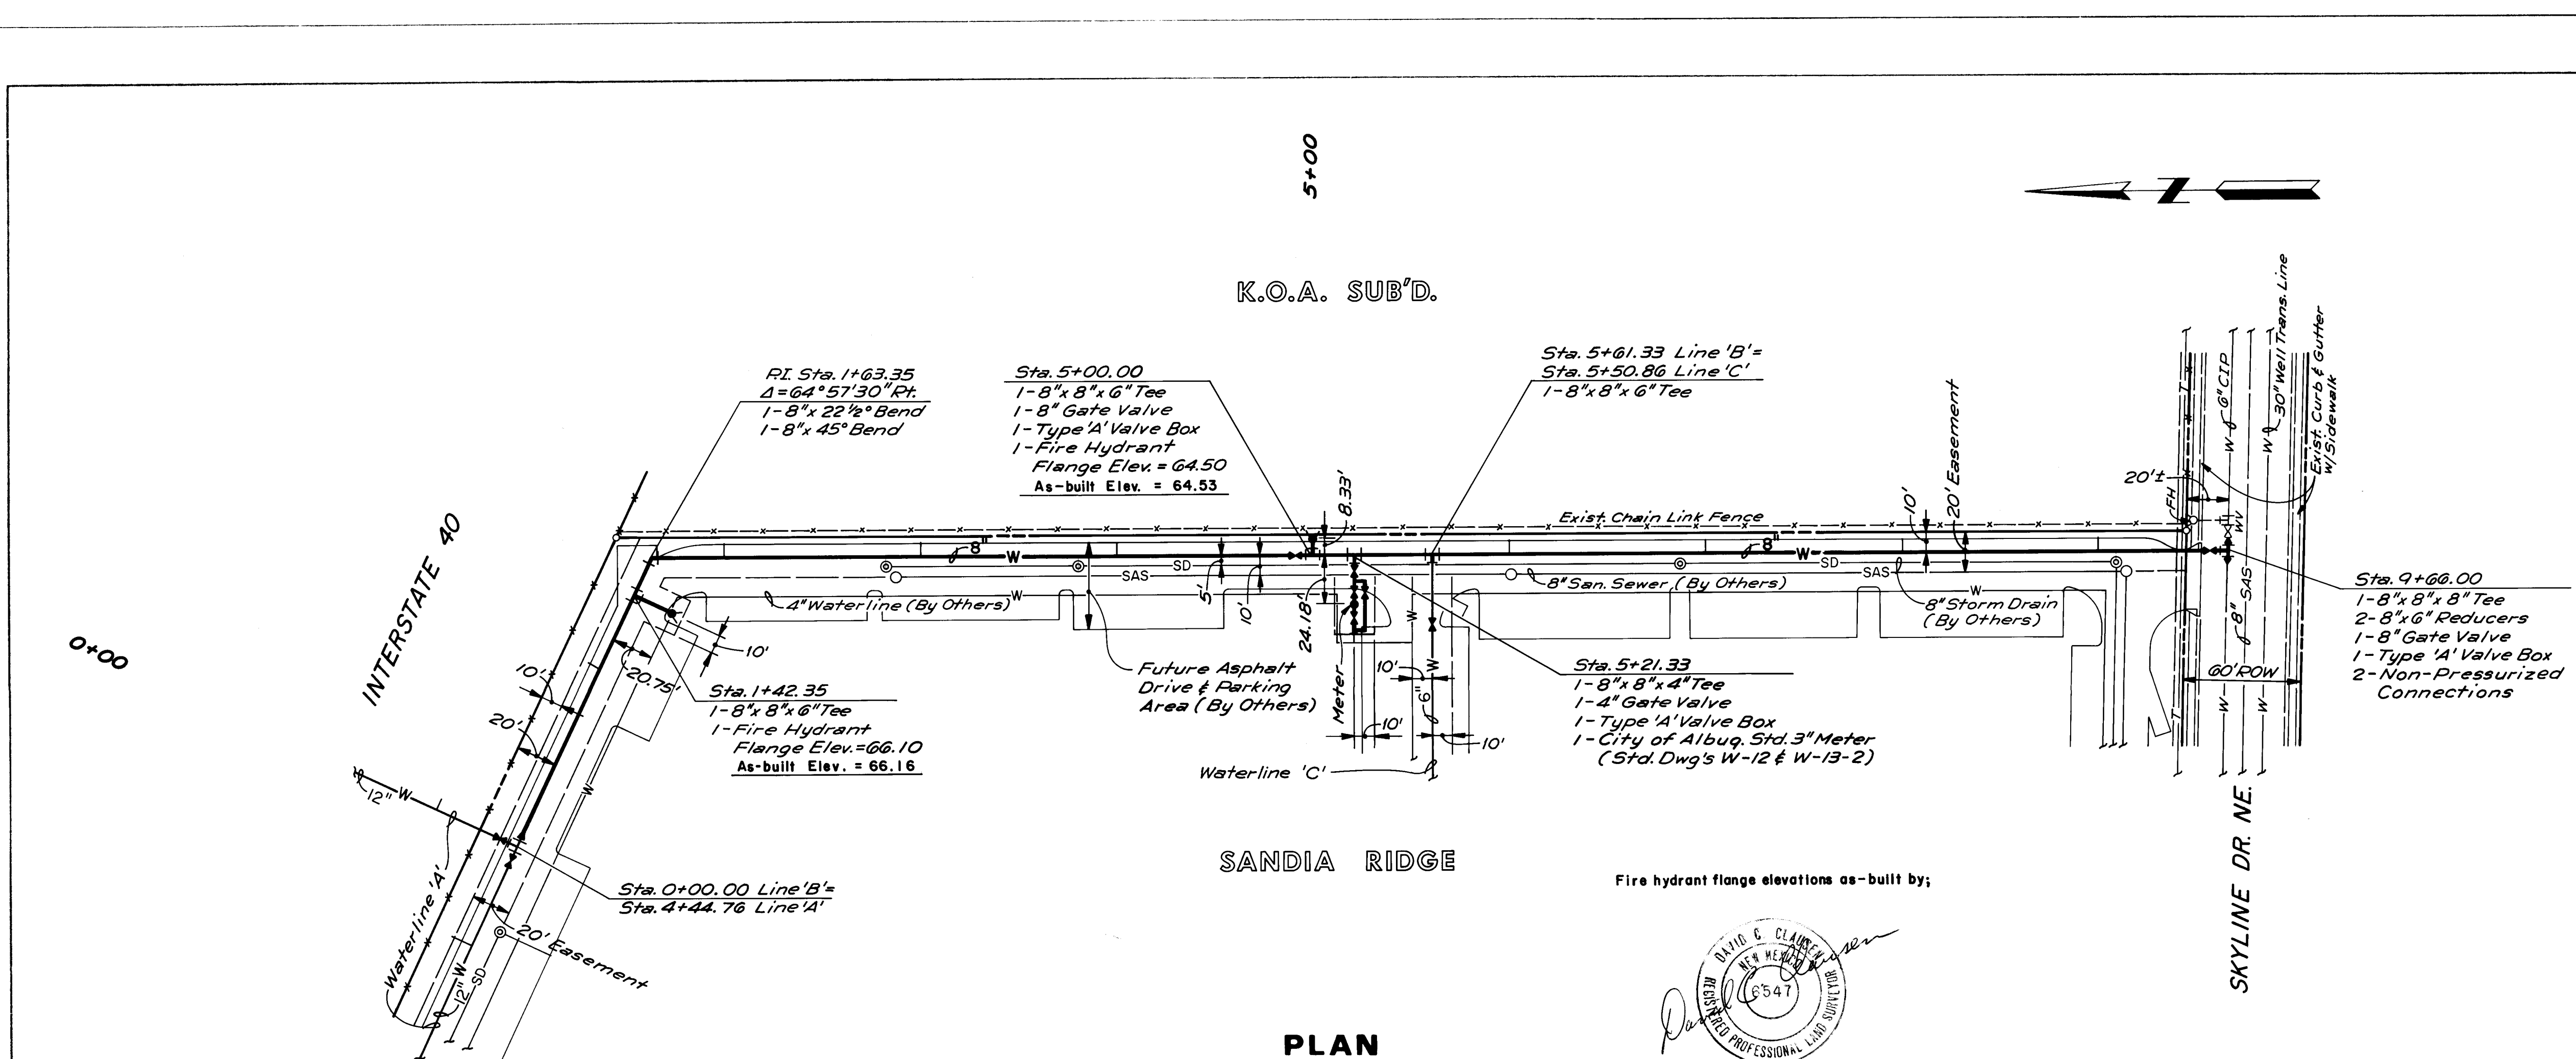

PLAN
SCALE: 1" = 50'

WATERLINE 'B'

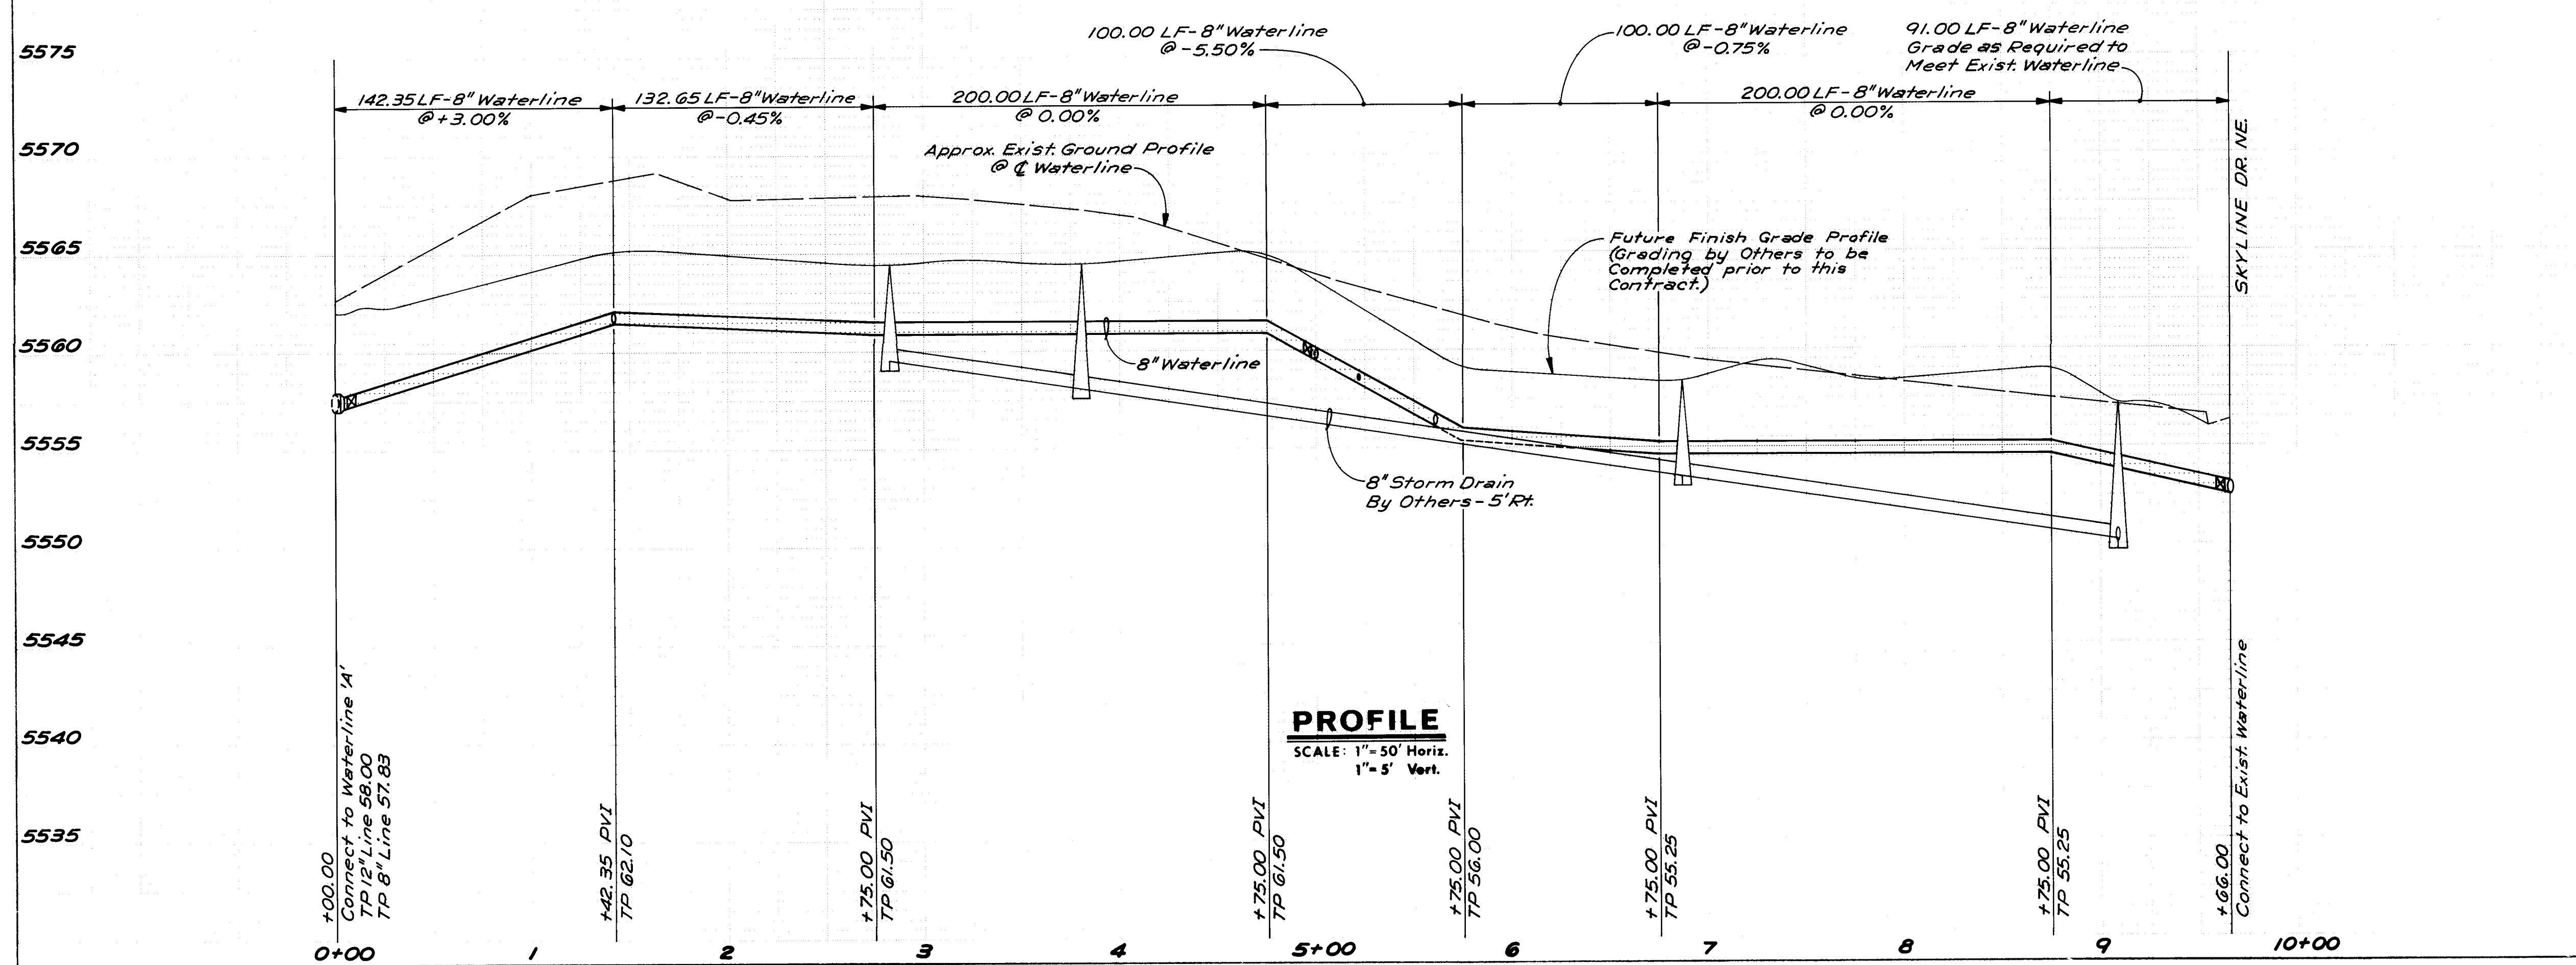

PROFILE
SCALE: 1" = 50' Horiz.
1" = 5' Vert.

LEGEND	
	NEW WATERLINE
	NEW FIRE HYDRANT
	EXISTING WATERLINE
	EXISTING FIRE HYDRANT
	EXISTING SANITARY SEWER
	EXISTING STORM DRAIN
	WATERLINE - BY OTHERS
	SANITARY SEWER - BY OTHERS
	STORM DRAIN - BY OTHERS
	EXISTING TELEPHONE LINE

Sta. 9+66.00
1-8" x 8" Tee
2-8" x 6" Reducers
1-8" Gate Valve
1-Type 'A' Valve Box
2-Non-Pressurized Connections

Sta. 5+21.33
1-8" x 8" Tee
1-4" Gate Valve
1-Type 'A' Valve Box
1-City of Albuquerque Std. 3" Meter (Std. Dwg's W-12 & W-13-2)

Sta. 5+50.86 Line 'B' =
Sta. 5+50.86 Line 'C' =
1-8" x 8" Tee

Sta. 5+00.00
1-8" x 8" Tee
1-8" Gate Valve
1-Type 'A' Valve Box
1-Fire Hydrant
Flange Elev. = 64.50
As-built Elev. = 64.53

Sta. 1+42.35
1-8" x 8" Tee
1-Fire Hydrant
Flange Elev. = 66.10
As-built Elev. = 66.10

Sta. 0+00.00 Line 'B' =
Sta. 4+44.76 Line 'A' =

Future Asphalt Drive & Parking Area (By Others)

Exist. Chain Link Fence

20' Easement

20' Easement

AS BUILT INFORMATION		BENCH MARKS		SURVEY INFORMATION		FIELD NOTES		ENGINEER'S SEAL		REVISIONS		DESIGN		APPROVALS		ENGINEER		DATE	
CONTRACTOR	DATE	ELEV. - 5534.54 FEET (MSL)	DATE	NO.	BY	DATE	DATE	REGISTERED PROFESSIONAL ENGINEER	REGISTERED PROFESSIONAL ENGINEER	NO.	DATE	DESIGNED BY	DATE	CITY ENGINEER	DATE	APPROVED BY	DATE	7/25/84	7/25/84
WORK	DATE	STANDARD ACS BRASS CAP STAMPED "1-121 RESET 1974"	DATE					DAVID C. CLAYTON	DAVID C. CLAYTON			DESIGNED BY	DATE	CITY ENGINEER	DATE	APPROVED BY	DATE	7/25/84	7/25/84
FIELD	DATE	LOCATED IN TOP OF MEDIAN CURB 5' NORTH OF CENTERLINE	DATE					DAVID C. CLAYTON	DAVID C. CLAYTON			DESIGNED BY	DATE	CITY ENGINEER	DATE	APPROVED BY	DATE	7/25/84	7/25/84
VERIFICATION BY	DATE	OF CENTRAL AVENUE & 81' WEST OF JUAN TABO BOULEVARD	DATE					DAVID C. CLAYTON	DAVID C. CLAYTON			DESIGNED BY	DATE	CITY ENGINEER	DATE	APPROVED BY	DATE	7/25/84	7/25/84
CORRECTED BY	DATE	CENTERLINE	DATE					DAVID C. CLAYTON	DAVID C. CLAYTON			DESIGNED BY	DATE	CITY ENGINEER	DATE	APPROVED BY	DATE	7/25/84	7/25/84
MICRO-FILM INFORMATION	DATE		DATE					DAVID C. CLAYTON	DAVID C. CLAYTON			DESIGNED BY	DATE	CITY ENGINEER	DATE	APPROVED BY	DATE	7/25/84	7/25/84
RECORDED BY	DATE		DATE					DAVID C. CLAYTON	DAVID C. CLAYTON			DESIGNED BY	DATE	CITY ENGINEER	DATE	APPROVED BY	DATE	7/25/84	7/25/84
NO								DAVID C. CLAYTON	DAVID C. CLAYTON			DESIGNED BY	DATE	CITY ENGINEER	DATE	APPROVED BY	DATE	7/25/84	7/25/84

NOTE:
STORM DRAINS & WATERLINES INDICATED TO BE BY OTHERS ARE PRIVATE LINES WITH THE SINGLE EXCEPTION OF WATERLINE INDICATED TO BE PROJECT NO. 2104. MOST WILL BE COMPLETED PRIOR TO CONSTRUCTION UNDER THIS CONTRACT; HOWEVER, IT IS POSSIBLE THAT SOME CONCURRENT CONSTRUCTION MAY TAKE PLACE.


AS-BUILT
26 20970685

CITY OF ALBUQUERQUE
WATER RESOURCES DEPARTMENT
ENGINEERING DIVISION

SANDIA RIDGE WATERLINE EXTENSIONS
WATERLINE 'B' PLAN & PROFILE


APPROVALS	ENGINEER	DATE	APPROVALS	ENGINEER	DATE
CITY ENGINEER	C. Clayton	7/25/84	Liquid Waste	R. Peña	7/25/84
A C E - Design	N.A. B.G.A.	7/25/84	Traffic	N.A. B.G.A.	7/25/84
A C E - Hydrology	N.A. B.G.A.	7/25/84	Water	R. Peña	7/25/84

DRAWING NO. 2097
MAP NO. K-22 & L-22
SHEET 6 OF 7

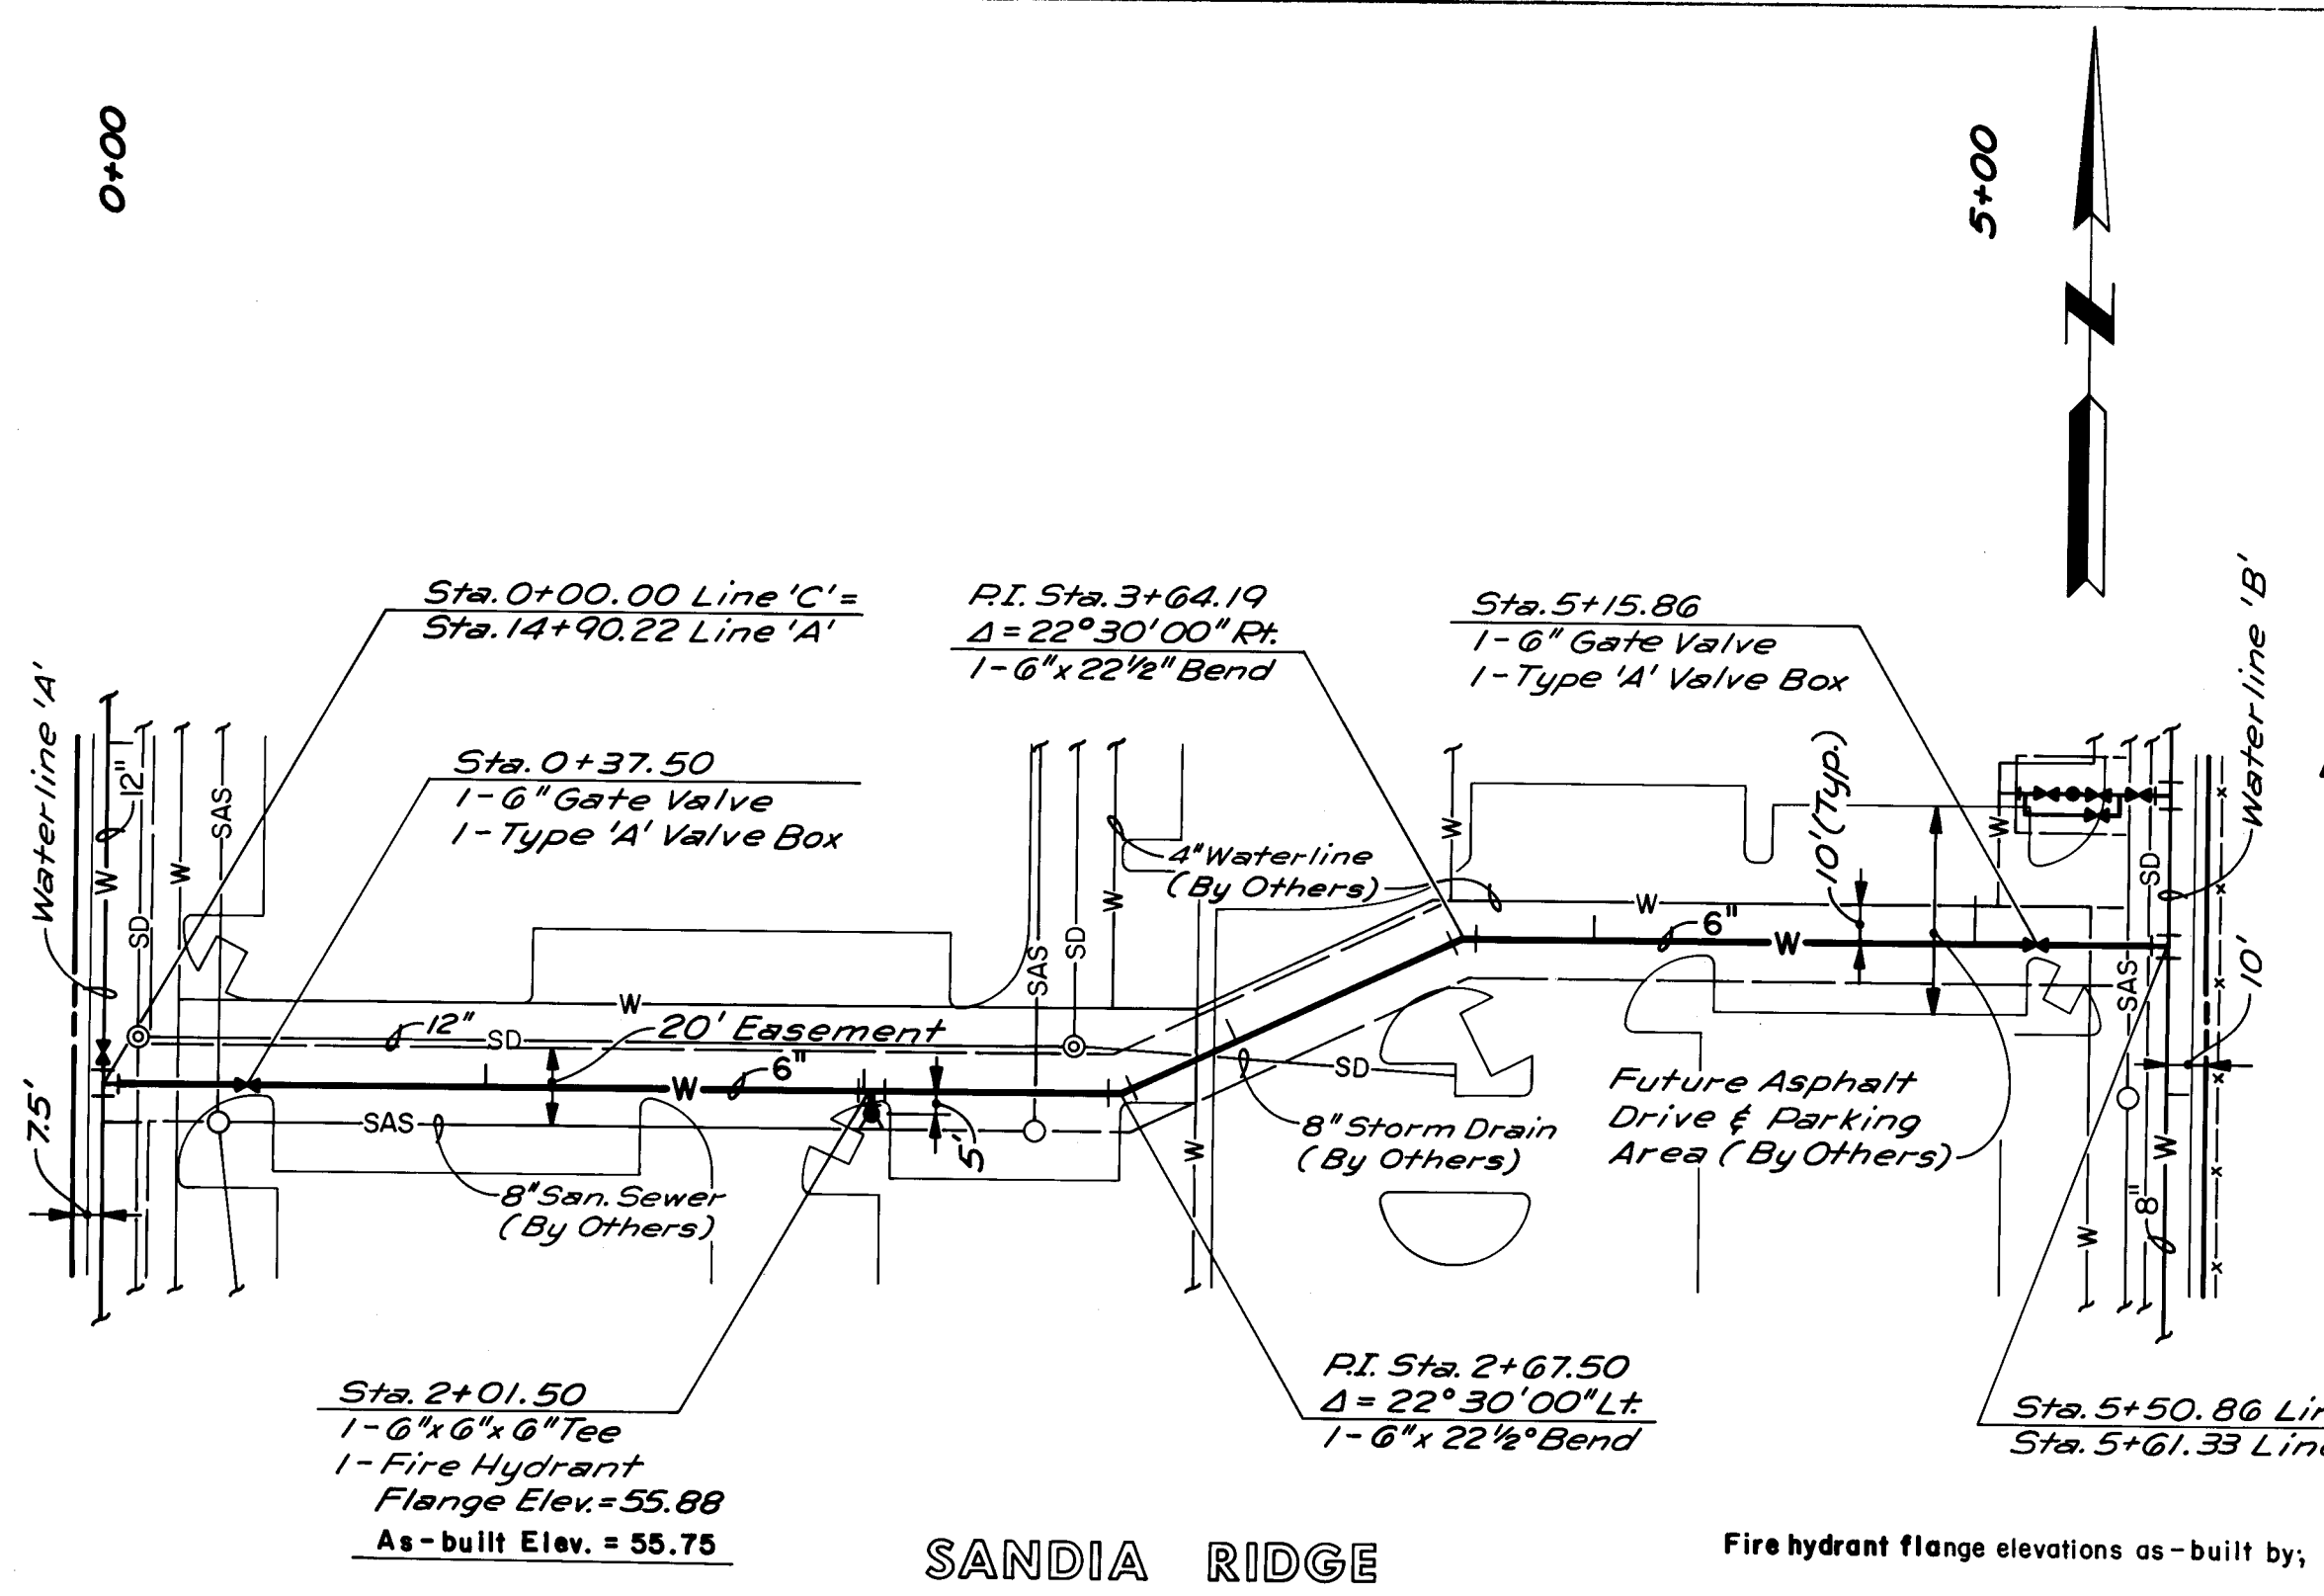



PLAN
SCALE: 1"=50'

WATERLINE 'C'

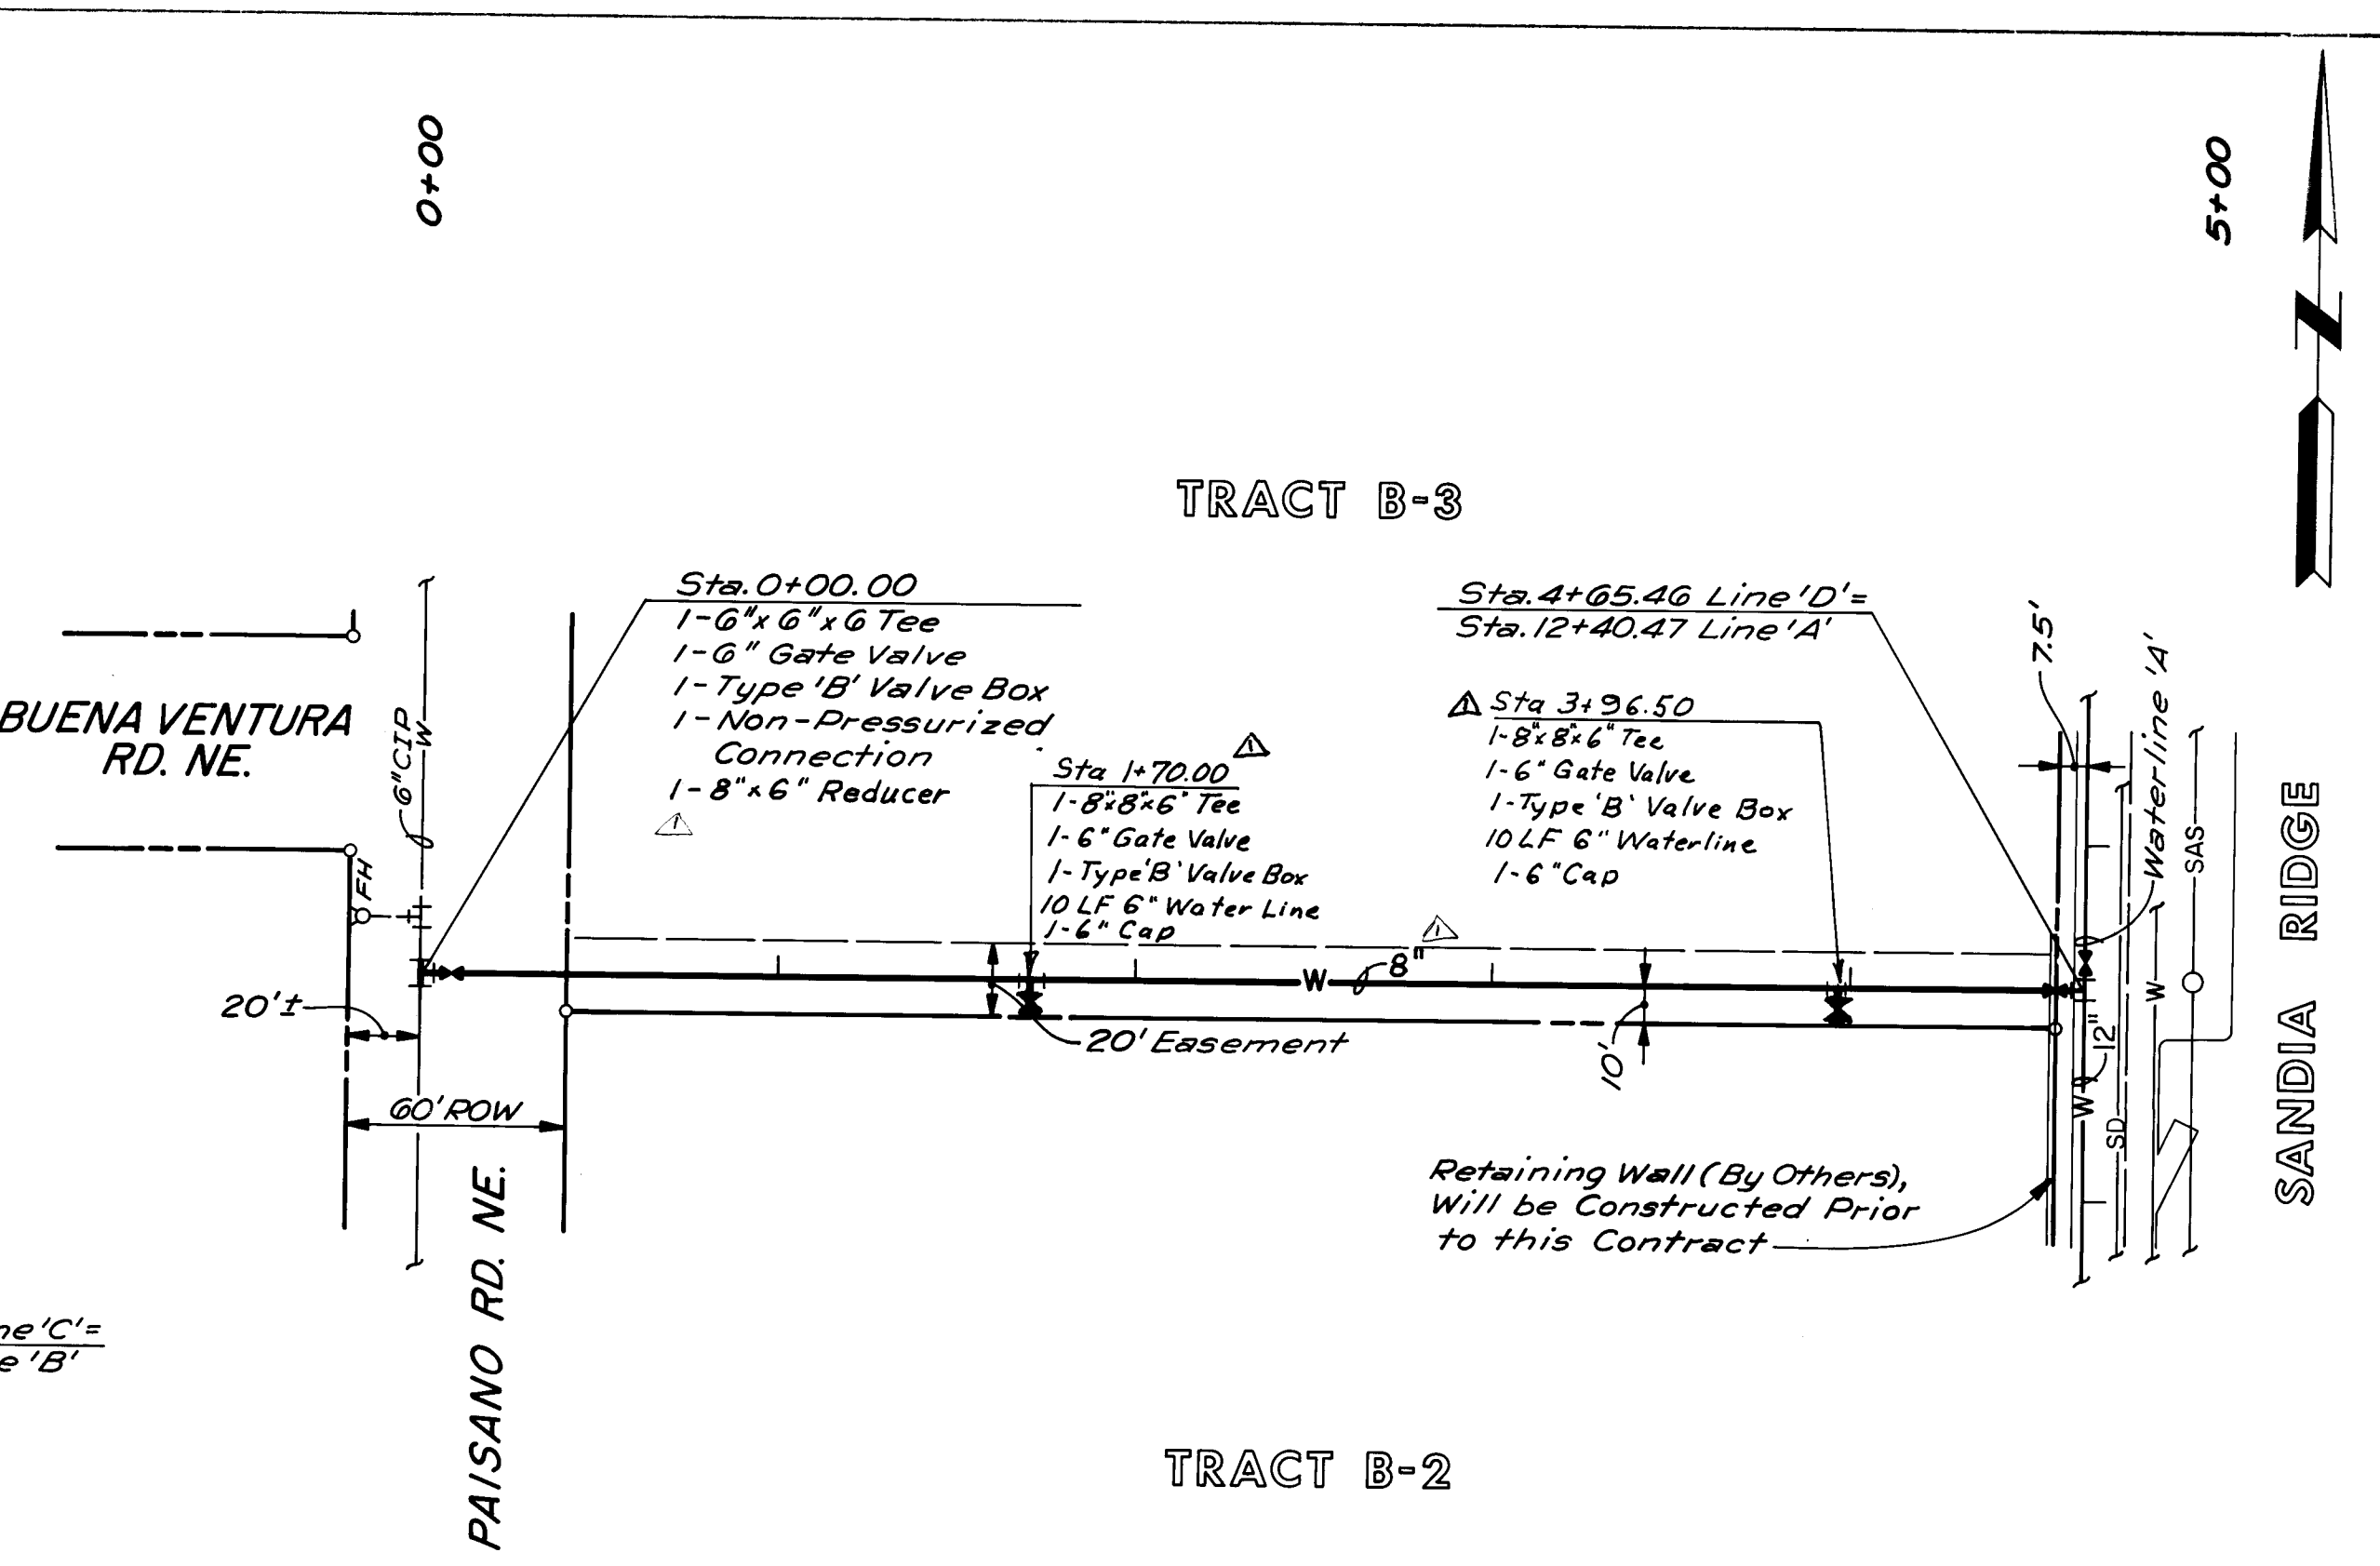

PLAN
SCALE: 1"=50'

WATERLINE 'D'

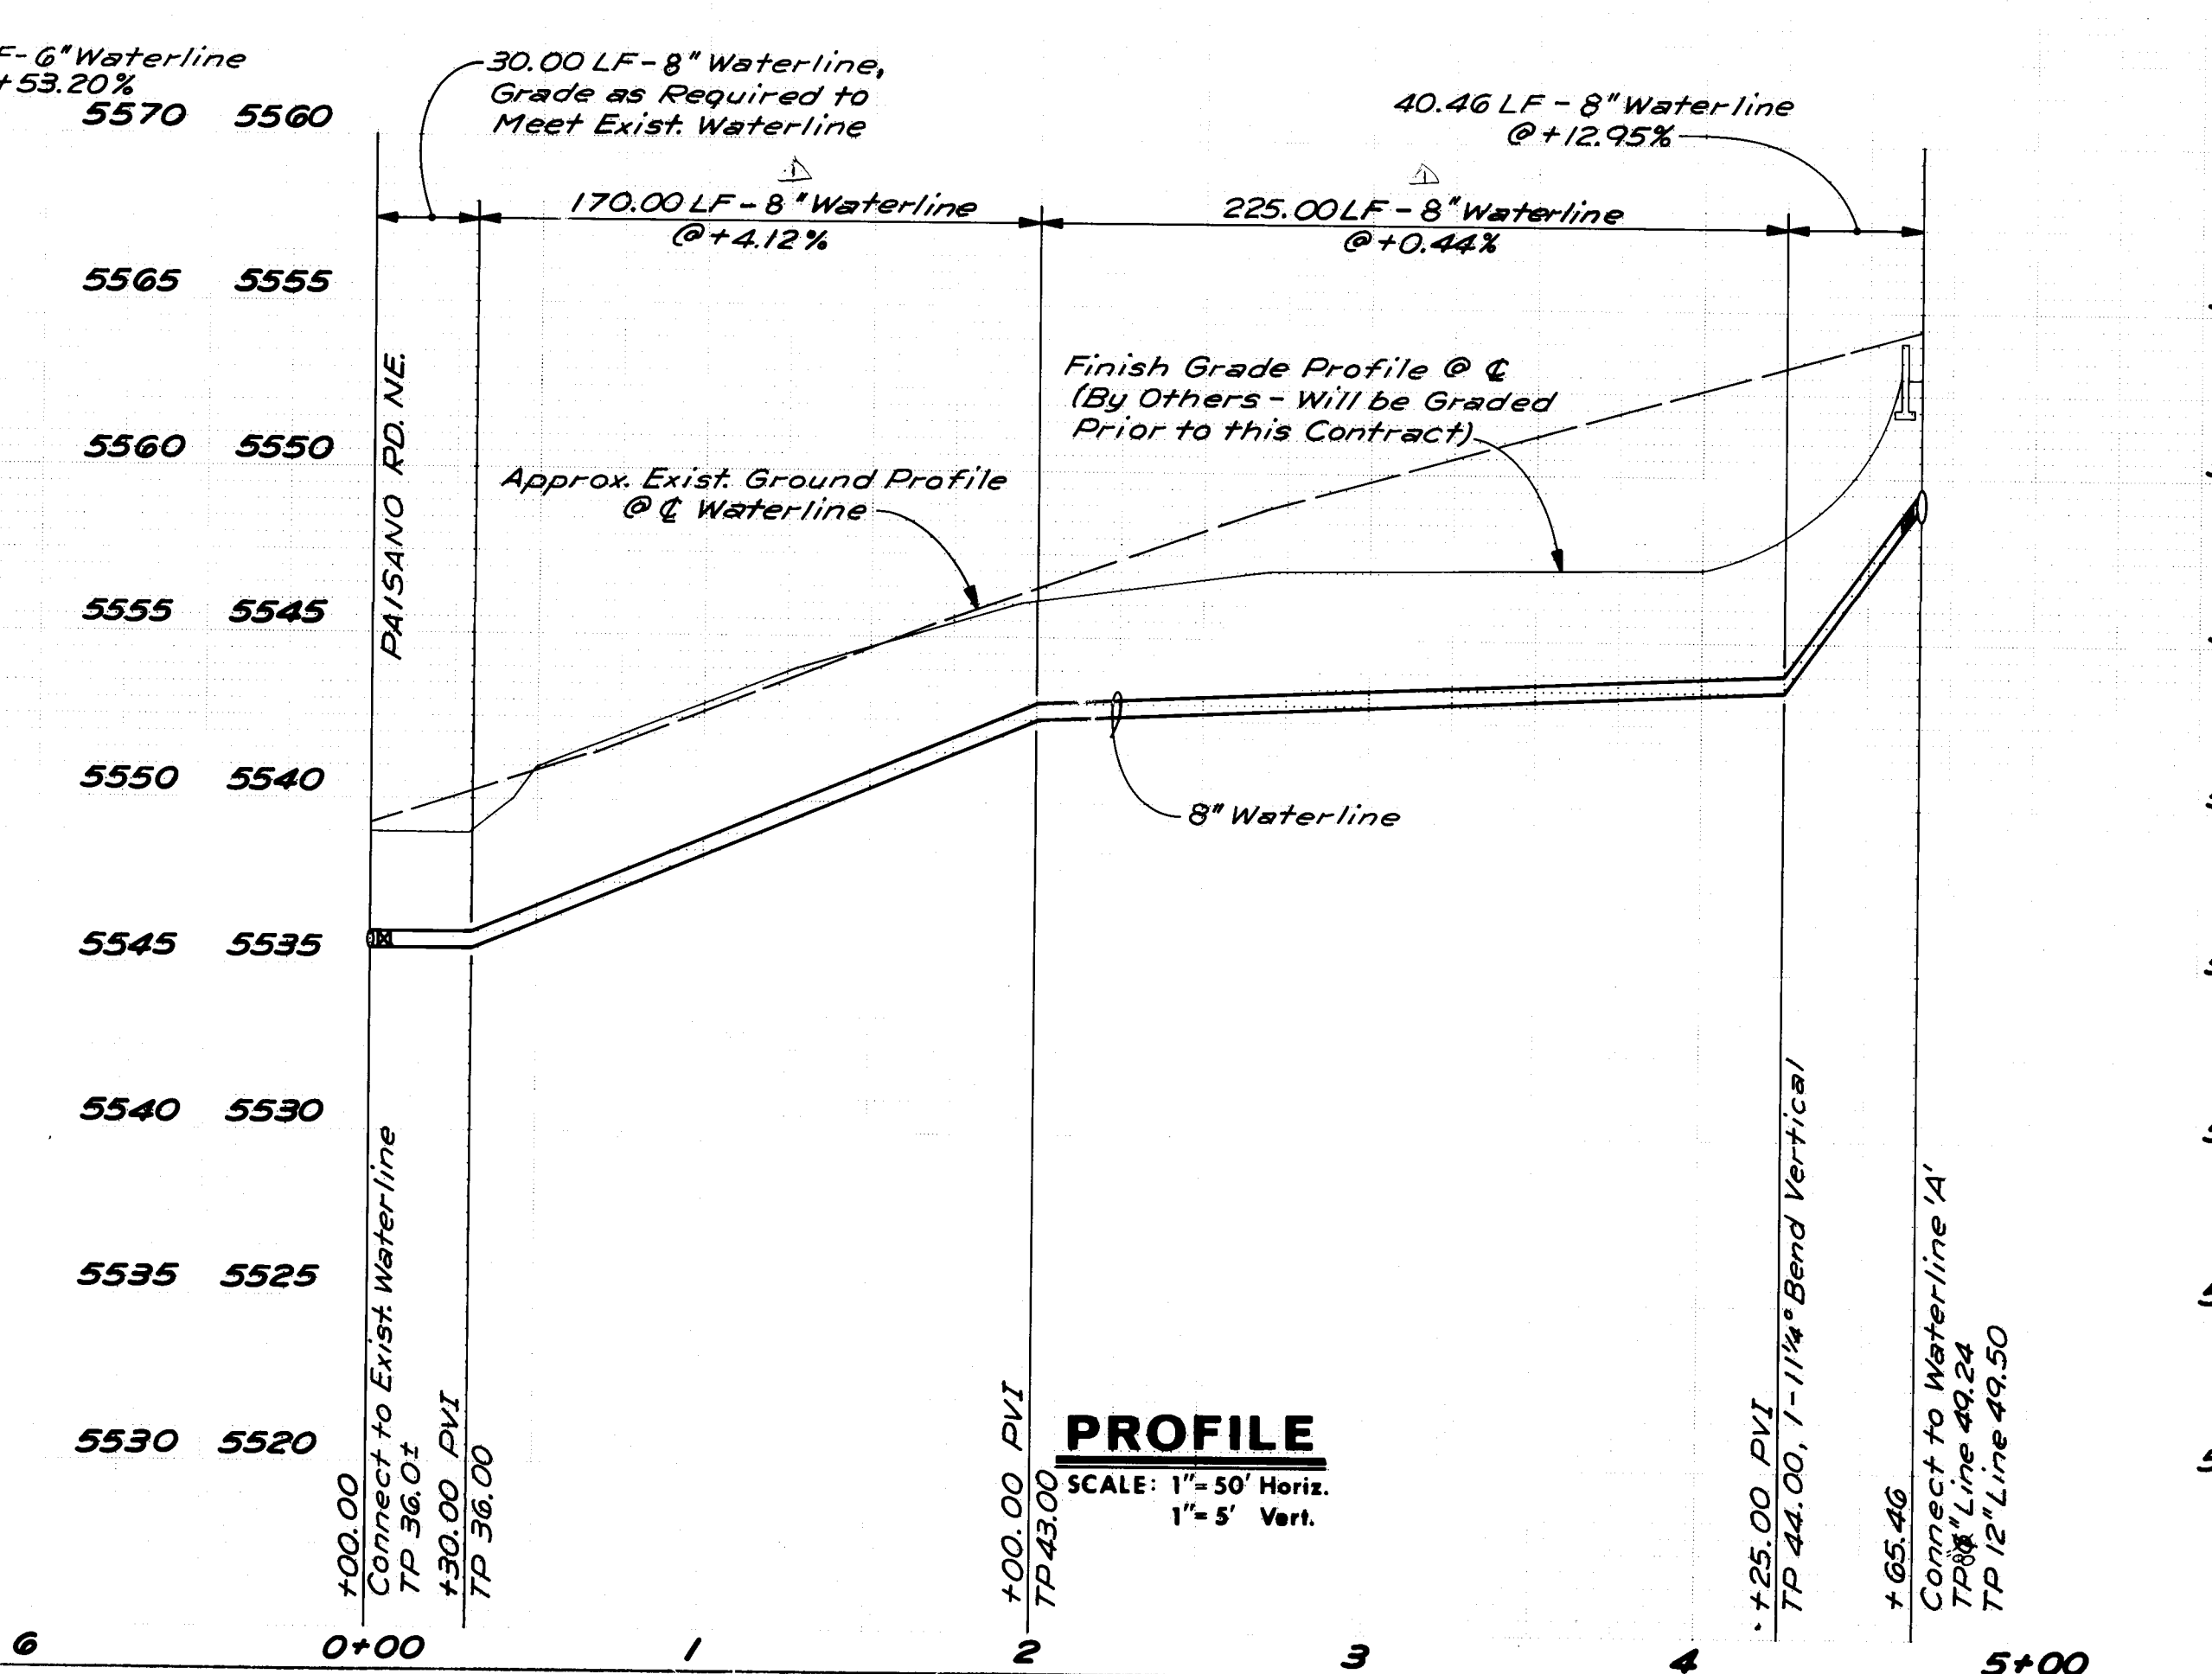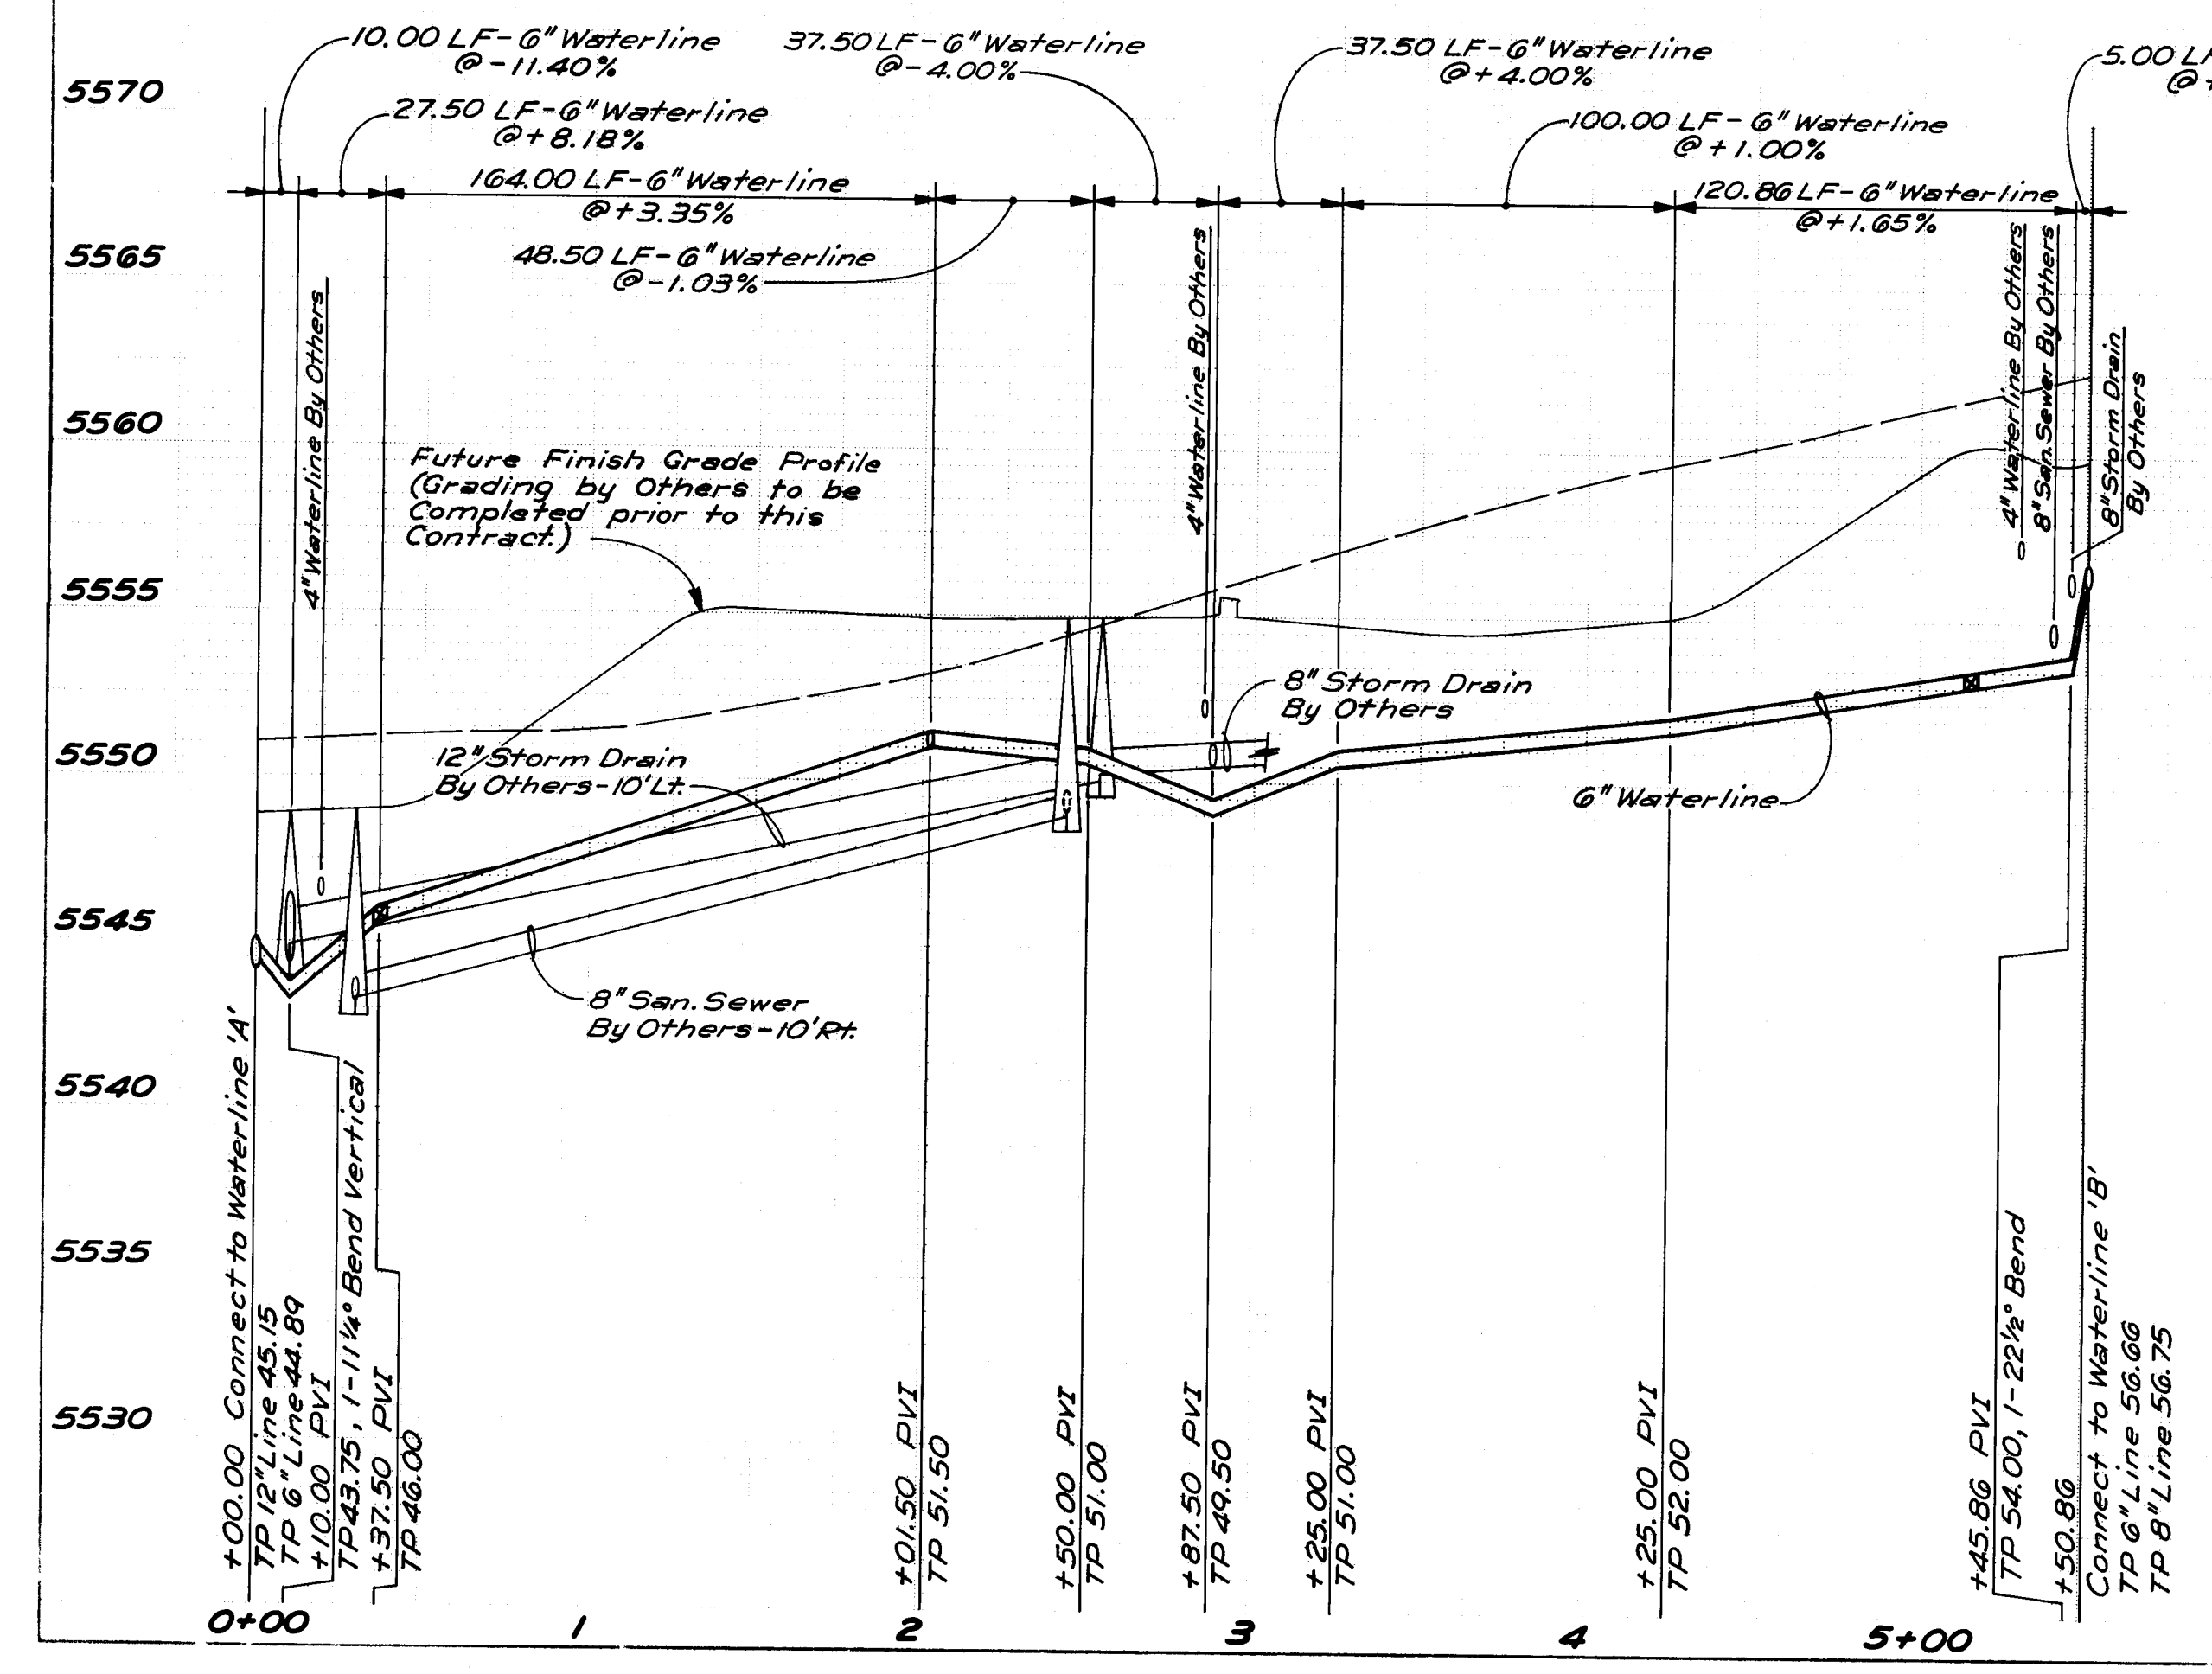

PROFILE
SCALE: 1"=50' Horiz.
1"=5' Vert.

LEGEND

	NEW WATERLINE
	NEW FIRE HYDRANT
	EXISTING WATERLINE
	EXISTING FIRE HYDRANT
	EXISTING SANITARY SEWER
	EXISTING STORM DRAIN
	WATERLINE - BY OTHERS
	SANITARY SEWER - BY OTHERS
	STORM DRAIN - BY OTHERS

NOTE:
STORM DRAINS & WATERLINES INDICATED TO BE BY OTHERS ARE PRIVATE LINES WITH THE SINGLE EXCEPTION OF WATERLINE INDICATED TO BE PROJECT NO. 2104. MOST WILL BE COMPLETED PRIOR TO CONSTRUCTION UNDER THIS CONTRACT; HOWEVER, IT IS POSSIBLE THAT SOME CONCURRENT CONSTRUCTION MAY TAKE PLACE.

AS-BUILT

26 20970785

CITY OF ALBUQUERQUE WATER RESOURCES DEPARTMENT ENGINEERING DIVISION					
SANDIA RIDGE WATERLINE EXTENSIONS WATERLINES 'C' & 'D' PLAN & PROFILE					
APPROVALS	ENGINEER	DATE	APPROVALS	ENGINEER	DATE
City Engineer	<i>C. A. Chavez</i>	8/1/84	Liquid Waste	<i>R. Pena</i>	7/25/84
A.C.E. Design	<i>A. A. Chavez</i>	8/1/84	Traffic	<i>N.A. Duff</i>	7/25/84
A.C.E. Hydrology	<i>N.A. Duff</i>	7/25/84	Water	<i>R. Pena</i>	7/25/84

DESIGNED BY	DRAWN BY	CHECKED BY	DATE	DATE	DATE
JM	PMO	JM	May, 1984	May, 1984	May, 1984

REVISIONS	NO.	DATE	REMARKS	BY
DESIGN	1			

ENGINEER'S SEAL	DATE	TIME	BY

AS BUILT INFORMATION	CONTRACTOR	DATE	NO.
	ACS "1-121 RESET"	ELEV. = 5534.54 FEET (MSL)	
	STANDARD ACS BRASS CAP STAMPED "1-121 RESET 1974"		
	LOCATED IN TOP OF MEDIAN CURB 5' NORTH OF CENTERLINE OF CENTRAL AVENUE & 81' WEST OF JUAN TABO BOULEVARD CENTERLINE		

SURVEY INFORMATION		BENCH MARKS		AS BUILT INFORMATION	
NO.	BY	NO.	DATE	NO.	DATE