


MILDRED AVE NW

PAVING AND WATER

INDEX

SHEET 1. TITLE SHEET
SHEET 2. PLAN & PROFILE

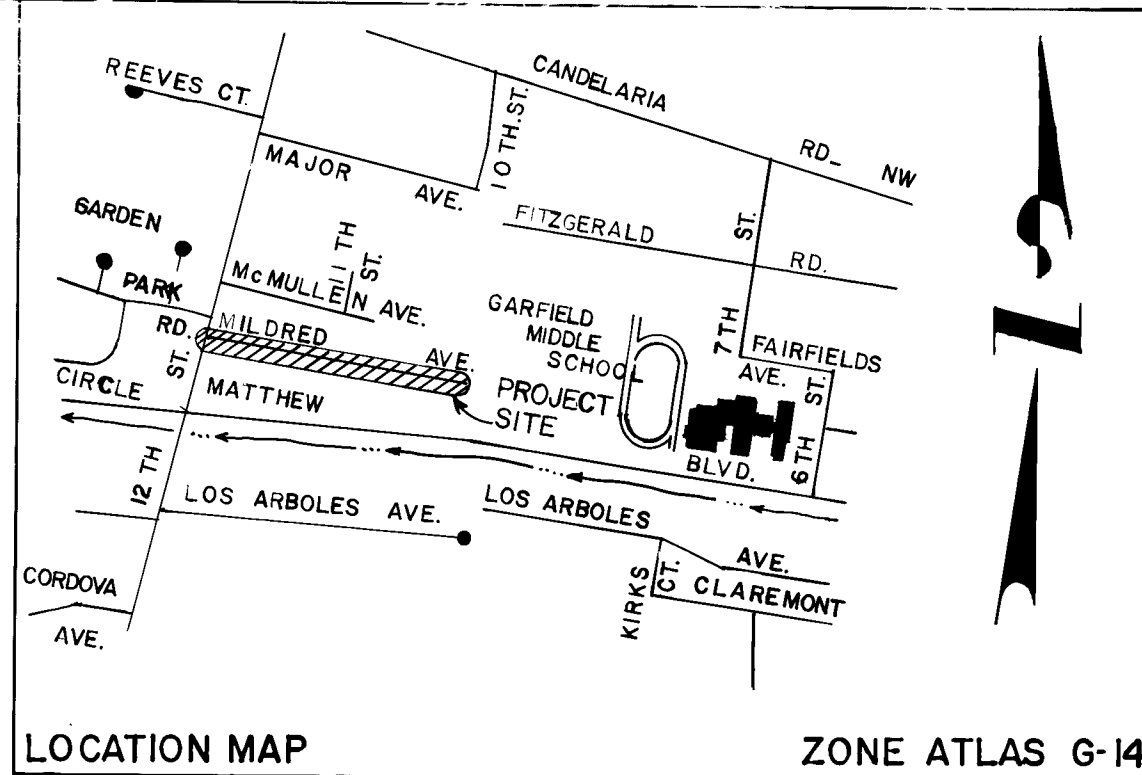

LOCATION MAP ZONE ATLAS G-14

NOTICE TO CONTRACTORS

1. All work detailed on these plans to be performed under contract shall, except as otherwise stated or provided for hereon, be constructed in accordance with the New Mexico Standard Specifications for Public Works Construction 1979-Edition (referred to herein as the Standard Specifications) and the Contract Documents for Public Works Contract 84-3.
2. Two(2) working days prior to any excavation, the contractor must contact Line Locating Service, 765-1234 for location of existing utilities.
3. Prior to construction, the contractor shall excavate and verify the horizontal and vertical locations of all obstructions. Should a conflict exist, the contractor shall notify the engineer or surveyor so that the conflict can be resolved with minimum amount of delay.

THE FOLLOWING NOTES ALSO APPLY WHEN CHECKED

- ☐ All utilities and utility service lines shall be installed prior to paving.
- ☒ Backfill compaction shall be according to specified street use. *Temporary*
- ☒ Tack coat requirements shall be determined by the City Engineer.
- ☐ Sidewalks and wheelchair ramps within the curb returns shall be constructed wherever a new curb return is constructed.
- ☐ If curb is depressed for a driveway or a handicap ramp, the driveway or ramp shall be constructed prior to acceptance of the curb and gutter.
- ☐ All storm drainage facilities shall be completed prior to final acceptance.


NOTICE TO CONTRACTORS

Installation of fire hydrants on sheet 2 shall not begin until receipt of easements is VERIFIED with City Engineer's Office.

L. J. McManis
DA 9/24/85

26 21010185

ENGINEER'S SEAL	CITY OF ALBUQUERQUE MUNICIPAL DEVELOPMENT DEPARTMENT ENGINEERING DIVISION	APPROVED FOR CONSTRUCTION <i>C. D. Shippard</i> CITY ENGINEER
	PROJECT NO. 2101	SHEET 1 OF 2

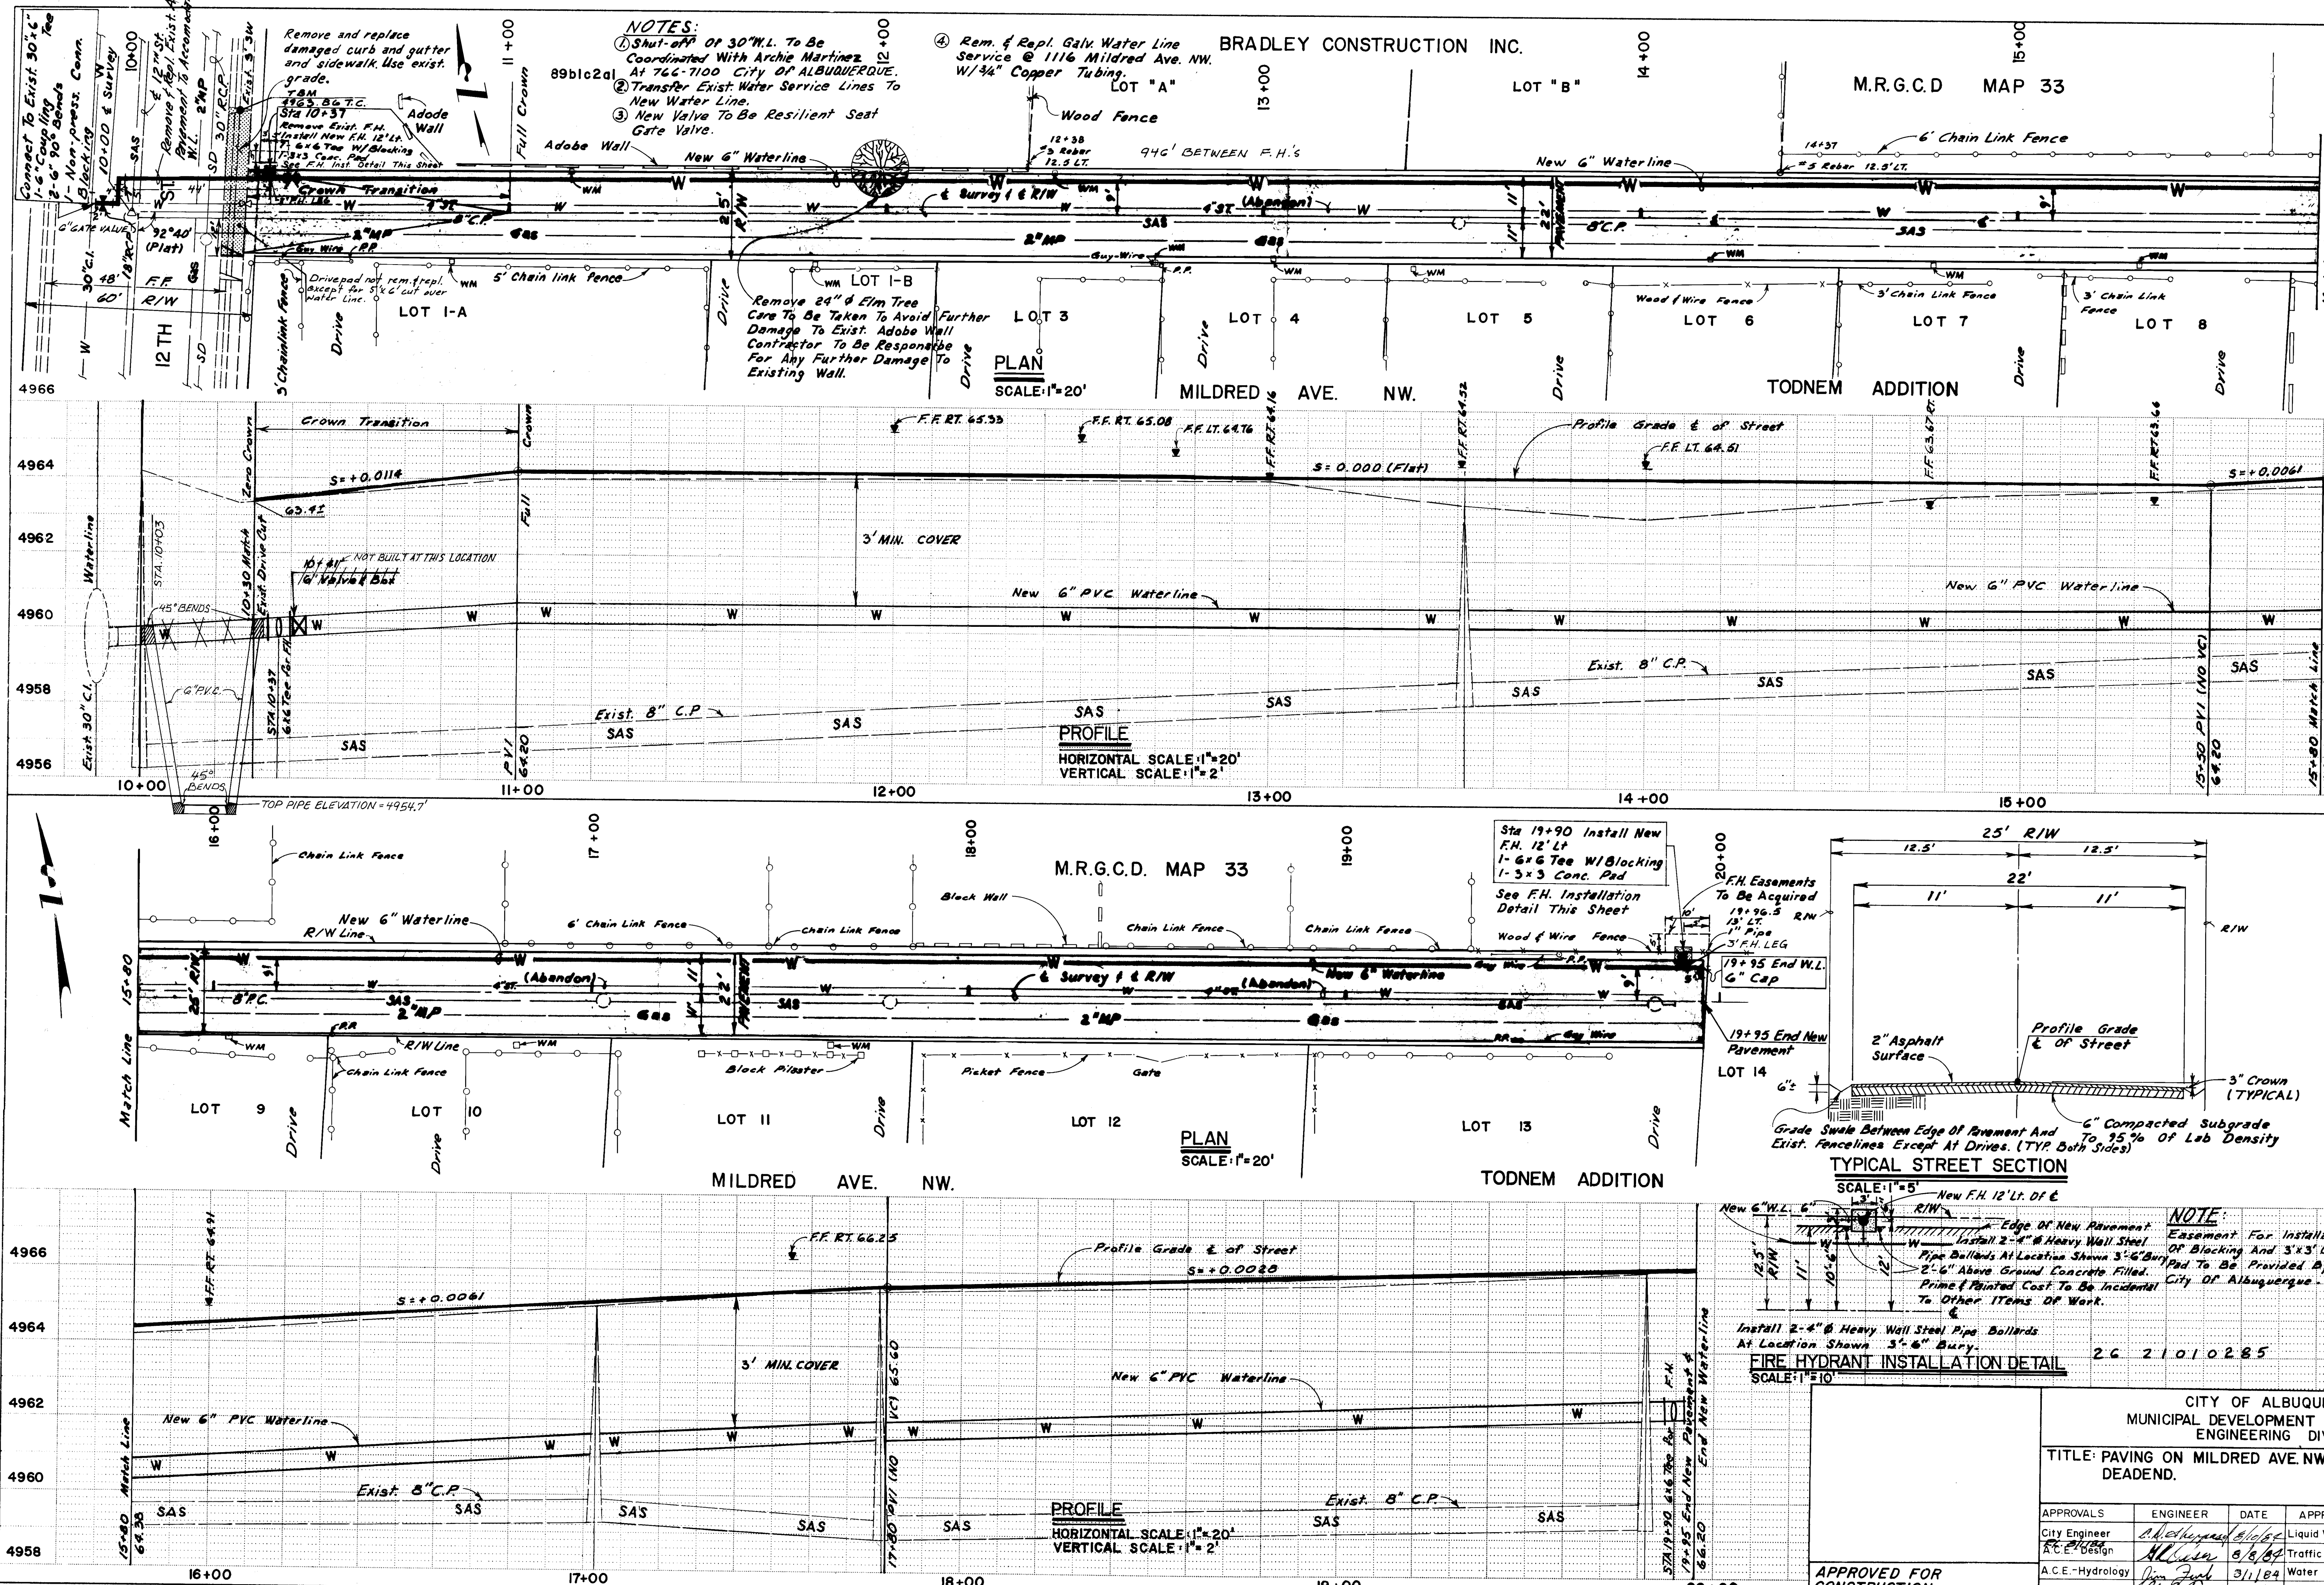

NOTES:
1. Shut-off of 30" W.L. To Be Coordinated With Archie Martinez At 744-7100 City Of ALBUQUERQUE.
2. Transfer Exist. Water Service Lines To New Water Line.
3. New Valve To Be Resilient Seat Gate Valve.
4. Rem. & Repl. Galv. Water Line Service @ 1116 Mildred Ave. NW. W/ 3/4" Copper Tubing.

BRADLEY CONSTRUCTION INC.

M.R.G.C.D MAP 33

PLAN
SCALE: 1"=20'

PROFILE
HORIZONTAL SCALE: 1"=20'
VERTICAL SCALE: 1"=2'

PLAN
SCALE: 1"=20'

PROFILE
HORIZONTAL SCALE: 1"=20'
VERTICAL SCALE: 1"=2'

TYPICAL STREET SECTION
SCALE: 1"=5'

NOTE:
Install 2-4" Heavy Wall Steel Pipe Ballards At Location Shown 3'-6" Bury. Prime & Painted. Cost To Be Incidental To Other Items Of Work.
26 21010285

FIRE HYDRANT INSTALLATION DETAIL
SCALE: 1"=10'

CITY OF ALBUQUERQUE
MUNICIPAL DEVELOPMENT DEPARTMENT
ENGINEERING DIVISION
TITLE: PAVING ON MILDRED AVE. NW. FROM 12TH ST. NW TO DEADEND.

APPROVALS	ENGINEER	DATE	APPROVALS	ENGINEER	DATE
City Engineer	<i>[Signature]</i>	8/1/84	Liquid Waste	<i>[Signature]</i>	8/1/84
A.C.E. Design	<i>[Signature]</i>	8/8/84	Traffic	<i>[Signature]</i>	8/1/84
A.C.E. Hydrology	<i>[Signature]</i>	3/1/84	Water	<i>[Signature]</i>	8/1/84
ST. MAINT. ENG.	<i>[Signature]</i>	8/2/84			

APPROVED FOR CONSTRUCTION
CITY ENGINEER
DATE: 8/1/84

DRAWING NO. 2101
SHEET 2 OF 2

AS BUILT INFORMATION	
CONTRACTOR	BRADLEY CONSTRUCTION INC.
INSPECTOR'S NAME	STANLEY
DATE	8/1/84
STATIONING BY	DATE
FIELD VERIFICATION BY	DATE
CORRECTION BY	DATE
MICRO-FILM INFORMATION	
RECORDED BY	NO.
DATE	4963.66

SURVEY INFORMATION	
FIELD NOTES	DATE
NO.	BY
PS-33	G. ARCHUNDE
DATE	4-10-84

REFERENCES	
MAP NO.	W.D. NO.
EST. NO.	BY

REVISIONS	
NO.	DATE
DESIGNED BY	DATE
DRAWN BY	DATE
CHECKED BY	DATE

1015