
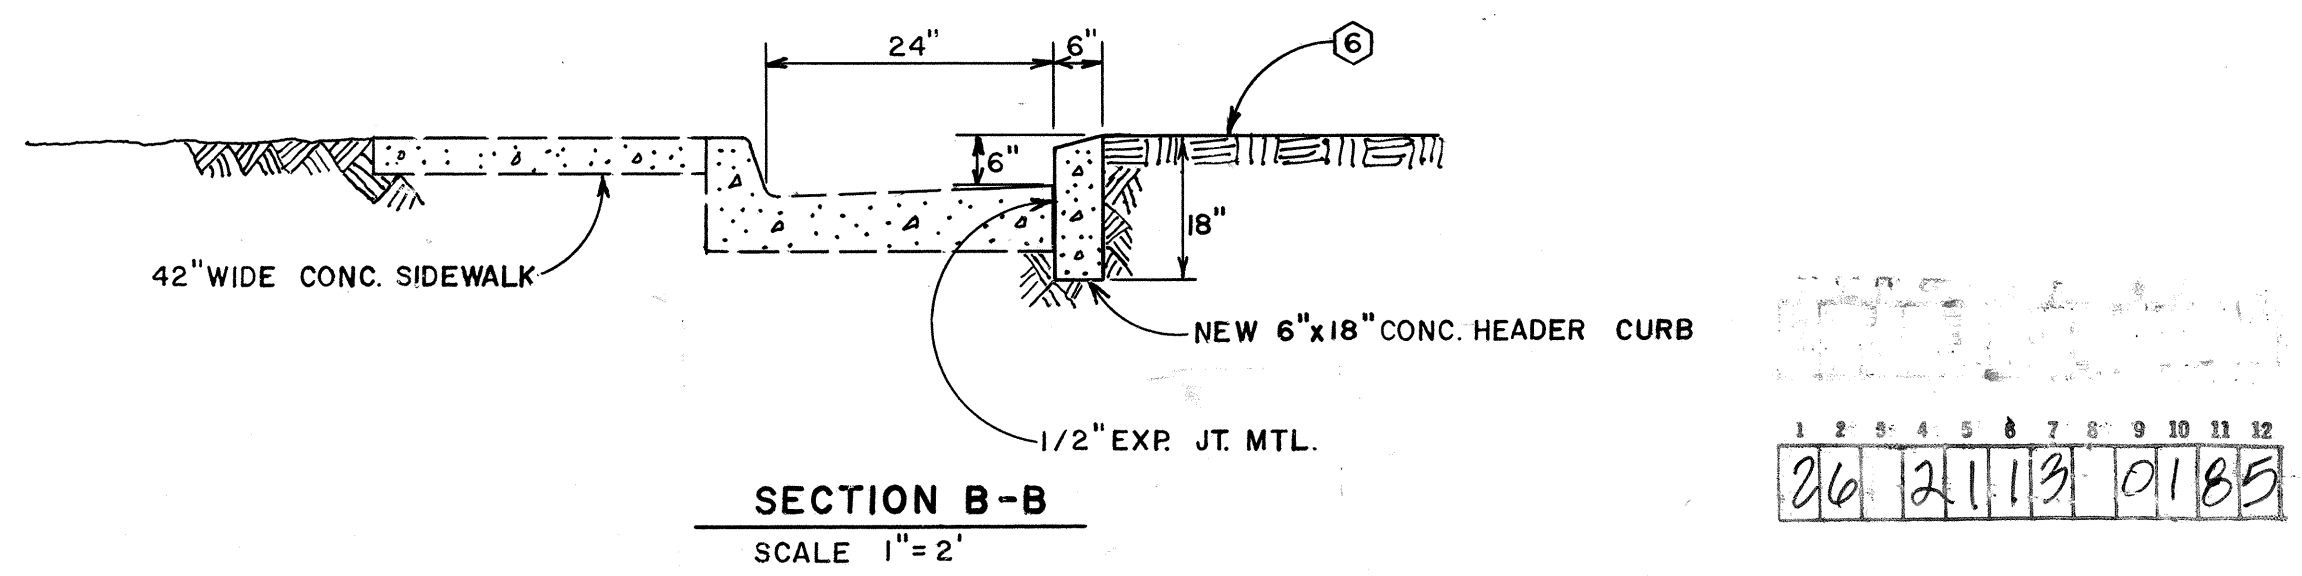
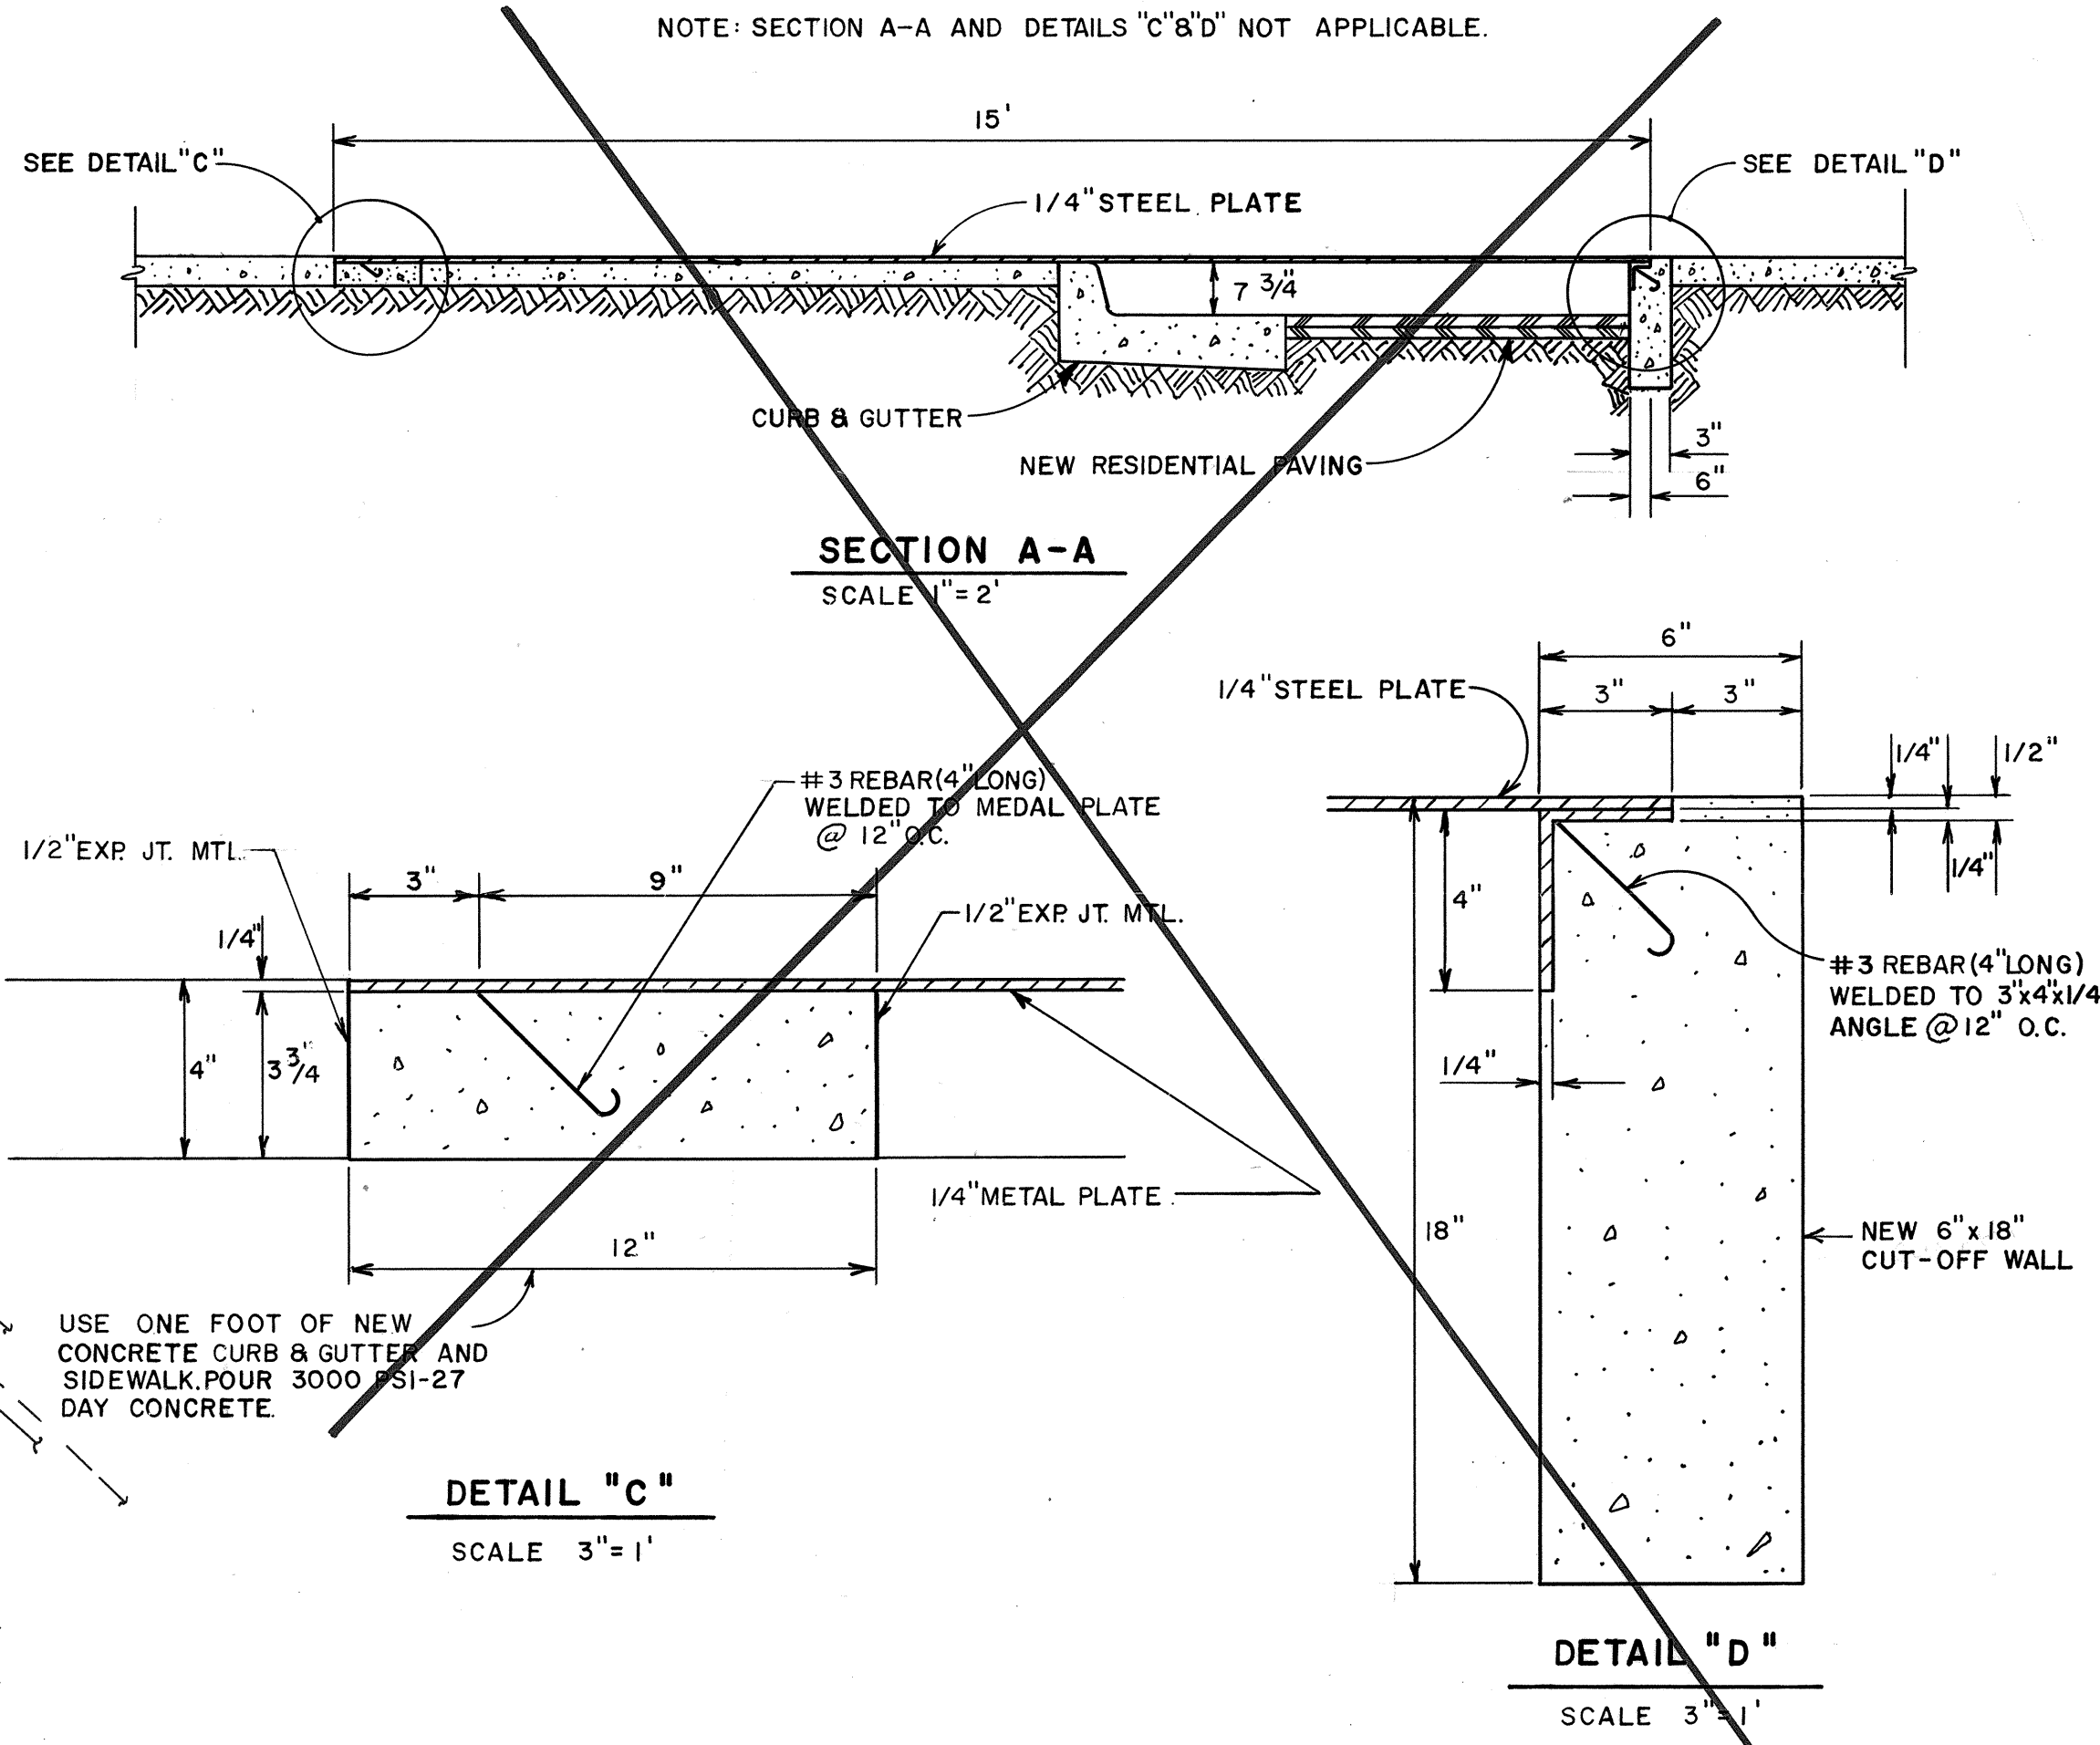
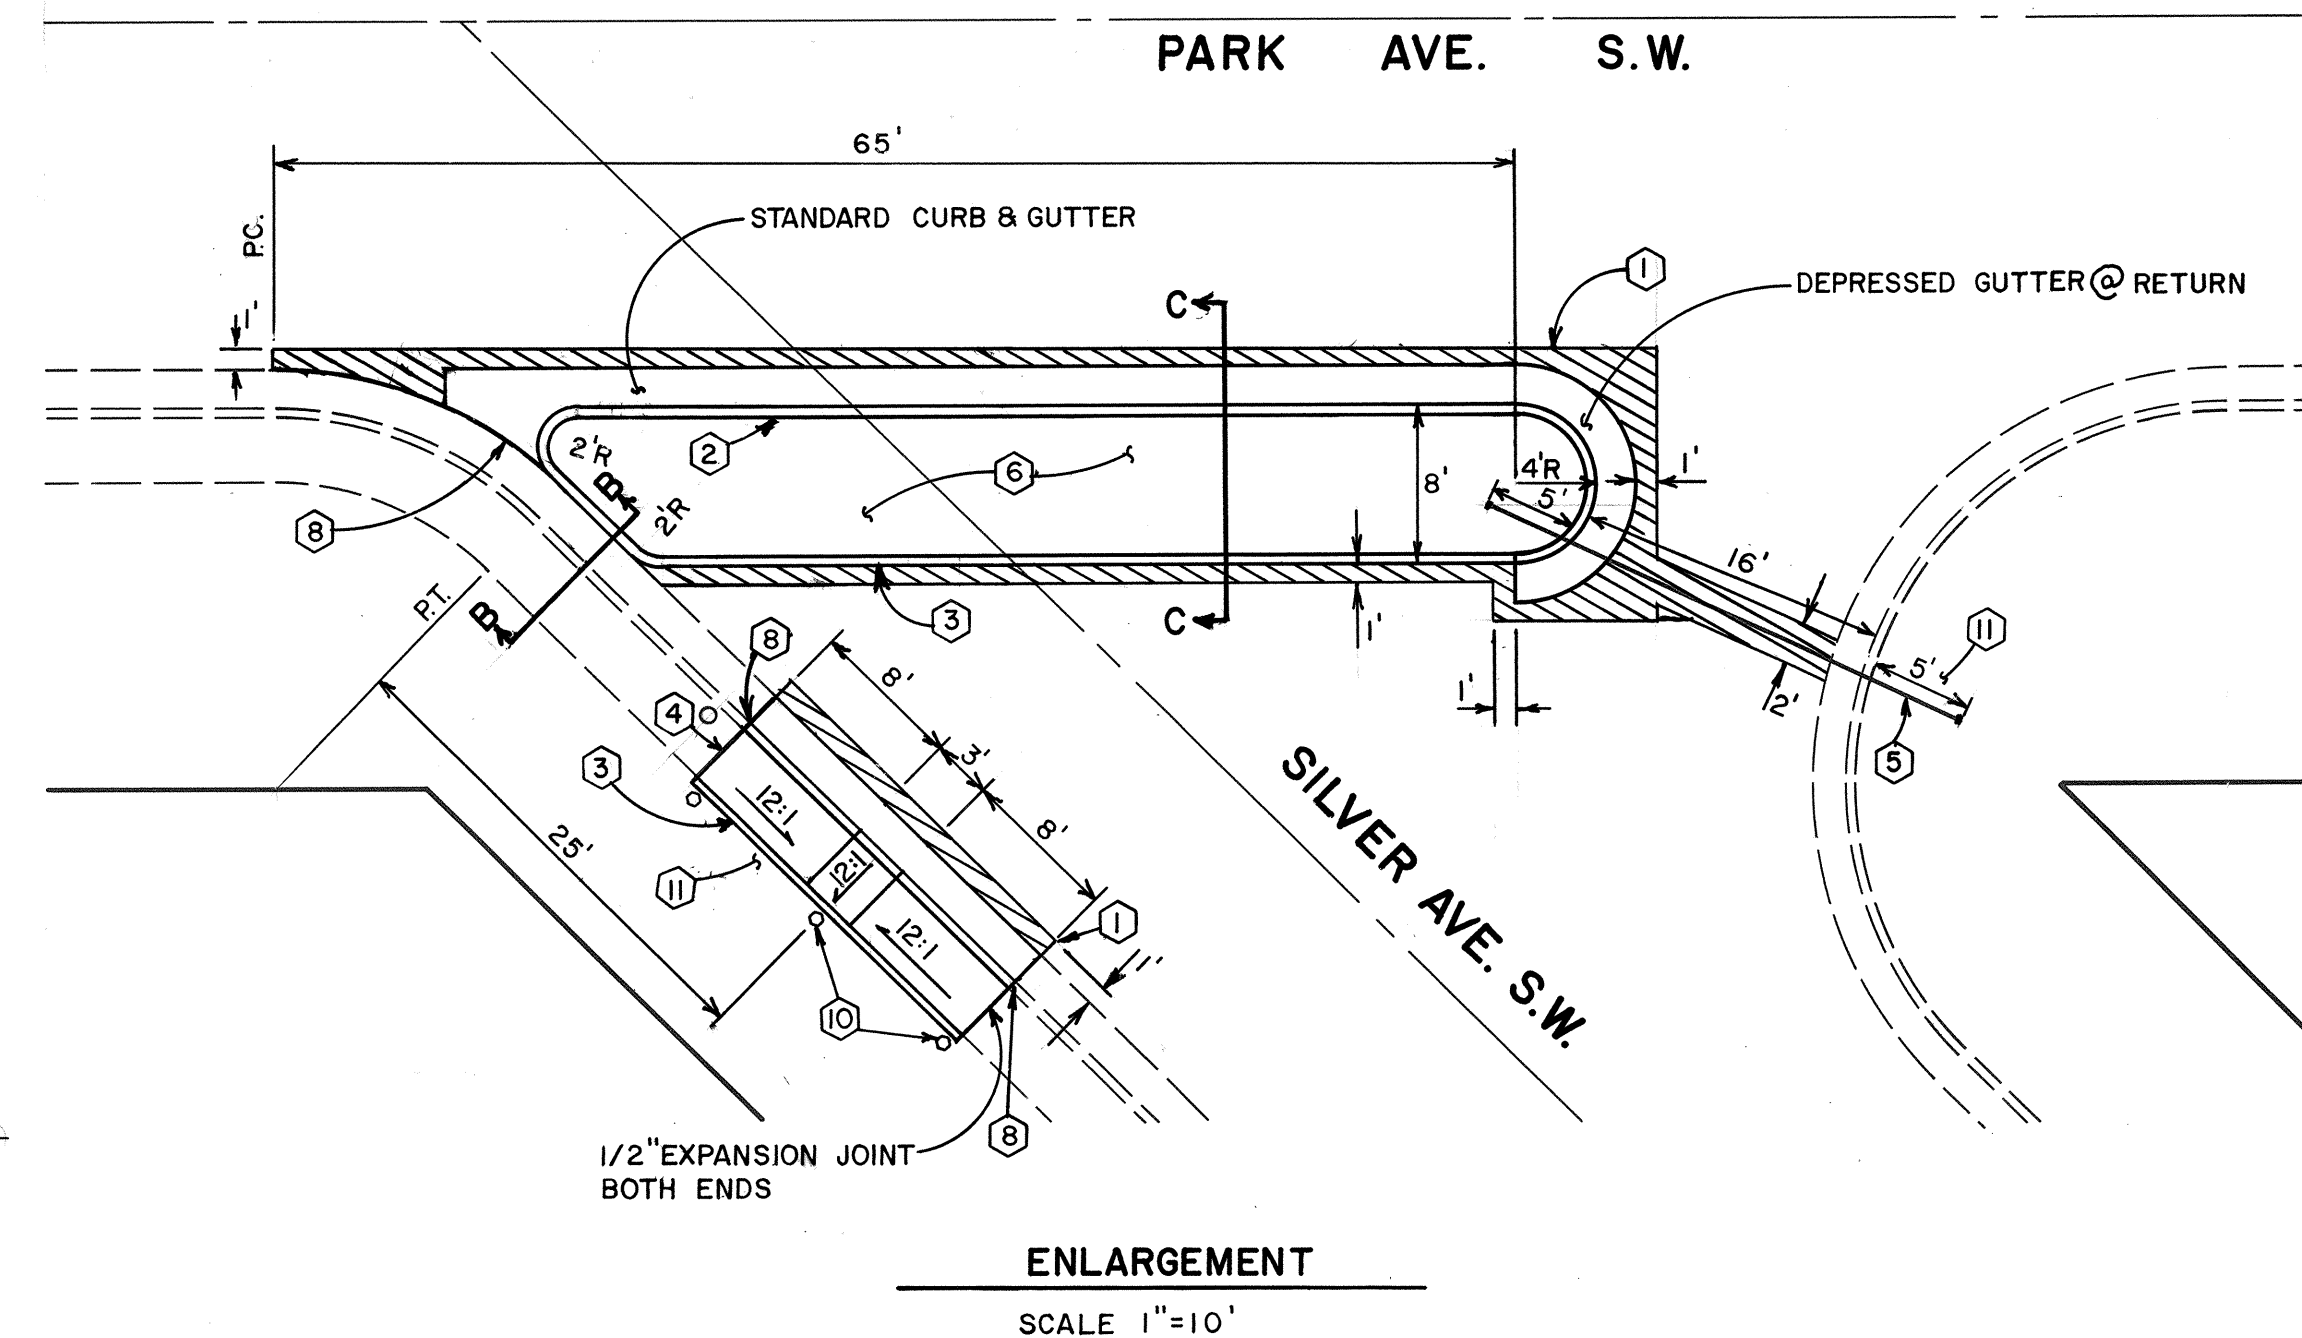


HUNING CASTLE ADDITION

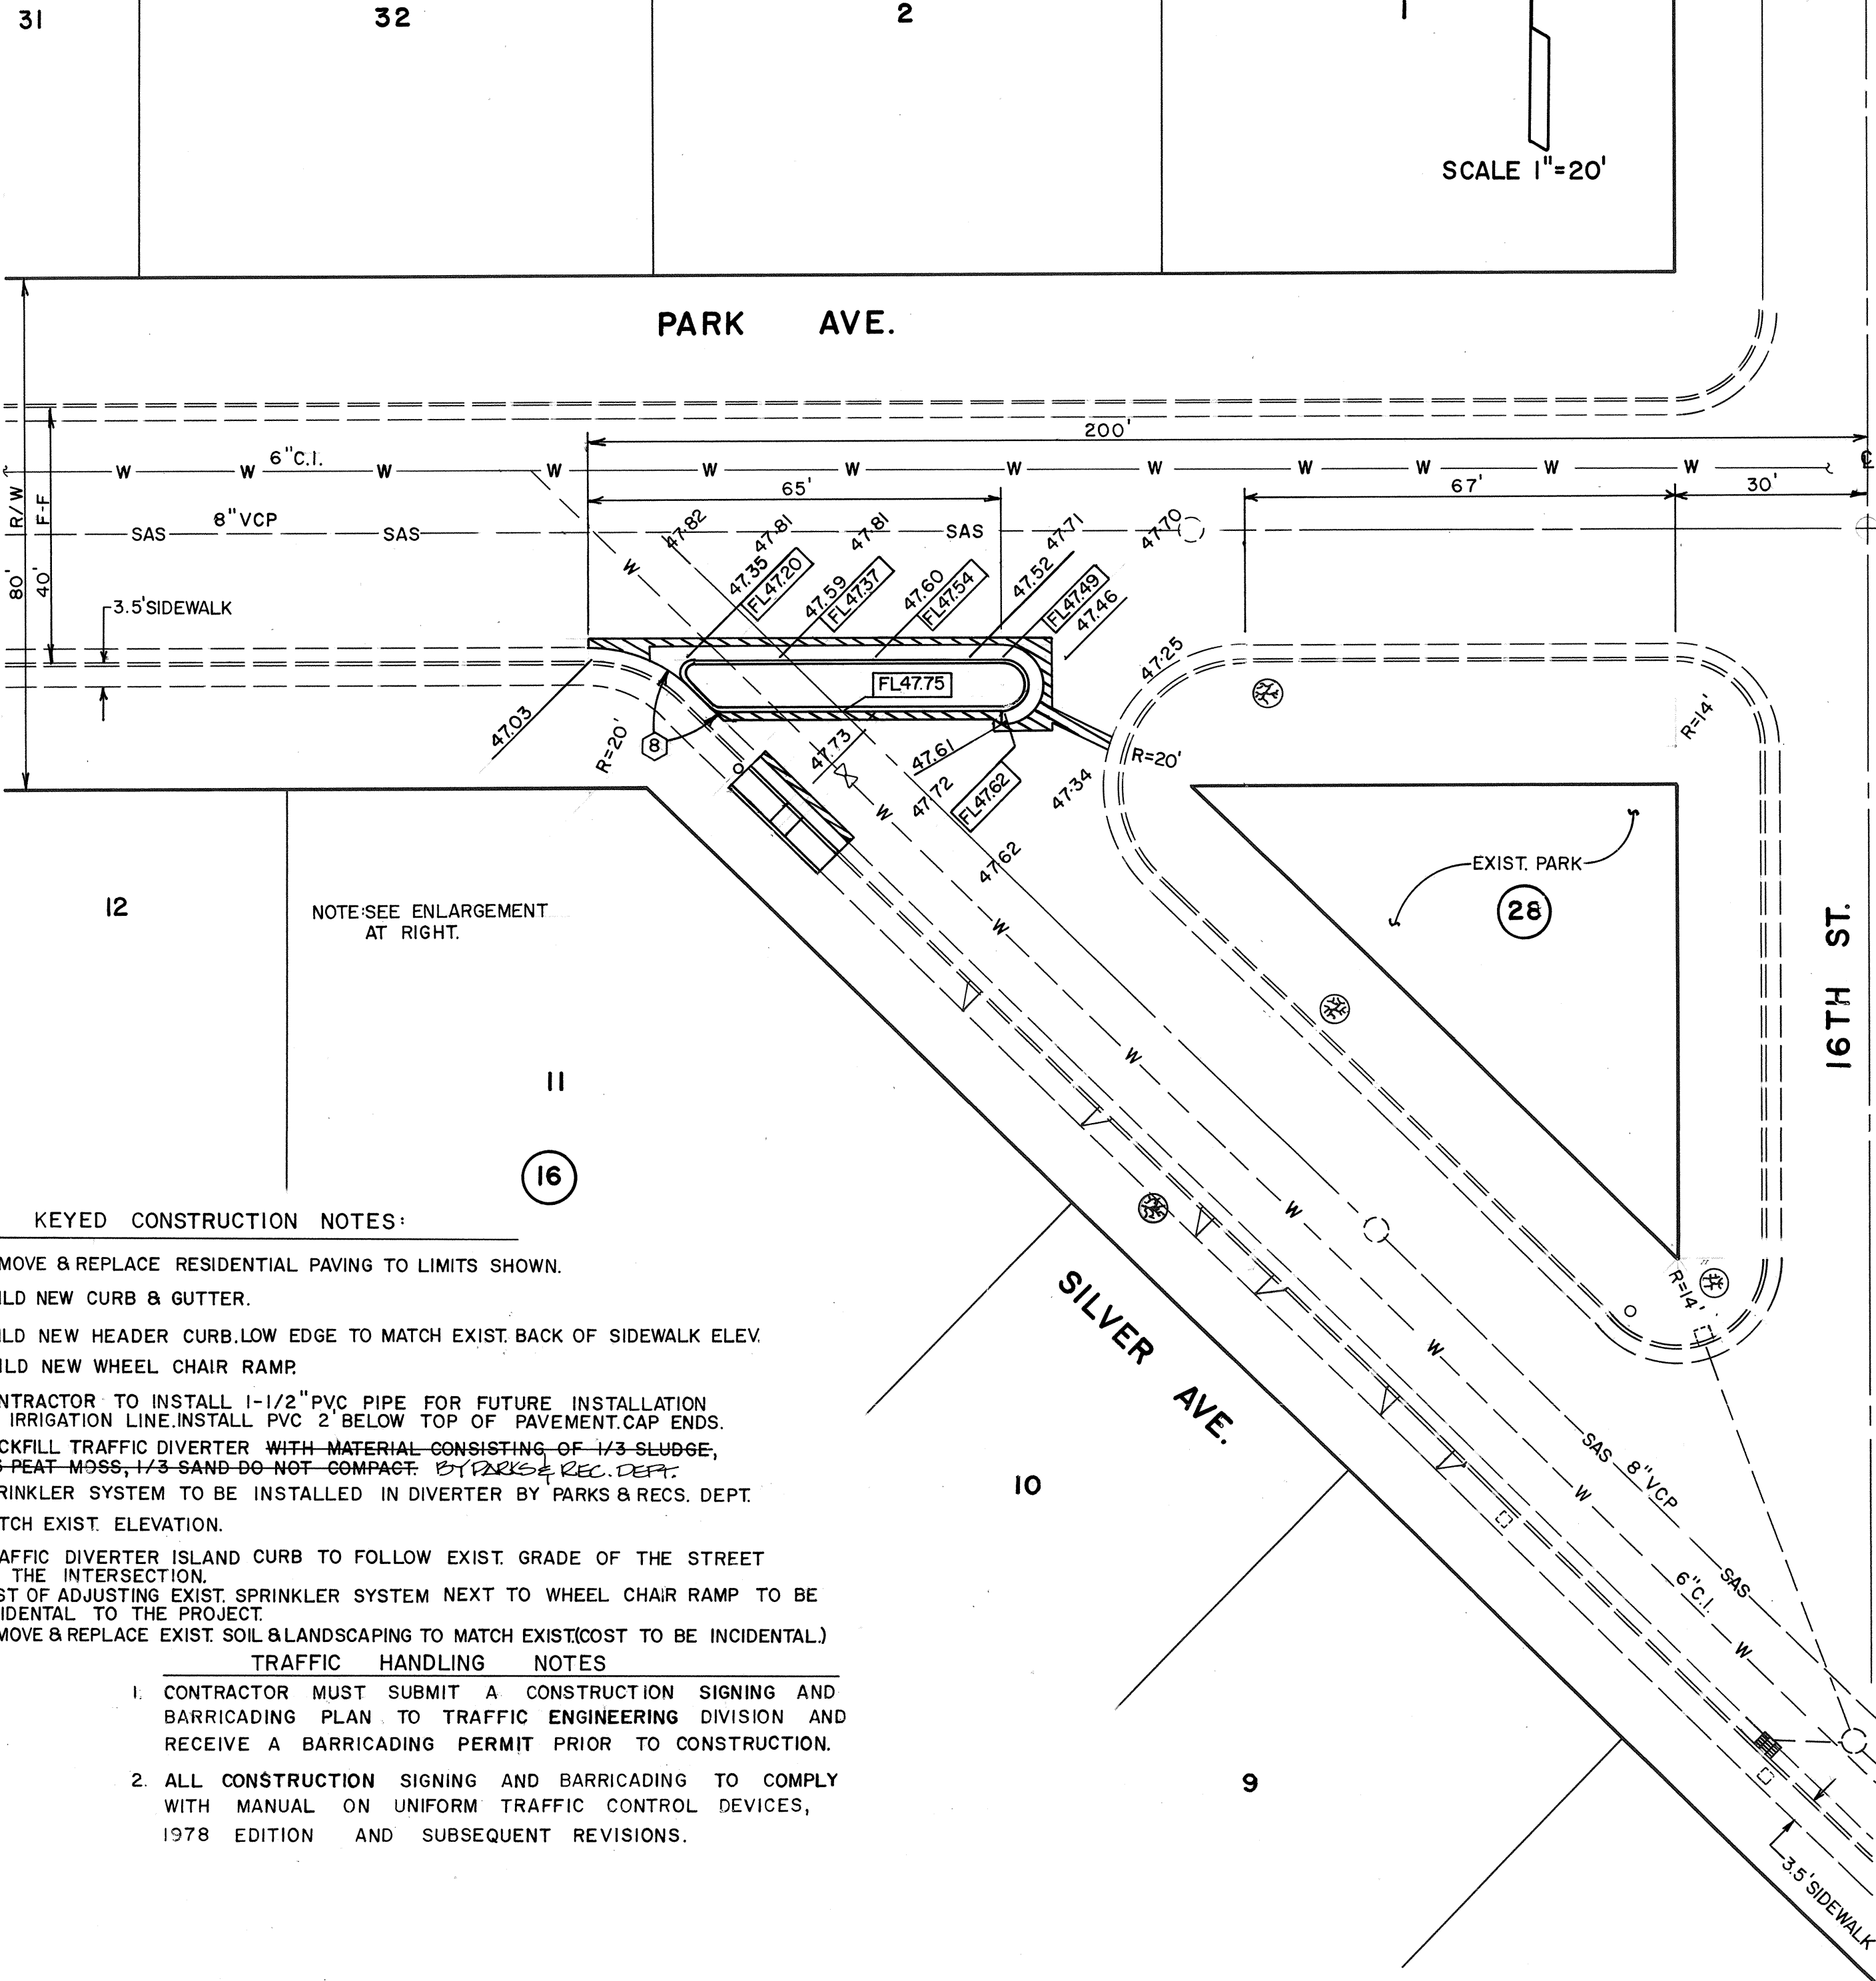

AS BUILT INFORMATION				BENCH MARKS				SURVEY INFORMATION				ENGINEER'S SEAL			
CONTRACTOR				INSPECTOR				DATE				NO.			
WORK				DATE				DATE				DATE			
ACCEPTANCE BY				DATE				DATE				DATE			
DRAWN BY				DATE				DATE				DATE			
CHECKED BY				DATE				DATE				DATE			
RECORDED BY				DATE				DATE				DATE			
G-13 3" BWH BRASS CAP IN CONC FLUSH WITH GROUND				LOCATED 34' NE FROM Q. OF TINGLEY DR. & 306' NW				DATE				NO.			
FROM Q. OF ALCALDE PL.				ELEV 4956.95				DATE				NO.			
T.B.M. TOP OF CURB AT RC. WNW RETURN OF SAN				PATRICIO AVE. BALCALDE PL. ELEV 4946.42				DATE				NO.			
RECORDED BY				DATE				DATE				DATE			
NO.				DATE				DATE				DATE			

NOTICE TO CONTRACTORS

1. All work detailed on these plans to be performed under contract shall, except as otherwise stated or provided for herein, be constructed in accordance with the New Mexico Standard Specifications for Public Works Construction-1979 Edition (referred to herein as the Standard Specifications) and the Contract Documents for Public Works Contract 84-5.

2. Two (2) working days prior to any excavation, the contractor must contact Line Locating Service, 765-1234, for location of existing utilities.

3. Prior to construction, the contractor shall excavate and verify the horizontal and vertical locations of all obstructions. Should a conflict exist, the contractor shall notify the engineer or surveyor so that the conflict can be resolved with minimum amount of delay.

THE FOLLOWING NOTES ALSO APPLY WHEN CHECKED

☐ All utilities and utility service lines shall be installed prior to paving.

☒ Backfill compaction shall be according to specified street use.

☒ Tack coat requirements shall be determined by the City Engineer.

☐ Sidewalks and wheelchair ramps within the curb returns shall be constructed wherever a new curb return is constructed.

☐ If curb is depressed for a driveway or a handicap ramp, the driveway or ramp shall be constructed prior to acceptance of the curb and gutter.

☐ All storm drainage facilities shall be completed prior to final acceptance.

LEGEND:

EXIST. CURB & GUTTER

NEW CURB & GUTTER

NEW RESIDENTIAL PAVING

EXIST. ELEVATION

NEW ELEVATION

FL. FLOWLINE

T.P. TOP OF PAVING

T.G. TOP OF GROUND

EXIST. WATER METER

EXIST. POWER POLE

EXIST. TREE

APPROVAL OF AS BUILT DRAWINGS

ASST. CITY ENGINEER - FIELD

W.F. McManus

DATE 1/31/85

APPROVED FOR CONSTRUCTION

CITY ENGINEER - FIELD

DATE 1/31/85

CITY OF ALBUQUERQUE

MUNICIPAL DEVELOPMENT DEPARTMENT

ENGINEERING DIVISION

TITLE: TRAFFIC DIVERTER ON SILVER AVE. AT PARK AVE.

APPROVALS	ENGINEER	DATE	APPROVALS	ENGINEER	DATE
City Engineer	W.F. McManus	1/31/85	Liquid Waste	R. Pina	6/29/84
A.C.E. - Design	W.F. McManus	1/31/85	Traffic	R. Pina	6/29/84
A.C.E. - Hydrology	W.F. McManus	1/31/85	Water	R. Pina	6/29/84

DRAWING NO. 2113

MAP NO. K-13

SHEET 1 OF 1