
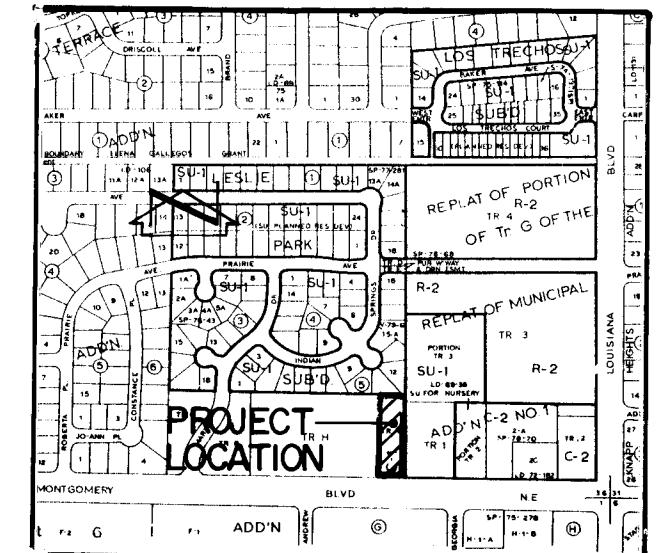


S112

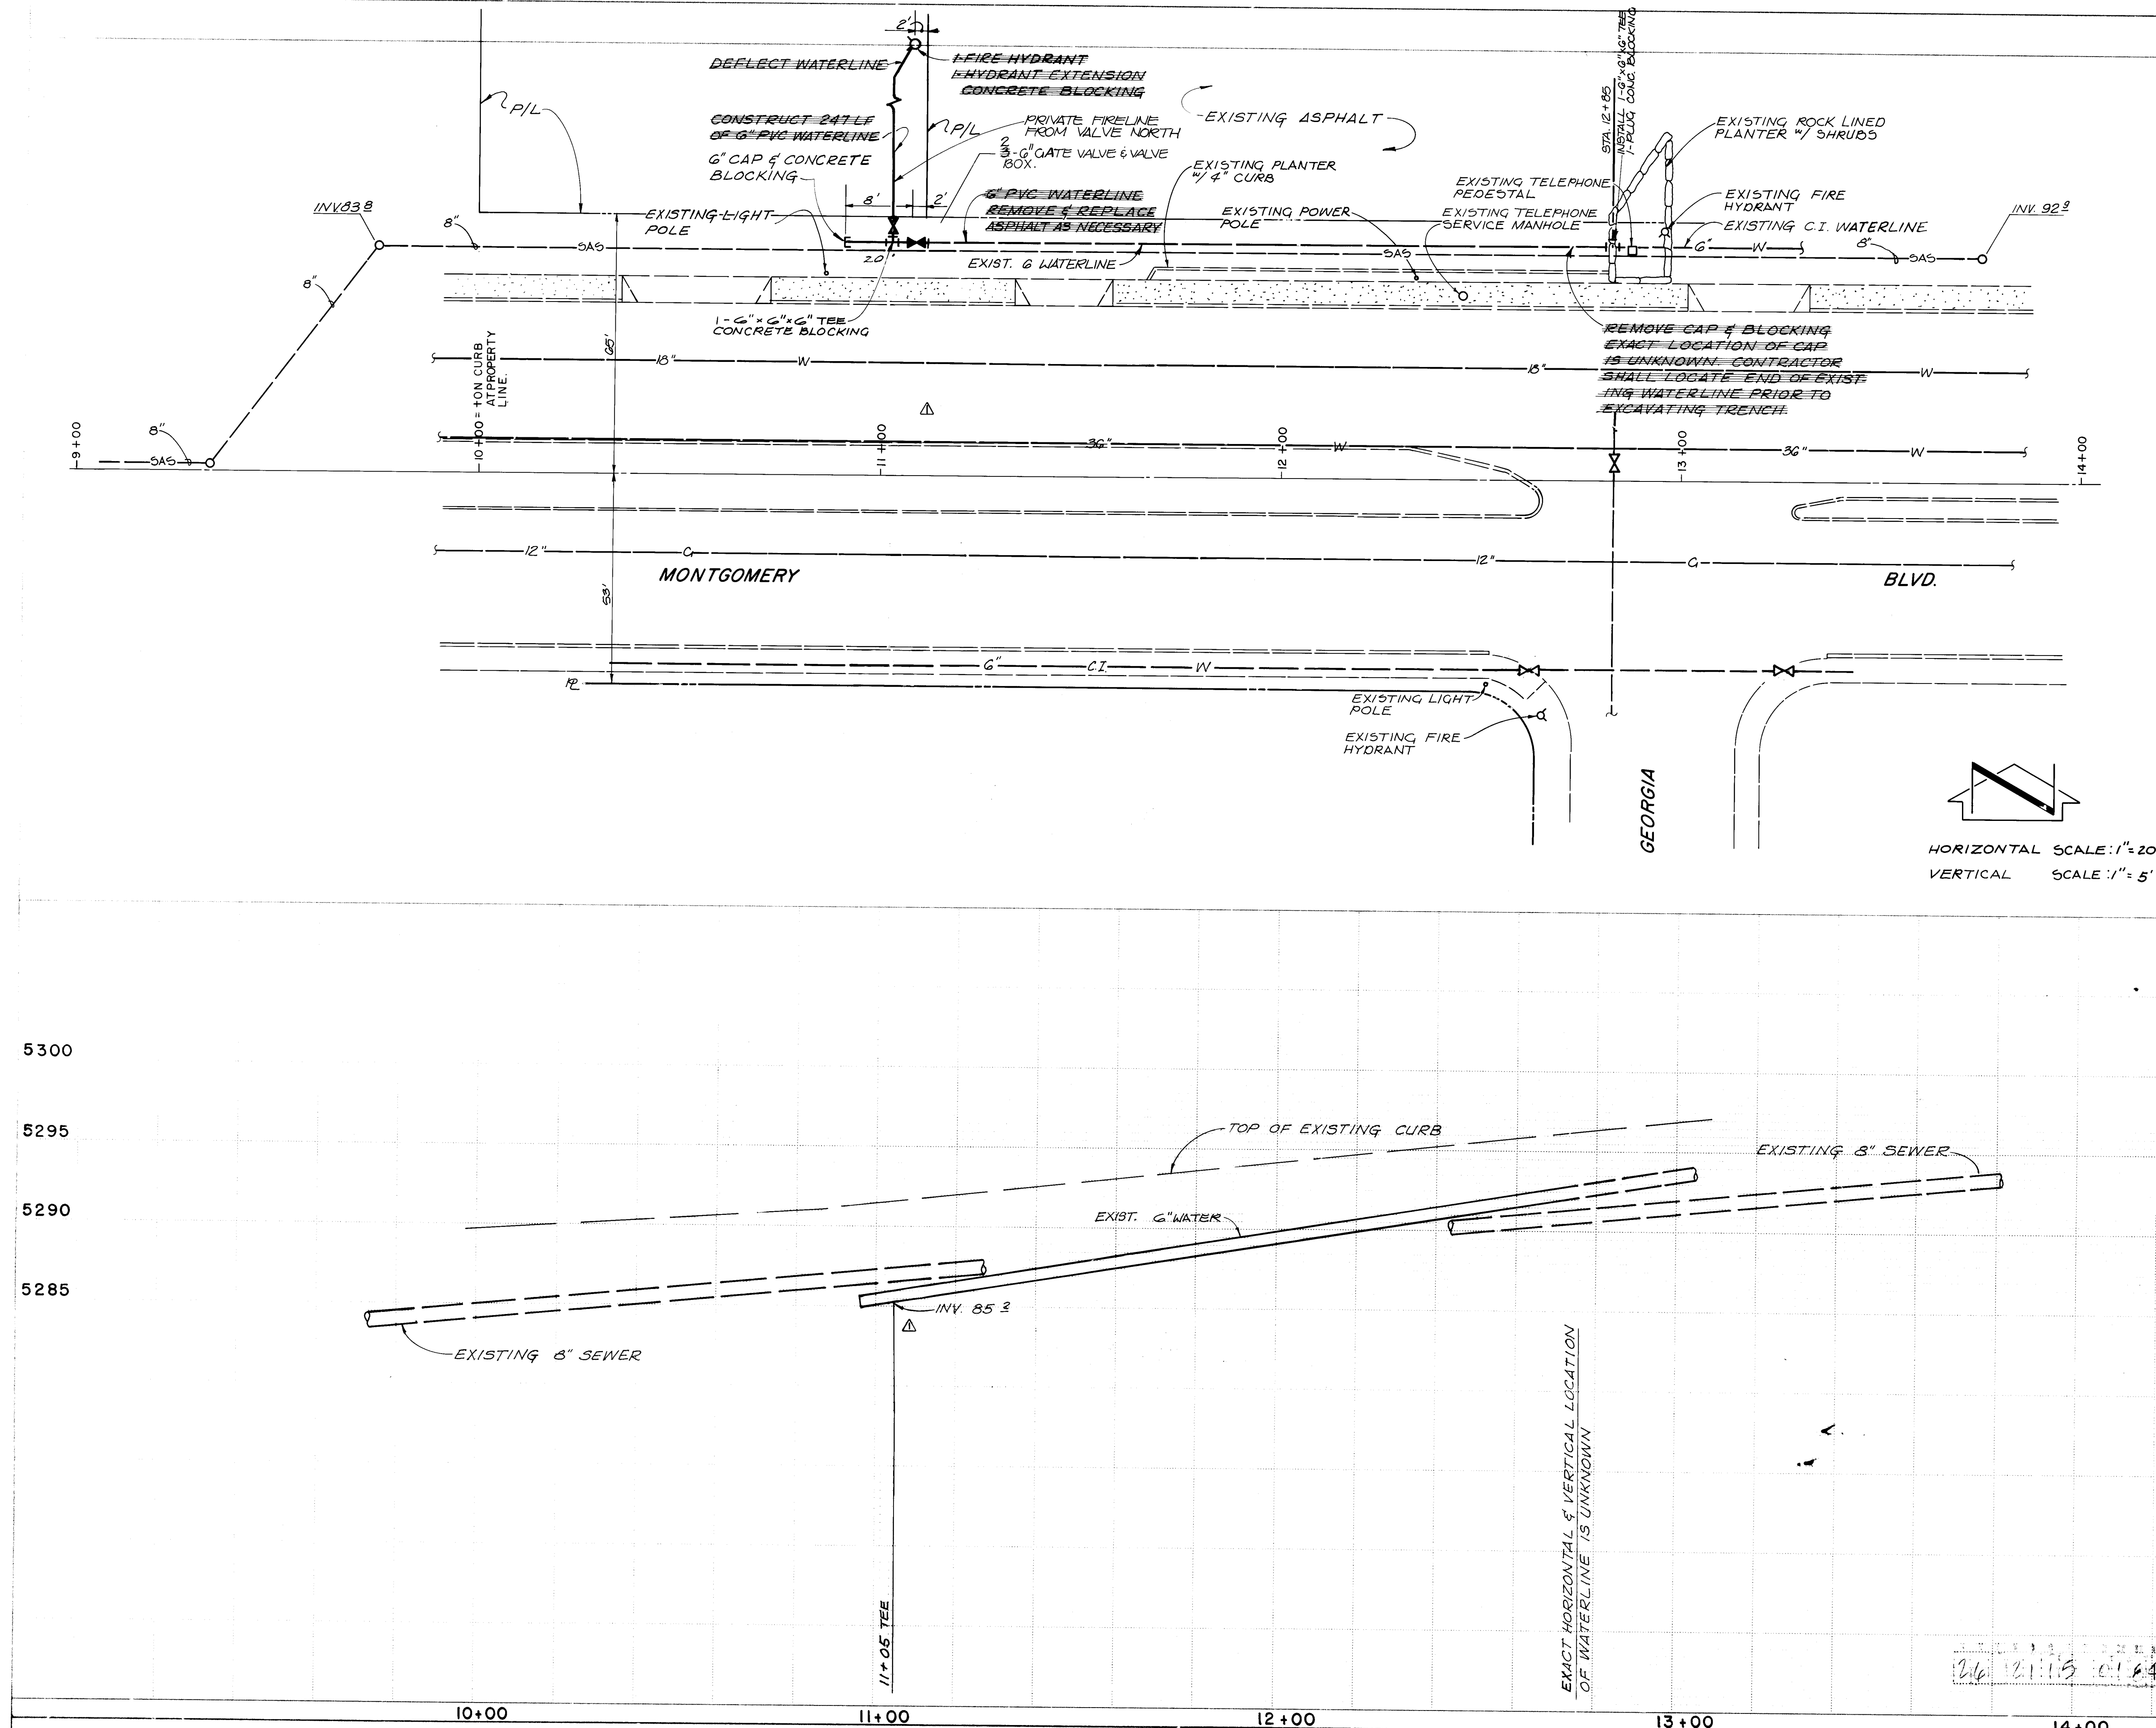

- GENERAL NOTES**
- ALL WORK DETAILED ON THESE PLANS TO BE PERFORMED UNDER CONTRACT SHALL, EXCEPT AS OTHERWISE STATED OR PROVIDED FOR HEREON, SHALL BE CONSTRUCTED IN ACCORDANCE WITH THE NEW MEXICO STANDARD SPECIFICATIONS FOR PUBLIC WORKS CONSTRUCTION - 1979 EDITION (REFERRED TO HEREIN AS THE STANDARD SPECIFICATIONS) AND THE CONTRACT DOCUMENTS FOR PUBLIC WORKS CONTRACT NO. 84-1.
 - TWO (2) WORKING DAYS PRIOR TO ANY EXCAVATION, CONTRACTOR MUST CONTACT LINE LOCATING SERVICE, 765-1234, FOR LOCATION OF EXISTING UTILITIES.
 - PRIOR TO CONSTRUCTION, THE CONTRACTOR SHALL EXCAVATE AND VERIFY THE HORIZONTAL AND VERTICAL LOCATION OF ALL POTENTIAL OBSTRUCTIONS. SHOULD A CONFLICT EXIST, THE CONTRACTOR SHALL NOTIFY THE ENGINEER SO THAT THE CONFLICT CAN BE RESOLVED WITH A MINIMUM AMOUNT OF DELAY.
 - THE CONTRACTOR SHALL MAINTAIN ACCESS TO ADJACENT PROPERTIES DURING CONSTRUCTION.
 - ALL WORK ON THIS PROJECT SHALL BE PERFORMED IN ACCORDANCE WITH APPLICABLE FEDERAL, STATE AND LOCAL LAWS, RULES AND REGULATIONS CONCERNING CONSTRUCTION SAFETY AND HEALTH.
 - THE CONTRACTOR MUST SUBMIT A CONSTRUCTION SIGNING AND BARRICADING PLAN TO TRAFFIC ENGINEERING TO RECEIVE A BARRICADING PERMIT PRIOR TO CONSTRUCTION.
- WATER DISTRIBUTION SYSTEM**
- ALL STATIONING IS BASED ON STREET CENTERLINE.
 - WATER MAIN SHALL BE P.V.C. (C-900) OR AS APPROVED BY THE CITY OF ALBUQUERQUE WATER RESOURCES DIVISION (SEE NOTE 11).
 - WATER LINE SHALL HAVE A MINIMUM COVER OF 4'0" (TOP OF CURB TO TOP OF PIPE).
 - ELECTRONIC MARKER DISKS (EMD) SHALL BE INSTALLED IN ACCORDANCE WITH SECTION 131 OF THE CITY OF ALBUQUERQUE "CONTRACT DOCUMENTS FOR CITY-WIDE UTILITIES AND BARRICADING NO. 84-1. Public Works Contract NO. 84-1."
 - DUCTILE IRON AND ASBESTOS CEMENT ARE ACCEPTABLE PIPE MATERIALS IN LIEU OF P.V.C.

APPROVED FOR CONSTRUCTION
C.D. SHEPPARD, P.E., CITY ENGINEER

CITY OF ALBUQUERQUE
MUNICIPAL DEVELOPMENT DEPARTMENT
ENGINEERING DIVISION

TITLE: **WATERLINE EXTENSION
MONTGOMERY BLVD. N.E.**

APPROVALS	ENGINEER	DATE	APPROVALS	ENGINEER	DATE
City Engineer	<i>[Signature]</i>	5/2/84	Liquid Waste	NA, W.F.Z.	5-2-84
A.C.E. Design	<i>[Signature]</i>	5/2/84	Traffic	NA, D.W.H.	5/2/84
A.C.E. Hydrology	<i>[Signature]</i>	5/2/84	Water	W.F.Z.	5-2-84

DRAWING NO. **2115** MAP NO. **F-18** SHEET **1** OF **1**

JOB NO. **4066**



ENGINEER'S SEAL	REMARKS	DATE	BY
<i>[Signature]</i>	REMOVE BORE UNDER MONTGOMERY	5/84	TM

AS BUILT INFORMATION	BENCH MARKS	SURVEY INFORMATION	FIELD NOTES
AS BUILT INFORMATION	A SQUARE CHISELED ON TOP OF THE CONCRETE CURB @ THE ESE RETURN OF THE INTERSECTION OF MONTGOMERY BLVD. AND ANDREWS DRIVE. (ALBUQ. D.M. 5-018) ELEV = 5285.675 FEET MSL	DATE	NO.

S112