


CONSTRUCTION PLANS
FOR
VISTA DEL MUNDO
BEING A
PORTION OF TRACT D EMBUDO HILLS
ALBUQUERQUE, NEW MEXICO
JULY 1984


INDEX TO DRAWINGS

<u>SHEET NO.</u>	<u>DESCRIPTION</u>
2.....	SUBDIVISION PLAT
3.....	SUBDIVISION PLAT
4-7.....	GRADING PLAN
8.....	OVERALL STREET PAVING PLAN
9.....	OVERALL WATER & SANITARY SEWER LINES & DRAINAGE CHANNELS
STREET PAVING PLAN & PROFILE	
10.....	TEMILE HILL PL., WIND MOUNTAIN RD. & SIERRA LARGA DR.
11.....	SIERRA LARGA DR., WIND MOUNTAIN RD. & MESITA CLIFF RD.
12.....	PINE BUTTE RD., ONAVA CT., OAK BUTTE RD. & LA MESITA RD.
13.....	PINNACLE VIEW DR. & TEJANA MESA PL.
14.....	LA MESITA RD. & MUNDO CT. & ZONE 10E WATER EXTENSION
STREET UTILITY PLAN & PROFILE	
15.....	TEMILE HILL PL., WIND MOUNTAIN RD. & SIERRA LARGA DR.
16.....	SIERRA LARGA DR., WIND MOUNTAIN RD. & MESITA CLIFF RD.
17.....	PINE BUTTE RD., ONAVA CT., OAK BUTTE RD. & LA MESITA RD.
18.....	PINNACLE VIEW DR. & TEJANA MESA PL.
19.....	LA MESITA RD. & MUNDO CT.
20.....	DETAIL SHEET

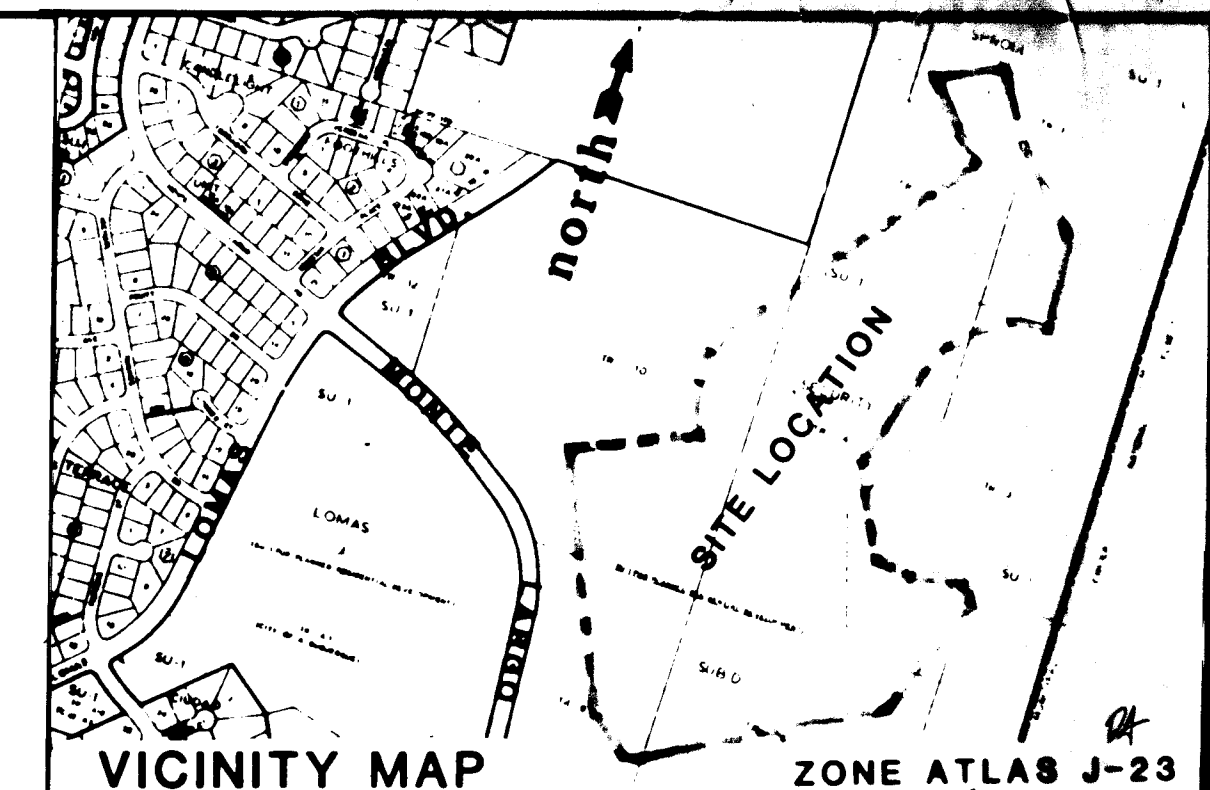

GENERAL NOTES

1. ALL WORK DETAILED ON THESE PLANS TO BE PERFORMED UNDER CONTRACT SHALL, EXCEPT AS OTHERWISE STATED OR PROVIDED FOR HEREON, BE CONSTRUCTED IN ACCORDANCE WITH THE NEW MEXICO STANDARD SPECIFICATION FOR PUBLIC WORKS CONSTRUCTION - 1979 EDITION (REFERRED TO HEREIN AS THE STANDARD SPECIFICATIONS) AND THE CONTRACT DOCUMENTS FOR PUBLICS WORKS CONTRACT NO. 84-1.
2. TWO (2) WORKING DAYS PRIOR TO ANY EXCAVATION, CONTRACTOR MUST CONTACT LINE LOCATING SERVICE 765-1234, FOR LOCATION OF EXISTING UTILITIES.
3. PRIOR TO CONSTRUCTION, THE CONTRACTOR SHALL EXCAVATE AND VERIFY THE HORIZONTAL AND VERTICAL LOCATIONS OF ALL OBSTRUCTIONS. SHOULD A CONFLICT EXIST, THE CONTRACTOR SHALL NOTIFY THE ENGINEER OR SURVEYOR SO THAT THE CONFLICT CAN BE RESOLVED WITH MINIMUM AMOUNT OF DELAY.
4. ALL UTILITIES AND UTILITY SERVICE LINES SHALL BE INSTALLED PRIOR TO PAVING.
5. BACKFILL COMPACTION SHALL BE ACCORDING TO SPECIFIED STREET USE.
6. TACT COAT REQUIREMENTS SHALL BE DETERMINED BY THE CITY ENGINEER.
7. SIDEWALKS AND WHEELCHAIR RAMPS WITHIN THE CURB RETURNS SHALL BE CONSTRUCTED WHEREVER A NEW CURB RETURN IS CONSTRUCTED.
8. IF CURB IS DEPRESSED FOR A DRIVEPAD OR A HANDICAP RAMP, THE DRIVEPAD OR RAMP SHALL BE CONSTRUCTED PRIOR TO ACCEPTANCE OF THE CURB AND GUTTER.
9. ALL STORM DRAINAGE FACILITIES SHALL BE COMPLETED PRIOR TO FINAL ACCEPTANCE.
10. MANHOLES SHALL BE 4' INSIDE DIAMETER TYPE "C" OR "E" EXCEPT AS NOTED.
11. ELECTRONIC MARKERS DISKS (EMD'S) ARE TO BE INSTALLED PER SECTION 131. IN ADDITION TO THOSE SHOWN ON THE PLANS, THE FOLLOWING EMD'S ARE REQUIRED:
 - A) SEWER- AT THE PROPERTY LINE FOR ALL SERVICE LINES.
 - B) WATER- SINGLE SERVICE, OVER THE MAIN LINE AT THE SERVICE TAP.
 - C) WATER- DOUBLE SERVICE, OVER THE MAIN LINE HALFWAY BETWEEN THE SERVICE TAPS.

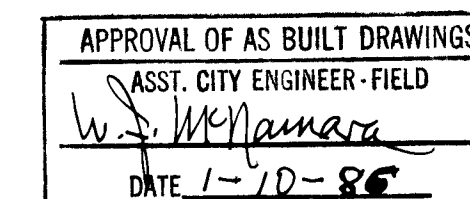

I hereby certify that the sheets marked "RECORD DRAWING" for Job 2133 have been revised to reflect record information for water, sanitary sewer, storm drainage, paving and grading required by the City of Albuquerque's Development Process Manual. This information was obtained via field survey by Greiner Engineering Sciences, Inc. and notes supplied by the Field Section of the City Engineer's Office.
By:

[Signature] 12-31-85
D. L. Morehead, P.E.
GREINER ENGINEERING SCIENCES, INC.

1	2	3	4	5	6	7	8	9	10	11	12
2	6	2	1	3	3	0	1	8	6		

REV	SHEETS	CITY ENGR.	DATE	USER	DEPT.	DATE	USER	DEPT.	DATE
APPROVAL OF REVISIONS									

	MSM MSM/SP Group CONSULTING ENGINEERS • SURVEYORS • PLANNERS 2601 Wyoming Blvd., N.E. Albuquerque, New Mexico 87112 (505) 292-1936	APPROVED FOR CONSTRUCTION <i>[Signature]</i> 12/10/85 C.E.
2133		SHEET 1 OF 20

SEE SHEET 19 FOR CHANNEL B
PLAN & PROFILE. SEE SHEET 20
FOR CHANNEL LINING AND WEIR
DETAIL.

NOTE: DETENTION POND
DESIGN WATER ELEVATION
= 6019.00

SEE CONTOUR BERM
AND CHANNEL DETAIL
SHEET 20

SCALE: 1" = 50'
2' CONTOUR INTERVALS

PAD TYPES		
PAD	TYPE	QUANTITY
	A	19
	B	9
	C	7

Note: See Sheet 20 for Split
Pad Detail.

LEGEND

- PROPOSED
- CENTERLINE
 - SUBDIVISION BOUNDARY
 - LOT LINE
 - MATCH LINE
 - CONTOURS
 - SPOT ELEVATION
 - PAD ELEVATION
 - BOTTOM OF POND ELEV.
 - RETAINING WALL
 - CURB AND GUTTER
 - SIDEWALK
 - WHEELCHAIR RAMP
 - LOT NUMBER
 - BLOCK NUMBER
 - TOP OF WALL ELEV.
 - BOTTOM OF WALL ELEV.
- EXISTING
- CONTOURS
 - CURB AND GUTTER
 - SIDEWALK
 - WHEELCHAIR RAMP

ROCK EXCAVATION NOTE:

Section 550.021 of the New Mexico
Standard Specifications For Public Works
Construction, 1979 Edition, shall apply
to all storm drain and utility
trenching, with the exception that
paragraph J shall be deleted and the
following paragraph shall be inserted:

Rock shall be defined as any material
that cannot be excavated at a rate of 50
cubic yards per hour by a competent
operator using a CAT 235 H02 or
equivalent (Bucket curling force =
15,600 lbs.), and stone or boulders
larger than 12 cubic feet. The
contractor may excavate rock using any
means at his disposal, except that
blasting must be thoroughly coordinated
with water resources operations.
Existing water facilities operations
must not be disrupted by blasting.
One-half or one-quarter charges with
time delay fuses, or the use of chemical
explosive materials, are recommended in
the vicinity of existing water
facilities. The quantity of rock
excavation, as included in the
engineer's estimate, is for estimating
purposes only. The contractor will be
paid for actual quantities excavated.

AS BUILT INFORMATION	
CONTRACTOR	CONSTRUCTION MANAGEMENT, INC.
DESIGNED BY	GREENE
CHECKED BY	GREENE
DATE	1/84

BENCH MARKS	
Top of header curb at southwest corner of Sandia Manor pump station, Elev. = 6011.62	

SURVEY INFORMATION	
FIELD NOTES	DATE
NO.	BY
1620	T. Aldrich 8/83
1627	T. Aldrich 10/83
1628	G. Smith 10/83
1634	J. Frecks 12/83
1635	G. Smith 1/84
1636	G. Smith 1/84

ENGINEER'S SEAL	


REVISIONS	
NO.	DATE
1	10-85
2	11-85
3	12-85
4	1-86
5	2-86
6	3-86
7	4-86
8	5-86
9	6-86
10	7-86
11	8-86
12	9-86
13	10-86
14	11-86
15	12-86
16	1-87
17	2-87
18	3-87
19	4-87
20	5-87
21	6-87
22	7-87
23	8-87
24	9-87
25	10-87
26	11-87
27	12-87
28	1-88
29	2-88
30	3-88
31	4-88
32	5-88
33	6-88
34	7-88
35	8-88
36	9-88
37	10-88
38	11-88
39	12-88
40	1-89
41	2-89
42	3-89
43	4-89
44	5-89
45	6-89
46	7-89
47	8-89
48	9-89
49	10-89
50	11-89
51	12-89
52	1-90
53	2-90
54	3-90
55	4-90
56	5-90
57	6-90
58	7-90
59	8-90
60	9-90
61	10-90
62	11-90
63	12-90
64	1-91
65	2-91
66	3-91
67	4-91
68	5-91
69	6-91
70	7-91
71	8-91
72	9-91
73	10-91
74	11-91
75	12-91
76	1-92
77	2-92
78	3-92
79	4-92
80	5-92
81	6-92
82	7-92
83	8-92
84	9-92
85	10-92
86	11-92
87	12-92
88	1-93
89	2-93
90	3-93
91	4-93
92	5-93
93	6-93
94	7-93
95	8-93
96	9-93
97	10-93
98	11-93
99	12-93
100	1-94

CITY OF ALBUQUERQUE
MUNICIPAL DEVELOPMENT DEPARTMENT
ENGINEERING DIVISION


TITLE: VISTA DEL MUNDO
GRADING PLAN

APPROVALS	ENGINEER	DATE	APPROVALS	ENGINEER	DATE
City Engineer	R. Peña	7/18/84	Liquid Waste	R. Peña	7/18/84
A.C.E. Design	N.A. Doh	7/18/84	Traffic	N.A. Doh	7/18/84
A.C.E. - Hydrology	R. Peña	7/18/84	Water	R. Peña	7/18/84

DRAWING NO. 2133 MAP NO. J-23 SHEET 5 OF 20

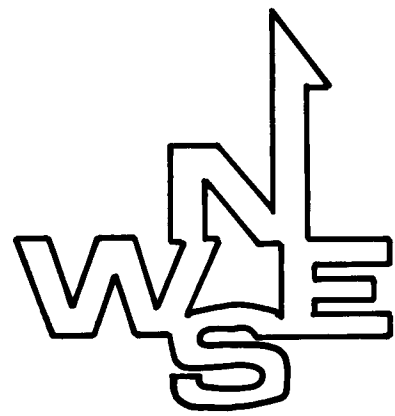

SCALE: 1" = 50'
2' CONTOUR INTERVALS

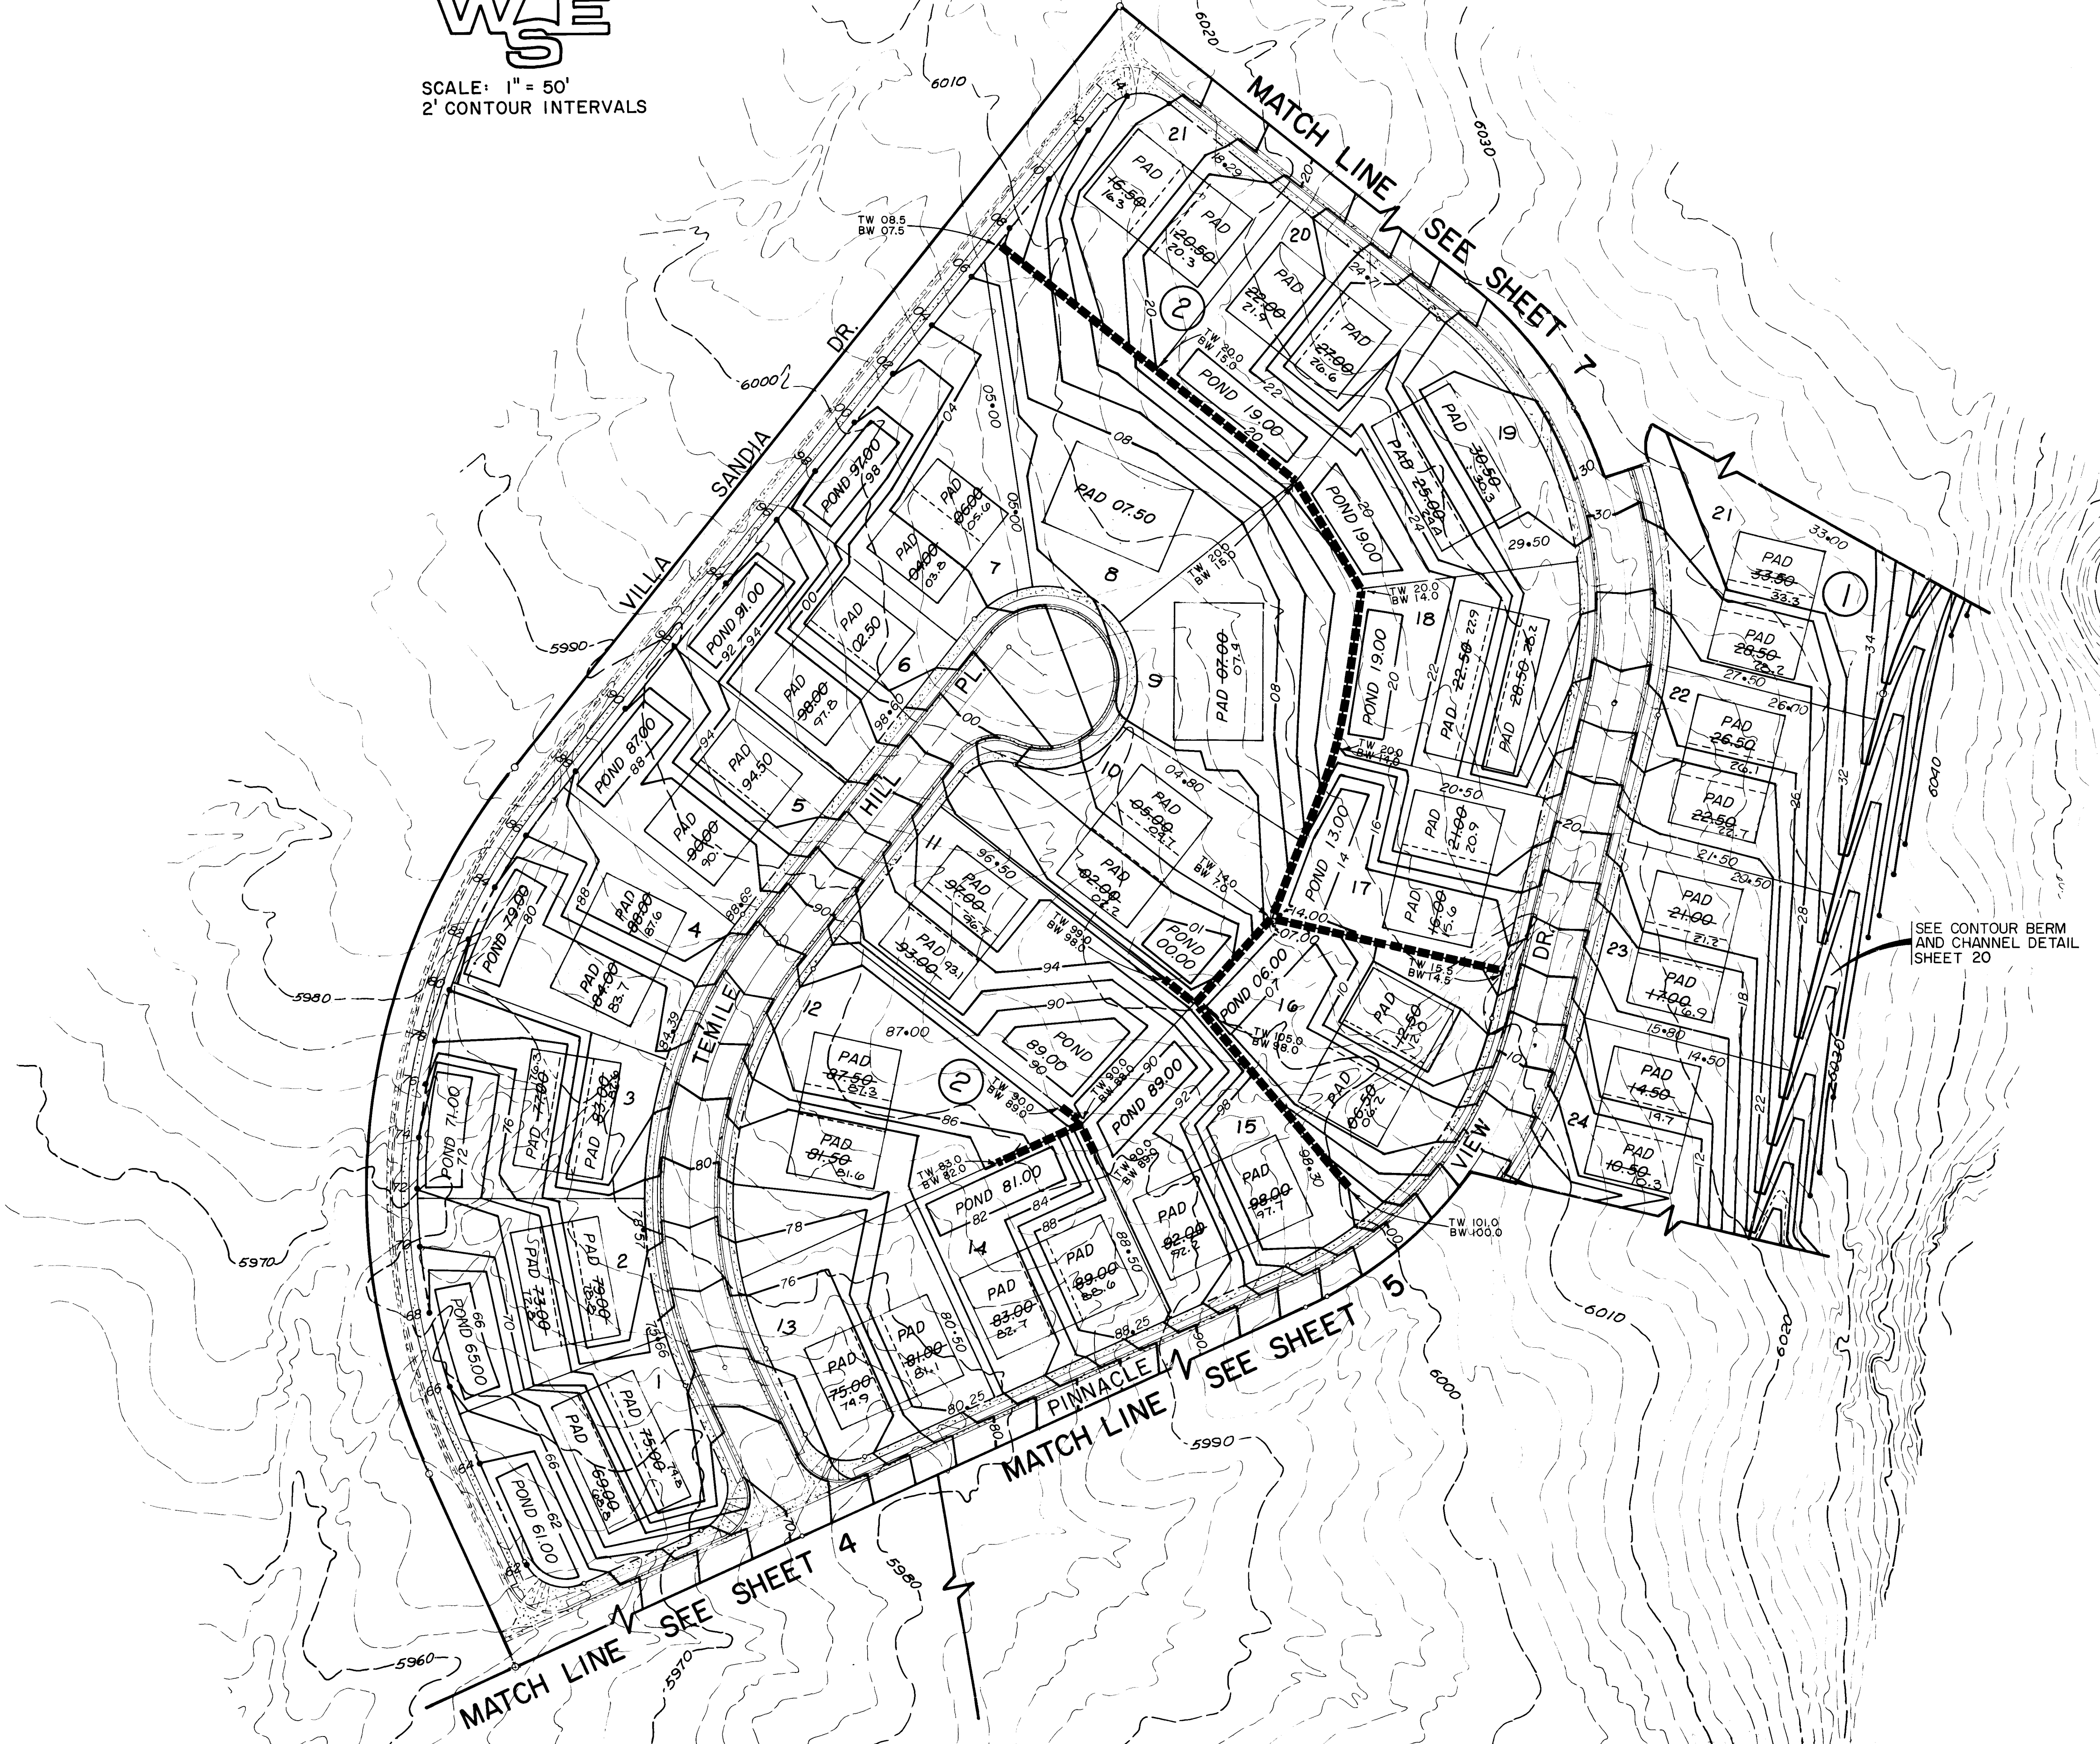

PAD TYPES		
PAD	TYPE	QUANTITY
	A	5
	B	18
	C	2

Note: See Sheet 20 for Split Pad Detail.

LEGEND

- PROPOSED
- CENTERLINE
 - SUBDIVISION BOUNDARY
 - LOT LINE
 - MATCH LINE
 - CONTOURS
 - SPOT ELEVATION
 - PAD ELEVATION
 - BOTTOM OF POND ELEV.
 - RETAINING WALL
 - CURB AND GUTTER
 - SIDEWALK
 - WHEELCHAIR RAMP
 - LOT NUMBER
 - BLOCK NUMBER
 - TOP OF WALL ELEV.
 - BOTTOM OF WALL ELEV.

EXISTING

- CONTOURS
- CURB AND GUTTER
- SIDEWALK
- WHEELCHAIR RAMP

ROCK EXCAVATION NOTE:
Section 550.021 of the New Mexico Standard Specifications For Public Works Construction, 1979 Edition, shall apply to all storm drain and utility trenching, with the exception that paragraph 1 shall be deleted and the following paragraph shall be inserted:
Rock shall be defined as any material that cannot be excavated at a rate of 50 cubic yards per hour by a competent operator using a CAT 235 BOM or equivalent (Bucket curling force = 35,600 lbs.), and stone or boulders larger than 12 cubic feet. The contractor may excavate rock using any means at his disposal, except that blasting must be thoroughly coordinated with water resources operations. Existing water facilities operations must not be disrupted by blasting. One-half or one-quarter charges with time delay fuses, or the use of chemical expansive materials, are recommended in the vicinity of existing water facilities. The quantity of rock excavation, as included in the engineer's estimate, is for estimating purposes only. The contractor will be paid for actual quantities excavated.

CITY OF ALBUQUERQUE MUNICIPAL DEVELOPMENT DEPARTMENT ENGINEERING DIVISION					
TITLE: VISTA DEL MUNDO GRADING PLAN					
APPROVALS	ENGINEER	DATE	APPROVALS	ENGINEER	DATE
City Engineer	<i>E. H. Williams</i>	7/18/84	Liquid Waste	<i>R. Dean</i>	7/18/84
A.C.E. Design	<i>A. C. E.</i>	7/18/84	Traffic	<i>N. A. D.</i>	7/18/84
A.C.E. Hydrology	<i>S. J. D.</i>	7/18/84	Water	<i>R. Dean</i>	7/18/84
DRAWING NO. 2133		MAP NO. J-23		SHEET 6 OF 20	

AS BUILT INFORMATION		BENCH MARKS		SURVEY INFORMATION		ENGINEER'S SEAL	
CONTRACTING	MANAGER	Top of header curb at southwest corner of Sandia Manor pump station. Elev. = 6011.62	NO.	BY	DATE		DESIGNED BY RM & LJ DRAWN BY BC & JK CHECKED BY MH
INSPECTOR	DATE	NO.	BY	DATE			
INSPECTION BY CITY & ASSOCIATES	DATE	NO.	BY	DATE			
INSPECTION BY GREENER, LATE	DATE	NO.	BY	DATE			
INSPECTION BY GREENER, LATE	DATE	NO.	BY	DATE			



PAD TYPES		
PAD	TYPE	QUANTITY
	A	5
	B	12
	C	3

Note: See Sheet 20 for Split Pad Detail.

LEGEND

- PROPOSED
- CENTERLINE
 - SUBDIVISION BOUNDARY
 - LOT LINE
 - MATCH LINE
 - CONTOURS
 - SPOT ELEVATION
 - PAD ELEVATION
 - BOTTOM OF POND ELEV.
 - RETAINING WALL
 - CURB AND GUTTER
 - SIDEWALK
 - WHEELCHAIR RAMP
 - LOT NUMBER
 - BLOCK NUMBER
 - TOP OF WALL ELEV.
 - BOTTOM OF WALL ELEV.

- EXISTING
- CONTOURS
 - CURB AND GUTTER
 - SIDEWALK
 - WHEELCHAIR RAMP

ROCK EXCAVATION NOTE:
Section 550.021 of the New Mexico Standard Specifications For Public Works Construction, 1979 Edition, shall apply to all storm drain and utility trenching, with the exception that paragraph 1 shall be deleted and the following paragraph shall be inserted:
Rock shall be defined as any material that cannot be excavated at a rate of 50 cubic yards per hour by a competent operator using a CAT 235 HOB or equivalent (Bucket curling force = 15,600 lbs.), and stone or boulders larger than 12 cubic feet. The contractor may excavate rock using any means at his disposal, except that blasting must be thoroughly coordinated with water resources operations. Existing water facilities operations must not be disrupted by blasting. One-half or one-quarter charges with time delay fuses, or the use of chemical explosives materials, are recommended in the vicinity of existing water facilities. The quantity of rock excavation, as included in the engineer's estimate, is for estimating purposes only. The contractor will be paid for actual quantities excavated.

AS BUILT INFORMATION

TRACTOR & MANAGEMENT INC.

DESIGNED BY: G. SMITH

DATE: 10/83

ACCEPTANCE BY: CITY & ASSC

DATE: 10/83

RECORDED BY: G. SMITH

DATE: 1/84

NO.

BENCH MARKS

Top of header curb at southwest corner of Sandia Manor pump station. Elev. =6011.62

SURVEY INFORMATION

FIELD NOTES

NO. BY DATE

1620 T. Aldrich 8/83

1627 T. Aldrich 10/83

1628 G. Smith 10/83

1634 J. Freeks 12/83

1635 G. Smith 1/84

1636 G. Smith 1/84

ENGINEER'S SEAL

NO. DATE

1 10-85

AS BUILT PAD ELEVATIONS

REMARKS

BY

DESIGN

DESIGNED BY: RM & LJ

DATE: 4-84

DRAWN BY: BC & JW

DATE: 4-84

CHECKED BY: MH

DATE: 4-84

CITY OF ALBUQUERQUE

MUNICIPAL DEVELOPMENT DEPARTMENT

ENGINEERING DIVISION

TITLE:

VISTA DEL MUNDO

GRADING PLAN

APPROVALS

ENGINEER

DATE

APPROVALS

ENGINEER

DATE

City Engineer:

7/18/84

A.C.E. Design:

7/18/84

A.C.E. Hydrology:

7/18/84

Liquid Waste:

7/18/84

Traffic:

7/18/84

Water:

7/18/84

DRAWING NO.

2133

MAP NO.


J-23

SHEET

7

OF

20

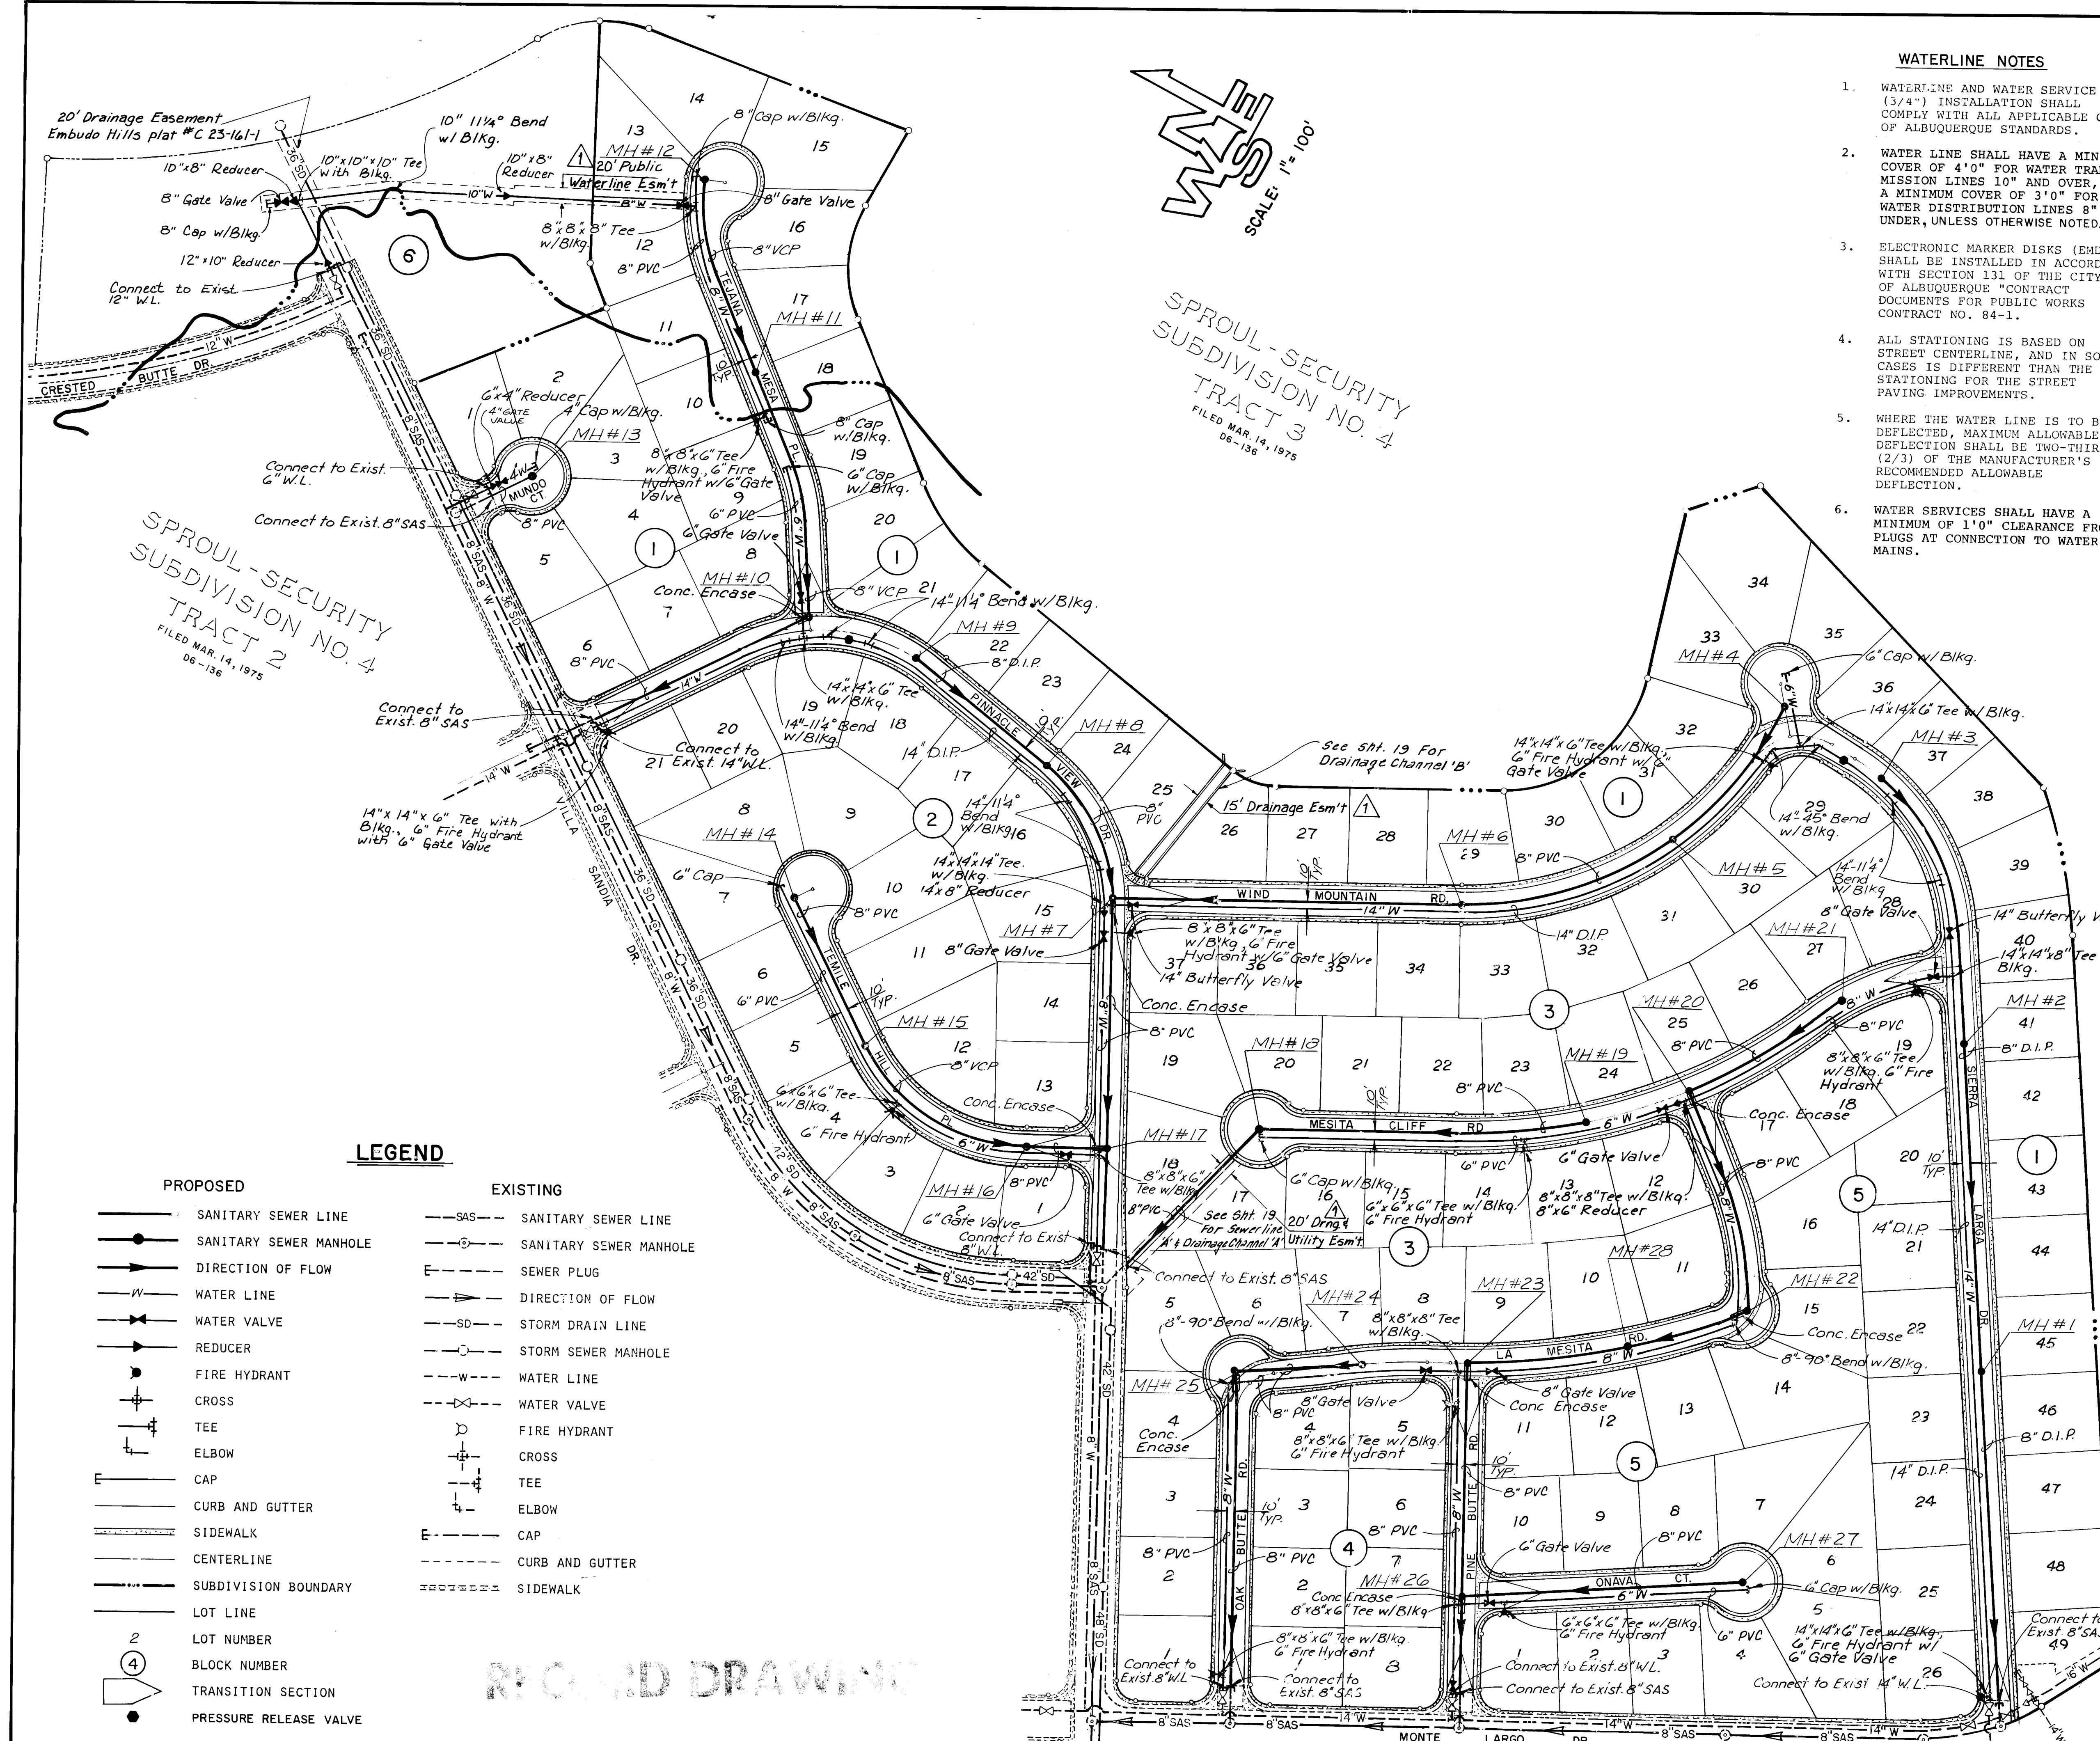

WATERLINE NOTES

1. WATERLINE AND WATER SERVICE (3/4") INSTALLATION SHALL COMPLY WITH ALL APPLICABLE CITY OF ALBUQUERQUE STANDARDS.
2. WATER LINE SHALL HAVE A MINIMUM COVER OF 4'0" FOR WATER TRANSMISSION LINES 10" AND OVER, AND A MINIMUM COVER OF 3'0" FOR WATER DISTRIBUTION LINES 8" AND UNDER, UNLESS OTHERWISE NOTED.
3. ELECTRONIC MARKER DISKS (EMD) SHALL BE INSTALLED IN ACCORDANCE WITH SECTION 131 OF THE CITY OF ALBUQUERQUE "CONTRACT DOCUMENTS FOR PUBLIC WORKS CONTRACT NO. 84-1."
4. ALL STATIONING IS BASED ON STREET CENTERLINE, AND IN SOME CASES IS DIFFERENT THAN THE STATIONING FOR THE STREET PAVING IMPROVEMENTS.
5. WHERE THE WATER LINE IS TO BE DEFLECTED, MAXIMUM ALLOWABLE DEFLECTION SHALL BE TWO-THIRDS (2/3) OF THE MANUFACTURER'S RECOMMENDED ALLOWABLE DEFLECTION.
6. WATER SERVICES SHALL HAVE A MINIMUM OF 1'0" CLEARANCE FROM PLUGS AT CONNECTION TO WATER MAINS.

NOTES:

1. EXTEND ALL WATER AND SANITARY SEWER SERVICES TO 5' BEYOND THE 10' UTILITY AND SIDEWALK EASEMENT LINE.
2. ALL WATER AND SANITARY SEWER PIPE SHALL BE PVC UNLESS OTHERWISE NOTED.

SANITARY SEWER

1. SANITARY SEWER AND SEWER SERVICE INSTALLATION SHALL COMPLY WITH ALL APPLICABLE CITY OF ALBUQUERQUE STANDARDS.
2. ALL STATIONING IS BASED ON STREET CENTERLINE, AND IN SOME CASES IS DIFFERENT THAN THE STATIONING FOR THE STREET PAVING IMPROVEMENTS.
3. SLOPES SHOWN ON THE PROFILES ARE BASED ON TRUE DISTANCES, NOT CENTERLINE STATIONING. LENGTHS SHOWN ON PROFILES ARE TRUE DISTANCES FROM CENTER OF MANHOLE TO CENTER OF MANHOLE.
4. ALL MANHOLES SHALL BE 4-FOOT DIAMETER TYPE 'E' AS PER CITY OF ALBUQUERQUE STANDARD DRAWING S-2-4 UNLESS OTHERWISE NOTED.
5. SEWER SERVICE LATERALS SHALL BE PROVIDED WITH ELECTRONIC MARKER DISKS AS PER CITY OF ALBUQUERQUE STANDARD DRAWING S-9. EMD SHALL BE PROVIDED IN ACCORDANCE WITH SECTION 131 OF THE CITY OF ALBUQUERQUE "CONTRACT DOCUMENTS FOR PUBLIC WORKS CONTRACT NO. 84-1."
6. WHERE SEWER AND WATER LINES CROSS, IF VERTICAL CLEARANCE DOES NOT EXCEED 1'-6", CONTRACTOR SHALL ENCASE SEWER PIPE IN CONCRETE, 10 FEET EACH SIDE OF WATER LINE. (NOTE THE POLICY ON THE PROXIMITY OF WATER AND SEWER LINES IN THE CONTRACT DOCUMENTS FOR PUBLIC WORKS CONTRACT NO. 84-1.)
7. WHERE THE SEWER LINE IS TO BE DEFLECTED, MAXIMUM ALLOWABLE DEFLECTION SHALL BE TWO-THIRDS (2/3) OF THE MANUFACTURER'S RECOMMENDED ALLOWABLE DEFLECTION.
8. ALL SERVICE CONNECTIONS SHALL BE MADE SUCH THAT THE SERVICE IS PERPENDICULAR OR RADIAL TO THE SEWER MAIN. (SEE NOTES 10 & 11.)
9. ALL SERVICE CONNECTIONS SHALL HAVE A MINIMUM SLOPE OF 1/4" PER FOOT TOWARD THE MAIN WITHIN THE PUBLIC RIGHT-OF-WAY AND SHALL HAVE A MINIMUM DEPTH OF 4' BELOW THE TOP OF CURB ELEVATION FROM THE FINISHED SURFACE PROJECTED TO THE PROPERTY LINE MEASURED TO THE PIPE INVERT.
10. ALL SERVICE CONNECTIONS MUST BE MADE TO THE MAIN LINE EXCEPT AT THE END OF CUL-DE-SACS WHERE CONNECTION TO A MANHOLE IS PERMITTED IN THE MANNER SHOWN IN THE STANDARD DETAILS.
11. SERVICE CONNECTIONS TO A MANHOLE ARE TO BE MADE WITH THE INVERT OF THE TOP OF THE MAIN LINE.

LEGEND

PROPOSED	EXISTING
SANITARY SEWER LINE	SANITARY SEWER LINE
SANITARY SEWER MANHOLE	SANITARY SEWER MANHOLE
DIRECTION OF FLOW	SEWER PLUG
WATER LINE	DIRECTION OF FLOW
WATER VALVE	STORM DRAIN LINE
REDUCER	STORM SEWER MANHOLE
FIRE HYDRANT	WATER LINE
CROSS	WATER VALVE
TEE	FIRE HYDRANT
ELBOW	CROSS
CAP	TEE
CURB AND GUTTER	ELBOW
SIDEWALK	CAP
CENTERLINE	CURB AND GUTTER
SUBDIVISION BOUNDARY	SIDEWALK
LOT LINE	
LOT NUMBER	
BLOCK NUMBER	
TRANSITION SECTION	
PRESSURE RELEASE VALVE	

SCALE: 1" = 100'

SPROUL-SECURITY SUBDIVISION NO. 4 TRACT 3

AS BUILT INFORMATION

CONTRACTOR: SANDIA MANOR PUMP STATION, ELEV. #6011.62

WORK BY: G. SMITH

INSPECTOR: G. SMITH

DATE: 1/84

APPROVED BY: G. SMITH

DATE: 1/84

RECORDED BY: G. SMITH

DATE: 1/84

SURVEY INFORMATION

NO. 1620

DATE 8/83

BY T. Aldrich

NO. 1627

DATE 10/83

BY T. Aldrich

NO. 1628

DATE 12/83

BY J. Freese

NO. 1634

DATE 1/84

BY G. Smith

NO. 1635

DATE 1/84

BY G. Smith

NO. 1636

DATE 1/84

BY G. Smith

ENGINEER'S SEAL

REVISIONS

NO.	DATE	REMARKS
1	1/84	ADD EASEMENTS TO DRAWINGS

DESIGNED BY: RM & LJ

DRAWN BY: BC & JW

CHECKED BY: MH

CITY OF ALBUQUERQUE

MUNICIPAL DEVELOPMENT DEPARTMENT

ENGINEERING DIVISION

TITLE: VISTA DEL MUNDO OVERALL WATER & SANITARY SEWER LINES & DRAINAGE CHANNEL


APPROVALS	ENGINEER	DATE	APPROVALS	ENGINEER	DATE
City Engineer	C. M. H. H. H.	7/18/84	Liquid Waste	R. P. H.	7/18/84
A.C.E. Design	W. H. H.	7/18/84	Traffic	N. A. H.	7/18/84
A.C.E. Hydrology	B. G. H.	7/18/84	Water	R. P. H.	7/18/84

DRAWING NO. 2133

MAP NO. J-23

SHEET 9 OF 20

5133

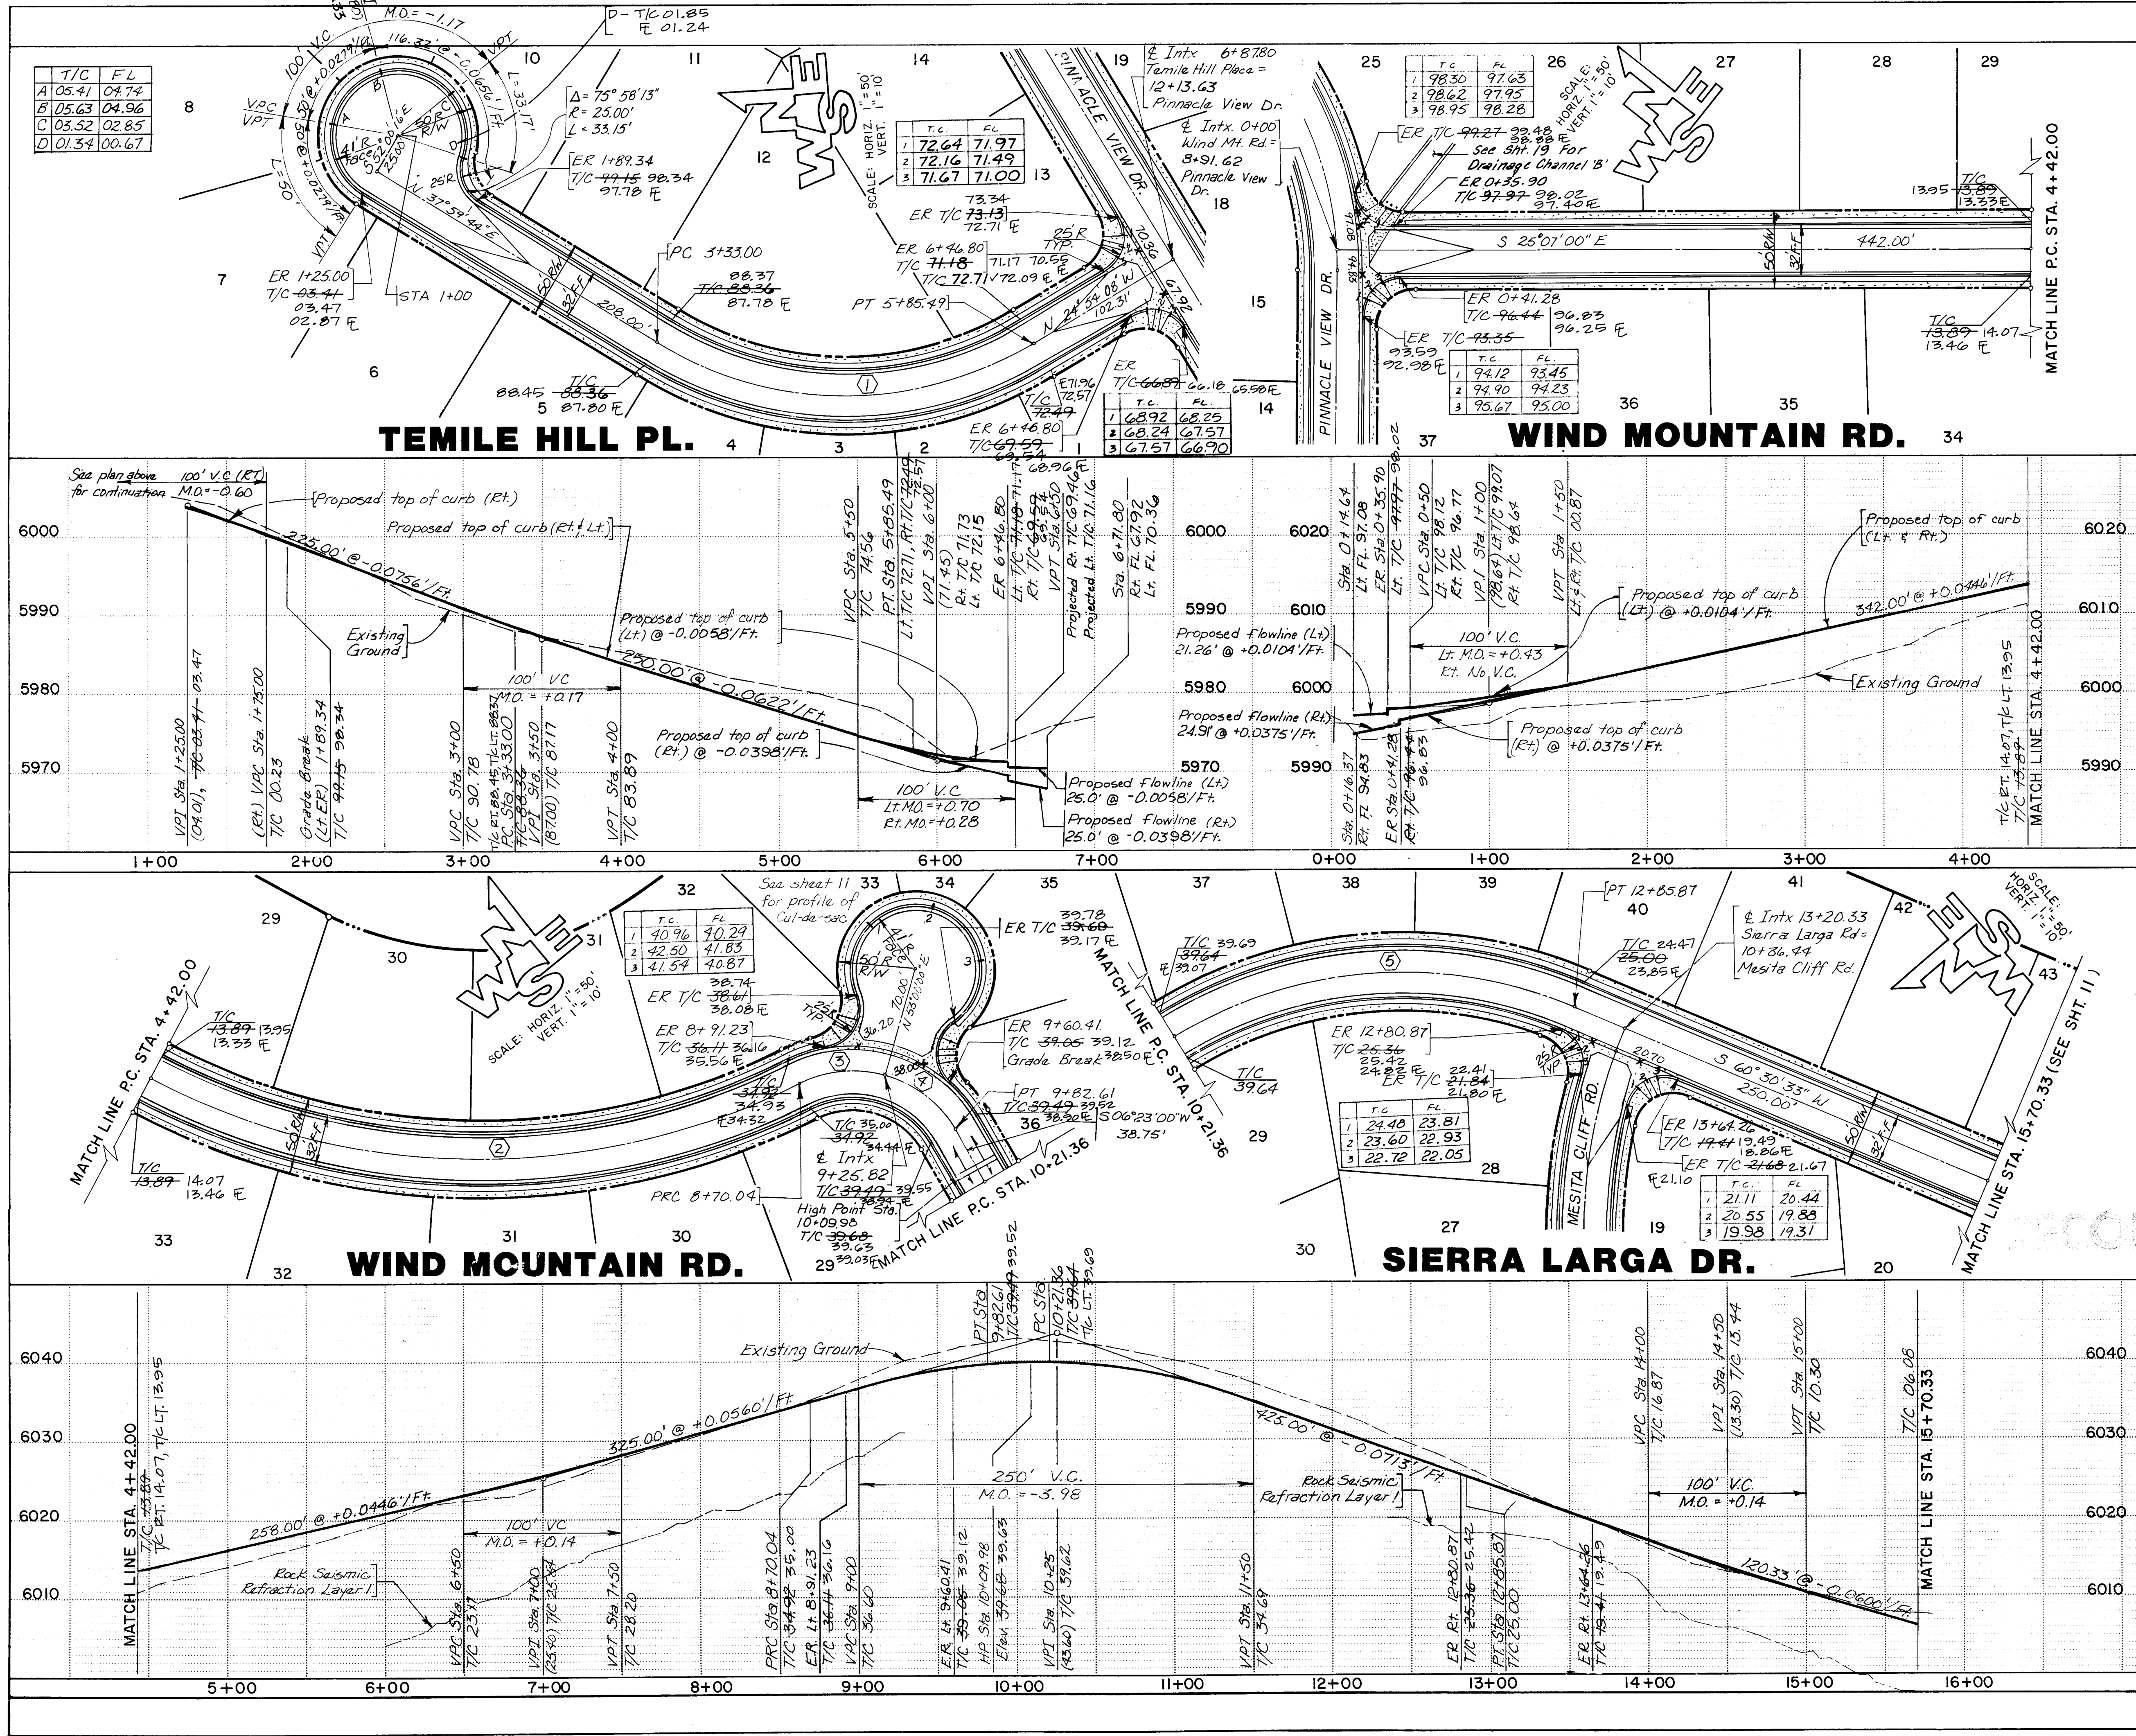

Horizontal Curve Data			
No.	Delta	Radius	Length
1	62° 53' 52"	230.00'	252.49'
2	54° 30' 00"	450.00'	428.04'
3	42° 31' 00"	75.00'	55.78'
4	43° 23' 00"	75.00'	56.79'
5	54° 07' 33"	280.00'	264.51'

Note: The horizontal curve data table shown is of Temile Hill Place, Wind Mountain Road and Sierra Larga Dr.

Seismic Data Interpretation
Seismic refraction is a surface geophysical method used to estimate earth material layer depths and their seismic velocities. The Seismic Profiles shown are delineated as Rock Seismic Refraction Layer 2 and/or 3. Layer 1 shall therefore be labeled as existing ground.
Layer 1 is a combination of overburden and possibly some very weathered granite. The velocity of this layer ranges from 2,972 to 5,857 ft/sec.
Layer 2 is composed of moderately weathered and fractured granite. The material has a velocity range from 2,972 to 5,857 ft/sec.
Layer 3 was occasionally detected and is composed of more competent granite. This material has a velocity ranging from 7,133 to 8,988 ft/sec.

AS BUILT INFORMATION	
CONTRACTOR	DATE
CONTRACTOR	DATE

BENCH MARKS	
Top of header curb at southwest corner of Sandia Manor pump station. Elev. = 6011.62	DATE
1620 T. Aldrich	8/83
1627 T. Aldrich	10/83
1628 G. Smith	10/83
1634 J. Freeks	12/83
1635 G. Smith	1/84
1636 G. Smith	1/84

SURVEY INFORMATION	
NO.	DATE
1620 T. Aldrich	8/83
1627 T. Aldrich	10/83
1628 G. Smith	10/83
1634 J. Freeks	12/83
1635 G. Smith	1/84
1636 G. Smith	1/84

ENGINEER'S SEAL	
NO.	DATE
1620 T. Aldrich	8/83
1627 T. Aldrich	10/83
1628 G. Smith	10/83
1634 J. Freeks	12/83
1635 G. Smith	1/84
1636 G. Smith	1/84

REVISIONS	
NO.	DATE
1	10-85 AS BUILT, T/C & STREET WIDTHS

DESIGN	
DESIGNED BY	DATE
RM & LJ <td>4-84</td>	4-84

DRAWING	
NO.	DATE
2133	J-23

MAP NO.	
NO.	DATE
J-23	10-85

SHEET	
NO.	DATE
10	4-84





OF	
NO.	DATE
20	4-84

CITY OF ALBUQUERQUE
MUNICIPAL DEVELOPMENT DEPARTMENT
ENGINEERING DIVISION

TITLE: VISTA DEL MUNDO
TEMILE HILL PL., WIND MT. RD. & SIERRA LARGA DR.
STREET PAVING PLAN & PROFILE

APPROVALS	ENGINEER	DATE	APPROVALS	ENGINEER	DATE
City Engineer	7/18/84		Liquid Waste	R. Pina	7/18/84
A.C.E. Design	7/18/84		Traffic	D. J. Hume	7/18/84
A.C.E. Hydrology	7/18/84		Water	R. Pina	7/18/84

DRAWING NO. 2133 MAP NO. J-23 SHEET 10 OF 20

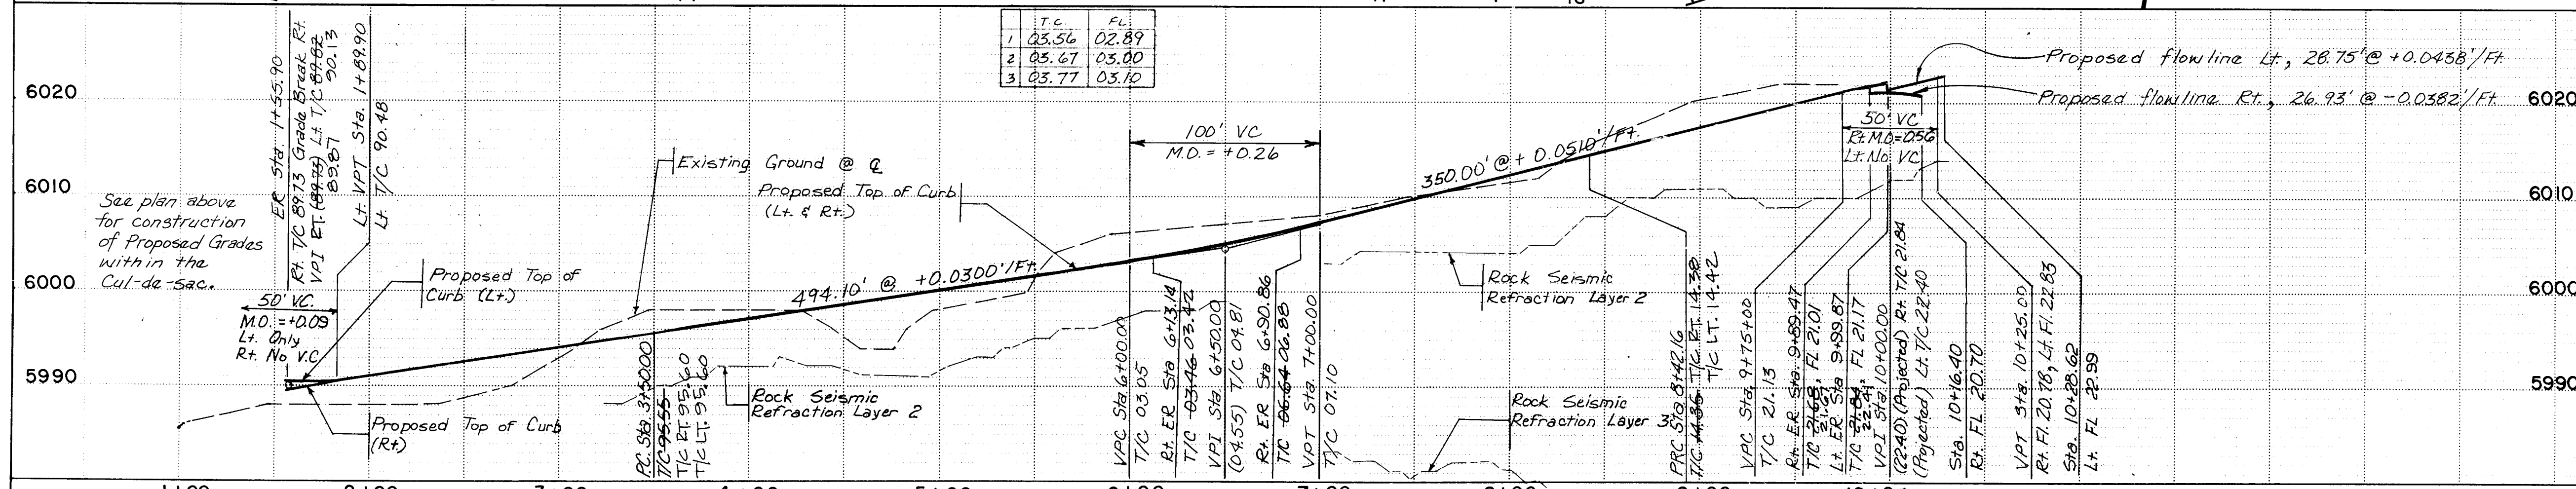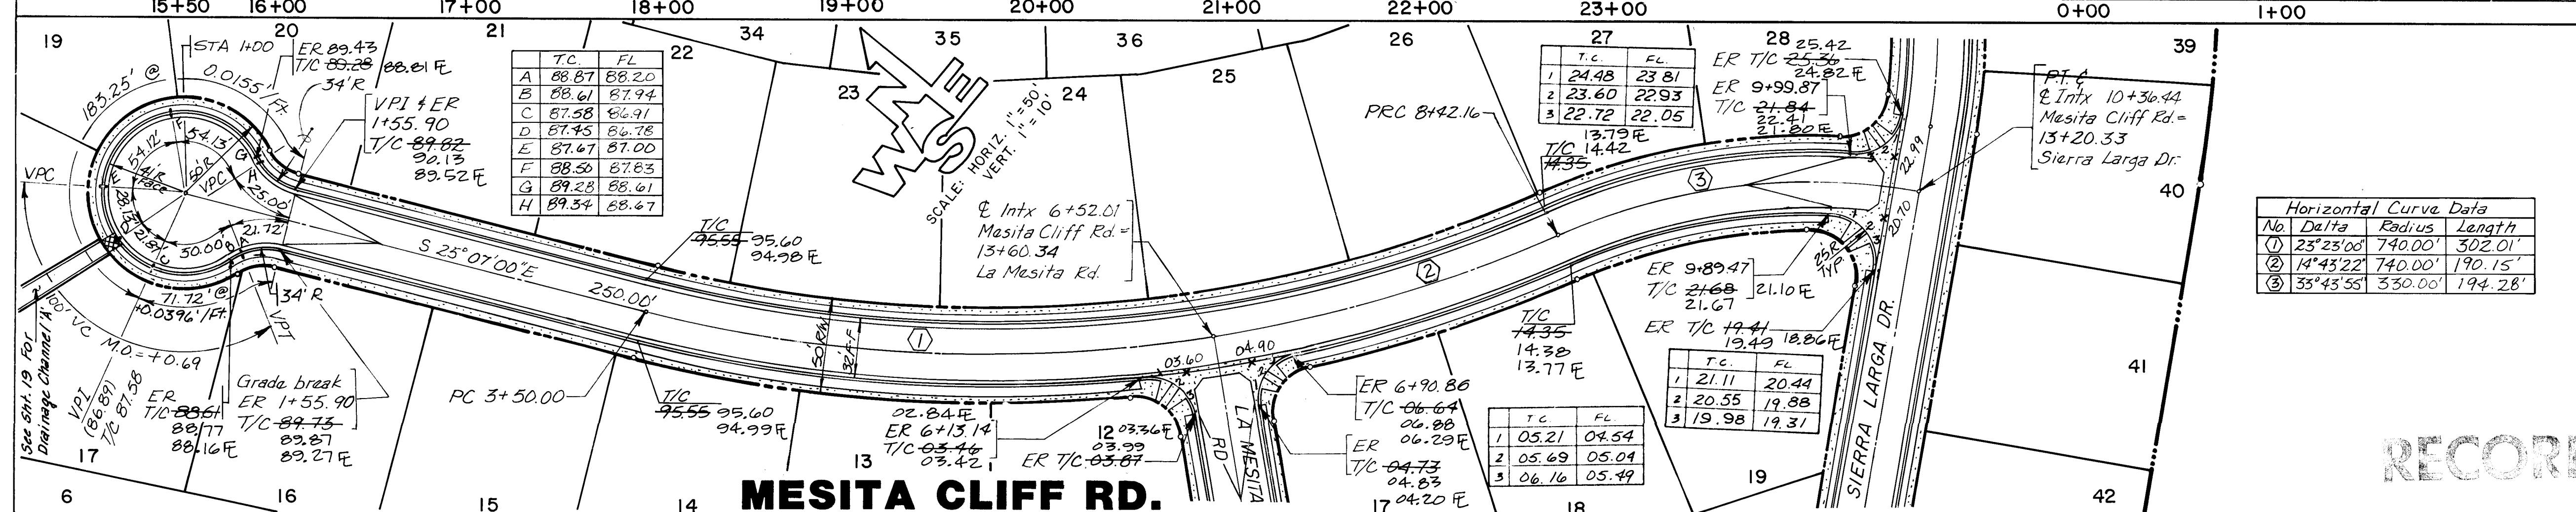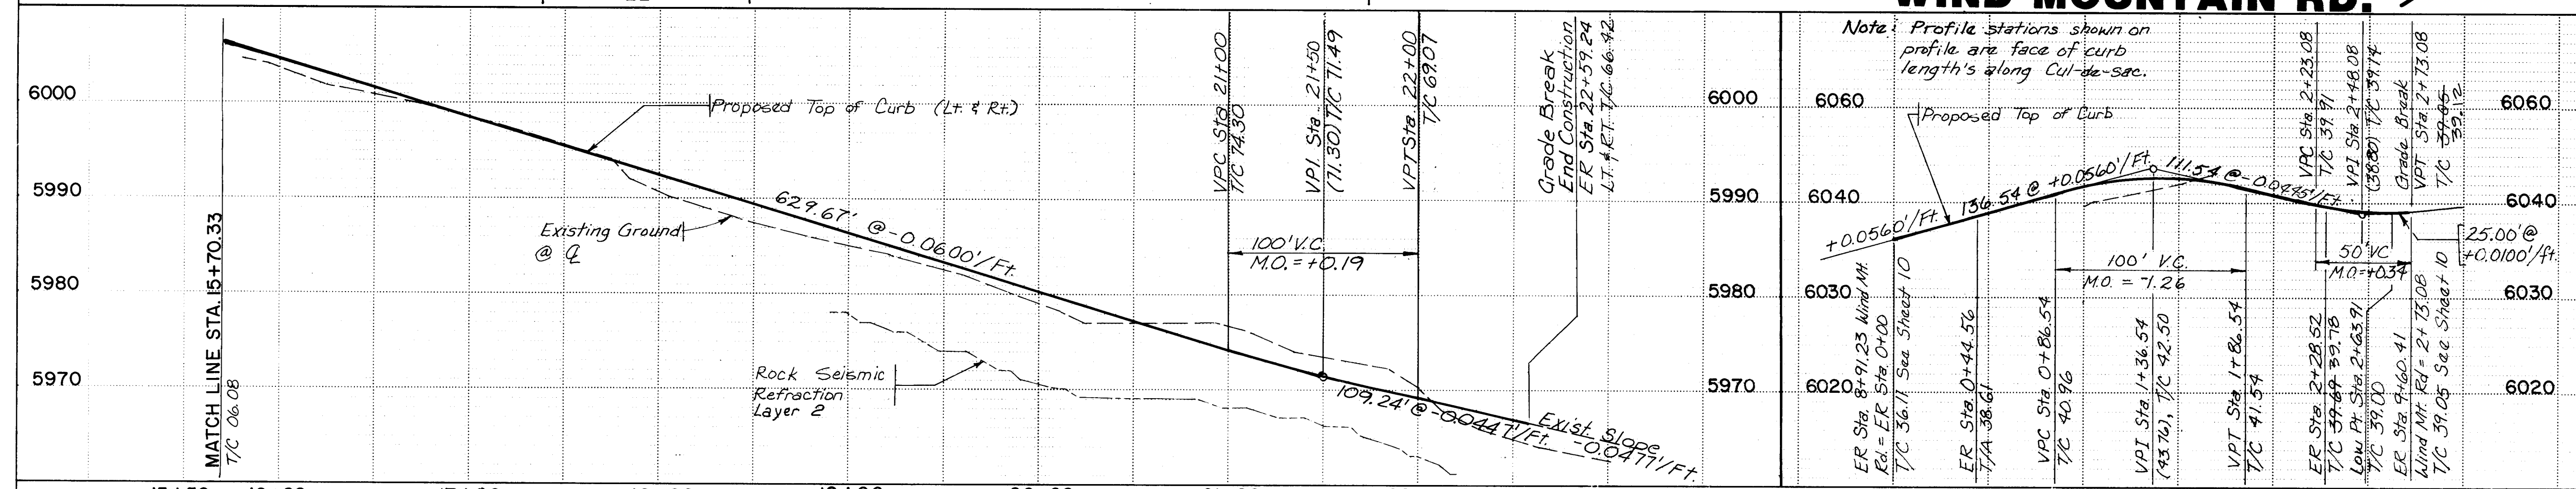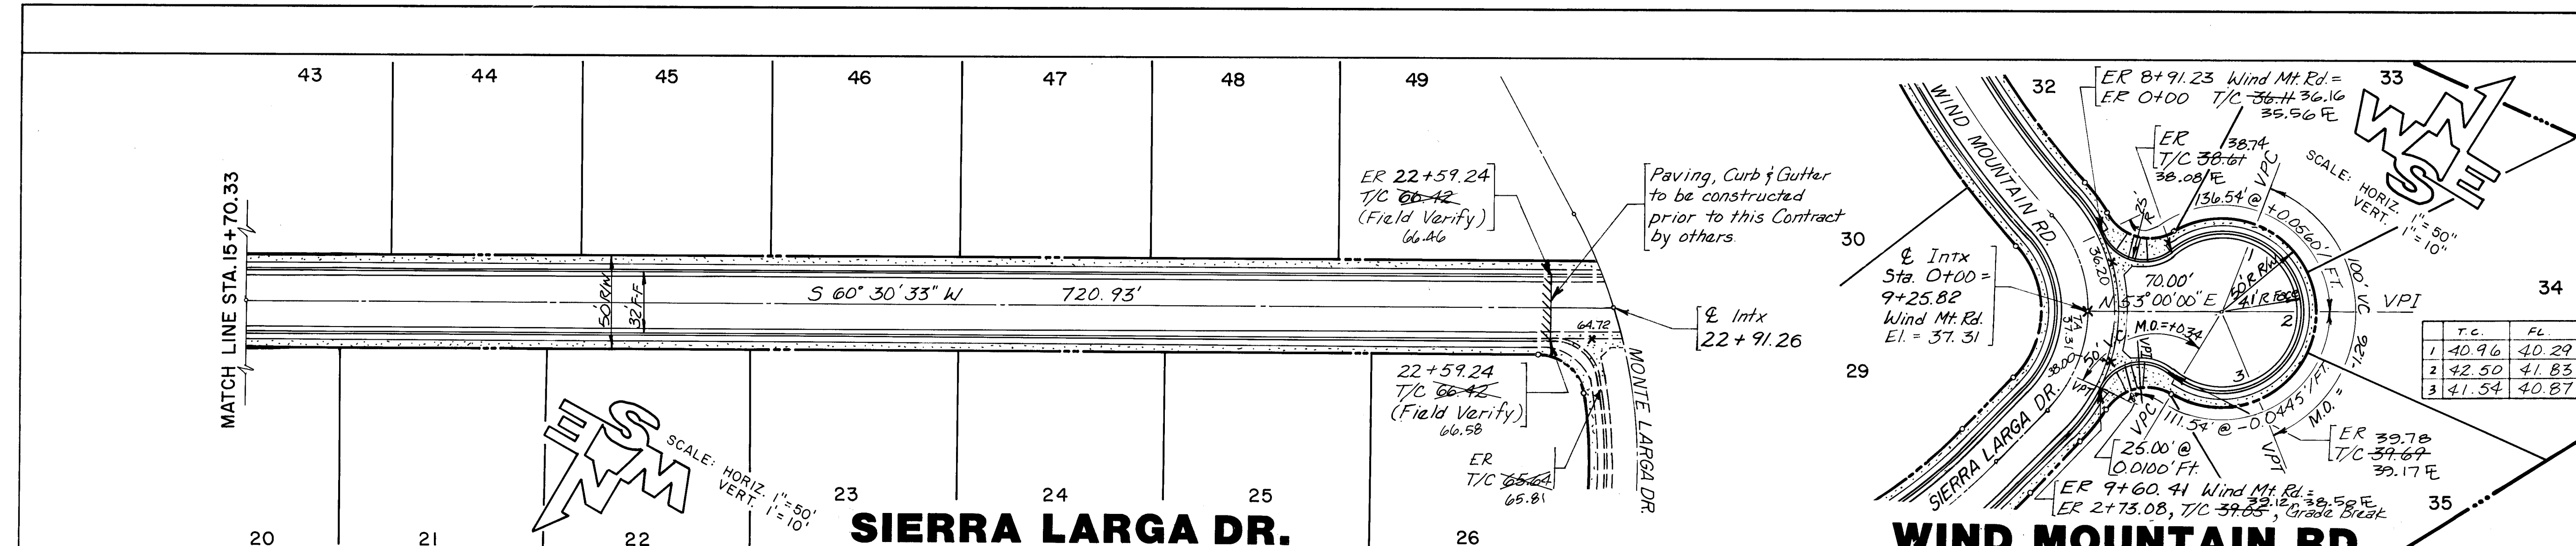

AS BUILT INFORMATION

CONTRACTOR: [blank]

DATE: [blank]

BY: [blank]

REVISIONS

NO. DATE

1 10-25-84 AS BUILT, T/C & STREET WIDTHS

DESIGN

DESIGNED BY: [blank]

DRAWN BY: [blank]

CHECKED BY: [blank]

DATE: [blank]

DATE: [blank]

DATE: [blank]

BENCH MARKS

Top of header curb at southwest corner of Sandia Manor pump station. Elev. = 6011.62

SURVEY INFORMATION

FIELD NOTES

NO. BY DATE

1620 T. Aldrich 8/83

1627 T. Aldrich 10/83

1628 G. Smith 10/83

1634 J. Freeks 12/83

1635 G. Smith 1/84

1636 G. Smith 1/84

ENGINEER'S SEAL

[Signature]

CITY OF ALBUQUERQUE

MUNICIPAL DEVELOPMENT DEPARTMENT

ENGINEERING DIVISION

TITLE:

VISTA DEL MUNDO

SIERRA LARGA DR., WIND MT. RD. & MESITA CLIFF RD.

STREET PAVING PLAN & PROFILE

APPROVALS

ENGINEER DATE

City Engineer [Signature] 7/18/84

A.C.E. - Design [Signature] 7/18/84

A.C.E. - Hydrology [Signature] 7/18/84

APPROVALS

ENGINEER DATE

Liquid Waste [Signature] 7/18/84

Traffic [Signature] 7/18/84

Water [Signature] 7/18/84

DRAWING NO.

2133

MAP NO.


J-23

SHEET

11

OF

20

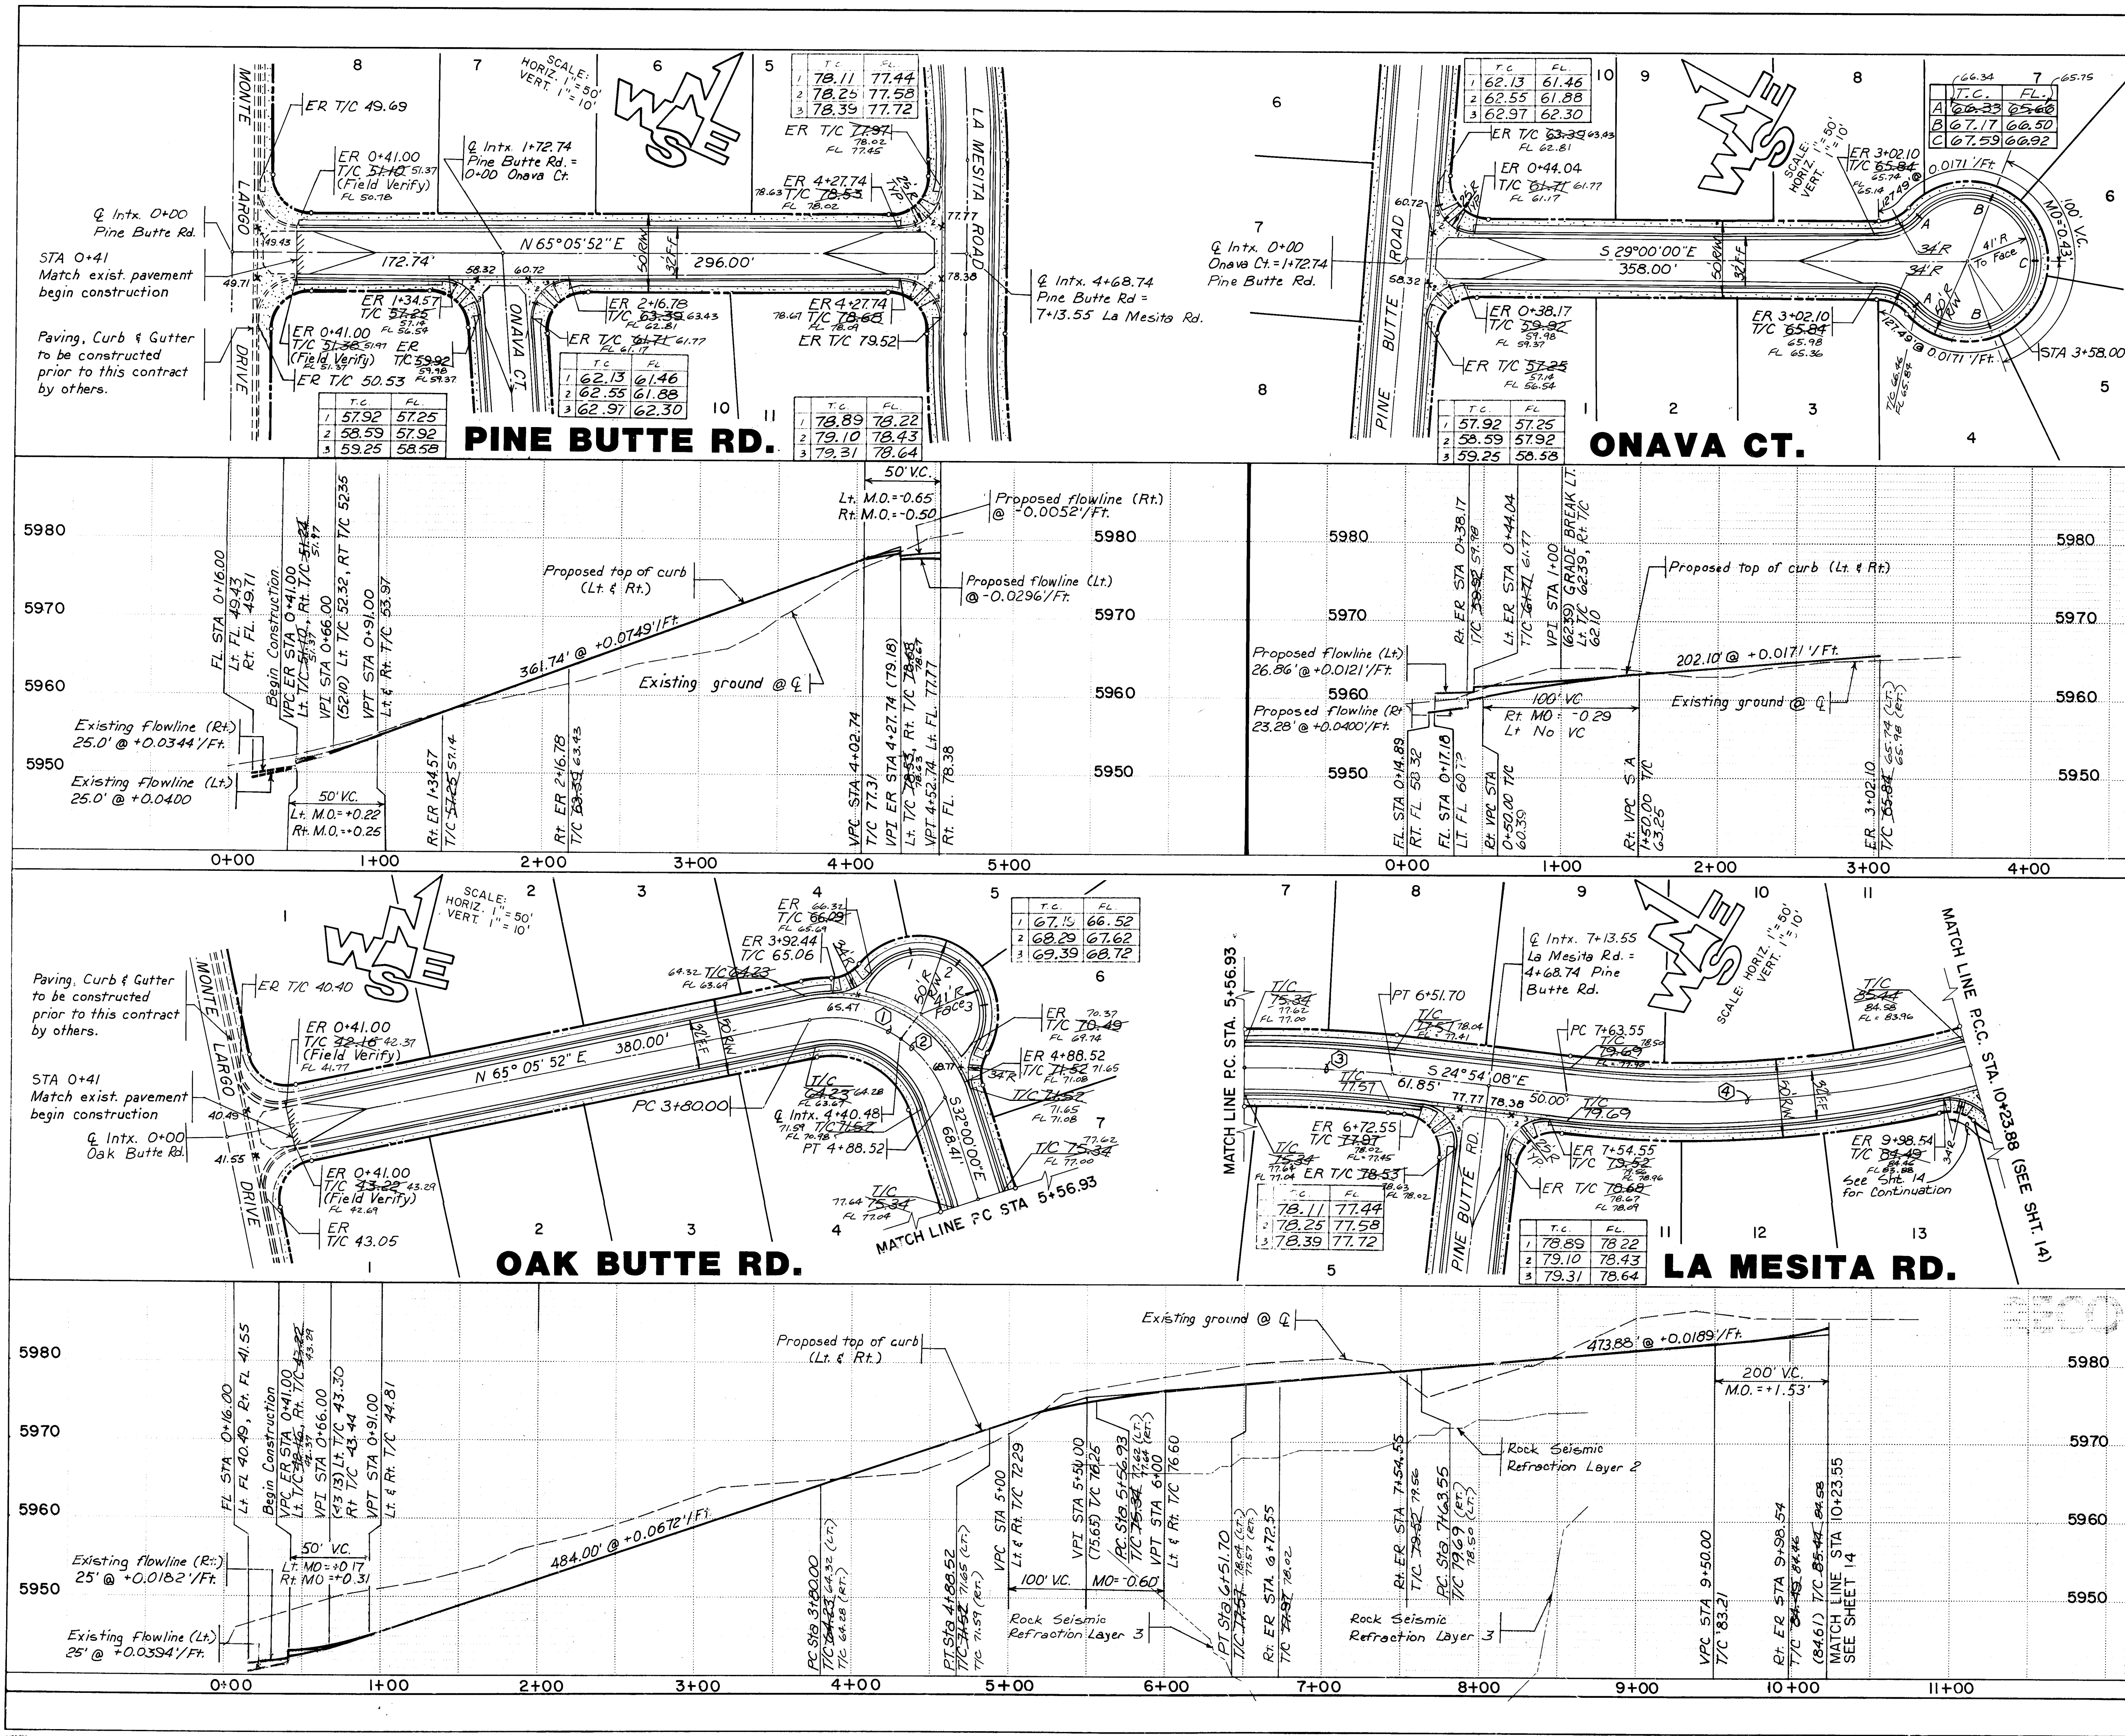

HORIZONTAL CURVE DATA			
NO.	DELTA	RADIUS	LENGTH
3+02.10 TO A	48° 11' 23"	34.00'	28.60'
A TO B	68° 18' 55"	41.00'	48.89'
B TO C	69° 52' 23"	41.00'	50.00'

Note:
Curve Data Along Face of Curb.

HORIZONTAL CURVE DATA			
NO.	DELTA	RADIUS	LENGTH
①	46° 12' 11"	75.00'	60.48'
②	36° 41' 57"	75.00'	48.04'
③	07° 05' 52"	765.00'	94.77'
④	22° 05' 52"	675.00'	260.33'

AS BUILT INFORMATION			
CONTRACTOR	DATE	NO.	DATE
CONTRACTOR	DATE	NO.	DATE

BENCH MARKS			
NO.	DESCRIPTION	ELEVATION	DATE
1	Top of header curb at southwest corner of Sandia Manor pump station.	6011.62	8/83


SURVEY INFORMATION			
NO.	BY	DATE	REMARKS
1620	T. Aldrich	8/83	
1627	T. Aldrich	10/83	
1628	G. Smith	10/83	
1634	J. Preeks	12/83	
1635	G. Smith	1/84	
1636	G. Smith	1/84	

ENGINEER'S SEAL			
NO.	DATE	REMARKS	DESIGN
1	10-85	AS BUILT, T/C & STREET WIDTHS	

CITY OF ALBUQUERQUE MUNICIPAL DEVELOPMENT DEPARTMENT ENGINEERING DIVISION			
TITLE: VISTA DEL MUNDO PINE BUTTE RD., ONAVA CT., OAK BUTTE RD. & LA MESITA RD. STREET PAVING PLAN & PROFILE			
APPROVALS	ENGINEER	DATE	APPROVALS
City Engineer	C. H. H. H.	9/84	Liquid Waste
A.C.E. - Design	J. H. H.	9/84	Traffic
A.C.E. - Hydrology	B. J. H.	7/84	Water

DRAWING NO. 2133			
MAP NO. J-23			
SHEET 12 OF 20			

2133

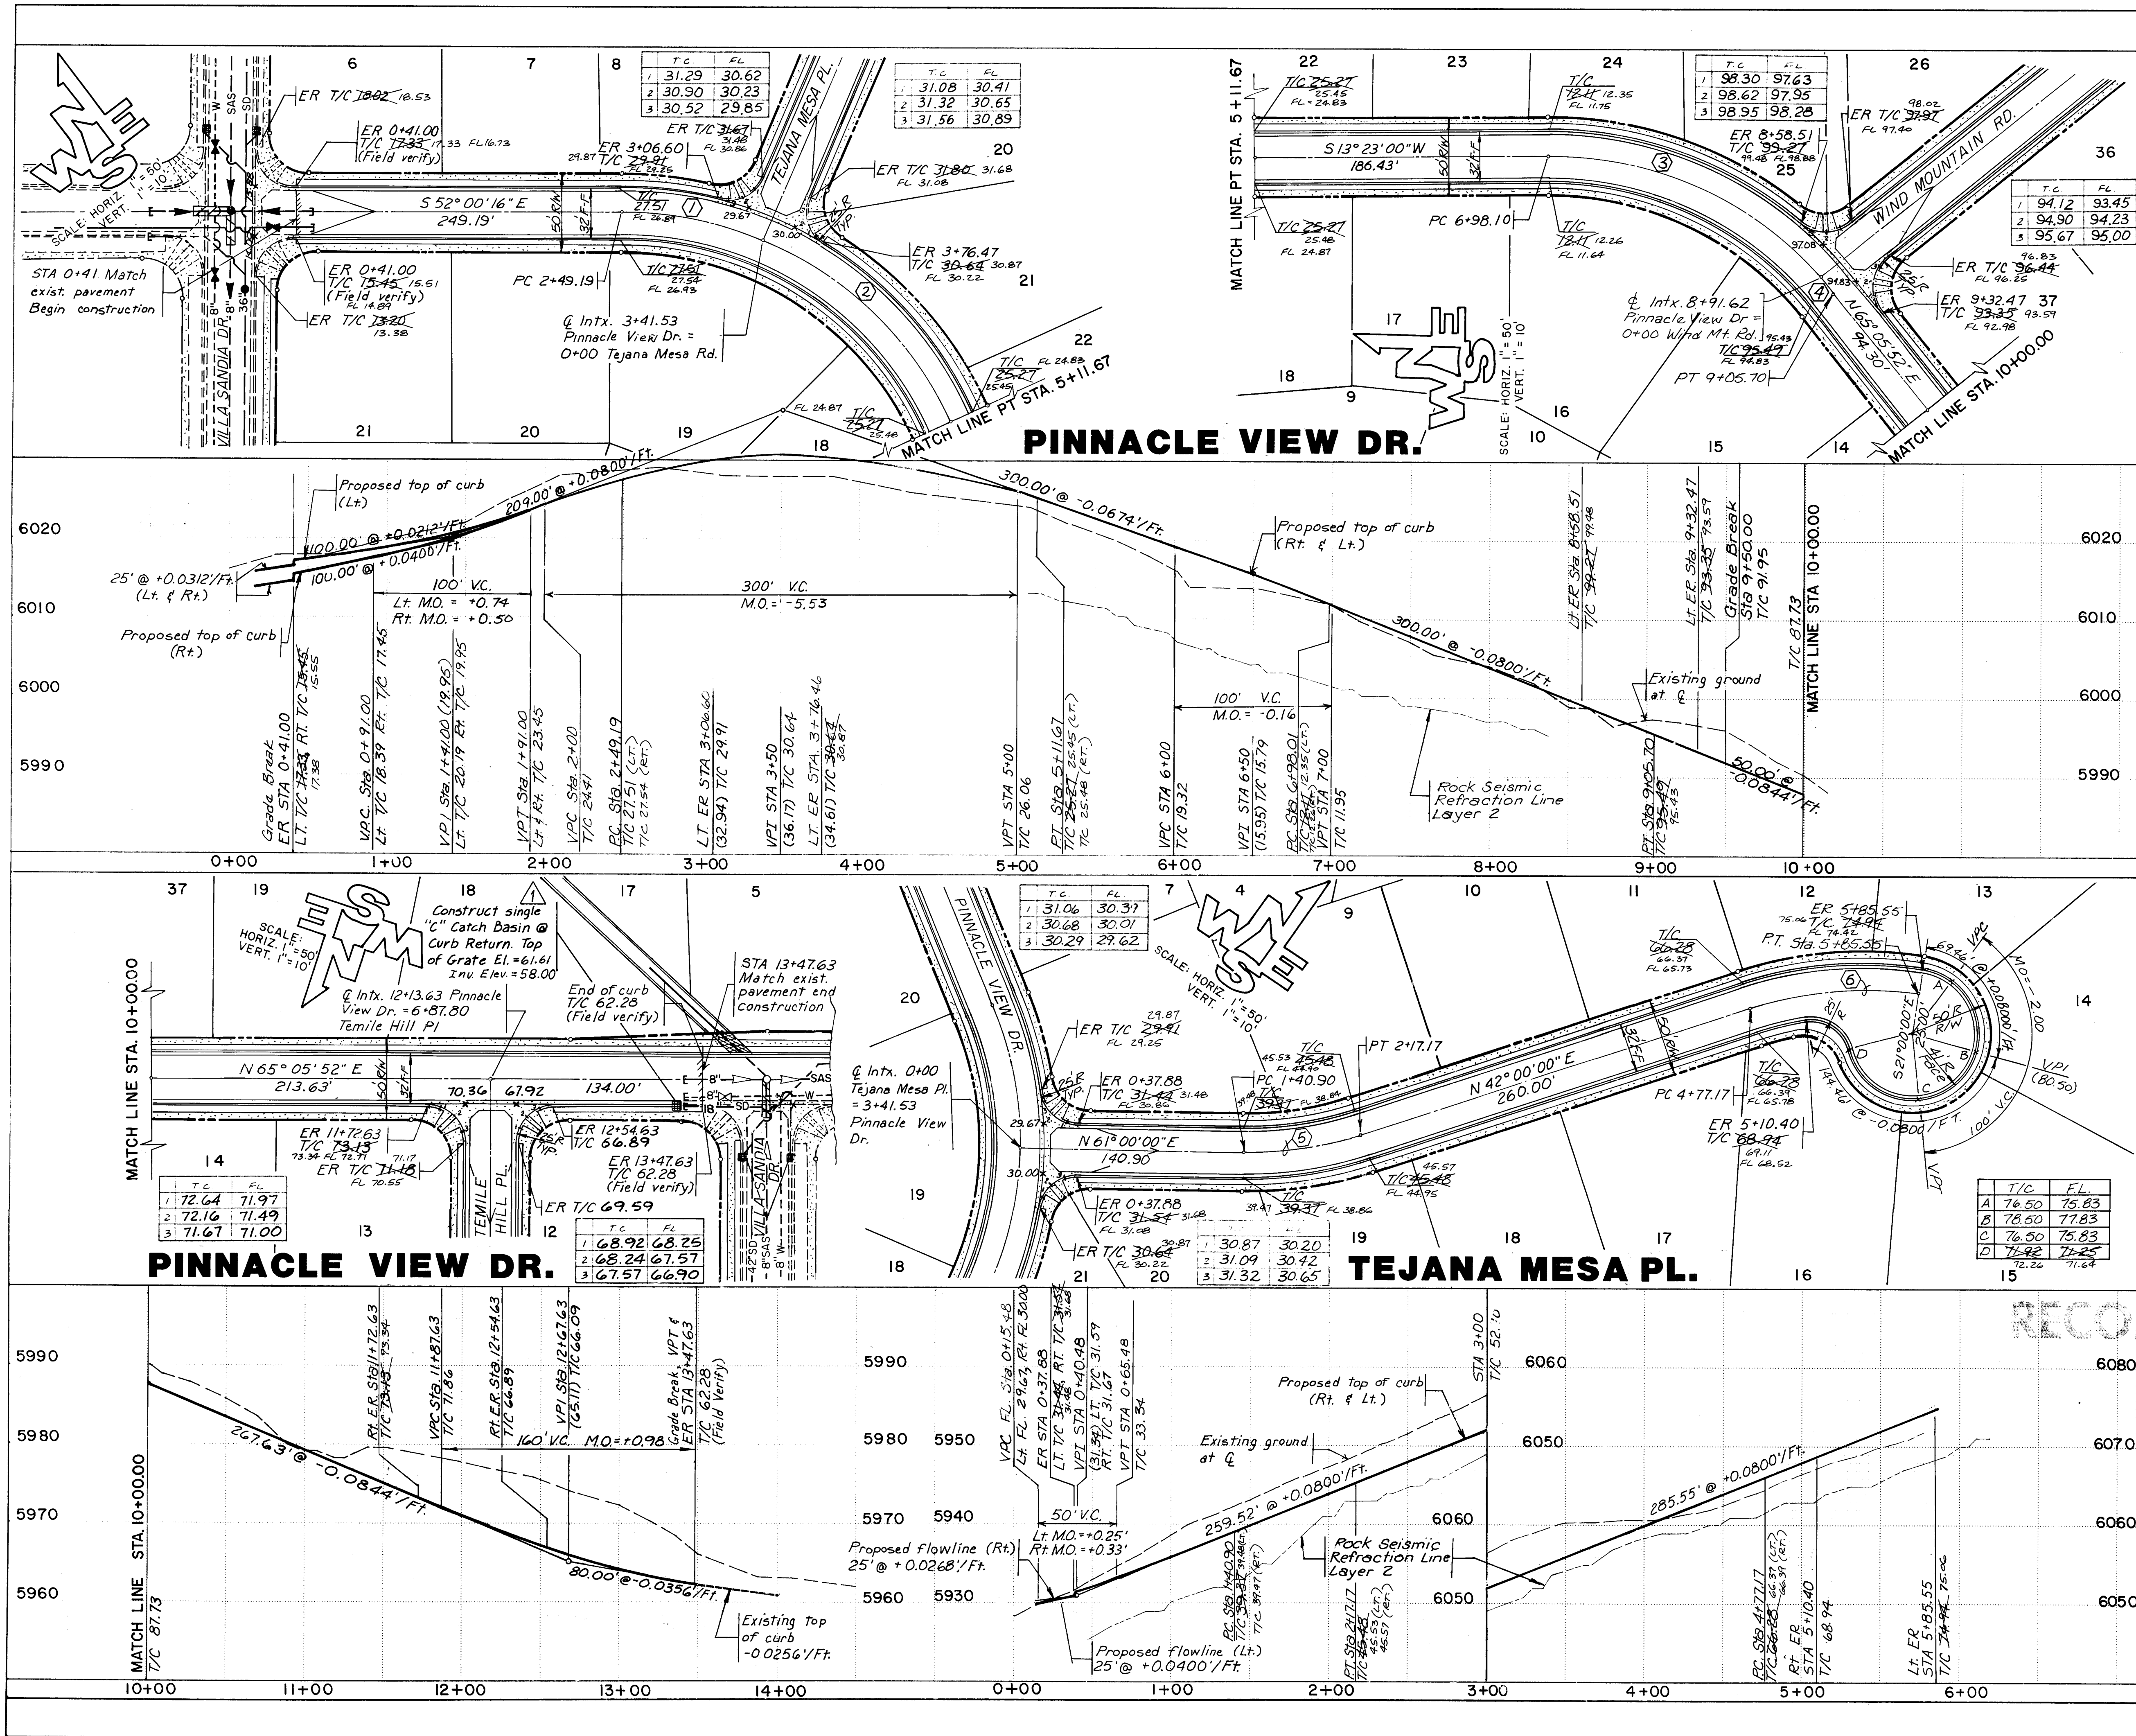

AS BUILT INFORMATION

CONTRACT NO. 10-05

DATE 10/05

BENCH MARKS

Top of header curb at southwest corner of Sandia Manor pump station. Elev. = 6011.62

SURVEY INFORMATION

FIELD NOTES

ENGINEER'S SEAL

10-05

NO. 1620

BY T. Aldrich

DATE 8/83

NO. 1627

BY T. Aldrich

DATE 10/83

NO. 1628

BY G. Smith

DATE 10/83

NO. 1634

BY J. Freeks

DATE 12/83

NO. 1635

BY G. Smith

DATE 1/84

NO. 1636

BY G. Smith

DATE 1/84

REVISIONS

DESIGN

DATE 4-84

REMARKS

10-05 AS BUILT, T/C & STREET WIDTHS

DATE 10-05

DESIGNED BY RM & LJ

DATE 4-84

DRAWN BY BC & JW

DATE 4-84

CHECKED BY MEI

DATE 4-84

CITY OF ALBUQUERQUE

MUNICIPAL DEVELOPMENT DEPARTMENT

ENGINEERING DIVISION

TITLE: VISTA DEL MUNDO

PINNACLE VIEW DR. & TEJANA MESA PL.

STREET PAVING PLAN & PROFILE

APPROVALS

ENGINEER

DATE

APPROVALS

ENGINEER

DATE

City Engineer

10/05

9/05

Liquid Waste

R. Pena

7/10/05

A C E - Design

10/05

9/05

Traffic

D. J. Pena

7/10/05

A C E - Hydrology

10/05

9/05

Water

R. Pena



7/10/05

DRAWING NO. 2133




MAP NO. J-23

SHEET 13 OF 20

HORIZONTAL CURVE DATA			
NO.	DELTA	RADIUS	LENGTH
1	23°00'00"	75.00'	30.11'
2	49°00'00"	75.00'	64.14'
3	19°30'00"	318.14'	108.27'

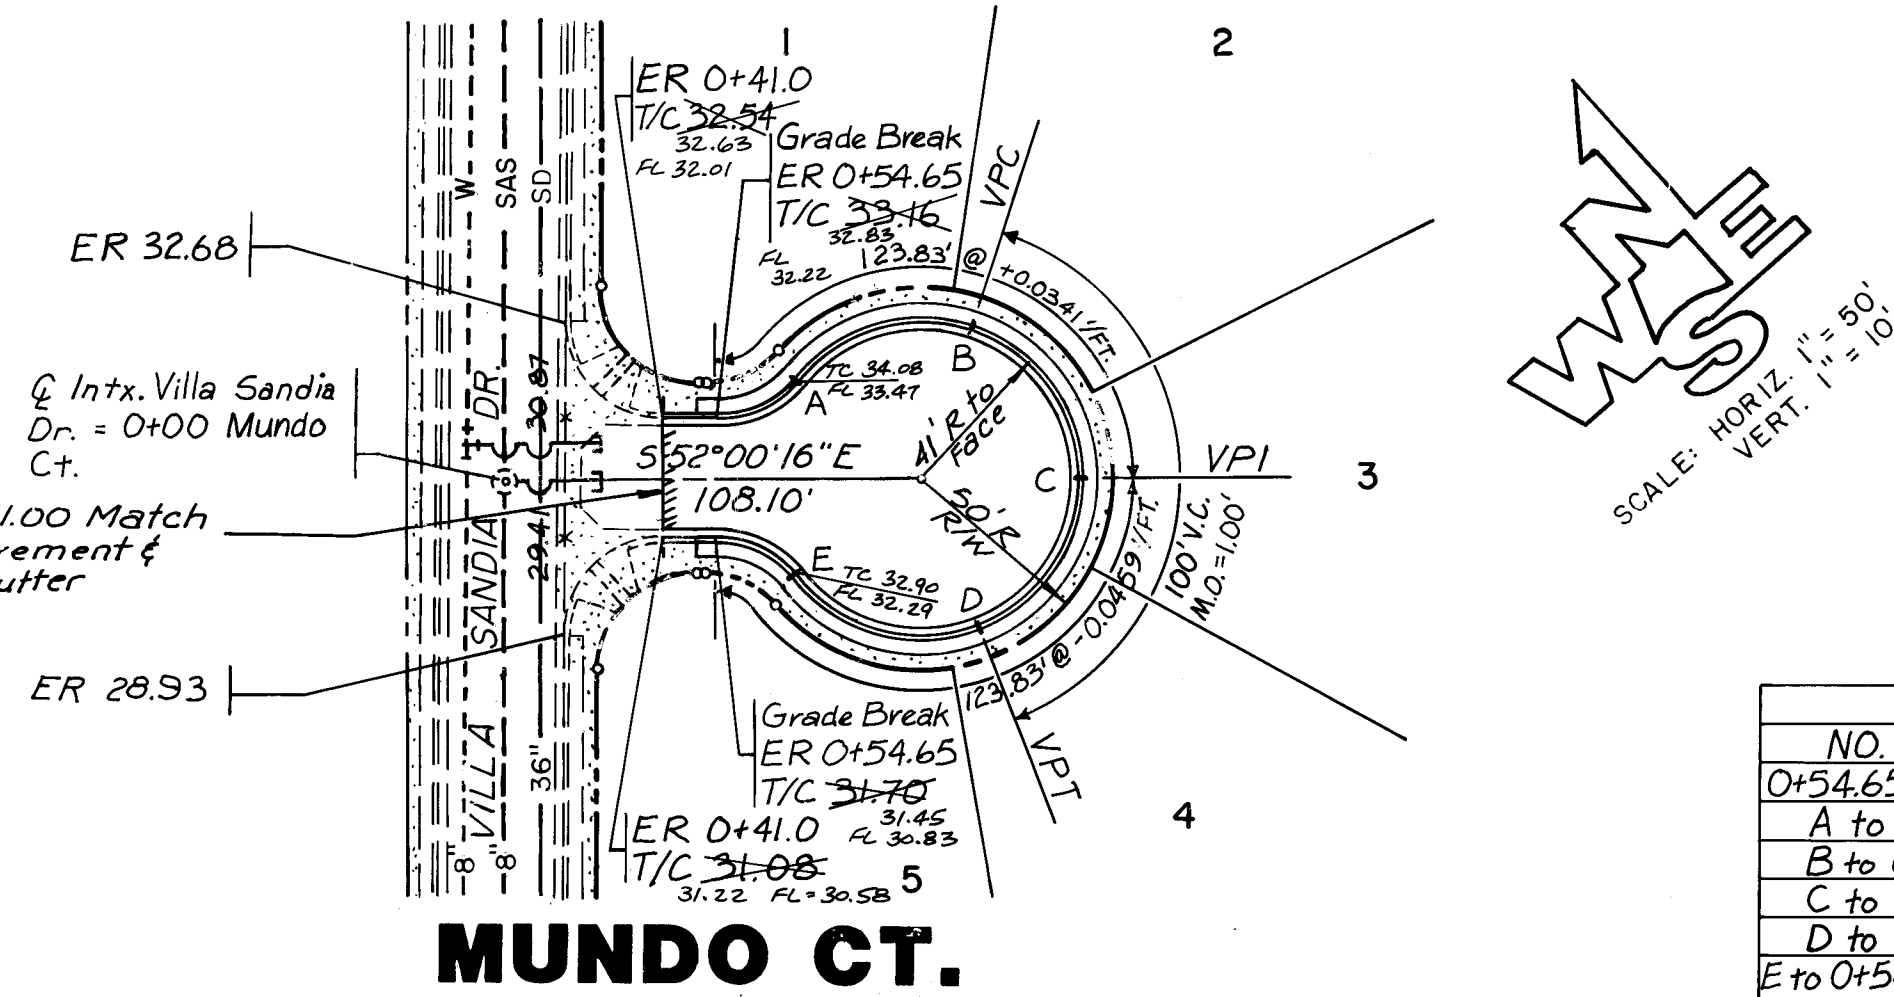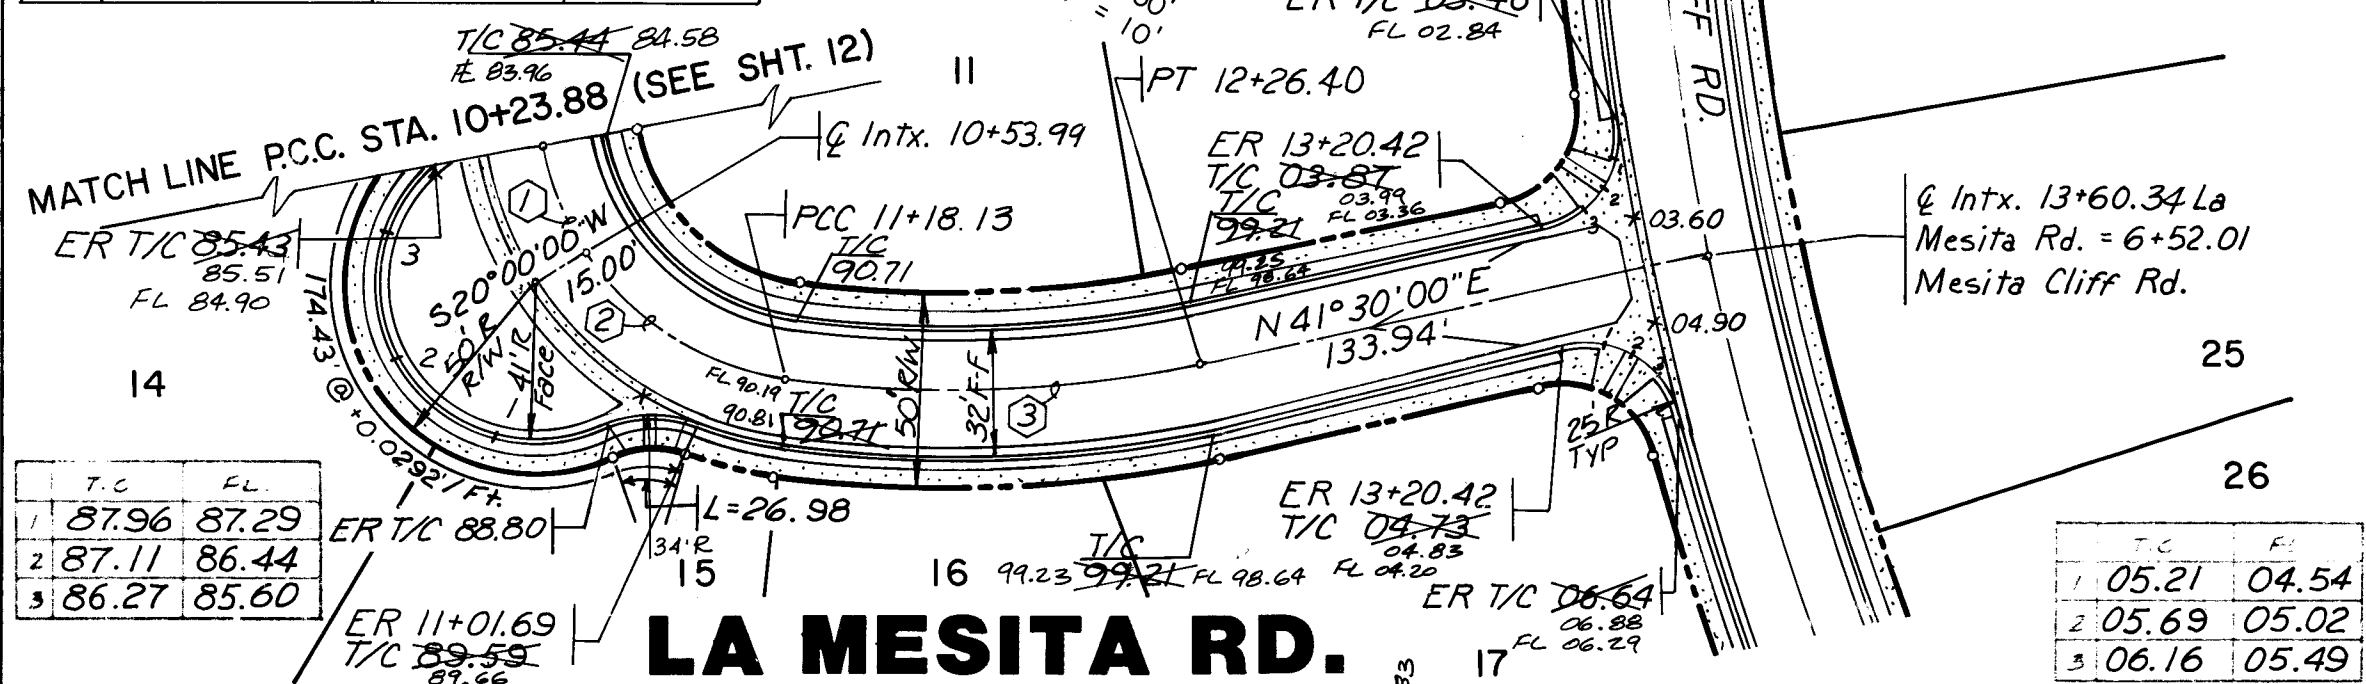





CURVE DATA			
NO.	Δ	R	L
0+54.65 to A	51°35'43"	25.00'	22.51'
A to B	71°43'21"	41.00'	51.32'
B to C	69°52'22"	41.00'	50.00'
C to D	69°52'23"	41.00'	50.00'
D to E	71°43'20"	41.00'	51.32'
E to 0+54.65	51°35'43"	25.00'	22.51'

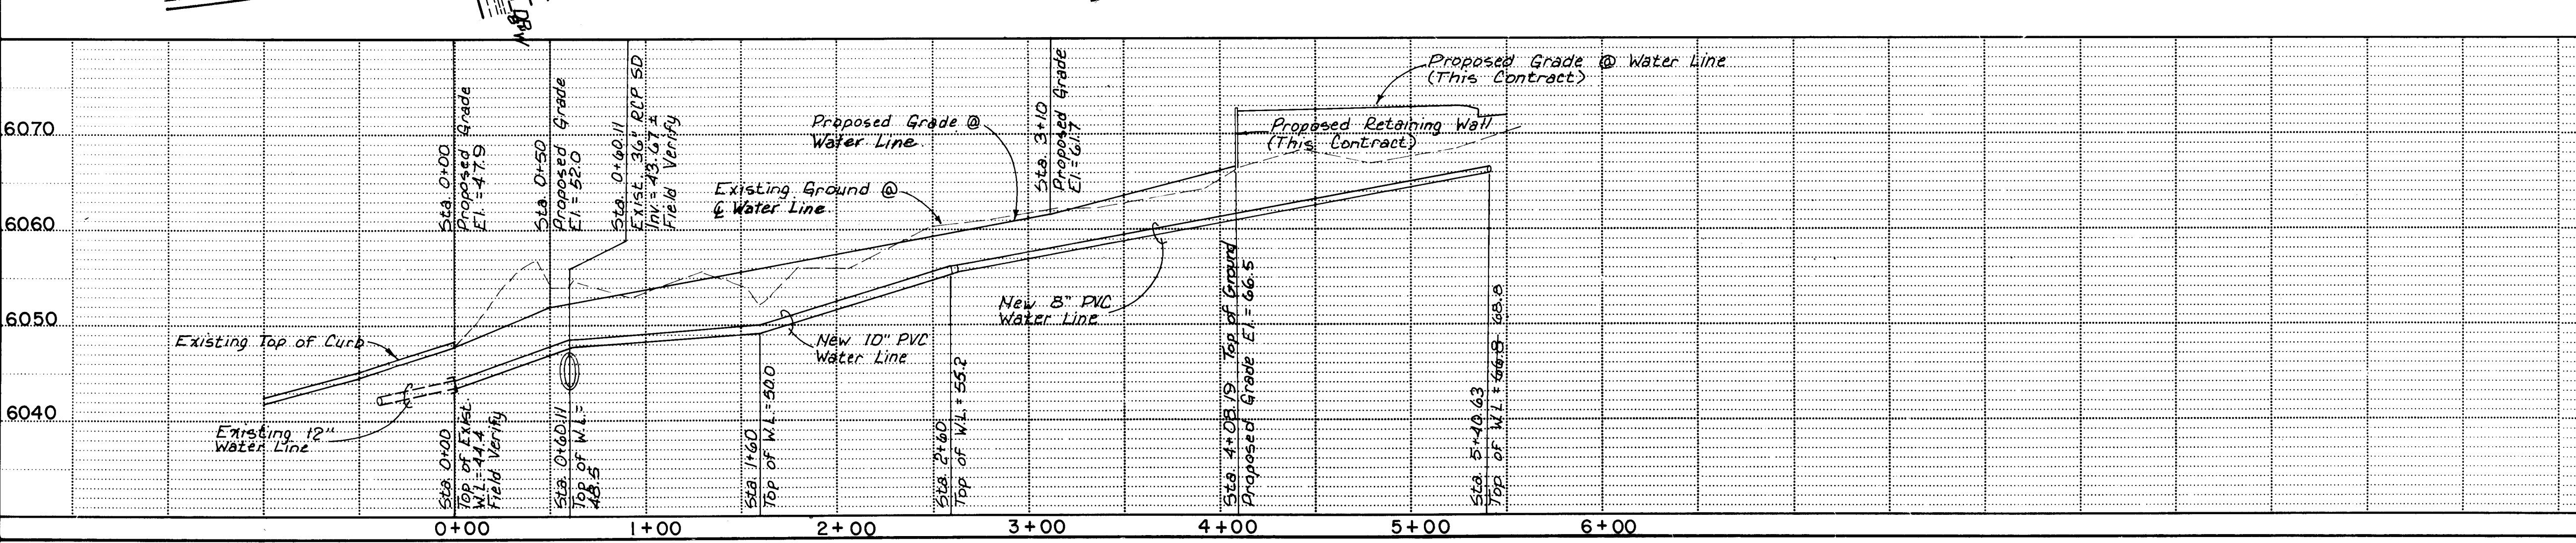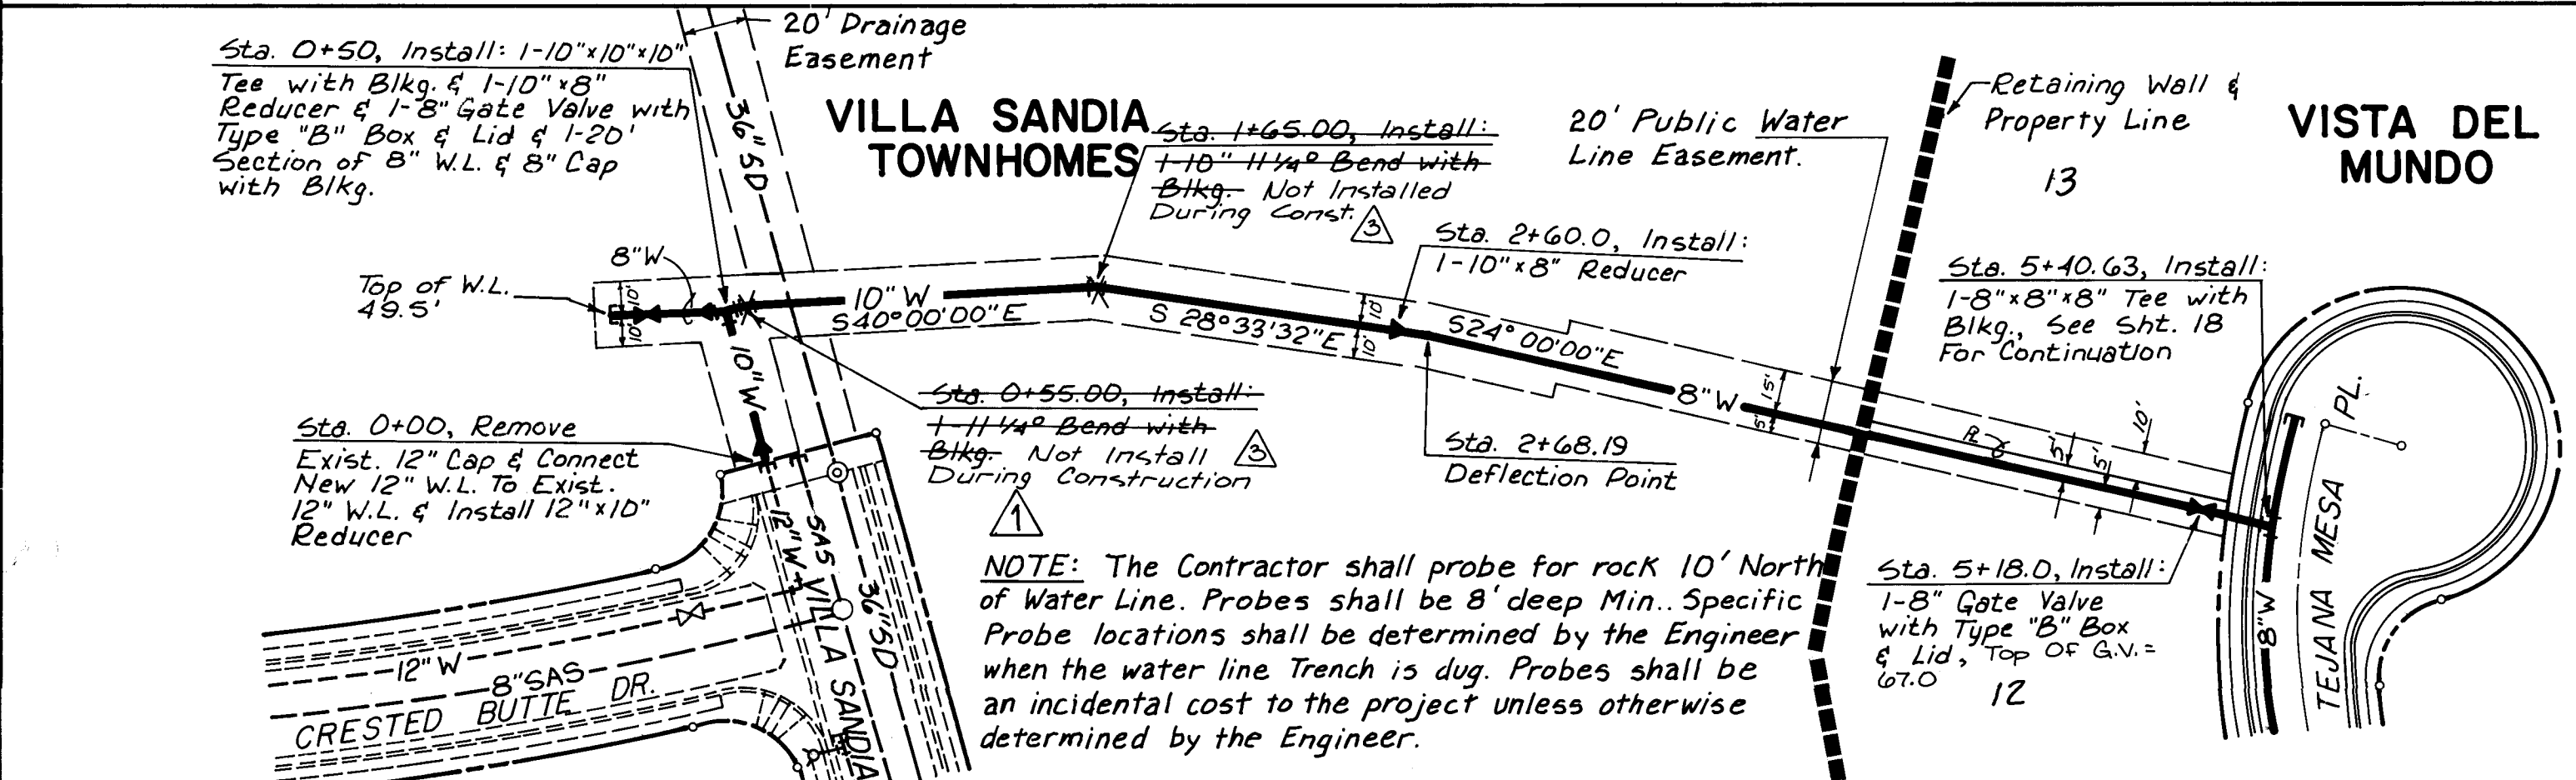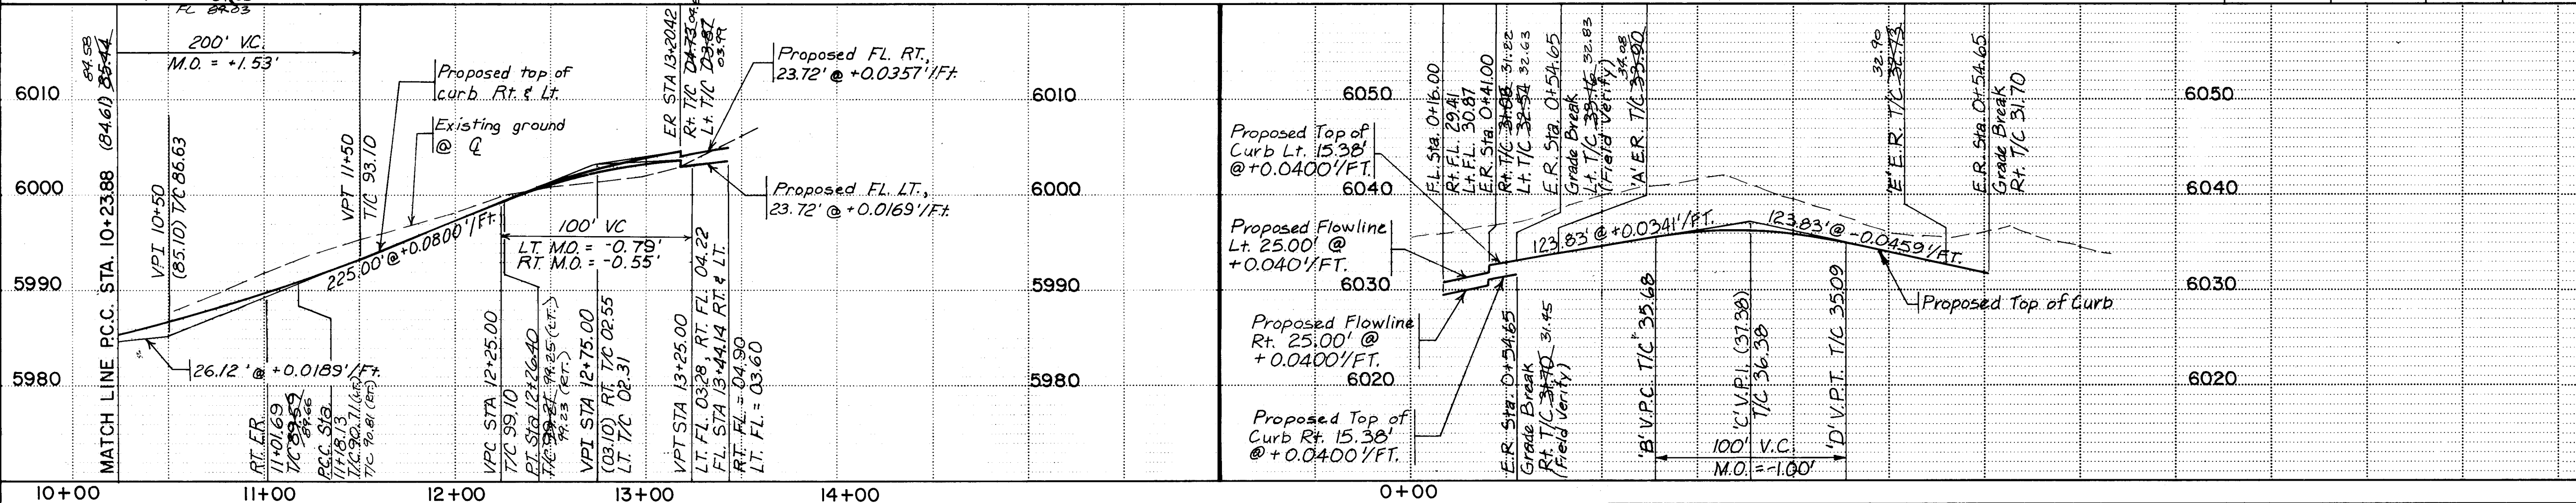


RECORD DRAWING

ENGINEER'S SEAL		SURVEY INFORMATION		BENCH MARKS		AS BUILT INFORMATION	
NO.	DATE	BY	FIELD NOTES	Top of header curb at southwest corner of Sandia Manor pump station. Elev. = 6011.62	CONTRACTOR	CONTRACTOR	CONTRACTOR
1620	8/83	T. Aldrich					
1627	10/83	T. Aldrich					
1628	10/83	G. Smith					
1634	12/83	J. Freese					
1635	1/84	G. Smith					
1636	1/84	G. Smith					

CITY OF ALBUQUERQUE MUNICIPAL DEVELOPMENT DEPARTMENT ENGINEERING DIVISION			
TITLE: VISTA DEL MUNDO LA MESITA RD. & MUNDO CT. STREET PAVING PLAN & PROFILE, ZONE 10E WATER LINE EXTENSION			
APPROVALS	ENGINEER	DATE	APPROVALS
City Engineer	C. H. [Signature]	7/18/84	Liquid Waste
A.C.E. - Design	[Signature]	7/18/84	Traffic
A.C.E. - Hydrology	[Signature]	7/18/84	Water
DRAWING NO.	2133	MAP NO.	J-23
SHEET	14	OF	20

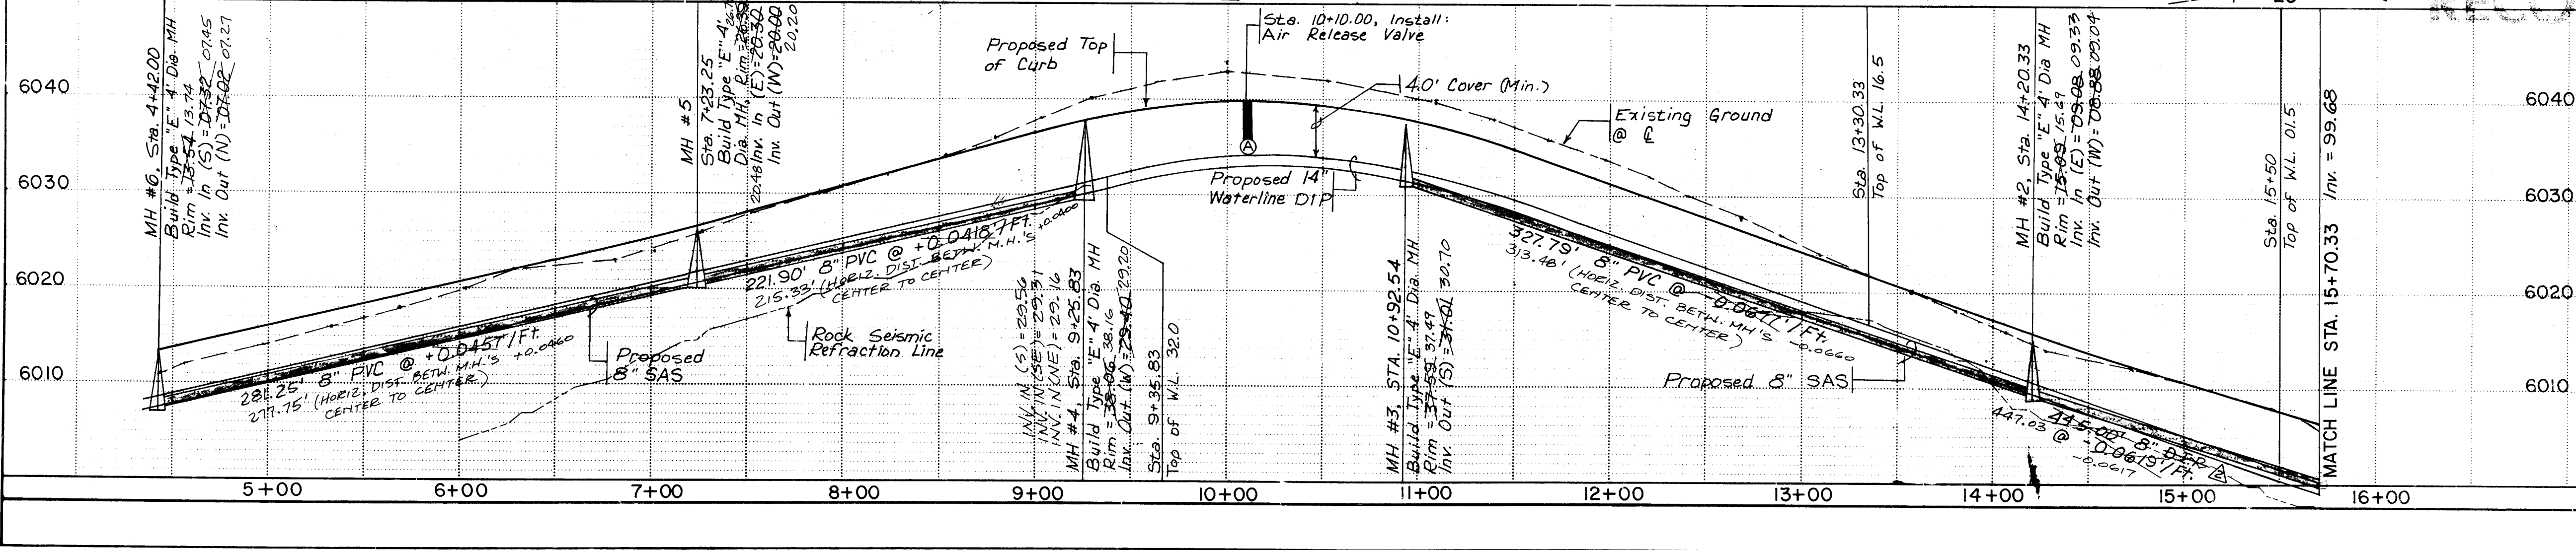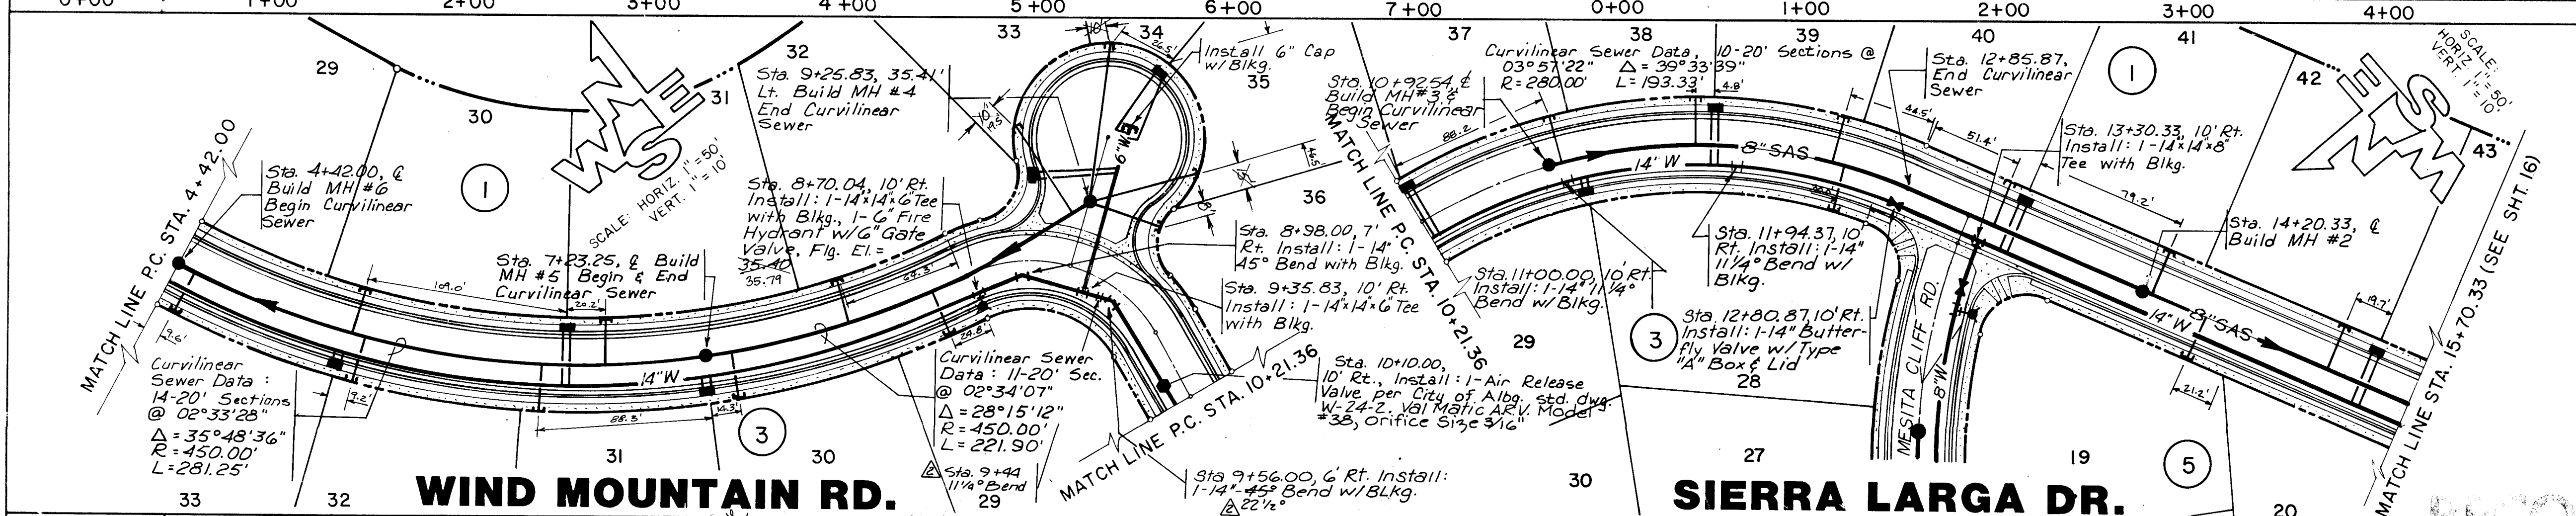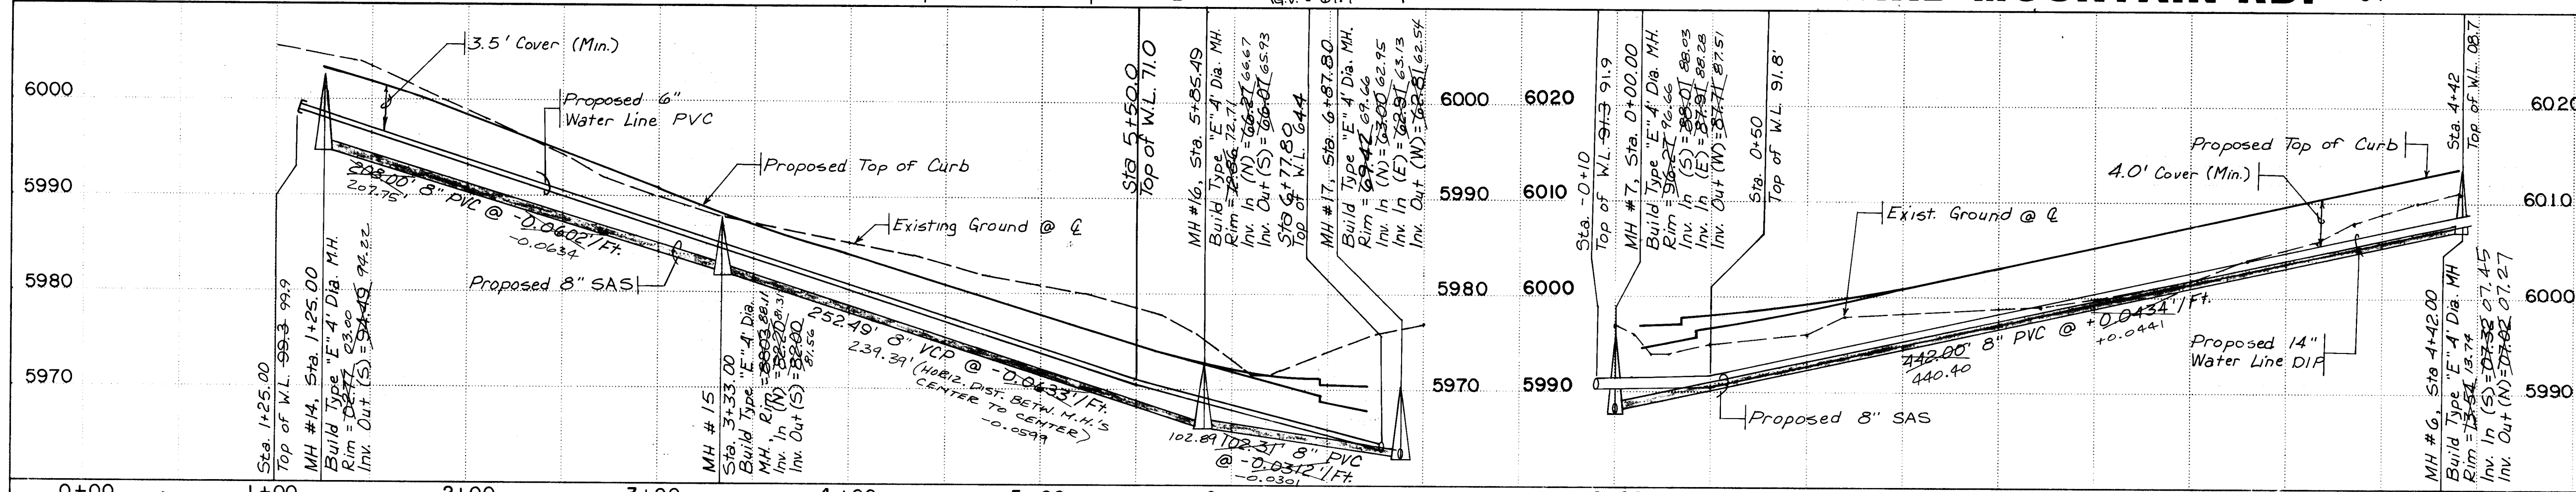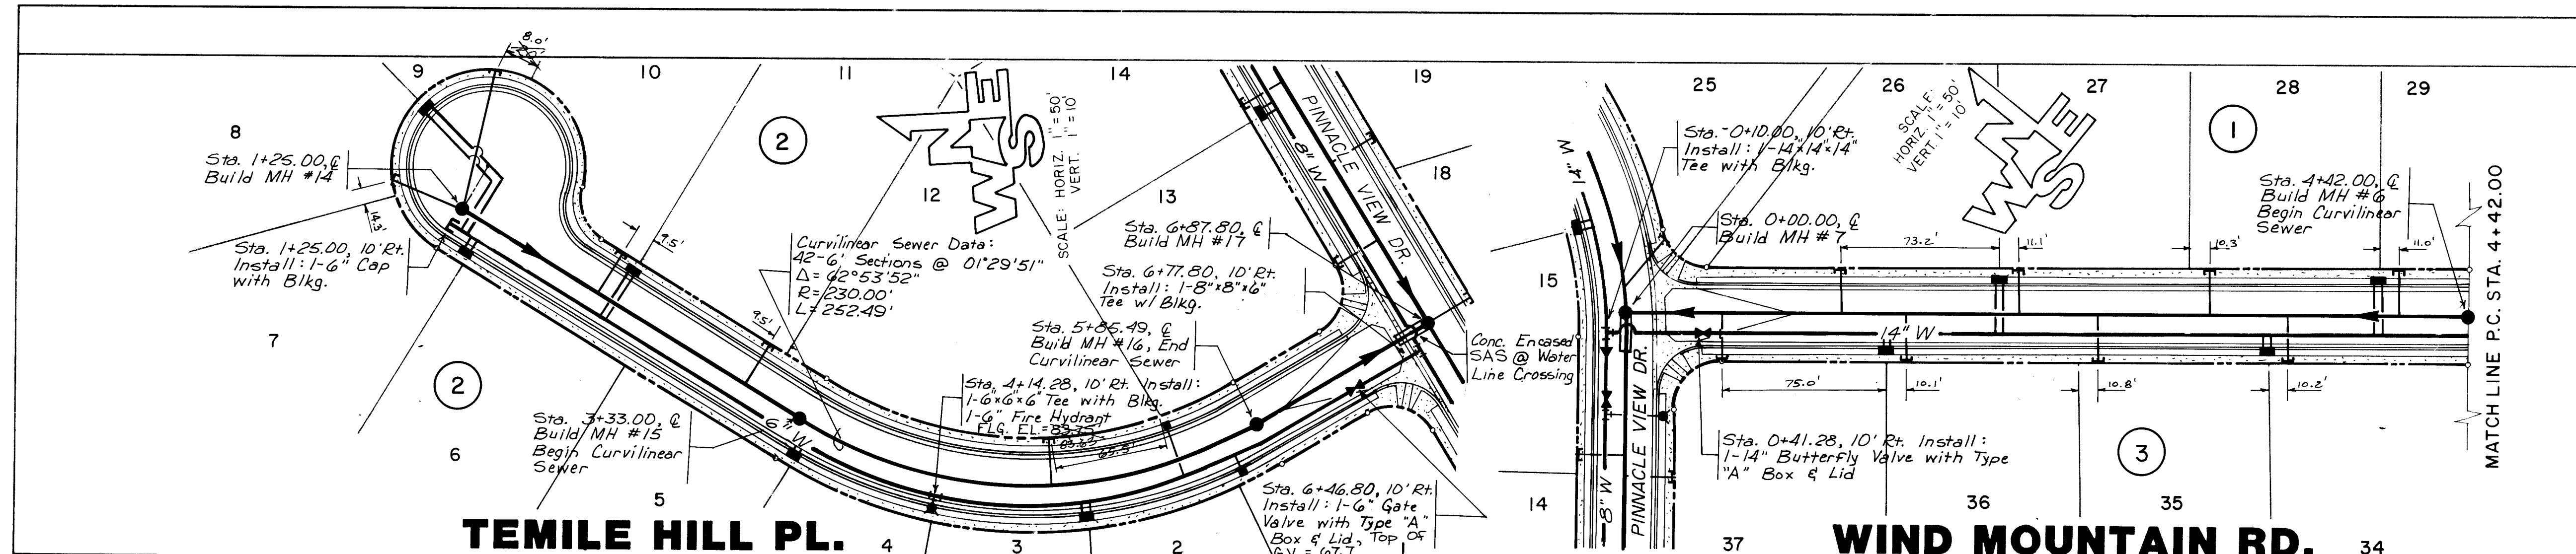

Notes: 1. Sanitary Sewer Line Service Stub-Outs For Block 3, Lots 1 to 7 & Block 2, Lots 1 & 5 Shall be Provided by Bohannon-Huston Inc., Embudo Hills Infrastructure. Phase I Plans. City Job No. 2007.										AS BUILT INFORMATION CONTRACT NO. 11-885 DRAWING NO. 10-85 ENGINEER DATE PROJECT NO. SHEET NO.																																																						
TEMILE HILL PL. SEWER SERVICES										BENCH MARKS Top of header curb at southwest corner of Sandia Manor pump station. Elev. =6011.62																																																						
<table><thead><tr><th>BLK.</th><th>LOT</th><th>STATION</th><th>INVERT @ P.L.</th><th>LENGTH</th></tr></thead><tbody><tr><td>2</td><td>8</td><td>1+25.0</td><td>95.7</td><td>43'</td></tr><tr><td>2</td><td>9</td><td>1+25.0</td><td>96.3</td><td>73'</td></tr><tr><td>2</td><td>10</td><td>2+06.0</td><td>91.7</td><td>25'</td></tr><tr><td>2</td><td>11</td><td>2+99.0</td><td>86.2</td><td>25'</td></tr><tr><td>2</td><td>12</td><td>4+70.0</td><td>75.5</td><td>25'</td></tr></tbody></table>										BLK.	LOT	STATION	INVERT @ P.L.	LENGTH	2	8	1+25.0	95.7	43'	2	9	1+25.0	96.3	73'	2	10	2+06.0	91.7	25'	2	11	2+99.0	86.2	25'	2	12	4+70.0	75.5	25'																									
BLK.	LOT	STATION	INVERT @ P.L.	LENGTH																																																												
2	8	1+25.0	95.7	43'																																																												
2	9	1+25.0	96.3	73'																																																												
2	10	2+06.0	91.7	25'																																																												
2	11	2+99.0	86.2	25'																																																												
2	12	4+70.0	75.5	25'																																																												
WIND MOUNTAIN RD. SEWER SERVICES										SURVEY INFORMATION <table><thead><tr><th>NO.</th><th>BY</th><th>DATE</th></tr></thead><tbody><tr><td>1620</td><td>T. Aldrich</td><td>8/83</td></tr><tr><td>1627</td><td>T. Aldrich</td><td>10/83</td></tr><tr><td>1628</td><td>G. Smith</td><td>10/83</td></tr><tr><td>1634</td><td>J. Freeks</td><td>12/83</td></tr><tr><td>1635</td><td>G. Smith</td><td>1/84</td></tr><tr><td>1636</td><td>G. Smith</td><td>1/84</td></tr></tbody></table>										NO.	BY	DATE	1620	T. Aldrich	8/83	1627	T. Aldrich	10/83	1628	G. Smith	10/83	1634	J. Freeks	12/83	1635	G. Smith	1/84	1636	G. Smith	1/84																								
NO.	BY	DATE																																																														
1620	T. Aldrich	8/83																																																														
1627	T. Aldrich	10/83																																																														
1628	G. Smith	10/83																																																														
1634	J. Freeks	12/83																																																														
1635	G. Smith	1/84																																																														
1636	G. Smith	1/84																																																														
SIERRA LARGA DR. SEWER SERVICES										ENGINEER'S SEAL 11-885 As-Built Per Ernest Vallegos, City DESI 10-85 As-Built Water and Sewer Lines DESI DESIGNED BY RFE & LJ DRAWN BY BC & JW CHECKED BY RHE DATE 4-84 DATE 4-84 DATE 4-84																																																						
<table><thead><tr><th>BLK.</th><th>LOT</th><th>STATION</th><th>INVERT @ P.L.</th><th>LENGTH</th></tr></thead><tbody><tr><td>1</td><td>37</td><td>10+98.0</td><td>32.6</td><td>25'</td></tr><tr><td>1</td><td>38</td><td>11+70.5</td><td>27.8</td><td>25'</td></tr><tr><td>1</td><td>39</td><td>12+45.0</td><td>22.8</td><td>25'</td></tr><tr><td>3</td><td>28</td><td>12+48.0</td><td>23.4</td><td>25'</td></tr><tr><td>1</td><td>40</td><td>13+35.0</td><td>16.8</td><td>25'</td></tr><tr><td>1</td><td>41</td><td>14+25.0</td><td>10.8</td><td>25'</td></tr><tr><td>5</td><td>19</td><td>14+54.0</td><td>09.3</td><td>25'</td></tr><tr><td>1</td><td>42</td><td>15+25.0</td><td>04.5</td><td>25'</td></tr></tbody></table>										BLK.	LOT	STATION	INVERT @ P.L.	LENGTH	1	37	10+98.0	32.6	25'	1	38	11+70.5	27.8	25'	1	39	12+45.0	22.8	25'	3	28	12+48.0	23.4	25'	1	40	13+35.0	16.8	25'	1	41	14+25.0	10.8	25'	5	19	14+54.0	09.3	25'	1	42	15+25.0	04.5	25'	REVISIONS DESIGN									
BLK.	LOT	STATION	INVERT @ P.L.	LENGTH																																																												
1	37	10+98.0	32.6	25'																																																												
1	38	11+70.5	27.8	25'																																																												
1	39	12+45.0	22.8	25'																																																												
3	28	12+48.0	23.4	25'																																																												
1	40	13+35.0	16.8	25'																																																												
1	41	14+25.0	10.8	25'																																																												
5	19	14+54.0	09.3	25'																																																												
1	42	15+25.0	04.5	25'																																																												
26 21331586																																																																
CITY OF ALBUQUERQUE MUNICIPAL DEVELOPMENT DEPARTMENT ENGINEERING DIVISION										CITY OF ALBUQUERQUE MUNICIPAL DEVELOPMENT DEPARTMENT ENGINEERING DIVISION																																																						
TITLE: VISTA DEL MUNDO TEMILE HILL PL., WIND MT. RD. & SIERRA LARGA DR. STREET UTILITY PLAN & PROFILE										TITLE: VISTA DEL MUNDO TEMILE HILL PL., WIND MT. RD. & SIERRA LARGA DR. STREET UTILITY PLAN & PROFILE																																																						
APPROVALS City Engineer <i>C. McHenry</i> 7/18/84 A C E - Design <i>W. Chen</i> 7/18/84 A C E - Hydrology <i>N.A. Rye</i> 7/18/84										APPROVALS liquid Waste Traffic Water <i>R. Peña</i> 7/18/84 <i>NA 20H</i> 7/18/84 <i>K. Peña</i> 7/18/84																																																						
DRAWING NO. 2133										MAP NO. 1-23																																																						
SHEET 15										OF 20																																																						

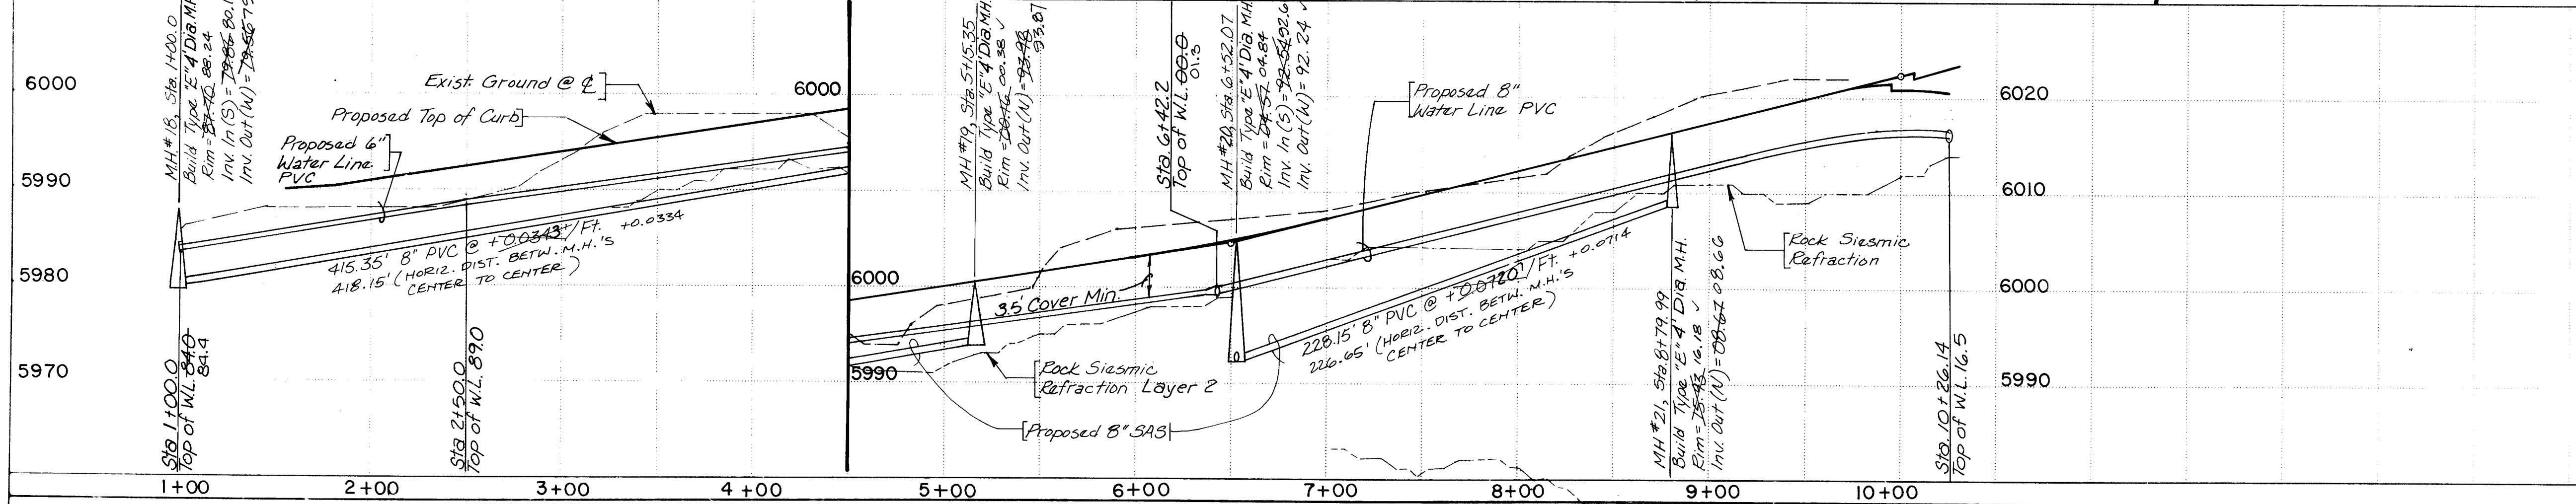

SIERRA LARGA DR. SEWER SERVICES

BLK.	LOT	STATION	INVERT @ P.L.	LENGTH
5	20	16+00.0	99.9 100.3	25'
1	43	16+25.0	70.8 90.8	25'
5	21	17+00.5	93.1 93.7	25'
1	44	17+25.0	92.0 92.7	25'
5	22	18+17.5	87.2	25'
1	45	18+25.0	86.8	25'
5	23	19+25.0	80.8	25'
1	46	19+27.0	77.8	25'
1	47	20+25.0	73.4	25'
5	24	20+35.5	73.7	25'
1	48	21+00.0	66.8	25'
5	25	21+45.0	66.0	25'
1	49	22+33.0	60.3	25'
5	26	22+41.5	62.5	25'

MESITA CLIFF RD. SEWER SERVICES

BLK.	LOT	STATION	INVERT @ P.L.	LENGTH
3	19	1+00.0	81.7 81.5	50'
3	20	1+00.0	82.2 81.5	50'
3	16	1+47.00	83.1 83.2	28'
3	21	1+90.0	84.9 84.9	25'
3	13	2+49.0	86.7 86.9	25'
3	22	2+90.0	88.8 88.3	25'
3	14	3+49.0	90.2 90.3	25'
3	23	3+97.5	92.6 92.4	25'
3	13	4+45.5	93.9 93.3	25'
3	24	5+07.5	95.7 95.7	25'
3	25	6+55.0	94.8	25'
3	26	7+37.5	00.6	25'
5	18	7+77.5	03.4	25'
3	27	8+51.5	08.7	27'

AS BUILT INFORMATION

CONTRACTOR'S CONTRACTING & ENGINEERING INC.

WORK SHEET NO. 1

DATE 11-5-85

PROJECT NAME SIERRA LARGA DR. SEWER

FIELD ALLOCATION BY GSEINER DATE 10-8-85

CORRECTION BY GSEINER DATE 10-8-85

RECORDED BY

DATE

NO

BENCH MARKS

Top of header curb at southwest corner of Sandia Manor pump station. Elev. = 6011.62

SURVEY INFORMATION

FIELD NOTES

DATE 6/83

BY T. Aldrich

NO. 1620

DATE 10/83

BY T. Aldrich

NO. 1627

DATE 12/83

BY J. Freeks

NO. 1634

DATE 1/84

BY G. Smith

NO. 1635

DATE 1/84

BY G. Smith

NO. 1636

ENGINEER'S SEAL

11-5-85 As-Built Per Ernest Vallegos City

10-8-85 As-Built Water & Sanitary Sewer

10-8-85 As-Built Water & Sanitary Sewer








10-8-85 As-Built Water & Sanitary Sewer

10-8-85 As-Built Water & Sanitary Sewer

10-8-85 As-Built Water & Sanitary Sewer

10-8-85 As-Built Water & Sanitary Sewer

10-8-85 As-Built Water &

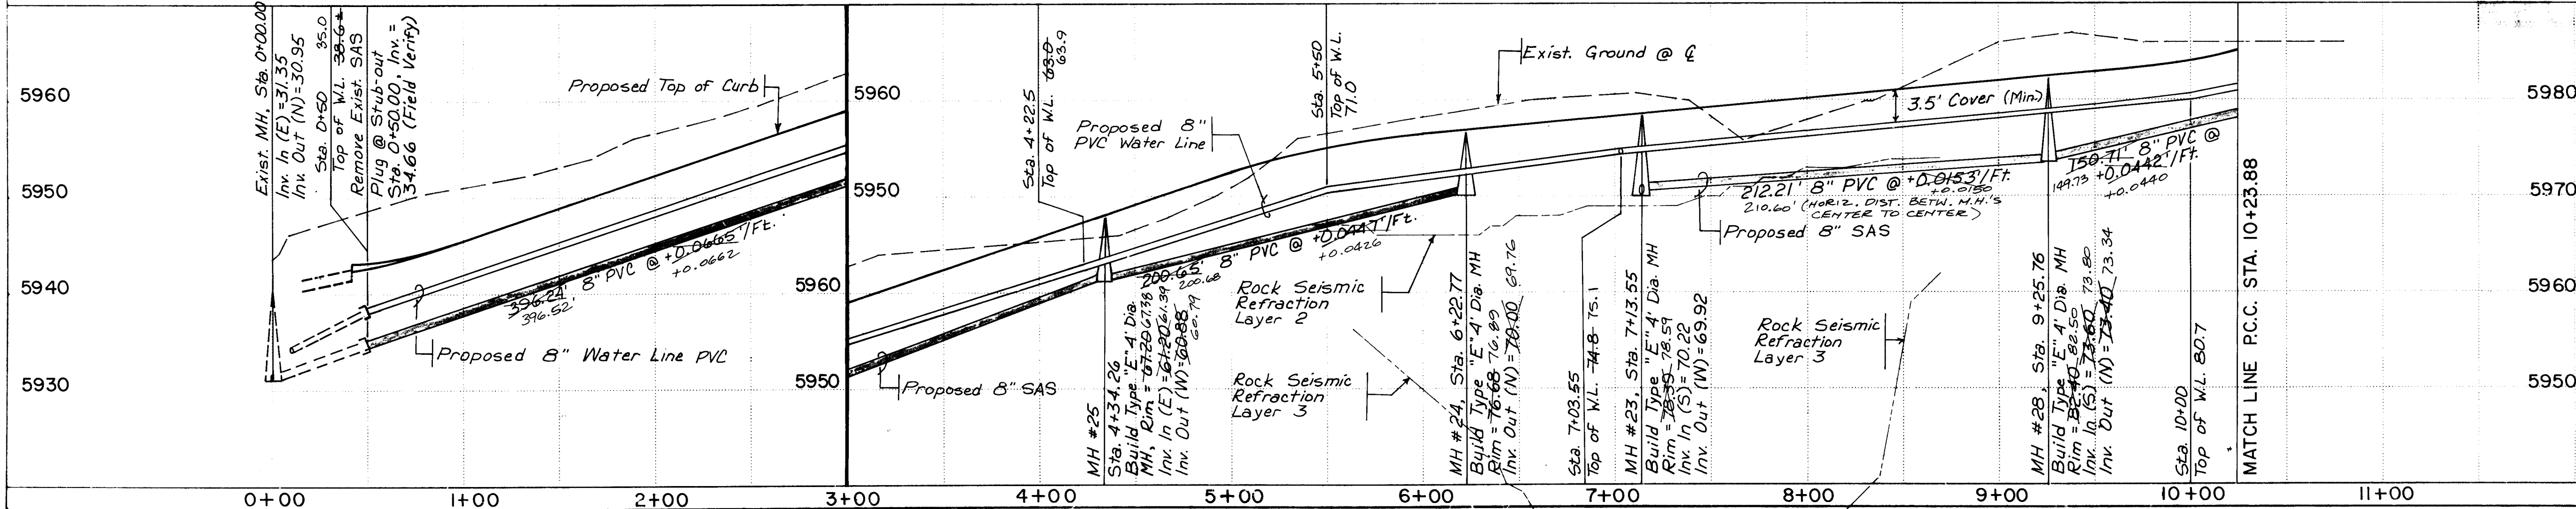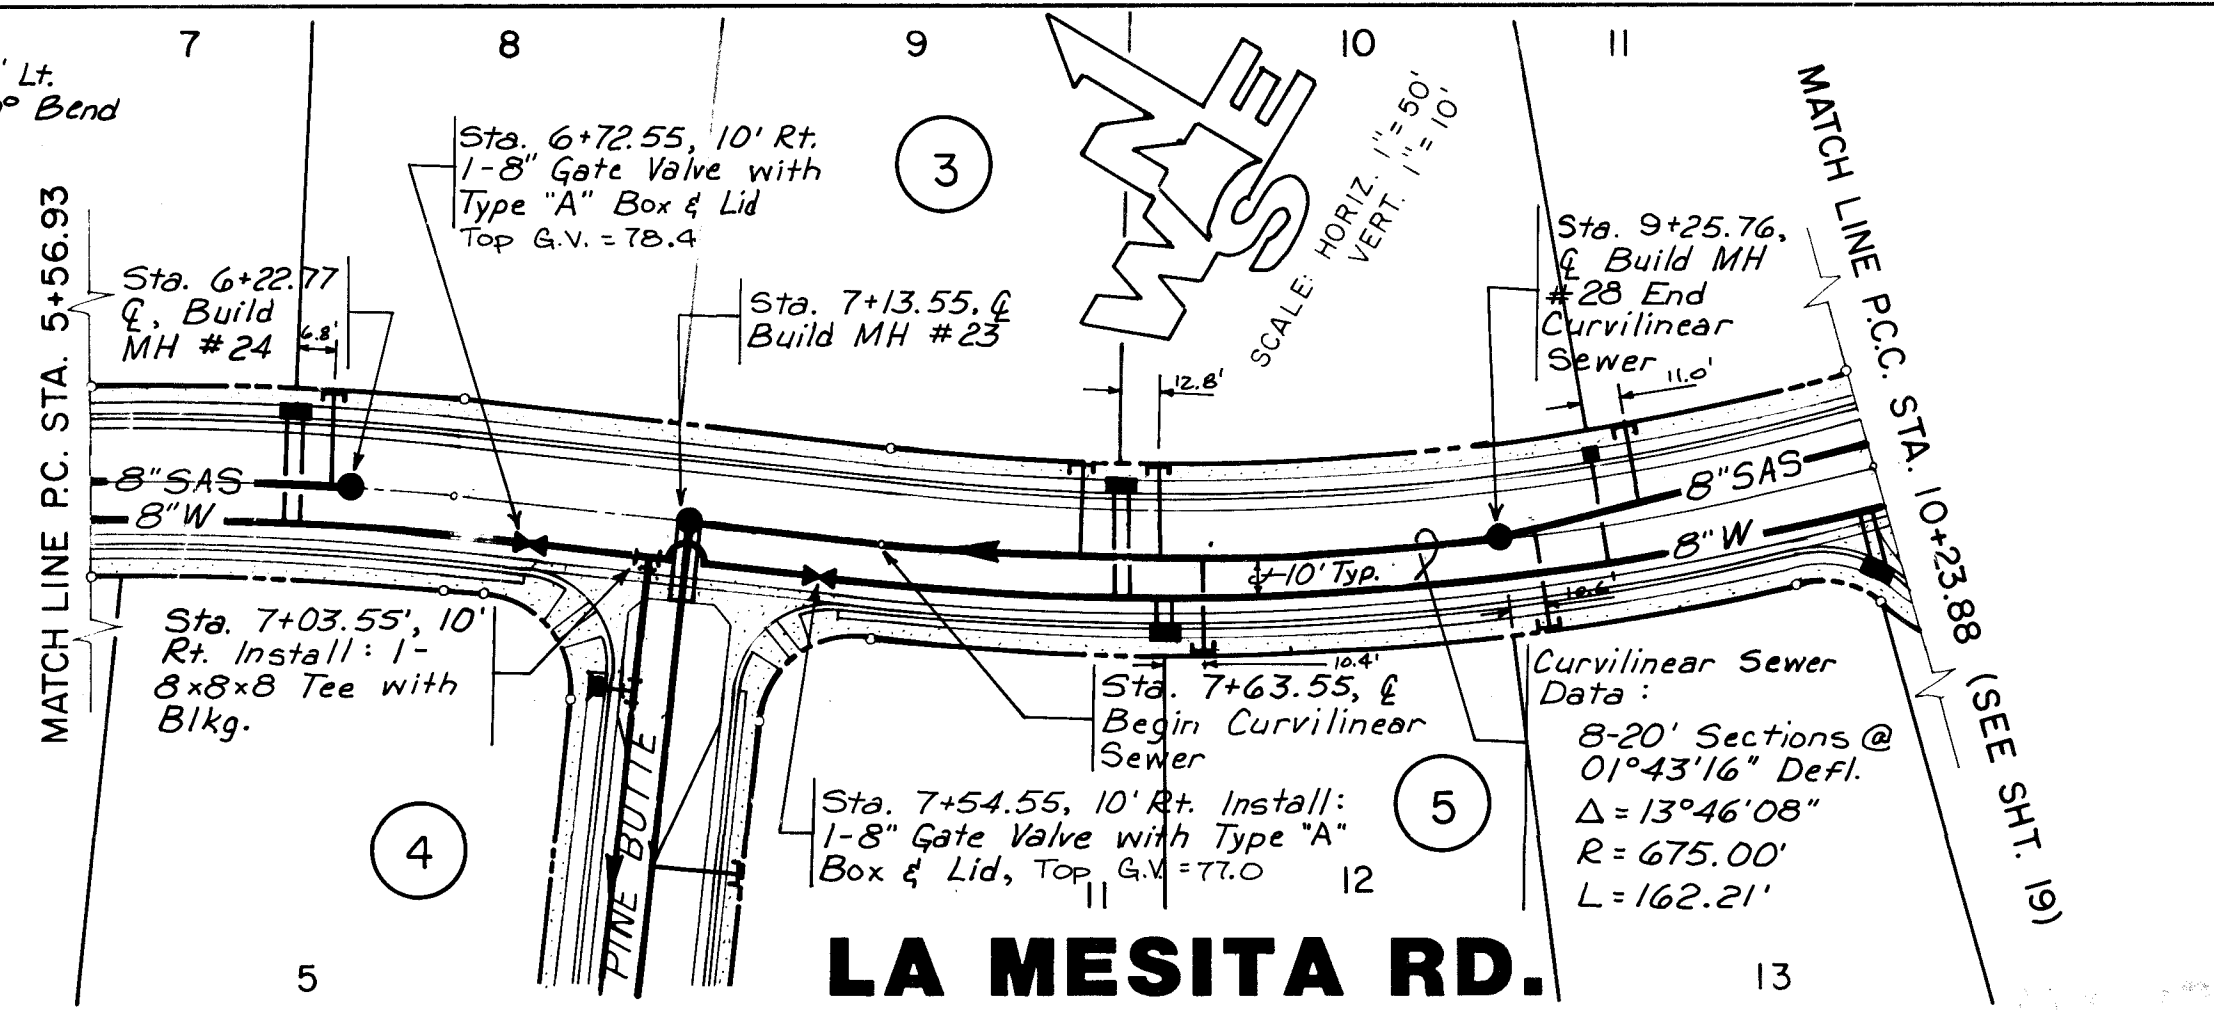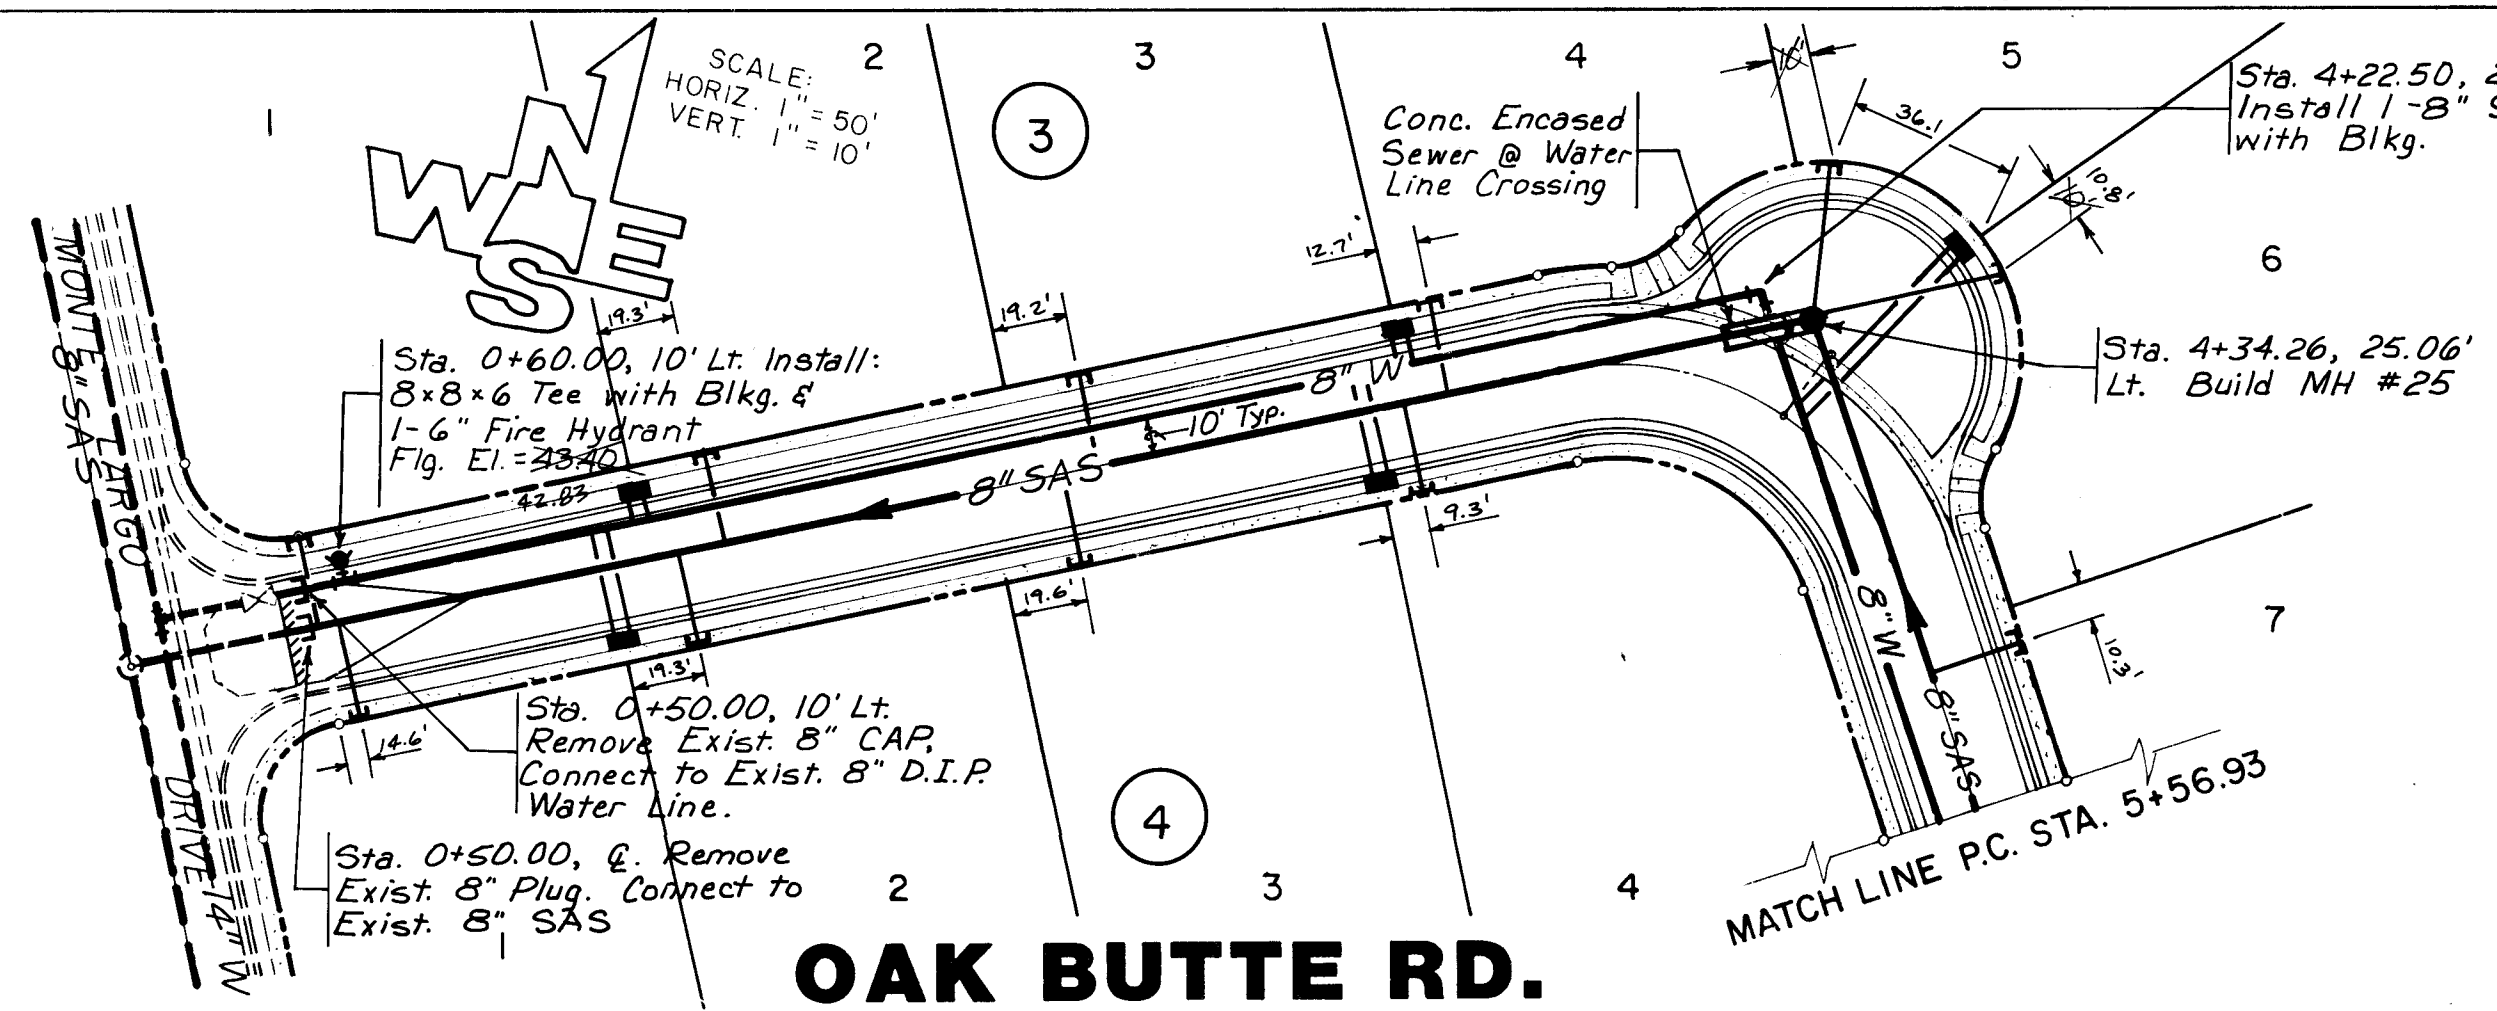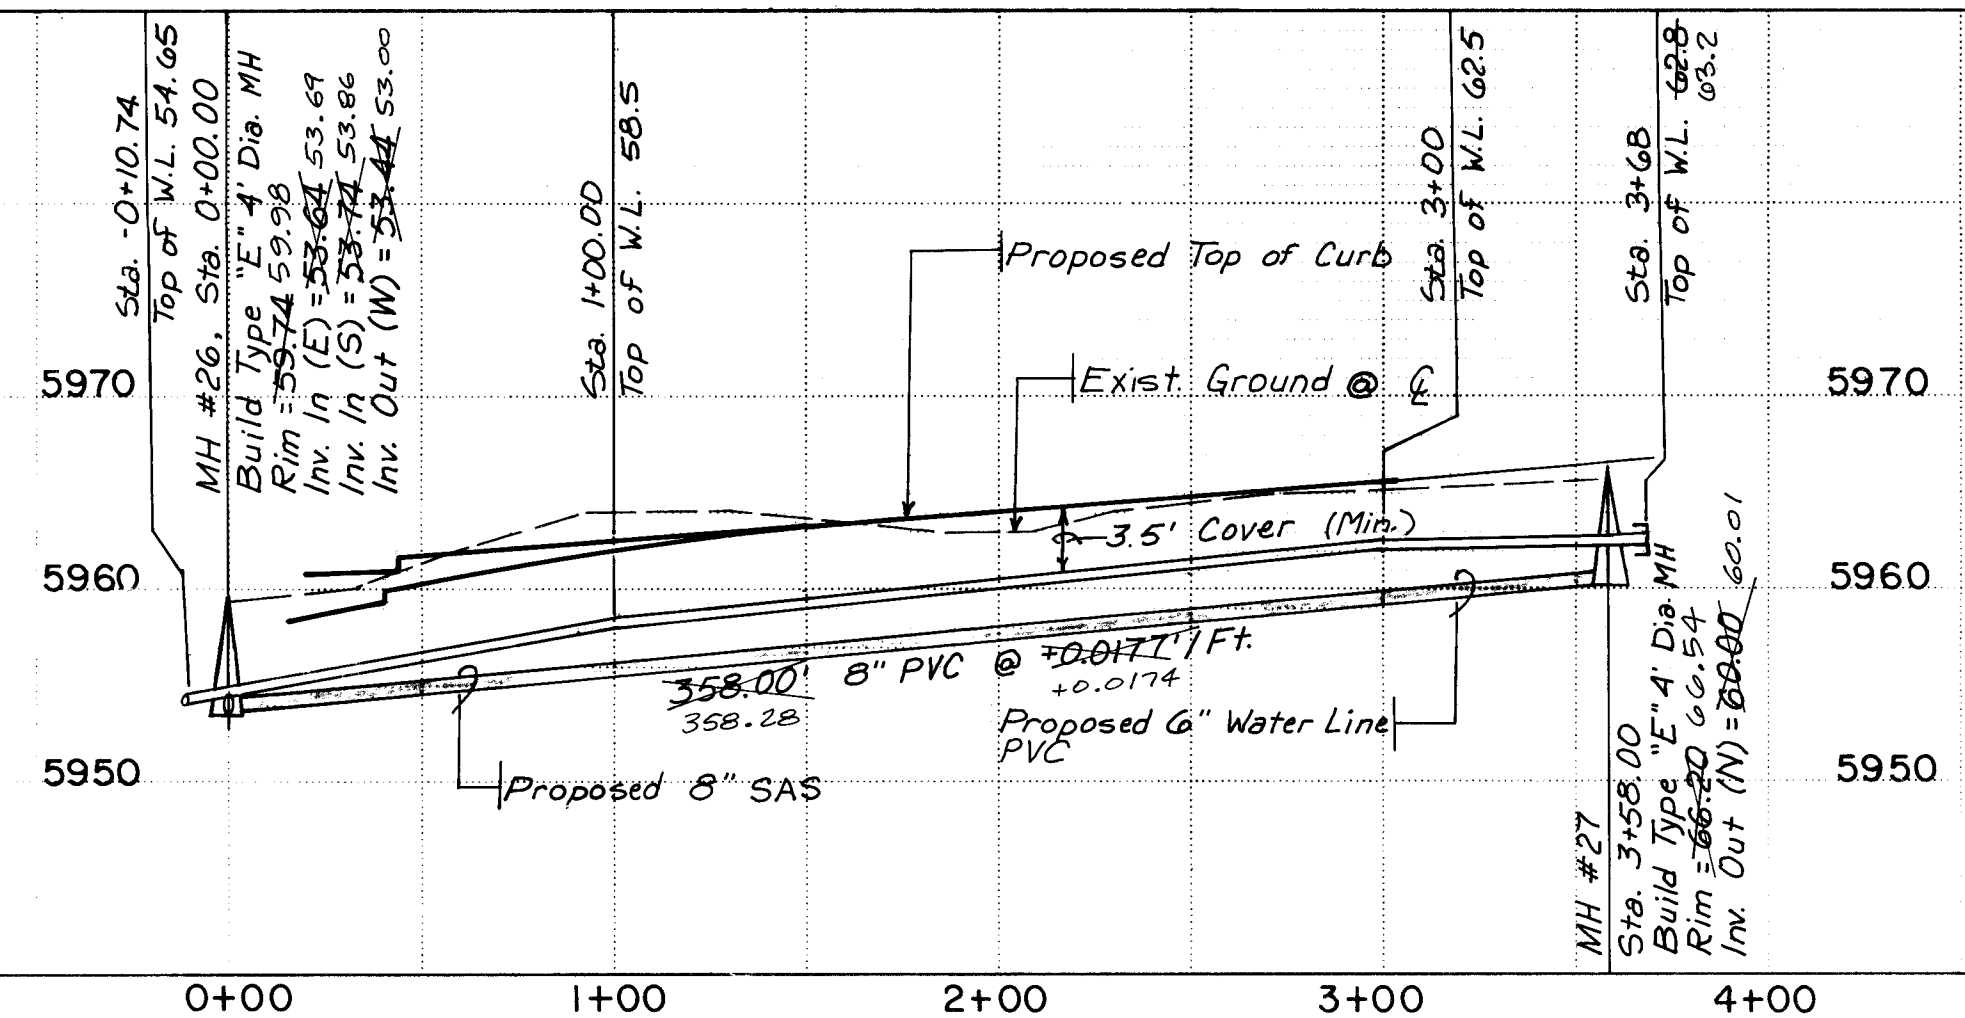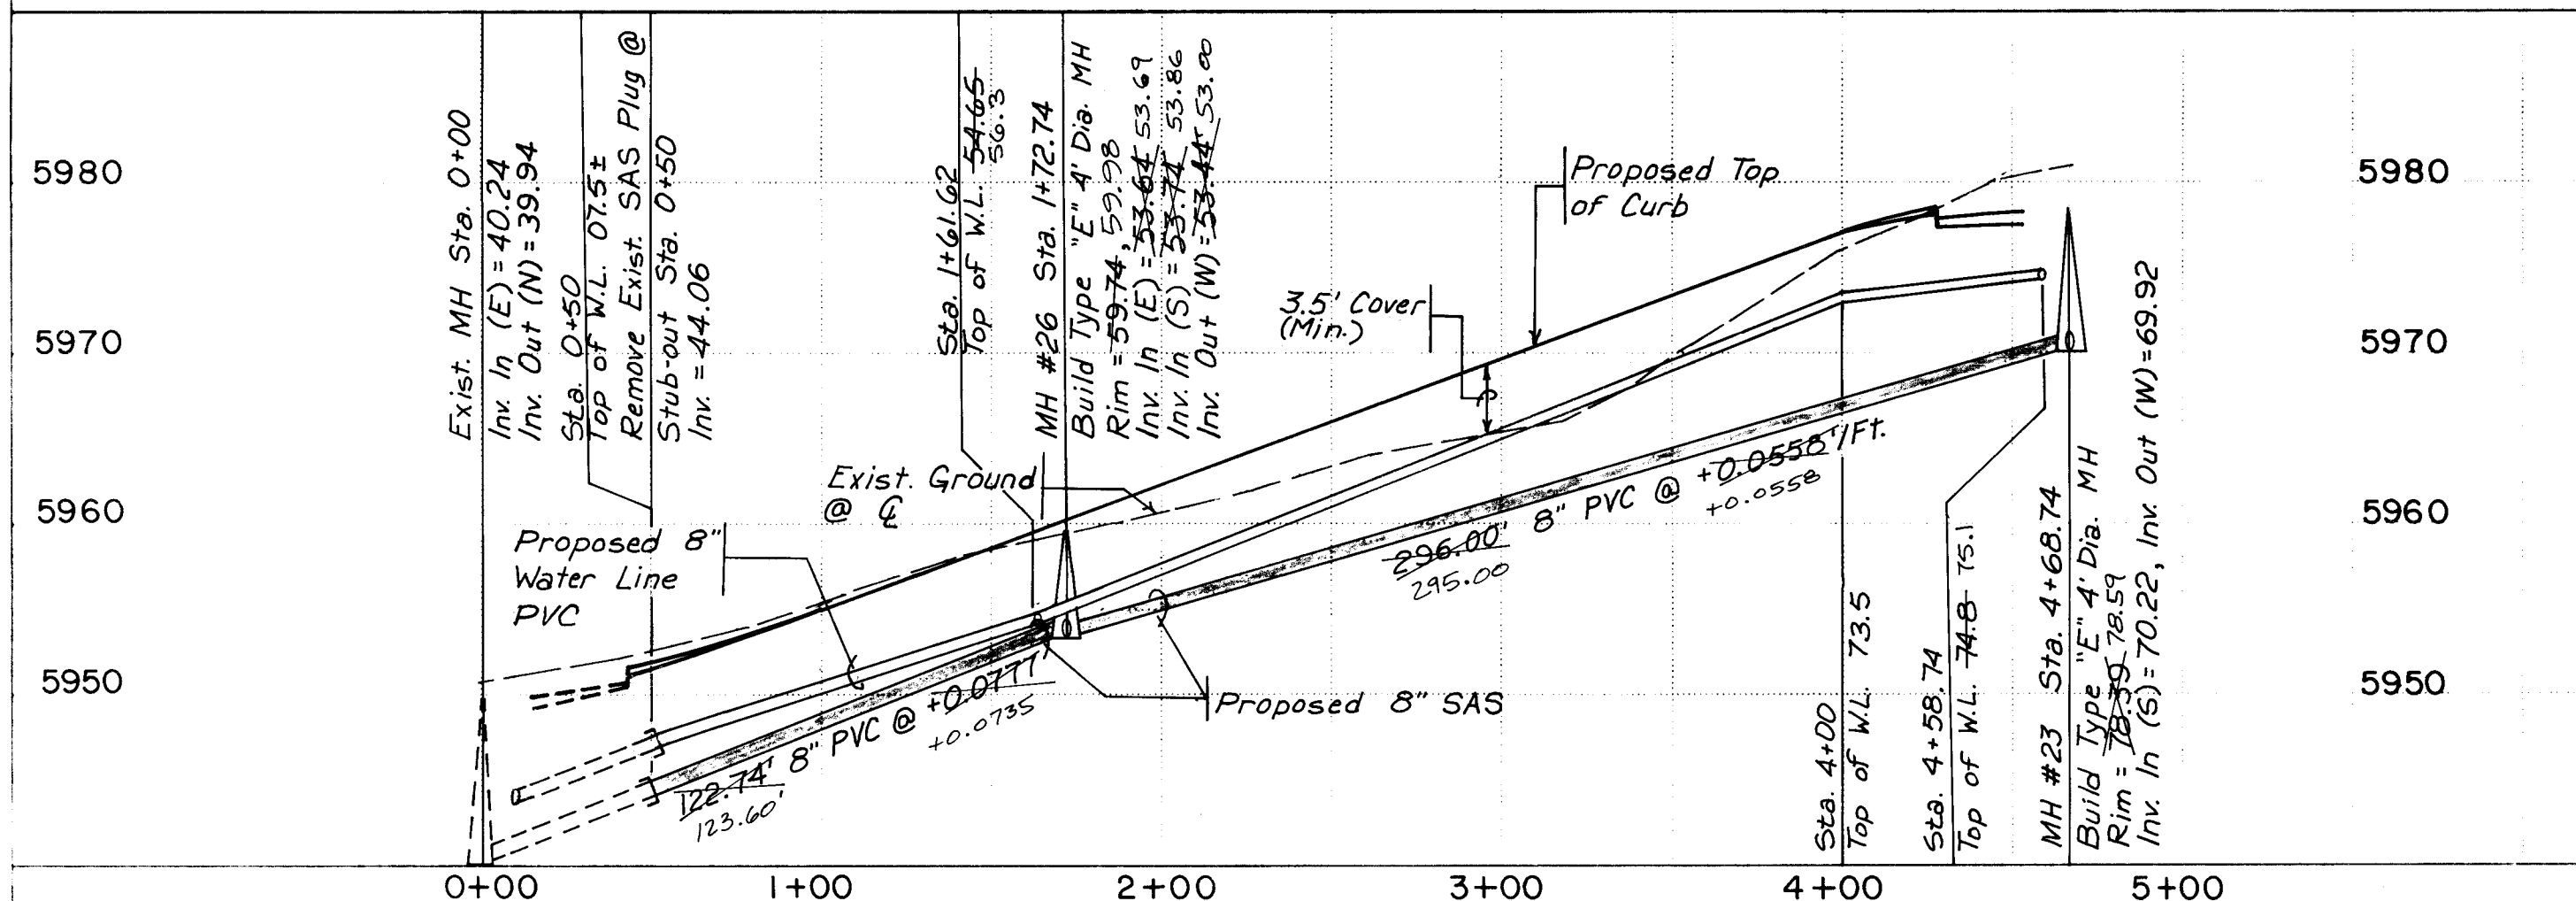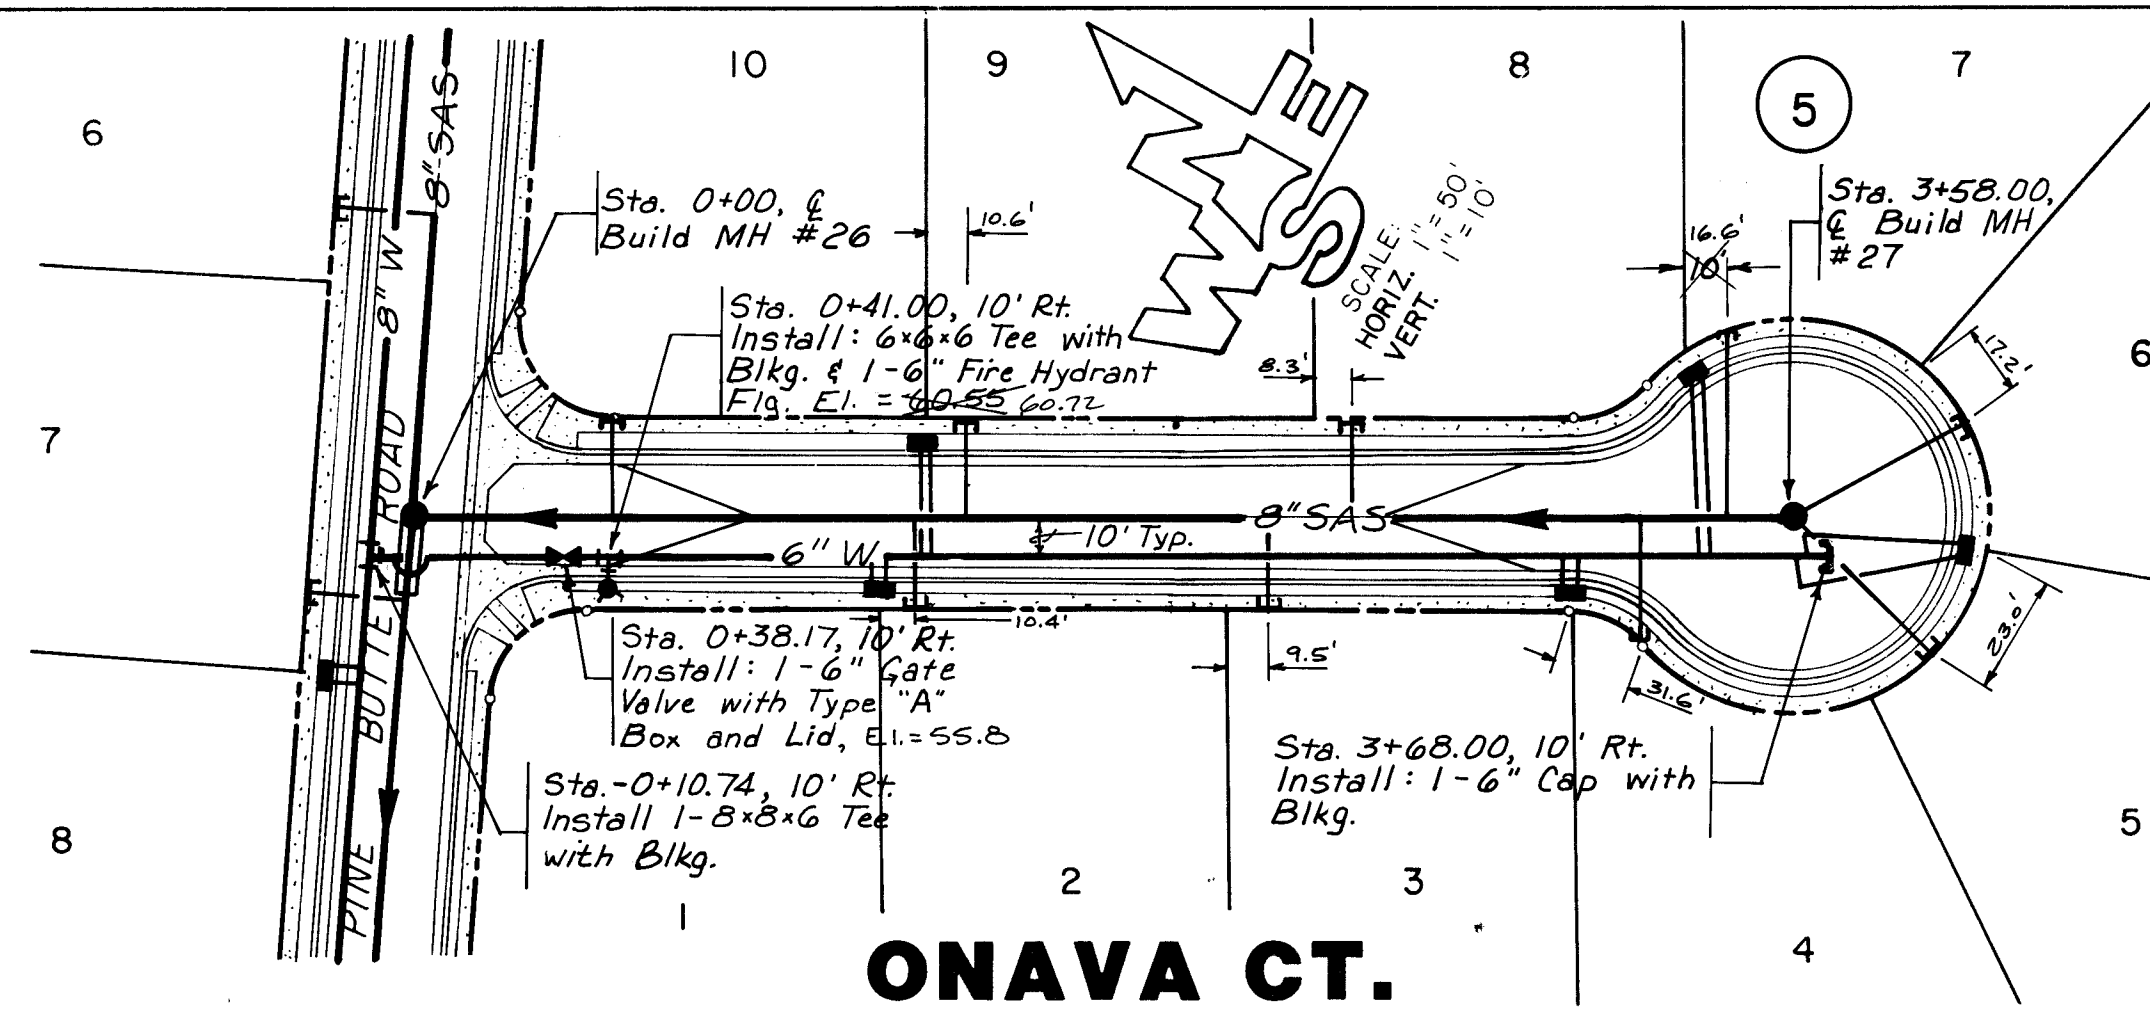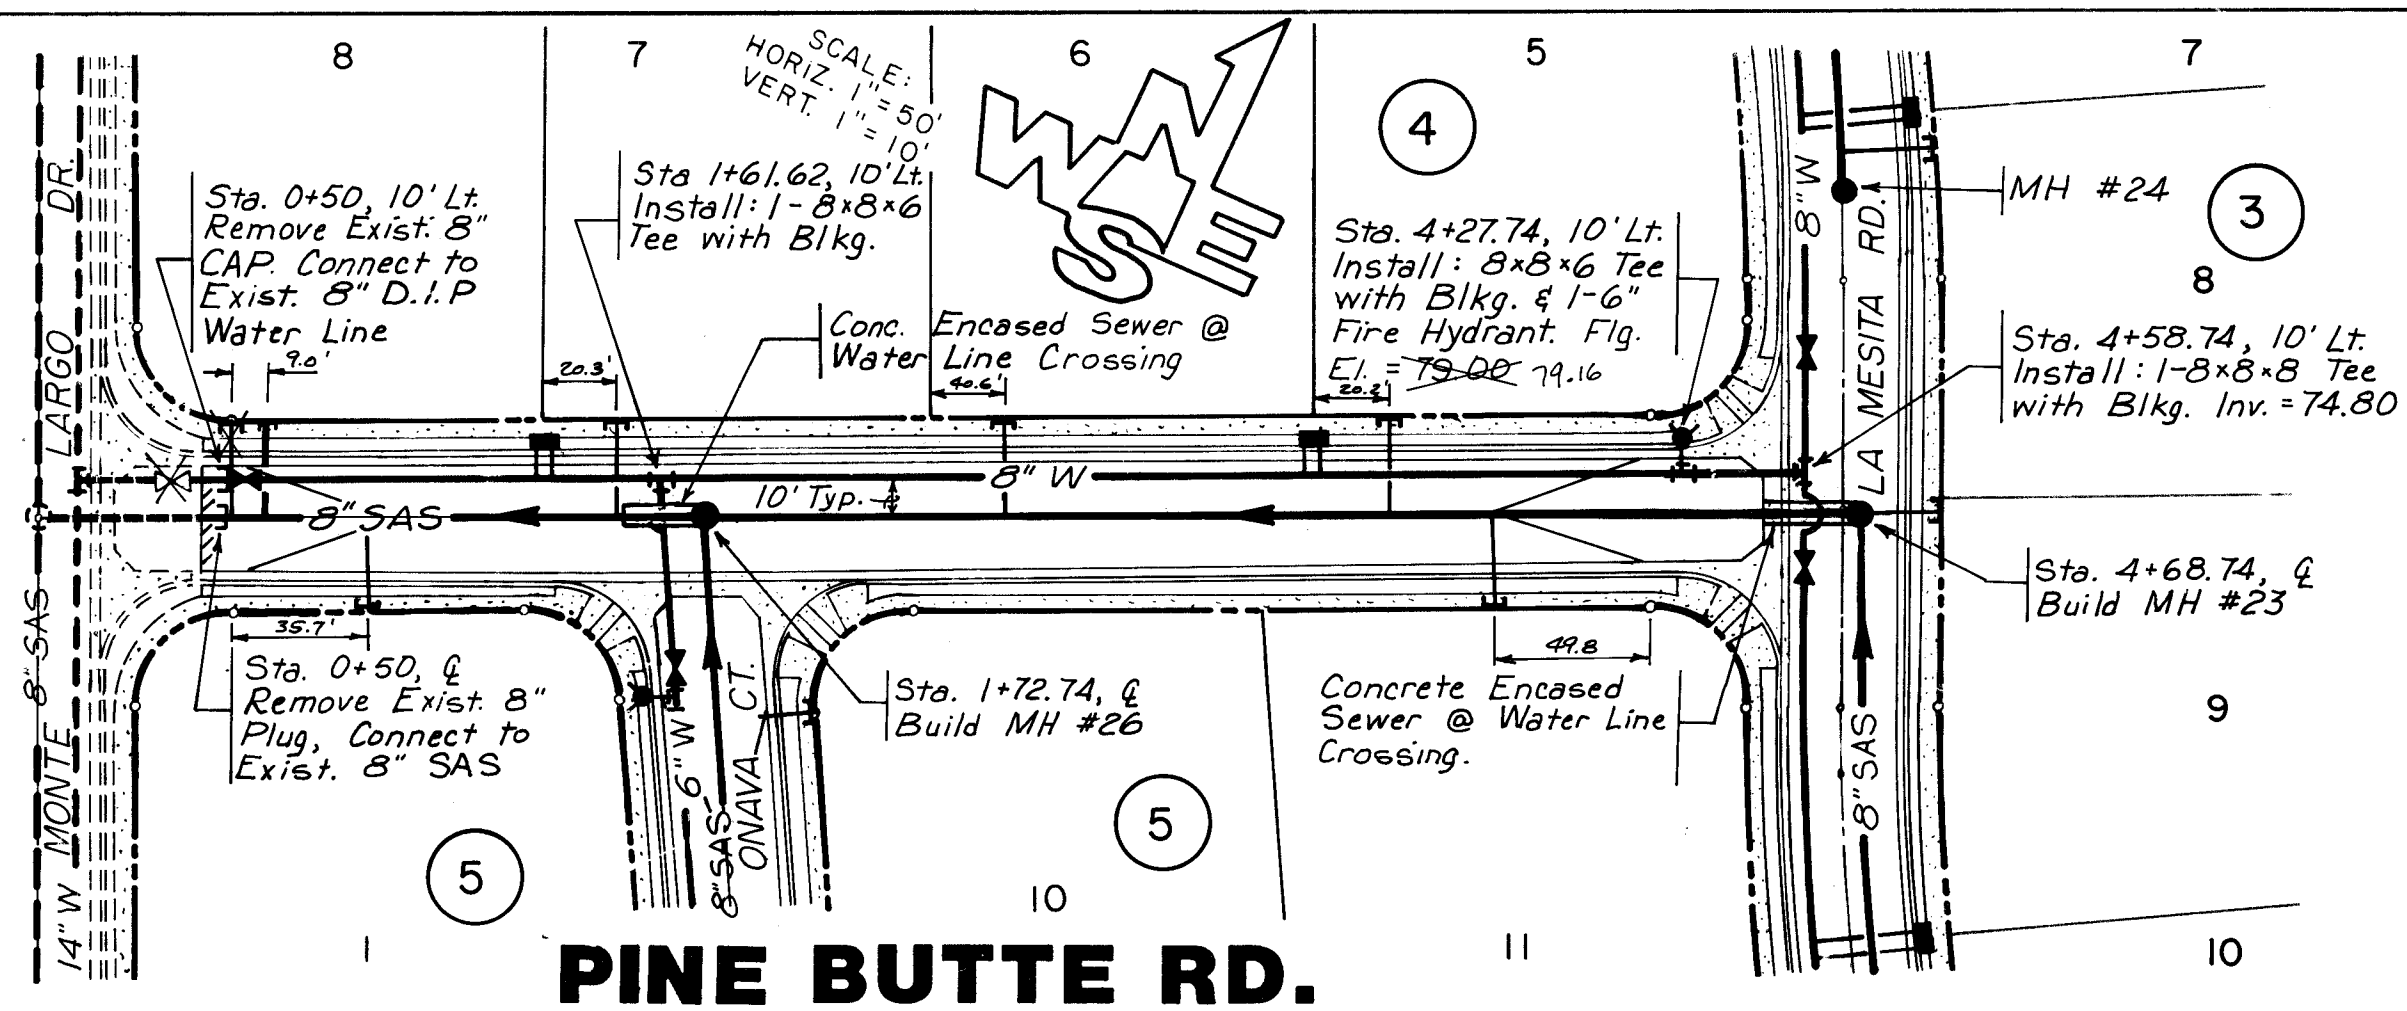

BLK.	LOT	STATION	INVERT @ P.L.	LEN
4	8	0+50.0	45.0 45.6	2
5	1	0+86.0	48.7 48.5	2
4	7	1+50.0	53.2 53.4	2
4	6	2+50.0	59.8 60.0	2
4	5	3+50.0	65.2 65.5	2
5	11	3+79.0	67.0 67.1	2

ONAVA CT. SEWER SERVICES				
BLK.	LOT	STATION	INVERT @ P.L.	LEN
5	10	0+54.0	56.6	2
5	2	1+31.5	57.7	2
5	9	1+43.7	58.3	2
5	3	2+21.5	59.6	2
5	8	2+43.7	60.0	2
5	4	3+18.0	61.0	3
5	7	3+39.0	62.2	4
5	6	3+58.0	61.2	5
5	5	3+58.0	61.2	5

OAK BUTTE RD. SEWER SERVICES				
BLK.	LOT	STATION	INVERT @ P. L.	LEN
3	1	0+50.0	36.7 36.7	2
4	1	0+55.0	37.1 37.0	2
4	2	1+47.0	33.2 33.1	2
4	2	1+57.0	33.7 33.6	2
4	3	2+47.0	47.9 47.7	2
4	3	2+57.0	50.2 50.1	2
4	4	3+37.0	56.7 56.6	2
4	4	3+50.0	56.3 56.2	2
3	5	4+34.26	62.1 62.0	4
3	6	4+34.26	63.1 62.2	5

LA MESITA RD. SEWER SERVICES				
BLK.	LOT	STATION	INVERT @ P.L.	LEN
3	7	5+20.5	671.67.3	2
3	8	6+15.7	711.71.2	2
3	9	8+05.0	73.7	2
3	10	8+25.2	73.9	2
5	12	8+48.1	74.3	2
5	13	9+35.4	76.1	2
3	11	9+62.4	78.8 77.1	2

[illegible]

CP	TH	BENCH MARKS
		Top of header curb at southwest corner of Sandia Manor pump station. Elev. = 6011.6

SURVEY INFORMATION			FIELD NOTES	
NO	BY	DATE		
1620	T. Aldrich	8/8/88		
1627	T. Aldrich	10/8/88		
1628	G. Smith	10/8/88		
1634	J. Preeks	12/8/88		
1635	G. Smith	1/94		
1636	G. Smith	1/84		

ENGINEER'S SEAL

Madhavi









NO	DATE	REMARKS	DESIGN			
			DESIGNED BY	RM & LJ	DATE	4-84
BY	DATE	REMARKS	DESIGN			
			DRAWN BY	BC & JW	DATE	4-84

CITY OF ALBUQUERQUE	MUNICIPAL DEVELOPMENT DEPARTMENT	ENGINEERING DIVISION
----------------------------	---	-----------------------------

TITLE: **VISTA DEL MUNDO**
PINE BUTTE RD., ONAVA CT., OAK BUTTE RD. & LA MESITA RD.
STREET UTILITY PLAN & PROFILE

APPROVALS	ENGINEER	DATE	APPROVALS	ENGINEER	DATE
City Engineer	C. S. Duran	9/15/82	Liquid Waste	R. Pina	7/18/82
ACE - Design	H. C. Cua	9/10/82	Traffic	N. B. W. H.	7/18/82
ACE - Hydrology	N. B. A.	7/18/82	Water	R. Pina	7/18/82

DRAWING NO.	2133	MAP NO.	J-23	SHEET	17	OF	20
-------------	------	---------	------	-------	----	----	----

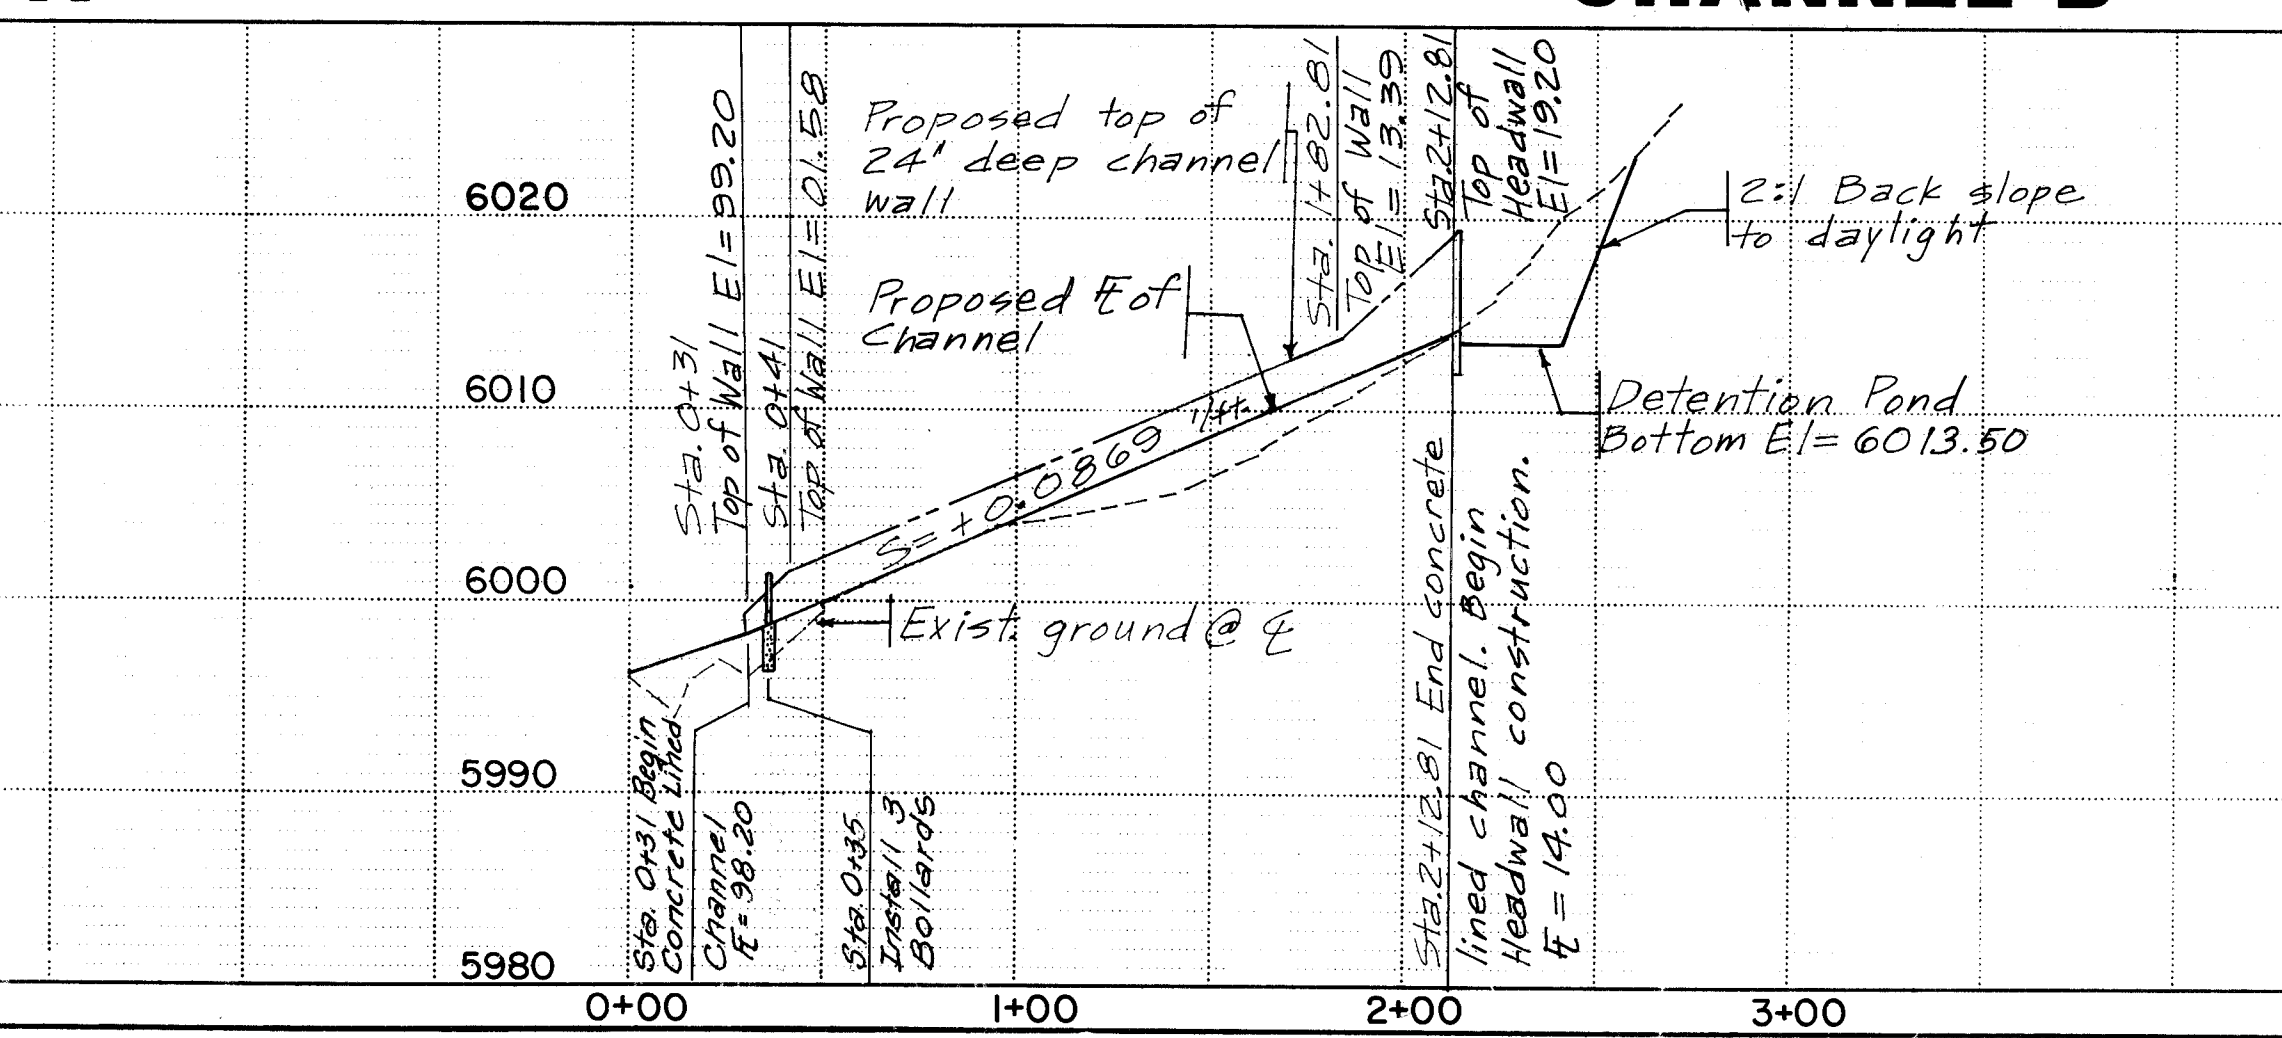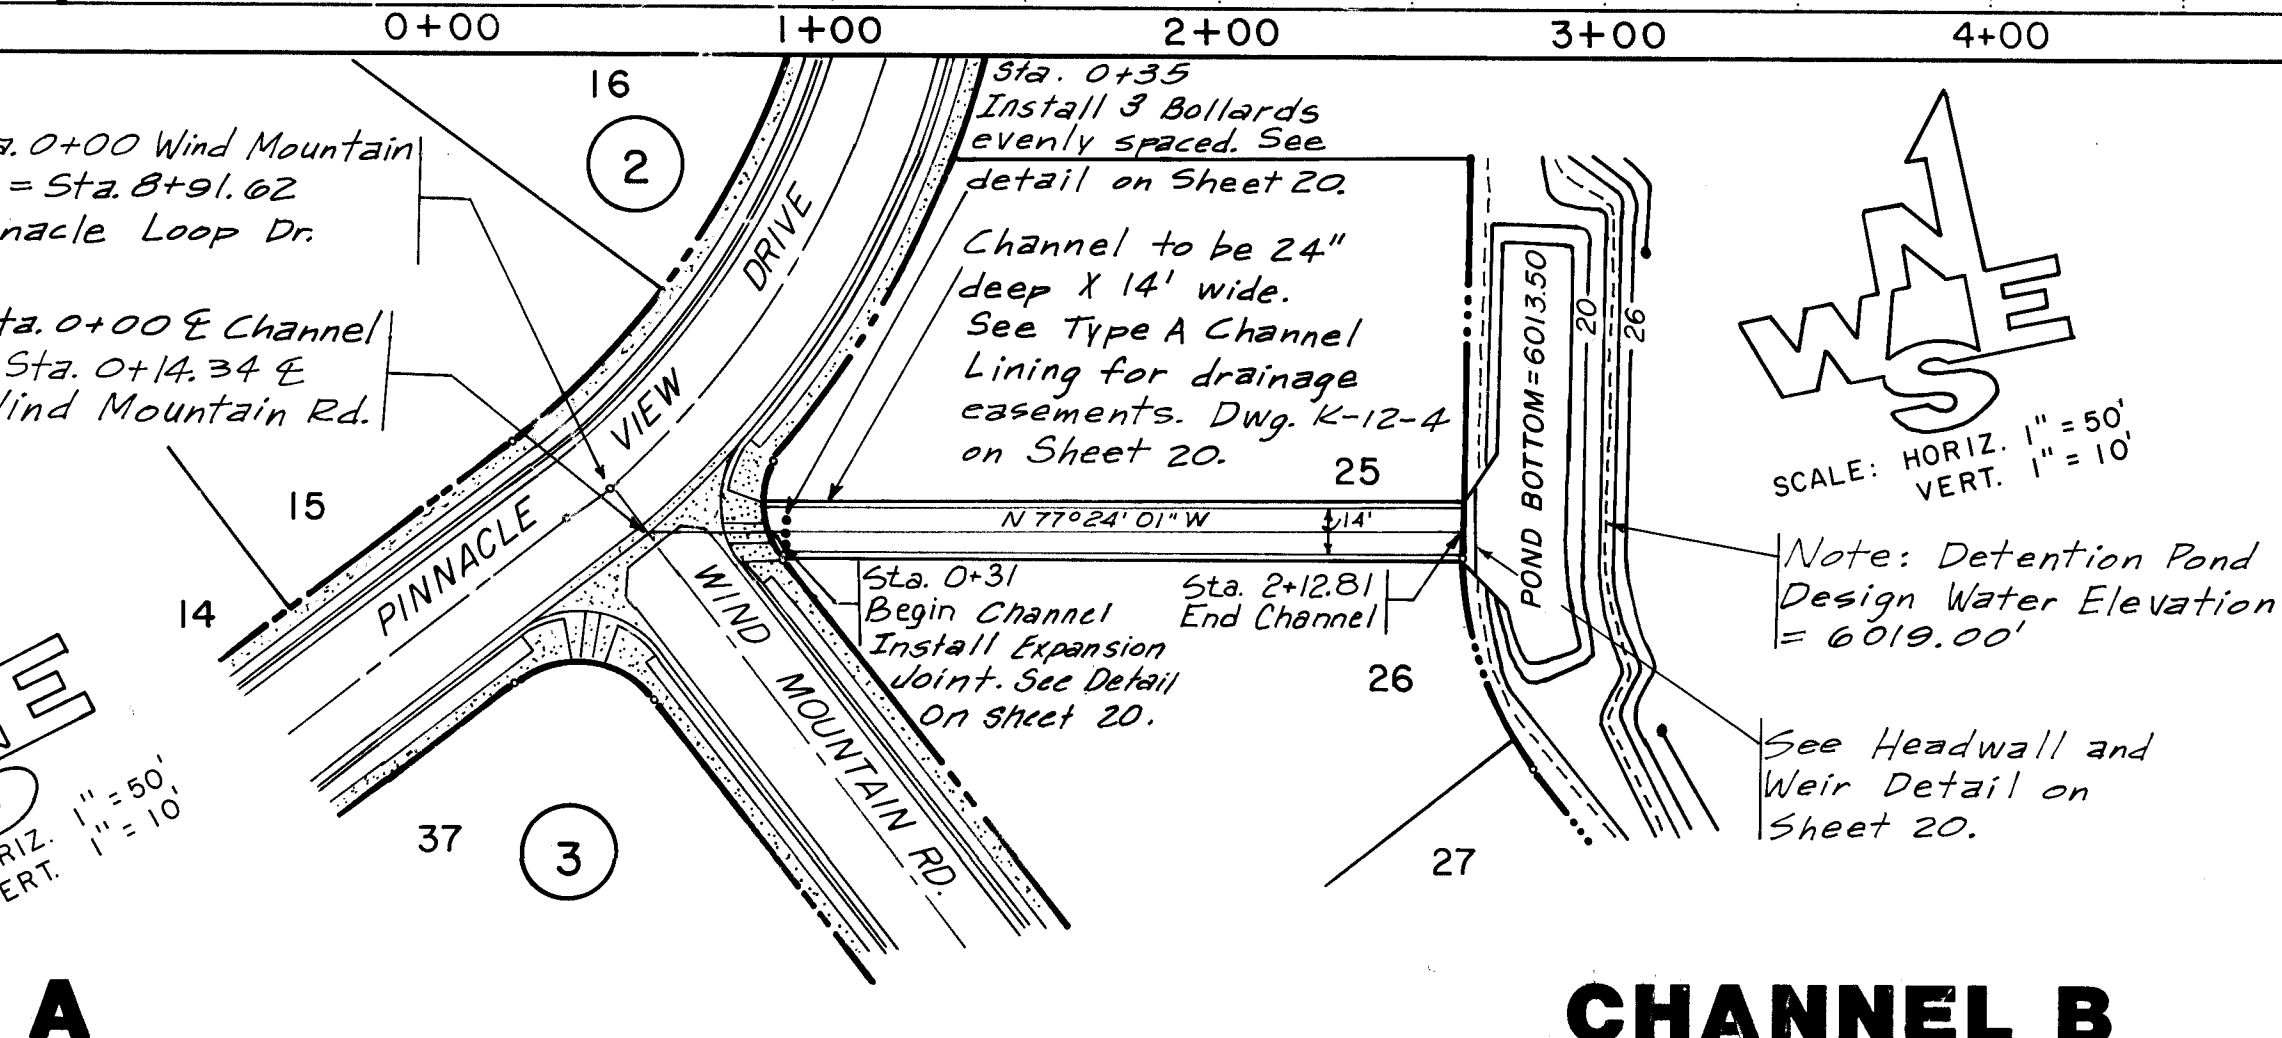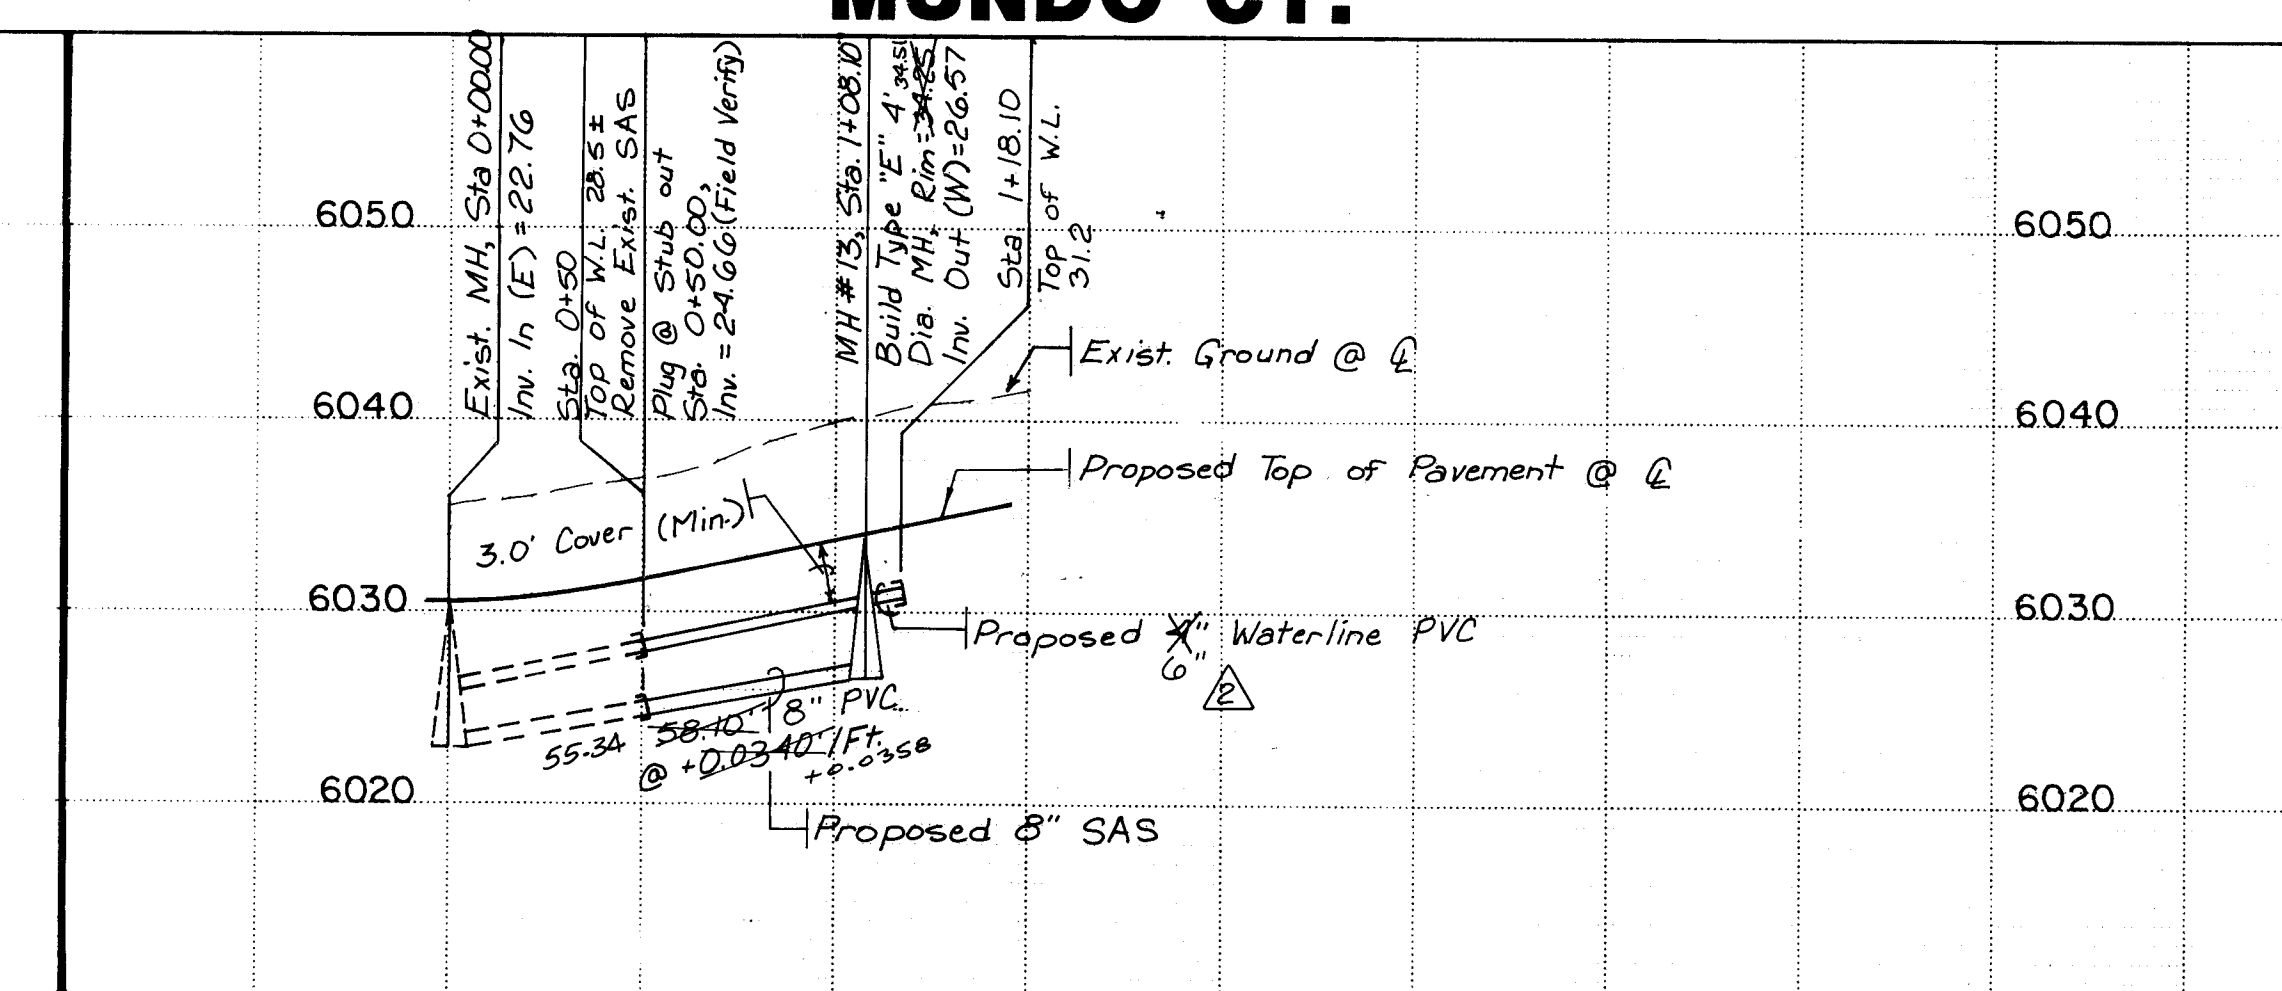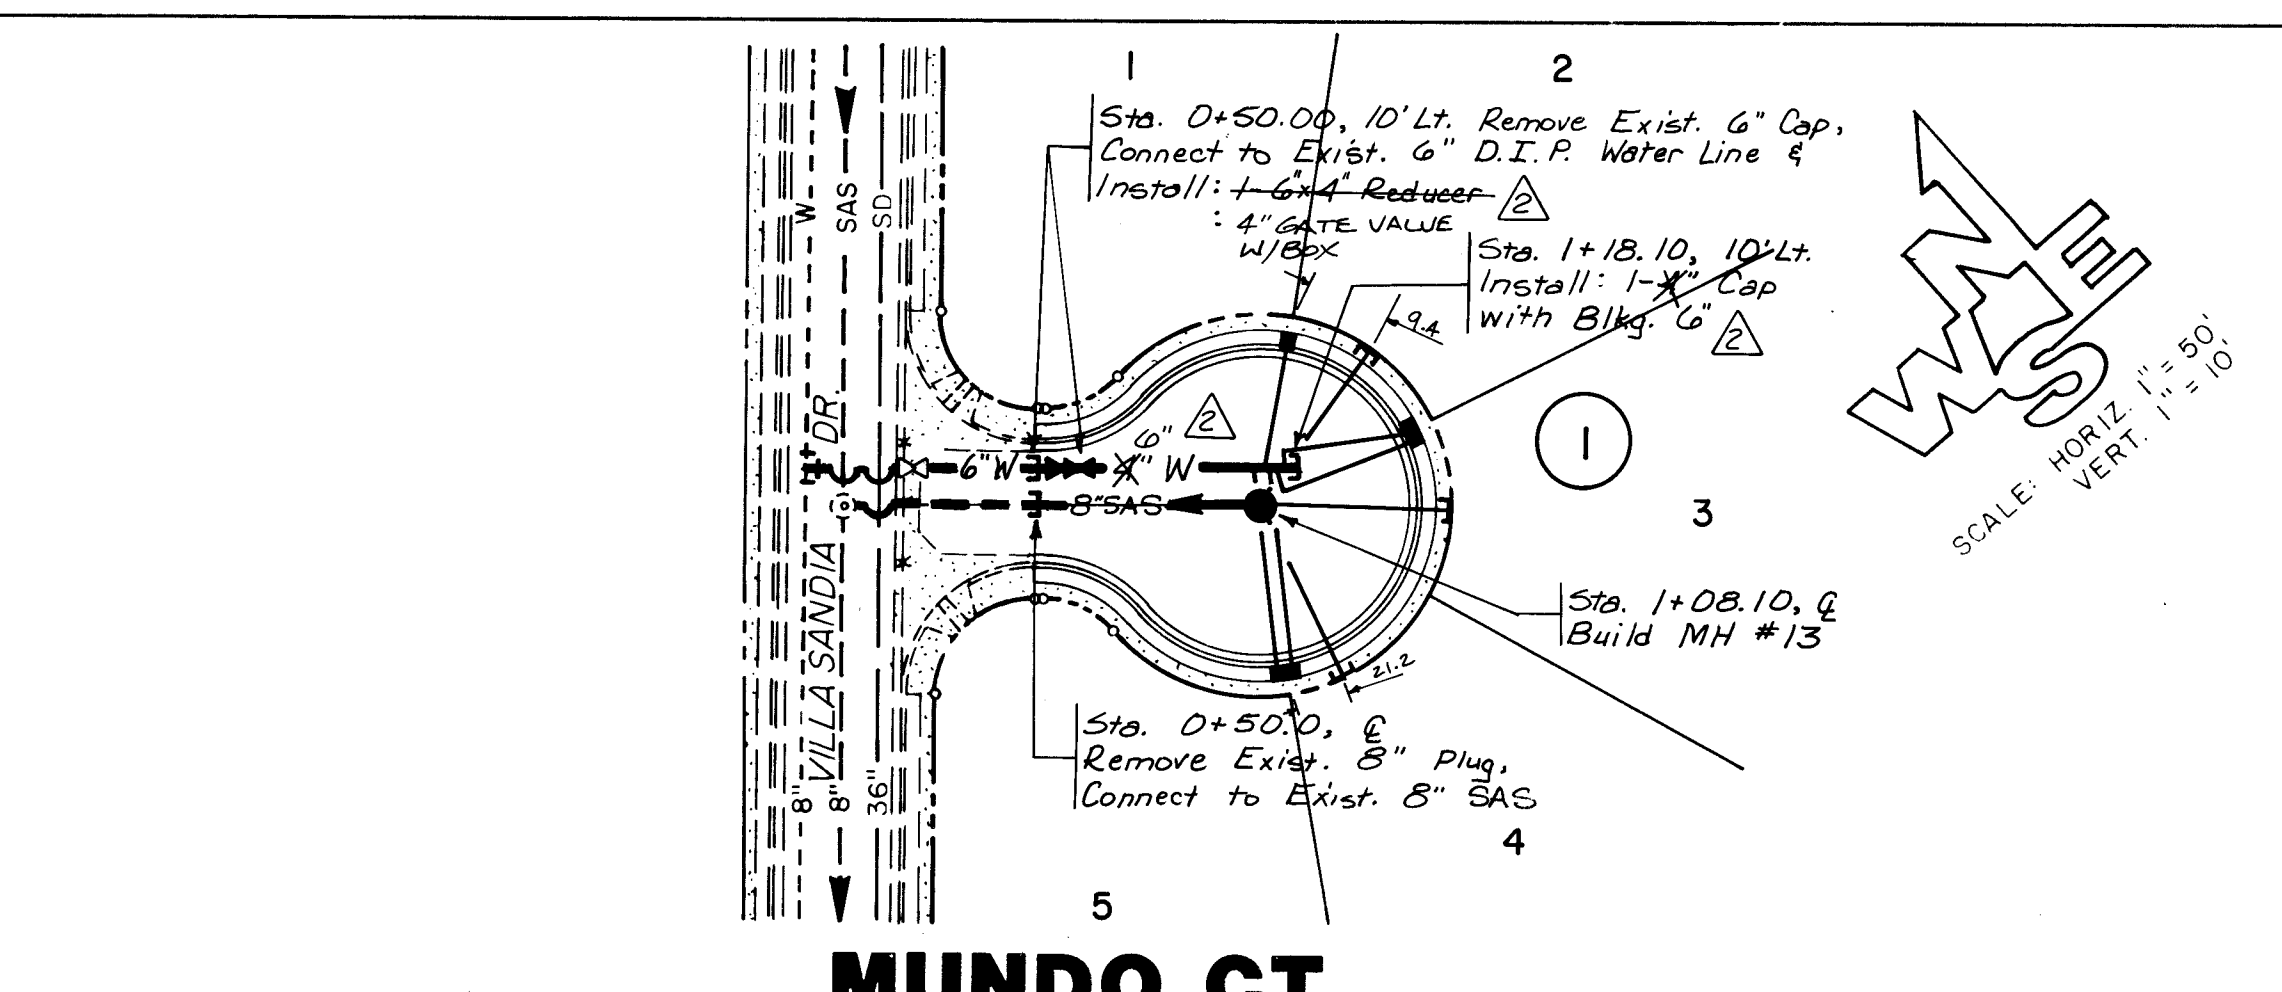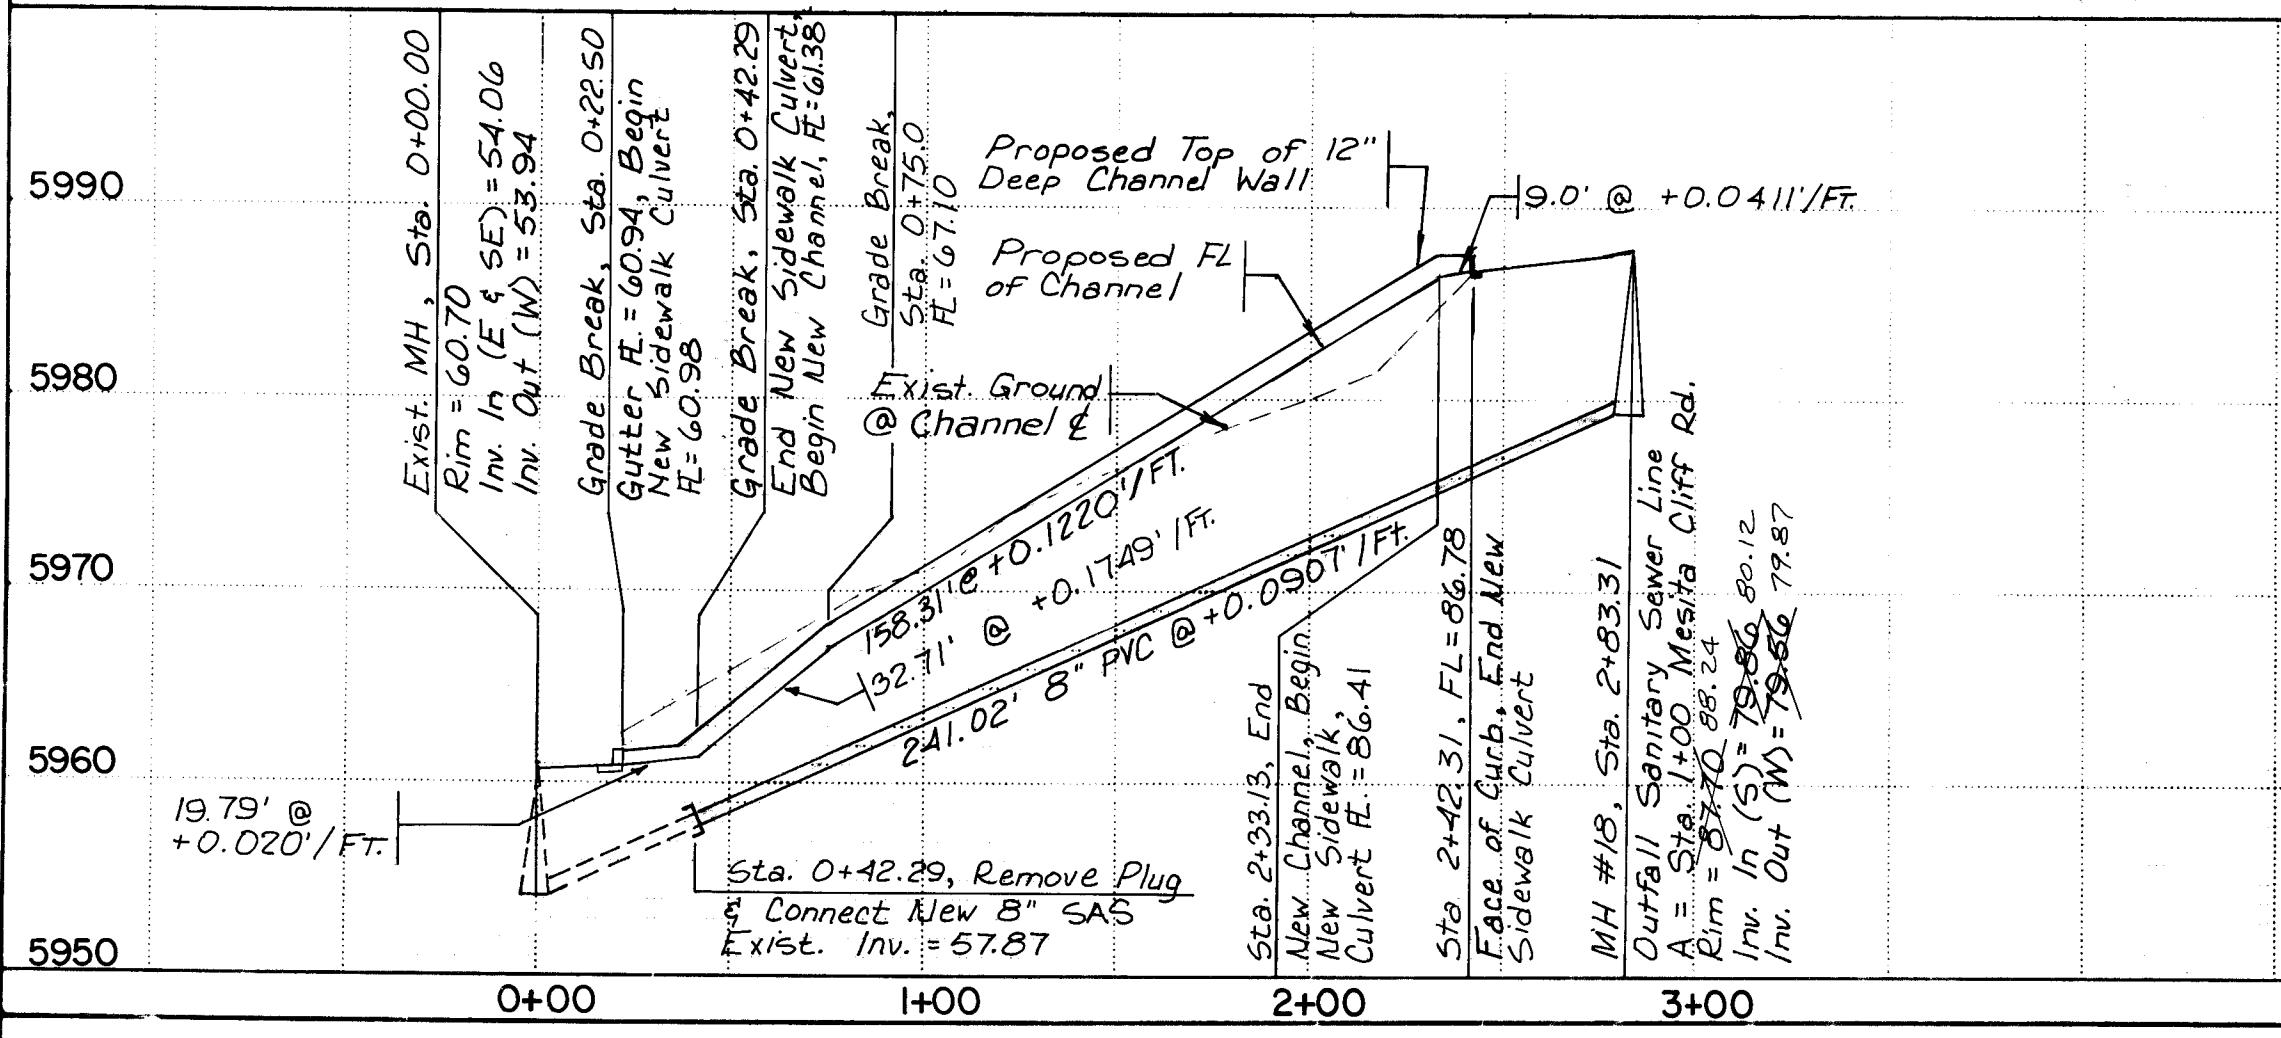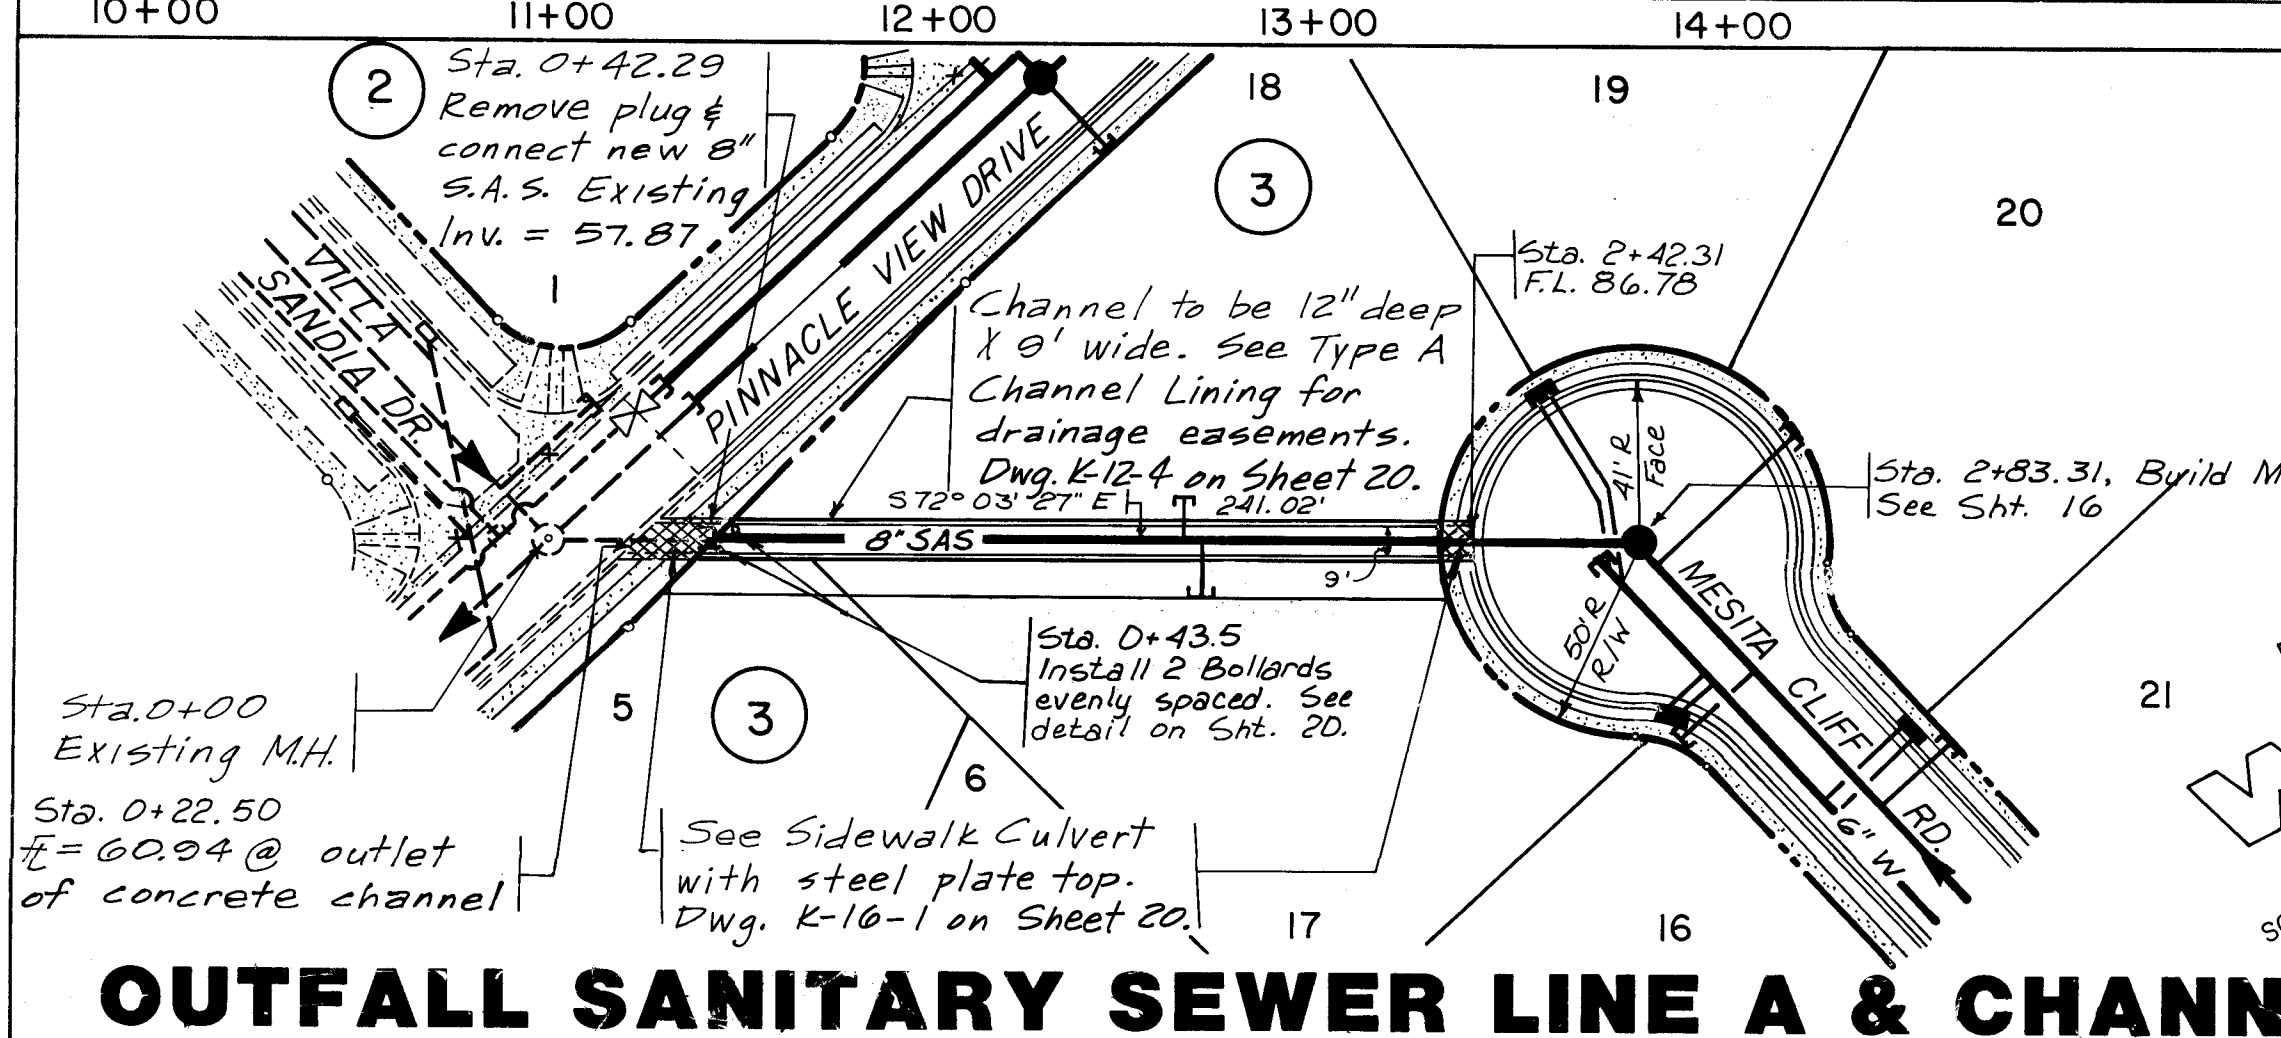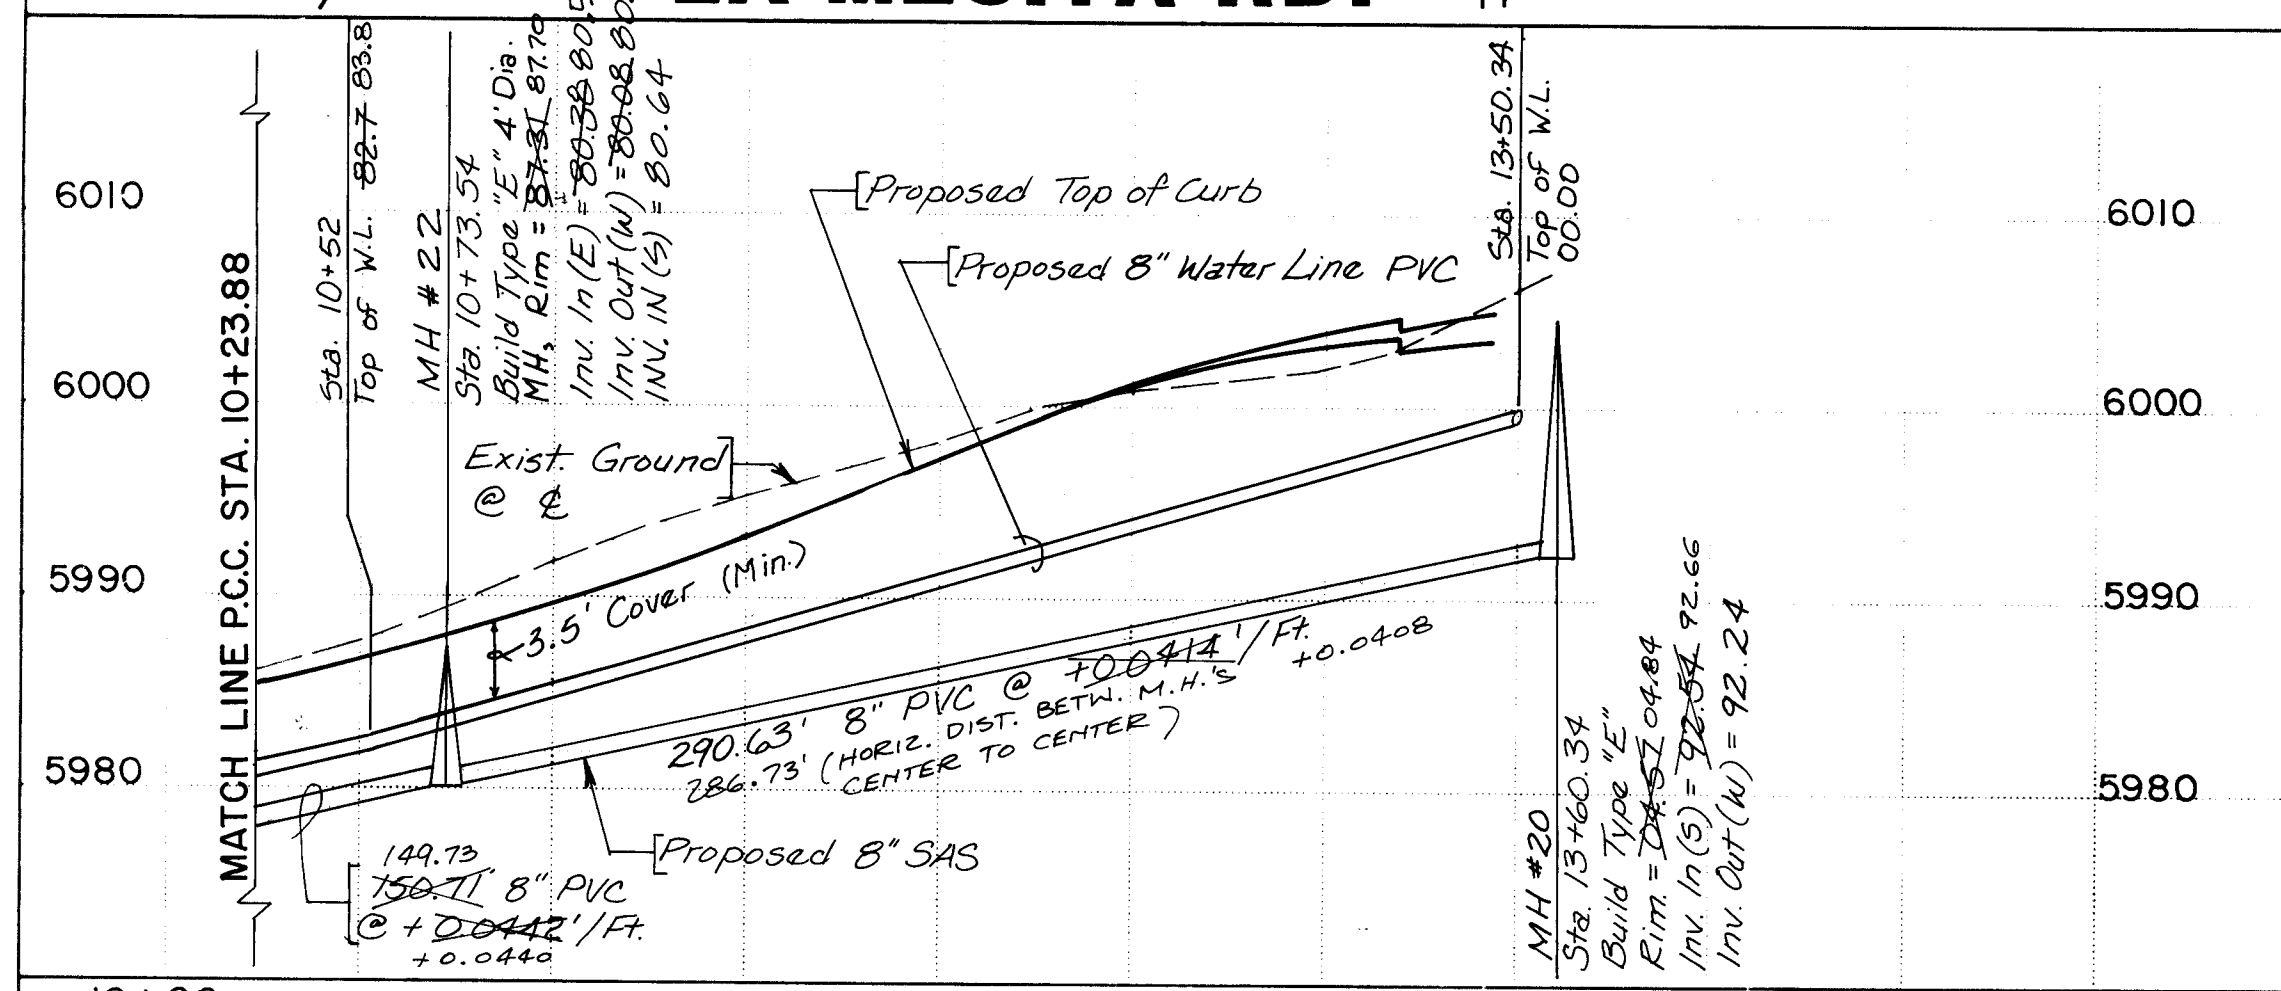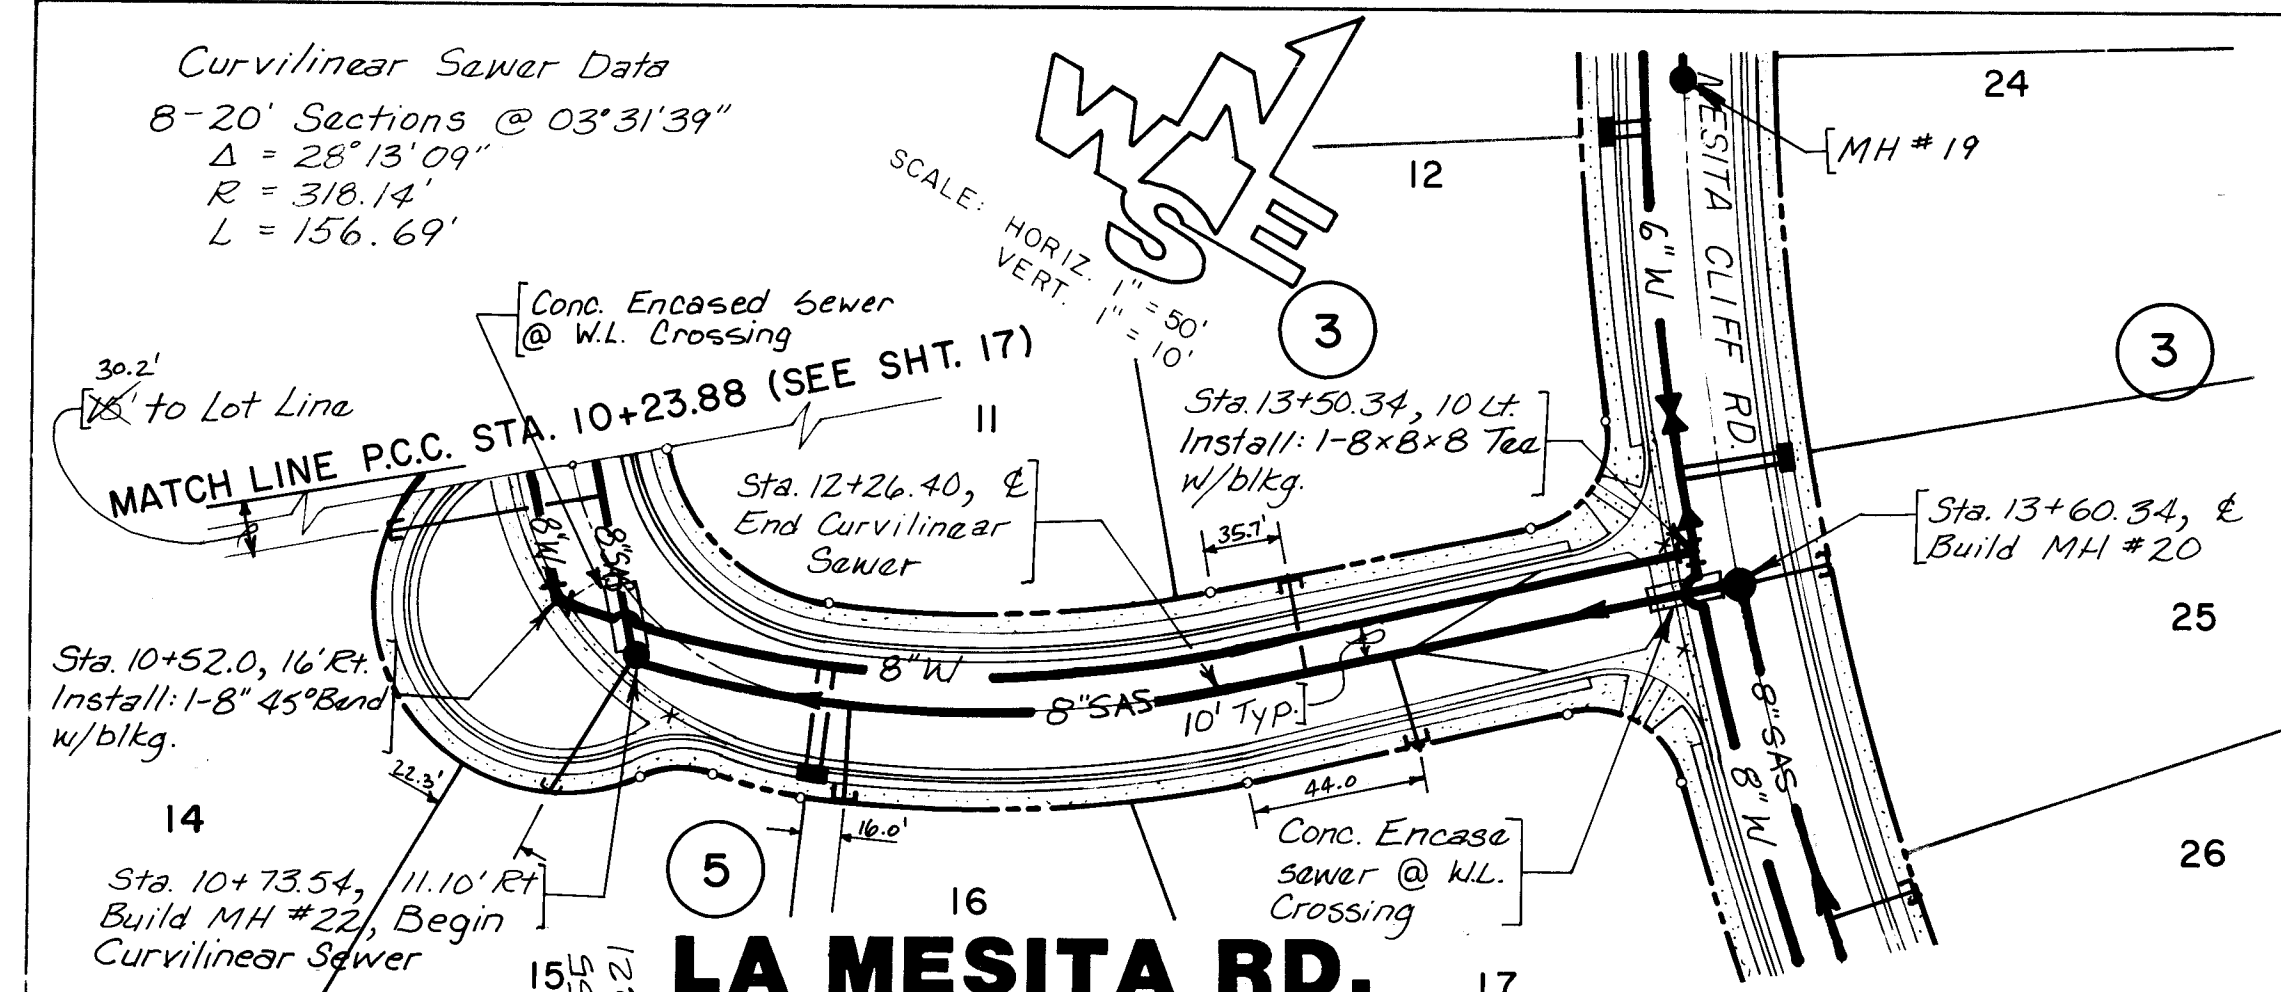

LA MESITA RD. SEWER SERVICES

BLK.	LOT	STATION	INVERT @ P.L.	LENGTH
5	14	10+32.3	80.8-80.8	55'
5	15	10+73.54	81.9-81.9	41'
5	16	11+27.4	84.7	25'
3	12	12+62.0	94.5-90.2	25'
5	17	12+72.0	90.6	25'

MUNDO CT. SEWER SERVICES

BLK.	LOT	STATION	INVERT @ P.L.	LENGTH
1	2	1+08.1	29.5-27.7	50'
1	3	1+08.1	29.1-27.7	50'
1	4	1+08.1	28.2-27.7	50'

OUTFALL LINE A SEWER SERVICES

BLK.	LOT	STATION	INVERT @ P.L.	LENGTH
3	18	1+65.0	70.5	10'
3	17	1+70.0	71.0	15'

AS BUILT INFORMATION

CONTRACTOR: *GREENE* DATE: *7/85*

STANDARD: *GREENE* DATE: *7/85*

FIELD: *GREENE* DATE: *7/85*

CORRECTED BY: *GREENE* DATE: *7/85*

RECORDED BY: *GREENE* DATE: *7/85*

BENCH MARKS

Top of header curb at southwest corner of Sandia Manor pump station. Elev. = 6011.62

SURVEY INFORMATION

NO. BY DATE

1620 T. Aldrich 8/83

1627 T. Aldrich 10/83

1628 G. Smith 10/83

1634 J. Freck 12/83

1636 G. Smith 1/84

1636 G. Smith 1/84

ENGINEER'S SEAL

W. J. Smith

DESIGNED BY: *RM & LJ* DATE: 4-84

DRAWN BY: *BC & JW* DATE: 4-84

CHECKED BY: *ME* DATE: 4-84

REVISIONS

NO.	DATE	REMARKS
1	11-85	As-Built Per Ernest Vallegos-City CESI
2	10-85	As-Built Water And Sewer

DESIGN

DESIGNED BY: *RM & LJ* DATE: 4-84

DRAWN BY: *BC & JW* DATE: 4-84

CHECKED BY: *ME* DATE: 4-84

CITY OF ALBUQUERQUE

MUNICIPAL DEVELOPMENT DEPARTMENT

ENGINEERING DIVISION

TITLE:

LA MESITA RD. & MUNDO CT.

STREET UTILITY PLAN & PROFILE

APPROVALS

CITY Engineer: *W. J. Smith* DATE: *7/18/84*

A.C.E. - Design: *W. J. Smith* DATE: *7/18/84*

A.C.E. - Hydrology: *W. J. Smith* DATE: *7/18/84*

APPROVALS

ENGINEER: *W. J. Smith* DATE: *7/18/84*


Liquid Waste: *W. J. Smith* DATE: *7/18/84*

Water: *W. J. Smith* DATE: *7/18/84*

DRAWING NO. **2133**


MAP NO. **J-23**

SHEET **19** OF **20**

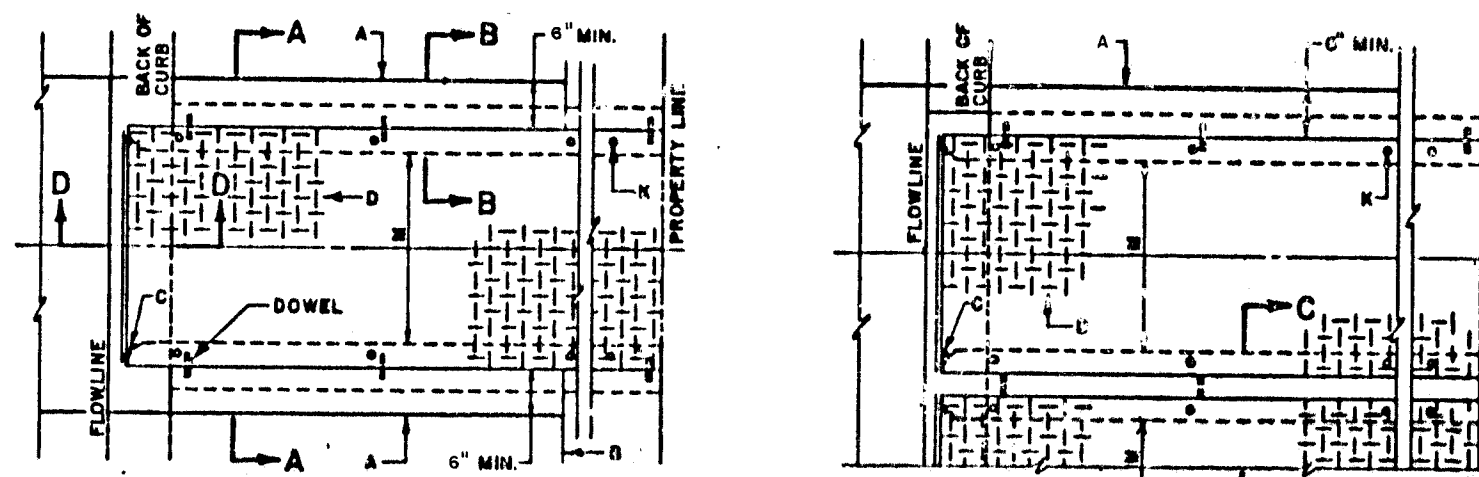

PLAN
SINGLE CULVERT


PLAN
MULTIPLE CULVERT

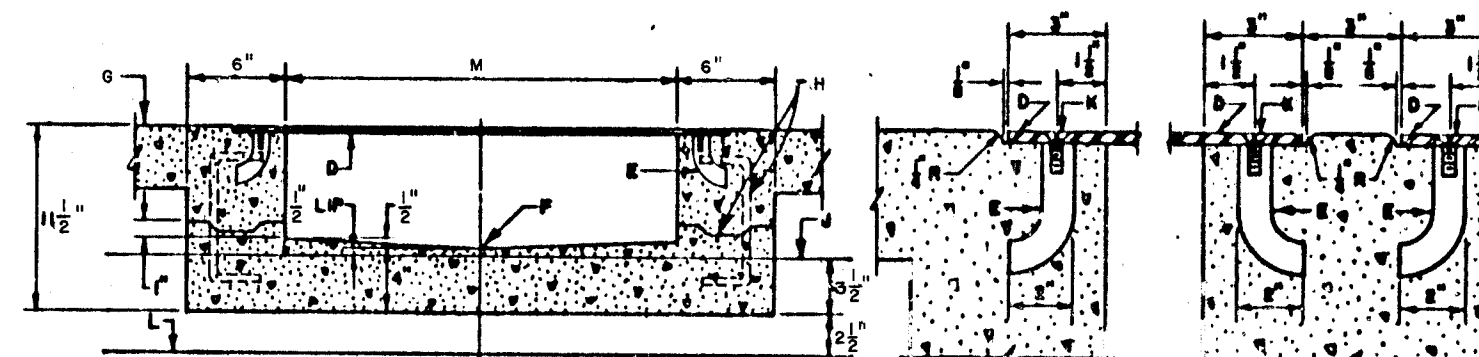

SECTION A-A

SECTION B-B

SECTION C-C

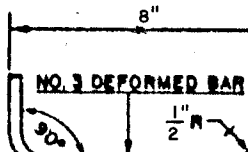

DOWEL DETAIL



SECTION D-D


GENERAL NOTES:

1. Placement of drain thru curb, sidewalk, curb and gutter will require removal and replacement of entire slabs & sidewalk, curb and gutter as detailed herein.
2. The invert shall be finished and reworked to produce a horizontal surface of max. density and strength. Invert shall be finished to within 3" of the outlet and worked from this point to outlet. Invert of outlet shall parallel gutter flanges unless otherwise shown on plans.
3. Surface of all exposed concrete shall match the grad. color, finish and texture of adjacent curb and sidewalk.
4. Sidewalk replaced during construction shall be poured monolithically with culvert walls.
5. Reinforcing steel shall be anchored and lapped for full length of lap. Lap shall be staggered and lapped for full length of lap. Lap shall be staggered and lapped for full length of lap.
6. The culvert steel top plate shall be not perpendicular to the walls unless otherwise specified. Length shall be such that the weight per plate does not exceed 300 lbs. It shall be stressed relieved after fabrication. After cleaning surface of steel, rust, dirt, the plate and framing members shall be painted with one shop coat red oxide and two field coats of aluminum paint (AASHO M281).
7. Joint and dowels optional. Dowels spaced 8" o.c. max. 1" min. clearance from face of concrete, may be added if necessary.
8. The City does not accept responsibility for maintenance for any drain lines installed by or for private property owners.


CONSTRUCTION NOTES:

- A. JOIN NEAREST SCORE LINE OR WEAKENED PLANE JOINT PLACE & EXPANSION JOINT MATERIAL.
- B. SIDEWALK OR SETBACK, (VARIABLE).
- C. 5" RADIUS, (TYPICAL).
- D. CHECKED STEEL PLATE CULVERT TOP.
- E. ADD ANCHOR 1" x 8".
- F. 1" INVERT.
- G. SIDEWALK GRADE.
- H. DOWEL AND JOINT, (OPTIONAL).
- I. BUTTER FLOWLINE ELEV.
- J. 1" x 1" FH. C/SUNK STAINLESS STL. MACHINE SCREW.
- K. BOTTOM OF BUTTER.
- L. DRAIN WIDTH 24" MAX. 12" MIN.
- M. SLOPE 1/4" PER FT. MIN.


REVISIONS	CITY OF ALBUQUERQUE
1-10-84	DRAINAGE SIDEWALK CULVERT WITH STEEL PLATE TOP DWG. K-16-1 JAN. 1981

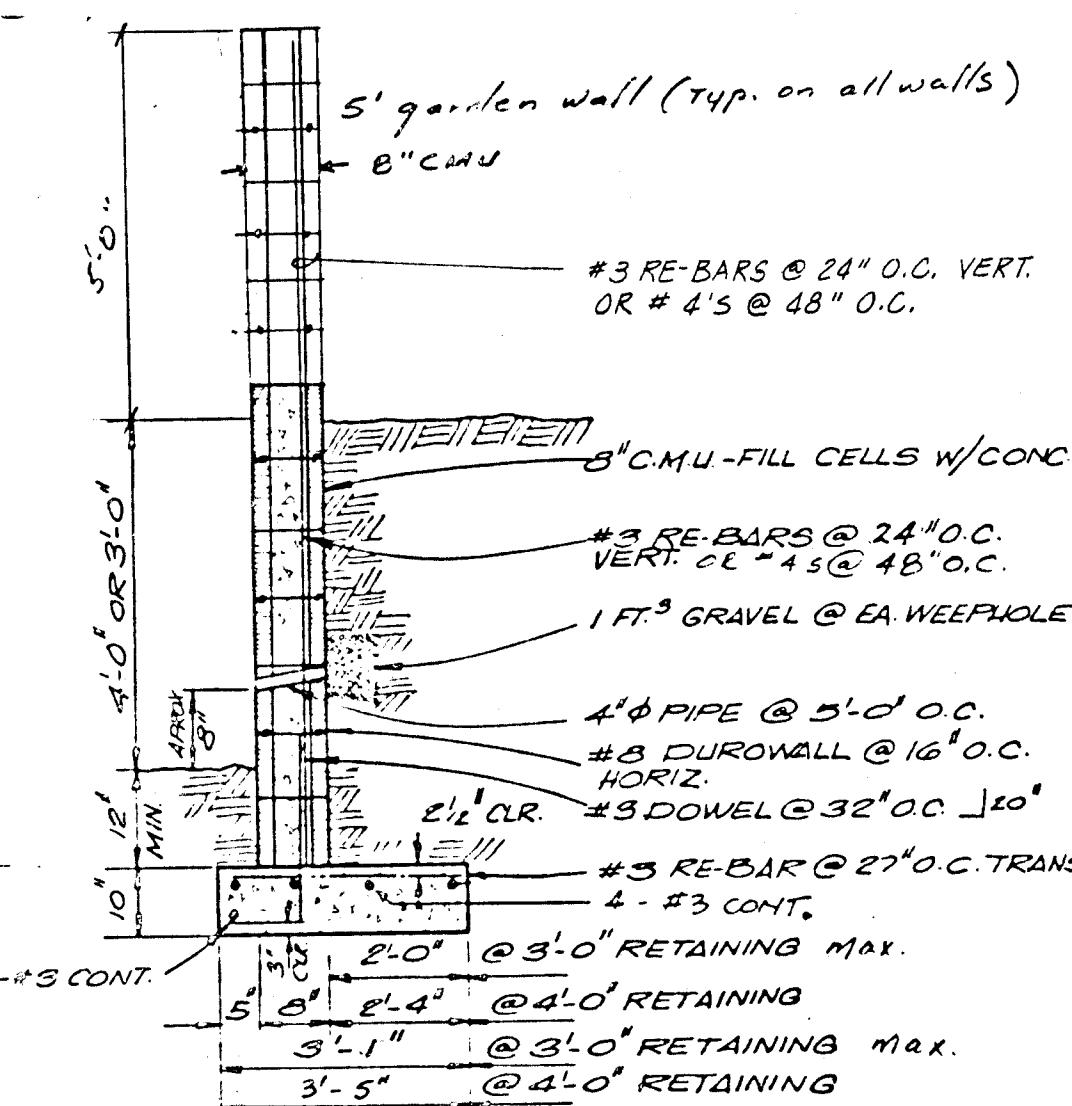

RETAINING WALL 2' to 4' (ACTUAL)

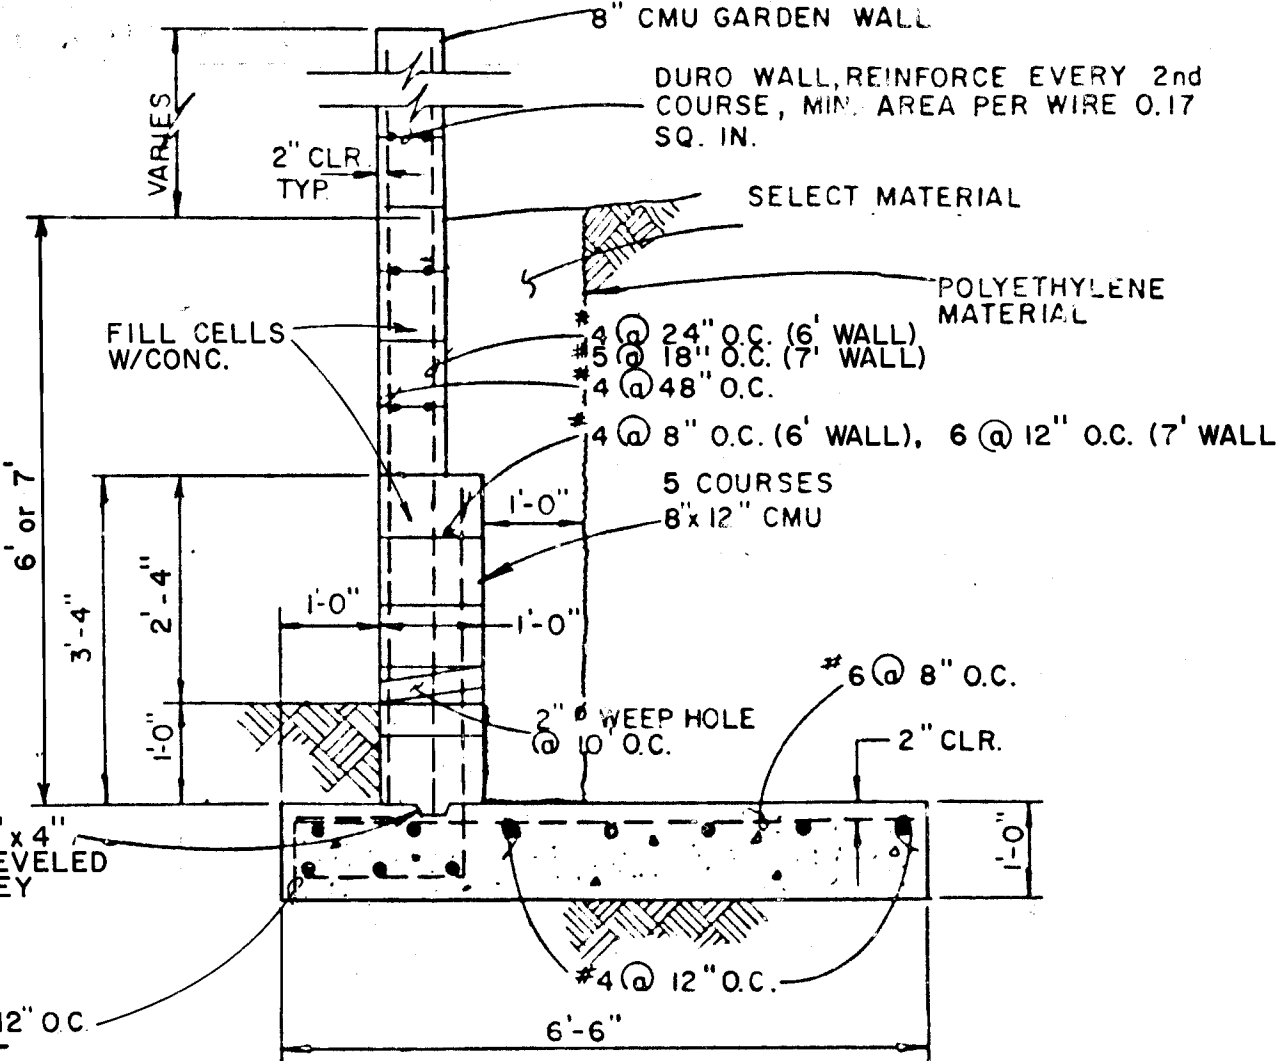


RETAINING WALL 6' to 7' (ACTUAL)

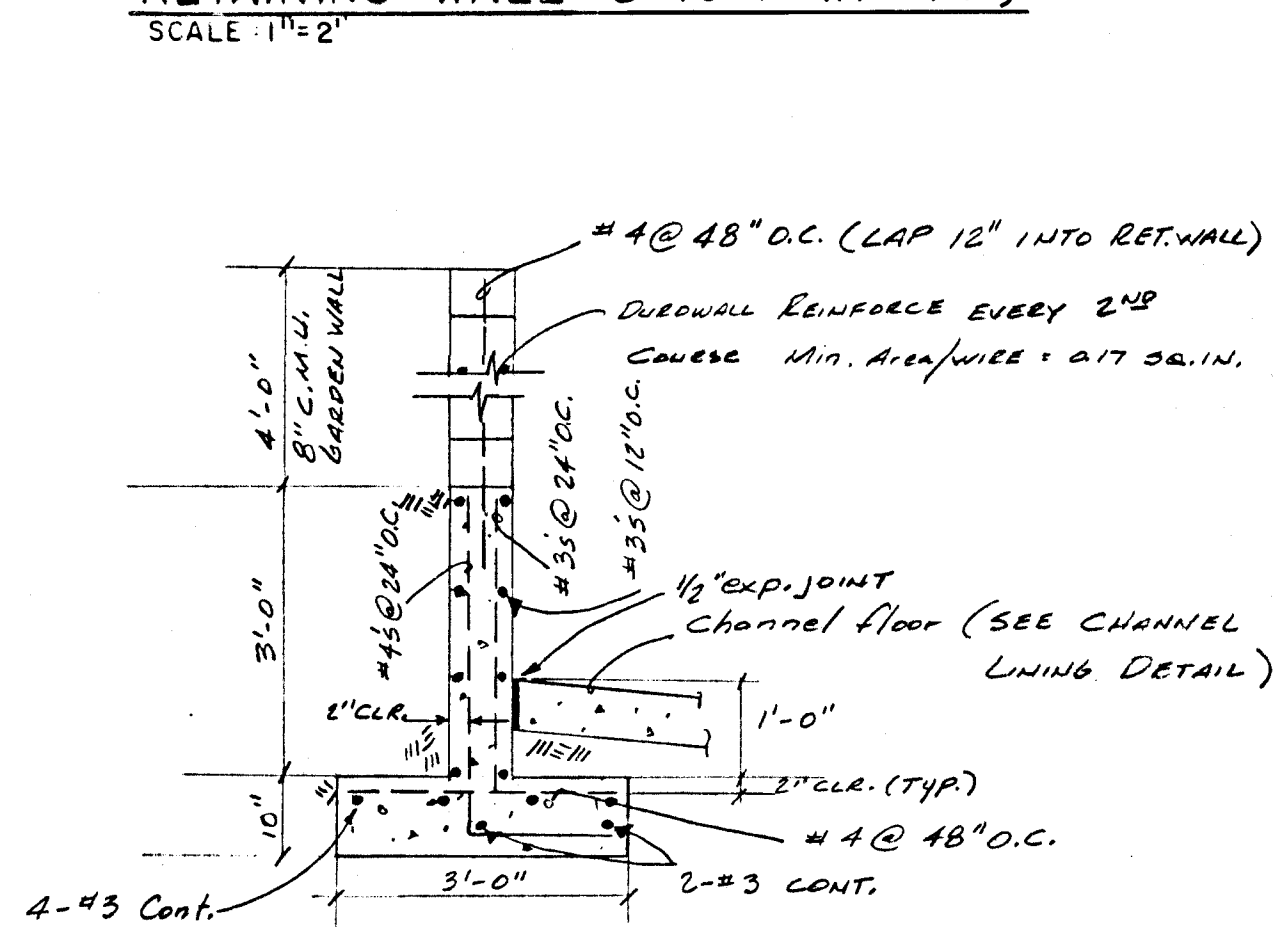


RET. WALL DETAIL
(FROM STA. 2+31 TO 1+82.81)
Scale 1"=2'-0"

NOTES:


1. ALL CONCRETE SHALL HAVE A 28 DAY STRENGTH OF 3000 P.S.I. USING 3/4" AGGREGATE & TYPE I PORTLAND CEMENT. ALL CONCRETE SHALL HAVE 5-7% AIR CONTENT AND A MAX. 4" SLUMP.
2. REBAR SHALL BE GRADE 40.
3. ALL MASONRY UNITS SHALL BE MANUFACTURED TO ASTM C-90.

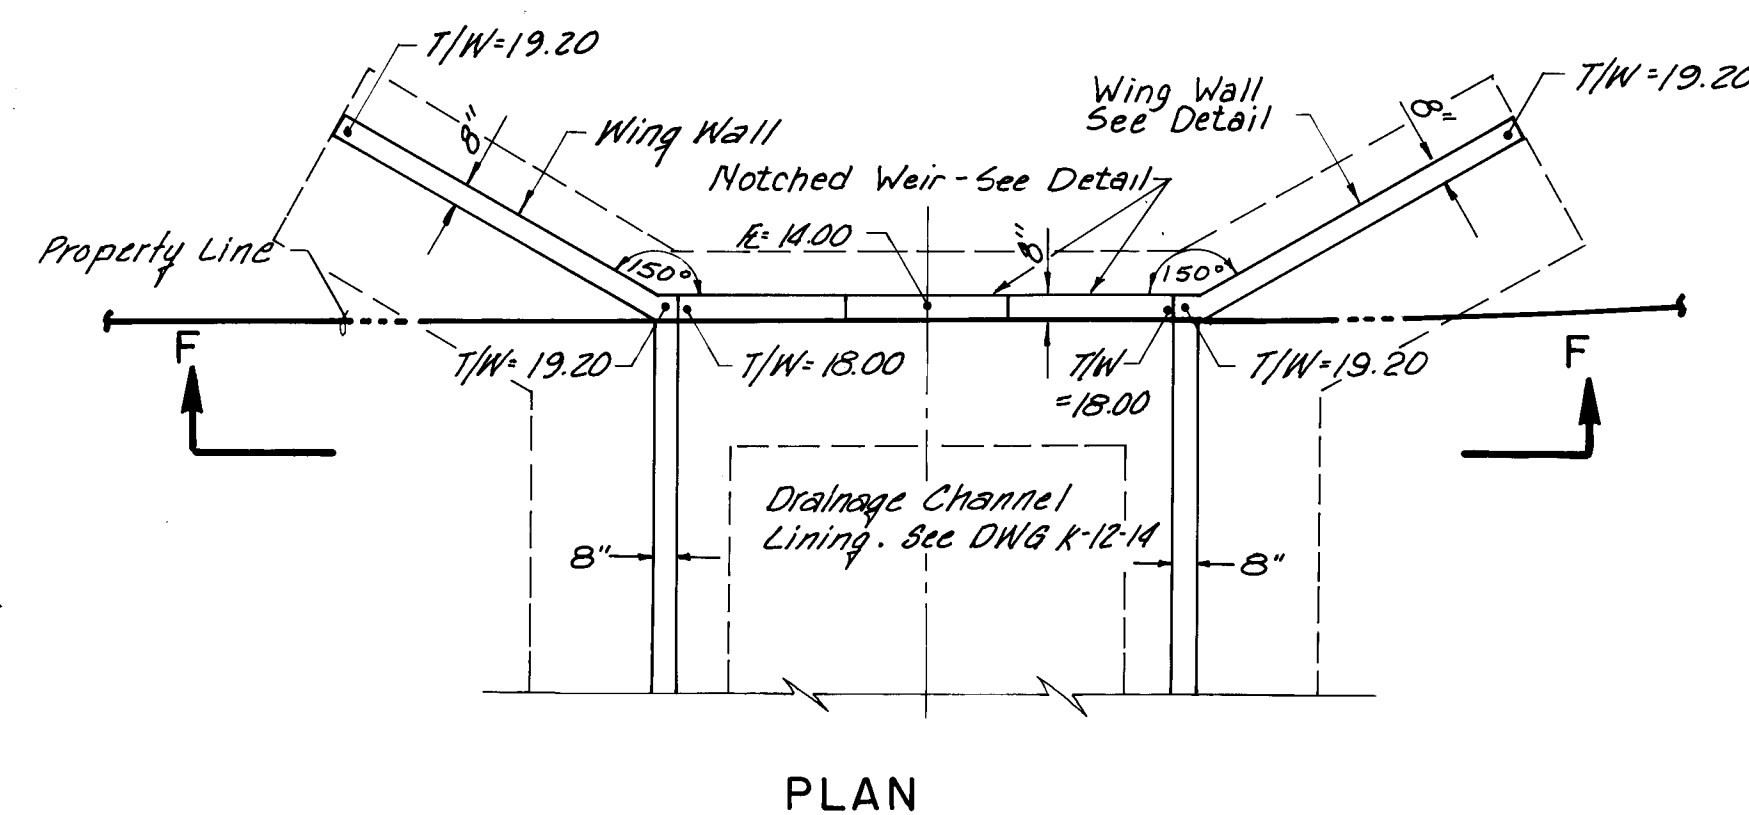


PLAN

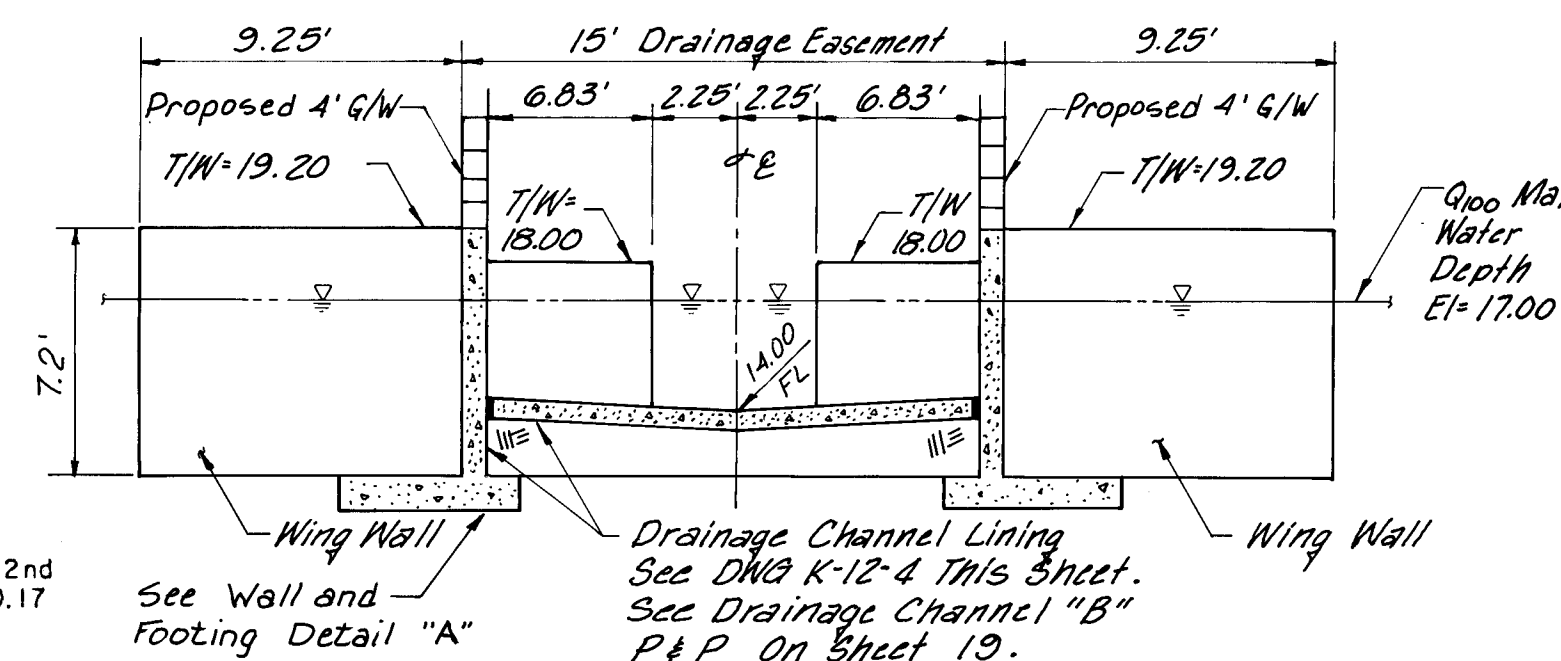

SECTION F-F
WEIR DETAILS
N.T.S.

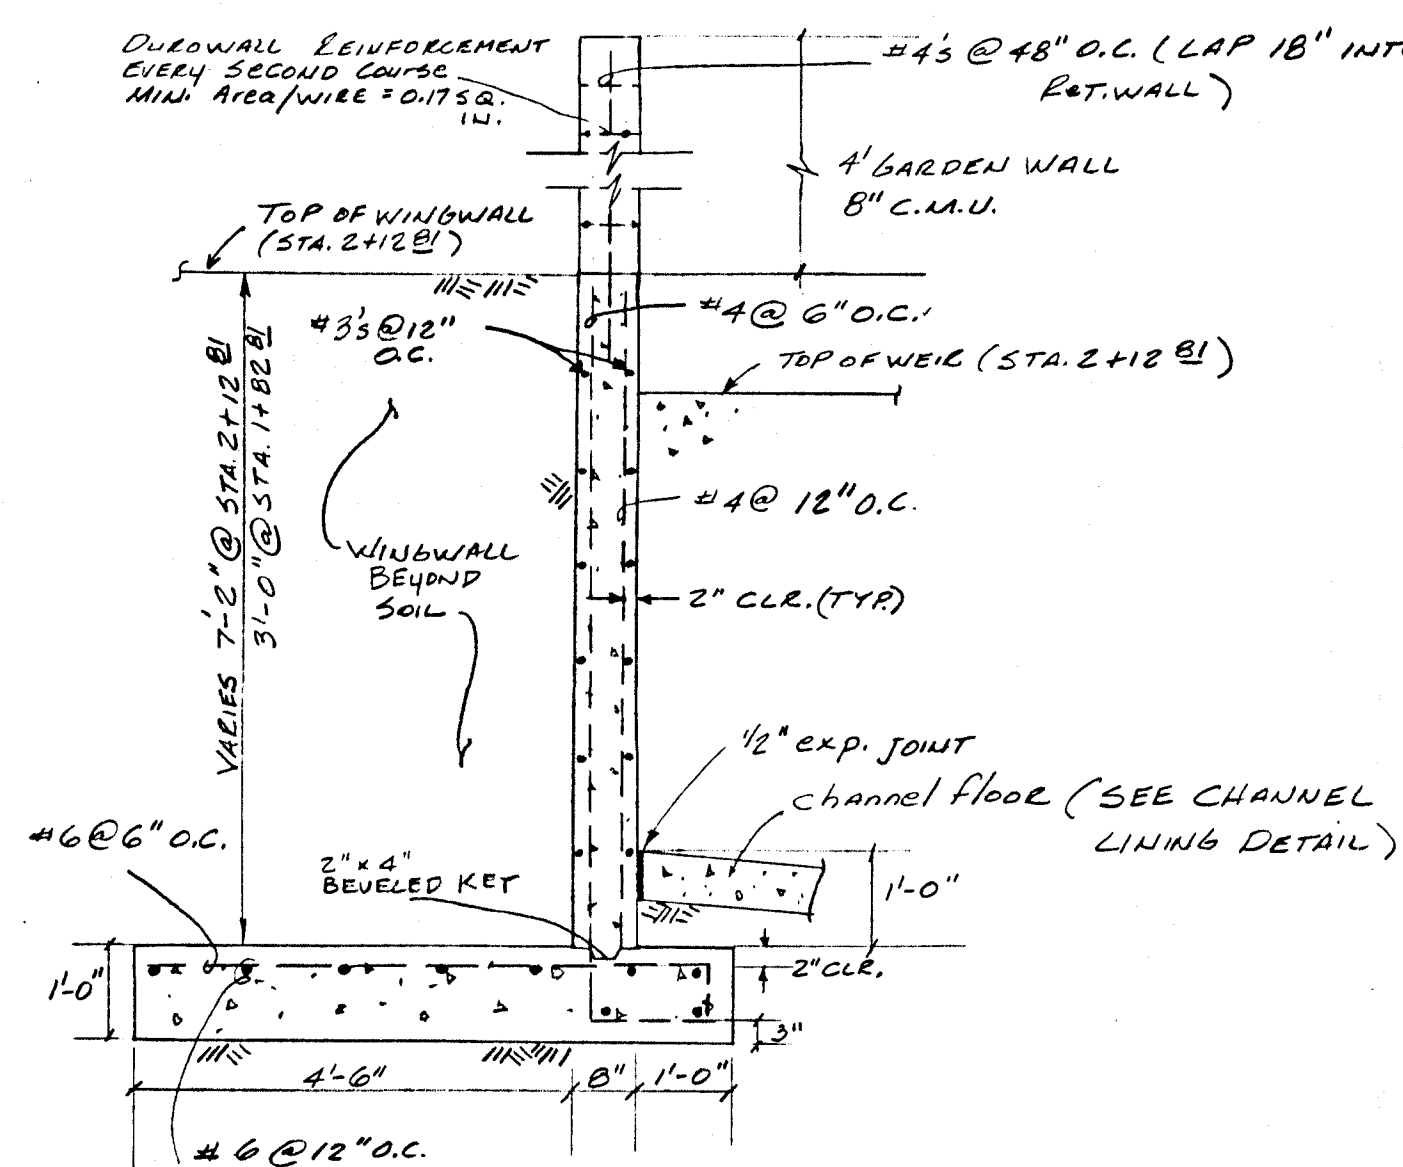

WEIR, WINGWALL & RET. WALL DETAIL "A"
(FROM STA. 2+10.81 TO 1+82.81)
Scale 1"=2'-0"

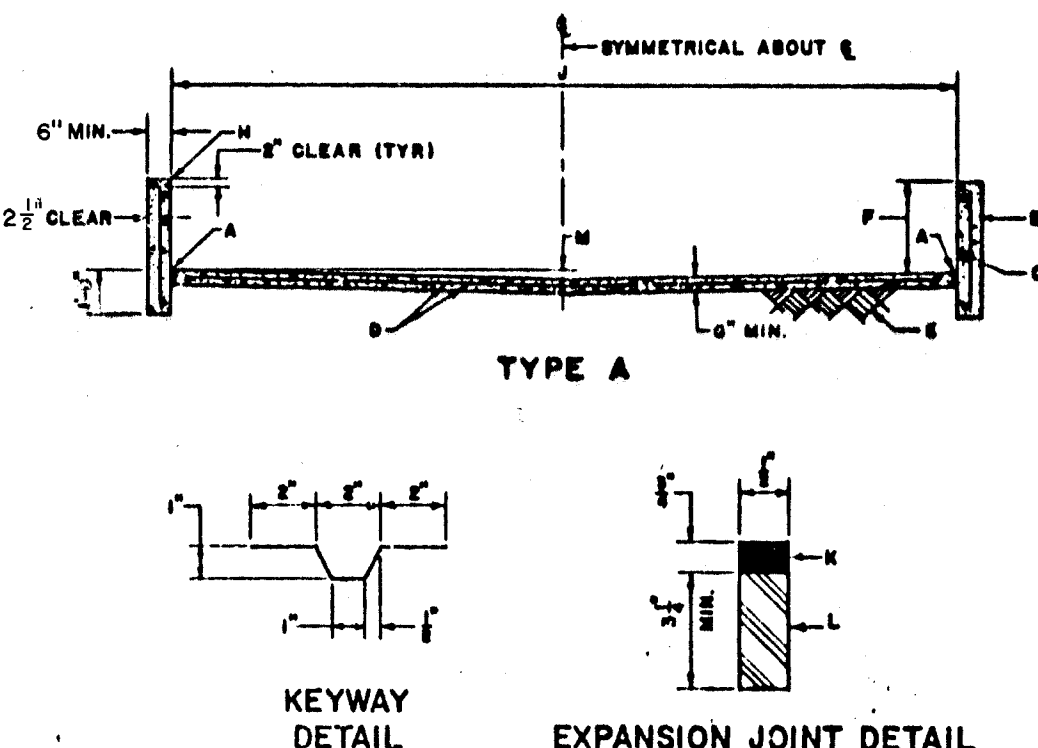

KEYWAY DETAIL

EXPANSION JOINT DETAIL


GENERAL NOTES:

1. CHANNEL DEPTHS EXCEEDING 2'-0" WILL REQUIRE SEPARATE DESIGN FOR FLOOR AND WALLS.
2. TYPE B LINING WILL BE USED ONLY WHERE NO UTILITIES ARE LOCATED OR PROPOSED.
3. UP TO 18'-0" WIDTH USE 4" INVERTED CROWN, 18'-0" WIDTH AND OVER USE 6" INVERTED CROWN.
4. WARNING: THESE WALLS ARE NOT DESIGNED TO SUPPORT THE ADDITION OF GARDEN OR RETAINING TYPE OF WALLS. A SEPARATE DESIGN WILL BE SUBMITTED FOR THE CITY ENGINEER'S APPROVAL.
5. THE OUTSIDE OF DRAINAGE WALLS SHALL NOT EXTEND BEYOND EASEMENT LINES OR RIGHT-OF-WAY LINES.
6. WIDTH OF CHANNEL TO BE SPECIFIED BY THE CITY ENGINEER, BUT IN NO CASE IS THE WIDTH TO BE LESS THAN 6'-0". HOWEVER THE LENGTH OF THE DRAINAGE EASEMENT EXCEEDS 870' THE MIN. WIDTH SHALL BE 10'-0".

CONSTRUCTION NOTES:


- A. EXPANSION JOINT, SEE DETAIL BELOW.
- B. NO. 4 REBARS AT 1'-0" O.C.
- C. NO. 4 REBARS AT 1'-0" O.C.
- D. NO. 4 REBARS AT 1'-0" O.C. BOTH WAYS.
- E. 6" COMPACTED SOIL 95% PER ASTM D 1587.
- F. AS SPECIFIED FOR 6" WALLS SEE NOTE NO. 1.
- G. ALL NO. 4 REBARS AT 1'-0" O.C.
- H. 8" CONC. BLOCK WITH CORES FILLED WITH CONC. AND NO. 4 REBARS INSERTED INTO CORES AT 1'-0" O.C. MAY BE SUBSTITUTED FOR FORMED CONC. WALLS.
- I. WIDTH OF CHANNEL.
- J. TWO COMPONENT URETHANE SEALANT.
- K. POLYETHYLENE FOAM FILLER TO DEPTH OF SLAB.
- L. SEE NOTE NO. 3.
- M. KEYED CONSTRUCTION JOINT, SEE DETAIL BELOW.

REVISIONS	CITY OF ALBUQUERQUE
1-10-84	DRAINAGE TYPICAL LINING FOR DRAINAGE EASEMENTS DWG. K-12-4 NOV 1979

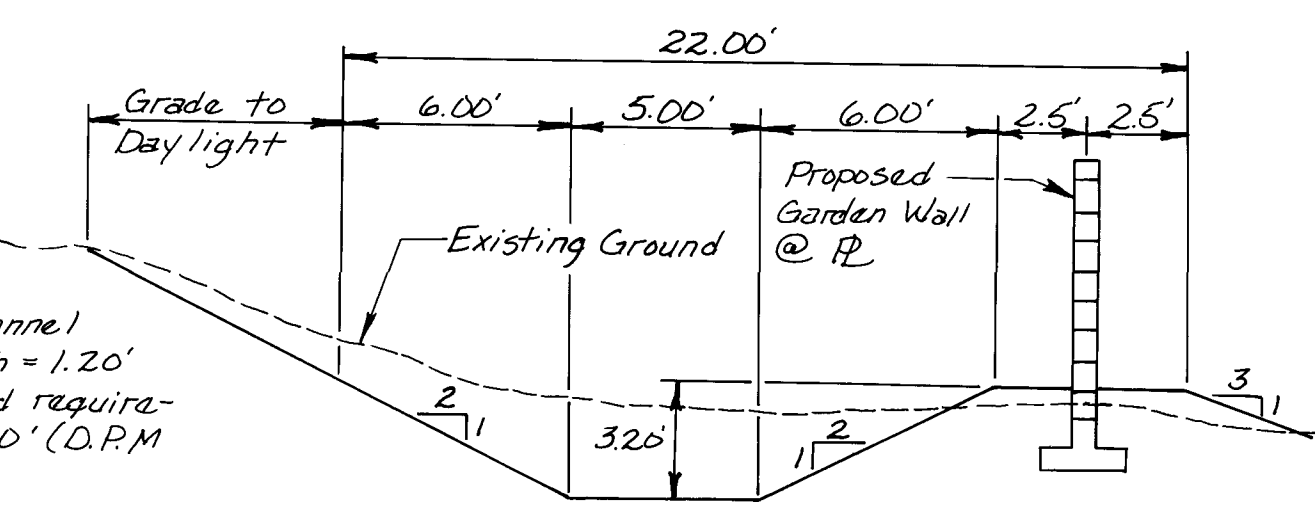

CONTOUR BERM AND CHANNEL
Scale: 1"=5'

BOLLARD DETAIL
Not to Scale

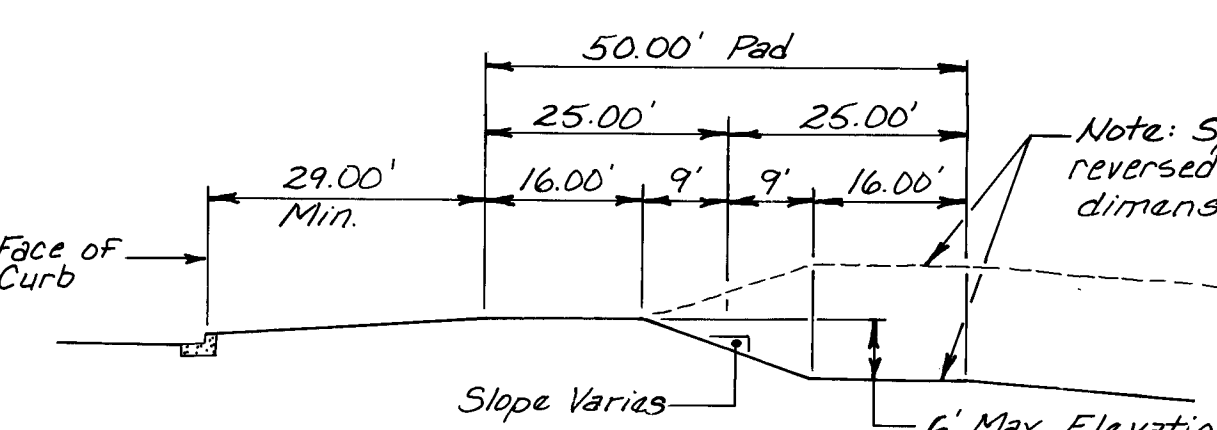

SPLIT HOUSE PAD DETAIL
Scale: 1"=20'

NOTES:

1. The house pad split detail shown delineates a pad split in a width direction.
2. A house pad split in a length direction shall maintain the same detailed split with a 6' maximum elevation difference & the slope may vary within the 18' difference.

NOTE:
1. Wing Wall, Weir Wall and Channel Wall to be Continuous. Footings and Wall to Have Same Geometry and Reinforcement as That of Detail "A" At Sta. 2+12.81

26 21332086

CITY OF ALBUQUERQUE MUNICIPAL DEVELOPMENT DEPARTMENT ENGINEERING DIVISION					
TITLE: VISTA DEL MUNDO DETAIL SHEET					
APPROVALS	ENGINEER	DATE	APPROVALS	ENGINEER	DATE
City Engineer	<i>A.C. Design</i>	7/10/84	Liquid Waste	<i>R. Kana</i>	7/10/84
A.C.E. Design	<i>N.C. Design</i>	9/10/84	Traffic	<i>N.C. Design</i>	7/10/84
A.C.E.-Hydrology	<i>B. J. Smith</i>	7/10/84	Water	<i>R. Kana</i>	7/10/84
DRAWING NO.	2133	MAP NO.	J-23	SHEET	20 OF 20