

ACADEMY COURT NE

ALBUQUERQUE, NEW MEXICO


INDEX

DESCRIPTION

SHEET NO.

COVER SHEET	1
PAVING PLAN & PROFILE	2
SEWER PLAN & PROFILE	3
WATER PLAN & PROFILE	4 & 5
MEDIAN CURB OPENING	6

VICINITY MAP


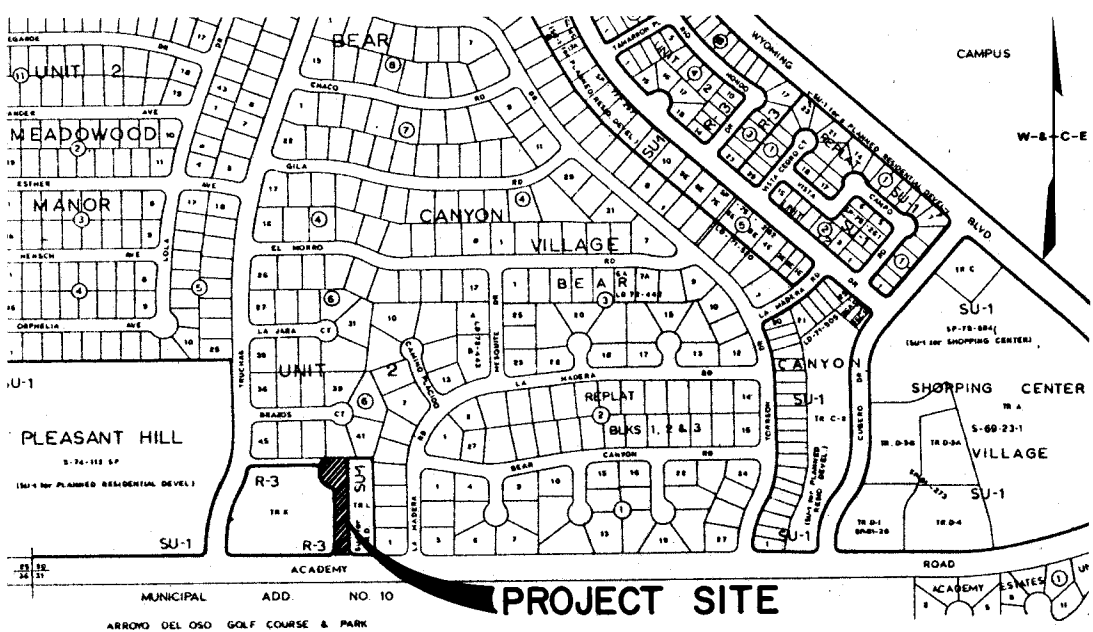


NOTES

ALL WORK DETAILED ON THESE PLANS TO BE PERFORMED UNDER CONTRACT SHALL, EXCEPT AS OTHERWISE STATED OR PROVIDED FOR HEREON, BE CONSTRUCTED IN ACCORDANCE WITH THE NEW MEXICO STANDARD SPECIFICATIONS FOR PUBLIC WORKS CONSTRUCTION - 1979 EDITION (REFERRED TO HEREIN AS THE STANDARD SPECIFICATIONS).



TWO (2) WORKING DAYS PRIOR TO ANY EXCAVATION, CONTRACTOR MUST CONTACT LINE LOCATING SERVICE, 765-1234, FOR LOCATION OF EXISTING UTILITIES.


PRIOR TO CONSTRUCTION, THE CONTRACTOR SHALL EXCAVATE AND VERIFY THE HORIZONTAL AND VERTICAL LOCATIONS OF ALL OBSTRUCTIONS. SHOULD A CONFLICT EXIST, THE CONTRACTOR SHALL NOTIFY THE ENGINEER OR SURVEYOR SO THAT THE CONFLICT CAN BE RESOLVED WITH MINIMUM AMOUNT OF DELAY.

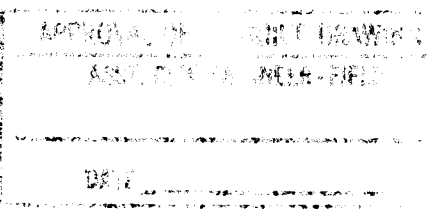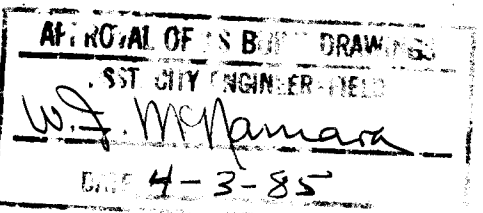

26 2135 0185

REV	SHEETS	CITY ENGR.	DATE	USER	DEPT.	DATE	USER	DEPT.	DATE
APPROVAL OF REVISIONS									

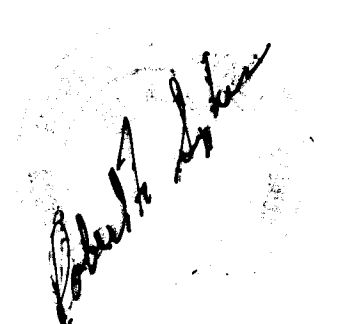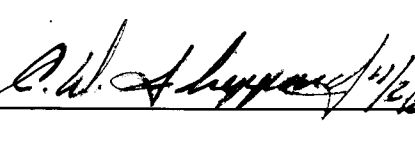
SUBMITTED BY:  DATE: _____	WILSON & COMPANY ENGINEERS ARCHITECTS ALBUQUERQUE, NEW MEXICO	APPROVED FOR CONSTRUCTION 
	PROJECT No. 2135	SHEET 1 OF 6

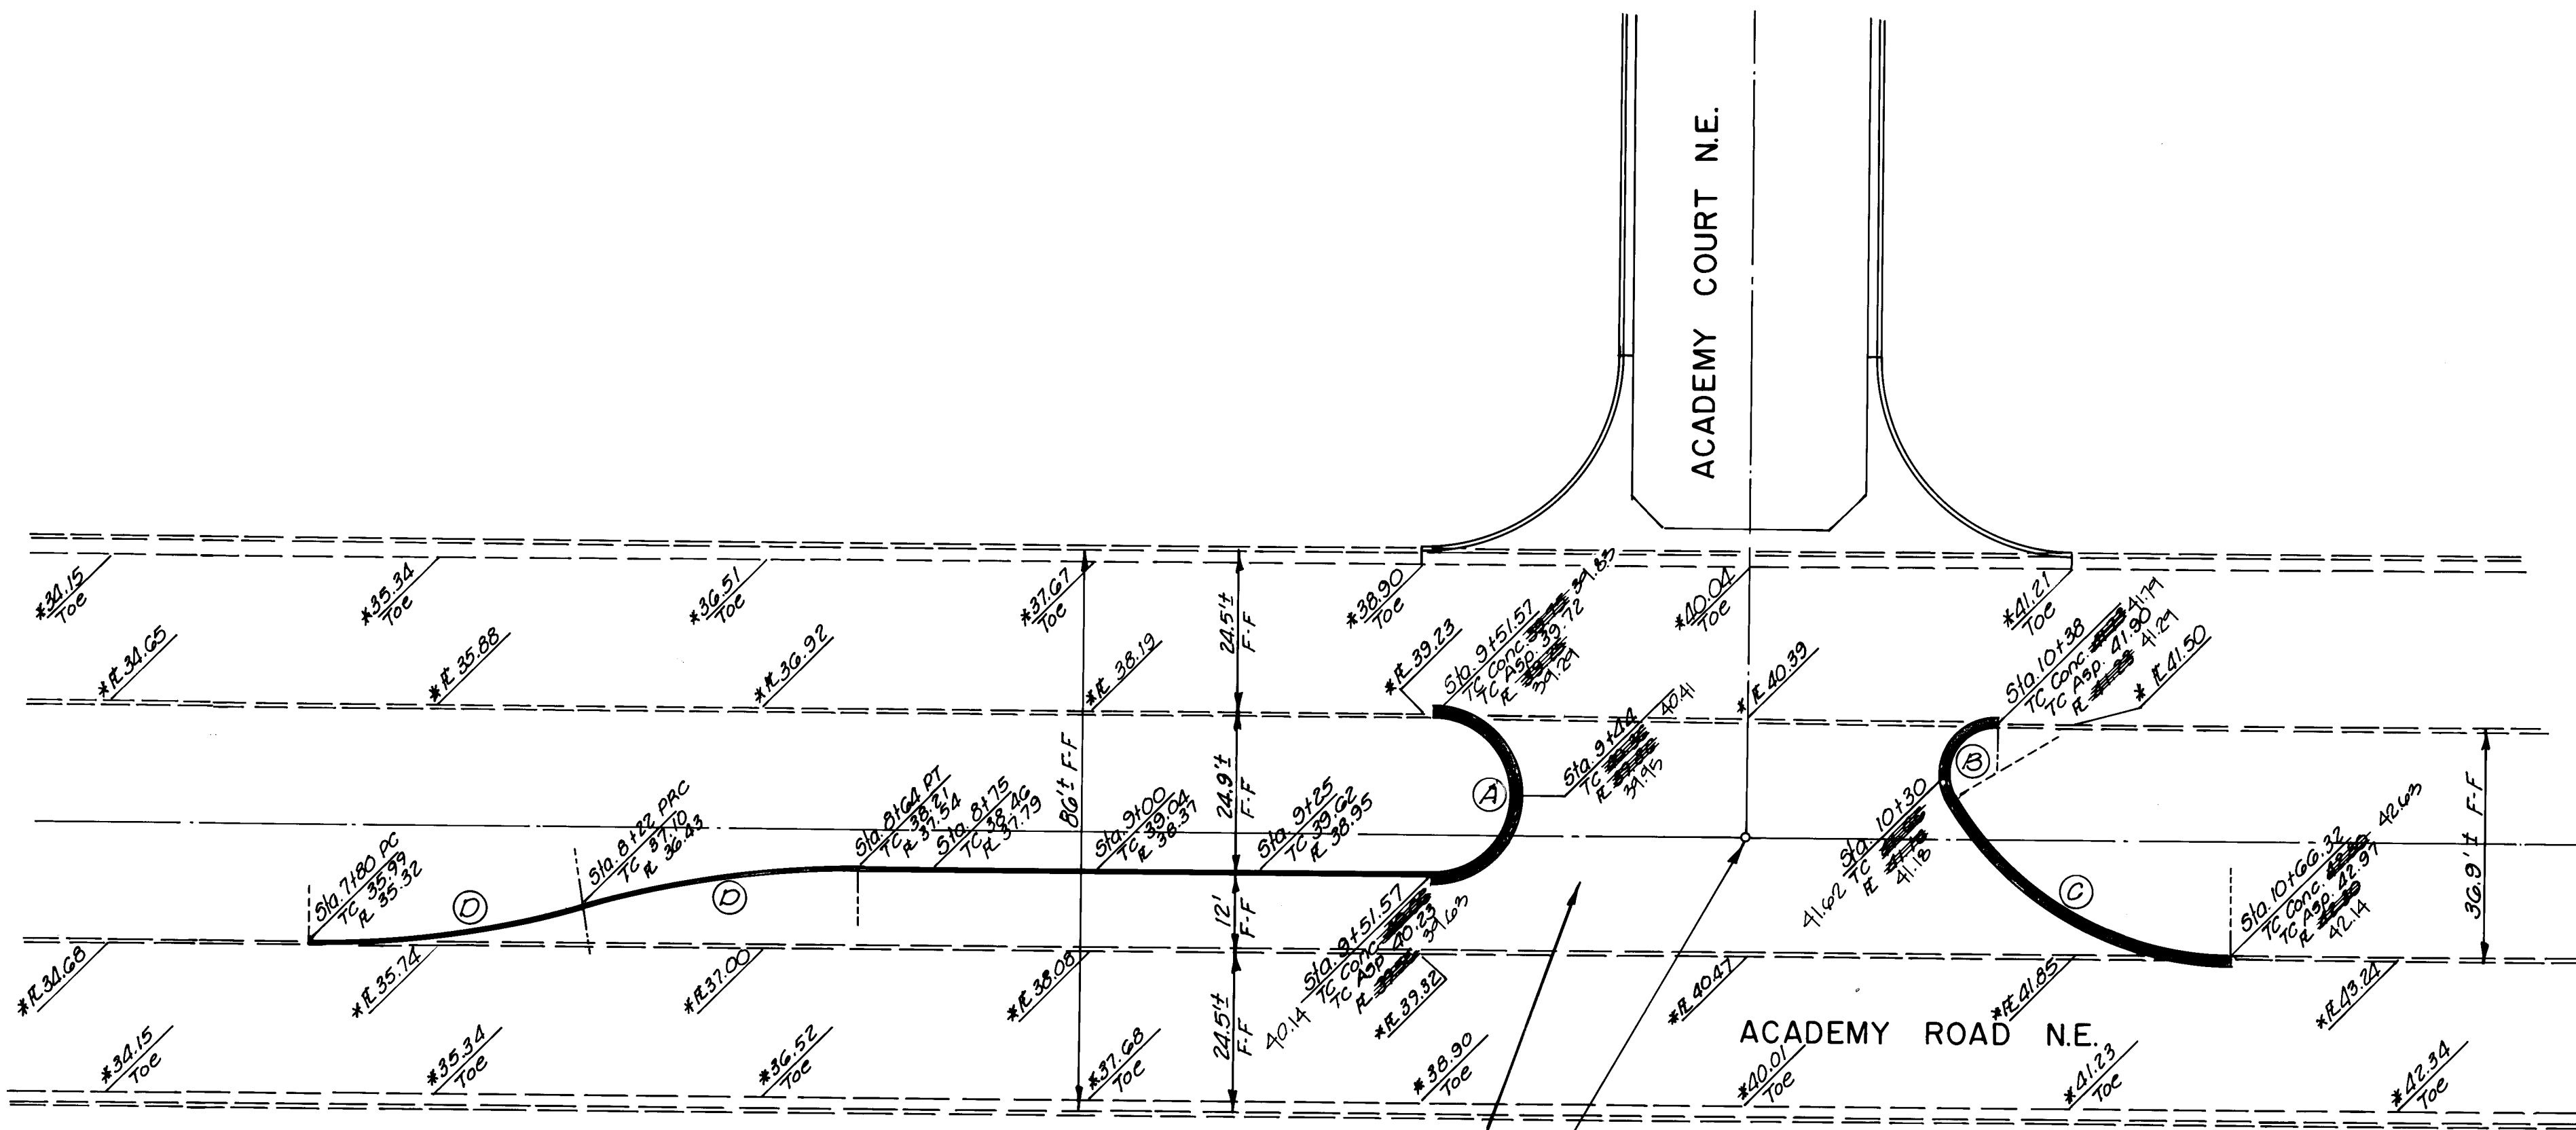


* Denotes Existing Elevation

Sig. 10100 ACADEMY ROAD NE
Sig. 10100 ACADEMY COURT NE

- (R) 380 LF ASPHALT CURB
- (C) 175 LF ASPHALT CURB
- (C) 110 LF MEDIAN CURB & GUTTER
- (C) 510 SY ARTERIAL PAVEMENT

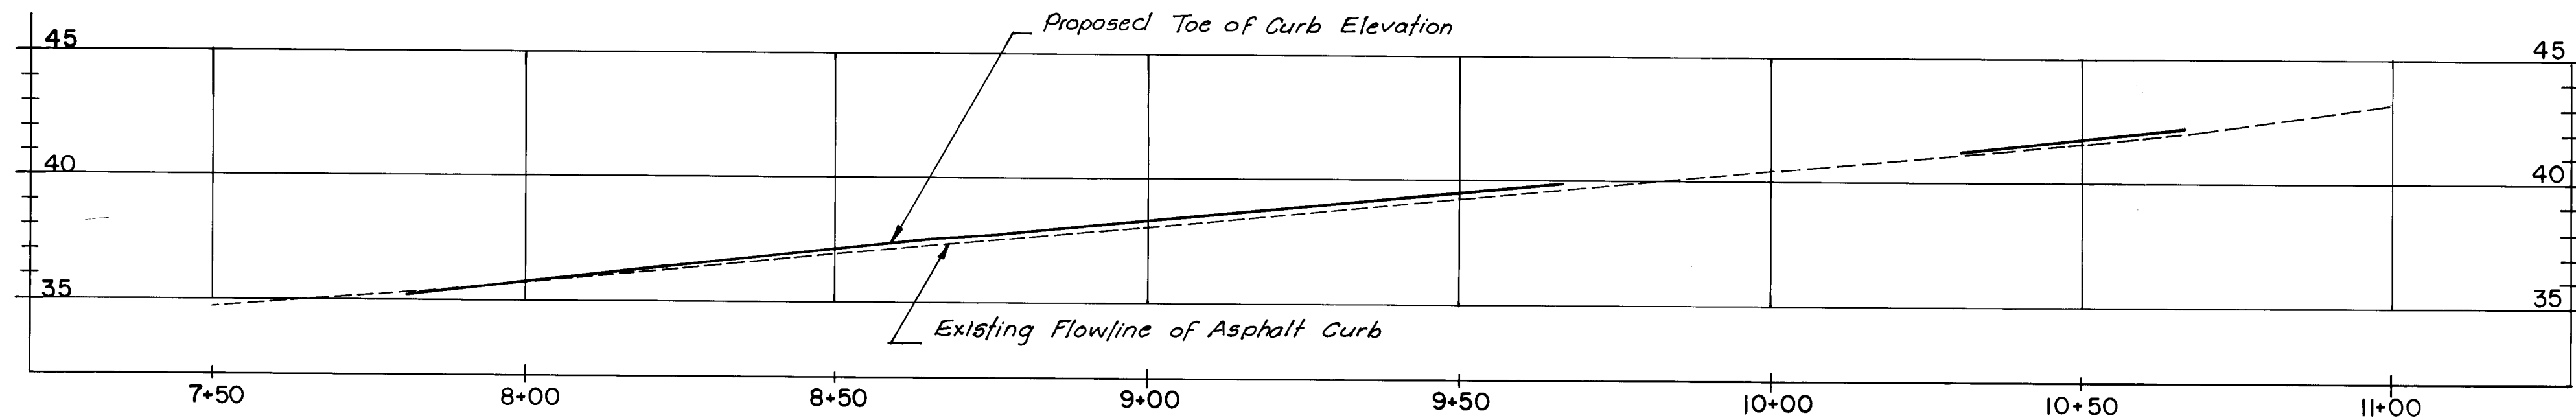


CURVE DATA			
CURVE A		CURVE B	
$\Delta = 180^{\circ}00'$		$\Delta = 120^{\circ}09'28''$	
$R = 12.43'$		$R = 8.00'$	
$L = 39.05'$		$T = 13.90'$	
		$L = 16.78'$	
CURVE C		CURVE D	
$\Delta = 59^{\circ}50'32''$		$\Delta = 16^{\circ}15'37''$	
$R = 50.00'$		$R = 150.00'$	
$T = 28.78'$		$T = 21.43'$	
$L = 52.22'$		$L = 42.57'$	

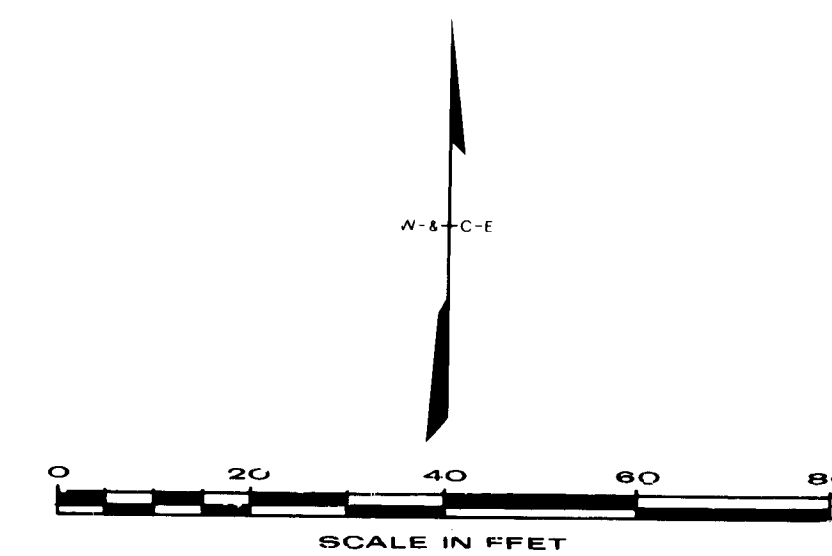

NOTE:
Pavement Materials and construction will be in accordance with City of Albuquerque Contract Documents For Public Works Contract 64-2.

BENCH MARKS		AS BUILT INFORMATION	
A Standard ACS Brass Tablet		CONTRACTOR	NO.
Stamped "I-F-194-1978" Set in the Median On Academy Rd. NE East of the Intersection of Truchas Dr. NE & Academy Rd. NE.		STATIONED BY	DATE
		ACCEPTANCE BY	DATE
		FIELD INSPECTION BY	DATE
		REVISIONS	DATE
		CORRECTED BY	DATE
		RECORDED BY	DATE
		NO.	


SURVEY INFORMATION		FIELD NOTES	
NO.	DATE	BY	DATE

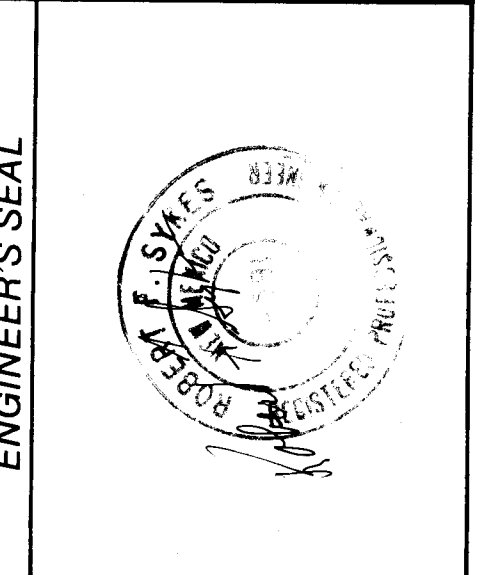


REVISIONS		BY	
NO.	DATE	NO.	DATE
WILSON & COMPANY, ENGINEERS & ARCHITECTS		DESIGNED BY	
		DRAWN BY	
		CHECKED BY	

26 2135 0685

CITY OF ALBUQUERQUE MUNICIPAL DEVELOPMENT					
ACADEMY ROAD NE					
MEDIAN CURB OPENING					
APPROVALS	ENGINEER	DATE	APPROVALS	ENGINEER	DATE
City Engineer	<i>C. H. H. H.</i>	7/11/84	Liquid Waste	<i>R. P. P.</i>	7/11/84
A.C.E.-Design	<i>W. H. H.</i>	5/5/84	Traffic	<i>D. H. H.</i>	7/11/84
A.C.E.-Hydrology	<i>N. A. H.</i>	7/11/84	Water	<i>R. P. P.</i>	7/11/84
DRAWING NO.	2135	MAP NO.	E-19	SHEET	6 OF 6

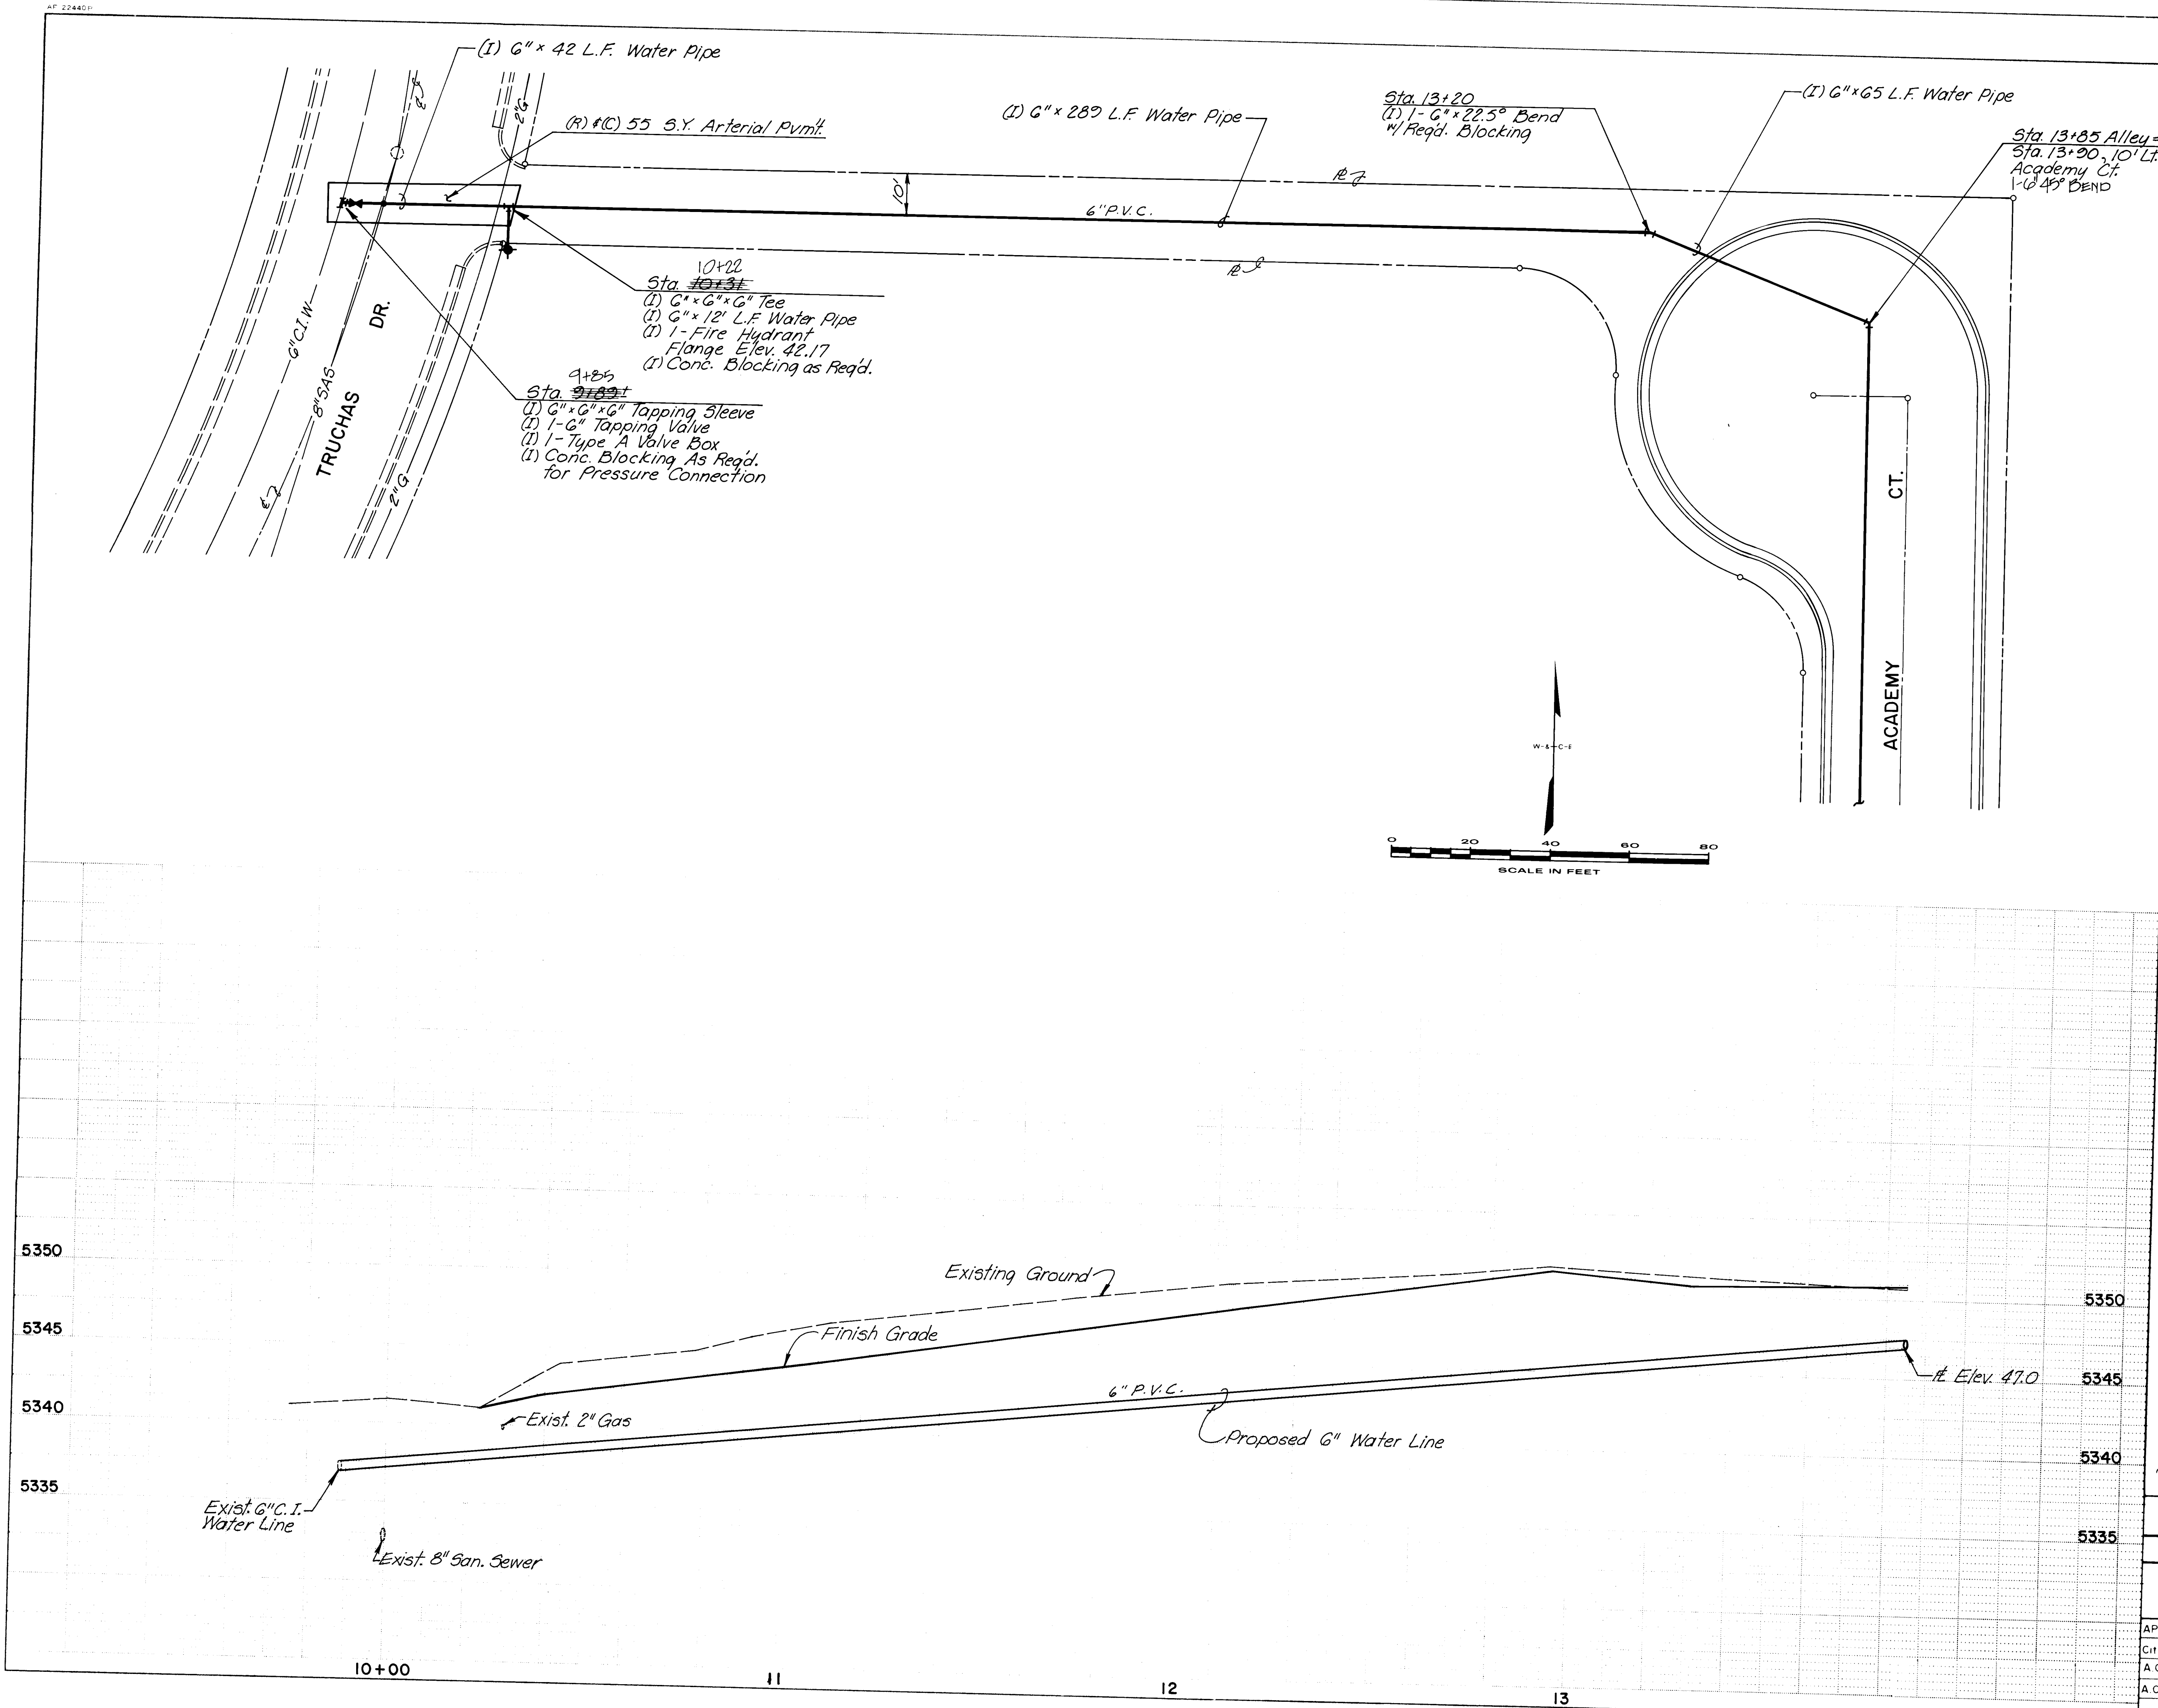

NOTE:
Water Line Materials and construction will be in accordance with City of Albuquerque Contract Documents For Public Works Contract 84-2.

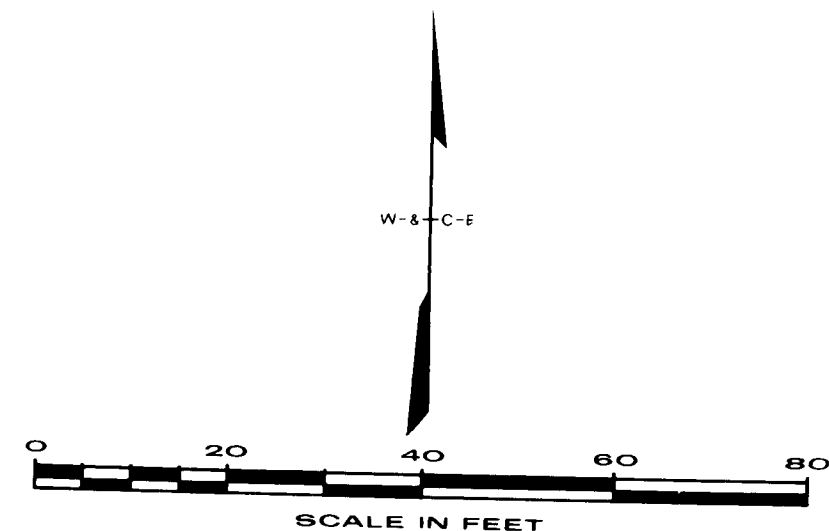

LEGEND
(I) Install
(C) Construct
(R) Remove
26 2135 0585


AS BUILT INFORMATION			BENCH MARKS			SURVEY INFORMATION			ENGINEER'S SEAL			REVISIONS			WILSON & COMPANY, ENGINEERS & ARCHITECTS			DESIGNED BY			DRAWN BY			CHECKED BY		
CONTRACT NO.	DATE	DATE	STATION	DATE	DATE	NO.	BY	DATE	DATE	DATE	DATE	NO.	DATE	DATE	NO.	DATE	DATE	NO.	DATE	DATE	NO.	DATE	DATE	NO.	DATE	DATE
A Standard AGS Brass Tablet			Station 11+79.4-1978 Set in the Median On Academy Rd. NE East of the Intersection of Truchas Dr. NE & Academy Rd. NE. Elev = 5328.52																							

CITY OF ALBUQUERQUE
MUNICIPAL DEVELOPMENT
ACADEMY COURT NE
WATER PLAN

APPROVALS	ENGINEER	DATE	APPROVALS	ENGINEER	DATE
City Engineer	<i>C. J. Dwyer</i>	7/11/84	Liquid Waste	<i>R. Peña</i>	7/11/84
A.C.E. - Design	<i>A. C. Dwyer</i>	8/5/84	Traffic	<i>NA</i>	7/11/84
A.C.E. - Hydrology	<i>NA</i>	7/11/84	Water	<i>R. Peña</i>	7/11/84

DRAWING NO. 2135 MAP NO. E-19 SHEET 5 OF 6

WILSON & COMPANY
ENGINEERS & ARCHITECTS
84-504

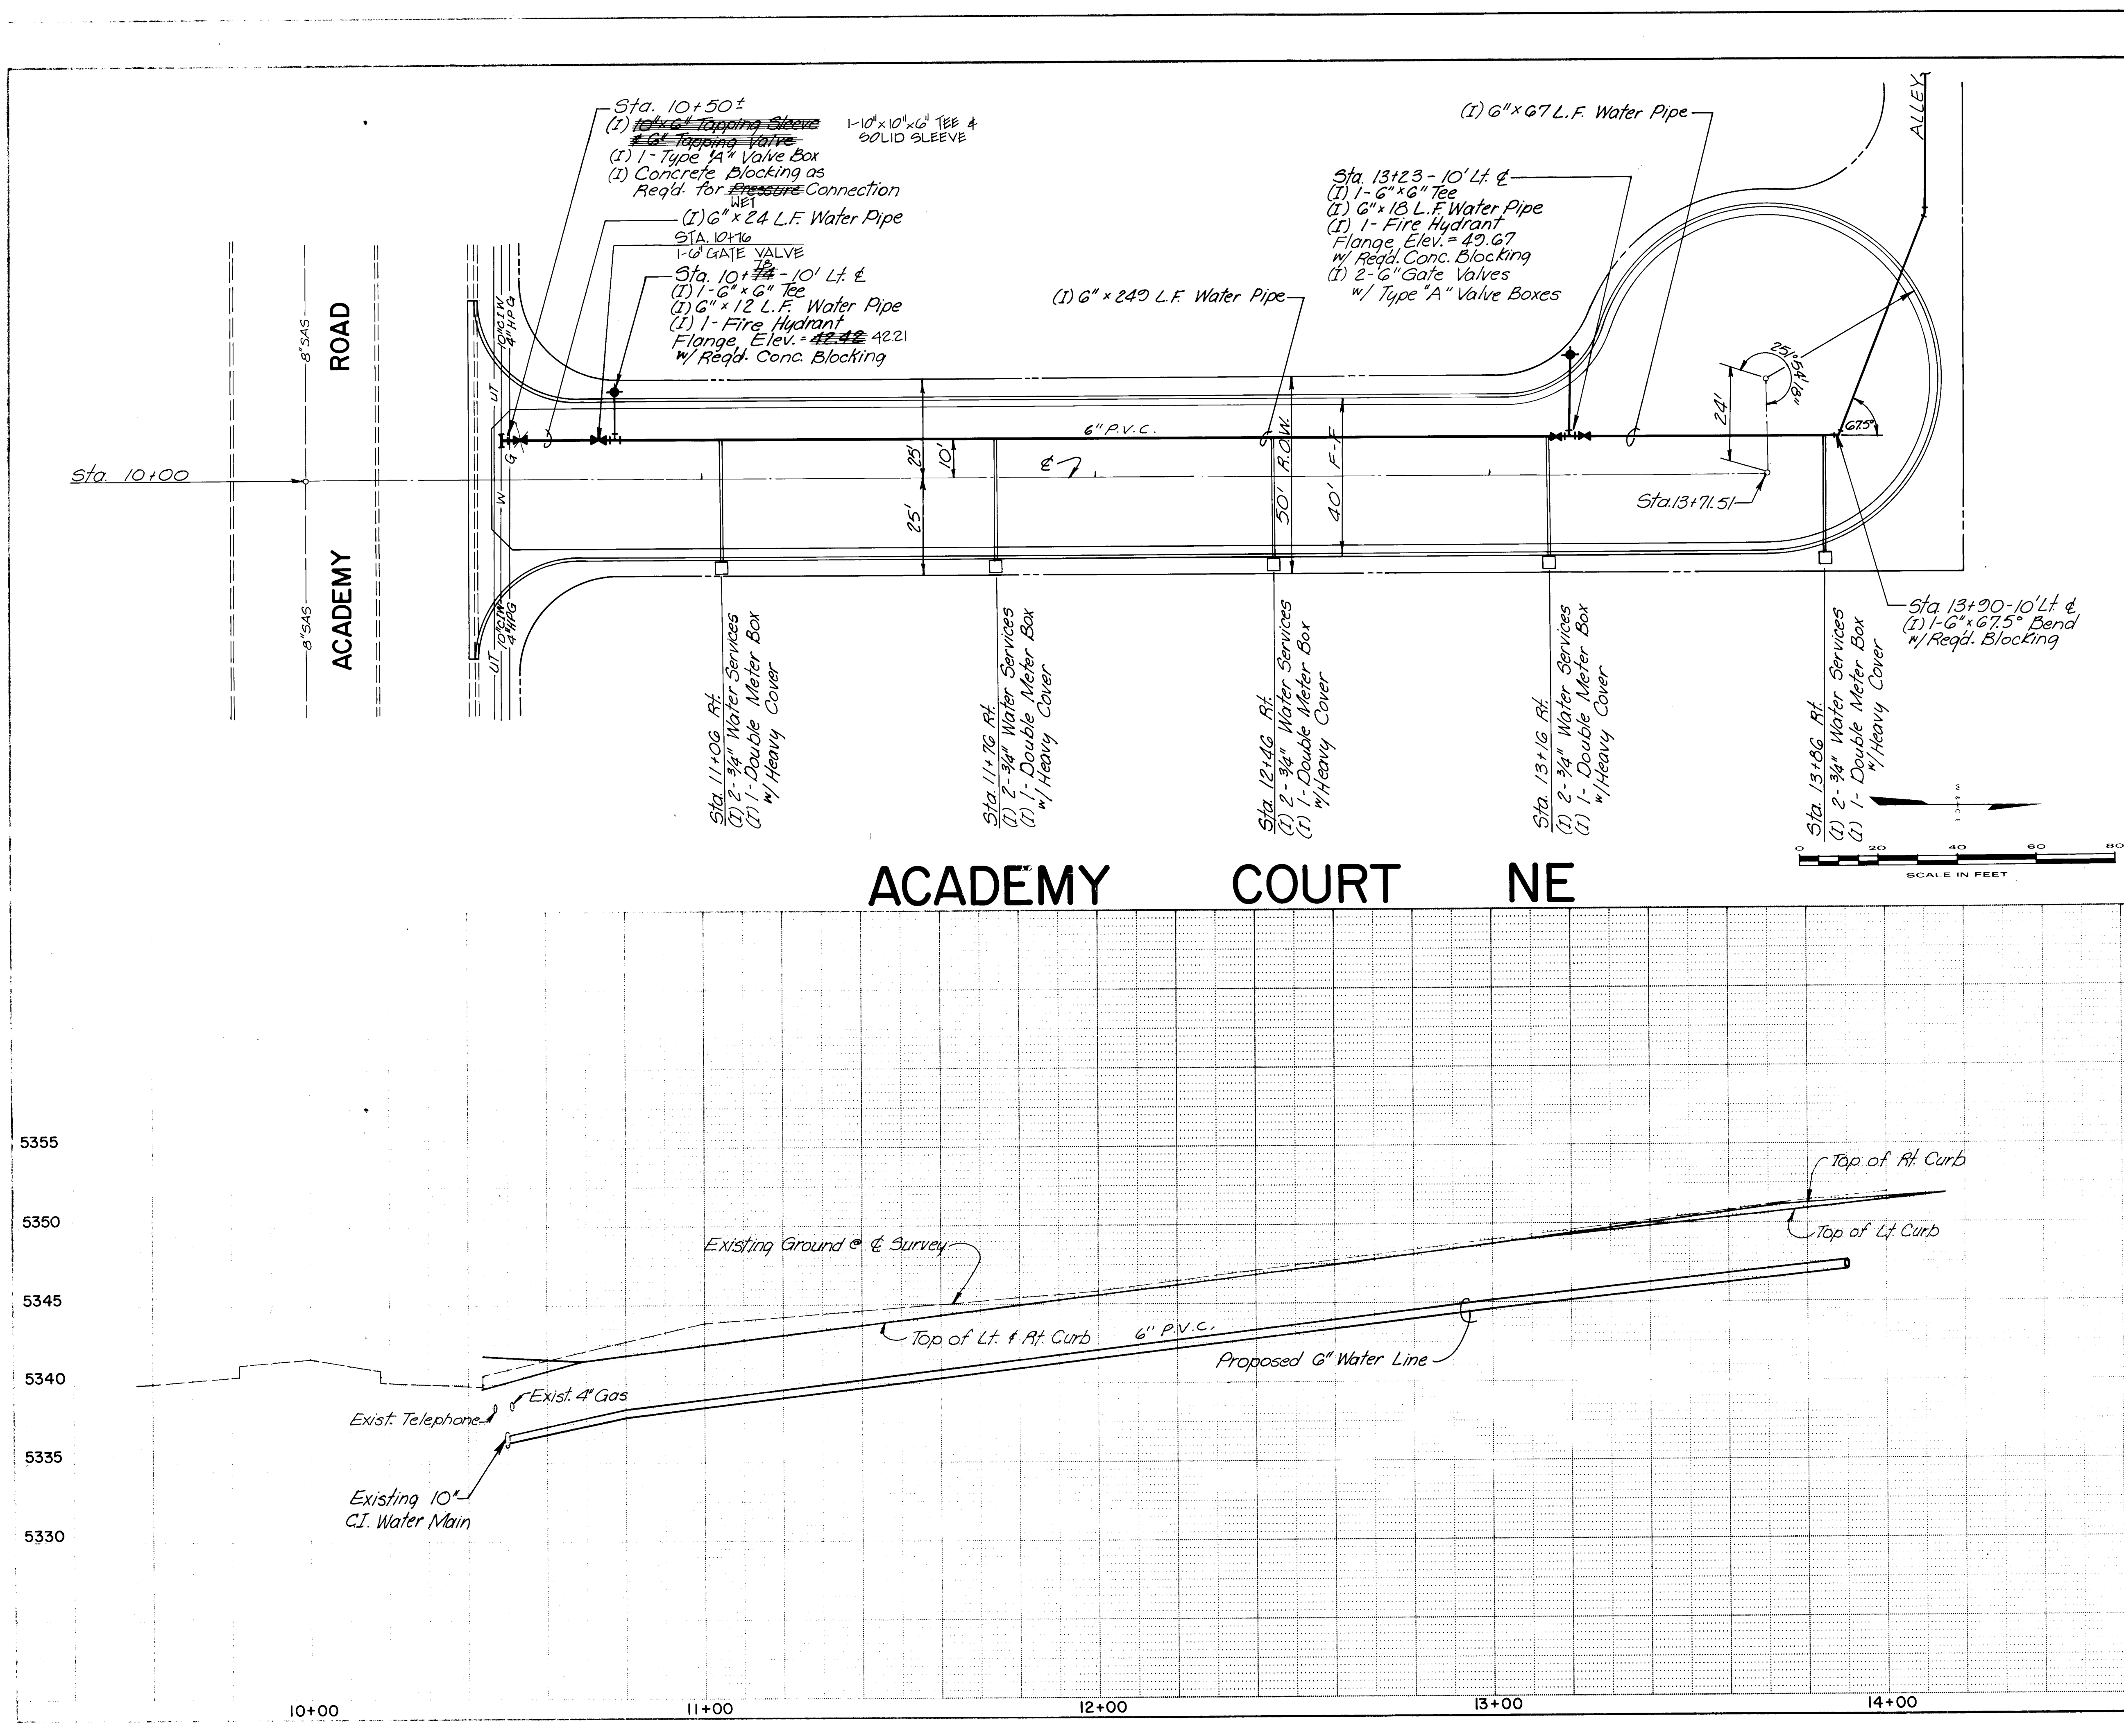

NOTE
For Curb Elevations see Sheet No. 2.
Water Line Materials and construction will be in accordance with City of Albuquerque Contract Documents For Public Works Contract 84-2.

LEGEND
(I) Install
(C) Construct
(R) Remove

26 2135 0485

ENGINEER'S SEAL

[Signature]

NO.	DATE	REMARKS	BY

WILSON & COMPANY, ENGINEERS & ARCHITECTS

DESIGNED BY	DATE	DRAWN BY	DATE	CHECKED BY	DATE

CITY OF ALBUQUERQUE MUNICIPAL DEVELOPMENT					
ACADEMY COURT NE					
WATER PLAN					
APPROVALS	ENGINEER	DATE	APPROVALS	ENGINEER	DATE
City Engineer	<i>C. M. Chavez</i>	7/11/84	Liquid Waste	<i>R. Pena</i>	7/11/84
A C E - Design	<i>N. B. A.</i>	7/11/84	Traffic	<i>N. B. A.</i>	7/11/84
A C E - Hydrology	<i>N. B. A.</i>	7/11/84	Water	<i>R. Pena</i>	7/11/84

DRAWING NO.	MAP NO.	SHEET
2135	E - 19	4 OF 6

WILSON & COMPANY
ENGINEERS & ARCHITECTS
ALBUQUERQUE NEW MEXICO

84-504

