



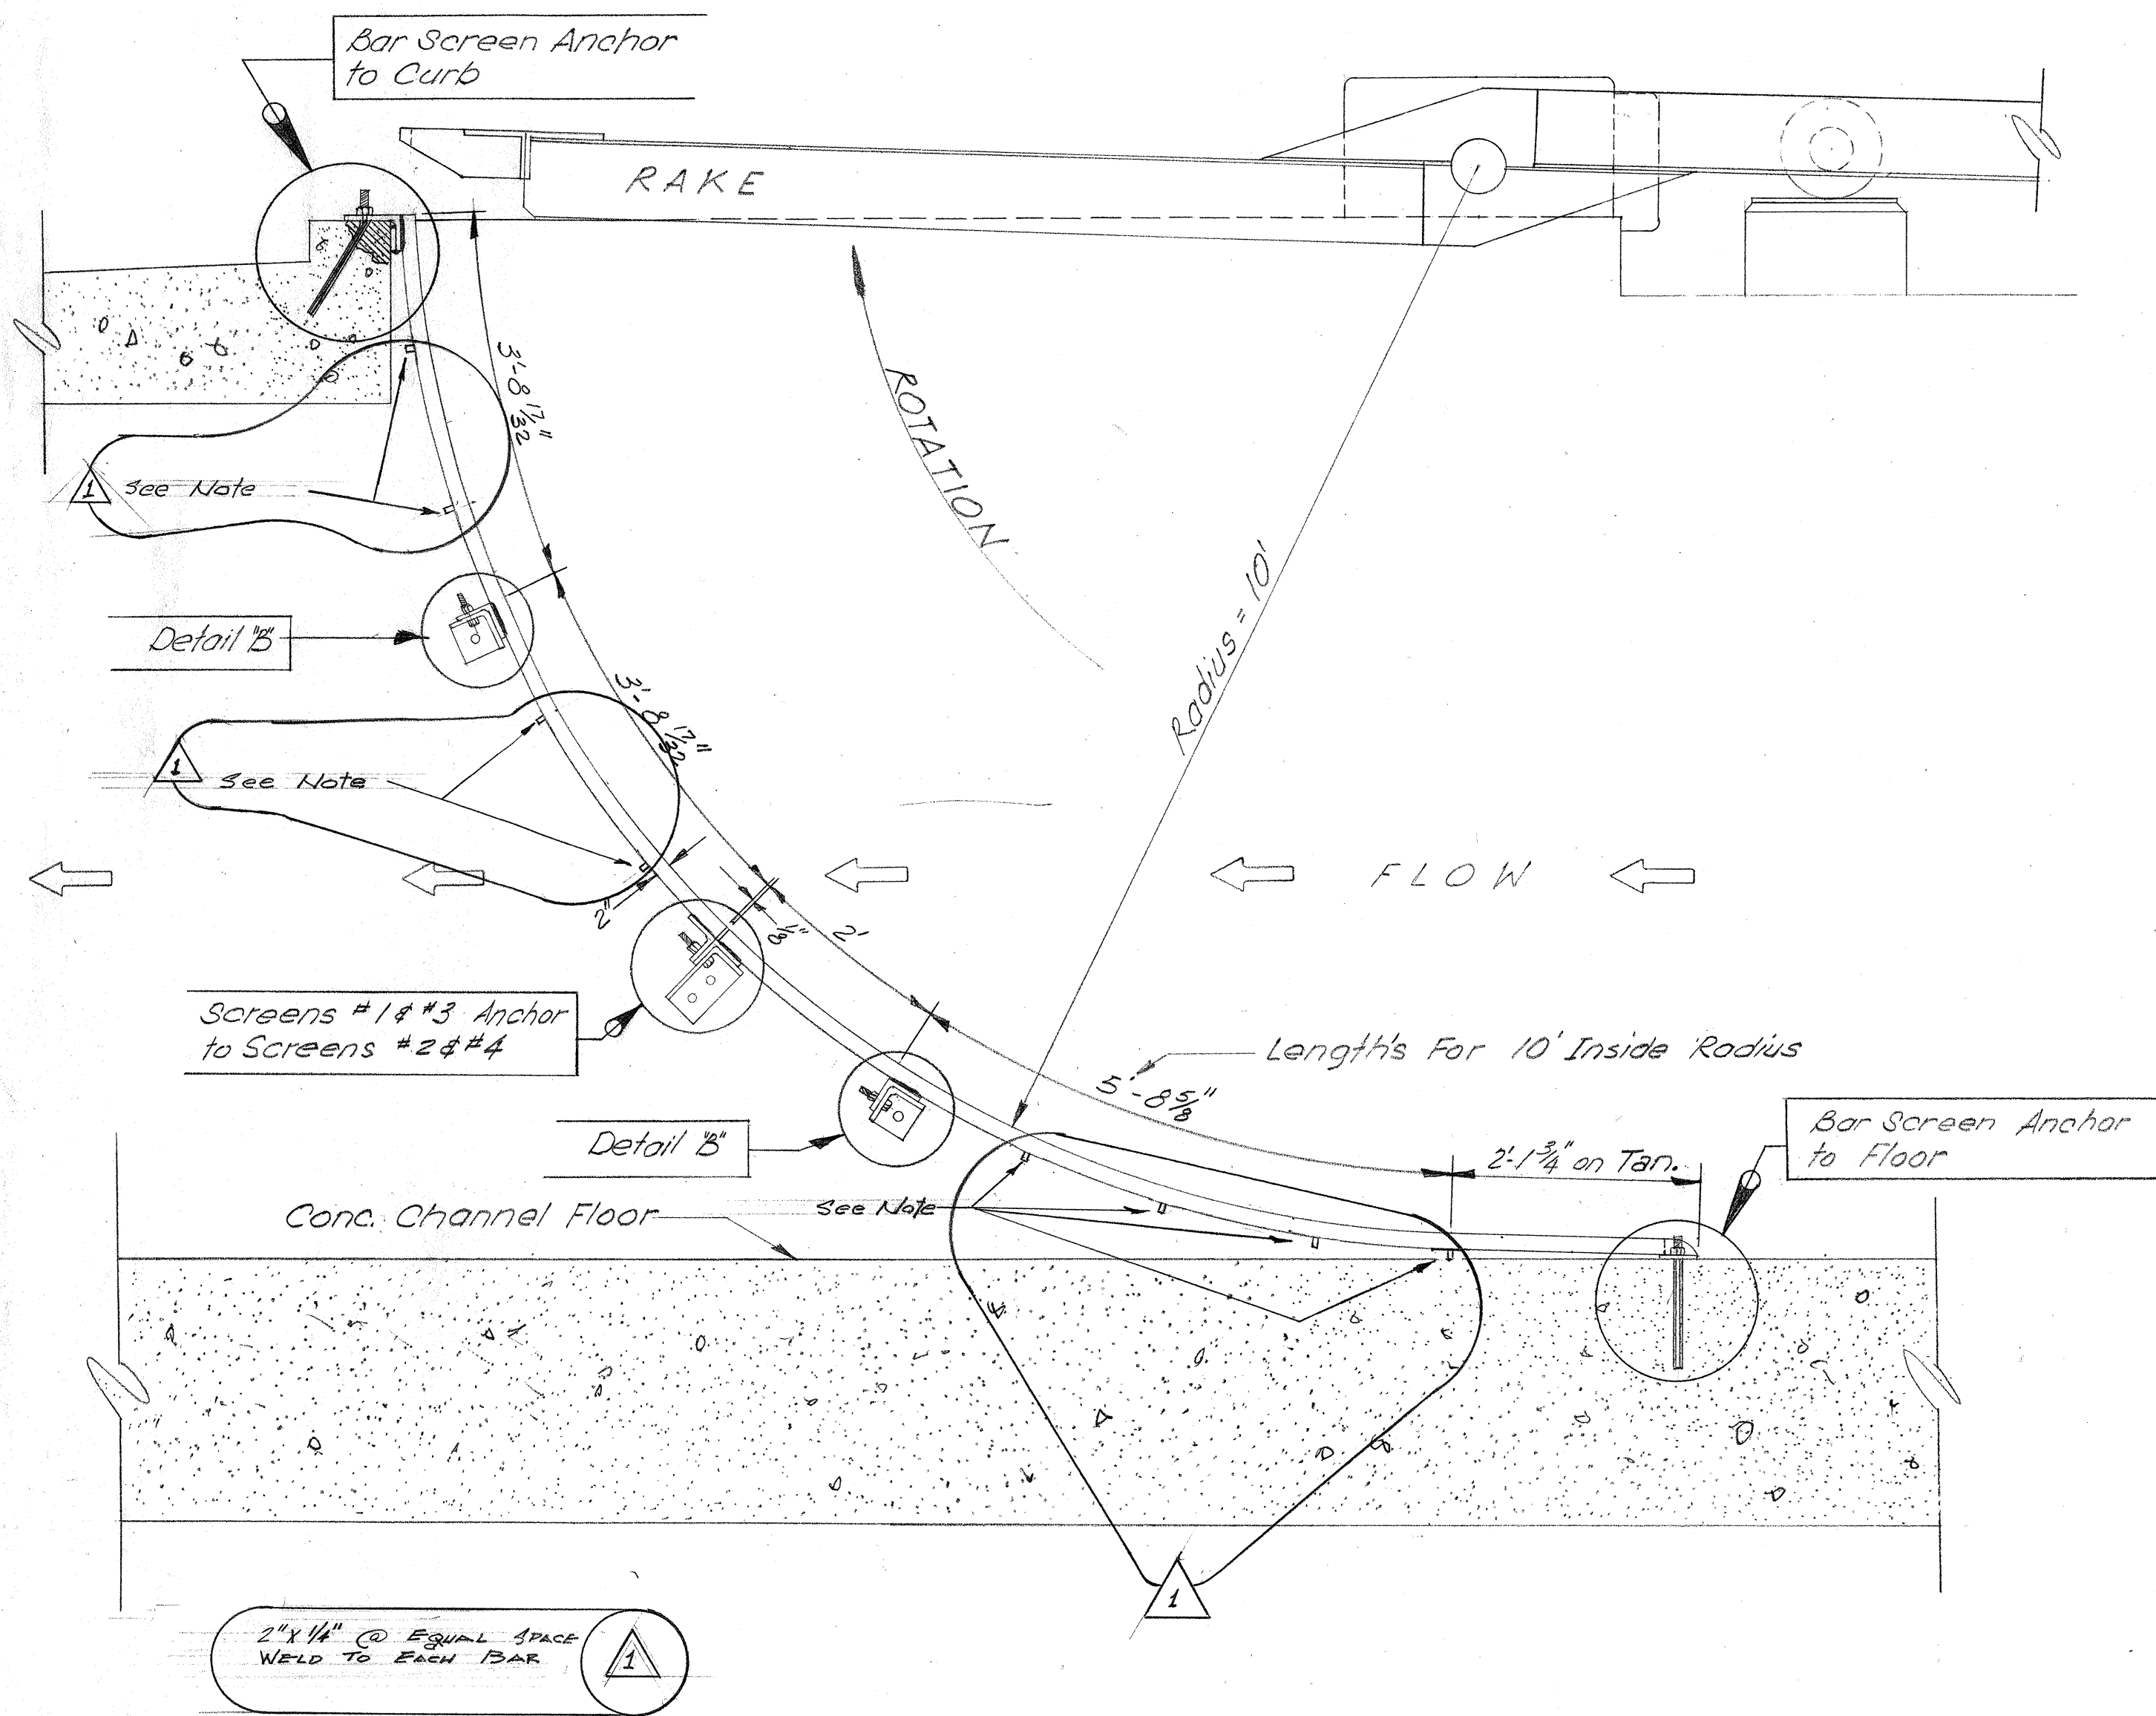

Bar Screen X-Section A-A
Not to Scale

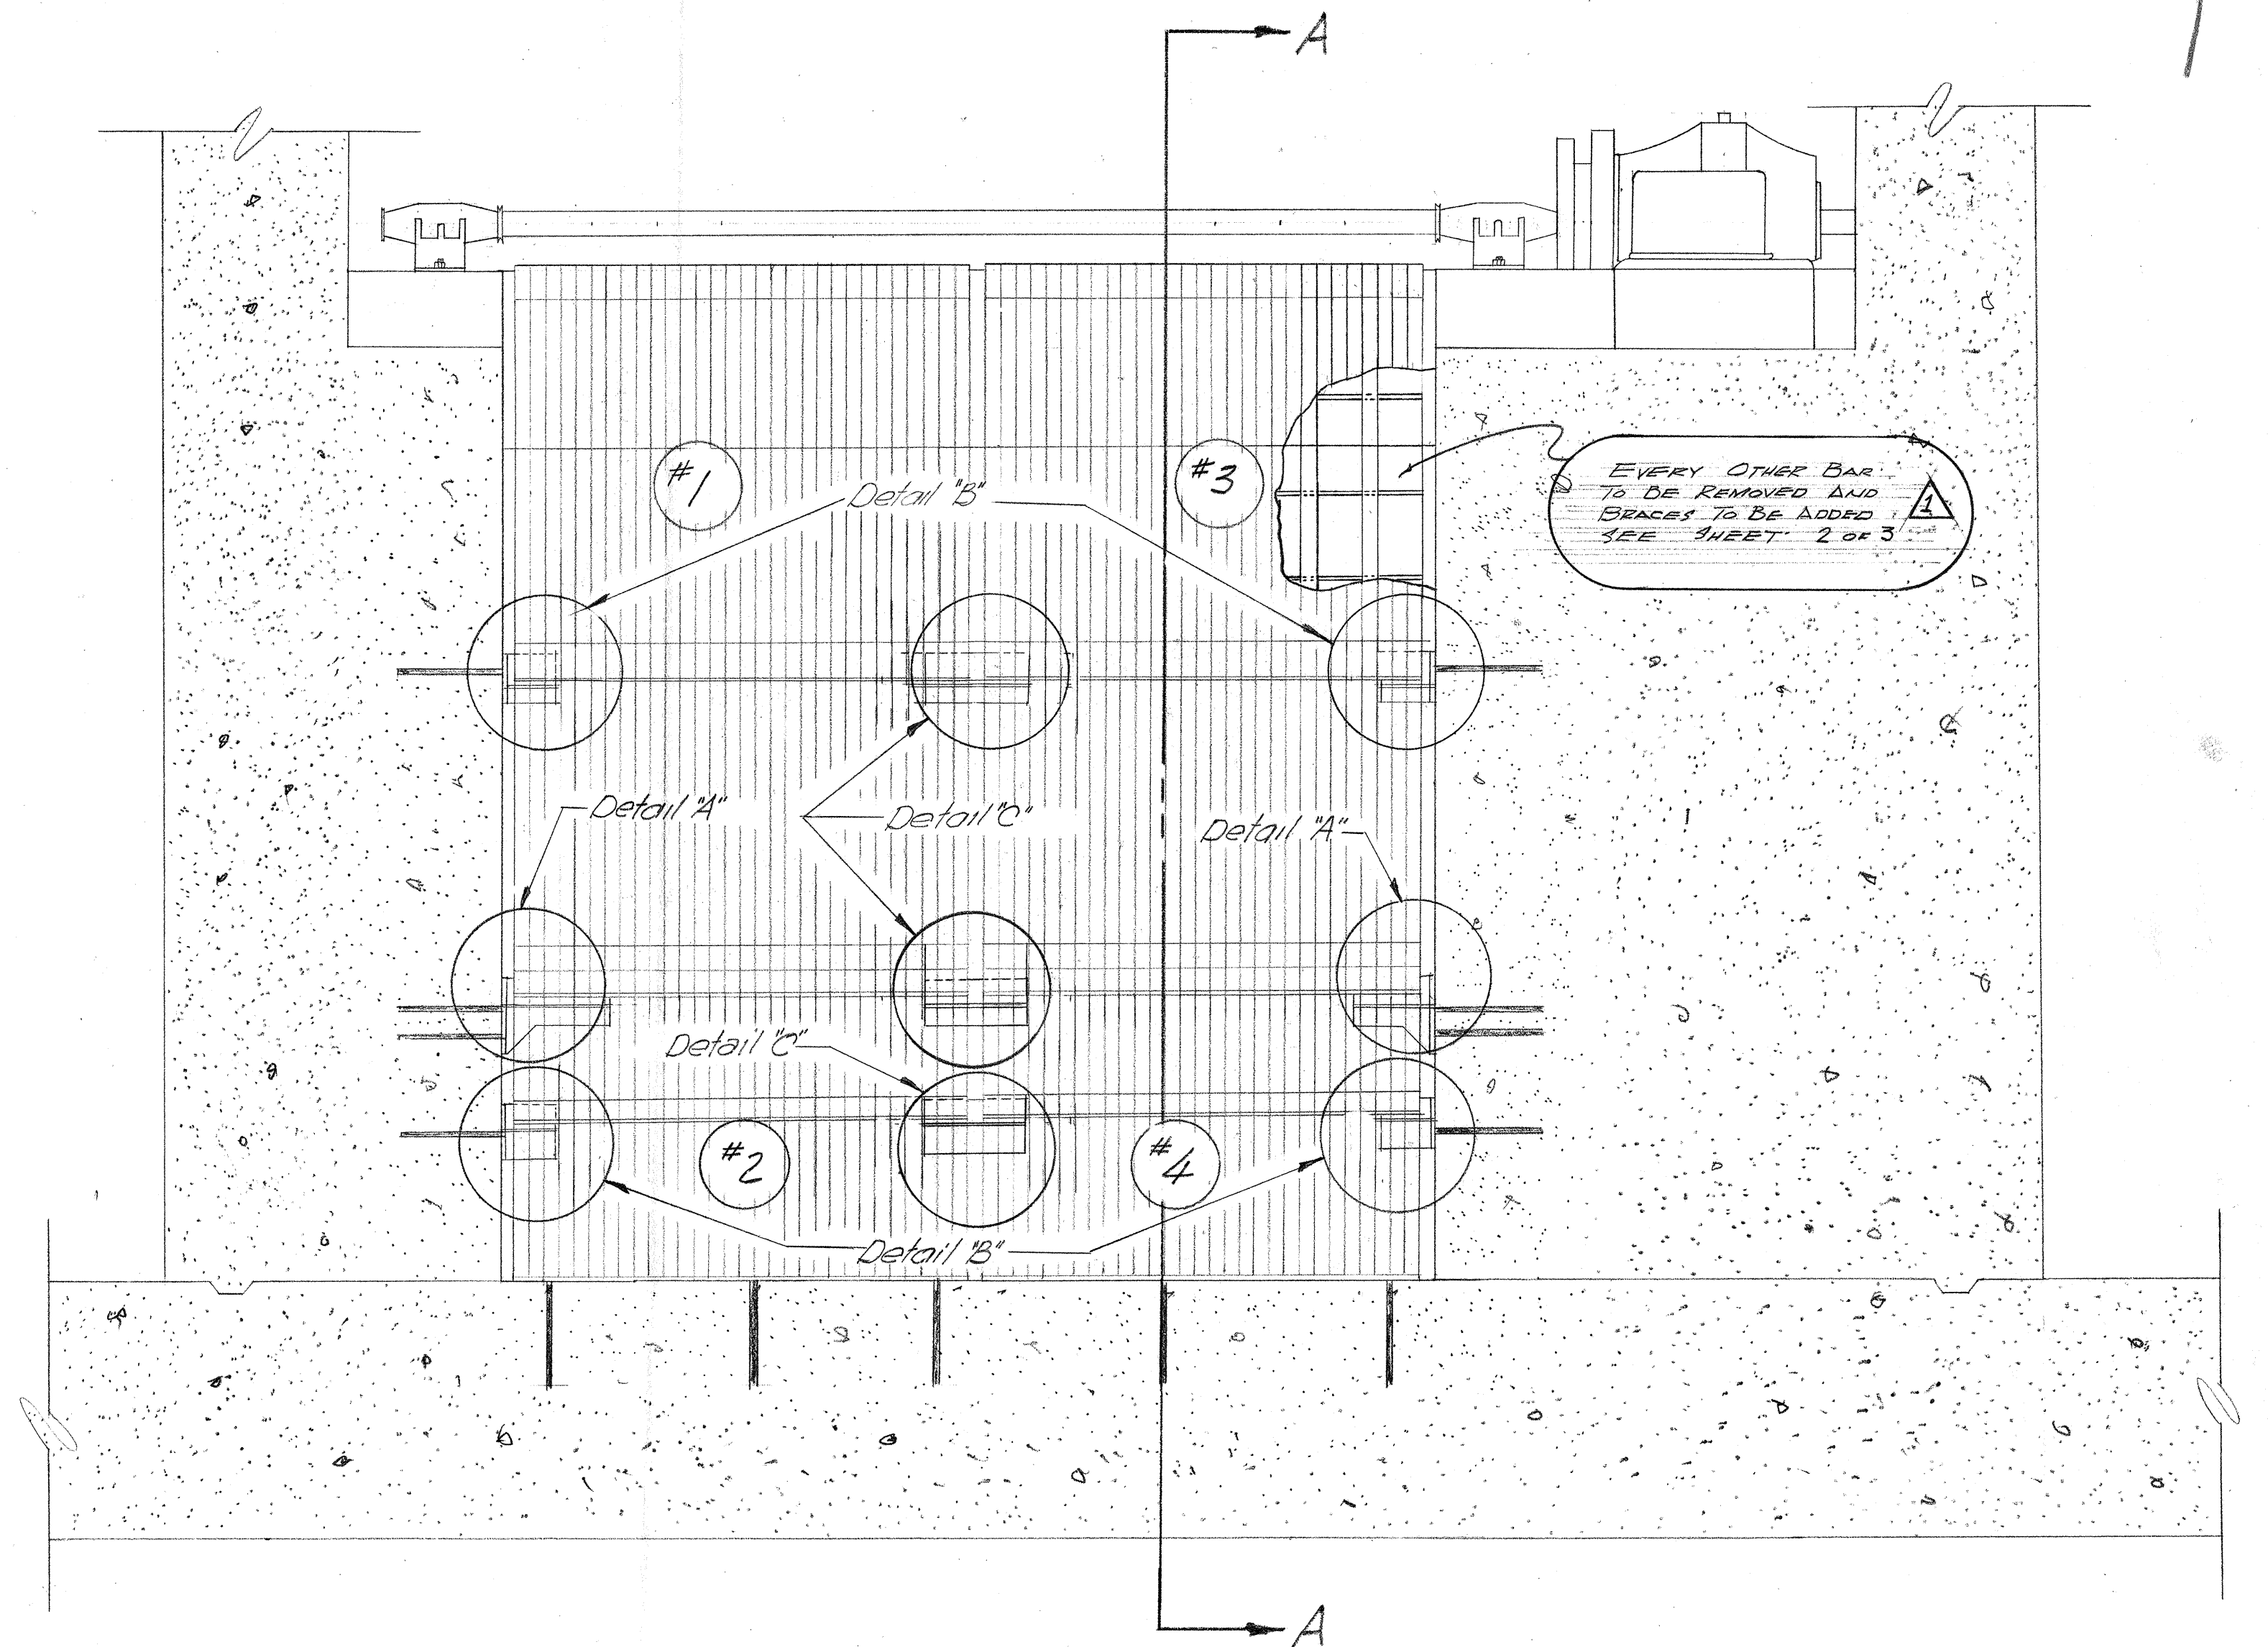

SEE NOTES & DETAILS



Bar Screen Front View
Not to Scale

1	2	3	4	5	6	7	8	9	10	11	12	13	14	15	16	17	18	19	20	21	22	23	24	25	26	27	28	29
02	7	1	3	8				0	1	6	7				0	8												


D-138

City of Albuquerque	
Dept. of Public Works Field & Design Section	
Title: Bar Screen For Storm Sewer Pump Station #32	
Drawn By: R. Velarde Date: 2-3-67	Designed By: J. R. Chapman Date: 2-17-67
Recommended By: J. R. Chapman	Approved By: W. J. Mendenhall Date: 2-17-67
Scale: As Shown	Sheet 1 of 3 Sheets

ADDED BRACES - DELETED BARS


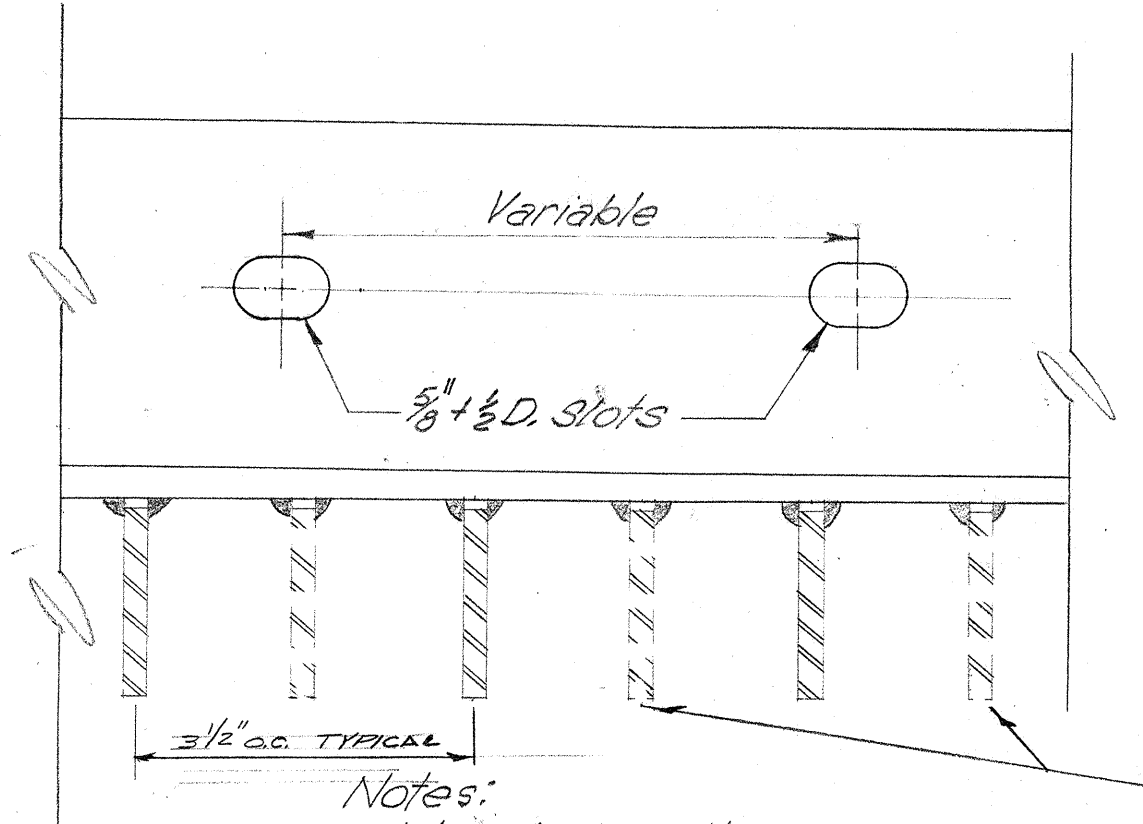
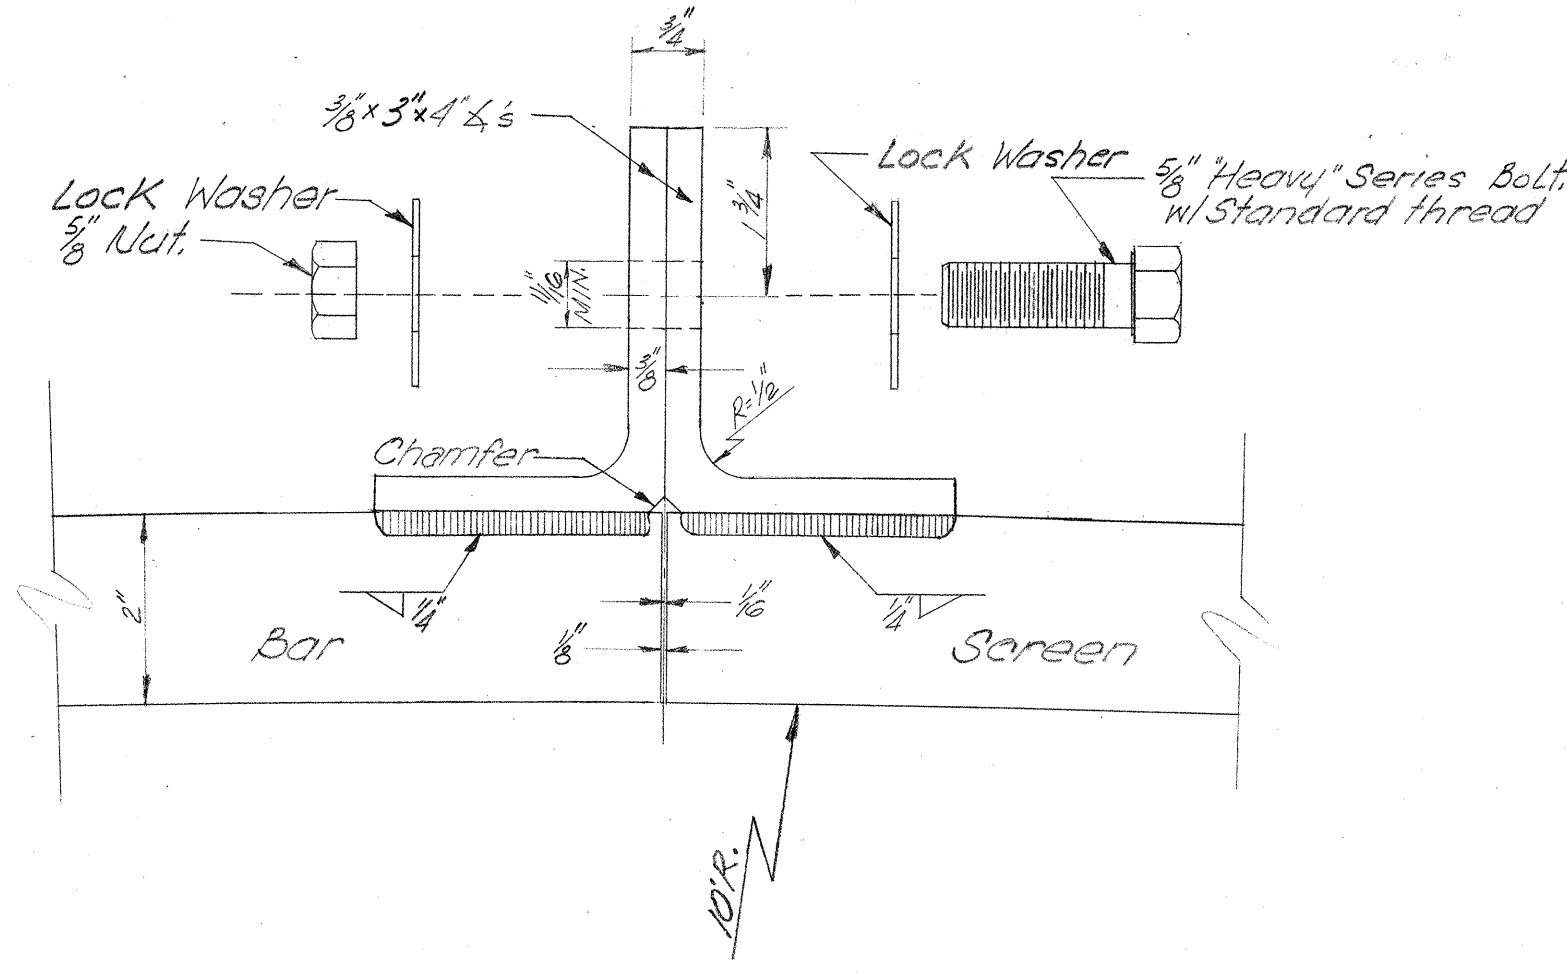


Section A-A

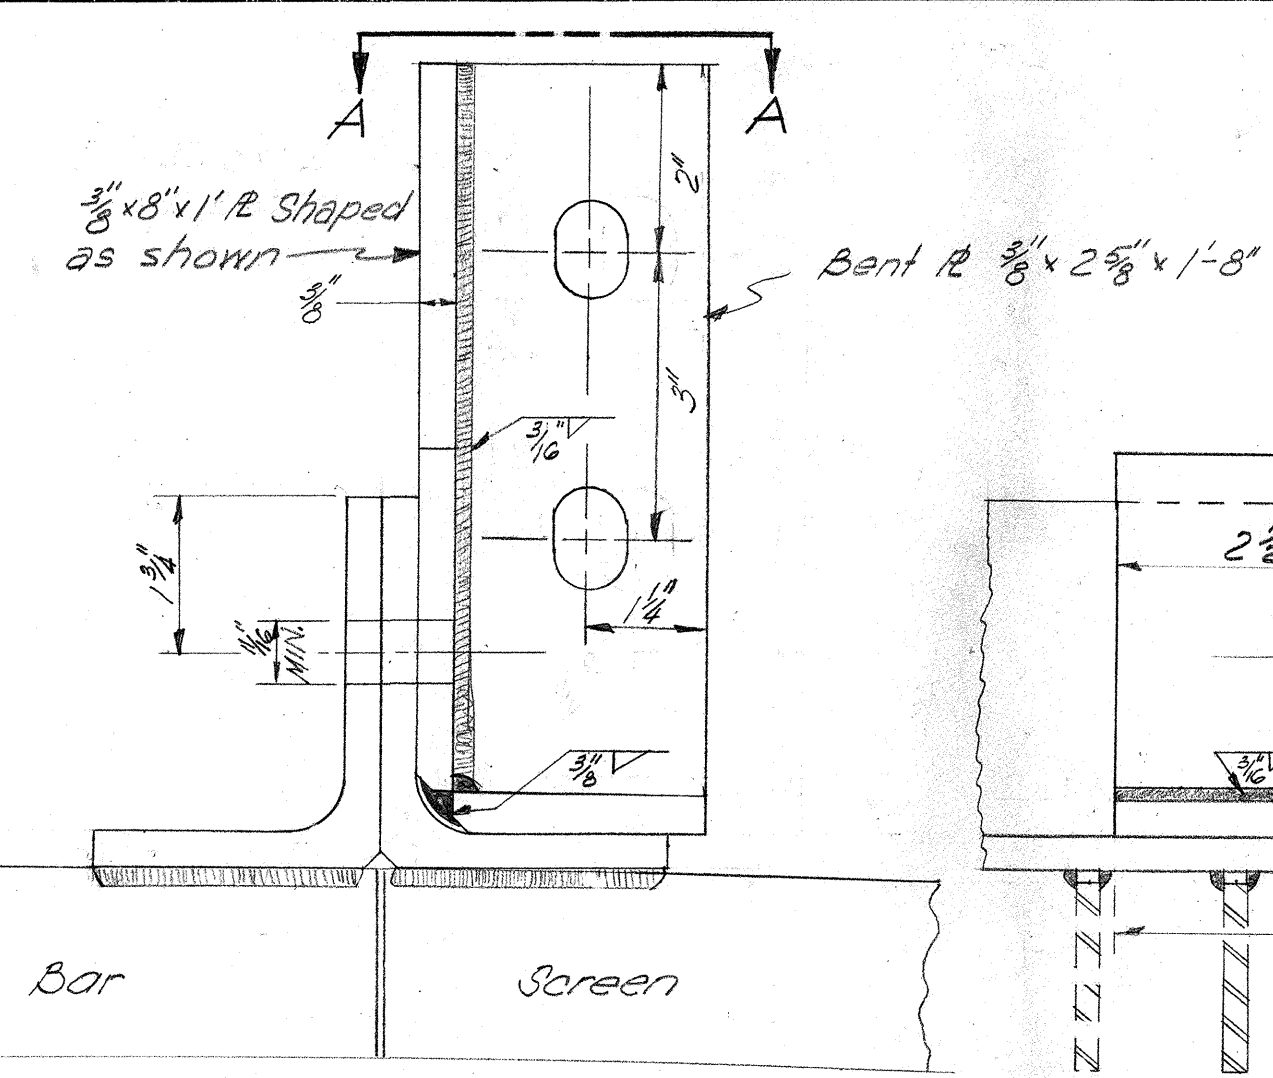





Scale 1/2"=1"

Detail "A"

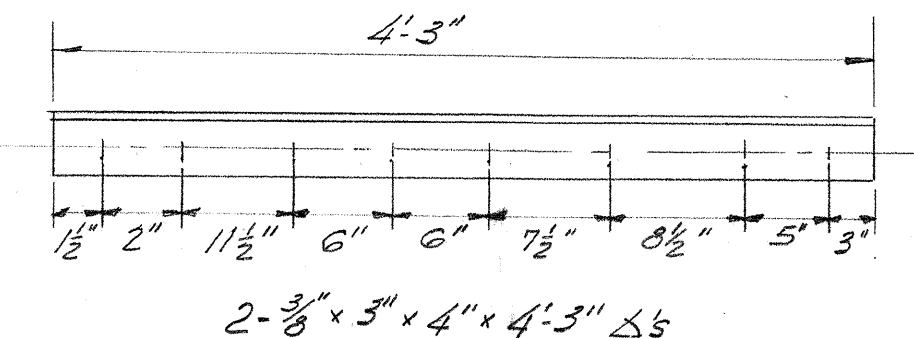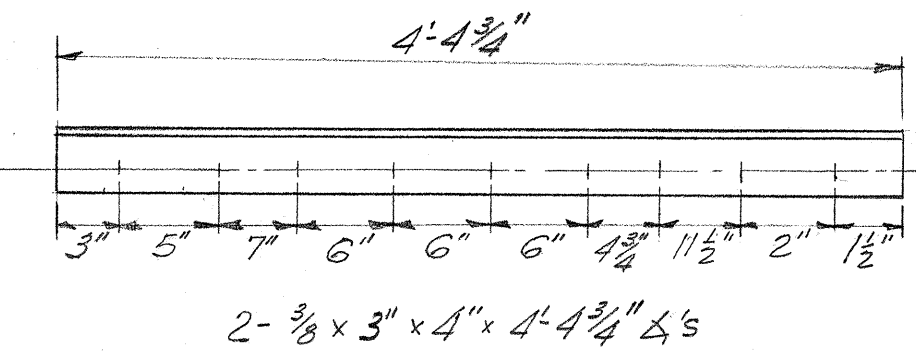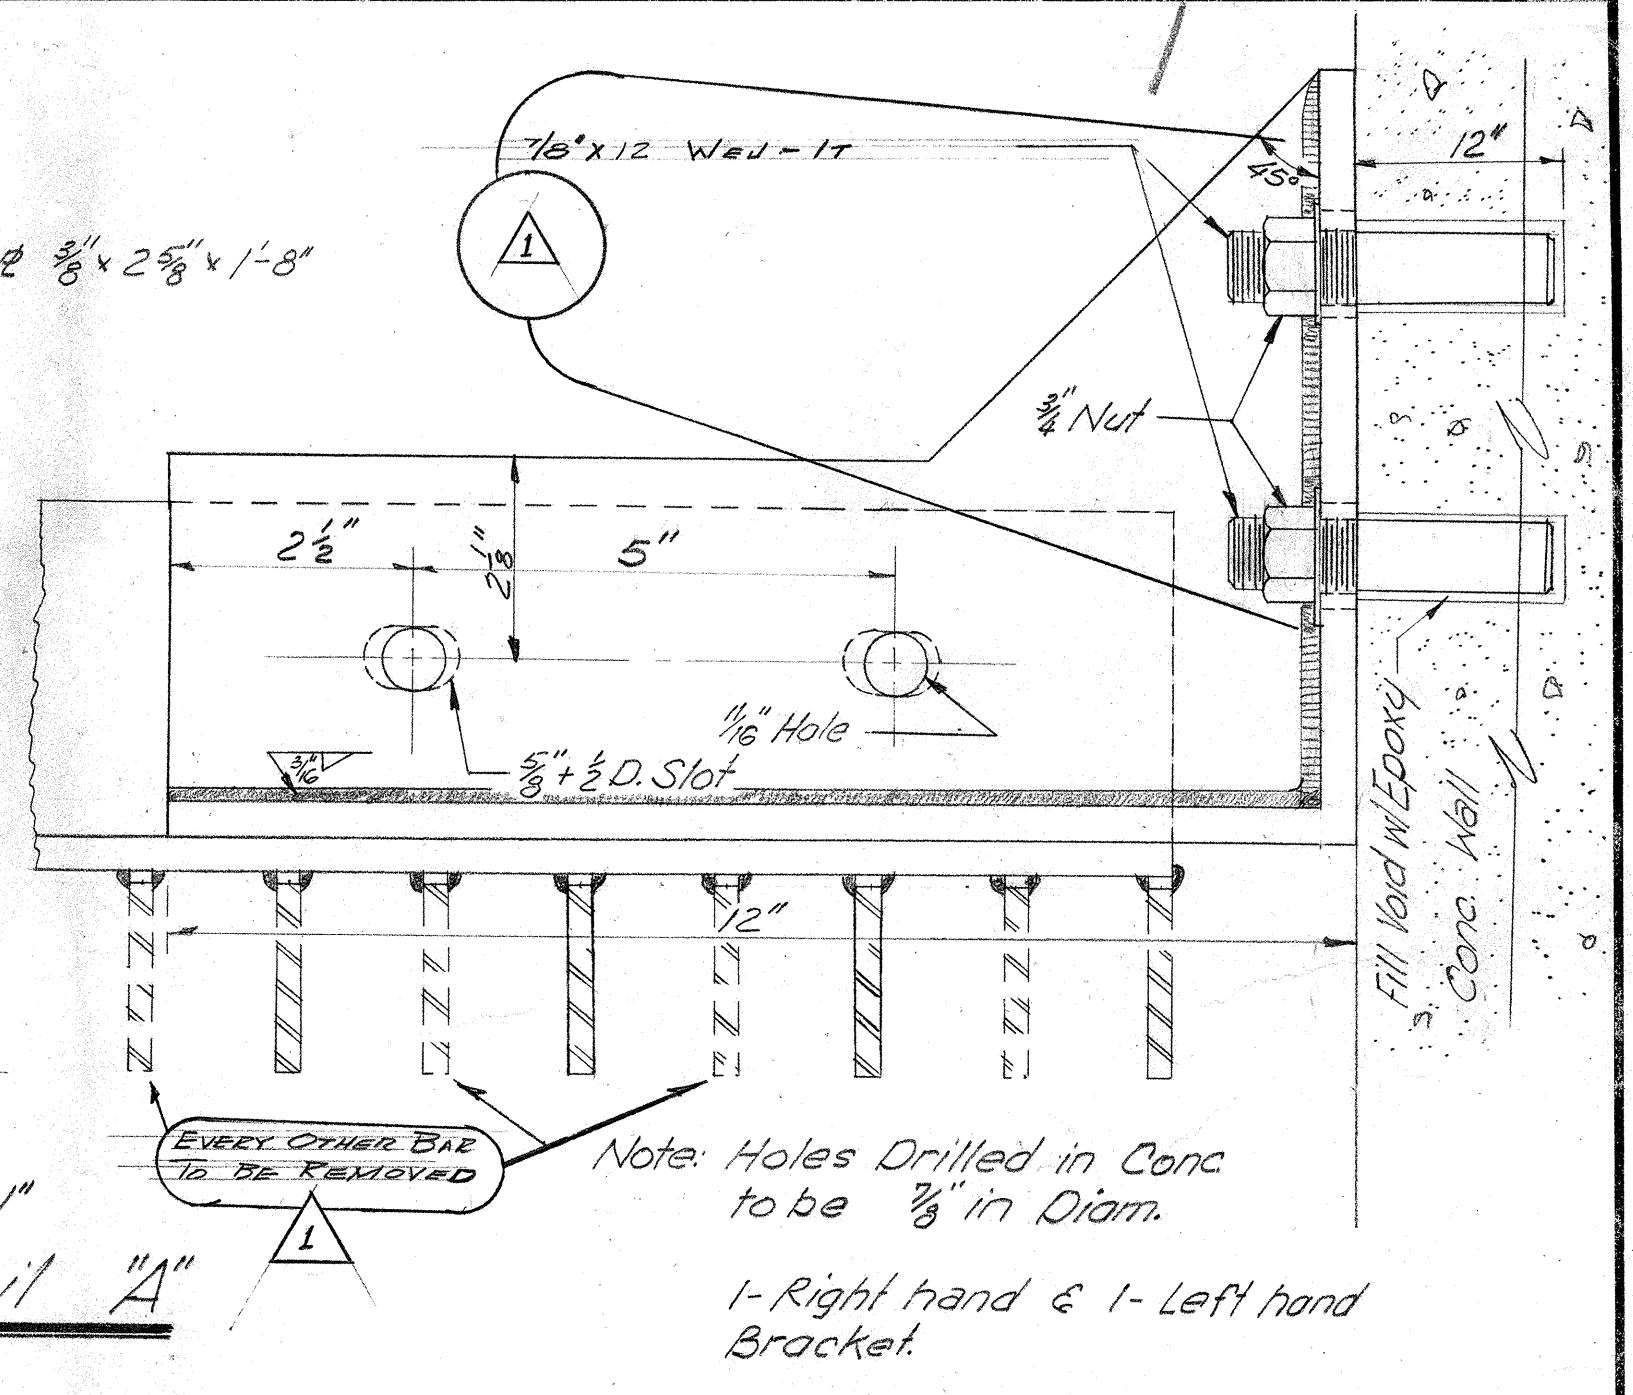


Not to Scale
Slot Hole Location

Scale 1/2"=1"
Screens No 1 & 3 Anchor to Screens No 2 & 4

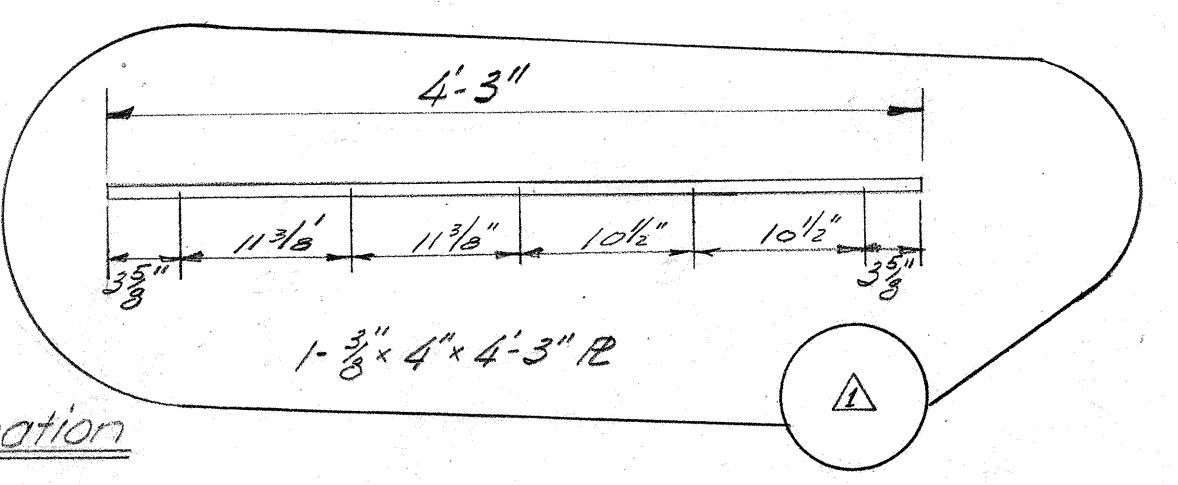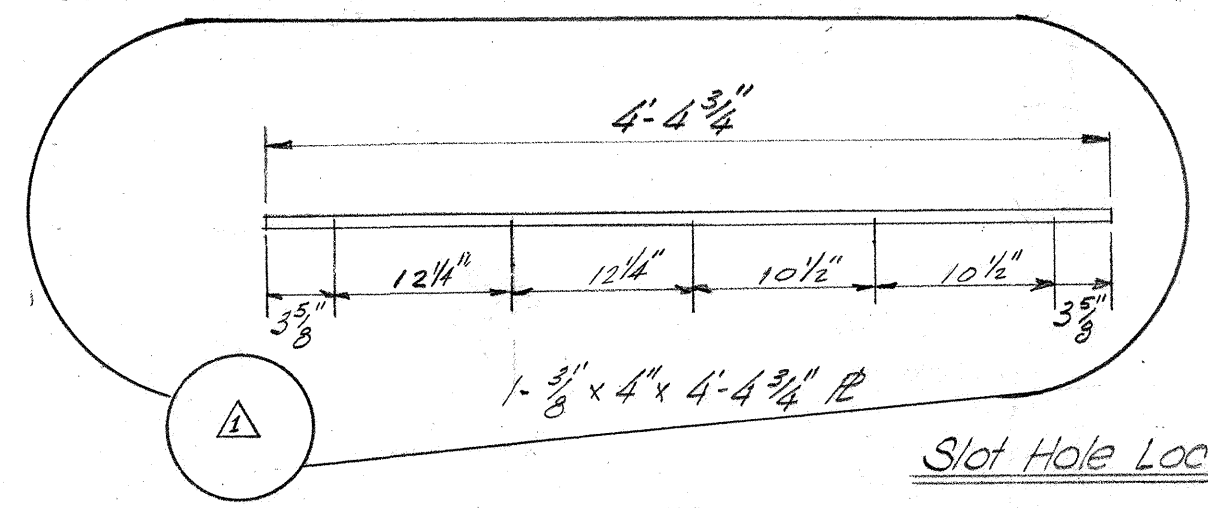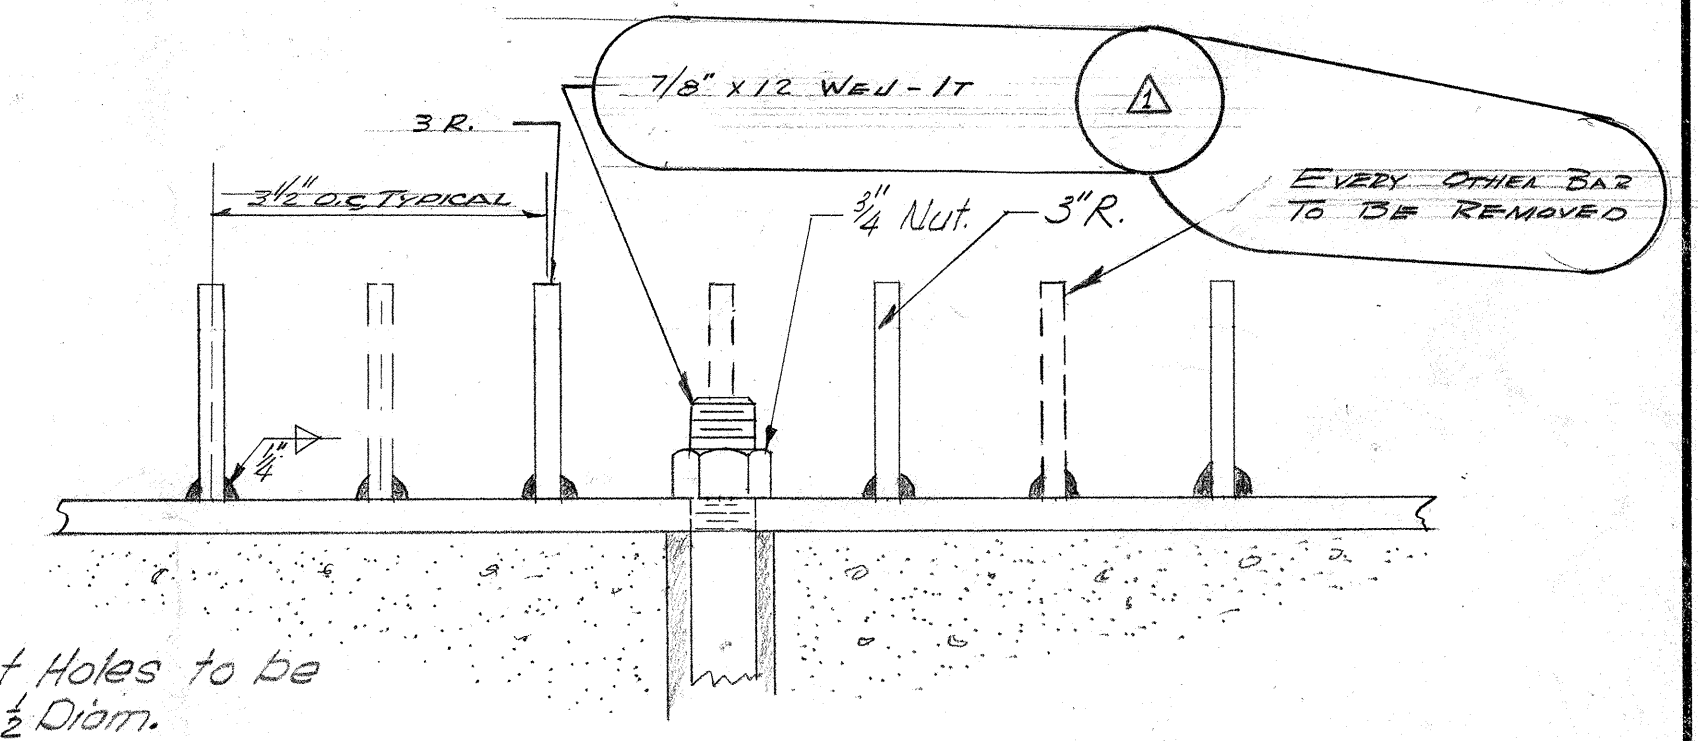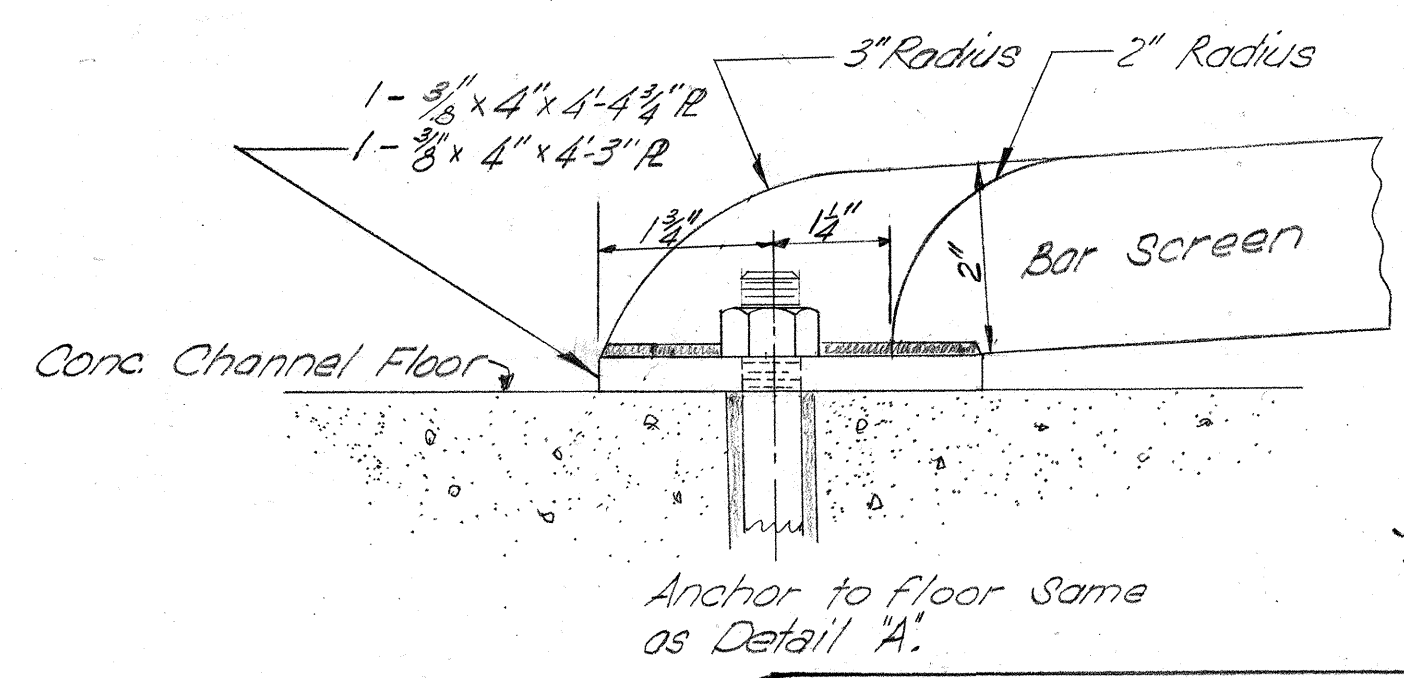

Scale 1/2"=1"
Bar Screen Anchor to Floor

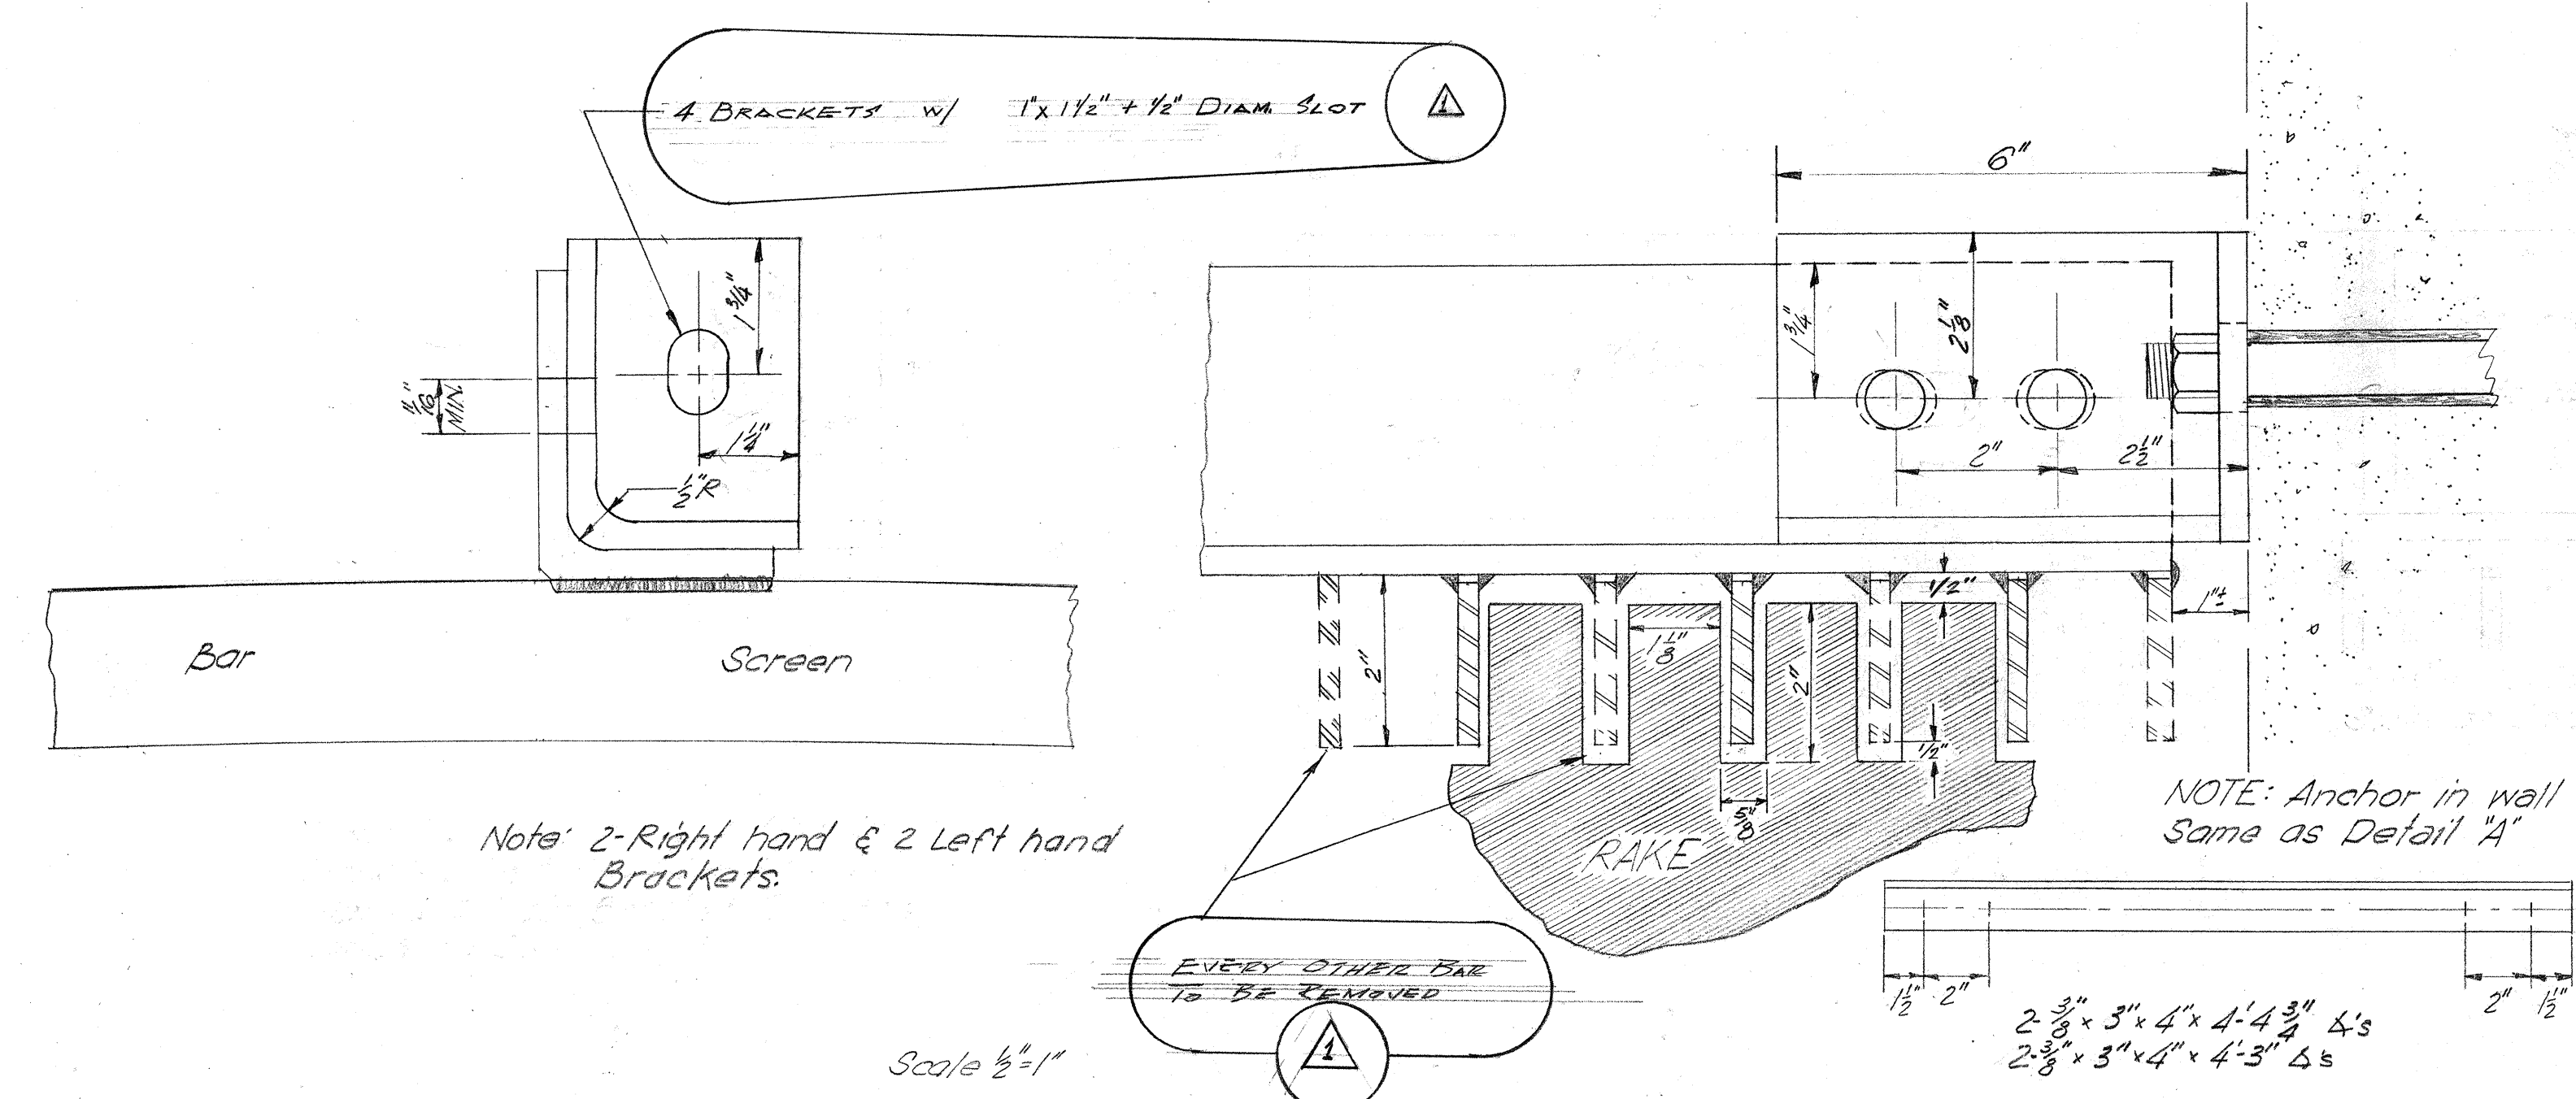

Scale 1/2"=1"
Detail "B"

Slot Hole Location - Detail "B"

D-138a

0271381016708

City of Albuquerque	
Dept. of Public Works Field & Design Section	
Title: Proposed Bar Screen For Storm Sewer Pump Station #32	
Drawn By R. Velarde Date 2-3-67	Designed By Date 2-17-67
Recommended By Date 2-17-67	Scale As Shown
Sheet 2 of 3 Sheets	

ADDED BRACES	DELETED	PARS
--------------	---------	------

