
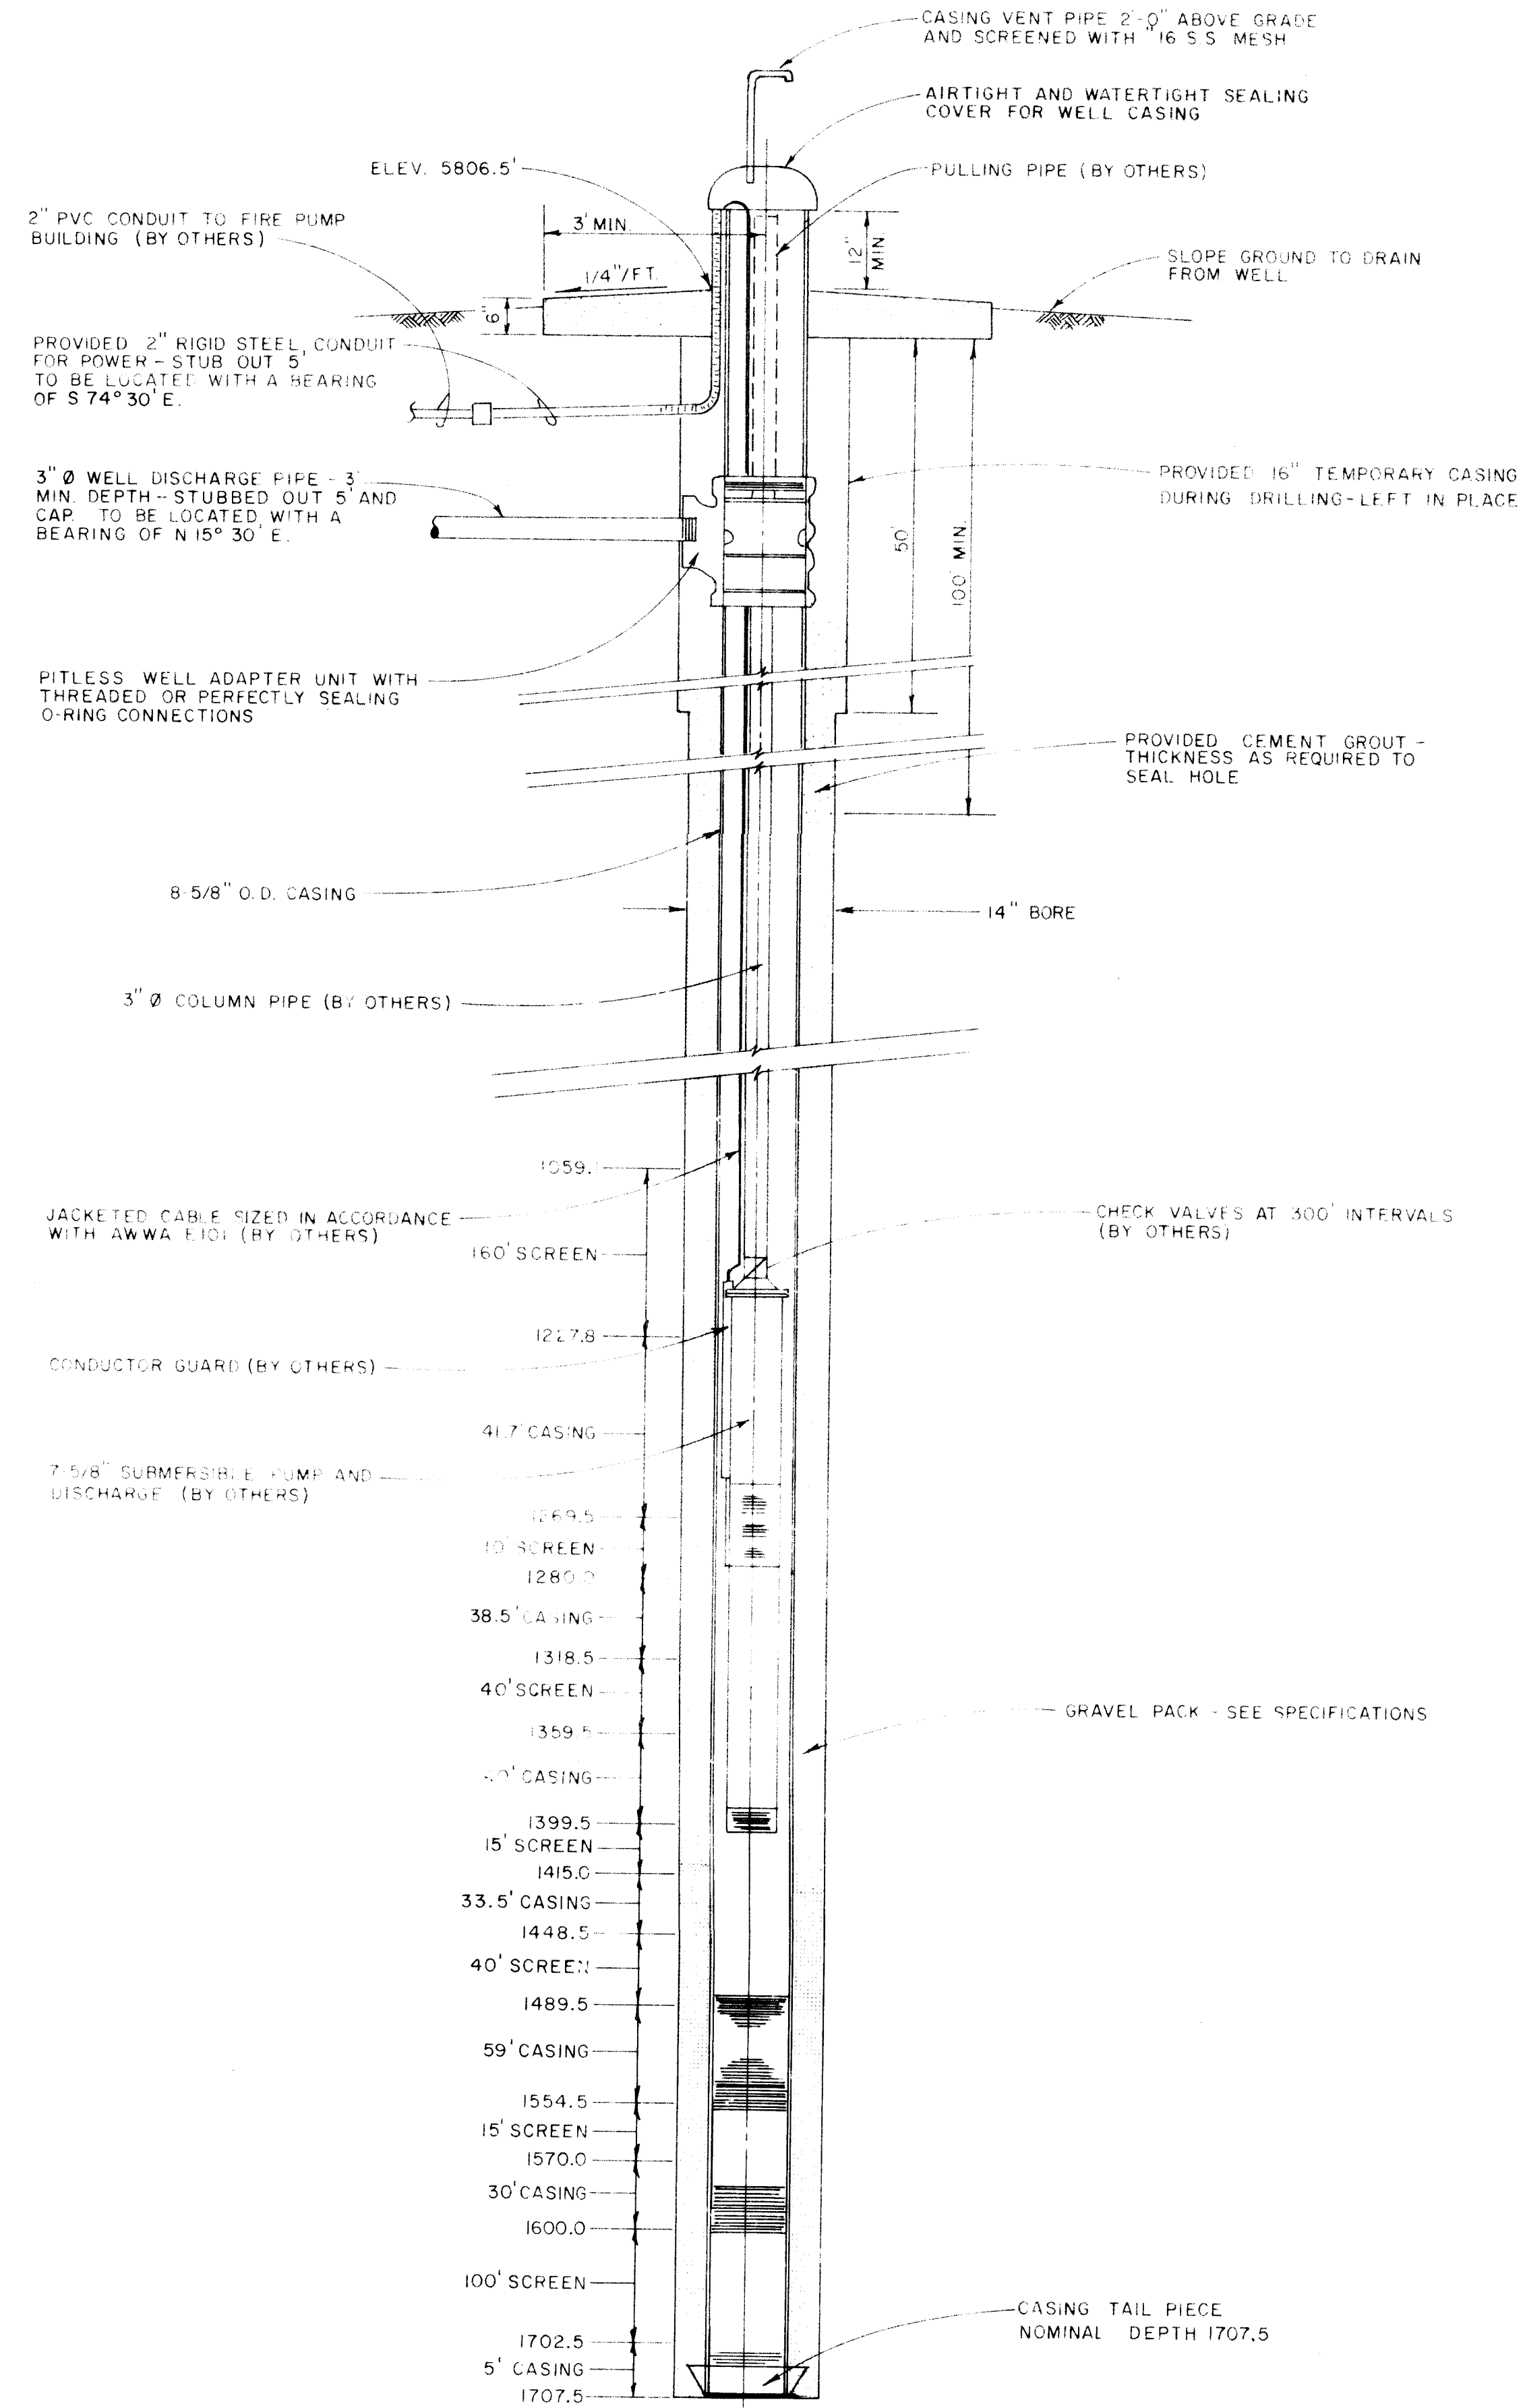
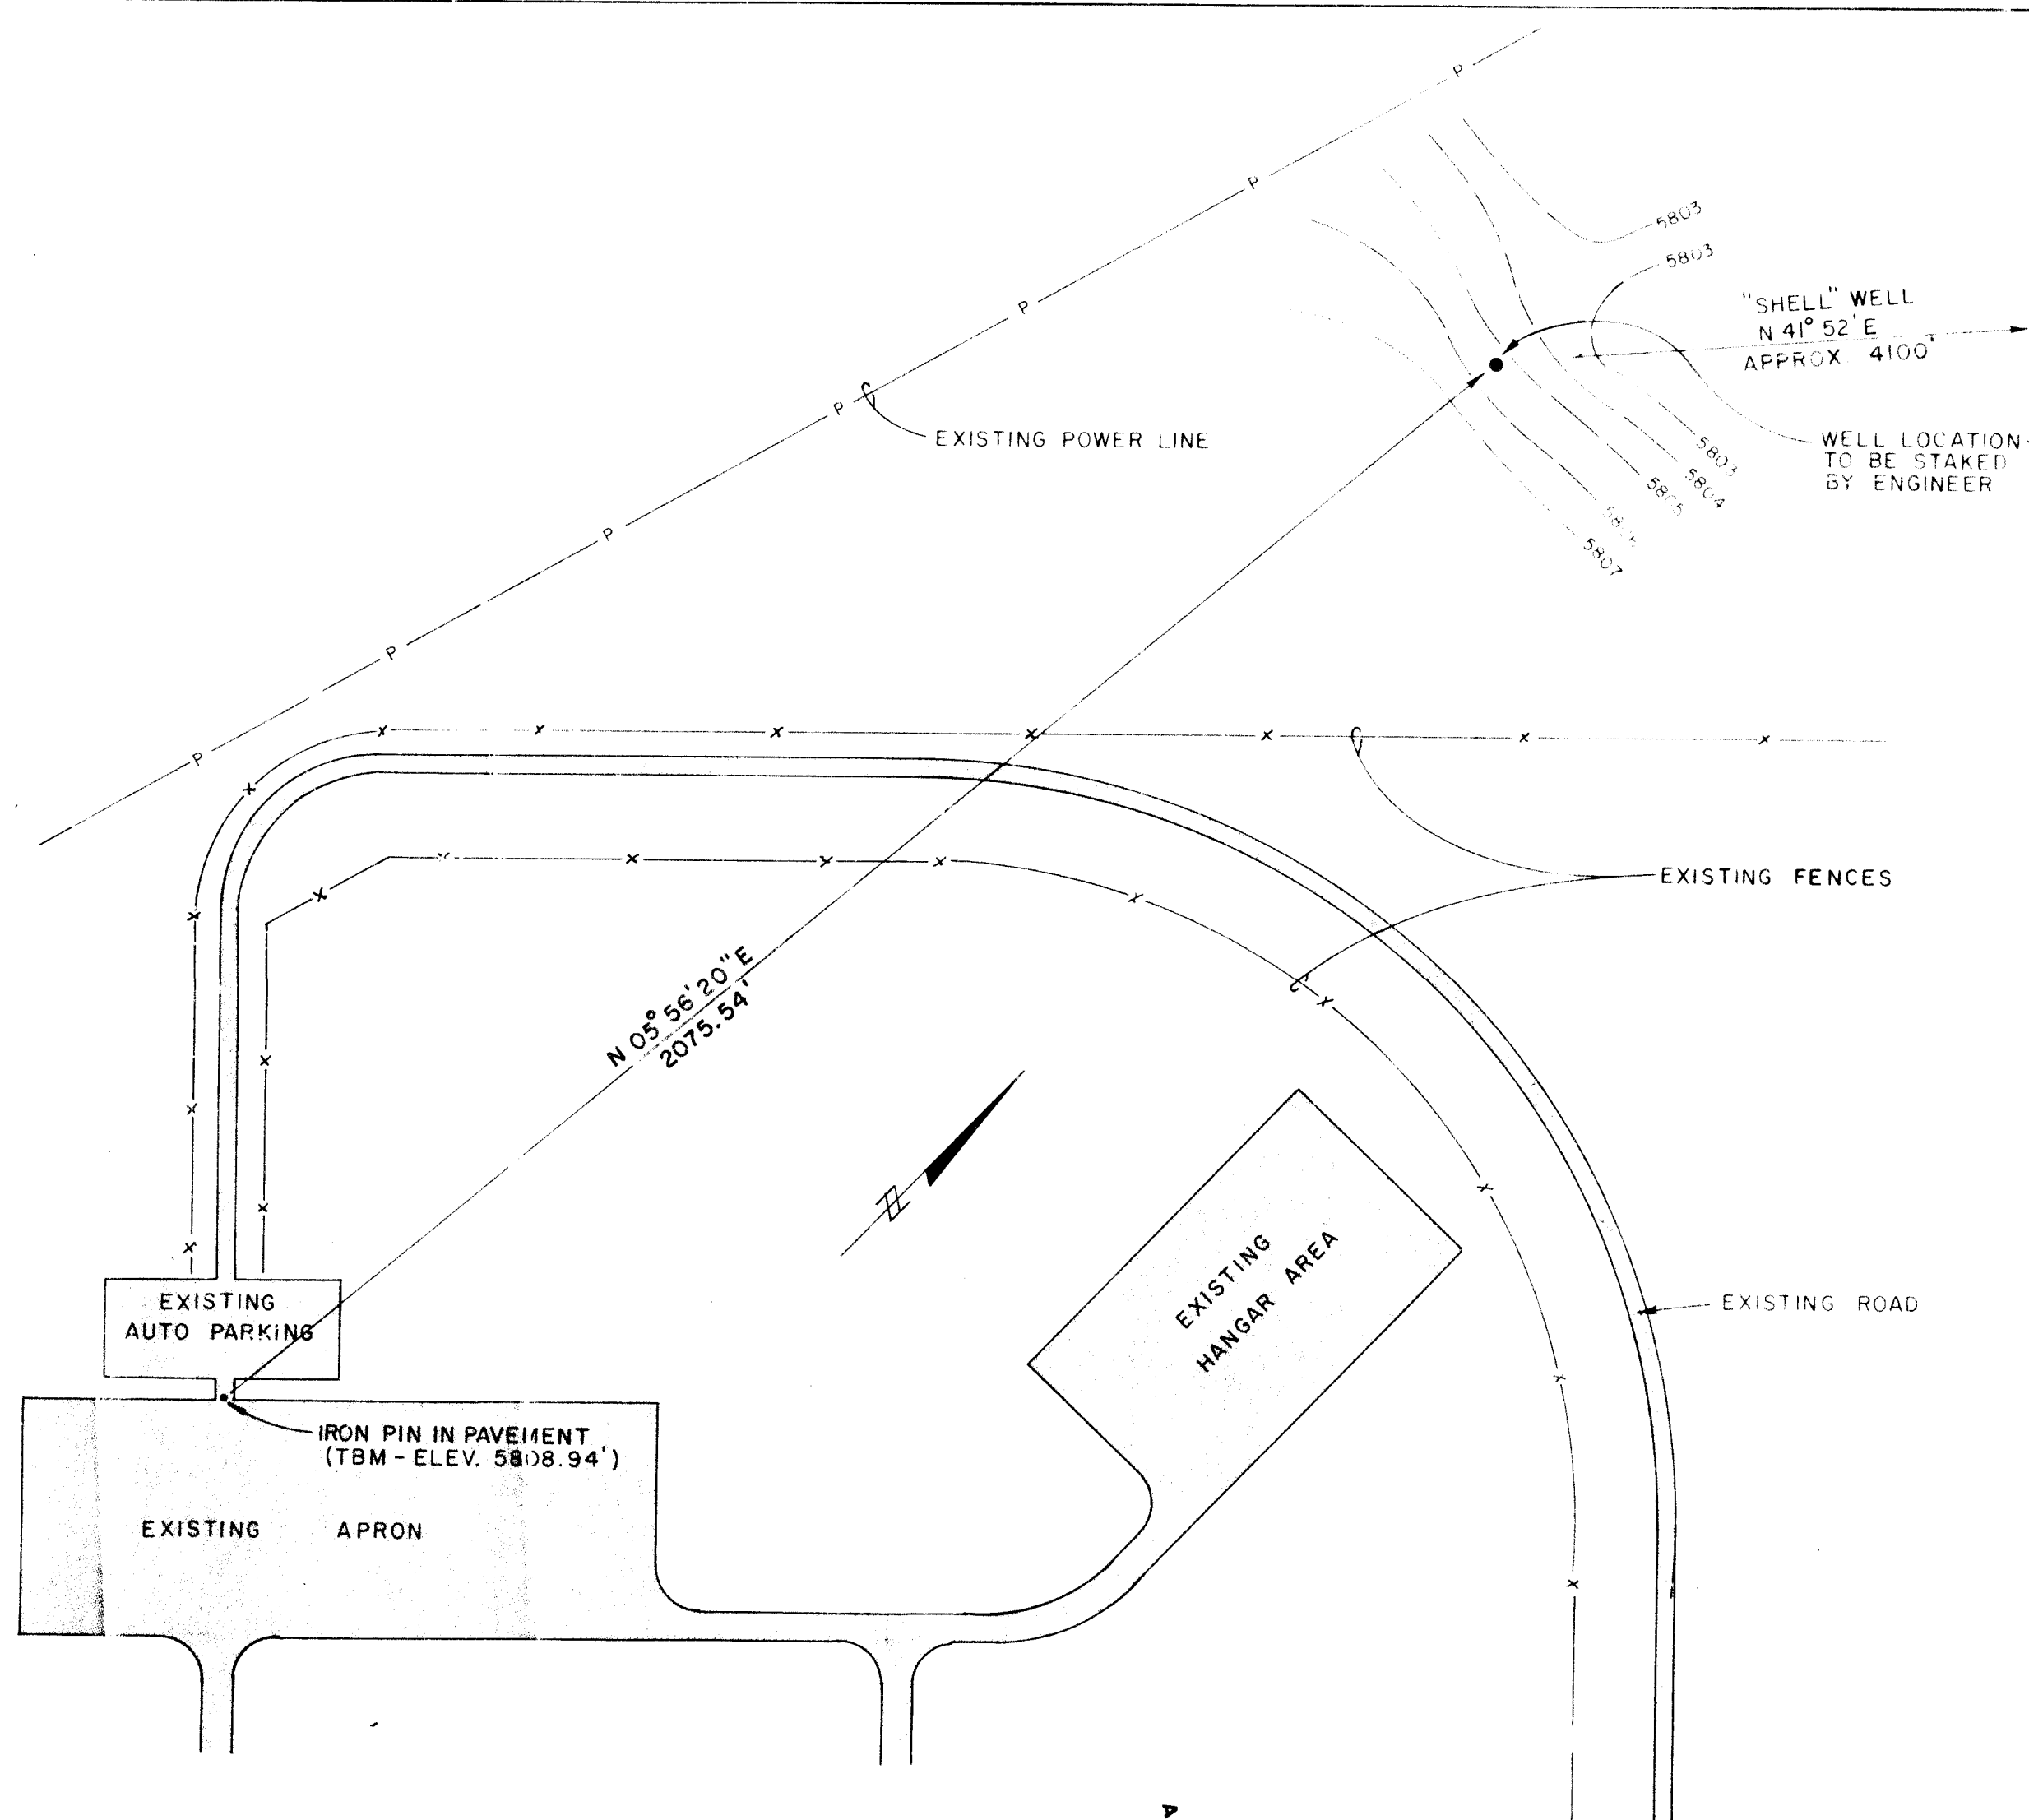


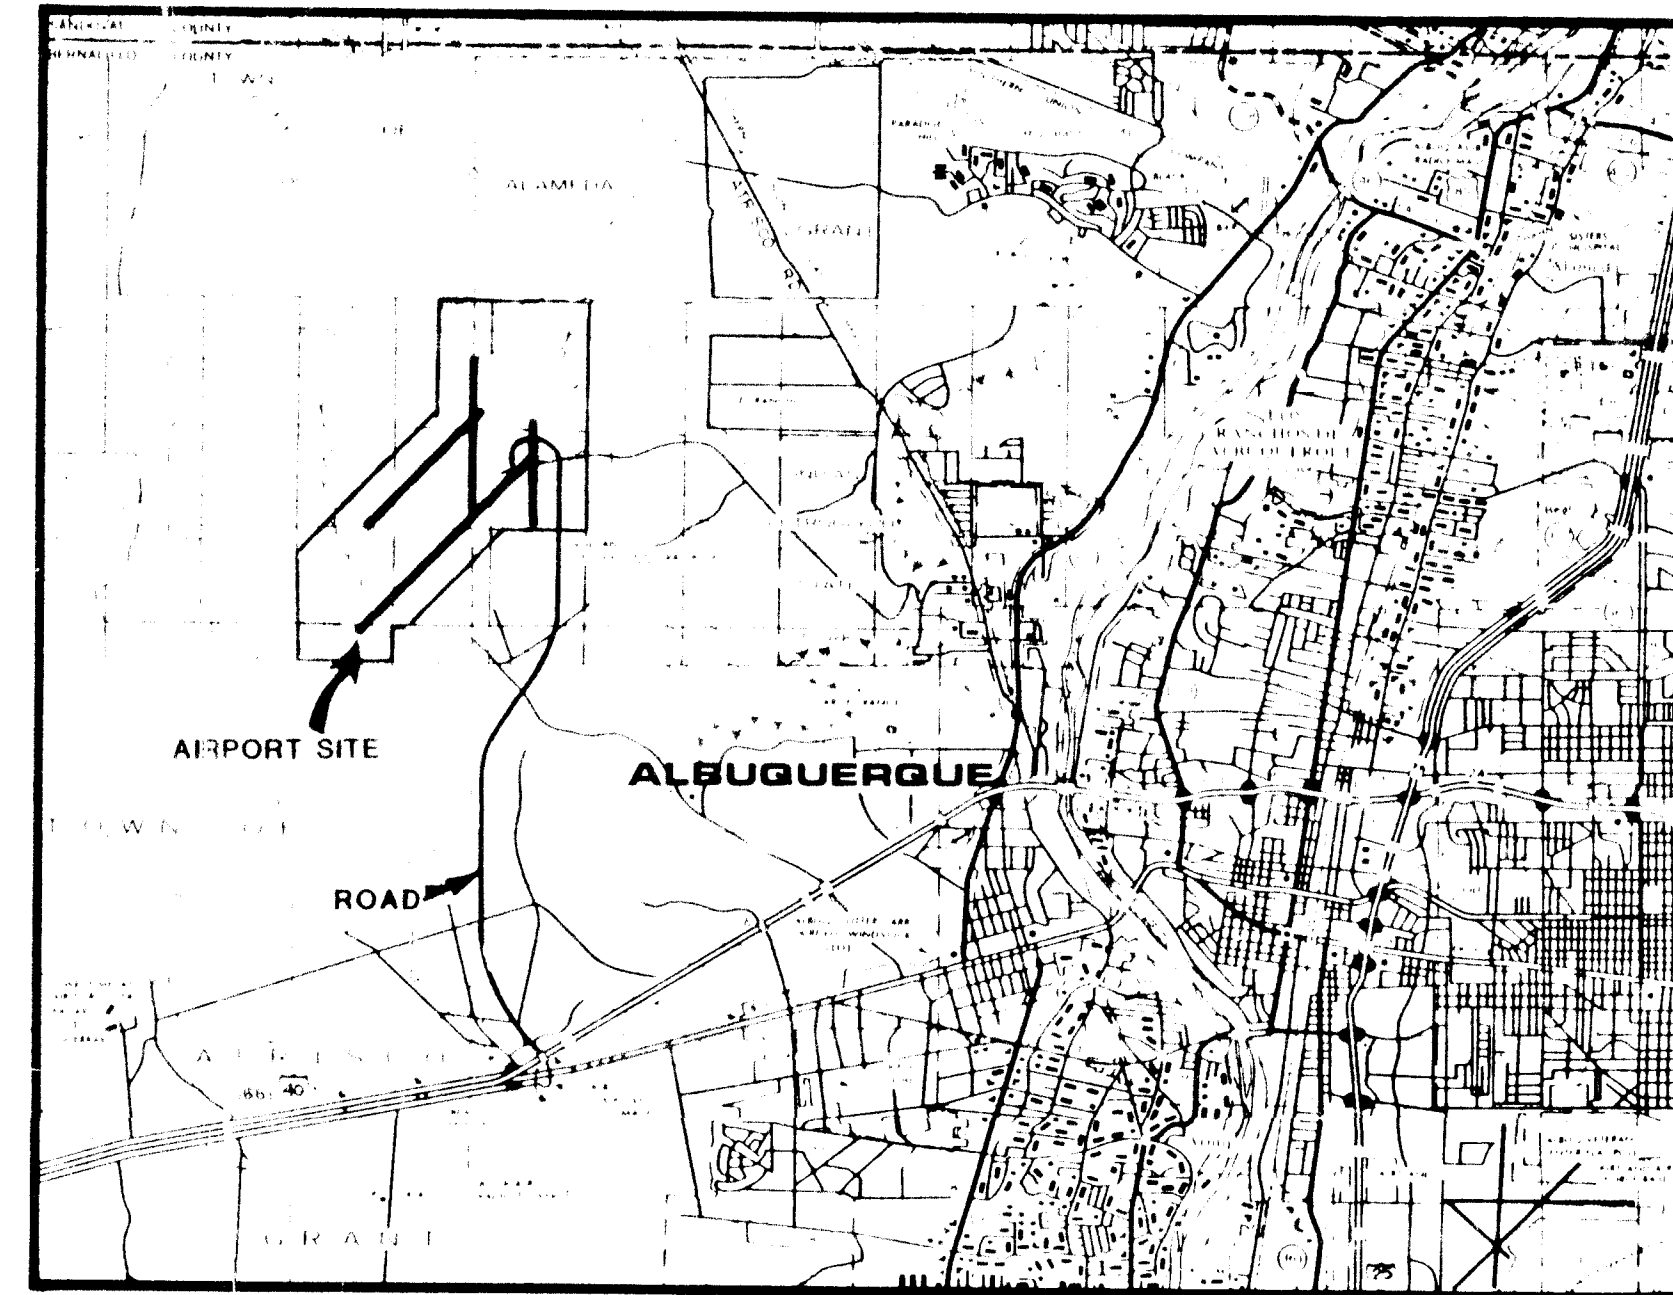

ENGINEER'S SEAL		SURVEY INFORMATION		BENCH MARKS		AS BUILT INFORMATION	
NO.	DATE	NO.	DATE	NO.	DATE	NO.	DATE
		FIELD NOTES BY: _____ NO.: _____		DOWNTOWN ALBUQUERQUE, ON THE HIGHEST OF THE GROUP OF VOLCANIC MOUNTAINS ON THE WEST MESA, STATION MARK IS STANDARD U.S.C. & G.S. TABLET, SAMPED "VULCAN 1948 B. 1949" CEMENTED IN UNILLED HOLE.		MICRO-FILM INFORMATION DATE: _____ BY: _____	
		CHECK VALVES AT 300' INTERVALS (BY OTHERS)		PROVIDED 16" TEMPORARY CASING DURING DRILLING - LEFT IN PLACE		PROVIDED CEMENT GROUT - THICKNESS AS REQUIRED TO SEAL HOLE	
REMARKS NO. DATE 1 2 3 4 5 6 7 8 9 10 11 12 26 21 39 01 85 RECONSTRUCTION DATE 3-11-85 BY David J. L... APPROVAL OF AS BUILT DRAWINGS ASS. CITY ENGINEER FIELD DATE 7-25-85		DESIGNED BY: KWC DRAWN BY: PSM CHECKED BY: DJL DATE NOV 1984 DATE NOV 1984 DATE NOV 1984		CITY OF ALBUQUERQUE MUNICIPAL DEVELOPMENT DEPARTMENT ENGINEERING DIVISION		TITLE: NEW WATER WELL	
APPROVALS City Engineer: [Signature] ACE Design: [Signature] ACE Hydrology: [Signature]		APPROVALS ENGINEER: [Signature] DATE: 11/14/84 Liquid Waste: N/A Traffic: N/A Water: [Signature]		EDA PROJECT NO. 08-01-024.0 DATE: 11/14/84		DATE: 11/14/84	
DRAWING NO. 2139		MAP NO. E-7		SHEET 1 OF 1		DATE: 11/14/84	