


PIÑO ARROYO CORRIDOR
IMPROVEMENTS-PHASE I

DESCRIPTION	INDEX	SHEET No.
TITLE SHEET		1
LAYOUT PLAN		2
ARROYO CHANNELIZATION PLAN & PROFILE		
STA 30+40 TO STA 34+00		3
STA 34+00 TO STA 45+00		4
STA 45+00 TO STA 56+00		5
STA 56+00 TO STA 67+71.49		6
STA 67+71.49 TO STA 78+35.62		7
STA 78+35.62 TO EOP		8
TYPICAL CHANNEL SECTION		9
CROSSING STRUCTURE DETAILS		10
CONCRETE RETAINING WALL DETAILS		11
TRANSITION STRUCTURE RETAINING WALLS		12
TRANSITION STRUCTURE RETAINING WALLS		13
CHANNEL DETAILS		14
SAN ANTONIO DRIVE NE PLAN & PROFILE		
STA 43+00 TO STA 54+00		15
STA 54+00 TO STA 64+66.62		16
STA 64+66.62 TO STA 75+47.54		17
STA 75+47.54 TO EOP		18
CROSS STREET, JOYCE DRIVE NE & LEONA STREET NE		19
LOUISIANA BOULEVARD NE PLAN & PROFILE		20
SAN ANTONIO PLACE NE PLAN & PROFILE		21
WYOMING BOULEVARD NE PLAN & PROFILE		22
SAN ANTONIO DRIVE STREET LIGHTING & SIGNALIZATION PLANS		23
SAN ANTONIO DRIVE STREET LIGHTING & SIGNALIZATION PLAN & DETAILS		24
TYPICAL STREET SECTIONS - SAN ANTONIO DRIVE NE		25
TYPICAL STREET SECTIONS - WYOMING BLVD. & SAN PEDRO DR. NE		26
TYPICAL STREET SECTIONS		27
LOUISIANA BOULEVARD NE STORM DRAIN PLAN & PROFILE		28
WYOMING BOULEVARD NE STORM DRAIN PLAN & PROFILE		29
LOUISIANA BOULEVARD NE WATERLINE RELOCATION PLAN & PROFILE		30
WYOMING BOULEVARD NE WATERLINE PLAN & PROFILE		31
TRAFFIC CONTROL DETAILS		32
TRAFFIC CONTROL DETAILS		33
TRAFFIC CONTROL DETAILS		34

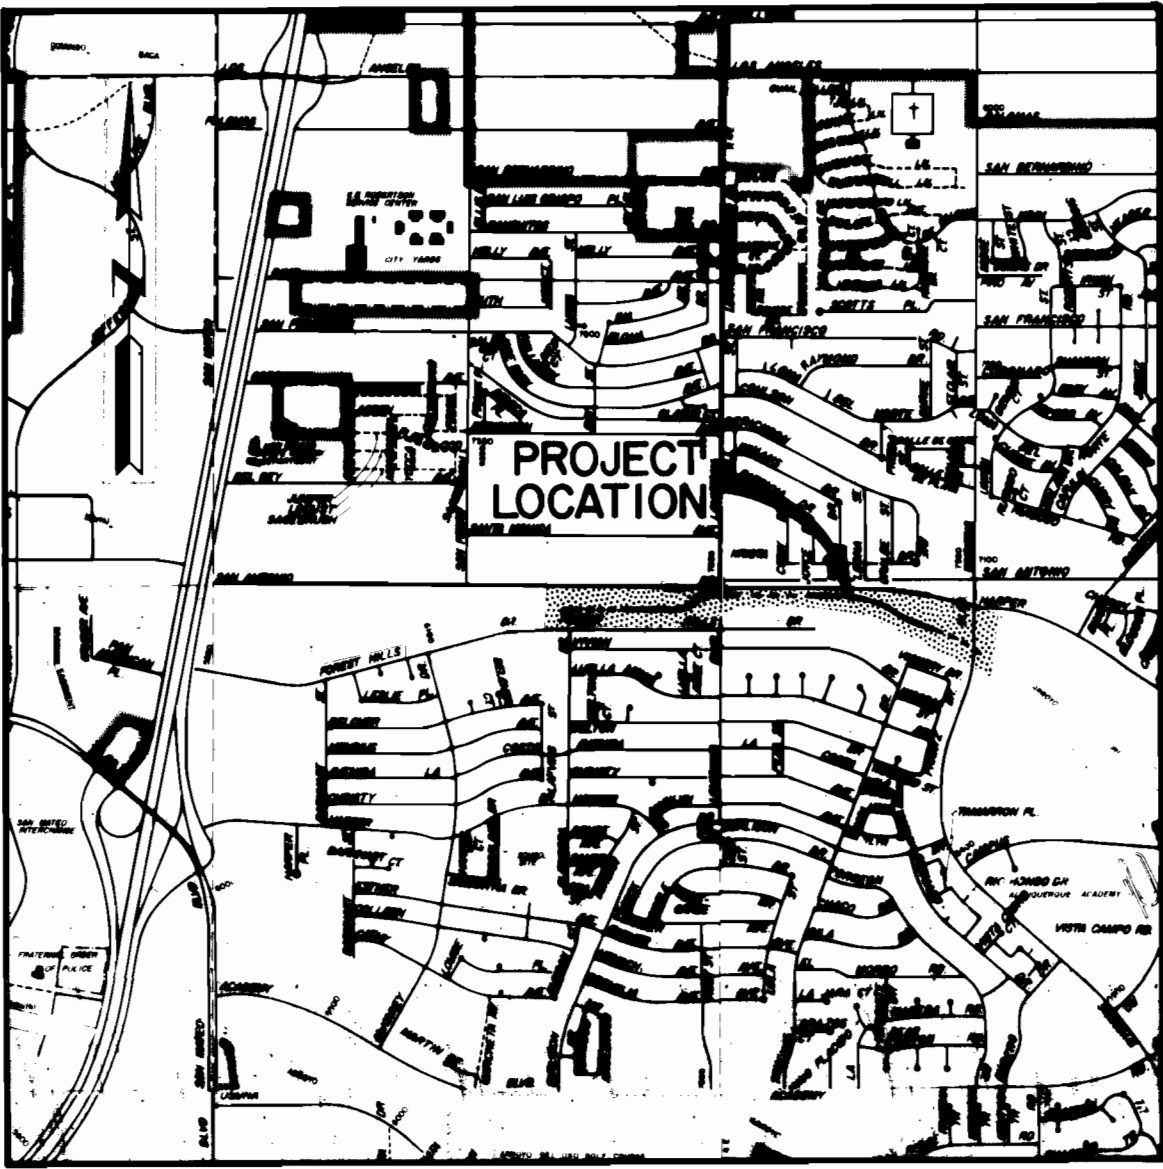


VICINITY MAP

GENERAL NOTES:

- 1. ALL WORK DETAILED ON THESE PLANS TO BE PERFORMED UNDER THIS CONTRACT SHALL, EXCEPT AS OTHERWISE STATED OR PROVIDED FOR HEREON, BE CONSTRUCTED IN ACCORDANCE WITH CITY OF ALBUQUERQUE INTERIM STANDARD SPECIFICATIONS FOR PUBLIC WORKS CONSTRUCTION.
- 2. REFERENCES MADE TO STANDARD DRAWINGS REFER TO CITY OF ALBUQUERQUE STANDARD DRAWINGS.
- 3. TWO WORKING DAYS PRIOR TO ANY EXCAVATION, CONTRACTOR MUST CONTACT LINE LOCATING SERVICE, 765-1234, FOR LOCATION OF EXISTING UTILITIES.
- 4. PRIOR TO CONSTRUCTION, THE CONTRACTOR SHALL EXCAVATE AND VERIFY THE HORIZONTAL AND VERTICAL LOCATIONS OF ALL OBSTRUCTIONS. SHOULD A CONFLICT EXIST, THE CONTRACTOR WILL NOTIFY THE ENGINEER OR SURVEYOR SO THAT THE CONFLICT CAN BE RESOLVED WITH A MINIMUM AMOUNT OF DELAY.
- 5. ALL UTILITIES AND UTILITY SERVICE LINES SHALL BE INSTALLED PRIOR TO PAVING.
- 6. BACKFILL COMPACTION SHALL BE ACCORDING TO SPECIFIED STREET USE.
- 7. TACK COAT REQUIREMENTS SHALL BE DETERMINED BY ENGINEER.
- 8. WHEELCHAIR RAMPS WITHIN THE CURB RETURNS SHALL BE CONSTRUCTED AS SHOWN.
- 9. CONTRACTOR SHALL PROVIDE 12" SUBGRADE PREPARATION UNDER ALL NEW PAVEMENT, CURBS & GUTTERS, VALLEY GUTTERS, AND CONCRETE FILLETS.
- 10. WHEN ABUTTING NEW PAVEMENT TO EXISTING, CUT BACK EXISTING PAVEMENT TO A NEAT STRAIGHT LINE AS REQUIRED TO REMOVE ANY BROKEN OR CRACKED PAVEMENT, AND MATCH NEW TO EXISTING. NO SEPARATE PAYMENT SHALL BE MADE FOR SUCH CUTTING OF EXISTING PAVEMENT BUT SHALL BE CONSIDERED INCIDENTAL TO THE PROJECT. CUTTING OF PAVEMENT SHALL BE IN CONFORMANCE WITH THE SPECIFICATIONS.
- 11. WHERE REMOVAL OF EXISTING CURB & GUTTER IS REQUIRED, SUCH REMOVAL SHALL BE MADE BACK TO THE NEAREST JOINT BEYOND THE REMOVAL REQUIRED.
- 12. CURB & GUTTER SHOWN AS EXISTING AND NOT TO BE REMOVED UNDER THE CONTRACT WHICH IS DAMAGED OR DISPLACED BY THE CONTRACTOR SHALL BE REMOVED AND REPLACED BY THE CONTRACTOR AT HIS EXPENSE.
- 13. WHEN CONSTRUCTION UNDER THIS PROJECT CONNECTS TO EXISTING IMPROVEMENTS, THE CONTRACTOR SHALL PROVIDE AN EASY RIDING CONNECTION.
- 14. MATCH FLOWLINES OF GUTTER WHEN CONNECTING NEW CURB & GUTTER TO EXISTING.
- 15. ALL WATER VALVE BOXES AND SEWER MANHOLES IN THE CONSTRUCTION AREA ARE TO BE ADJUSTED TO FINISH GRADE UNDER THE CONTRACT.


(SEE SHEET 2 FOR CONTINUATION OF GENERAL NOTES)

CITY OF ALBUQUERQUE
NEW MEXICO

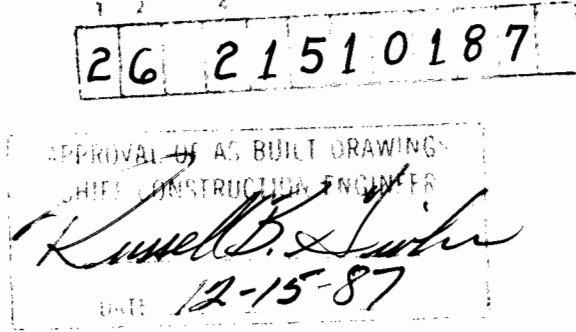

RECORD DRAWING



REV SHEETS	CITY ENGR.	DATE	USER DEPT.	DATE	USER DEPT.	DATE
APPROVAL OF REVISIONS						
			ANDREWS, ASBURY & ROBERT, INC. CONSULTING ENGINEERS ALBUQUERQUE NEW MEXICO		APPROVED FOR CONSTRUCTION CITY ENGINEER DATE 11/21/87	
			2151		SHEET 1 OF 34	

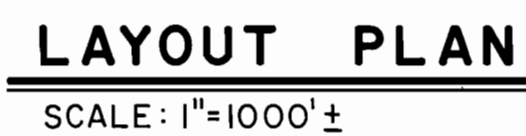

16. CONTRACTOR SHALL REMOVE AND DISPOSE OF ALL OBJECTIONABLE MATERIAL FROM THE CONSTRUCTION SITE. A DISPOSAL SITE FOR ALL REMOVAL ITEMS SHALL BE OBTAINED BY THE CONTRACTOR. THE SITE SHALL BE IN COMPLIANCE WITH APPLICABLE ENVIRONMENTAL REGULATIONS AND APPROVED BY THE CITY ENGINEERING DEPARTMENT. ALL COSTS INCURRED IN OBTAINING AN ACCEPTABLE SITE AND HAUL THERETO SHALL BE CONSIDERED INCIDENTAL TO CONSTRUCTION OF THE PROJECT.
17. ALL PERMANENT PAVEMENT MARKING AND TRAFFIC SIGNING WILL BE PERFORMED BY THE CITY OF ALBUQUERQUE, TRAFFIC ENGINEERING DEPARTMENT.
18. CONSTRUCTION SIGNING:
 - A. ALL BARRICADES AND SIGNING SHALL CONFORM TO APPLICABLE SECTIONS OF THE "MANUAL ON UNIFORM TRAFFIC CONTROL DEVICES" (MUTCD), U.S. DEPARTMENT OF TRANSPORTATION, 1978 EDITION.
 - B. CONTRACTOR SHALL PREPARE A CONSTRUCTION SIGNING PLAN AND OBTAIN APPROVAL OF SUCH PLAN FROM THE CITY OF ALBUQUERQUE, TRAFFIC ENGINEERING DEPARTMENT, PRIOR TO BEGINNING ANY CONSTRUCTION WORK ON OR ADJACENT TO EXISTING STREETS.
 - C. ALL CONSTRUCTION WARNING SIGNS SHALL HAVE A MOUNTED HEIGHT OF SEVEN (7) FEET.
 - D. CONTRACTOR SHALL MAINTAIN ALL BARRICADES AND SIGNING AT ALL TIMES. THE CONTRACTOR SHALL VERIFY THE PROPER LOCATION OF ALL BARRICADES AT THE END AND BEGINNING OF EACH DAY.
19. REINFORCED CONCRETE STRUCTURES SHALL HAVE REINFORCING STEEL CONTINUOUS AT ALL CORNERS.
20. DOWELS SHALL BE PROVIDED AT ALL CONNECTIONS OF REINFORCED CONCRETE CONSTRUCTION.
21. ALL EXPOSED CONCRETE SURFACES, TO A MINIMUM OF 6 INCHES BELOW FINISHED GRADE, SHALL BE FINISHED WITH "THOROSEAL", AS PER NMSHD SPECIFICATIONS FOR ROAD AND BRIDGE CONSTRUCTION, PARAGRAPH 509.037, TYPE I.

John A. Andrew
RECORD DRAWING
1 2 3 4 5 6 7 8 9 10 11 12
26 21510287

CITY OF ALBUQUERQUE					
MUNICIPAL DEVELOPMENT DEPARTMENT					
ENGINEERING DIVISION					
PINO ARROYO CORRIDOR IMPROVEMENTS					
LAYOUT PLAN					
APPROVALS	ENGINEER	DATE	APPROVALS	ENGINEER	DATE
City Engineer	<i>[Signature]</i>	1/12/86	Liquid Waste	N/A BR	1-31-86
A.C.E.-Design	<i>[Signature]</i>	1/31/86	Traffic	D.A. Parks	1-31-86
A.C.E.-Hydrology	K.K. Hoagel	1-31-86	Water	N/A BR	1-31-86
DRAWING NO.	2151		MAP NO.	SHEET OF	
		E-18, E-19		2	34

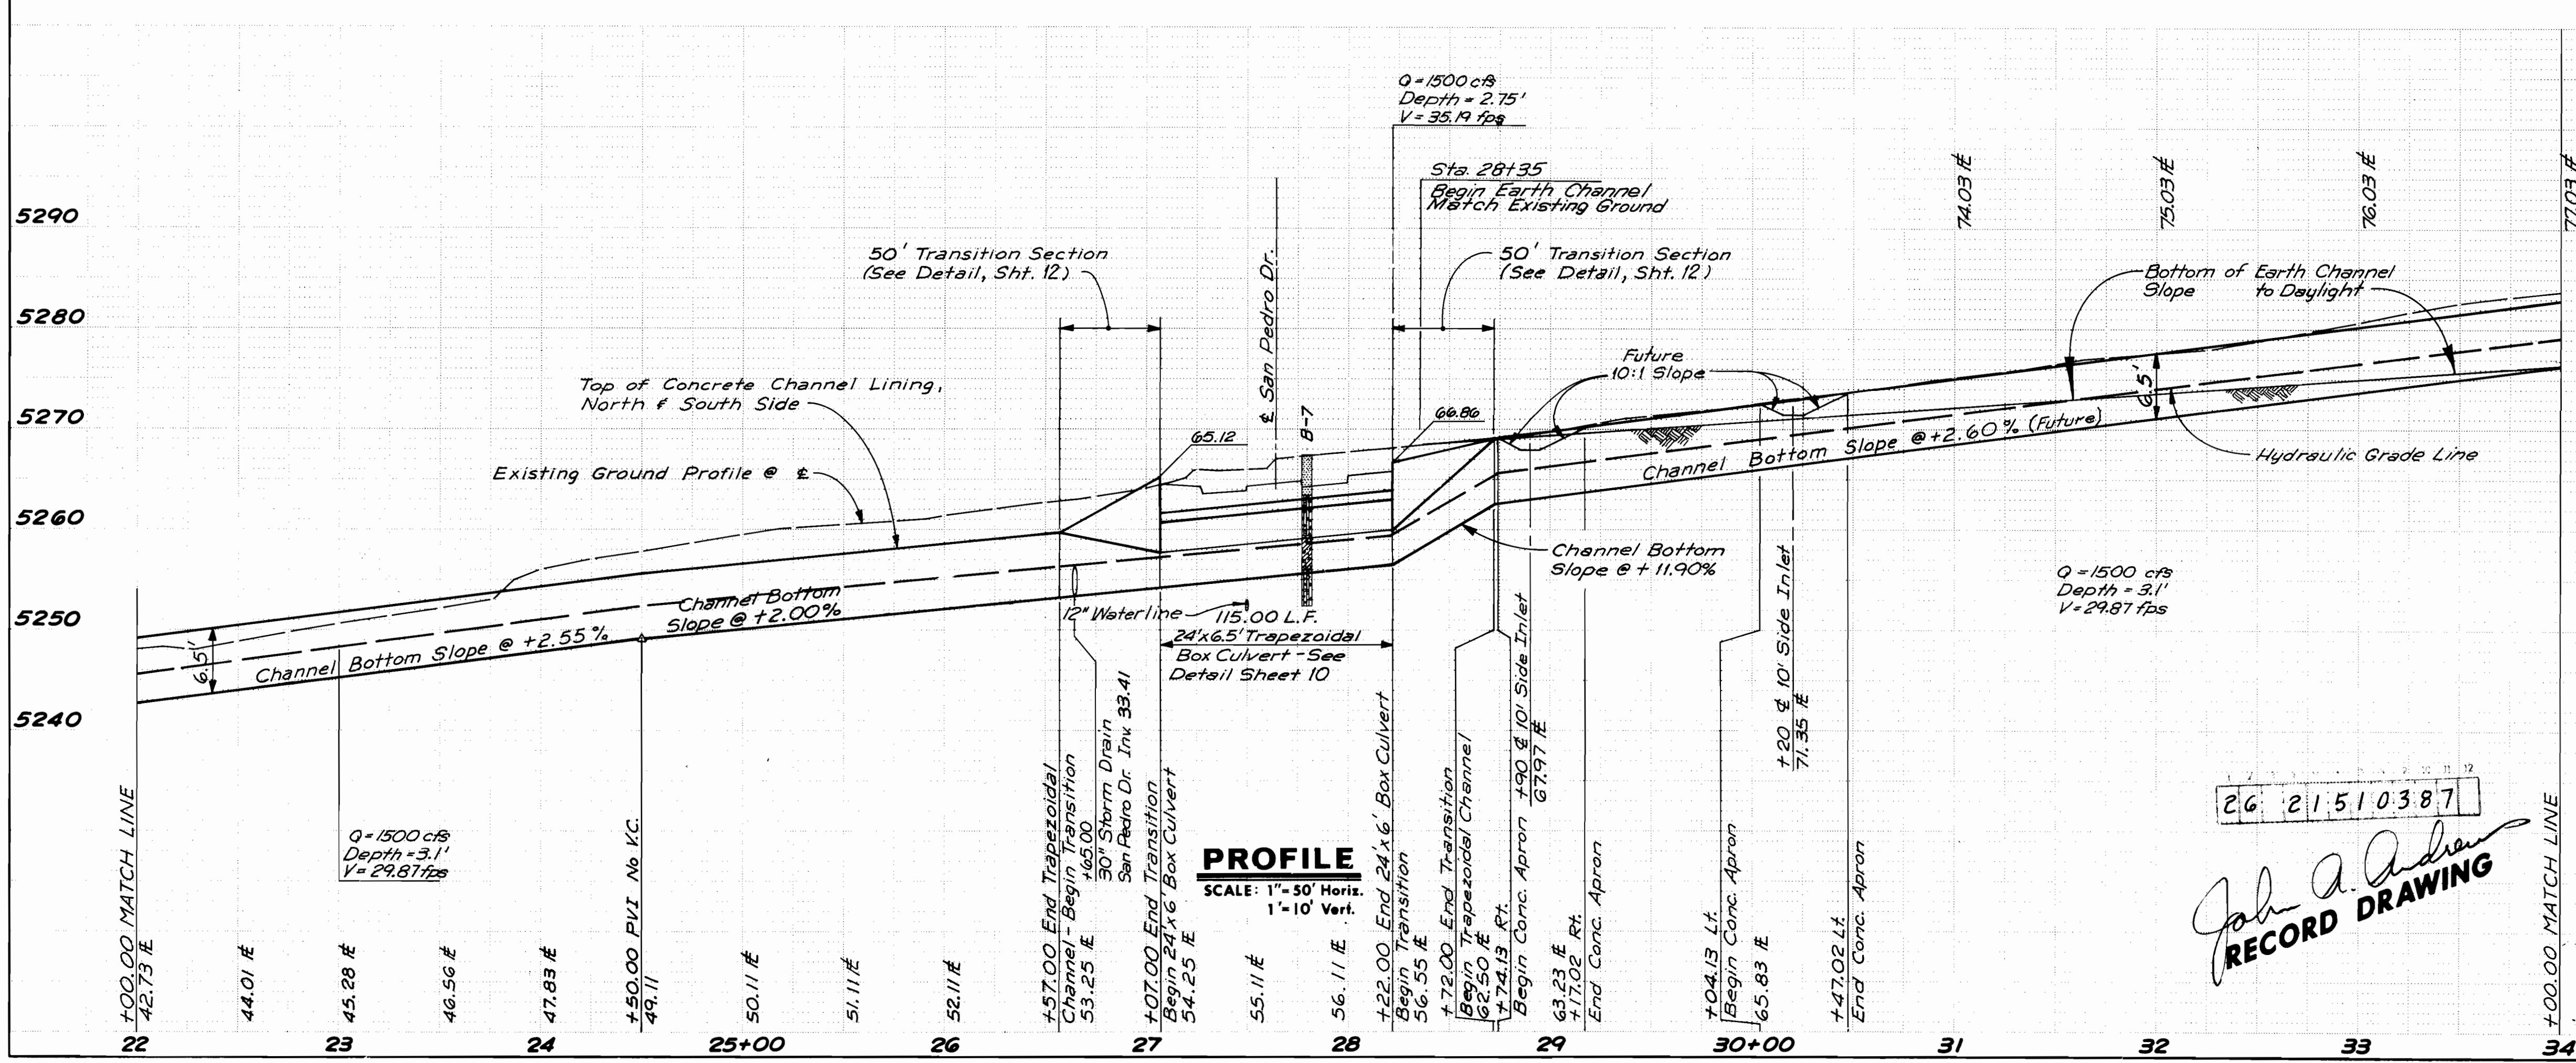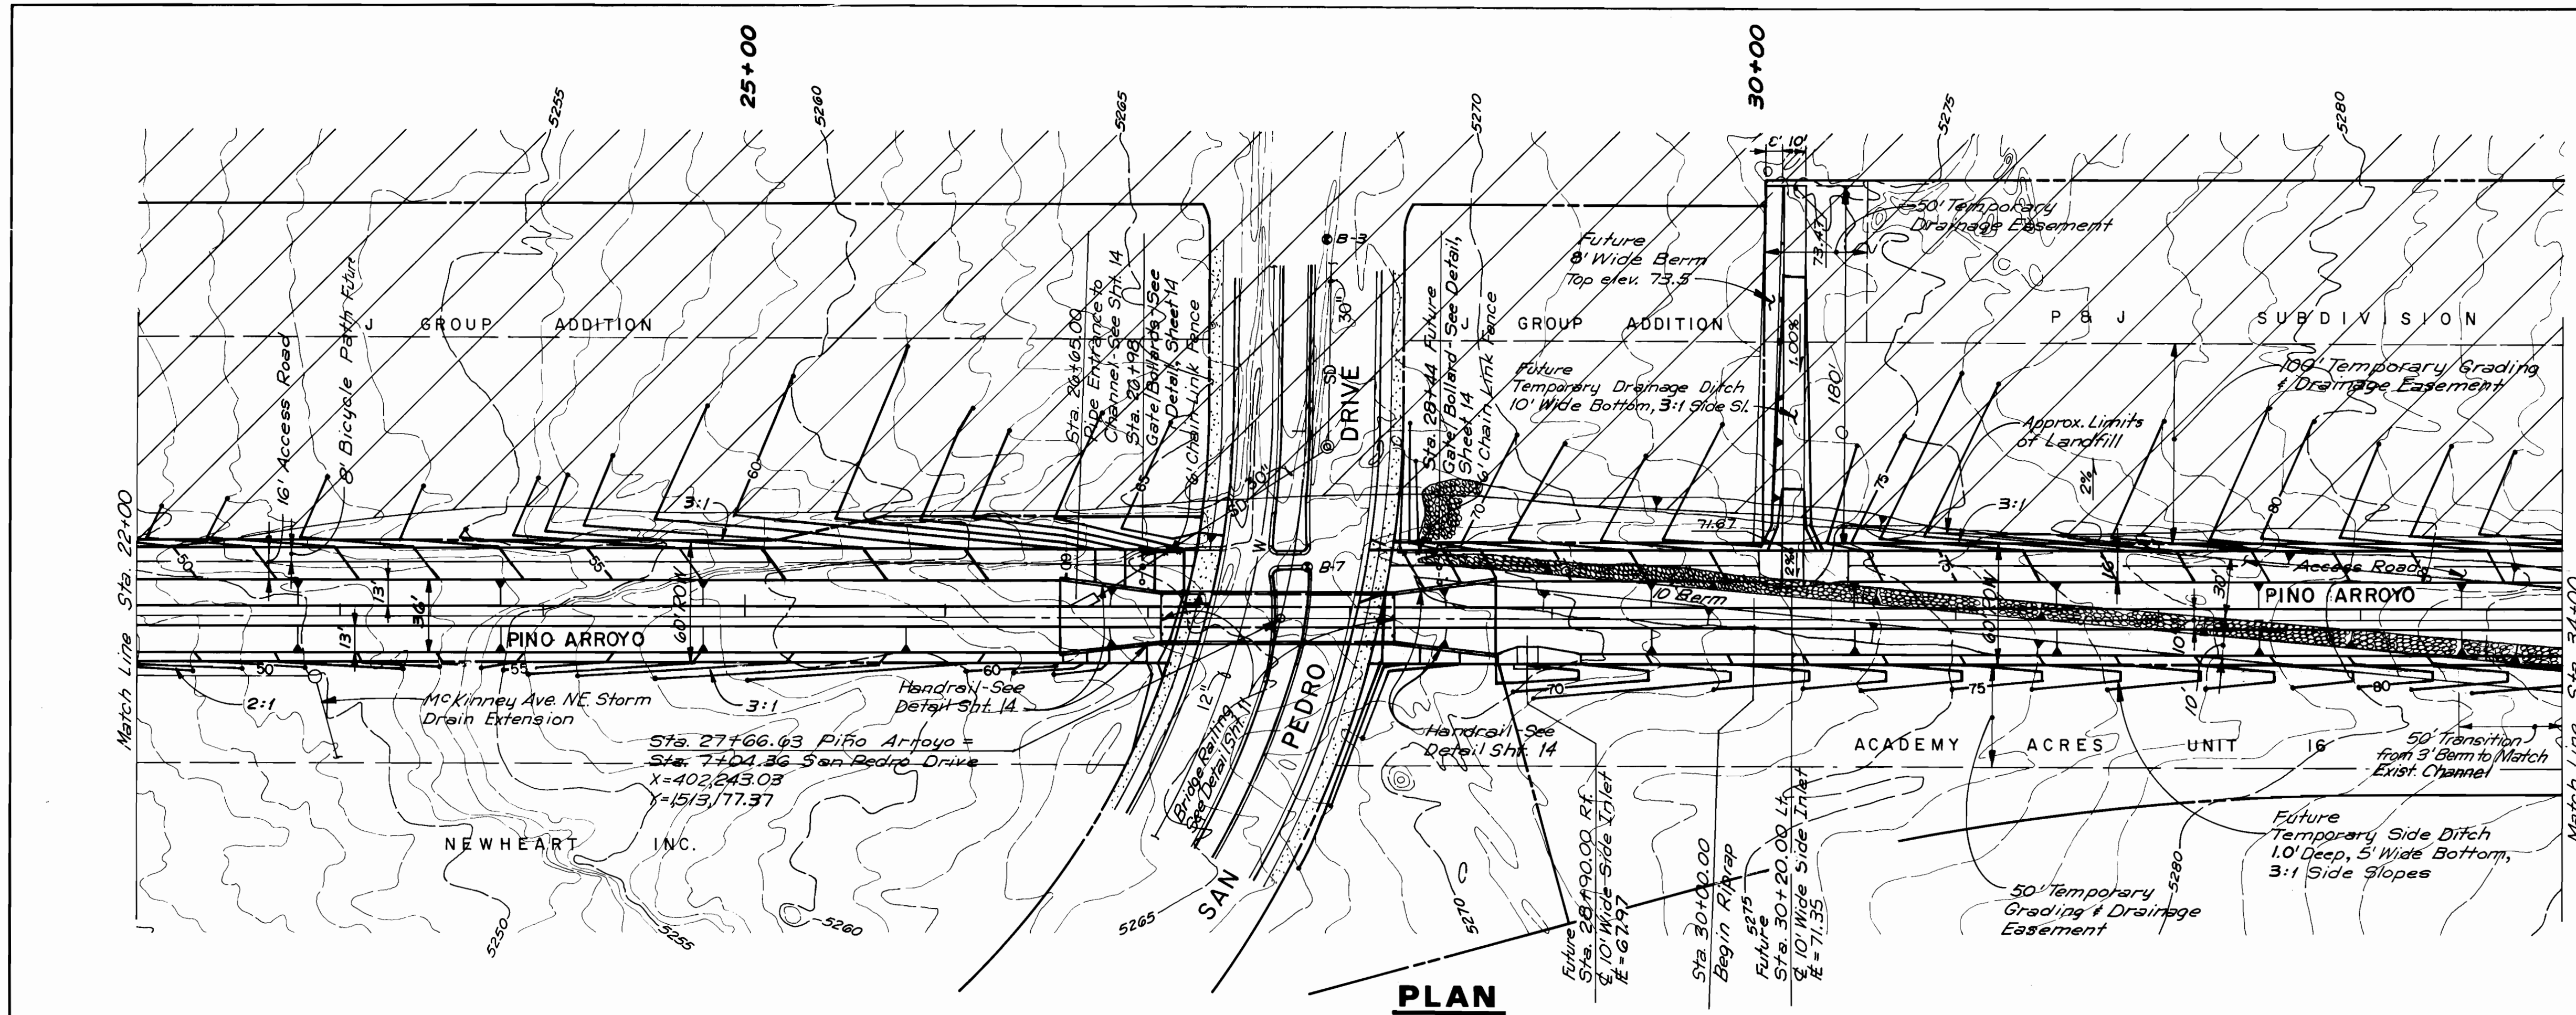

NOTES

1. LIMITS OF LANDFILL INDICATED ON THESE PLANS ARE APPROXIMATE ONLY. CONTRACTOR SHALL, EXCAVATE ALL LANDFILL MATERIAL OUTSIDE THE LIMITS OF EXCAVATION SHOWN ON THE TYPICAL SECTIONS, WHICH IN THE OPINION OF THE ENGINEER THREATENS THE INTEGRITY OF THE CHANNEL. SUCH EXCESS EXCAVATION SHALL BE BACKFILLED WITH SUITABLE MATERIAL COMPACTED TO 90% MODIFIED DENSITY. EXCESS LANDFILL EXCAVATION WILL BE MEASURED FOR PAYMENT BY THE CUBIC YARD WHICH PAYMENT SHALL INCLUDE BACKFILLING & HAULING LANDFILL MATERIAL TO DISPOSAL.

2. ALL EXCAVATED LANDFILL, WHETHER WITHIN THE NORMAL LIMITS OF EXCAVATION OR WITHOUT AS DESCRIBED IN NOTE 1, SHALL BE HAULED TO A SUITABLE DISPOSAL SITE IN COMPLIANCE WITH ALL STATE & LOCAL REGULATIONS.

3. ALL FLOWS, FLOW DEPTH, VELOCITIES & HYDRAULIC GRADIENTS SHOWN ON THE PROFILES ARE BASED UPON 100 YEAR FLOW CONDITIONS.

EARTH CHANNEL SECTION

NO SCALE

LEGEND

Approximate Location of Sanitary Landfill

Property line

-25.5-

Existing Ground Contour

-05-

Finish Grade Contour

B-5

Soil Boring Location & Number

Street Crown Transition

SOIL BORINGS LEGEND

FINE-GRAINED SOIL

MORE THAN 50% SMALLER THAN 200 SIEVE SIZE

DESCRIPTION	MAJOR DIVISIONS
ML INORGANIC SILTS AND VERY FINE SANDS, ROCK FLOUR, SILTY OR CLAYEY FINE SANDS OR CLAYEY SILTS WITH SLIGHT PLASTICITY	SILTS AND CLAYS
CL INORGANIC CLAYS OF LOW TO MEDIUM PLASTICITY, GRAVELLY CLAYS, SANDY CLAYS, SILTY CLAYS, LEAN CLAYS	Liquid limit less than 50
OL ORGANIC SILTS AND SILTY CLAYS OF LOW PLASTICITY	SILTS
MH INORGANIC SILTS, MICACEOUS OR DIATOMACEOUS FINE SANDY OR SILTY SOILS, ELASTIC SILTS	AND CLAYS
CH INORGANIC CLAYS OF HIGH PLASTICITY, FAT CLAYS	CLAYS
OH ORGANIC CLAYS OF MEDIUM TO HIGH PLASTICITY, ORGANIC SILTS	Liquid limit greater than 50
PT PEAT AND OTHER HIGHLY ORGANIC SOILS	

COARSE-GRAINED SOIL

MORE THAN 50% LARGER THAN 200 SIEVE SIZE

DESCRIPTION	MAJOR DIVISIONS
GW WELL-GRADED GRAVELS OR GRAVELLY SAND MIXTURES, LESS THAN 5% 200 FINES	GRAVELS
GP POORLY-GRADED GRAVELS OR GRAVELLY SAND MIXTURES, MORE THAN 5% 200 FINES	More than half of coarse fraction is larger than No. 4 sieve size
GM SILTY GRAVELS, GRAVELLY SAND SILT MIXTURES, MORE THAN 12% 200 FINES	No. 4 sieve size
GC CLAYEY GRAVELS, GRAVELLY SAND-CLAY MIXTURES, MORE THAN 12% 200 FINES	More than half of coarse fraction is smaller than No. 4 sieve size
SW WELL-GRADED SANDS OR GRAVELLY SANDS, LESS THAN 12% 200 FINES	SANDS
SP POORLY-GRADED SANDS OR GRAVELLY SANDS, LESS THAN 5% 200 FINES	More than half of coarse fraction is smaller than No. 4 sieve size
SM SILTY SANDS, SAND SILT MIXTURES, MORE THAN 12% 200 FINES	
SC CLAYEY SANDS, SAND-CLAY MIXTURES, MORE THAN 12% 200 FINES	

CITY OF ALBUQUERQUE

MUNICIPAL DEVELOPMENT DEPARTMENT

ENGINEERING DIVISION

PINO ARROYO CORRIDOR IMPROVEMENTS

ARROYO CHANNELIZATION

PLAN & PROFILE - STA. 30+40 TO STA. 34+00

APPROVALS	ENGINEER	DATE	APPROVALS	ENGINEER	DATE
CITY Engineer	<i>[Signature]</i>	1/22/06	Liquid Waste	<i>[Signature]</i>	1-21-06
A-C-E-Design	<i>[Signature]</i>	1/22/06	Traffic	<i>[Signature]</i>	1-21-06
A-C-E-Hydrology	<i>[Signature]</i>	1-31-06	Water	<i>[Signature]</i>	1-21-06

DRAWING NO.

2151

MAP NO.


E-18, E-19

SHEET

3


OF

34

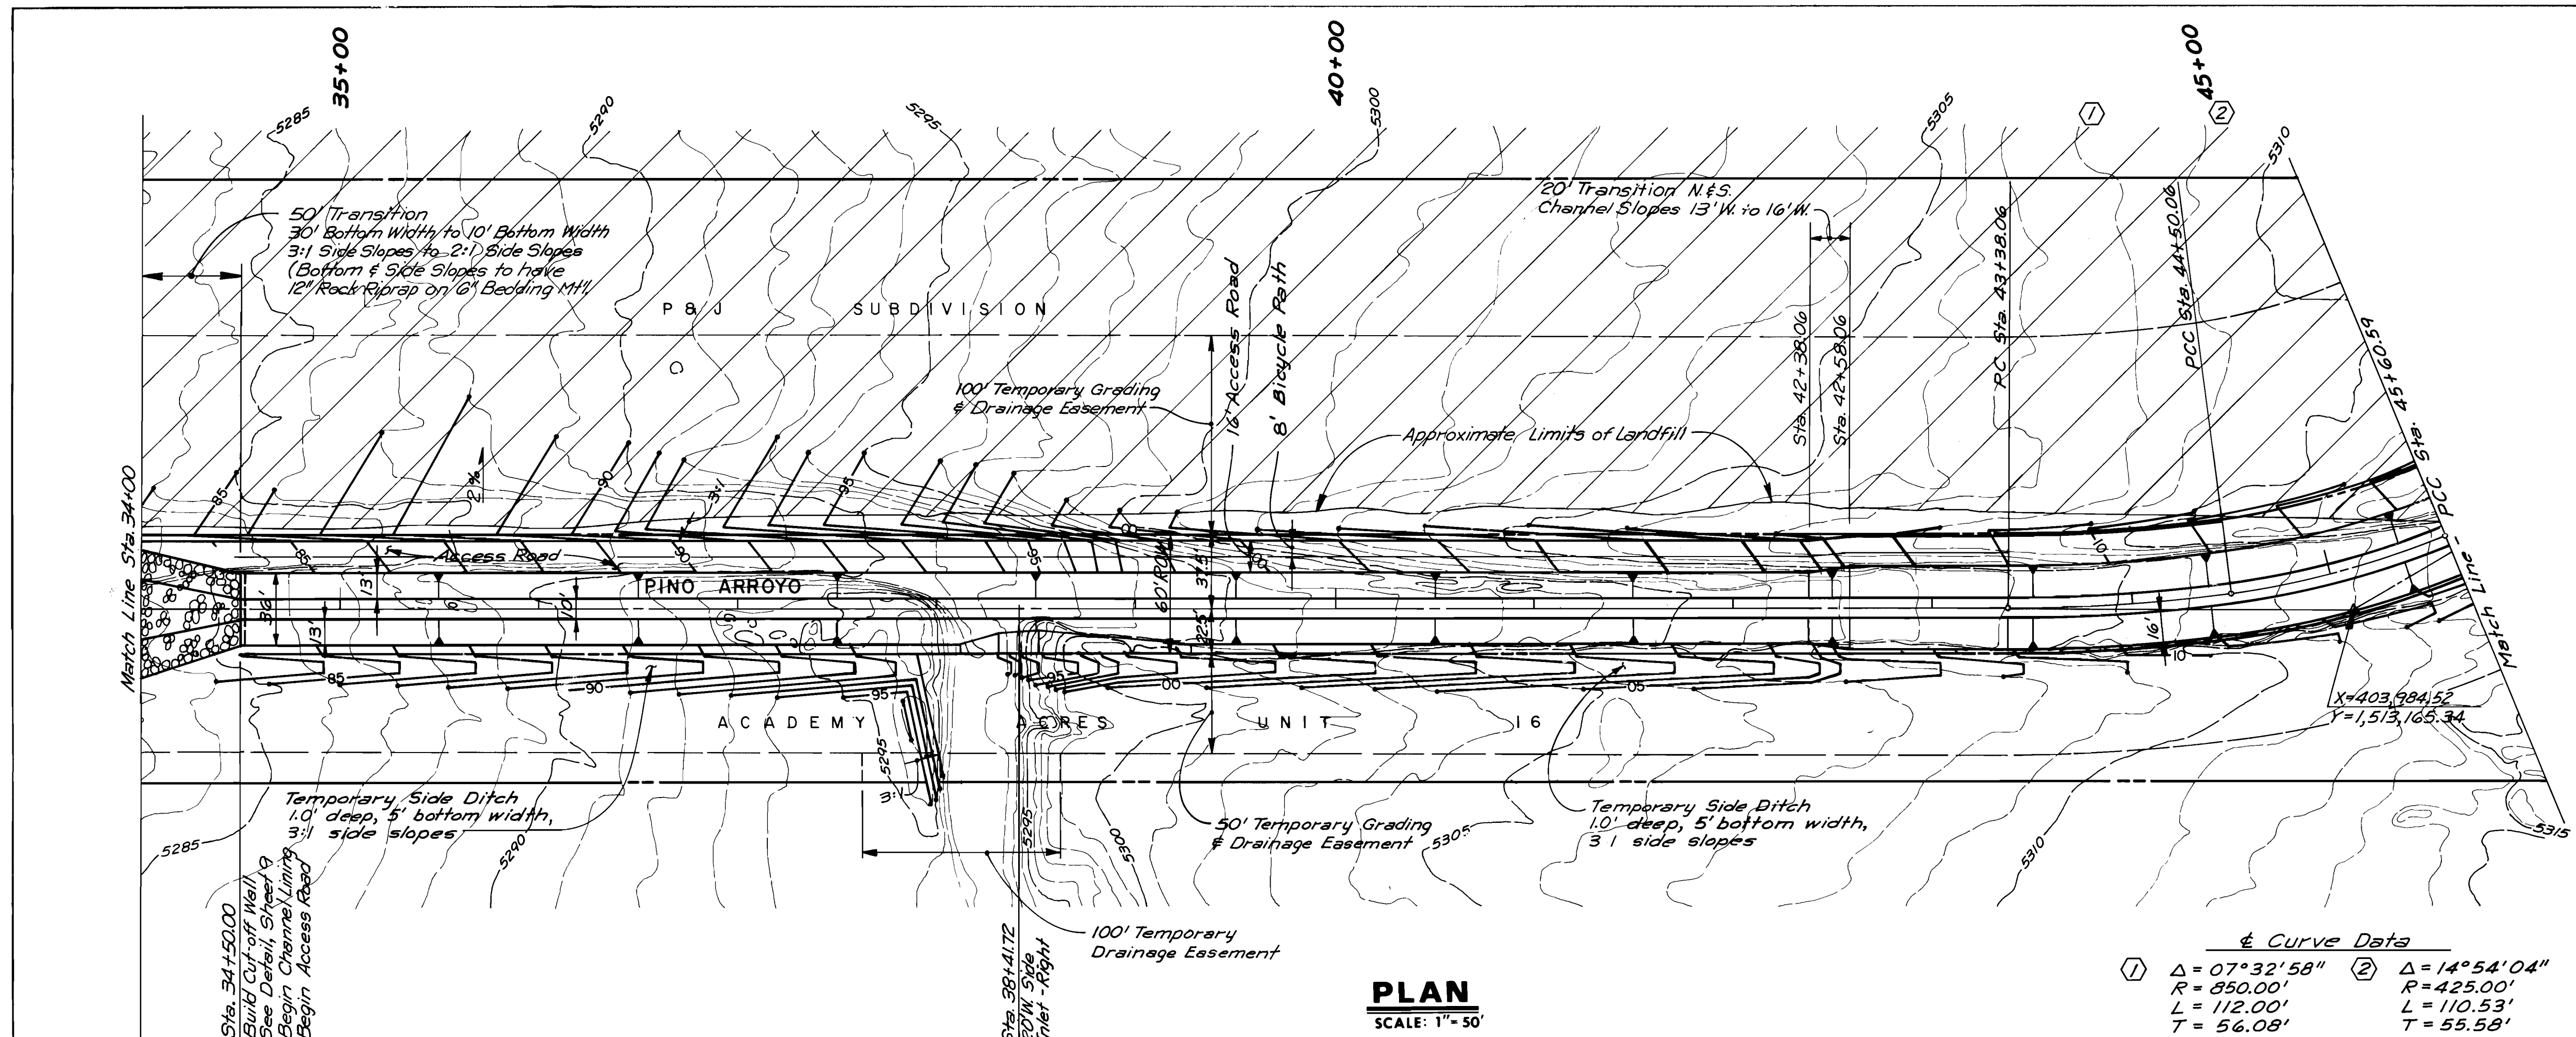

Curve Data

① $\Delta = 07^\circ 32' 58''$	② $\Delta = 14^\circ 54' 04''$
$R = 850.00'$	$R = 425.00'$
$L = 112.00'$	$L = 110.53'$
$T = 56.08'$	$T = 55.58'$

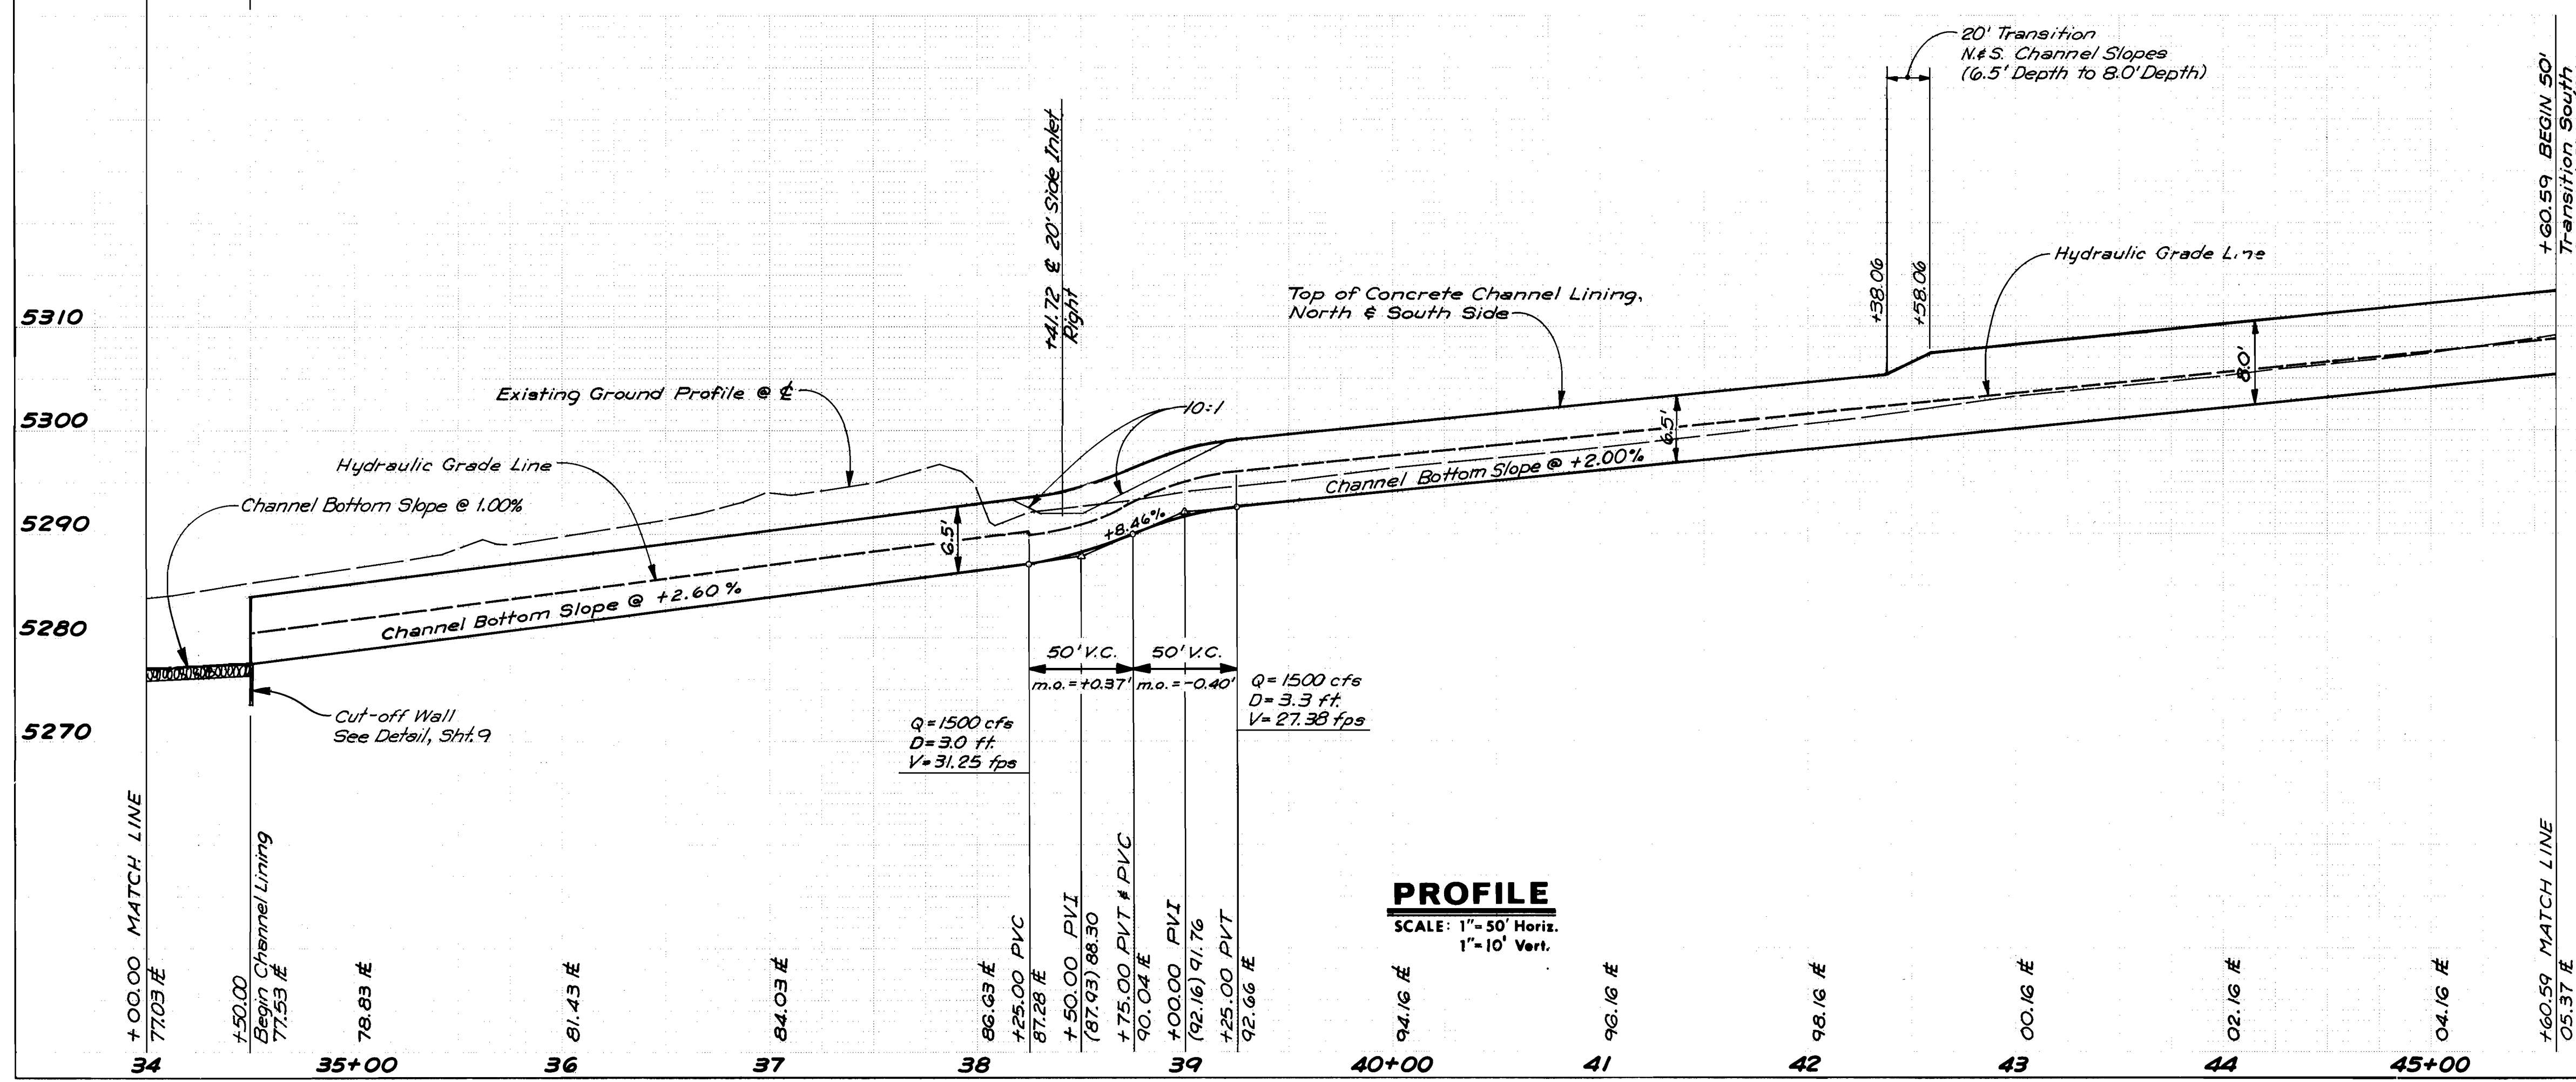



5320
5310
5300
5290
5280
5270

26 21510487

John A. Andrews
RECORD DRAWING

CITY OF ALBUQUERQUE MUNICIPAL DEVELOPMENT DEPARTMENT ENGINEERING DIVISION					
PINO ARROYO CORRIDOR IMPROVEMENTS ARROYO CHANNELIZATION PLAN & PROFILE - STA. 34+00 TO STA. 45+00					
APPROVALS	ENGINEER	DATE	APPROVALS	ENGINEER	DATE
City Engineer	<i>John A. Andrews</i>	1/31/86	Liquid Waste	N/A	1-31-86
A.C.E. - Design	<i>John A. Andrews</i>	1/31/86	Traffic	N/A	1-31-86
A.C.E. - Hydrology	<i>John A. Andrews</i>	1-31-86	Water	N/A	1-31-86
DRAWING NO. 2151		MAP NO. E-18, E-19		SHEET 4 OF 34	


AS BUILT INFORMATION		BENCH MARKS		SURVEY INFORMATION		ENGINEER'S SEAL	
CONTRACTOR	Moore & Conner	ACS STA "12-E18 1978"	ELEVATION 5337.039	NO.	DATE		ANDREWS, ASBURY & ROBERT, INC. ALBUQUERQUE, NEW MEXICO CONSULTING ENGINEERS 1978-1988
INSPECTOR'S	DATE 10/87	ACS BRASS TABLET SET ON CONCRETE POST FLUSH W/GROUND	DATE 10/87	BY	REVISIONS		
VERIFICATION BY	CITY	LOCATED 41 FEET SOUTH OF THE CENTERLINE OF SAN ANTONIO DRIVE AND 34 FEET WEST OF THE CENTERLINE OF LOUISIANA BOULEVARD	DATE 10/87	NO.	DATE		
VERIFICATION BY	CITY	LOCATED 41 FEET SOUTH OF THE CENTERLINE OF SAN ANTONIO DRIVE AND 34 FEET WEST OF THE CENTERLINE OF LOUISIANA BOULEVARD	DATE 10/87	NO.	DATE		
MICRO-FILM INFORMATION		RECORDED BY		NO.		DATE	

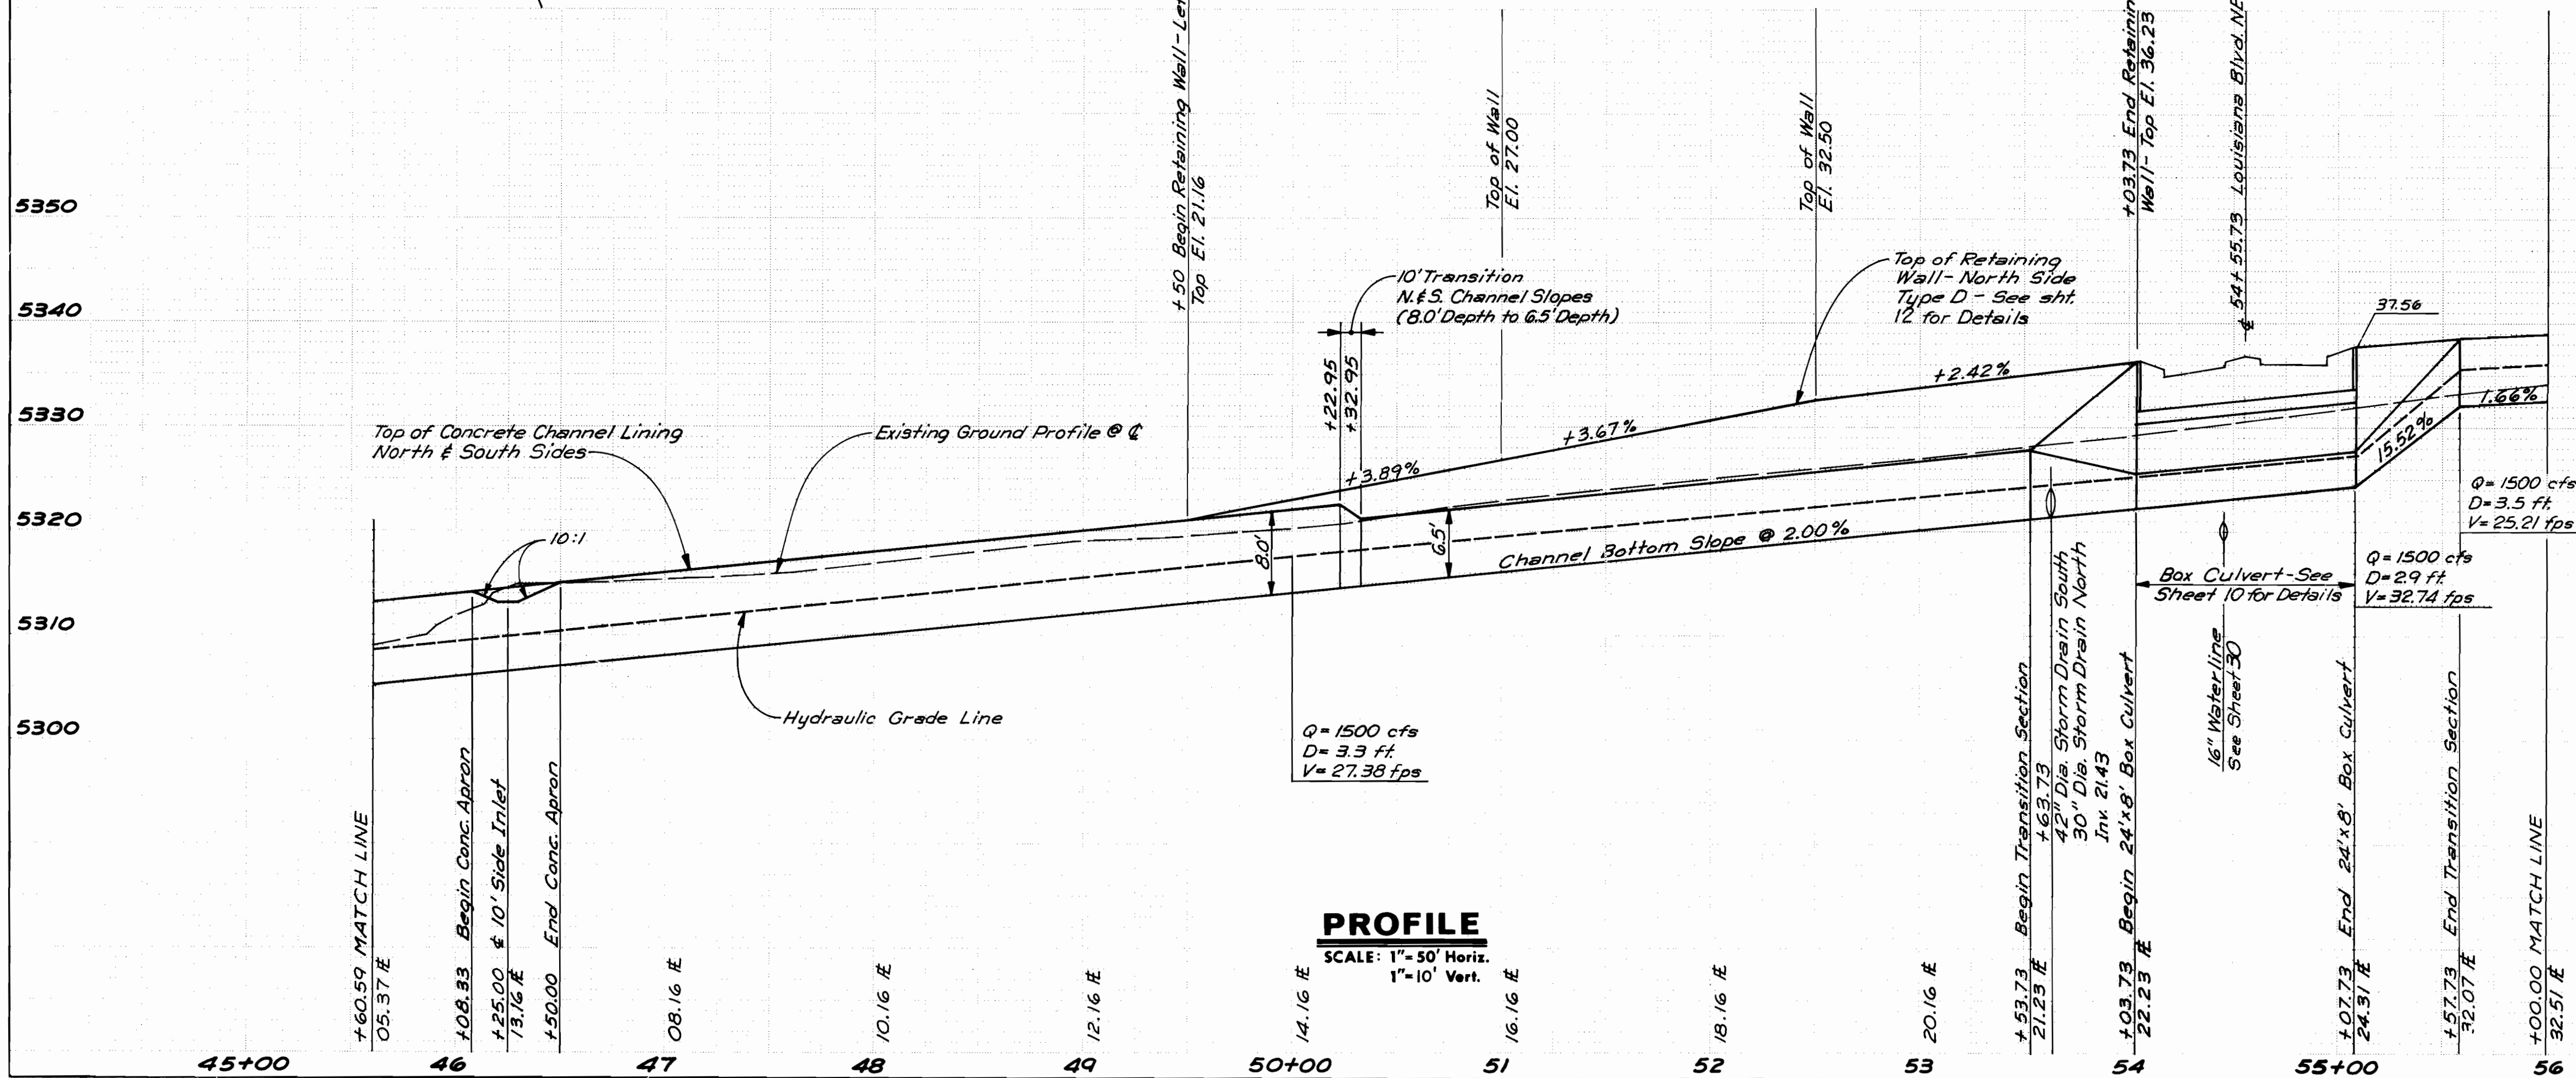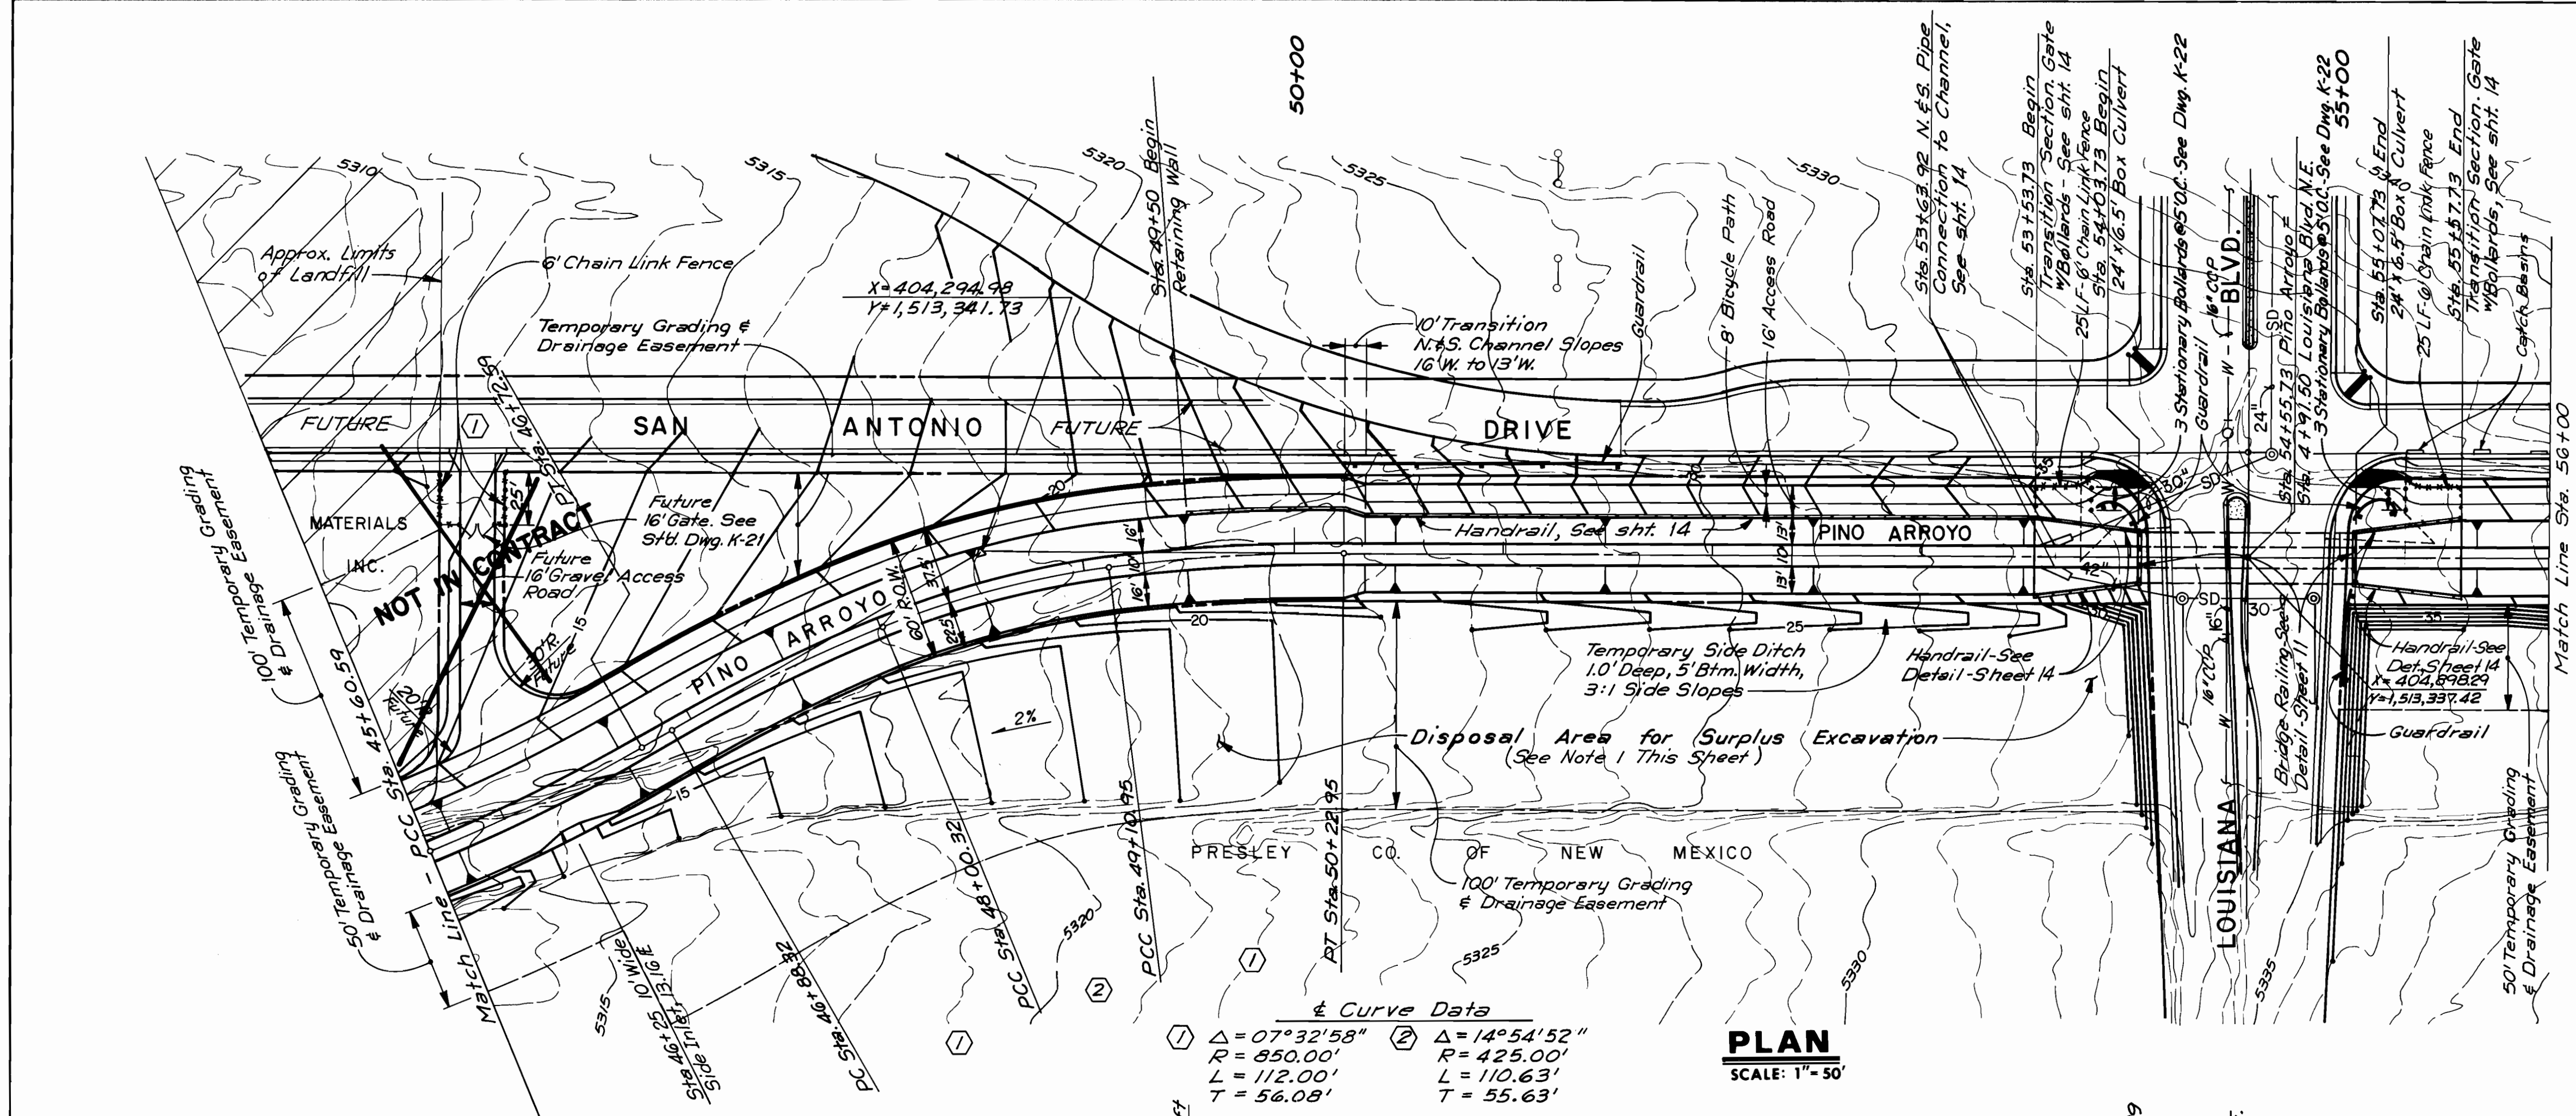

- NOTES
- SURPLUS EXCAVATION SHALL BE NEATLY PLACED, GRADED TO DRAIN AND COMPACTED TO 90% ASTM D-1557. RANDOM PLACEMENT WILL NOT BE ACCEPTED.
 - SEE SHEET 28 FOR STORM DRAIN & CATCH BASINS.
 - SEE SHEET 30 FOR WATERLINE.

John A. Andrews
RECORD DRAWING
26 21510587


CITY OF ALBUQUERQUE MUNICIPAL DEVELOPMENT DEPARTMENT ENGINEERING DIVISION				
PINO ARROYO CORRIDOR IMPROVEMENTS ARROYO CHANNELIZATION PLAN & PROFILE - STA. 45+00 TO STA. 56+00				
APPROVALS	ENGINEER	DATE	ENGINEER	DATE
City Engineer	<i>[Signature]</i>	11/29/84	Liquid Waste	<i>[Signature]</i> 1-28-86
A C E - Design	<i>[Signature]</i>	1/31/86	Traffic	<i>[Signature]</i> 1-31-86
A C E - Hydrology	<i>[Signature]</i>	1/31/86	Water	<i>[Signature]</i> 1-31-86
DRAWING NO. 2151		MAP NO. E-18, E-19	SHEET 5 OF 34	

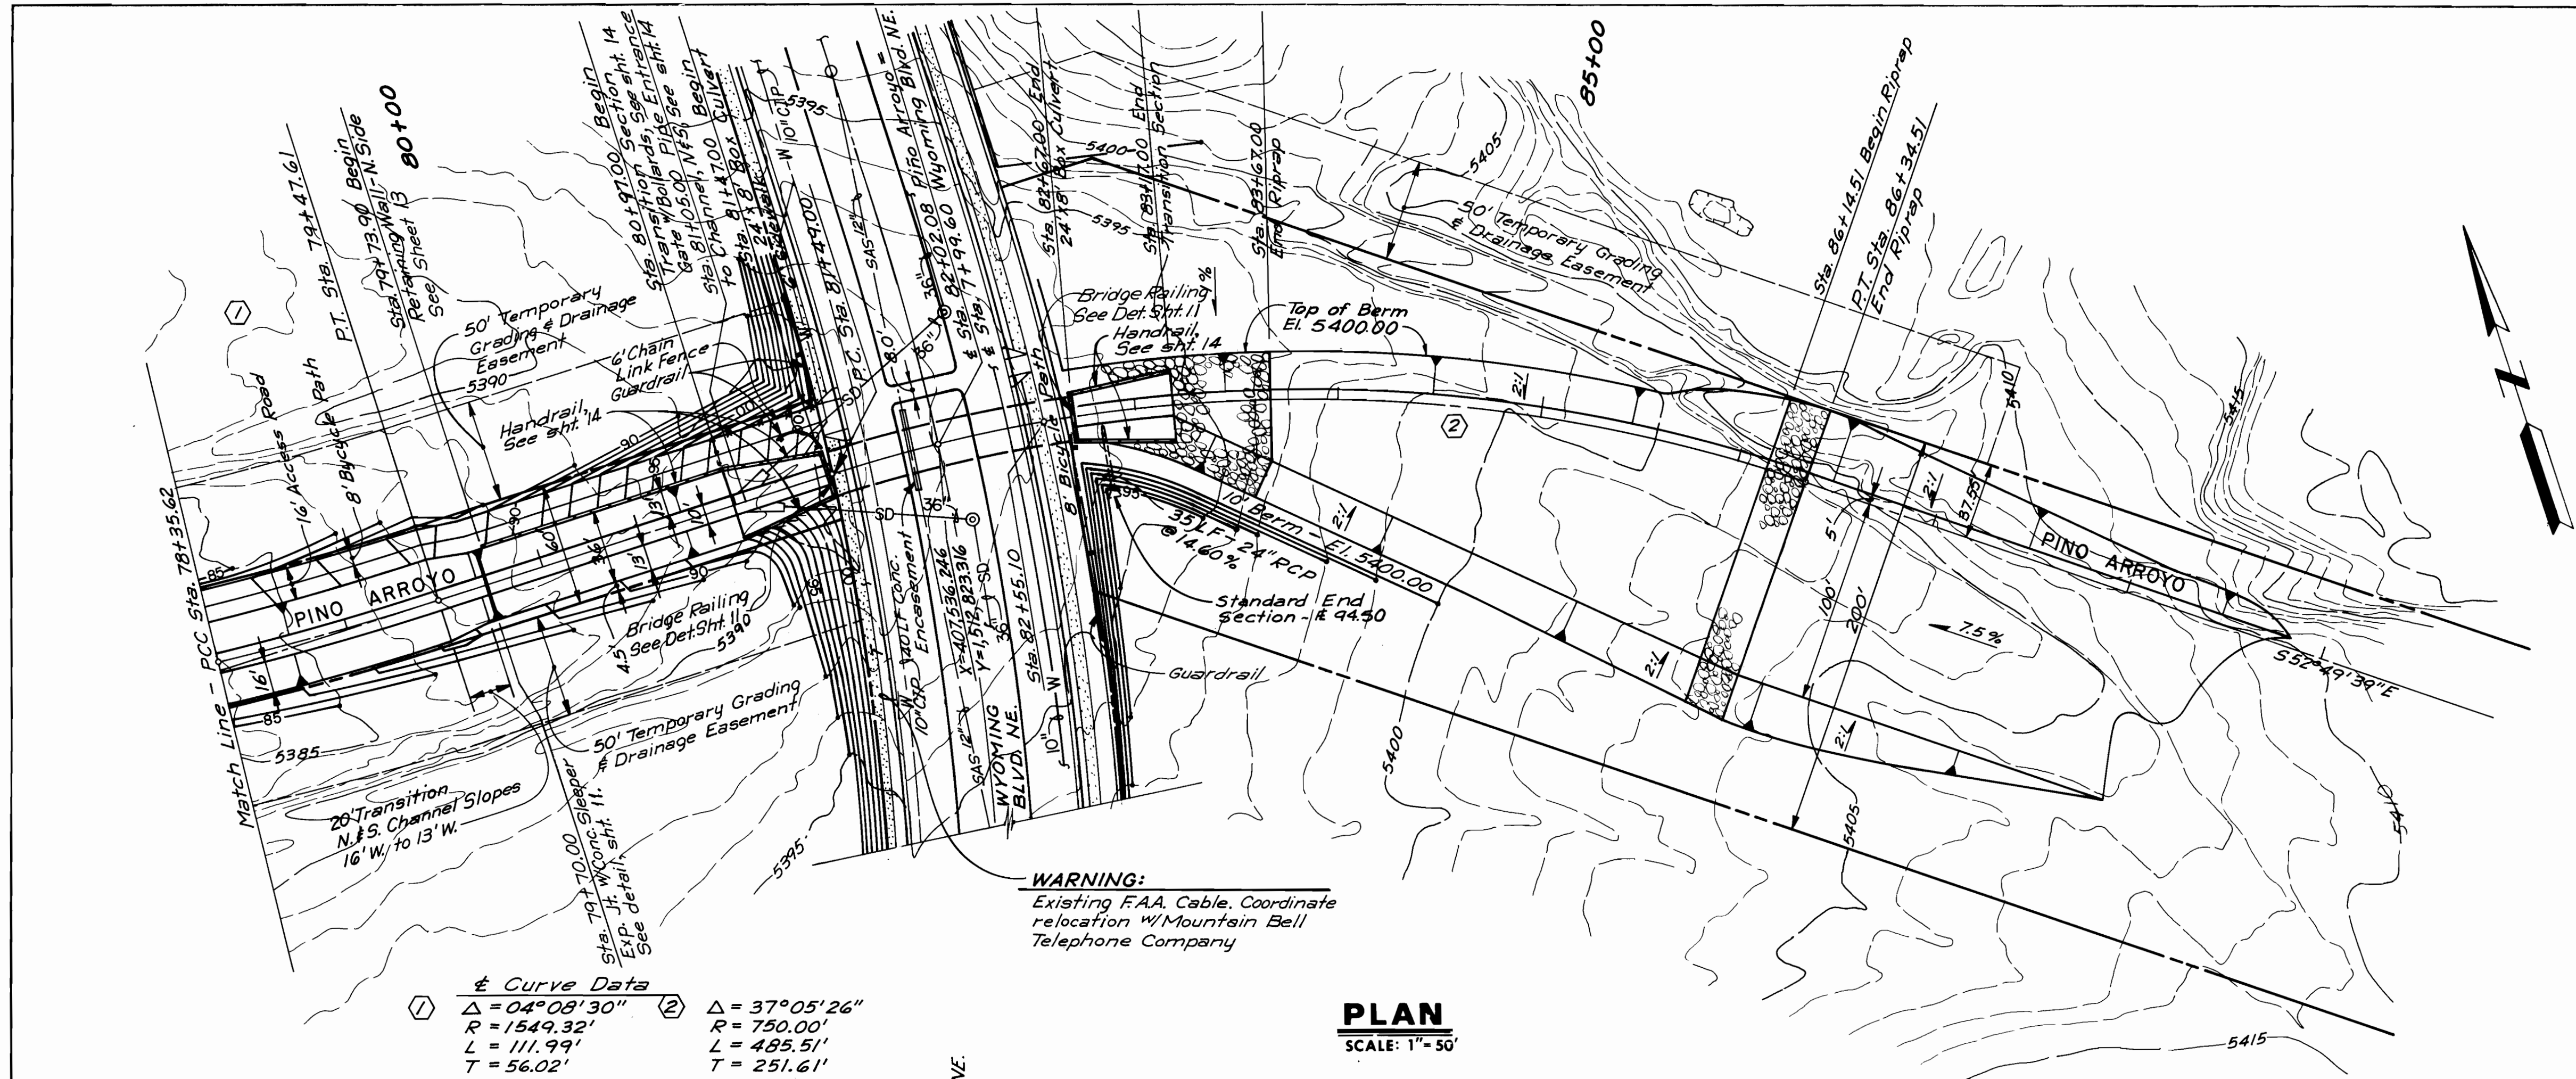

Curve Data

①	②
$\Delta = 04^{\circ}08'30''$	$\Delta = 37^{\circ}05'26''$
$R = 1549.32'$	$R = 750.00'$
$L = 111.99'$	$L = 485.51'$
$T = 56.02'$	$T = 251.61'$

PLAN
SCALE: 1" = 50'

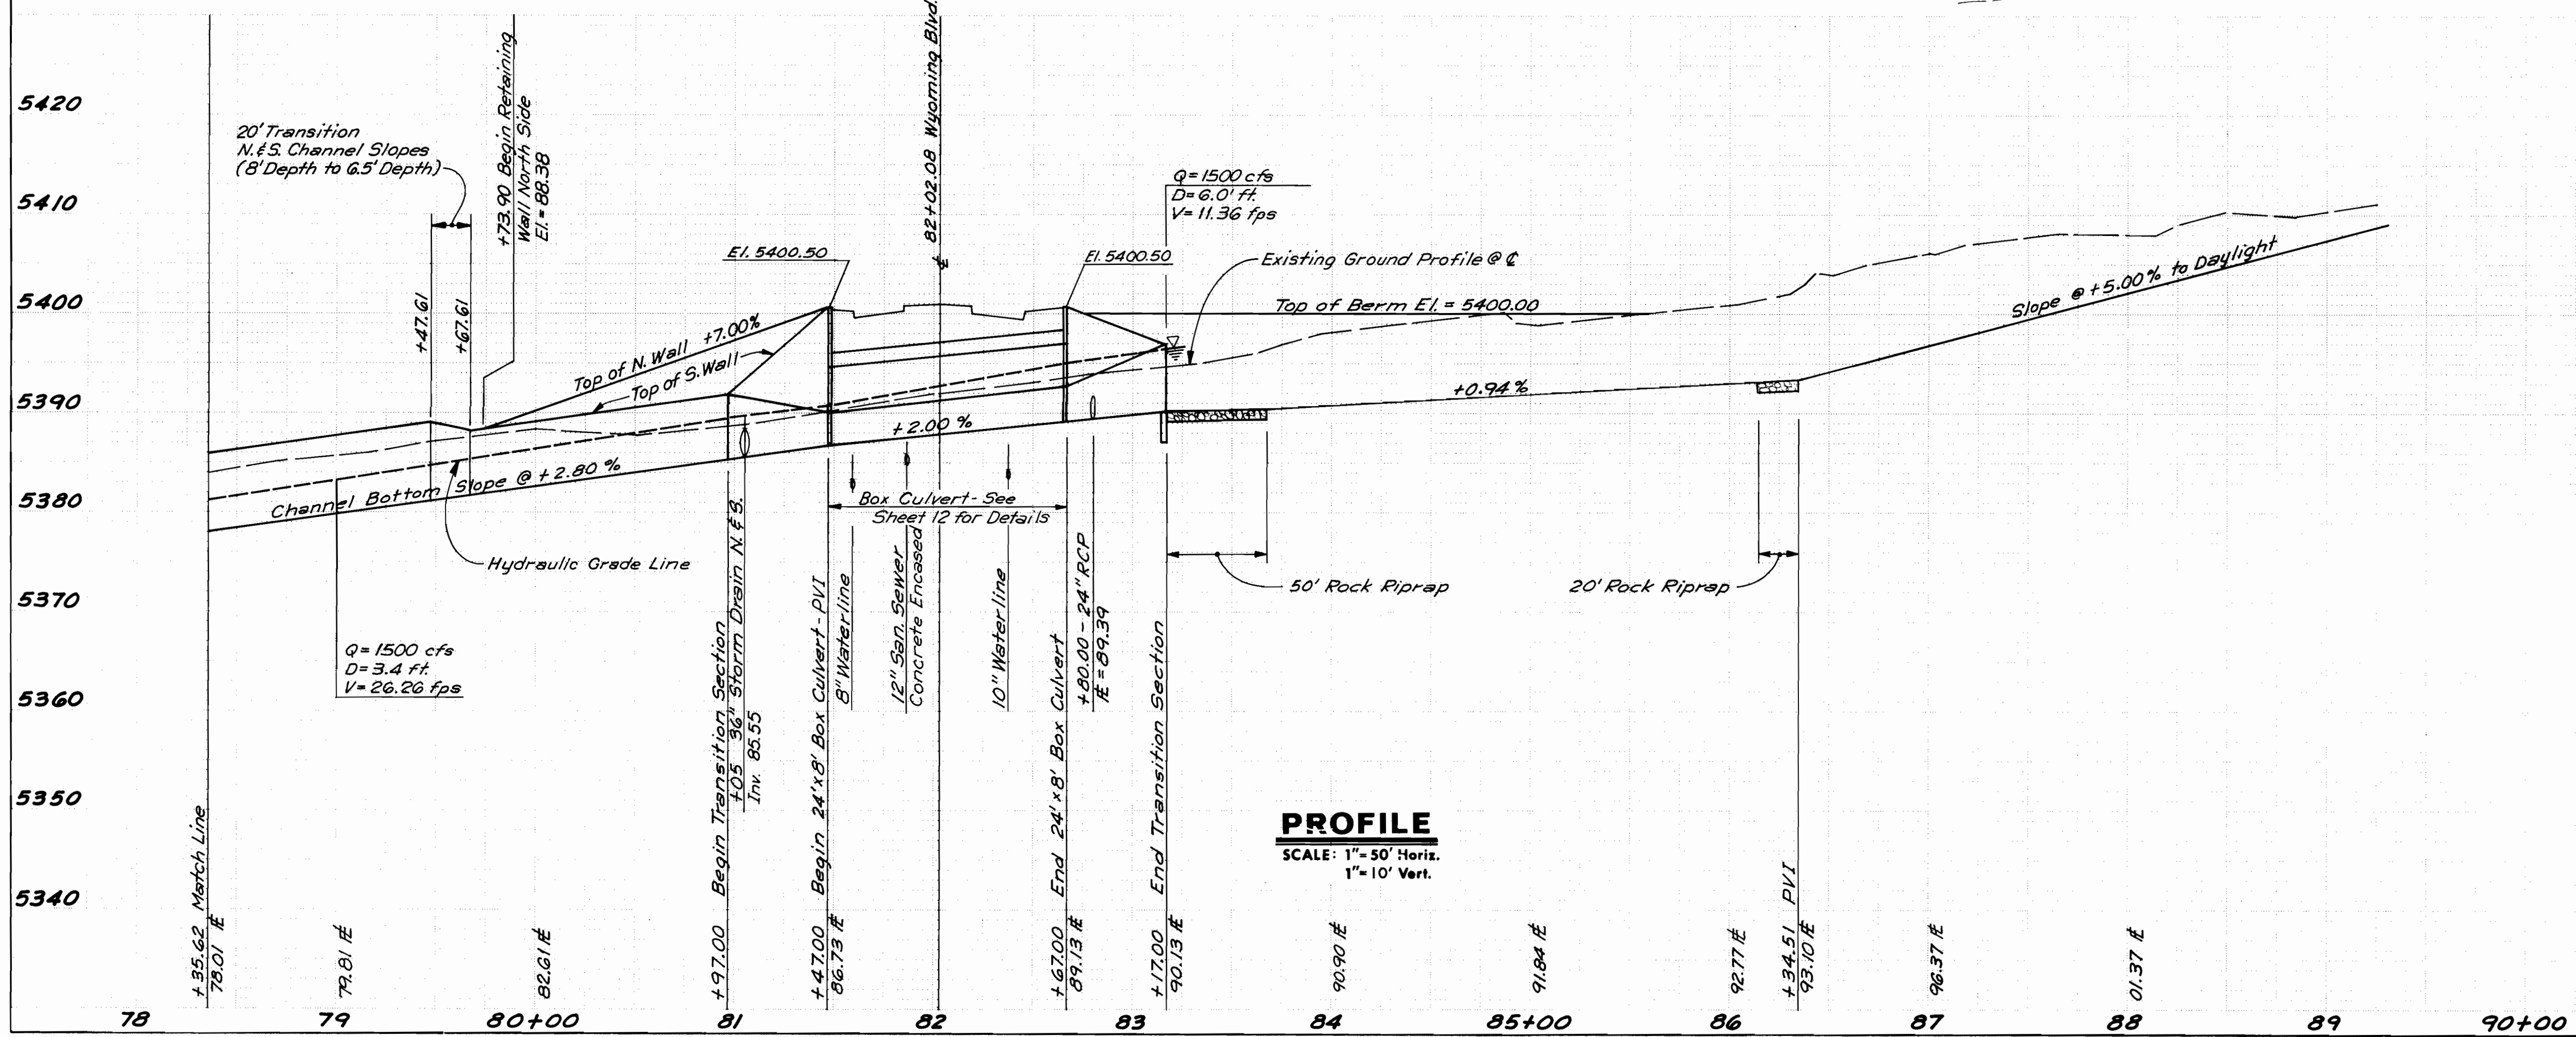





PROFILE
SCALE: 1" = 50' Horiz.
1" = 10' Vert.

- NOTES:
- SEE SHEET 29 FOR STORM DRAIN.
 - SEE SHEET 31 FOR WATERLINE.

John A. Anderson
RECORD DRAWING
26 21510887

CITY OF ALBUQUERQUE MUNICIPAL DEVELOPMENT DEPARTMENT ENGINEERING DIVISION					
PINO ARROYO CORRIDOR IMPROVEMENTS					
ARROYO CHANNELIZATION					
PLAN & PROFILE STA. 78+35.62 TO E.O.P.					
APPROVALS	ENGINEER	DATE	APPROVALS	ENGINEER	DATE
City Engineer	<i>John A. Anderson</i>	11/21/86	Liquid Waste	N/A	1-31-86
A.C.E. - Design	<i>John A. Anderson</i>	1/31/86	Traffic	D.A. Parks	1-31-86
A.C.E. - Hydrology	K.K. Royal	1-31-86	Water	N/A	1-31-86
DRAWING NO. 2151			MAP NO. E-18, E-19		
SHEET 8			OF 34		

SURVEY INFORMATION		BENCH MARKS		AS BUILT INFORMATION	
NO.	BY	DATE	ELEVATION	CONTRACTOR	DATE
1	BY	DATE	5337.039	MOORE & CONERT	1987
2	BY	DATE	5337.039	INSPECTION	1987
3	BY	DATE	5337.039	VERIFICATION BY CITY	1987
4	BY	DATE	5337.039	VERIFICATION BY CITY	1987
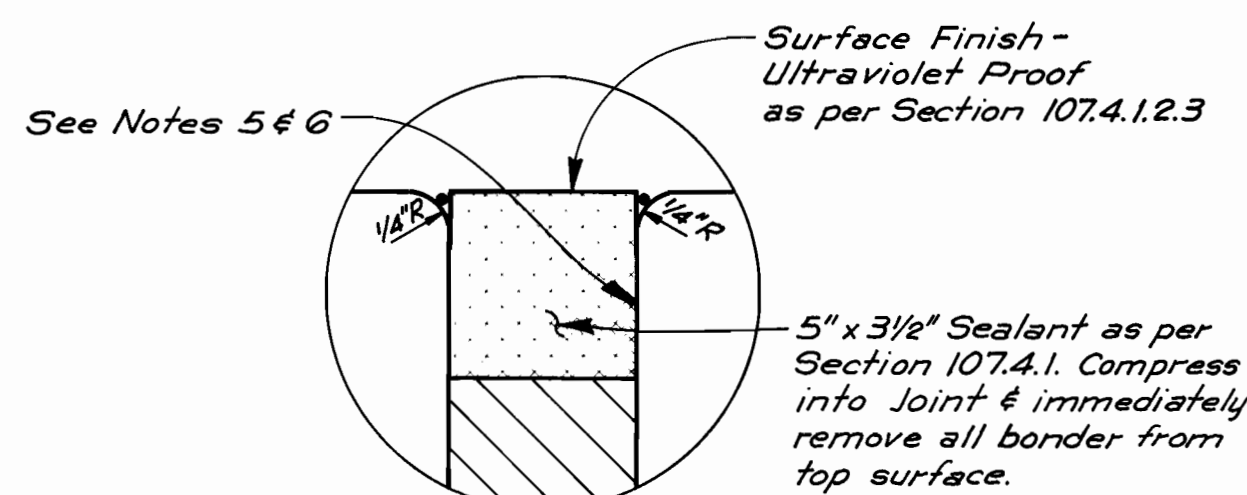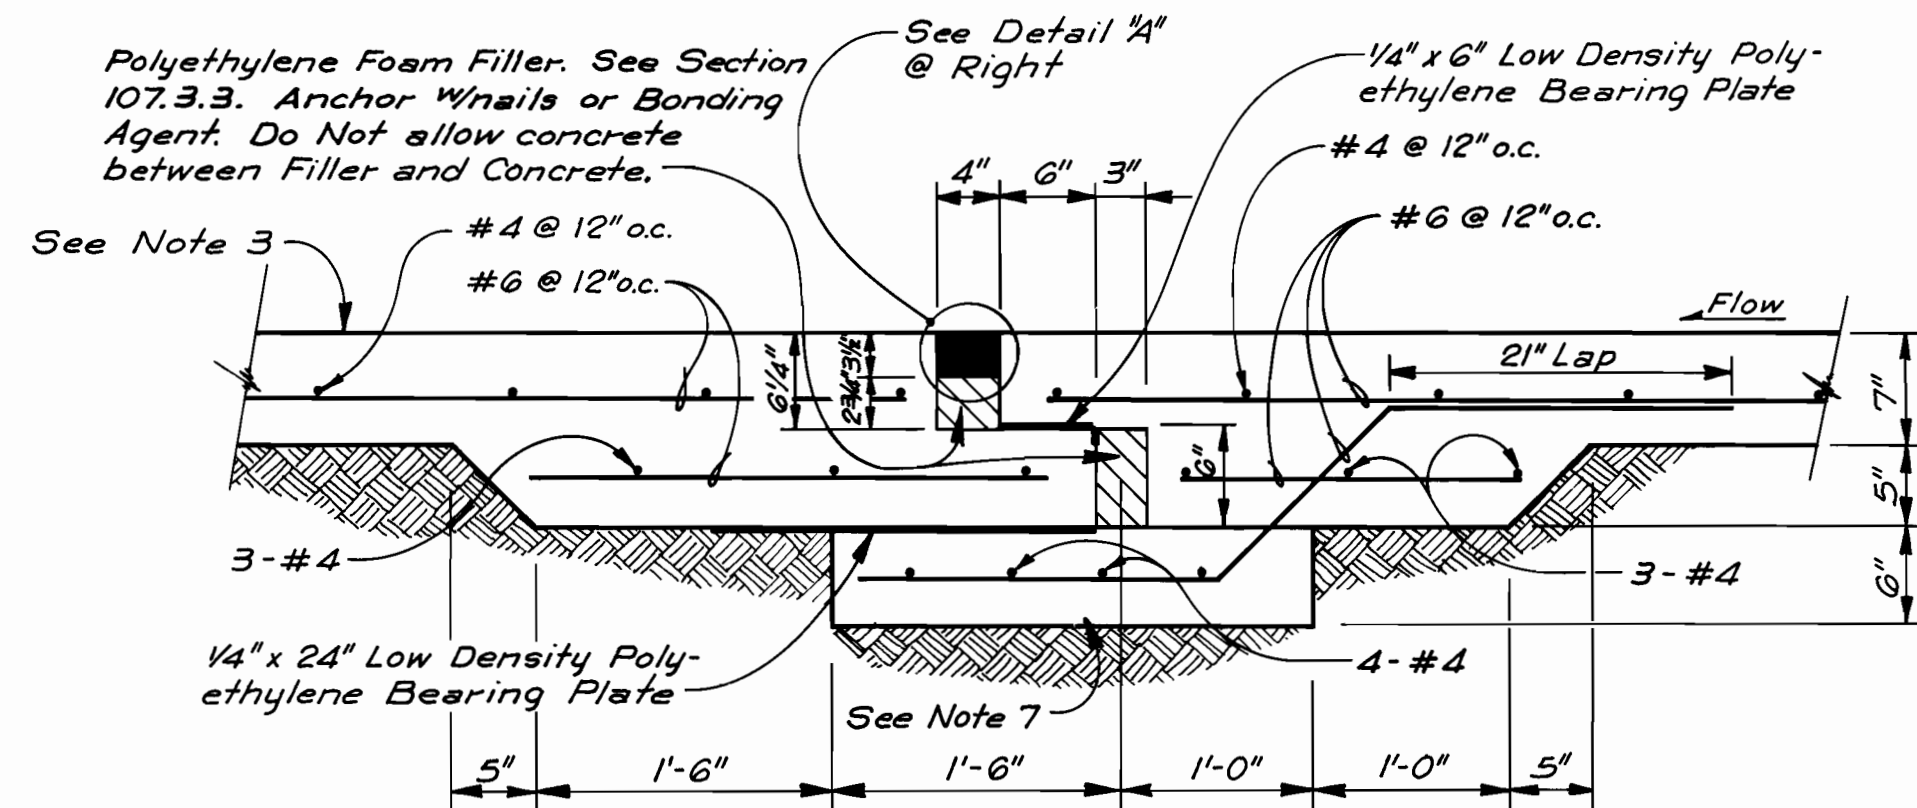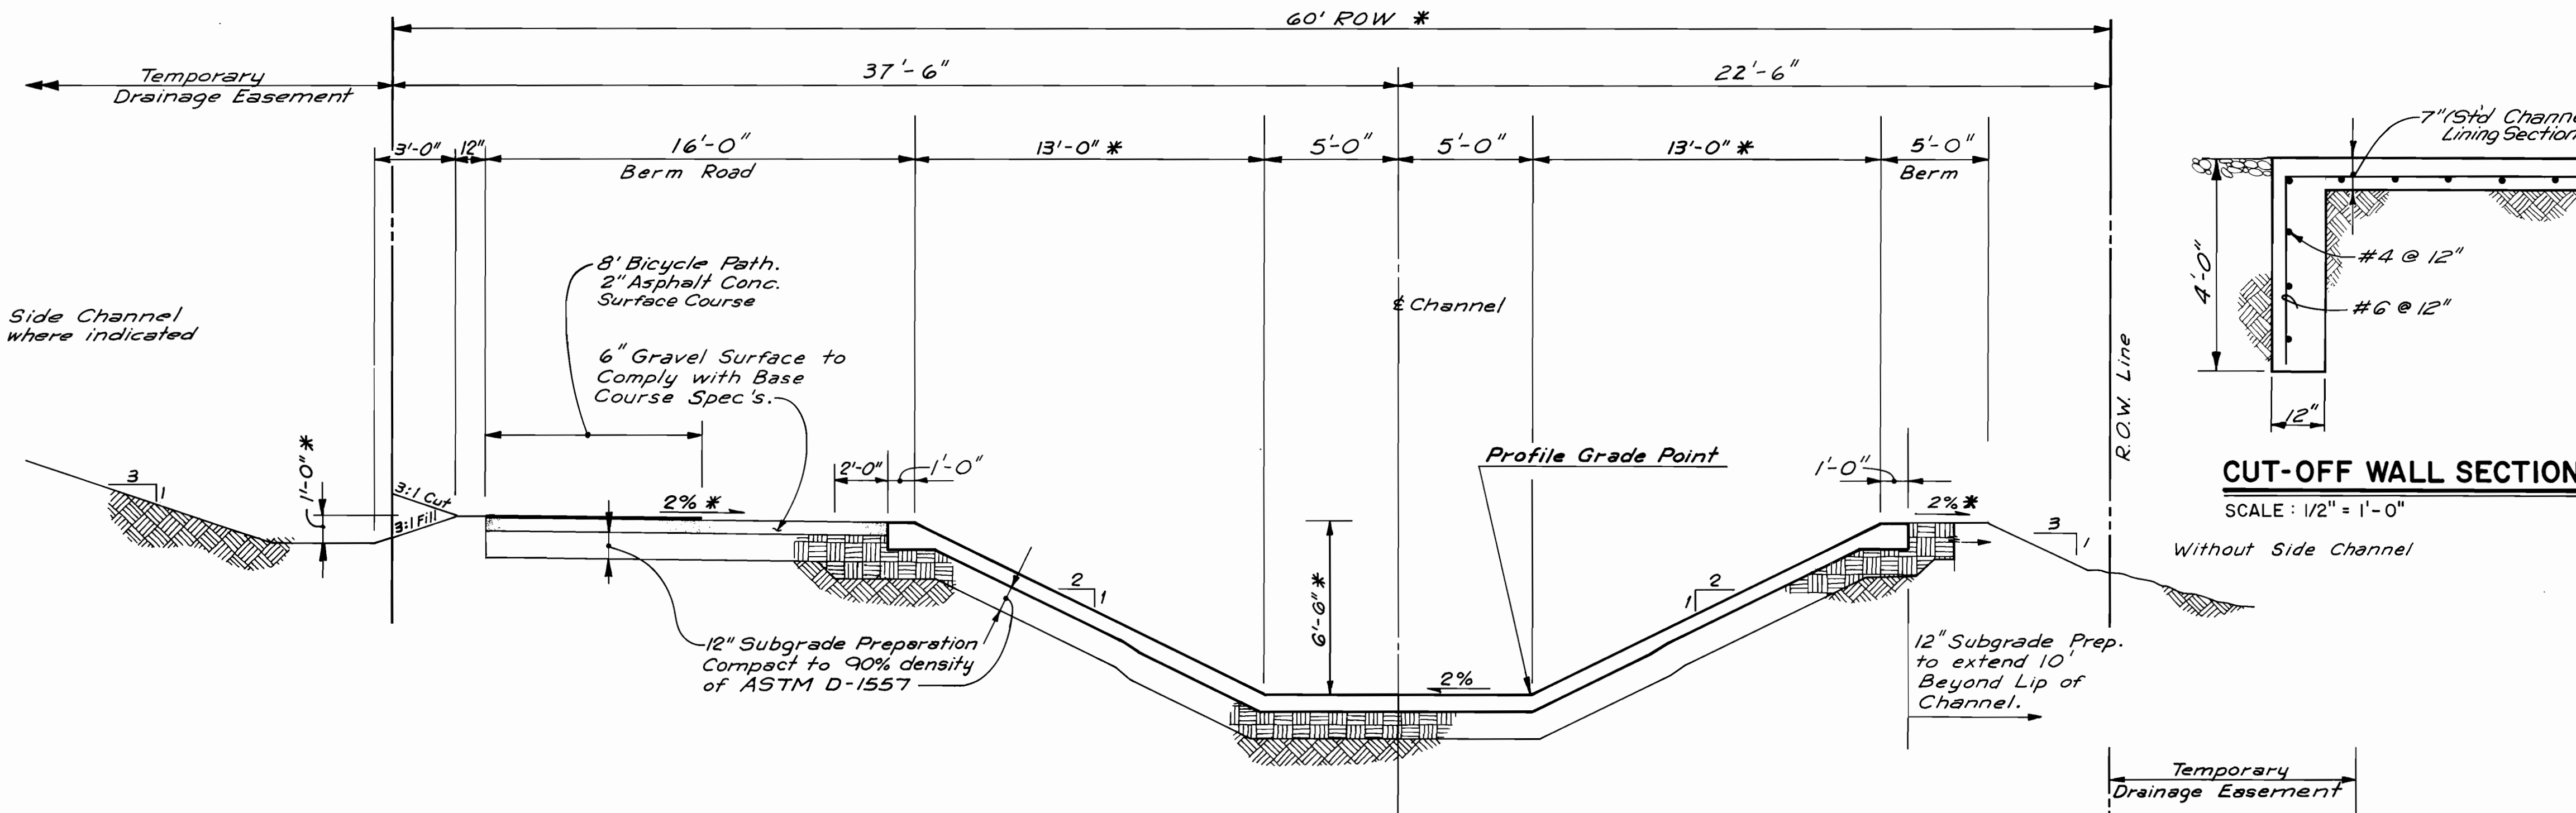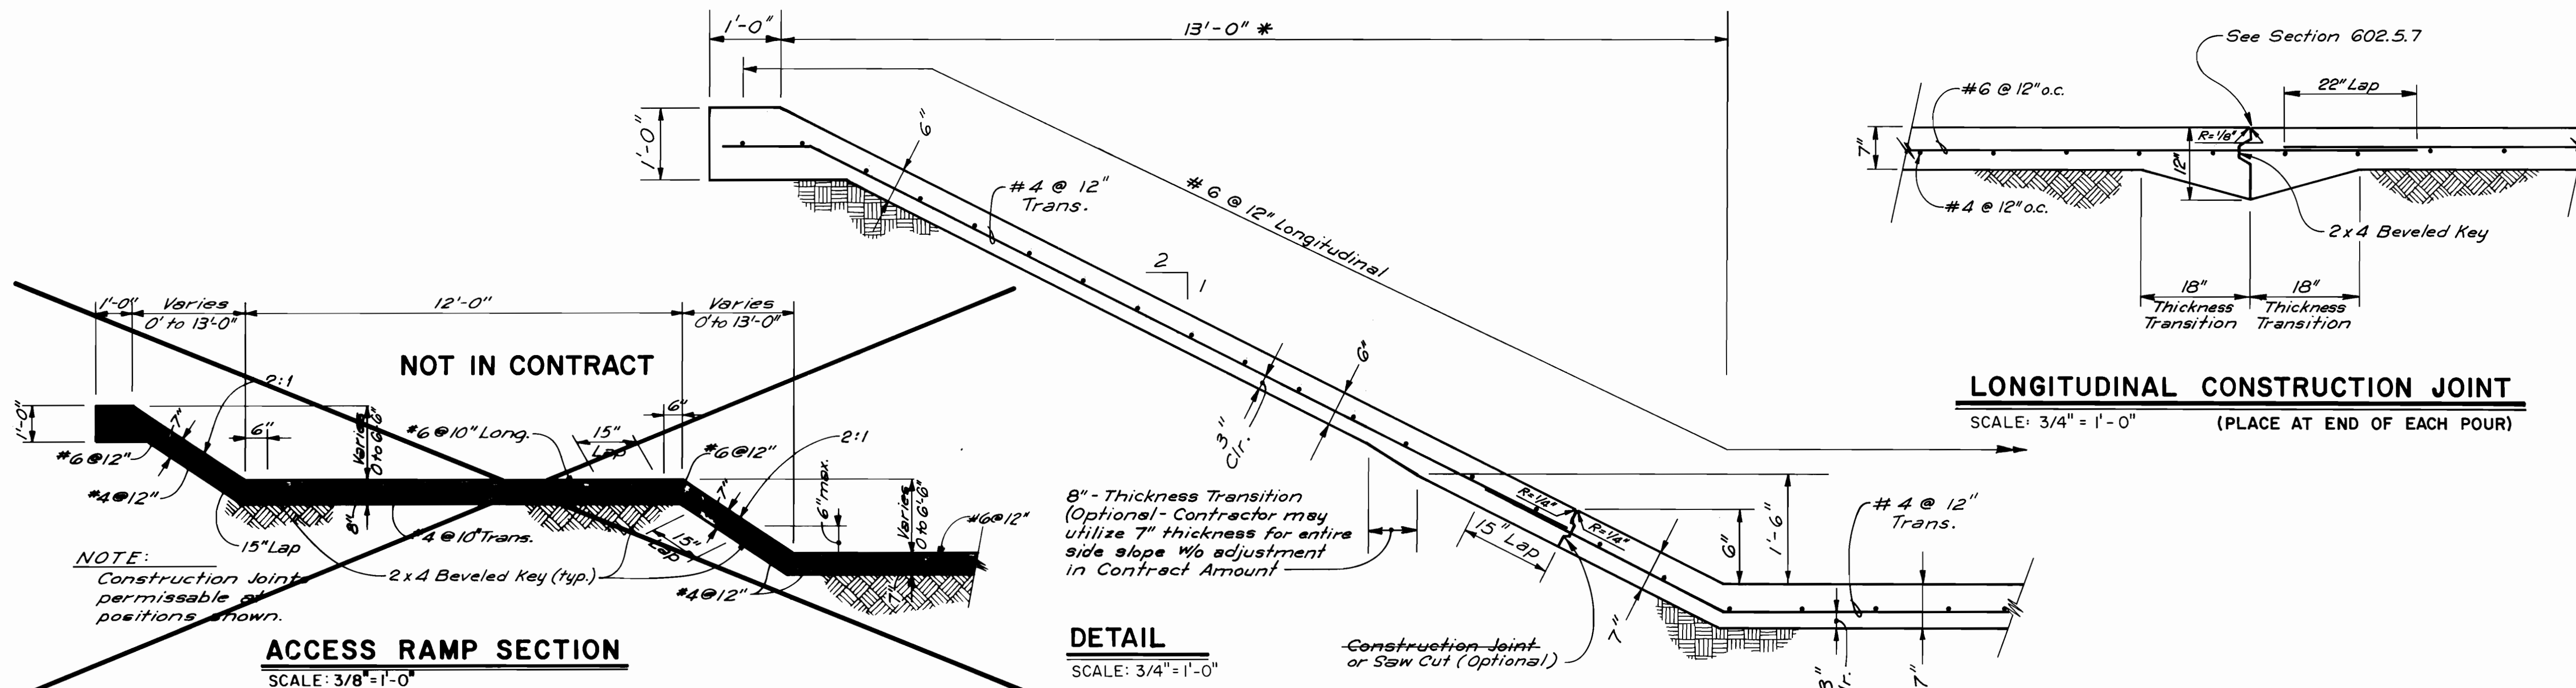

NOTES

1. LANDFILL MATERIAL FOUND WITHIN THE LIMITS OF THE CHANNEL OR BENEATH THE ACCESS ROAD SHALL BE REMOVED TO THE LIMITS DIRECTED BY THE ENGINEER AND HAULED TO A SUITABLE DISPOSAL SITE. EXCAVATED AREA SHALL BE BACKFILLED AND COMPACTED TO 90% DENSITY AS DETERMINED BY ASTM D-1557.

CONSTRUCTION NOTES FOR EXPANSION JOINT WITH CONCRETE SLEEPER


- AS SOON AS JOINT IS COMPLETE, EXPOSED ENDS OF JOINT SHALL BE COVERED WITH A SHEET OF 16 GA. GALV. STEEL ANCHORED TO CONCRETE AT TWO CORNERS ON ONE SIDE OF JOINT. THE SHEET SHALL HAVE 1/4" CRIMPED EDGES AND WILL EXTEND AT LEAST 3" PAST SEALANT, FILLER ON THE SIDES, 3" BELOW LOWER BEARING PLATE AND BE FLUSH TO TOP OF JOINT.
- JOINT MATERIALS TO BE PLACED ACCORDING TO MANUFACTURER'S RECOMMENDATIONS.
- POUR DOWNSTREAM SECTION, FLY ASH CONCRETE WITH ALUMINUM FLOAT AND DRY BROOM FINISH. STEEL TROWEL BEARING PLATE SURFACE ONLY. SURFACE TO BE PARALLEL TO SURFACE ON SLEEPER. FORM TO REMAIN IN PLACE UNTIL NEXT DAY.
- TIE ALL REINFORCING CONNECTIONS SECURELY. SUPPORT SLEEPER MAT WITH PREFORMED CONCRETE SAND CHAIRS. STEEL SHALL BE FREE OF FERRIC OXIDE (BLACK RUST SCALE).
- SIDE OF FORM TO BE USED TO BLOCK OUT SPACE FOR SEALANT SHALL BE SMOOTH. CLEAN MATERIAL TO AVOID NOSING CONTAMINATION & FOR EASY REMOVAL CONCRETE SHALL BE CURED TO 80% MINIMUM OF DESIGN STRENGTH BEFORE PLACING SEALANT.
- NOSING PREPARATION AND APPLICATION, SECTION 107.4.1.2, BONDING AGENT SECTION 107.4.1.1.
- POUR FLY ASH CONCRETE SLEEPER. STEEL TROWEL BEARING SURFACE ONLY.

RECORD DRAWING
26 21510987


CITY OF ALBUQUERQUE MUNICIPAL DEVELOPMENT DEPARTMENT ENGINEERING DIVISION					
PINO ARROYO CORRIDOR IMPROVEMENTS					
TYPICAL CHANNEL SECTION					
APPROVALS	ENGINEER	DATE	APPROVALS	ENGINEER	DATE
City Engineer	<i>[Signature]</i>	1/20/86	Liquid Waste	N/A BR	1-31-86
A.C.E. - Design	<i>[Signature]</i>	1/31/86	Traffic	S.A. 1/31/86	1-31-86
A.C.E. - Hydrology	<i>[Signature]</i>	1-31-86	Water	N/A BR	1-31-86
DRAWING NO.	2151	MAP NO.	E-18, E-19	SHEET	9 OF 34

AS BUILT INFORMATION		BENCH MARKS		SURVEY INFORMATION		ENGINEER'S SEAL	
CONTRACTOR	Moore & Conner	DATE	1987	DATE	1987		
DESIGNED BY	A.A.R.	DATE	1987	DATE	1987		
INSPECTED BY	City	DATE	1987	DATE	1987		
VERIFICATION BY	CHALAPAR	DATE	1987	DATE	1987		
CORRECTED BY	A.A.R.	DATE	1987	DATE	1987		
RECORDED BY	NO	DATE		DATE			
NO		DATE		DATE			
NO		DATE		DATE			


ANDREWS, ASBURY & ROBERT, INC.
REGISTERED PROFESSIONAL ENGINEERS
1515 15th St. N.E.
ALBUQUERQUE, N.M. 87102

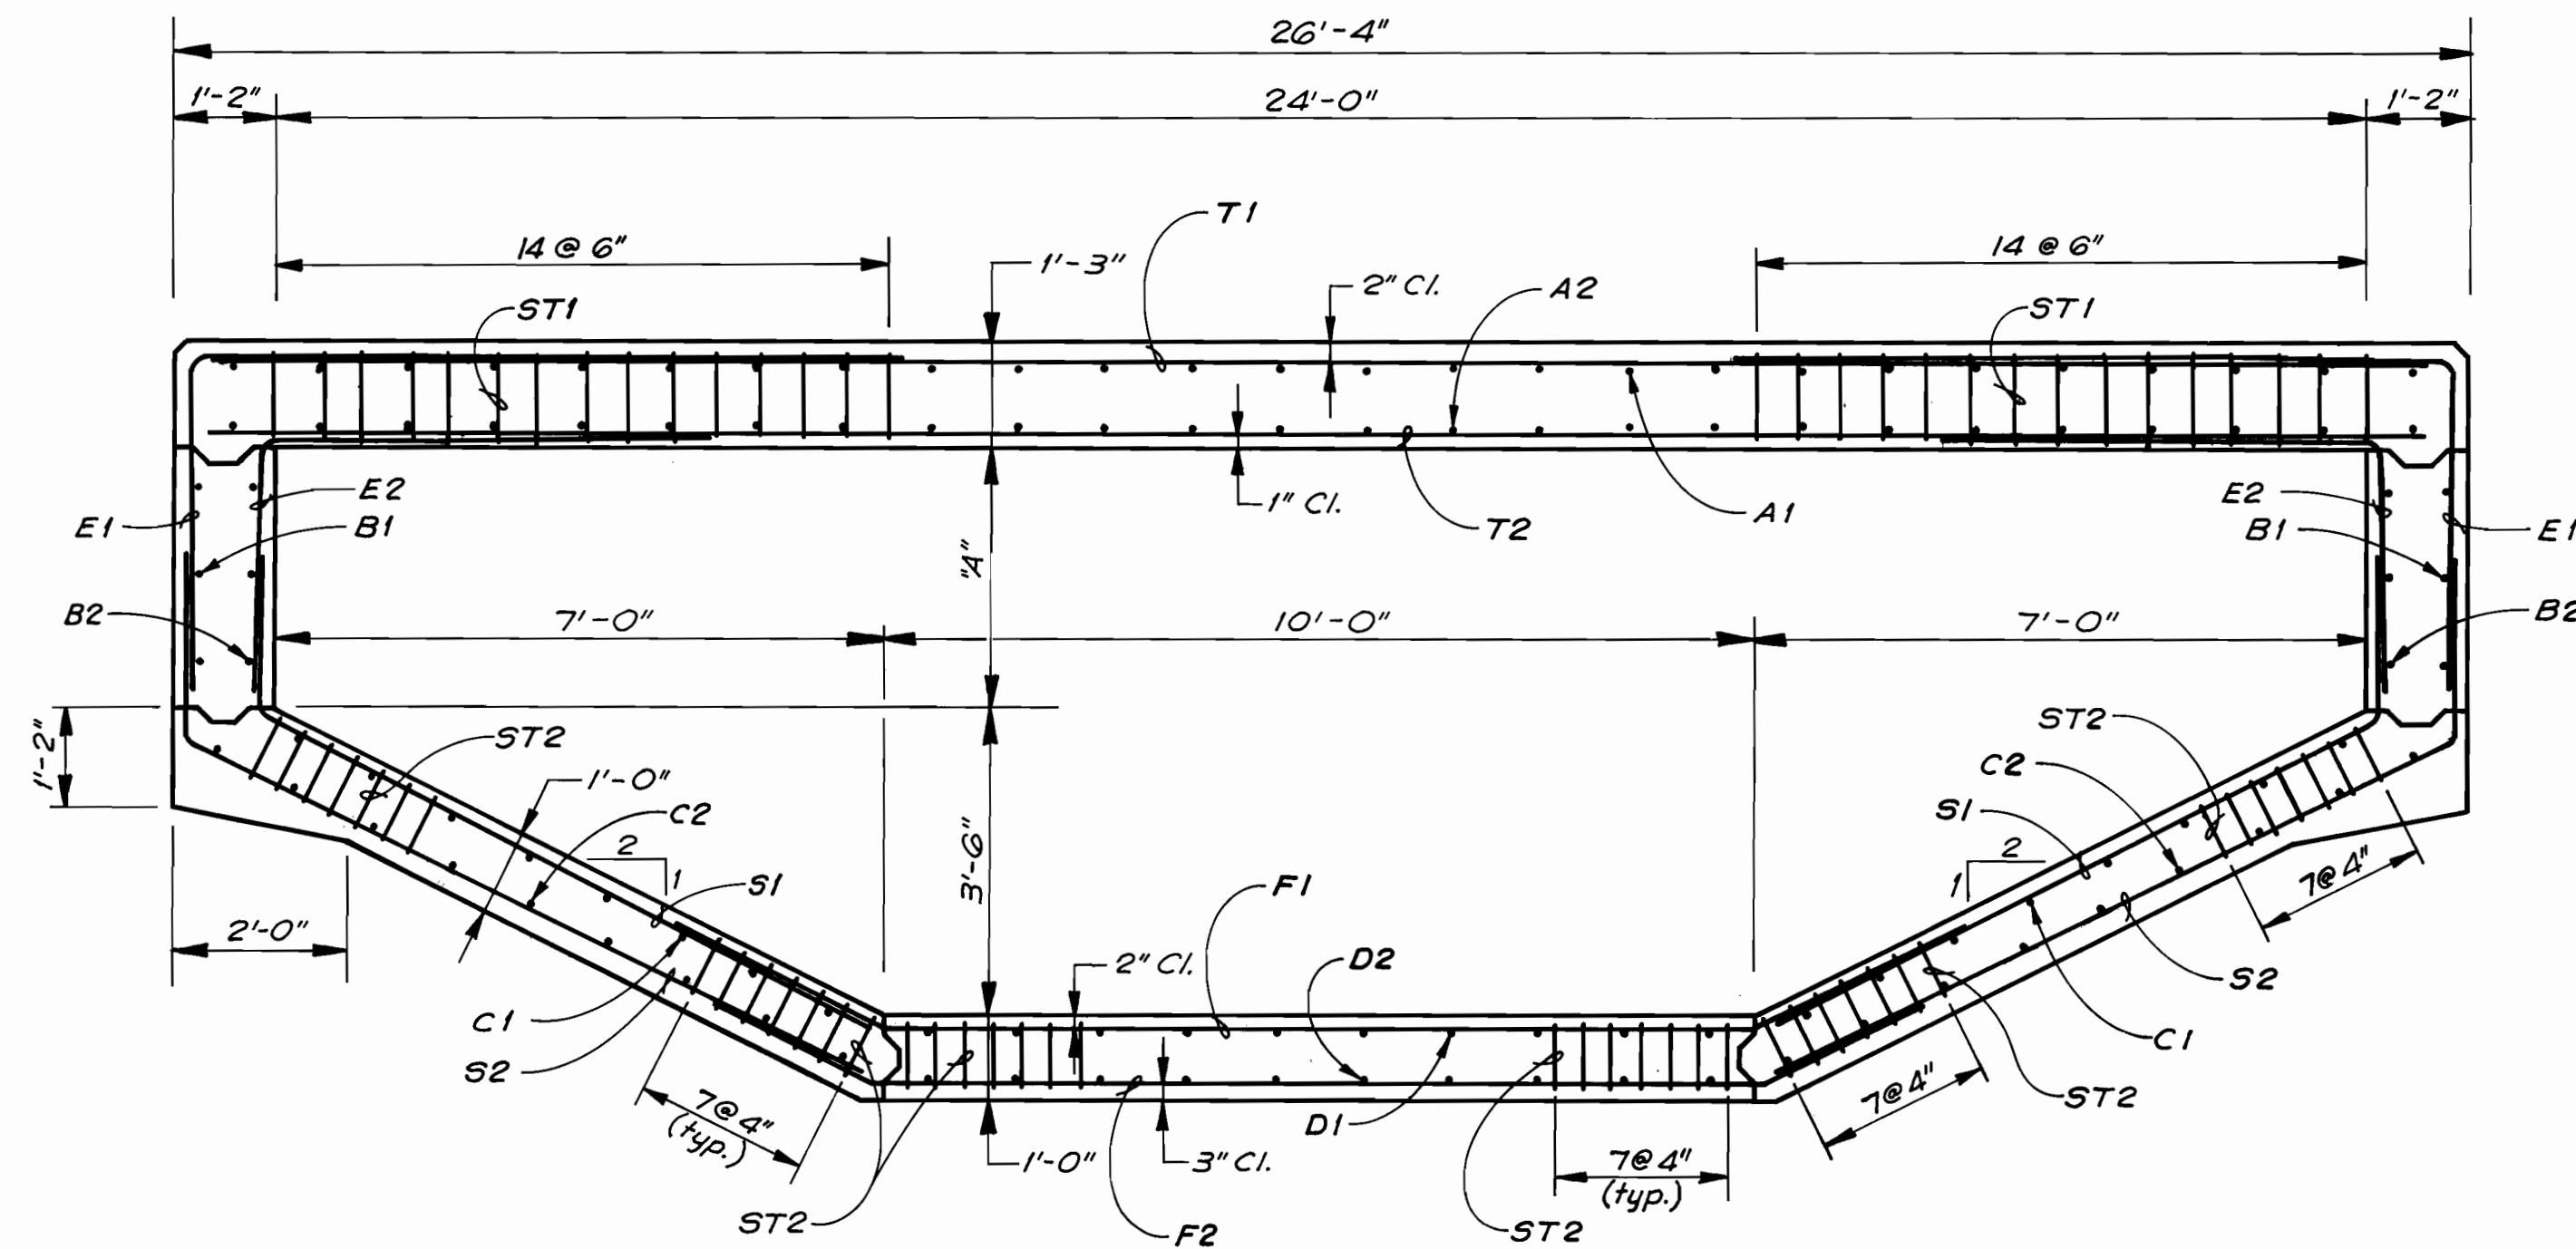


**TYPICAL SECTION
BOX CULVERT**
SCALE: 1/2" = 1'-0"

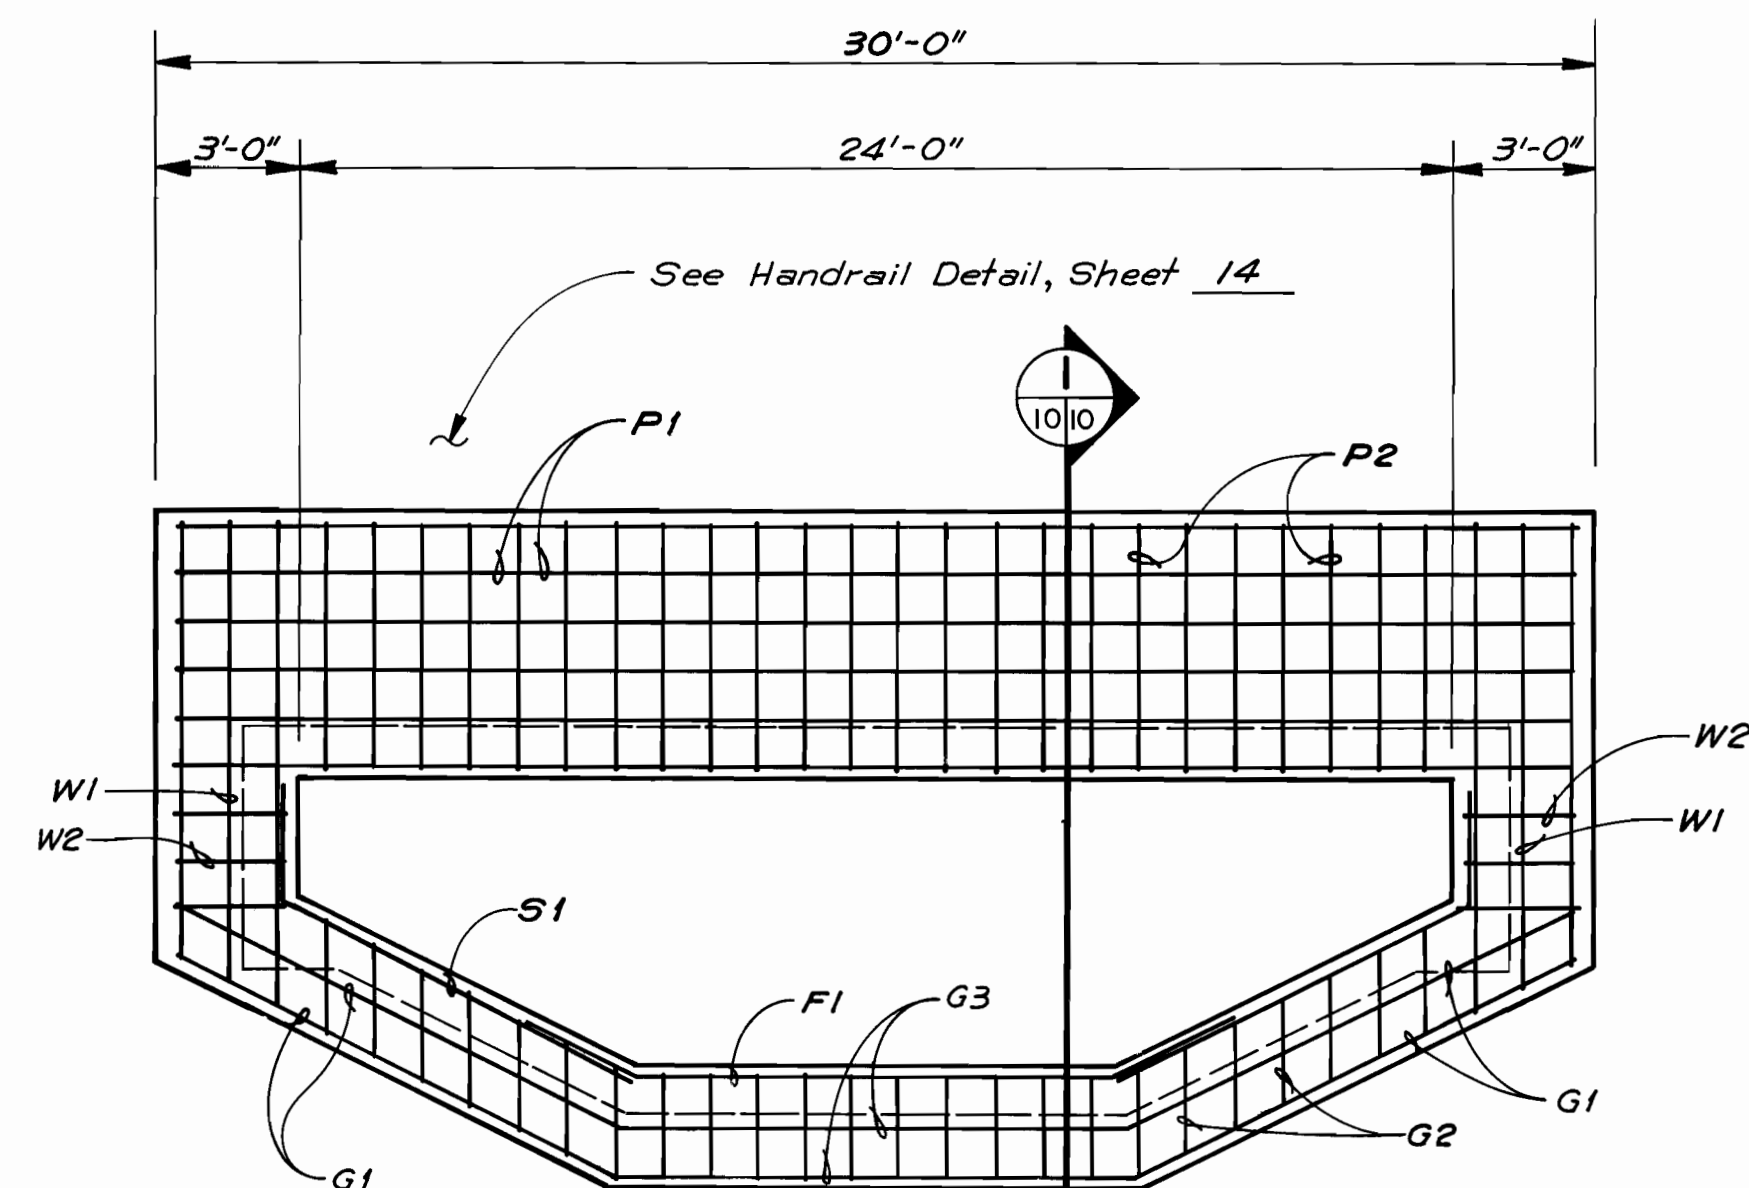

**ELEVATION
BOX CULVERT HEADWALL**
SCALE: 1/4" = 1'-0"

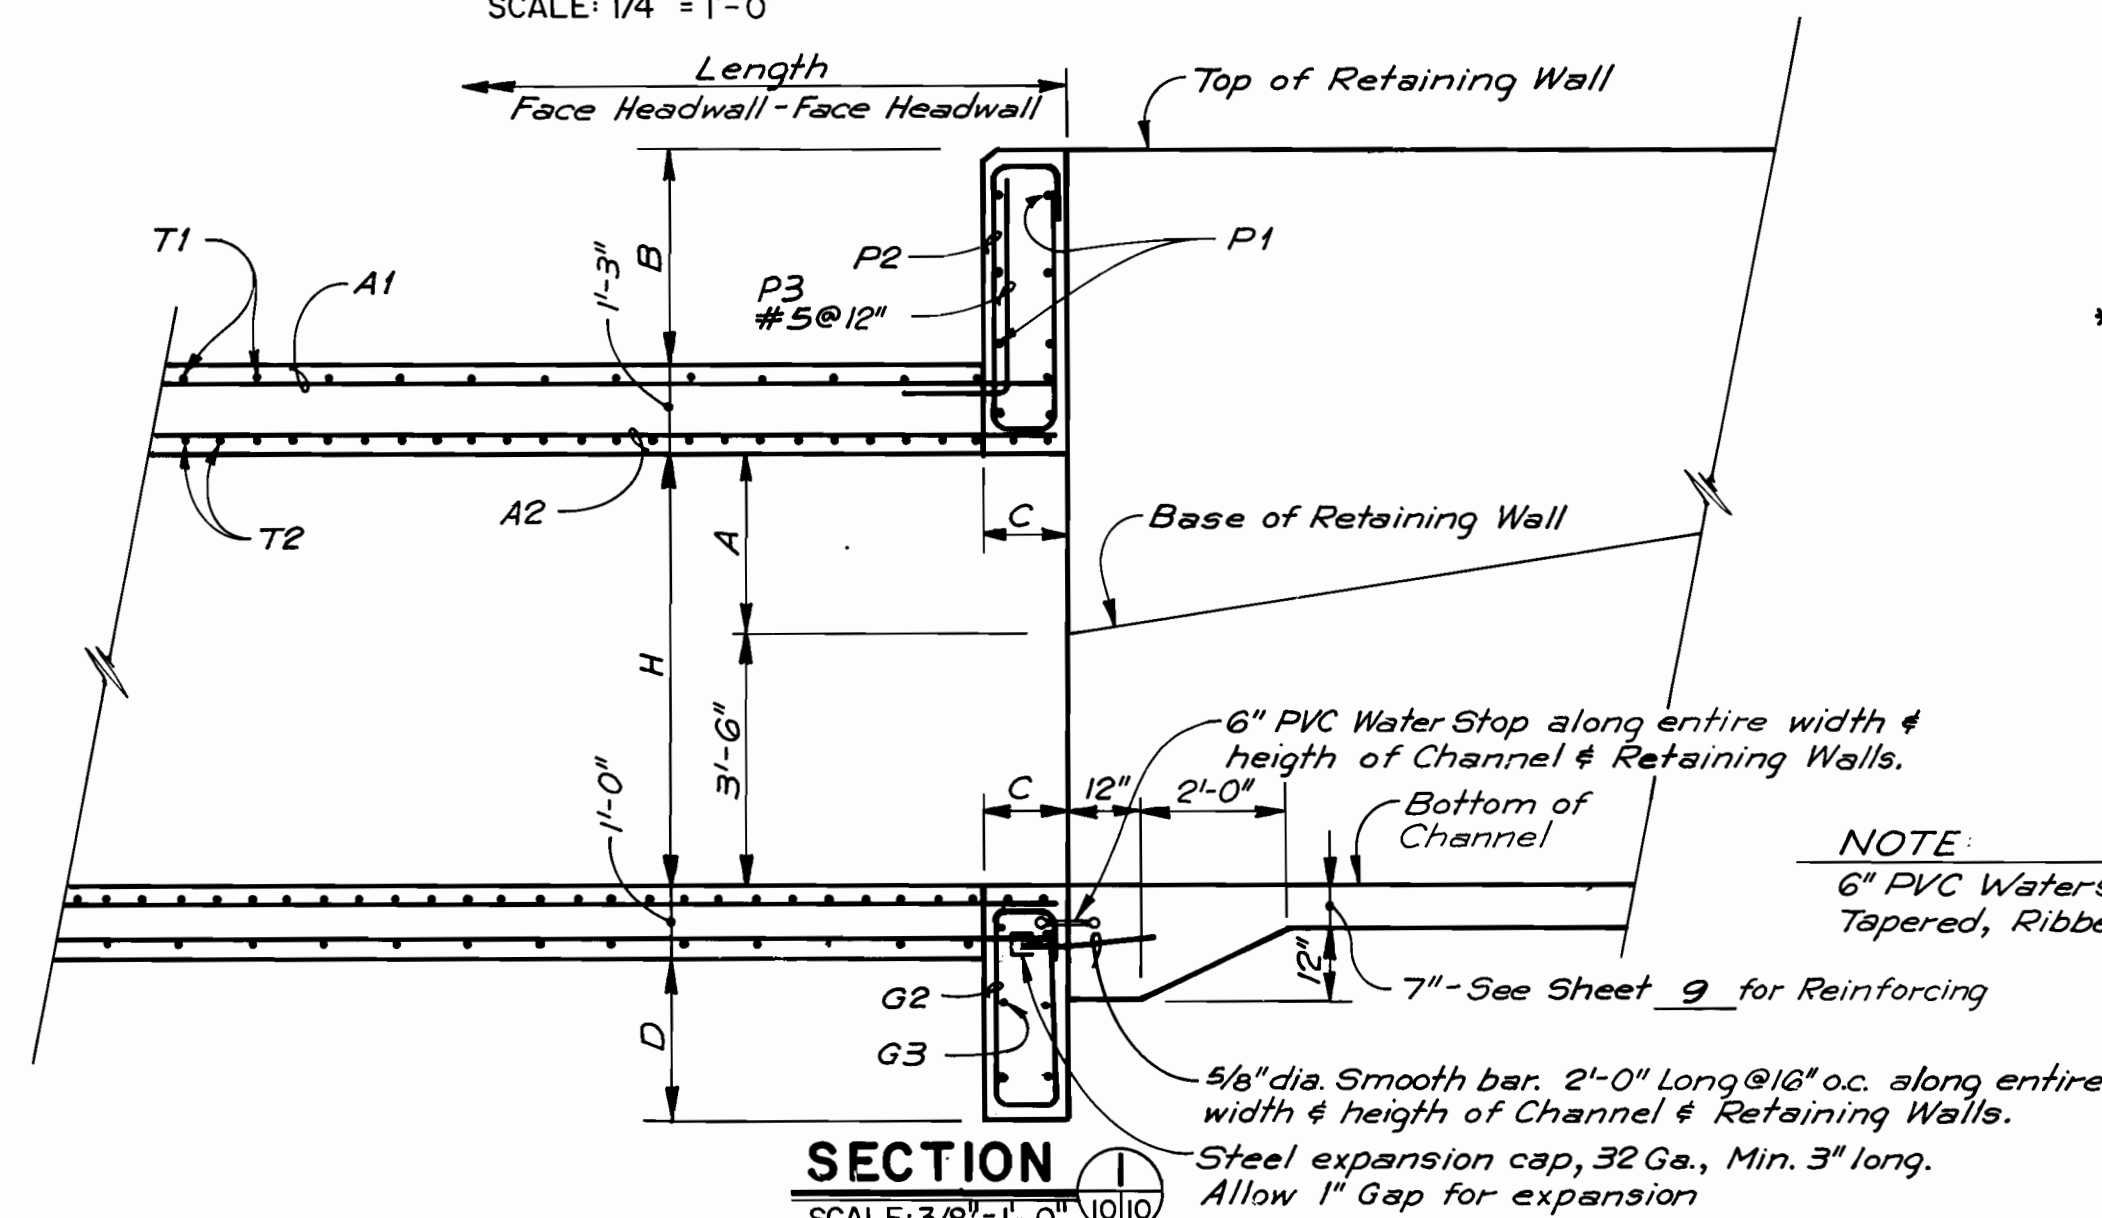


SECTION
SCALE: 3/8" = 1'-0"

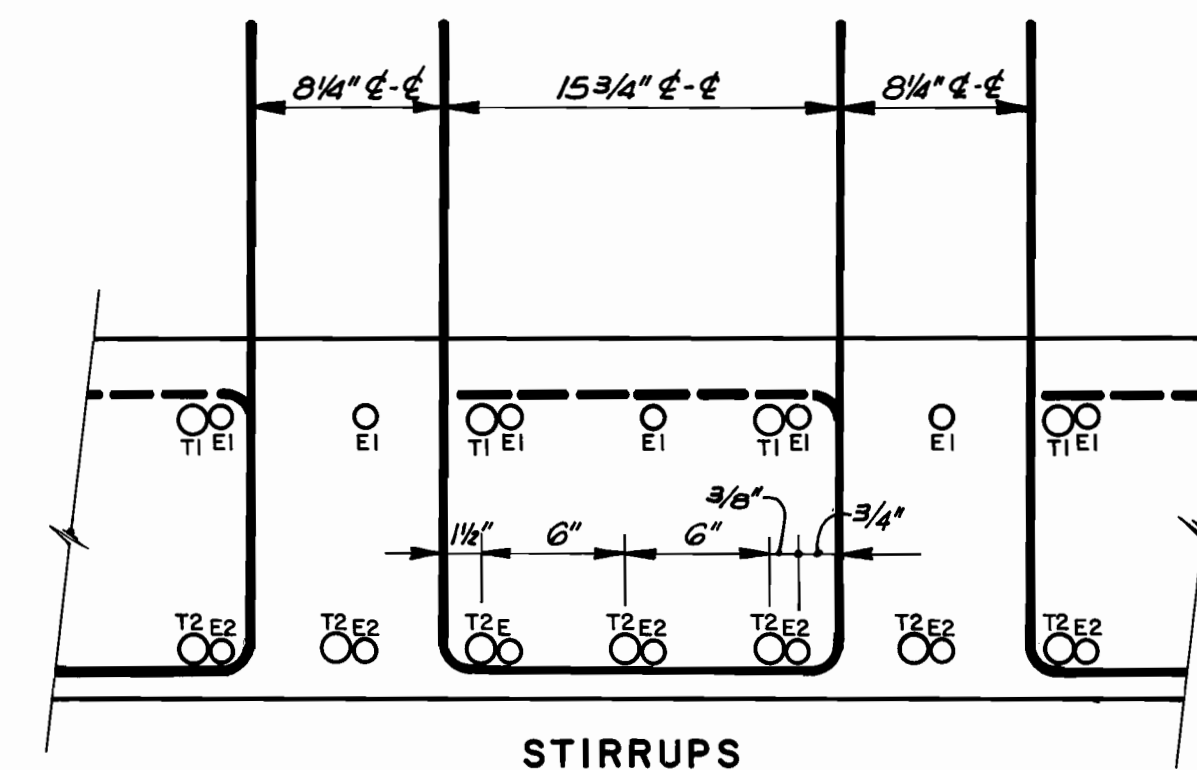

BAR BENDING DIAMETERS										
Bar Size	#3	#4	#5	#6	#7	#8	#9	#10	#11	
'D' (dia. inch)	2.25	3.0	3.75	4.5	5.25	6.0	9.0	10.25	11.25	
Stirrup 'D'	1.5	2.0	2.5	3.0	—	—	—	—	—	

BAR BENDING DETAILS

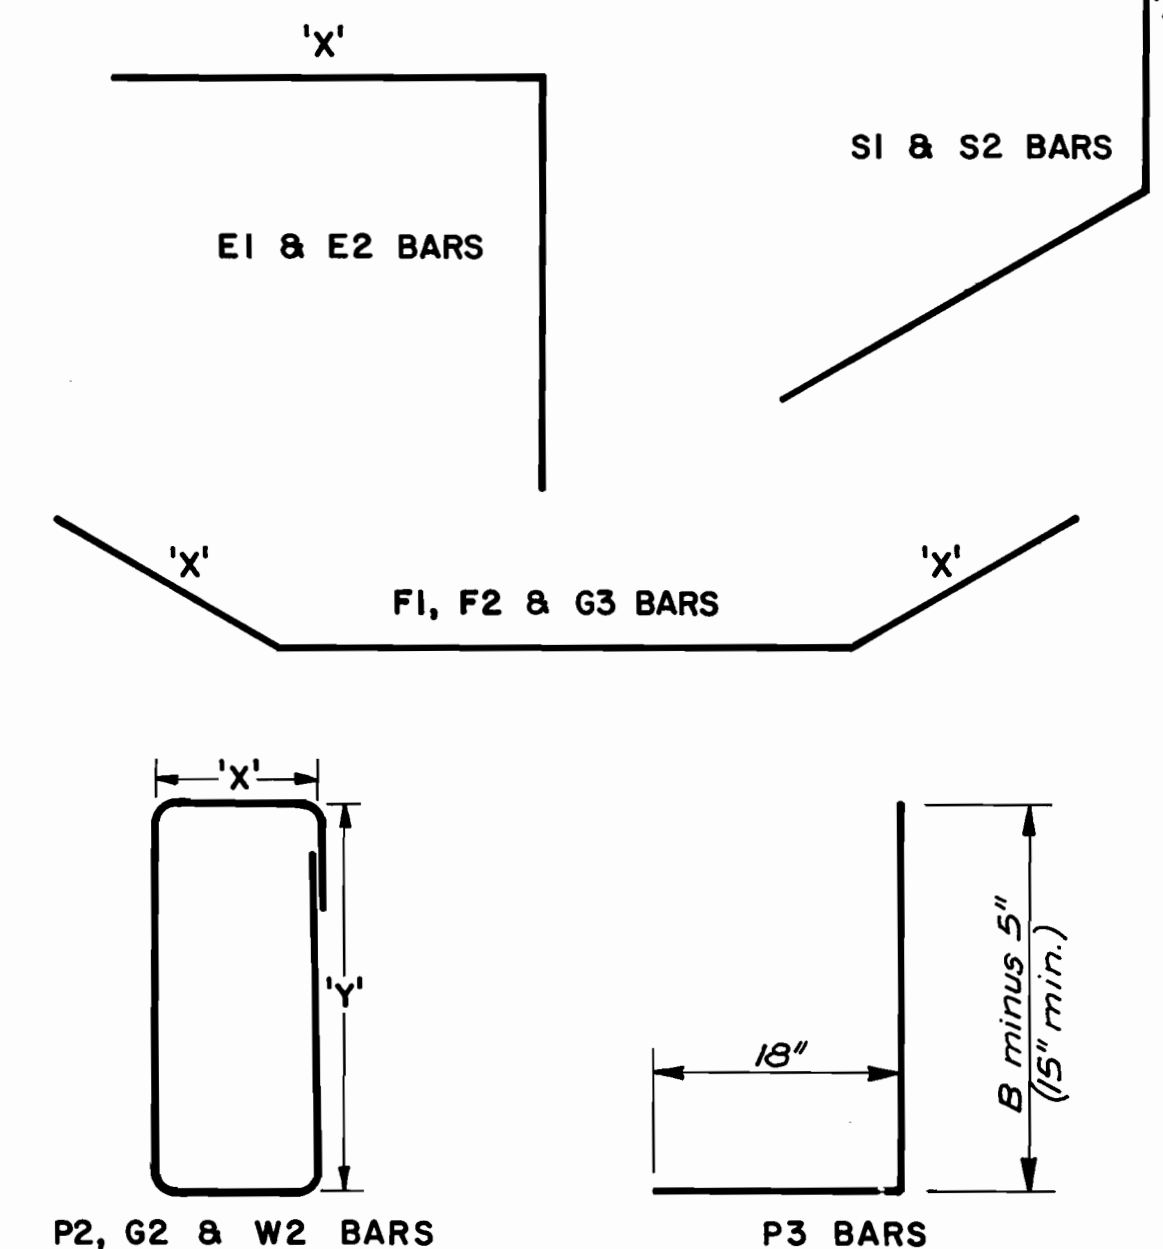

***NOT IN CONTRACT**

CROSSING	A1		A2		B1		B2		C1		C2		D1		D2		E1		E2		F1	
	SIZE	SPACING	SIZE	SPACING	SIZE	SPACING	SIZE	SPACING	SIZE	SPACING	SIZE	SPACING	SIZE	SPACING	SIZE	SPACING	SIZE	SPACING	SIZE	SPACING	SIZE	SPACING
* San Pedro Dr.	#4	12"	#4	12"	#4	12"	#4	12"	#4	12"	#4	12"	#4	12"	#4	12"	#4	12"	#4	12"	#4	12"
Louisiana Blvd.	#4	12"	#4	12"	#4	12"	#4	12"	#4	12"	#4	12"	#4	12"	#4	12"	#4	12"	#4	12"	#4	12"
San Antonio Dr.	#4	12"	#4	12"	#4	12"	#4	12"	#4	12"	#4	12"	#4	12"	#4	12"	#4	12"	#4	12"	#4	12"
Wyoming Blvd.	#4	12"	#4	12"	#4	12"	#4	12"	#4	12"	#4	12"	#4	12"	#4	12"	#4	12"	#4	12"	#4	12"

CROSSING	F2		S1		S2		T1		T2		ST1		ST2	
	SIZE	SPACING	SIZE	SPACING	SIZE	SPACING	SIZE	SPACING	SIZE	SPACING	SIZE	SPACING	SIZE	SPACING
* San Pedro Dr.	#4	12"	#4	12"	#4	12"	#4	12"	#4	12"	#4	12"	#4	12"
Louisiana Blvd.	#4	12"	#4	12"	#4	12"	#4	12"	#4	12"	#4	12"	#4	12"
San Antonio Dr.	#4	12"	#4	12"	#4	12"	#4	12"	#4	12"	#4	12"	#4	12"
Wyoming Blvd.	#4	12"	#4	12"	#4	12"	#4	12"	#4	12"	#4	12"	#4	12"

(UPSTREAM ONLY)												(UPSTREAM ONLY)																
CROSSING	P1			P2				G1			G2				G3				W1			W2						
	SIZE	SPACING	LENGTH	SIZE	SPACING	LENGTH	'X'	'Y'	SIZE	SPACING	LENGTH	SIZE	SPACING	LENGTH	'X'	'Y'	SIZE	SPACING	LENGTH	'X'	SIZE	SPACING	LENGTH	'X'	'Y'			
* San Pedro Dr.	#4	12"	29'-8"	#7	12"	31'-4"	10"	3'-9"	#8	12"	10'-0"	#4	12"	9'-10"	10"	3'-9"	#6	12"	15'-0"	2'-6"	#7	12"	10'-10"	#7	12"	7'-5"	0'-10"	2'-8"
Louisiana Blvd.	#4	12"	29'-8"	#7	12"	11'-7"	10"	4'-9"	#6	12"	10'-0"	#4	12"	9'-10"	10"	3'-9"	#6	12"	15'-0"	2'-6"	#9	12"	13'-9"	#7	12"	7'-5"	0'-10"	2'-8"
San Antonio Dr.	#4	12"	29'-8"	#7	12"	9'-7"	10"	3'-9"	#6	12"	10'-0"	#4	12"	9'-10"	10"	3'-9"	#6	12"	15'-0"	2'-6"	#9	12"	12'-9"	#7	12"	7'-5"	0'-10"	2'-8"
Wyoming Blvd.	#4	12"	29'-8"	#7	12"	10'-9"	10"	4'-4"	#6	12"	10'-0"	#4	12"	9'-10"	10"	3'-9"	#6	12"	15'-0"	2'-6"	#9	12"	14'-3"	#7	12"	7'-5"	0'-10"	2'-8"

UPSTR'DWNSTR'M							
CROSSING	LENGTH	A	H	B	B	C	D
* San Pedro Dr.	100'-0"	4'-6"	8'-0"	3'-11 3/4"	4'-9"	1'-2"	3'-3"
Louisiana Blvd.	35'-3"	4'-6"	8'-0"	2'-11 3/8"	3'-7 1/8"	1'-2"	3'-3"
San Antonio Dr.	120'-0"	4'-6"	8'-0"	2'-11 3/8"	4'-6"	1'-2"	3'-3"

DOWNSTREAM ONLY

CROSSING	SIZE	SPACING	LENGTH	SIZE	SPACING	LENGTH	'X'	'Y'
* San Pedro Dr.	#4	12"	29'-8"	#4	12"	29'-8"	10'	4'-6"
Louisiana Blvd.	#4	12"	29'-8"	#4	12"	29'-8"	10'	4'-6"
San Antonio Dr.	#4	12"	29'-8"	#4	12"	29'-8"	10'	4'-6"
Wyoming Blvd.	#4	12"	29'-8"	#4	12"	29'-8"	10'	4'-6"

John Q. Andrews
RECORD DRAWING

26 21511087

CITY OF ALBUQUERQUE
MUNICIPAL DEVELOPMENT DEPARTMENT
ENGINEERING DIVISION

PINO ARROYO CORRIDOR IMPROVEMENTS

CROSSING STRUCTURE DETAILS

APPROVALS	ENGINEER	DATE	APPROVALS	ENGINEER	DATE
City Engineer	<i>John Q. Andrews</i>	11/29/86	Liquid Waste	N/A B.R.	1-31-86
A.C.E. Design	<i>John Q. Andrews</i>	12/31/86	Traffic	N/A B.R.	1-31-86
Hydrology	<i>John Q. Andrews</i>	1-31-86	Water	N/A B.R.	1-31-86

DRAWING NO. **2151** MAP NO. **E-18, E-19** SHEET **10** OF **34**

AS BUILT INFORMATION

CONTRACTOR: Moore & Conner
WORK NO. 12-E18 1978
INSPECTOR: DATE 10/87
ACCEPTANCE BY CITY: DATE 10/87
VERIFICATION BY CITY: DATE 10/87
DRAWINGS: DATE 10/87
CORRECTED BY: DATE 10/87
RECORDED BY: DATE

BENCH MARKS

ACS STA "12-E18 1978"
ELEVATION 5337.039
ACS BRASS TABLET SET ON CONCRETE POST FLUSH W/GROUND
LOCATED 41 FEET SOUTH OF THE CENTERLINE OF SAN ANTONIO
DRIVE AND 34 FEET WEST OF THE CENTERLINE OF LOUISIANA
BOULEVARD

SURVEY INFORMATION

FIELD NOTES

NO. BY DATE

ENGINEER'S SEAL


PROFESSIONAL ENGINEER
STATE OF NEW MEXICO
JOHN ANDREWS
ANDREWS, ASBURY & ROBERT, INC.
ALBUQUERQUE, N.M. 87102
78-138

REVISIONS


NO. DATE

REMARKS

DESIGNED BY
DRAWN BY
CHECKED BY

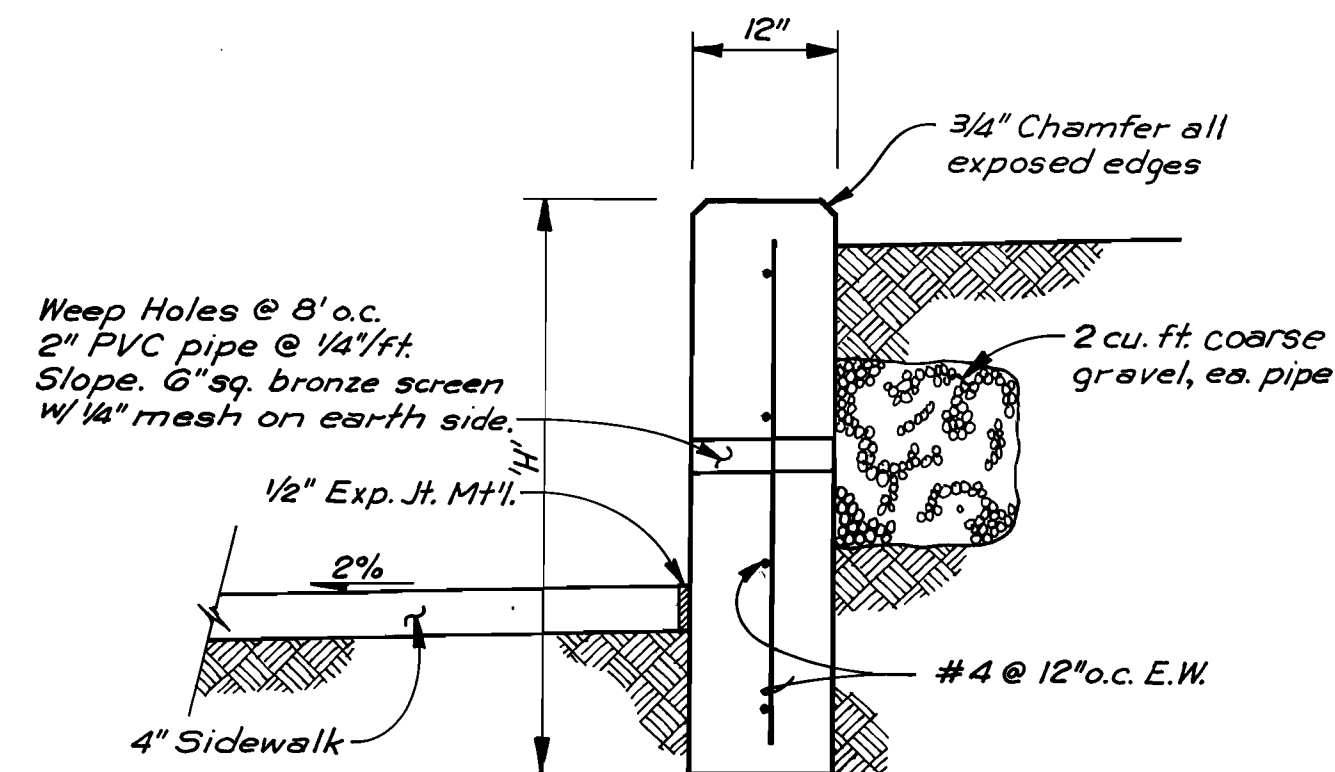

**TYPICAL SECTION
TYPE 'A'
CONCRETE RETAINING WALL**

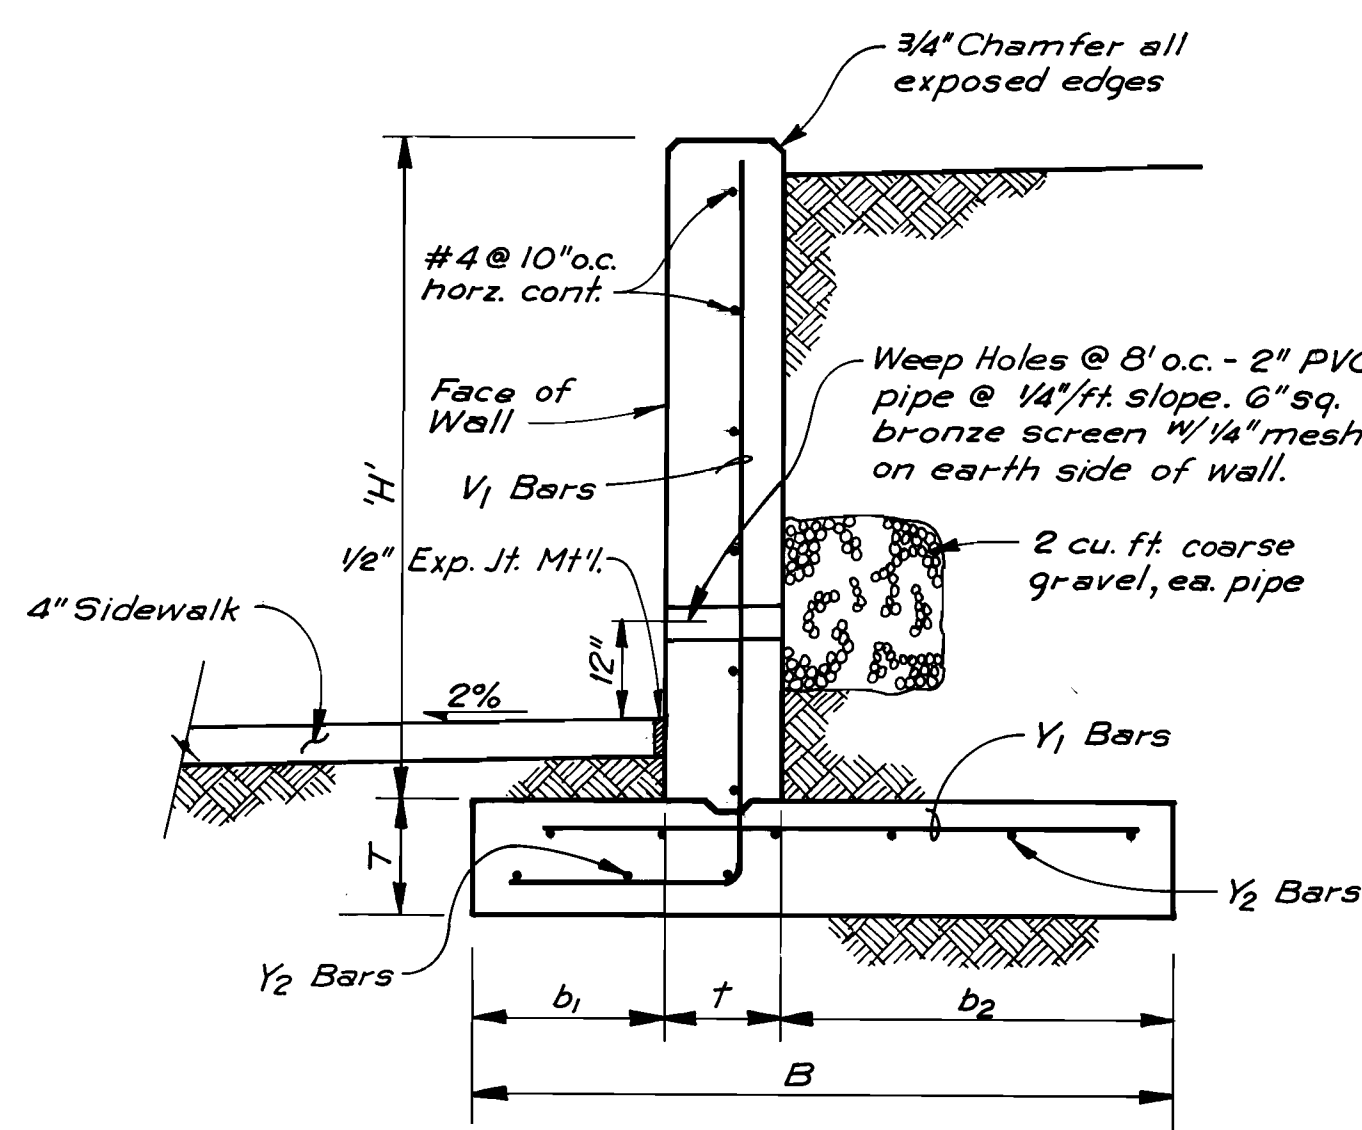


**TYPICAL SECTION
TYPE 'B' AND TYPE 'C'
CONCRETE RETAINING WALL**

TYPE 'B' RETAINING WALL

H	B	b ₁	t	T	b ₂	V ₁	Y ₁	Y ₂
3'-0" OR LESS	1'-9"	0'-4"	10"	0'-10"	0'-7"	#4@18"	#4 x 1'-3"@18"	#4@10"
4'-0"	2'-0"	0'-5"	10"	0'-10"	0'-9"	#4@18"	#4 x 1'-8"@18"	#4@10"
5'-0"	2'-8"	0'-5"	10"	0'-10"	1'-5"	#4@18"	#4 x 2'-2"@14"	#4@10"

TYPE 'C' RETAINING WALL


H	B	b ₁	t	T	b ₂	V ₁	Y ₁	Y ₂
3'-0" OR LESS	2'-6"	0'-10"	8"	0'-10"	1'-0"	#4@18"	#4 x 2'-0"@18"	#4@10"
4'-0"	3'-0"	1'-2"	8"	0'-10"	1'-2"	#4@18"	#4 x 2'-6"@18"	#4@10"
5'-0"	3'-6"	1'-3"	8"	0'-10"	1'-7"	#4@14"	#4 x 3'-0"@14"	#4@10"
6'-0"	4'-2"	1'-5"	8"	0'-10"	2'-1"	#4@12"	#4 x 3'-8"@12"	#4@10"
7'-0"	4'-6"	1'-7"	10"	1'-0"	2'-3"	#4@10"	#4 x 4'-2"@10"	#4@10"
8'-0"	5'-2"	1'-9"	10"	1'-0"	2'-7"	#5@12"	#5 x 4'-6"@12"	#4@10"
9'-0"	5'-8"	2'-0"	10"	1'-0"	2'-11"	#5@10"	#5 x 4'-10"@12"	#4@10"
10'-0"	6'-3"	2'-2"	10"	1'-0"	3'-3"	#5@8"	#5 x 5'-1"@12"	#5@10"
11'-0"	6'-9"	2'-4"	10"	1'-0"	3'-7"	#5@6"	#5 x 5'-5"@12"	#5@10"
12'-0"	7'-3"	2'-6"	10"	1'-2"	3'-11"	#6@9"	#5 x 5'-8"@12"	#5@10"
13'-0"	7'-9"	2'-8"	12"	1'-2"	4'-1"	#6@8"	#6 x 5'-10"@12"	#5@10"
14'-0"	8'-4"	2'-10"	12"	1'-3"	4'-6"	#6@6"	#6 x 6'-0"@12"	#5@10"

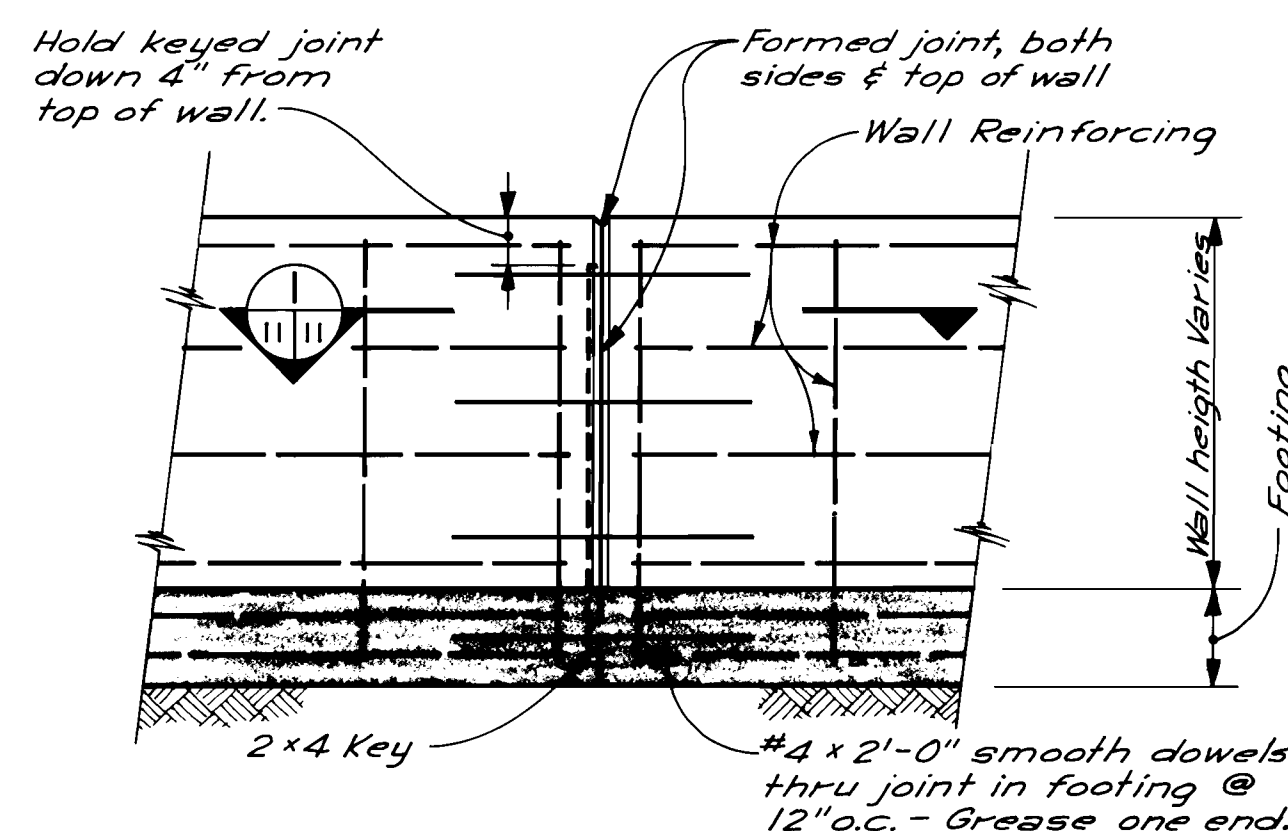


**ELEVATION
NO SCALE**

CONCRETE WALL CONSTRUCTION JOINT DETAILS

NO SCALE

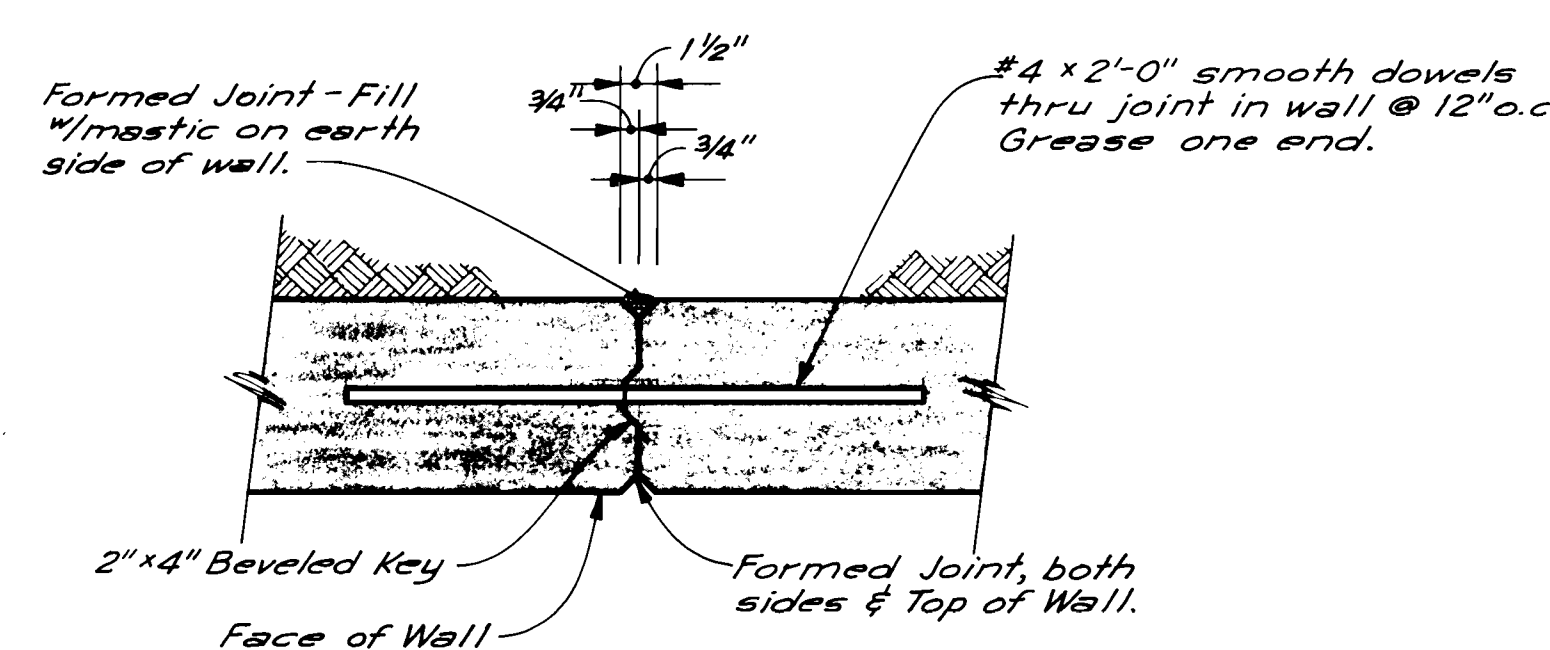


**SECTION
NO SCALE**

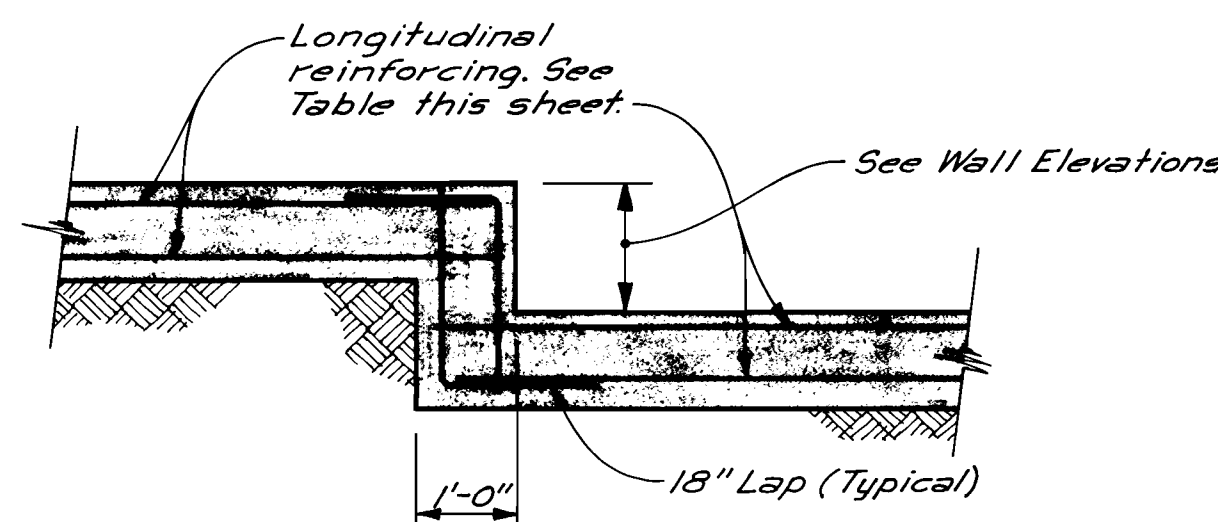


TYPICAL FOOTING STEP DETAIL

NO SCALE

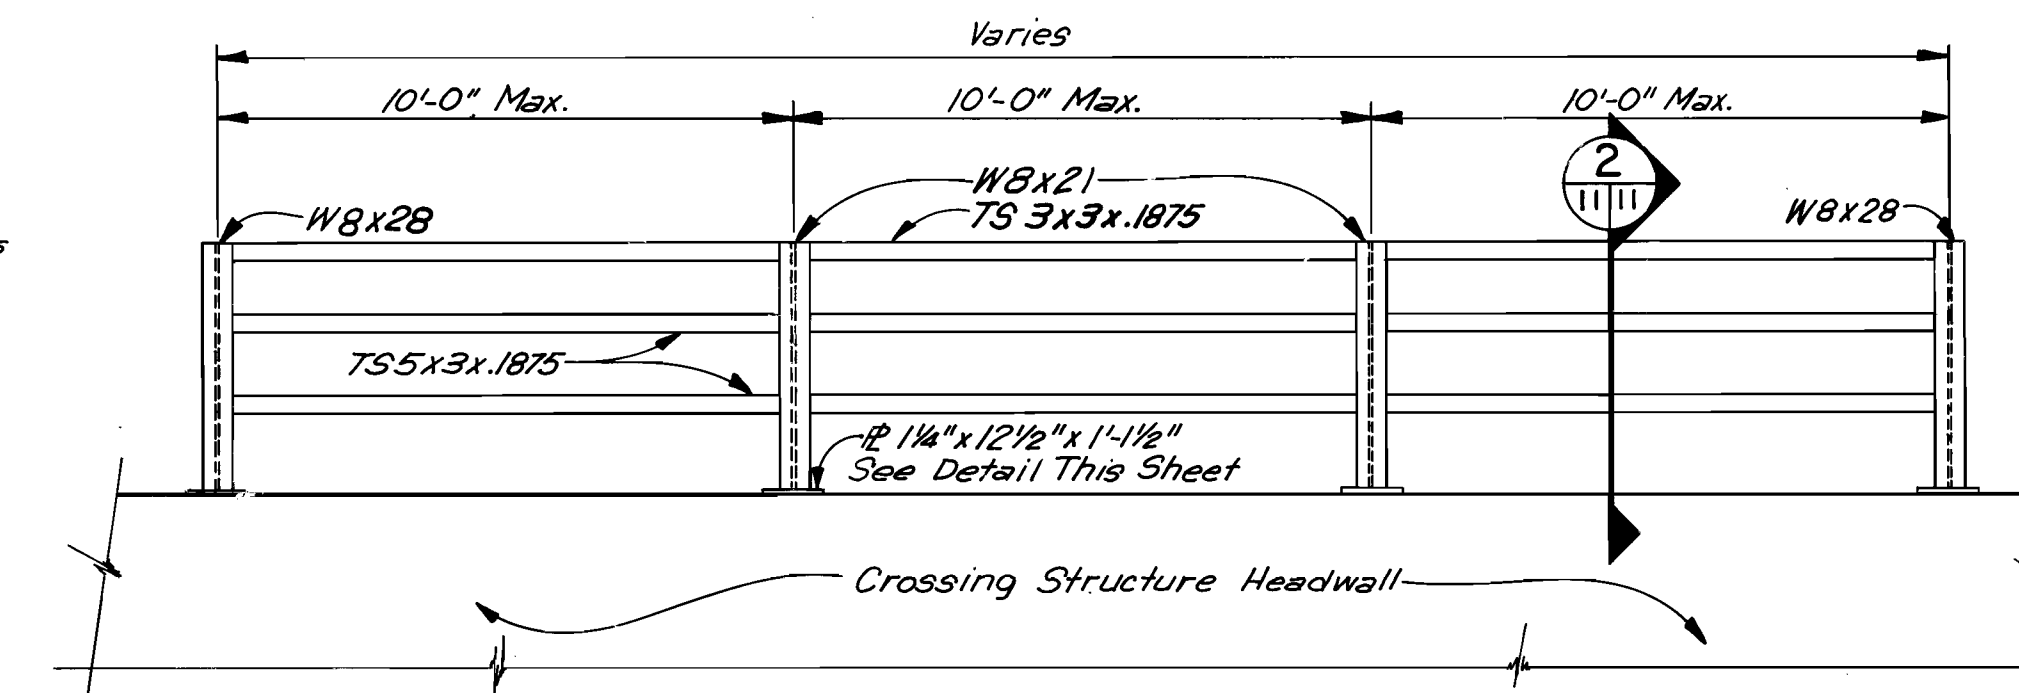


ELEVATION

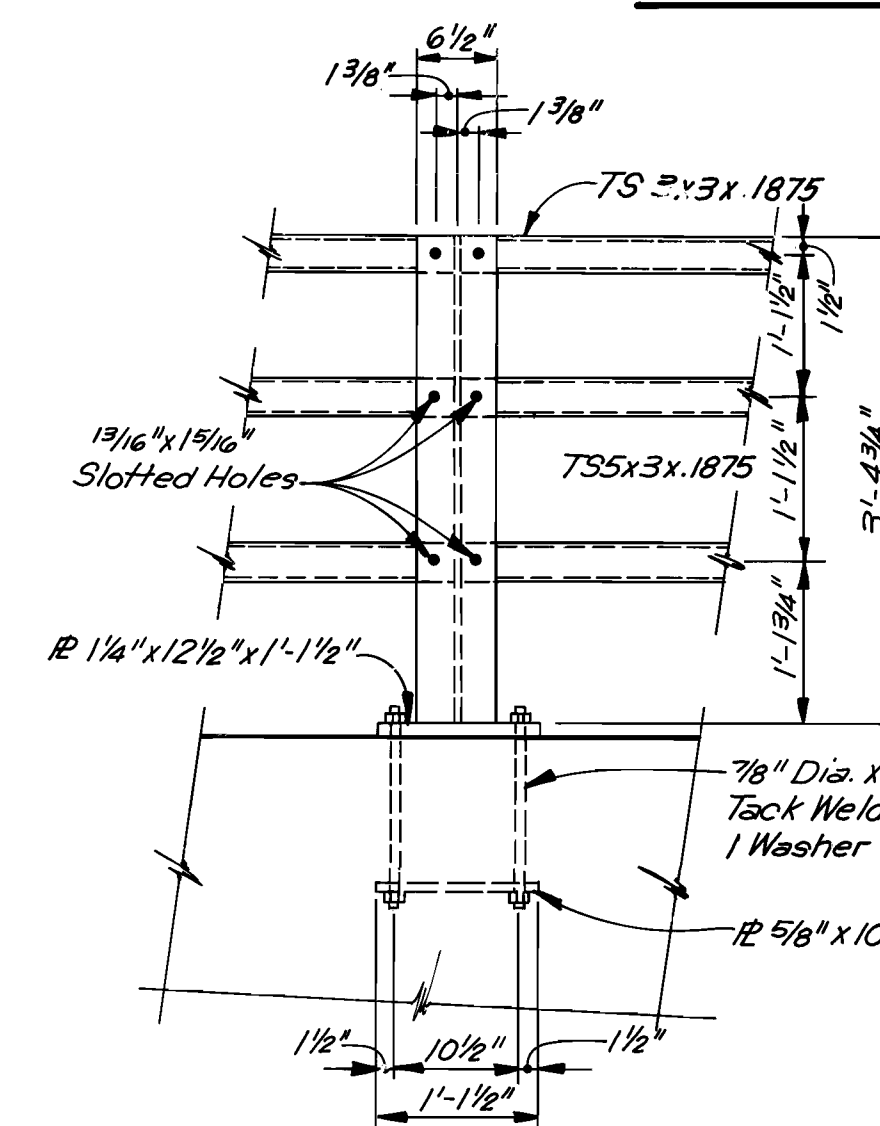

ELEVATION


METAL BRIDGE RAILING DETAILS

NO SCALE

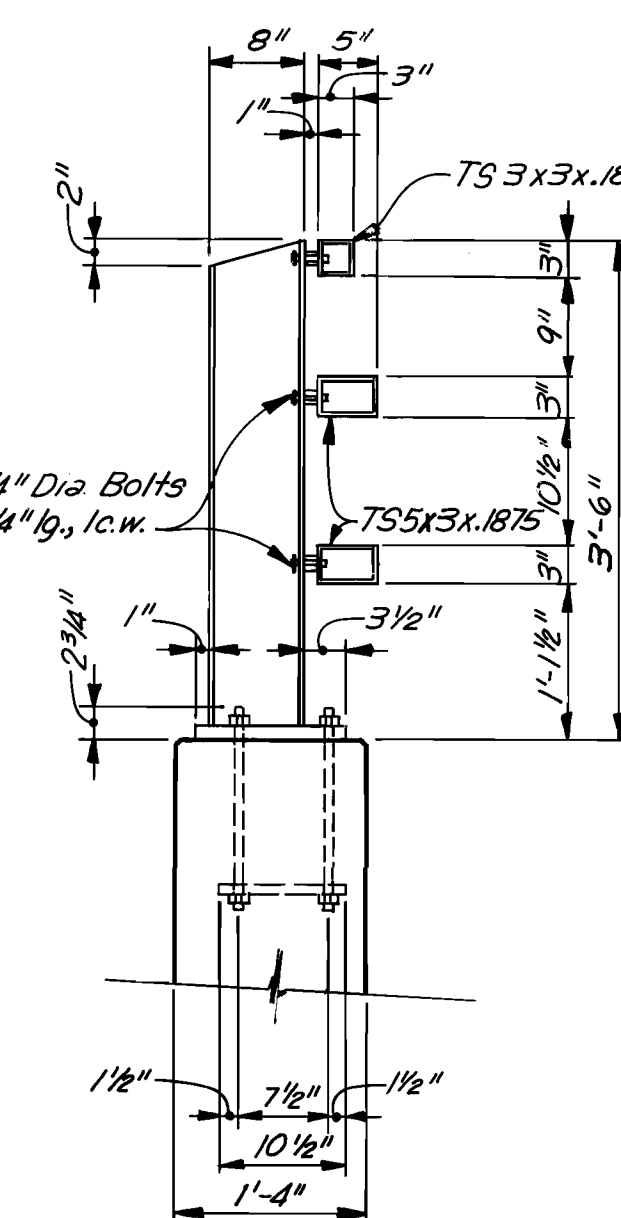

SECTION

2

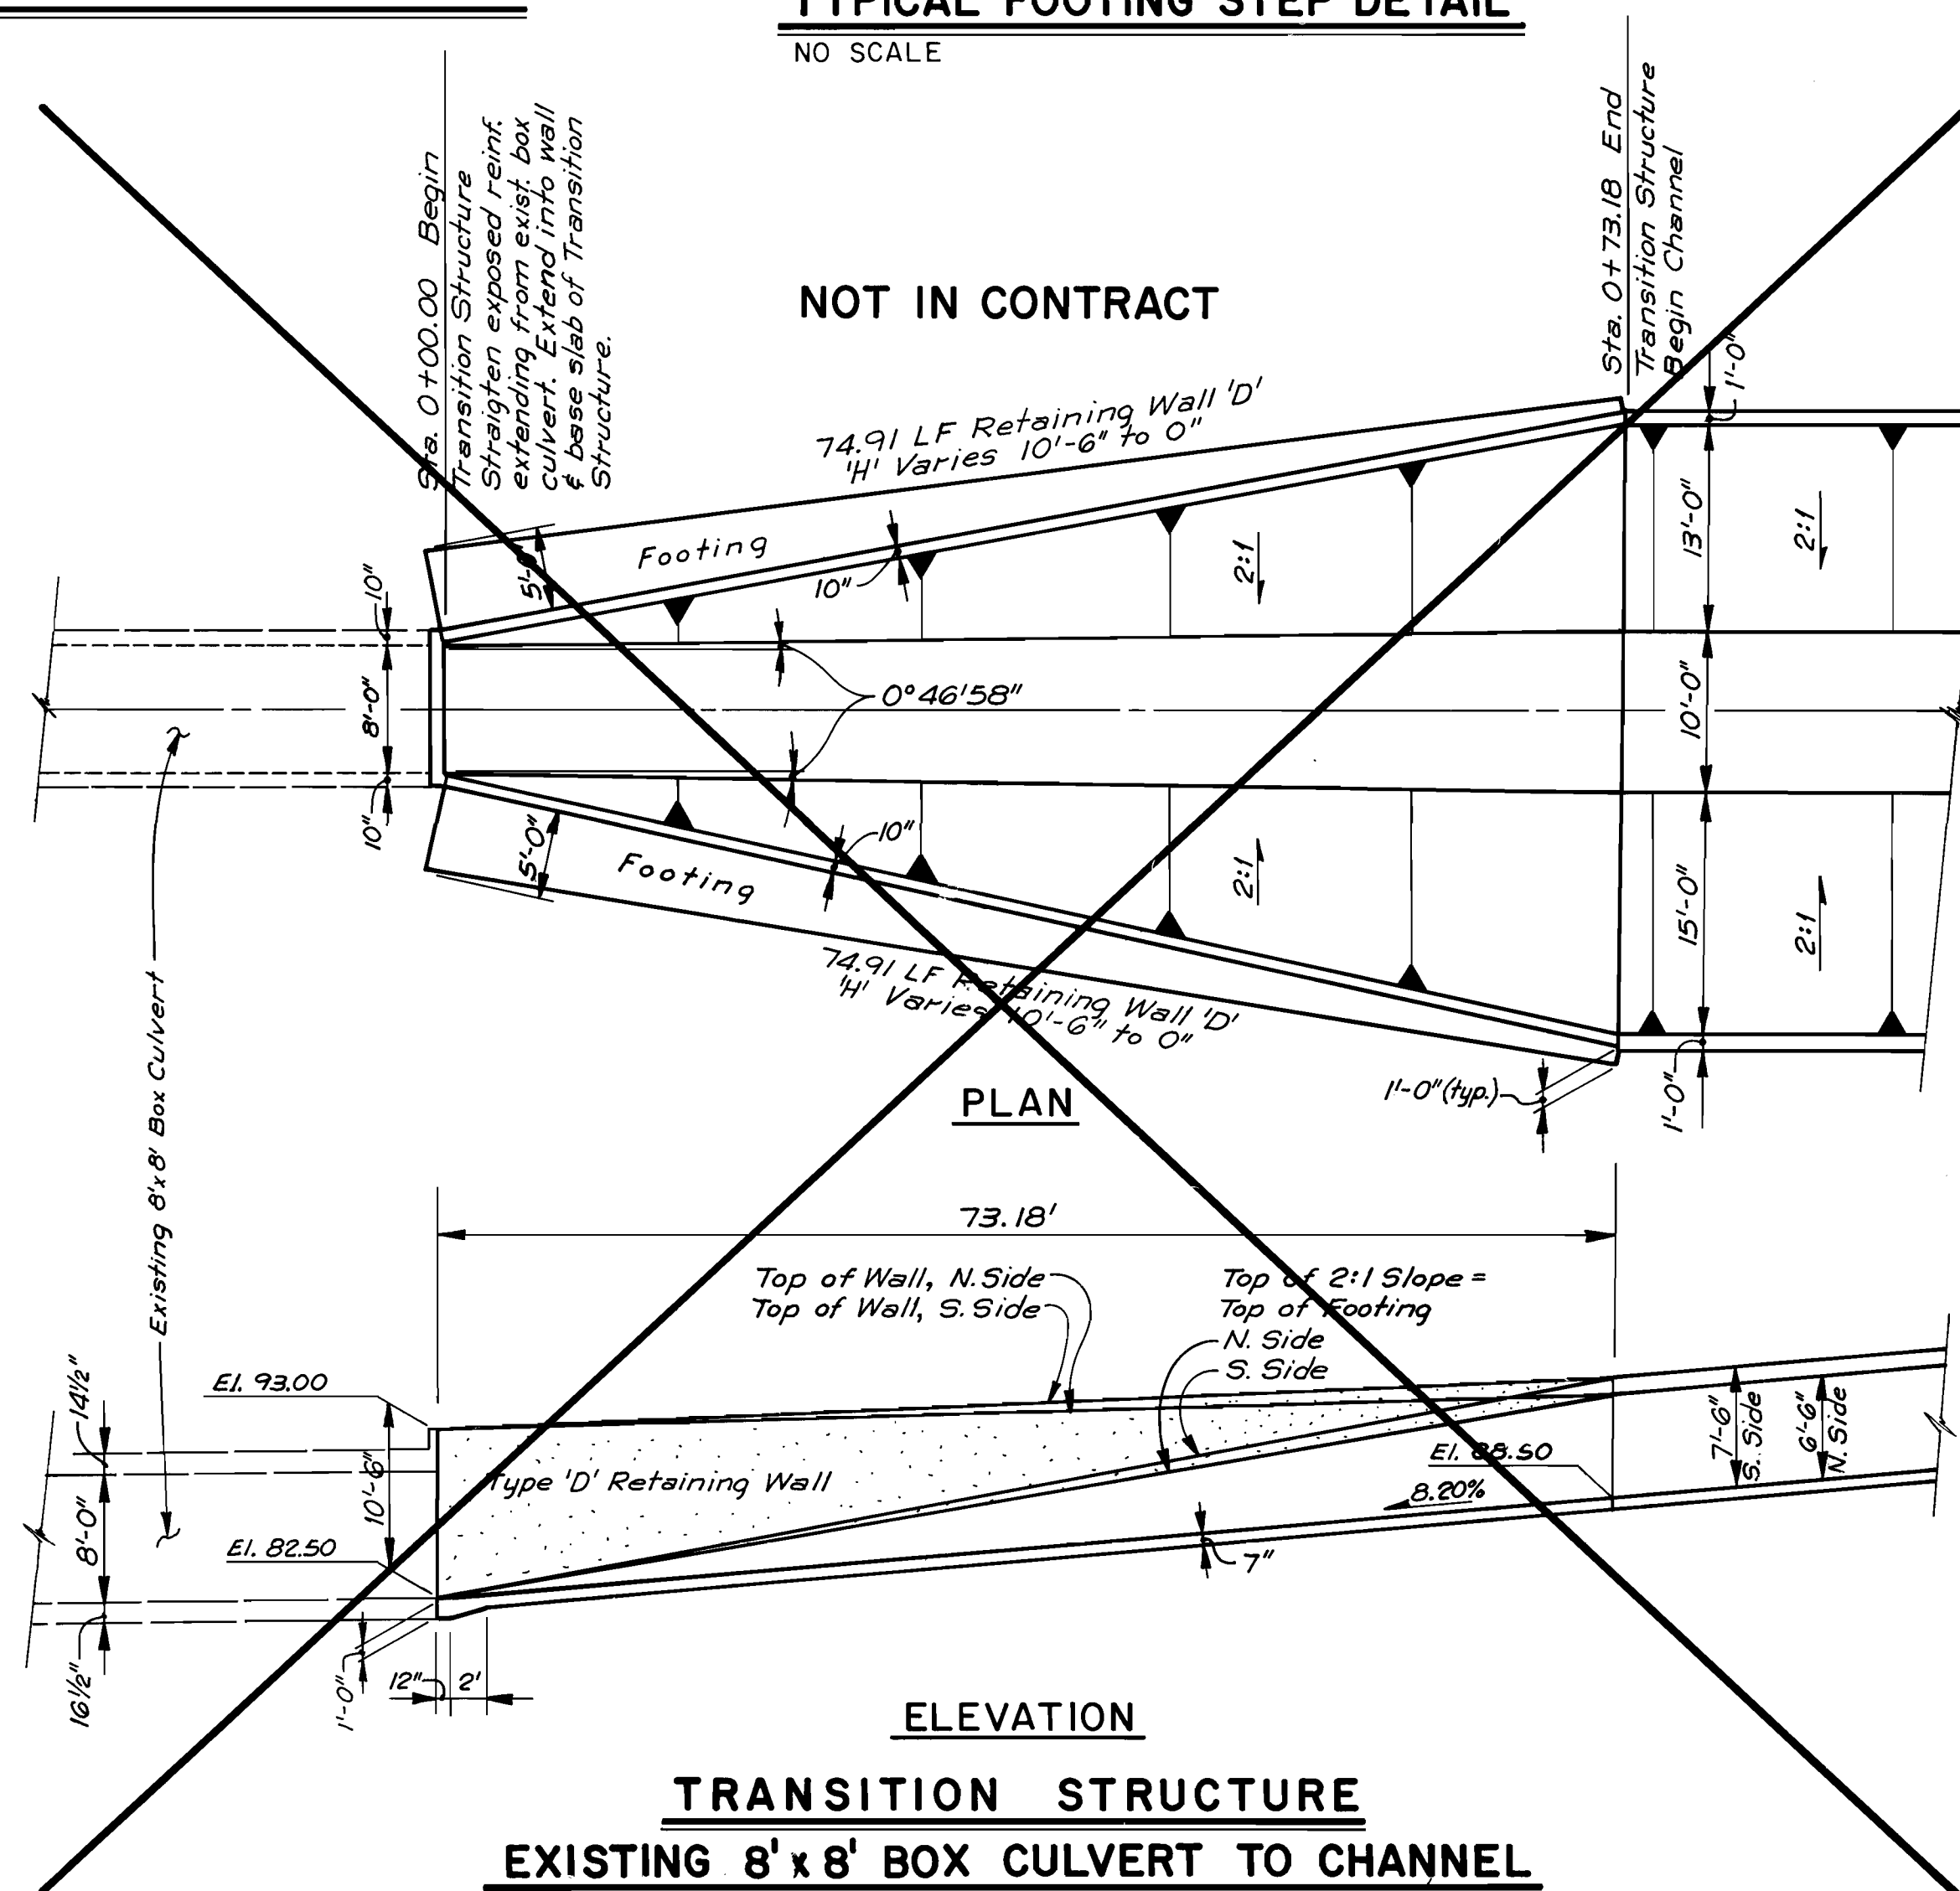

ELEVATION

TRANSITION STRUCTURE

EXISTING 8' x 8' BOX CULVERT TO CHANNEL

SCALE: 1" = 10'

- NOTES**
- ALL CONCRETE SHALL HAVE A MINIMUM COMPRESSIVE STRENGTH OF 3000 PSI IN 28 DAYS.
 - REINFORCING STEEL SHALL BE GRADE 60.
 - SEAL ALL CONTROL JOINTS ON EARTH SIDE OF RETAINING WALLS. JOINT SEALANT SHALL BE SONOLASTIC NP-1 AS MFG'D BY SONOBORN OR APPROVED EQUAL.
 - EARTH SIDE OF RETAINING WALLS SHALL BE DAMP PROOFED. USE HYDROSIDE 700 B AS MFG'D BY SONOBORN OR APPROVED EQUAL. TWO COATS.
 - CONTRACTOR SHALL PERFORM ALL EXCAVATION AND BACKFILL AS REQUIRED FOR A COMPLETE INSTALLATION.
 - ALL RETAINING WALL FOOTING SHALL BE FOUNDED UPON 12" SUBGRADE PREPARATION @ 95% DENSITY.

AS BUILT INFORMATION				BENCH MARKS				SURVEY INFORMATION				ENGINEER'S SEAL				
CONTRACTOR	DATE	ELEVATION	NO.	CONTRACTOR	DATE	ELEVATION	NO.	NO.	BY	DATE	NO.	BY	DATE	NO.	BY	DATE
MOORE & CONWAY	10/87	5337.039	10/87	MOORE & CONWAY	10/87	5337.039	10/87	10/87	10/87	10/87	10/87	10/87	10/87	10/87	10/87	10/87
FIELD NOTES				FIELD NOTES				FIELD NOTES				FIELD NOTES				
ACCS STA. 12+10.18				ACCS STA. 12+10.18				ACCS STA. 12+10.18				ACCS STA. 12+10.18				
ACCS BRASS TABLET SET ON CONCRETE POST FLUSH W/GROUND				ACCS BRASS TABLET SET ON CONCRETE POST FLUSH W/GROUND				ACCS BRASS TABLET SET ON CONCRETE POST FLUSH W/GROUND				ACCS BRASS TABLET SET ON CONCRETE POST FLUSH W/GROUND				
LOCATED 41 FEET SOUTH OF THE CENTERLINE OF SAN ANTONIO DRIVE AND 34 FEET WEST OF THE CENTERLINE OF LOUISIANA BOULEVARD				LOCATED 41 FEET SOUTH OF THE CENTERLINE OF SAN ANTONIO DRIVE AND 34 FEET WEST OF THE CENTERLINE OF LOUISIANA BOULEVARD				LOCATED 41 FEET SOUTH OF THE CENTERLINE OF SAN ANTONIO DRIVE AND 34 FEET WEST OF THE CENTERLINE OF LOUISIANA BOULEVARD				LOCATED 41 FEET SOUTH OF THE CENTERLINE OF SAN ANTONIO DRIVE AND 34 FEET WEST OF THE CENTERLINE OF LOUISIANA BOULEVARD				
MICRO-FILM INFORMATION				MICRO-FILM INFORMATION				MICRO-FILM INFORMATION				MICRO-FILM INFORMATION				
RECORDED BY				RECORDED BY				RECORDED BY				RECORDED BY				
DATE				DATE				DATE				DATE				
NO.				NO.				NO.				NO.				


John A. Anderson
RECORD DRAWING
26 21511187

**CITY OF ALBUQUERQUE
MUNICIPAL DEVELOPMENT DEPARTMENT
ENGINEERING DIVISION**


**PINO ARROYO CORRIDOR IMPROVEMENTS
CONCRETE RETAINING WALL DETAILS**

APPROVALS	ENGINEER	DATE	APPROVALS	ENGINEER	DATE
City Engineer	<i>John A. Anderson</i>	11/20/86	Liquid Waste	N/A	1-3-86
ACE - Design	<i>John A. Anderson</i>	11/20/86	Traffic	N/A	1-3-86
ACE - Hydrology	<i>John A. Anderson</i>	11/20/86	Water	N/A	1-3-86

DRAWING NO. **2151** MAP NO. **E-18, E-19** SHEET **11** OF **34**

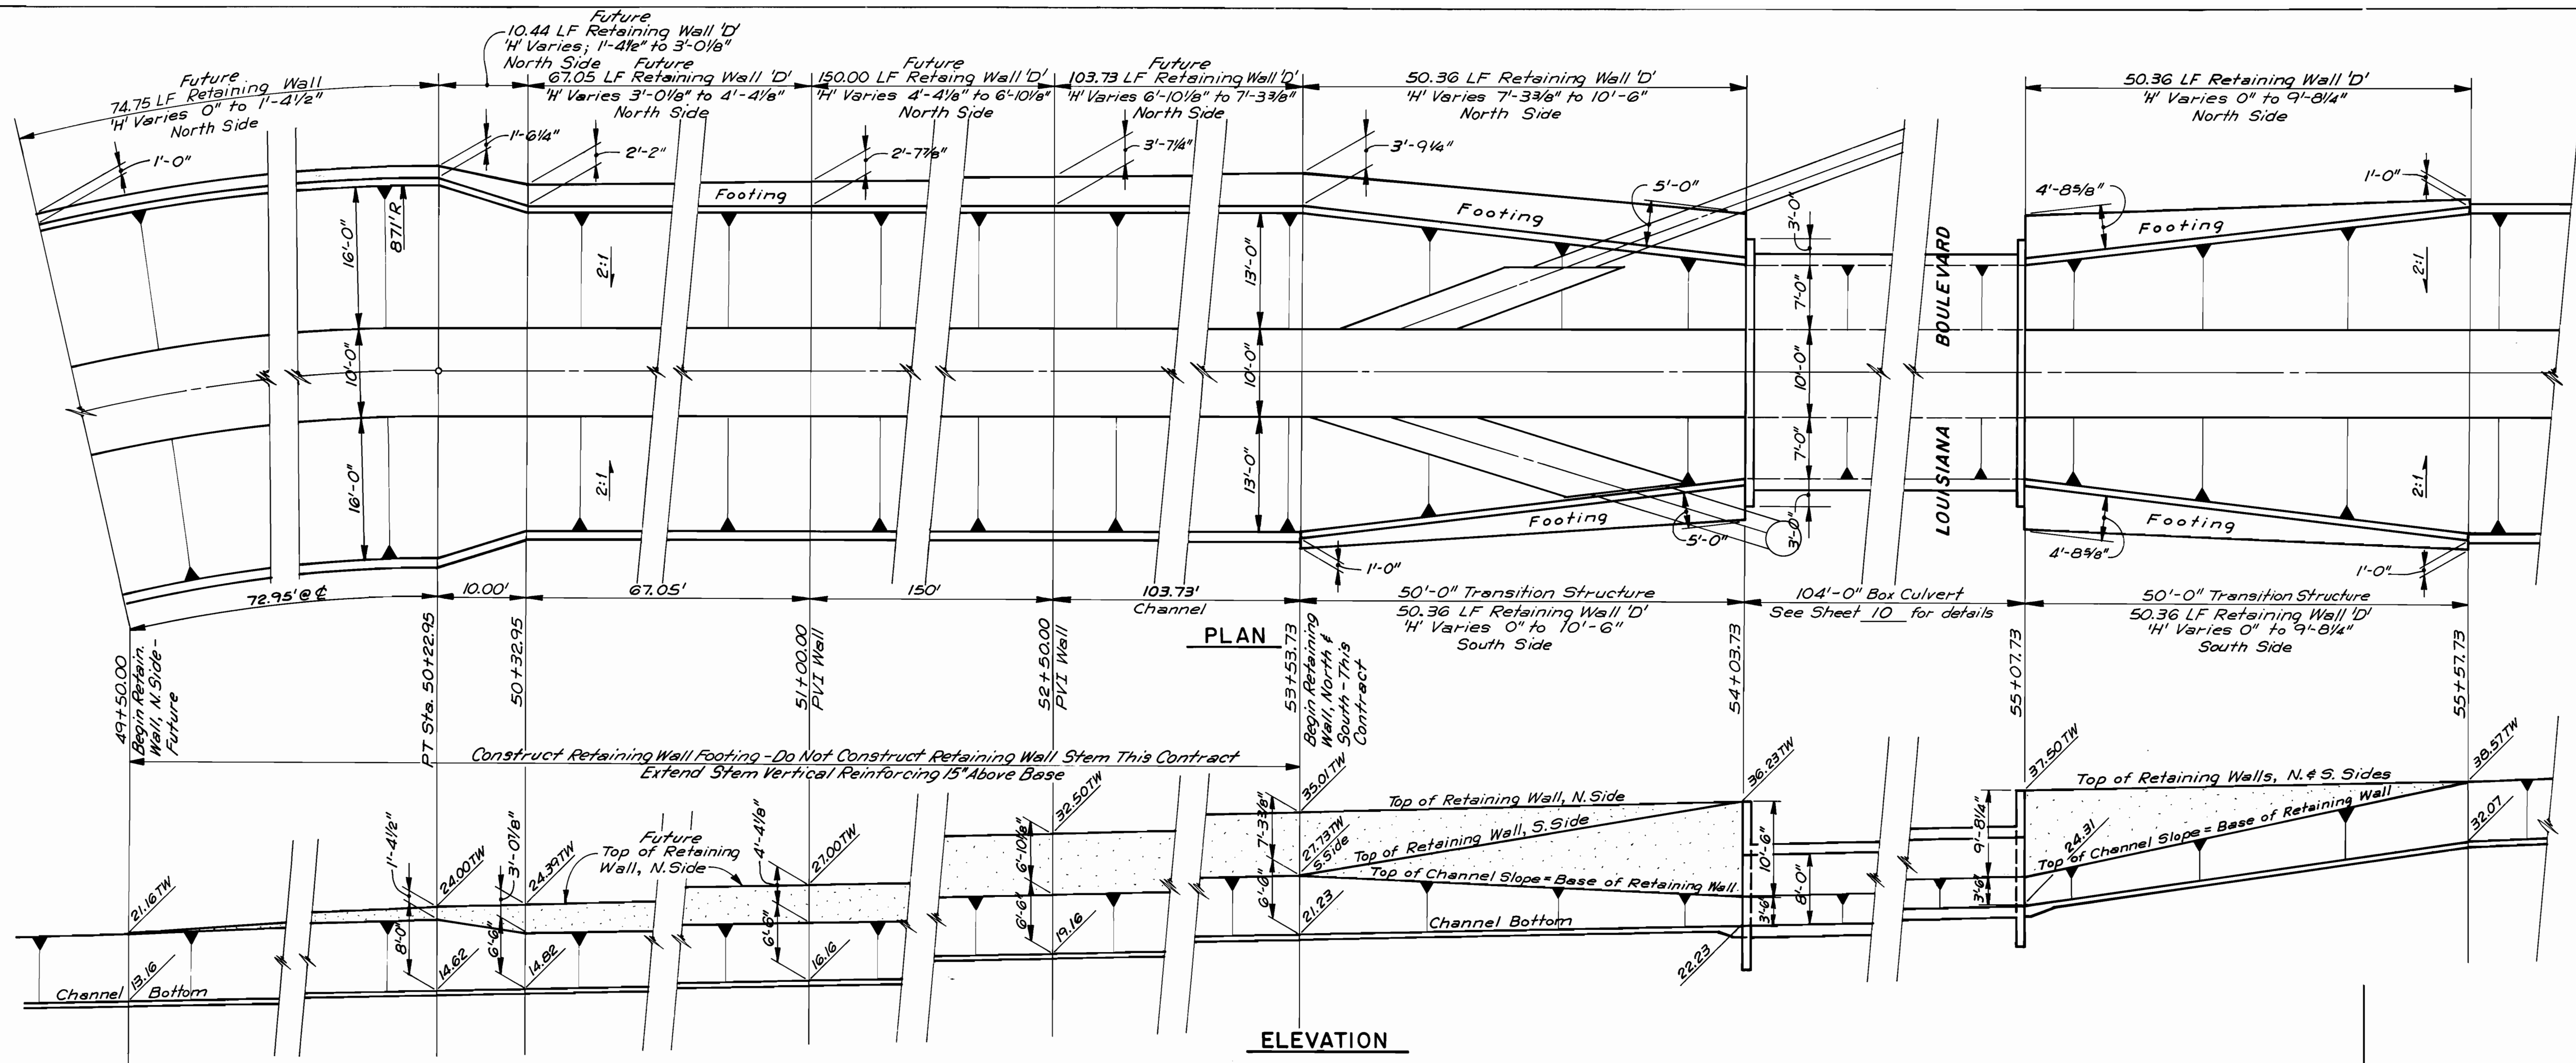

LOUISIANA BOULEVARD CROSSING STRUCTURE
SCALE: 1" = 10'

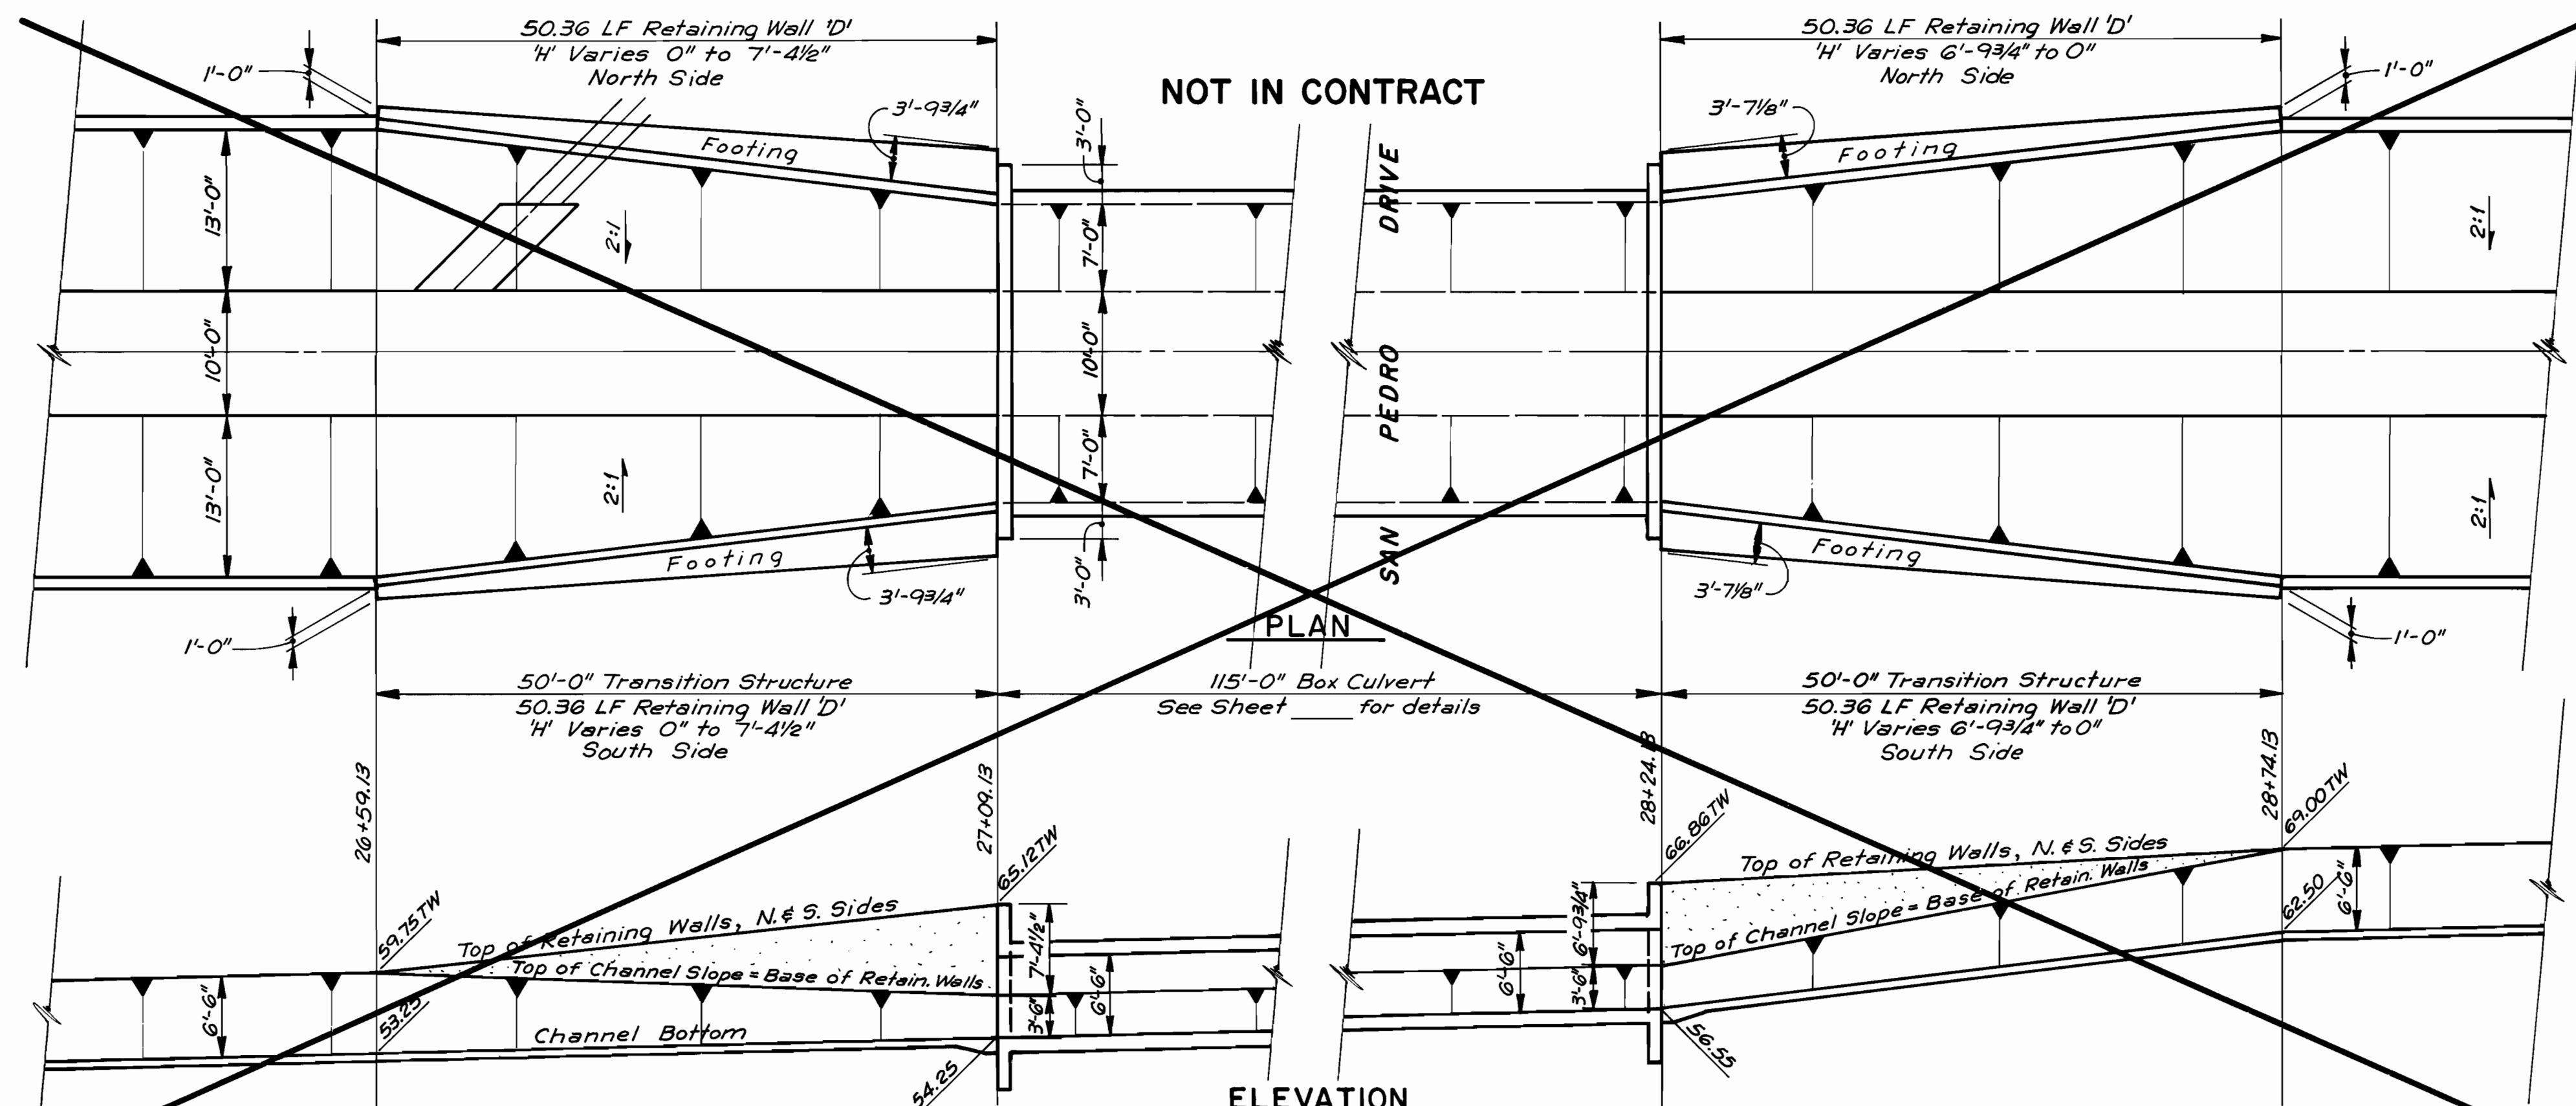


SAN PEDRO DRIVE CROSSING STRUCTURE
SCALE: 1" = 10'


John A. Anderson
RECORD DRAWING
26 21511287

CITY OF ALBUQUERQUE MUNICIPAL DEVELOPMENT DEPARTMENT ENGINEERING DIVISION					
PINO ARROYO CORRIDOR IMPROVEMENTS					
TRANSITION STRUCTURE RETAINING WALLS					
APPROVALS	ENGINEER	DATE	APPROVALS	ENGINEER	DATE
City Engineer	<i>John A. Anderson</i>	1/24/86	Liquid Waste	N/A AR	1-31-86
A.C.E. - Design	<i>John A. Anderson</i>	1/31/86	Traffic	N/A AR	1-31-86
A.C.E. - Hydrology	<i>John A. Anderson</i>	1-31-86	Water	N/A AR	1-31-86
DRAWING NO.	2151		MAP NO.	E-18, E-19	
SHEET	12		OF	34	

AS BUILT INFORMATION		BENCH MARKS		SURVEY INFORMATION		ENGINEER'S SEAL	
CONTRACTOR	Moore & Covert	DATE	10/87	NO.		BY	
WORK	STANDARD	ELEVATION	5337.039	DATE		REVISIONS	
STANDARD	TABLET SET ON CONCRETE POST FLUSH W/ GROUND	DATE	10/87	DESIGNED BY	JM	DATE	
FIELD	ACCEPTANCE BY CHA/HAAR	DATE	10/87	DRAWN BY	JV	DATE	
REVISION	LOCATED 41 FEET SOUTH OF THE CENTERLINE OF SAN ANTONIO DRIVE AND 34 FEET WEST OF THE CENTERLINE OF LOUISIANA BOULEVARD	DATE	10/87	CHECKED BY	JA	DATE	
CORRECTED BY	A.A.F.R.	DATE	10/87				
MICRO-FILM INFORMATION		NO		DATE		REVISIONS	
RECORDED BY		NO		DATE		REVISIONS	

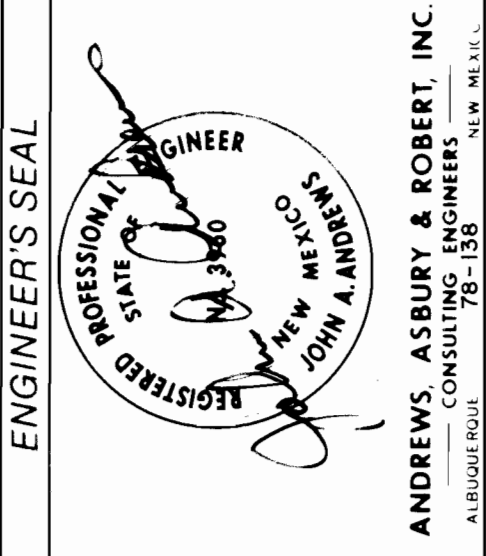


ANDREWS, ASSURRY & ROBERT, INC.
ALBUQUERQUE, N.M. 87102

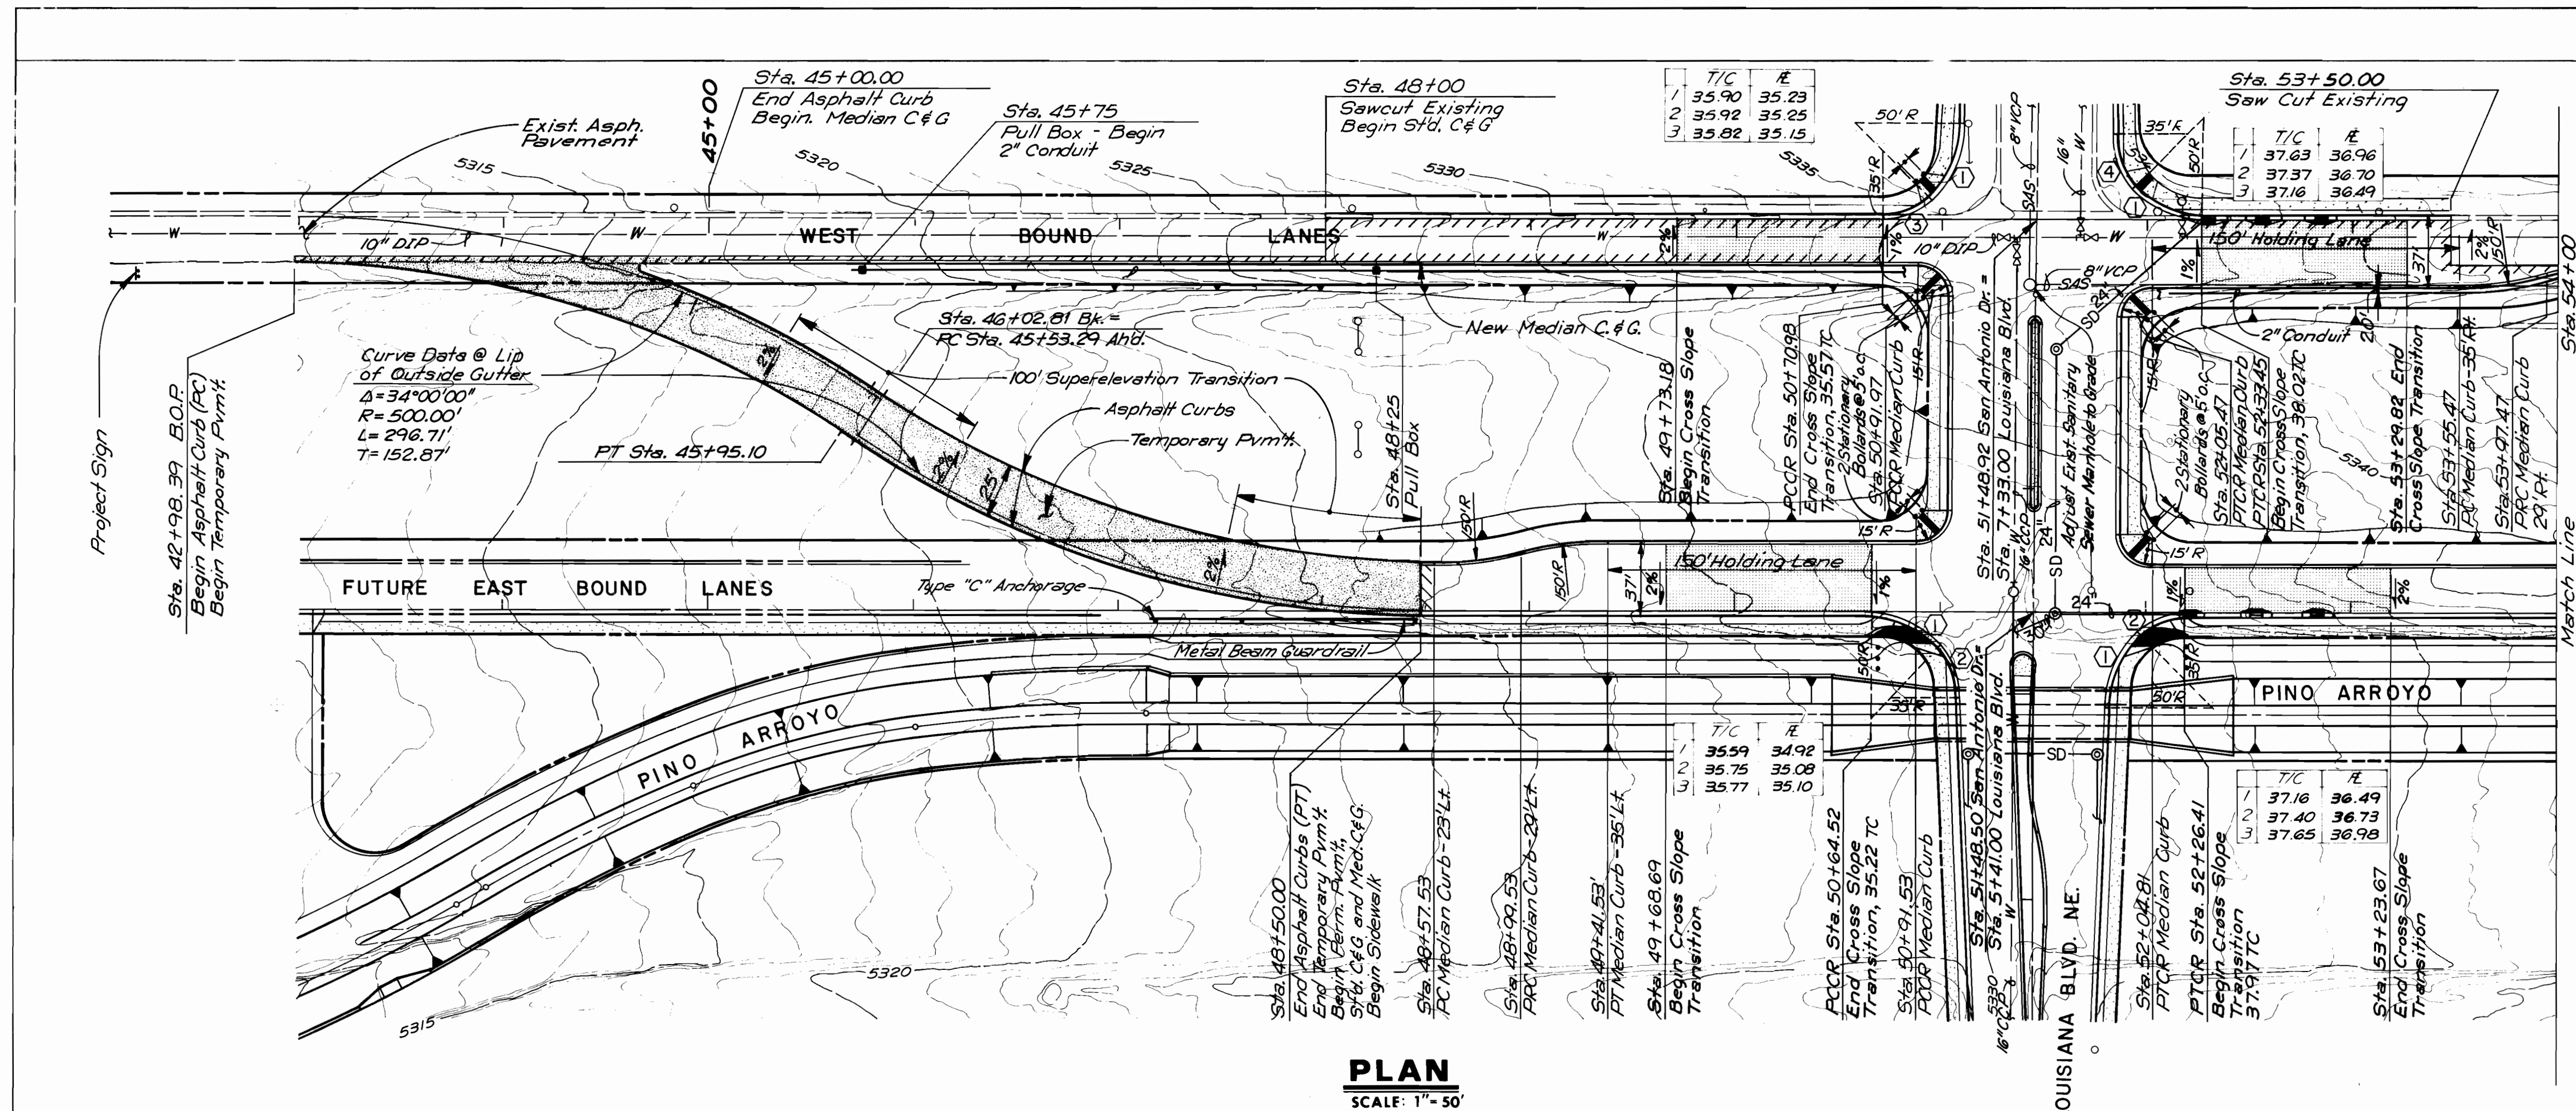

PLAN
SCALE: 1" = 50'

SAN ANTONIO DRIVE NE.

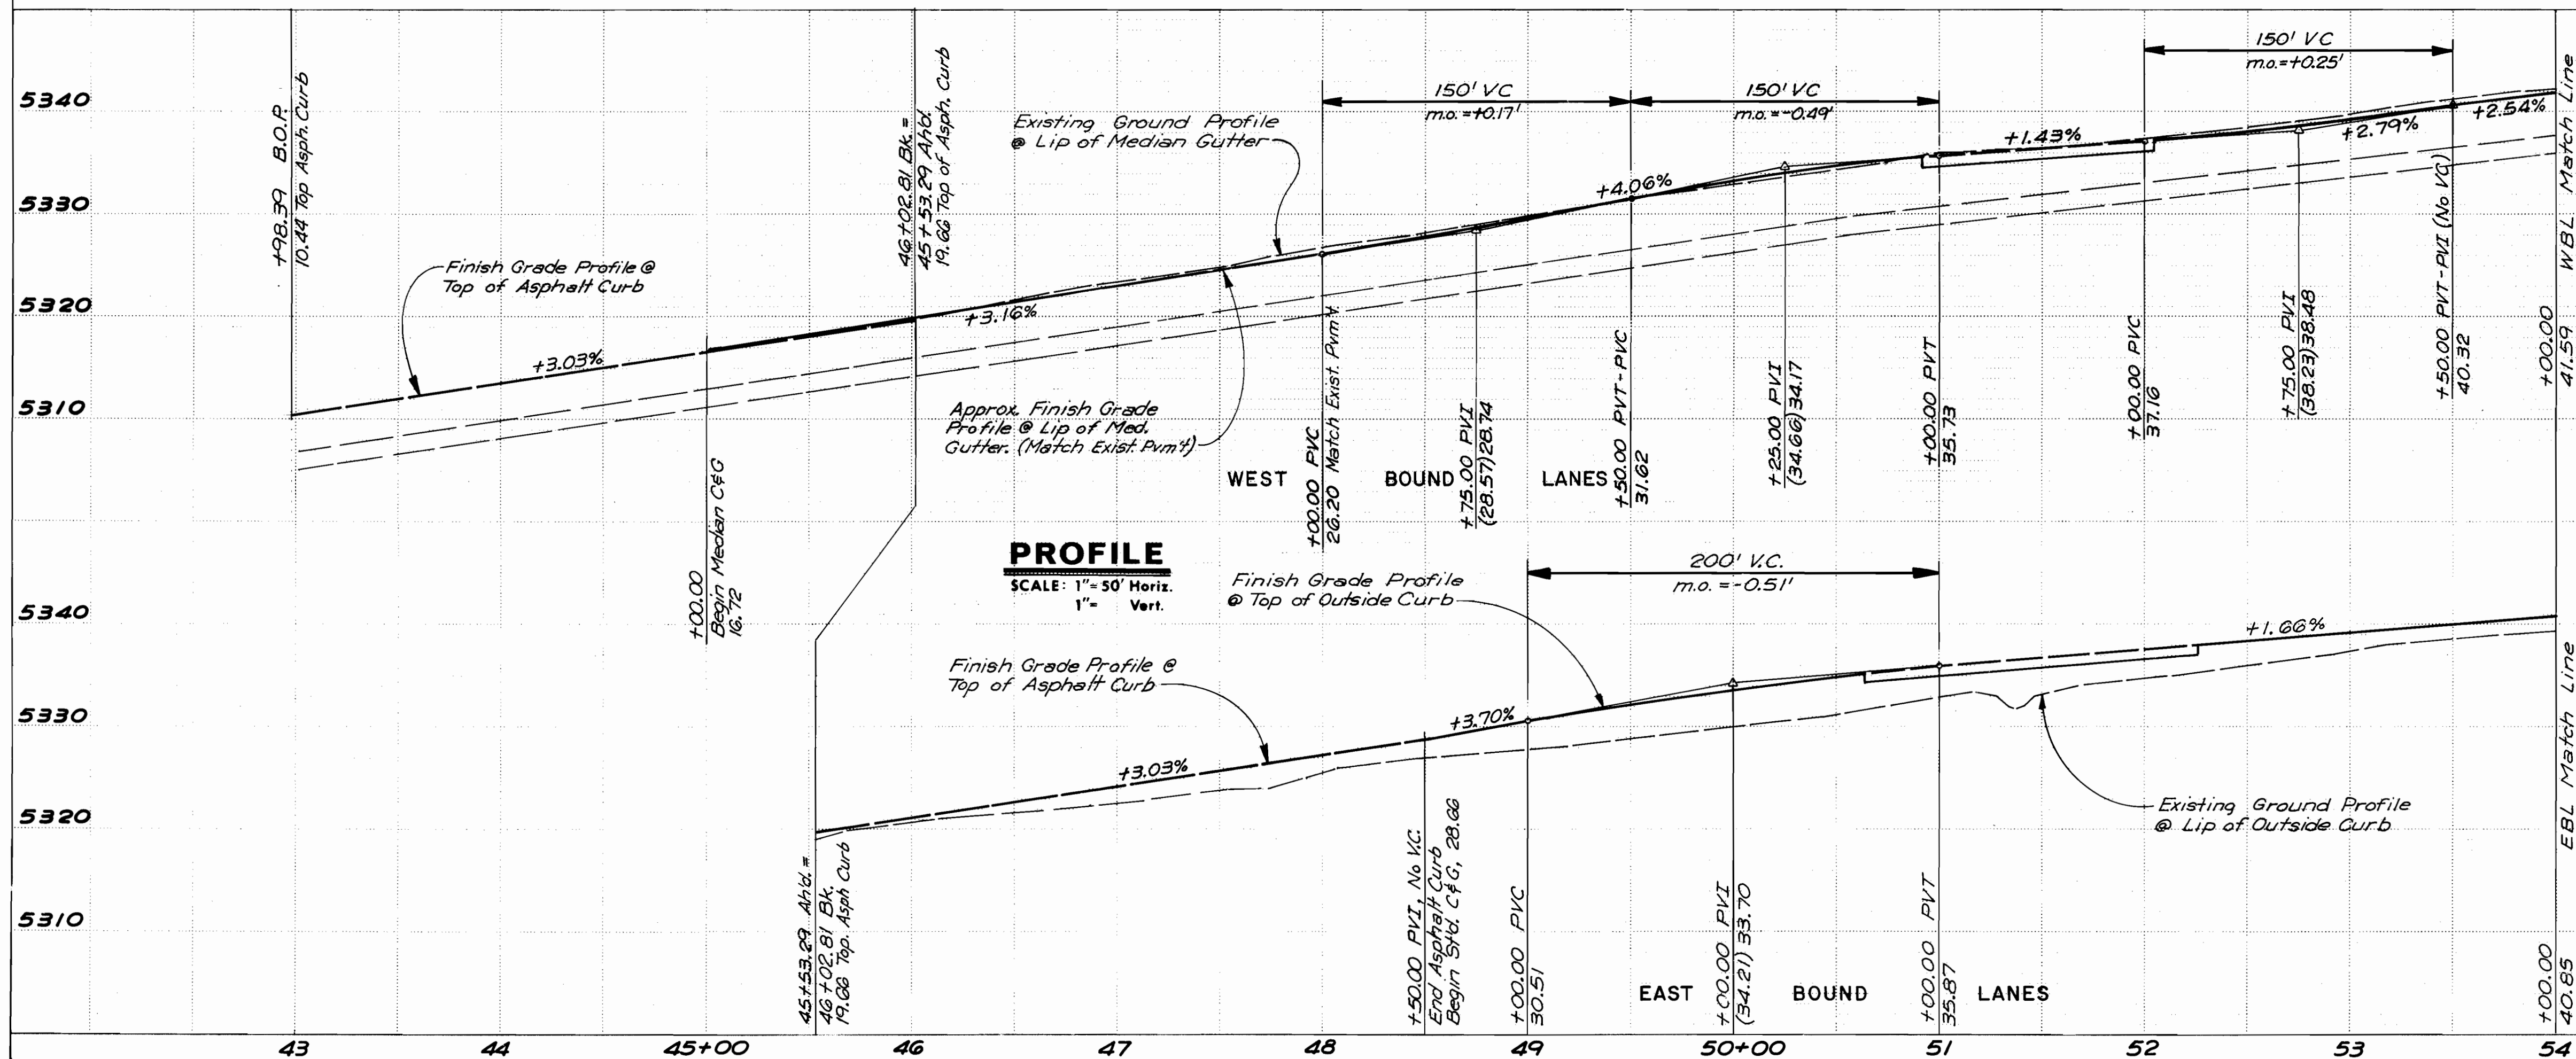


PROFILE
SCALE: 1" = 50' Horiz.
1" = 10' Vert.

- NOTES**
- SEE SHEET 20 FOR LOUISIANA BOULEVARD.
 - SEE SHEET 20 FOR STORM DRAIN & CATCH BASINS.
 - SEE SHEET 30 FOR WATERLINE.
 - SEE SHEET 23 FOR INTERSECTION STREET LIGHTING & SIGNALIZATION.
 - EXISTING POWERLINE IN EASTBOUND SAN ANTONIO DRIVE WILL BE RELOCATED BY OTHERS.

CURB RETURN CURVE DATA

- | Curve | R | Δ | L | T |
|-------|--------|-----------|--------|--------|
| ① | 50.00' | 42°50'00" | 37.38' | 19.61' |
| ② | 35.00' | 44°49'25" | 27.38' | 14.43' |
| ③ | 35.00' | 44°30'13" | 27.19' | 14.39' |
| ④ | 35.00' | 45°32'23" | 27.82' | 14.69' |

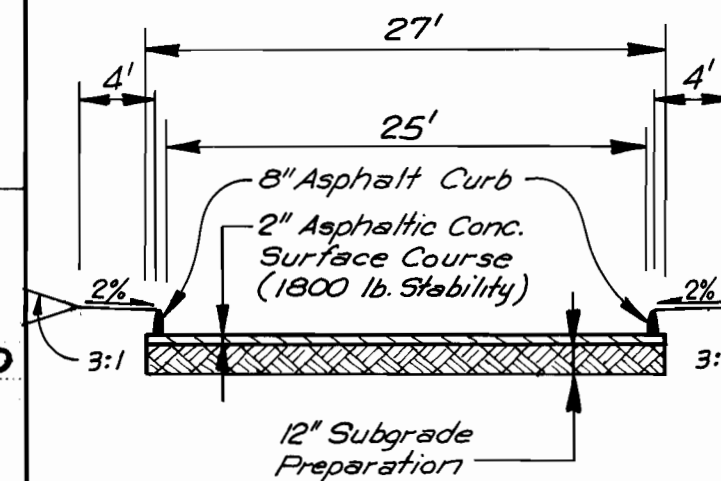

TEMPORARY PAVEMENT SECTION
NO SCALE


John A. Andrews
RECORD DRAWING
26 2151/587

CITY OF ALBUQUERQUE
MUNICIPAL DEVELOPMENT DEPARTMENT
ENGINEERING DIVISION

PINO ARROYO CORRIDOR IMPROVEMENTS
SAN ANTONIO DRIVE NE.
PLAN & PROFILE - STA. 43+00 TO STA. 54+00


APPROVALS	ENGINEER	DATE	APPROVALS	ENGINEER	DATE
City Engineer	Andrews	11/29/86	Liquid Waste	B. R. R. R.	1-31-86
A.C.E. - Design	Andrews	11/29/86	Traffic	D. G. R. R.	1-31-86
Hydrology	K. K. R. R.	1/31/86	Water	B. R. R. R.	1-31-86

DRAWING NO. **2151** MAP NO. **E-18, E-19** SHEET **15** OF **34**

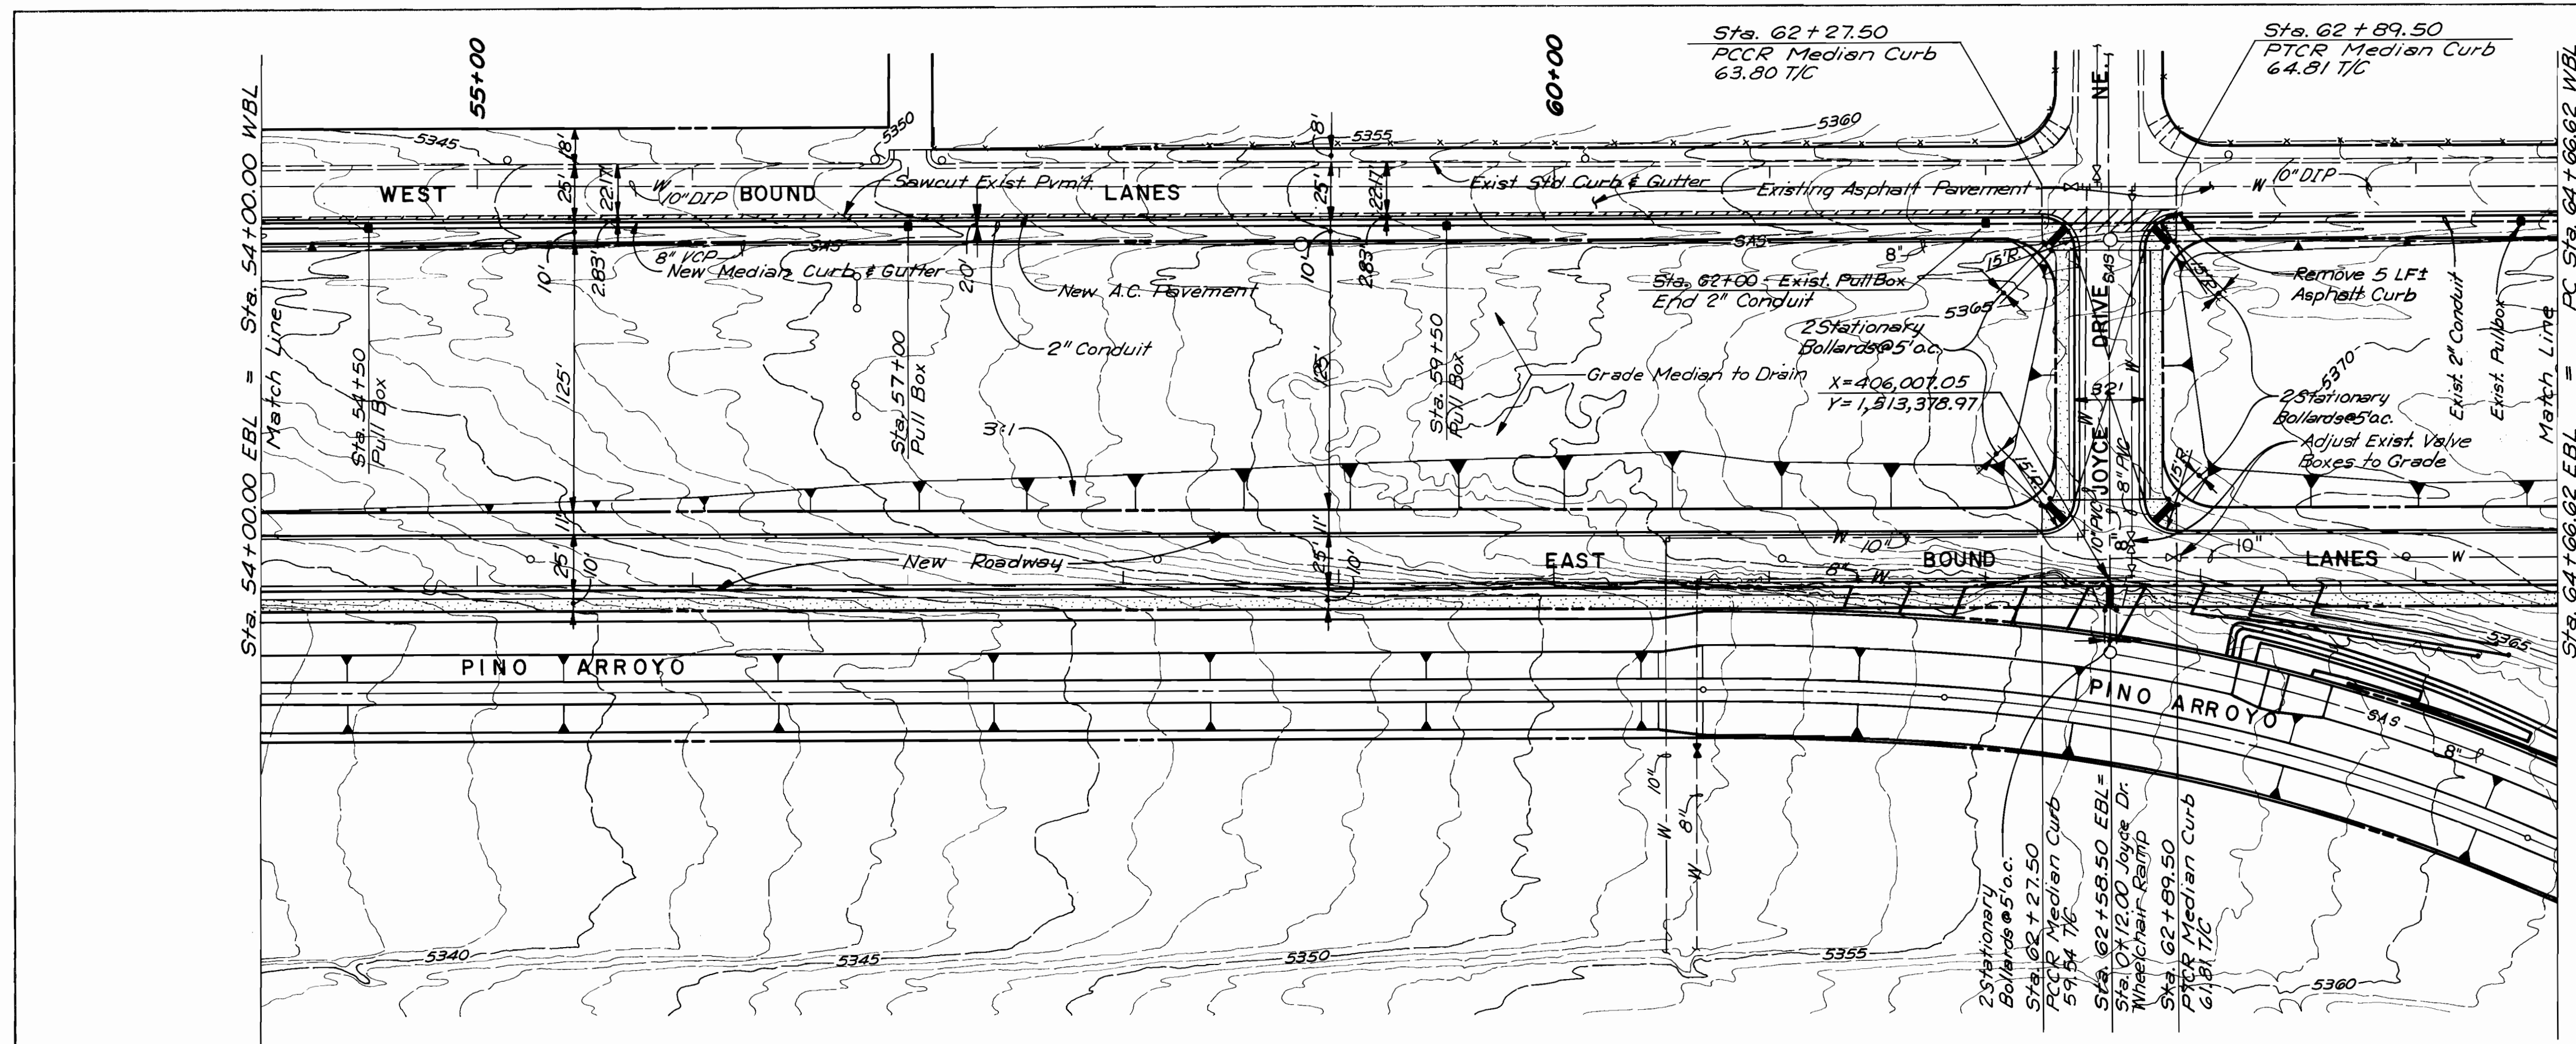

PLAN
SCALE: 1"=50'

SAN ANTONIO DRIVE NE.

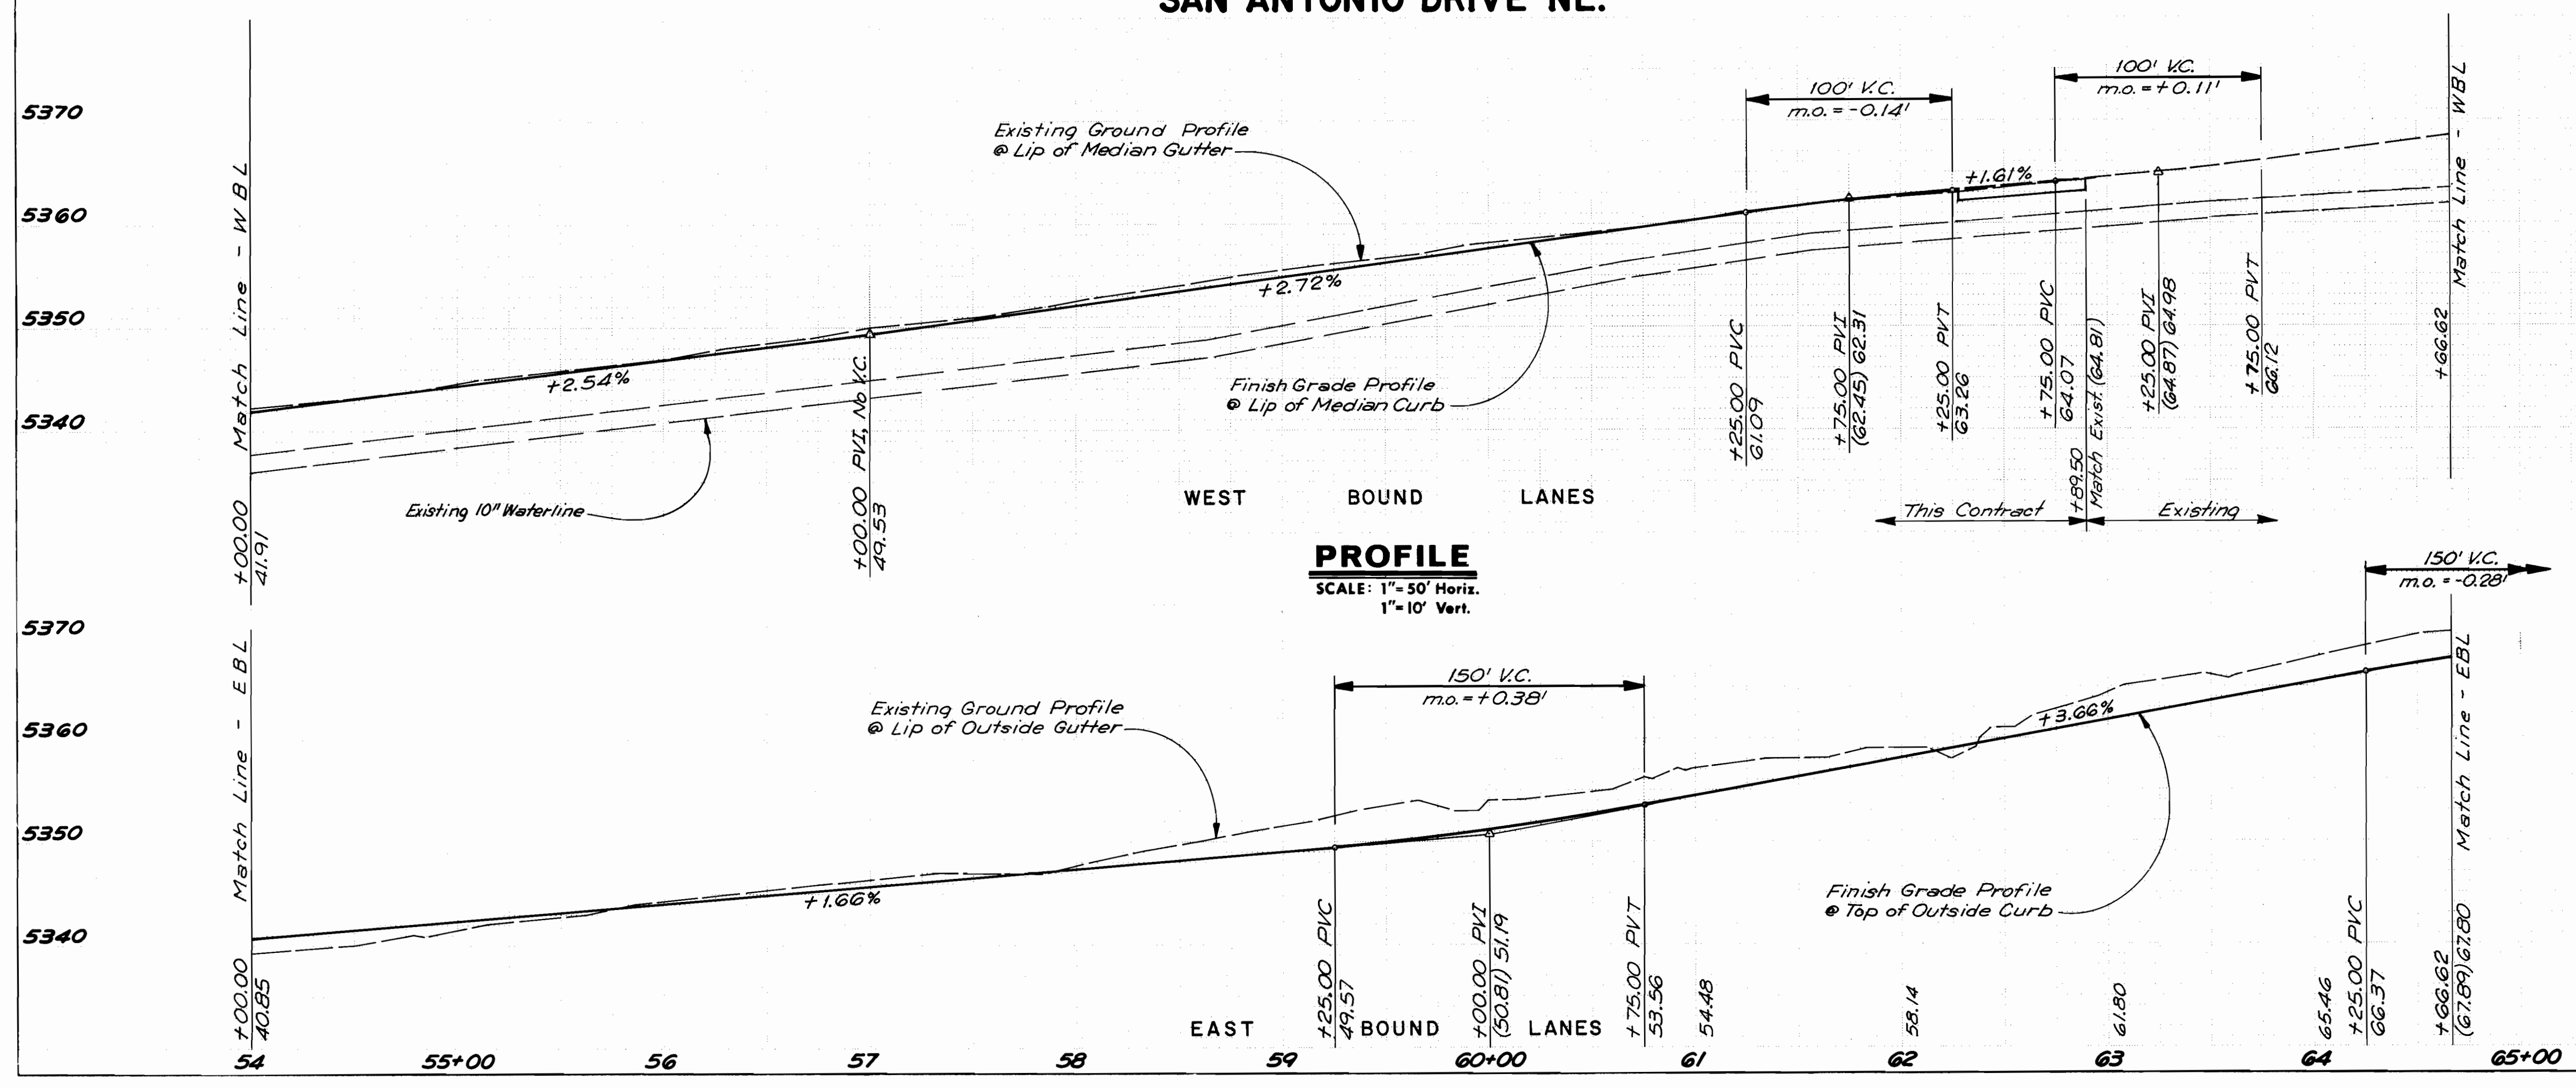

PROFILE
SCALE: 1"=50' Horiz.
1"=10' Vert.

- NOTES**
- SEE SHEET 19 FOR JOYCE DRIVE.
 - SEE SHEET FOR SANITARY SEWER LINE.
 - EXISTING POWERLINE IN EASTBOUND SAN ANTONIO DRIVE WILL BE RELOCATED BY OTHERS.

SURVEY INFORMATION			BENCH MARKS			AS BUILT INFORMATION		
NO.	BY	DATE	NO.	DATE	NO.	DATE	NO.	DATE
1	MOORE & CONERT	1/18/87	1	ACS STA 112+18.1978"	1	ACS STA 112+18.1978"	1	ACS STA 112+18.1978"
2	ELEVATION 5337.039		2	ACS BRASS TABLET SET ON CONCRETE POST FLUSH W/ GROUND	2	ACS BRASS TABLET SET ON CONCRETE POST FLUSH W/ GROUND	2	ACS BRASS TABLET SET ON CONCRETE POST FLUSH W/ GROUND
3	LOCATED 41 FEET SOUTH OF THE CENTERLINE OF SAN ANTONIO DRIVE AND 34 FEET WEST OF THE CENTERLINE OF LOUISIANA BOULEVARD		3	LOCATED 41 FEET SOUTH OF THE CENTERLINE OF SAN ANTONIO DRIVE AND 34 FEET WEST OF THE CENTERLINE OF LOUISIANA BOULEVARD	3	LOCATED 41 FEET SOUTH OF THE CENTERLINE OF SAN ANTONIO DRIVE AND 34 FEET WEST OF THE CENTERLINE OF LOUISIANA BOULEVARD	3	LOCATED 41 FEET SOUTH OF THE CENTERLINE OF SAN ANTONIO DRIVE AND 34 FEET WEST OF THE CENTERLINE OF LOUISIANA BOULEVARD
MICRO-FILM INFORMATION			MICRO-FILM INFORMATION			MICRO-FILM INFORMATION		
RECORDED BY			RECORDED BY			RECORDED BY		
DATE			DATE			DATE		

REVISIONS			
NO.	DATE	REMARKS	BY
1		DESIGN	

APPROVALS			APPROVALS		
ENGINEER	DATE	DATE	ENGINEER	DATE	DATE
City Engineer	1/20/84		Liquid Waste	B. Ryals	1-31-84
A.C.E. Design	1/2/84		Traffic	B. Ryals	1-31-84
A.C.E. Hydrology	1/31/84		Water	B. Ryals	1-31-84


DRAWING NO.	2151	MAP NO.	E-18, E-19	SHEET	16	OF	34
-------------	------	---------	------------	-------	----	----	----

26 21511687

John A. Andrews
RECORD DRAWING


CITY OF ALBUQUERQUE
MUNICIPAL DEVELOPMENT DEPARTMENT
ENGINEERING DIVISION

PINO ARROYO CORRIDOR IMPROVEMENTS
SAN ANTONIO DRIVE NE.
PLAN & PROFILE - STA. 54+00 TO STA. 64+66.02

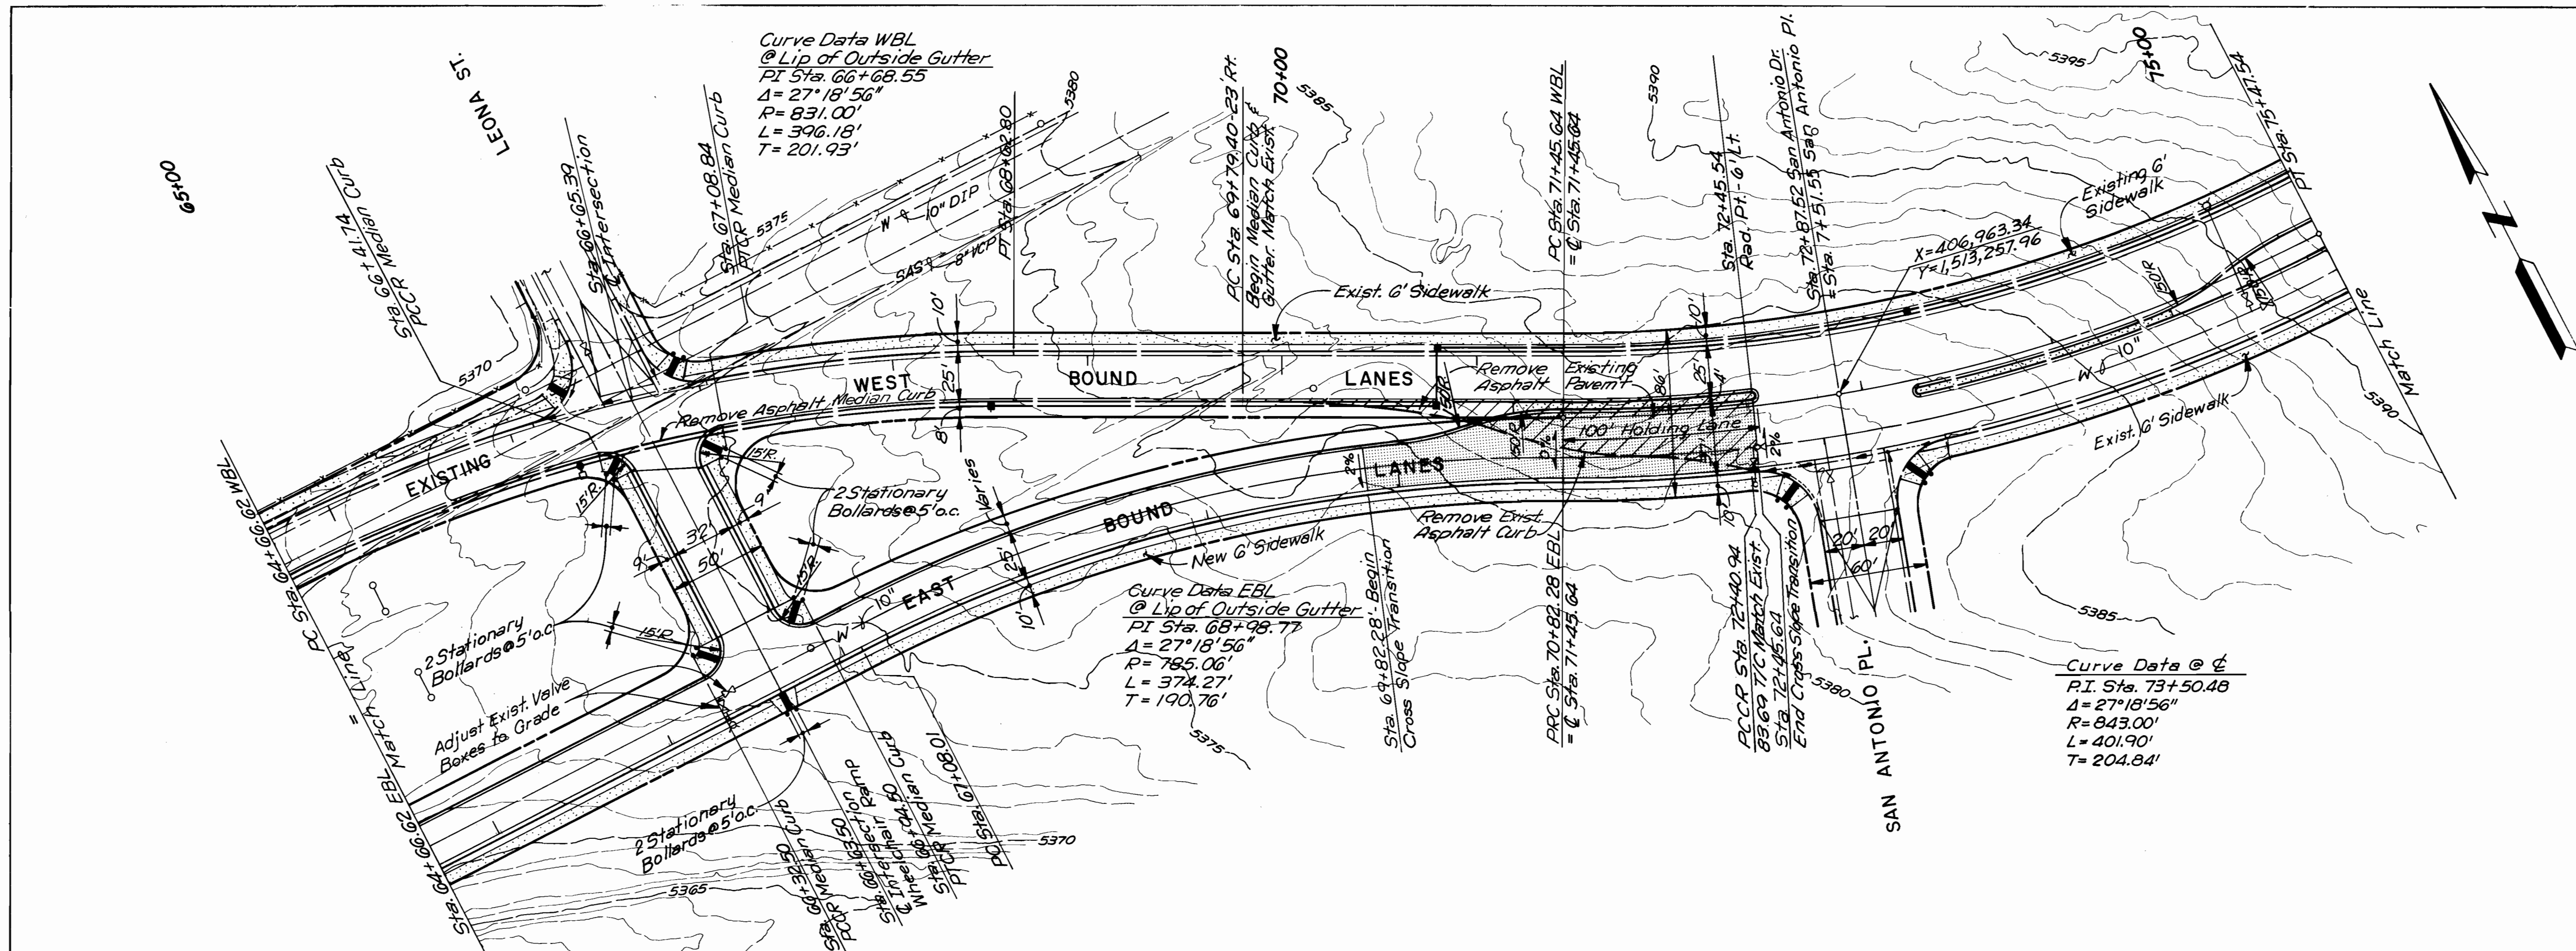

PLAN
 SCALE: 1" = 50'

SAN ANTONIO DRIVE NE.

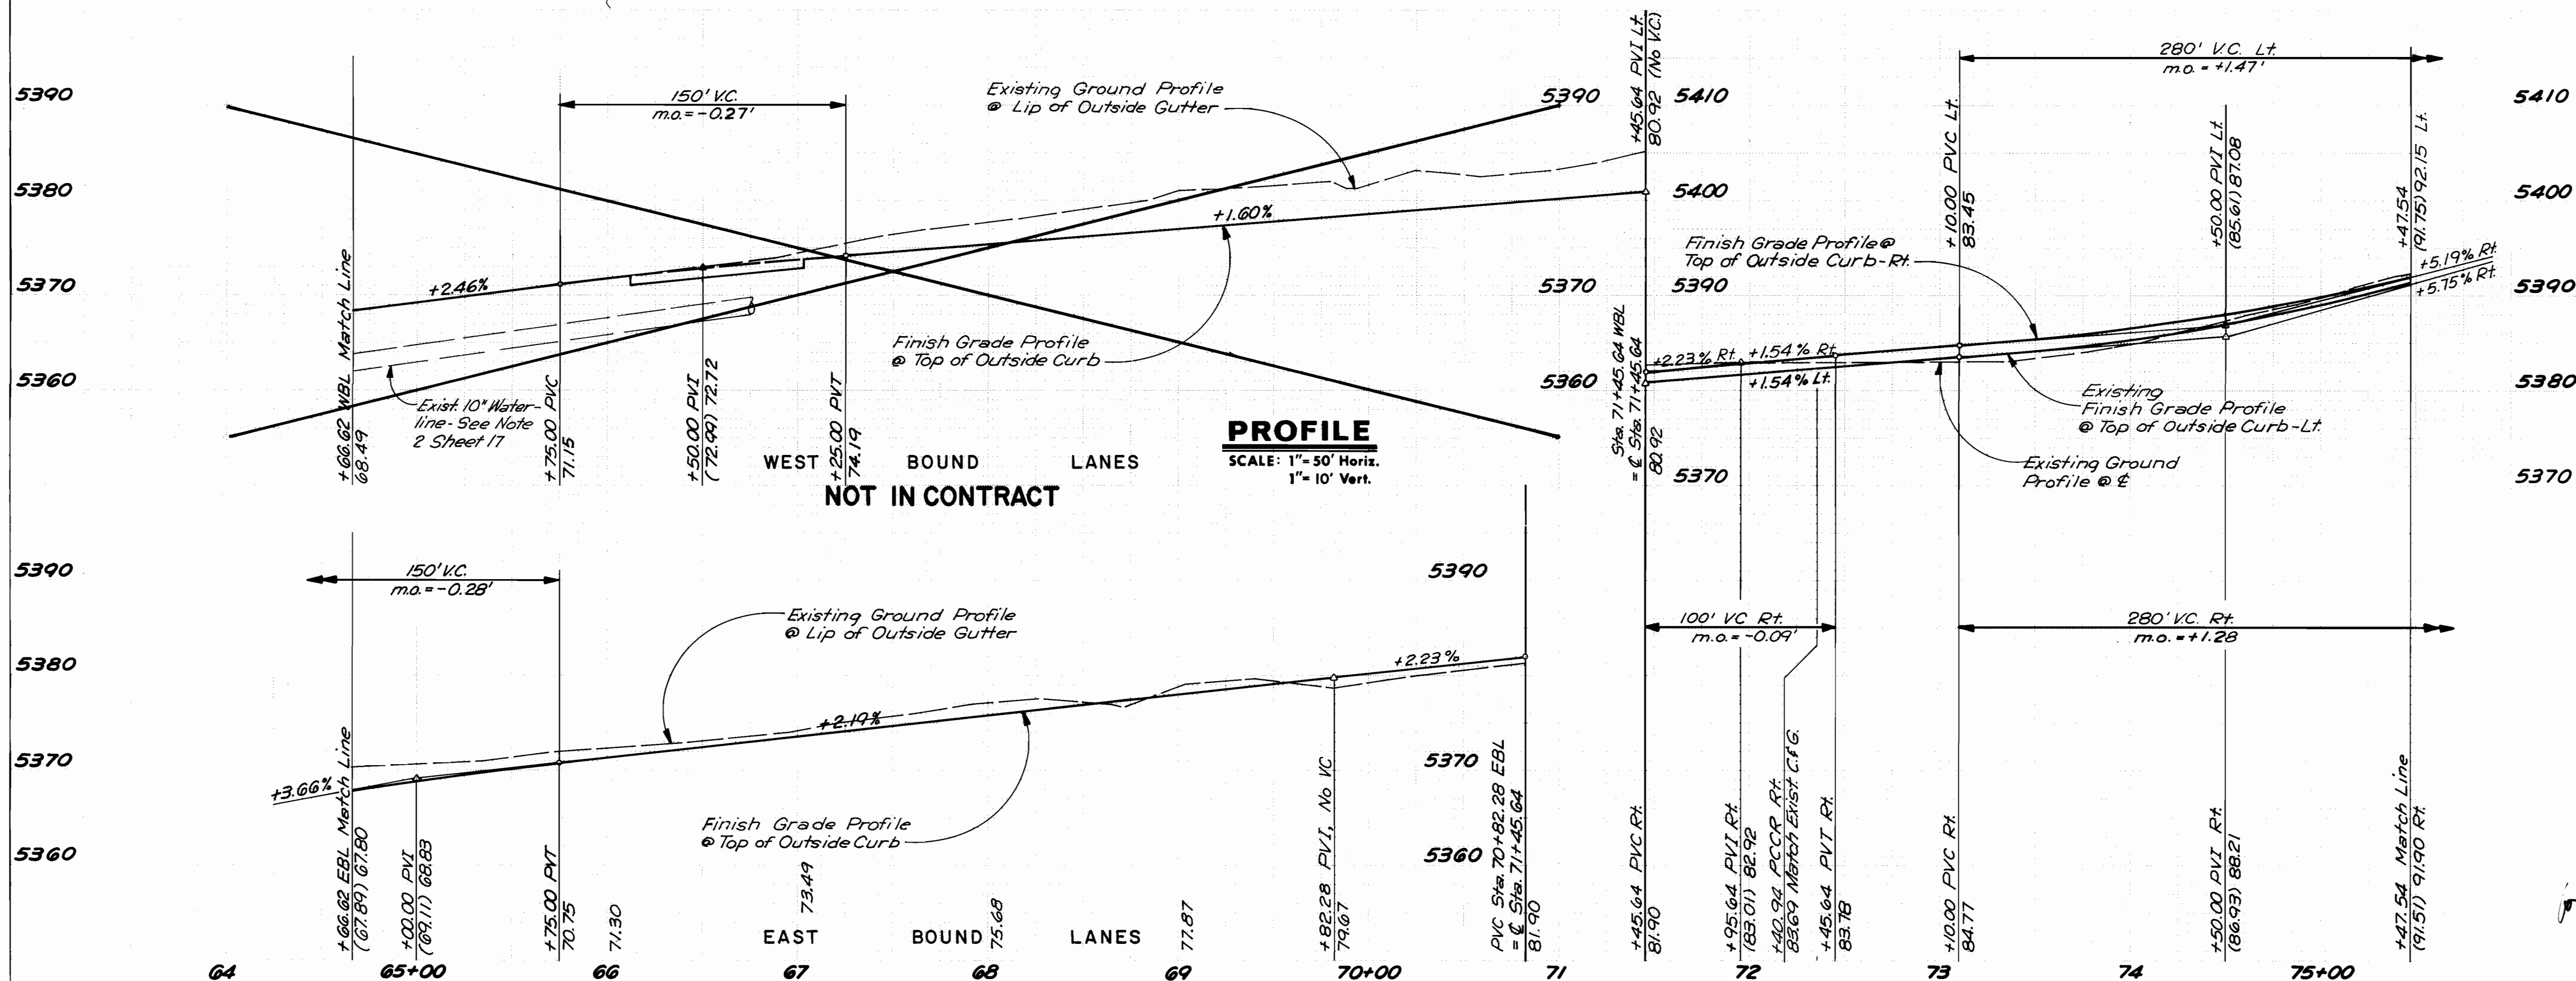

CURB RETURN CURVE DATA

①	R = 30.00'
	$\Delta = 100^\circ 04' 02''$
	$L = 52.40'$
	$T = 35.80'$
②	R = 30.00'
	$\Delta = 73^\circ 39' 15''$
	$L = 38.57'$
	$T = 22.47'$
③	R = 30.00'
	$\Delta = 86^\circ 49' 47''$
	$L = 45.46'$
	$T = 28.38'$

John A. Anderson
RECORD DRAWING
 26 21511787


CITY OF ALBUQUERQUE
 MUNICIPAL DEVELOPMENT DEPARTMENT
 ENGINEERING DIVISION

PINO ARROYO CORRIDOR IMPROVEMENTS
 SAN ANTONIO DRIVE NE.
 PLAN & PROFILE - STA. 64+66.62 TO STA. 75+47.54

APPROVALS	ENGINEER	DATE	APPROVALS	ENGINEER	DATE
City Engineer	<i>[Signature]</i>	11/20/06	Liquid Waste	<i>[Signature]</i>	1-31-06
A.C.E. Design	<i>[Signature]</i>	1/31/06	Traffic	<i>[Signature]</i>	1-31-06
A.C.E. Hydrology	<i>[Signature]</i>	1-31-06	Water	<i>[Signature]</i>	1-31-06


DRAWING NO. **2151** MAP NO. **E-18, E-19** SHEET **17** OF **34**

SURVEY INFORMATION		BENCH MARKS		AS BUILT INFORMATION	
NO.	FIELD NOTES BY	DATE		CONTRACTOR	DATE
				MOORE & CONANT	1/31/06
				INSPECTOR	DATE
				CHY	1/31/06
				LOCATION	DATE
				LOCATED 41 FEET SOUTH OF THE CENTERLINE OF SAN ANTONIO DRIVE AND 34 FEET WEST OF THE CENTERLINE OF LOUISIANA BOULEVARD	1/31/06
				RECORDED BY	DATE
				NO	

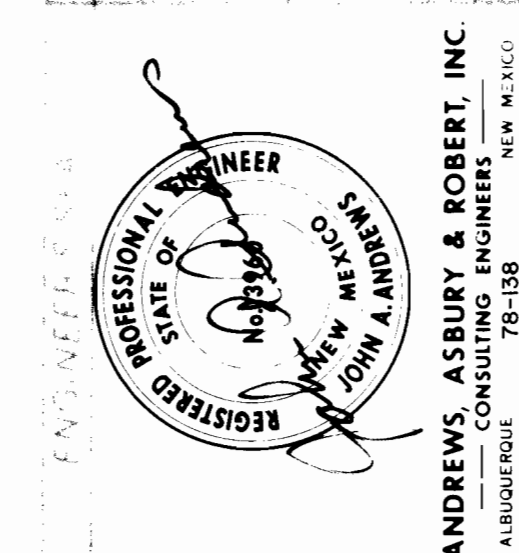

REVISIONS		DESIGN	
NO.	DATE	BY	DATE

ANDREWS, ASBURY & ROBERT, INC.
 ALBUQUERQUE, N.M. 87102

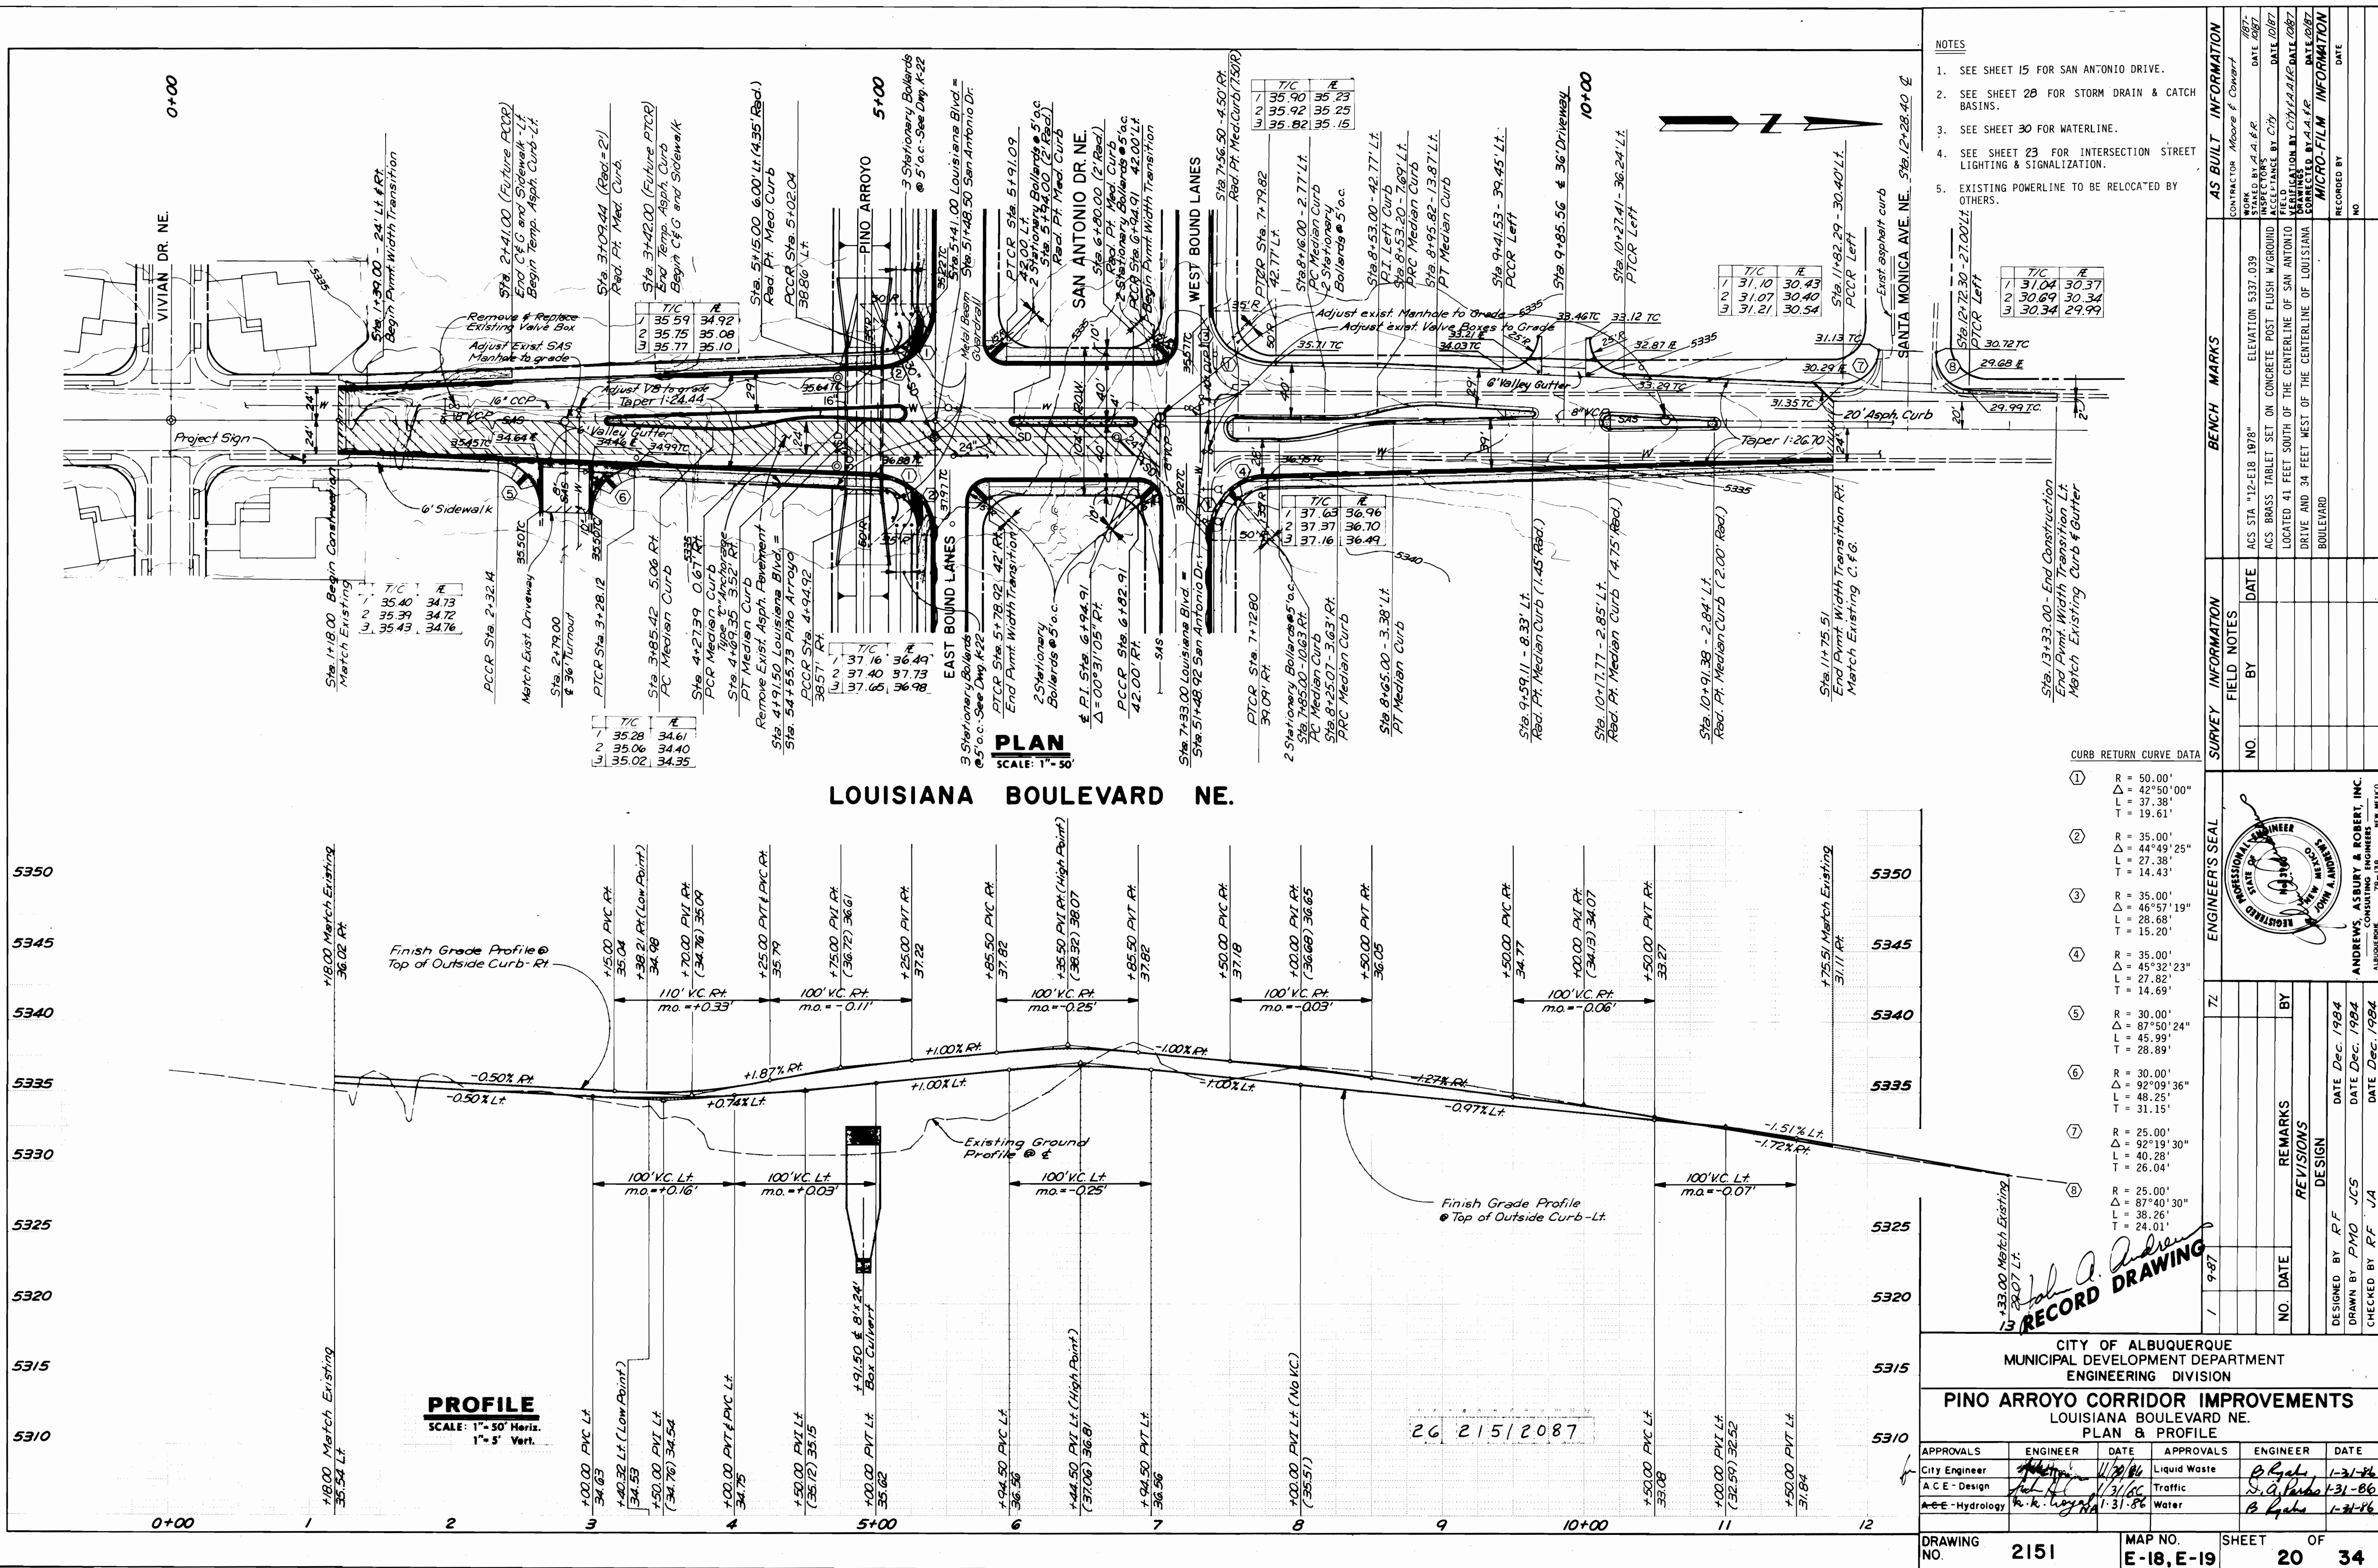

- NOTES
- SEE SHEET 15 FOR SAN ANTONIO DRIVE.
 - SEE SHEET 28 FOR STORM DRAIN & CATCH BASINS.
 - SEE SHEET 30 FOR WATERLINE.
 - SEE SHEET 23 FOR INTERSECTION STREET LIGHTING & SIGNALIZATION.
 - EXISTING POWERLINE TO BE RELOCATED BY OTHERS.

T/C	E
1 31.10	30.43
2 31.07	30.40
3 31.21	30.54

T/C	E
1 31.04	30.37
2 30.69	30.34
3 30.34	29.99

T/C	E
1 37.63	36.96
2 37.37	36.70
3 37.16	36.49

NO.	DATE	BY
1	12-18-1978	ACS STA
2	12-18-1978	ACS STA
3	12-18-1978	ACS STA

NO.	DATE	BY
1	12-18-1978	ACS STA
2	12-18-1978	ACS STA
3	12-18-1978	ACS STA


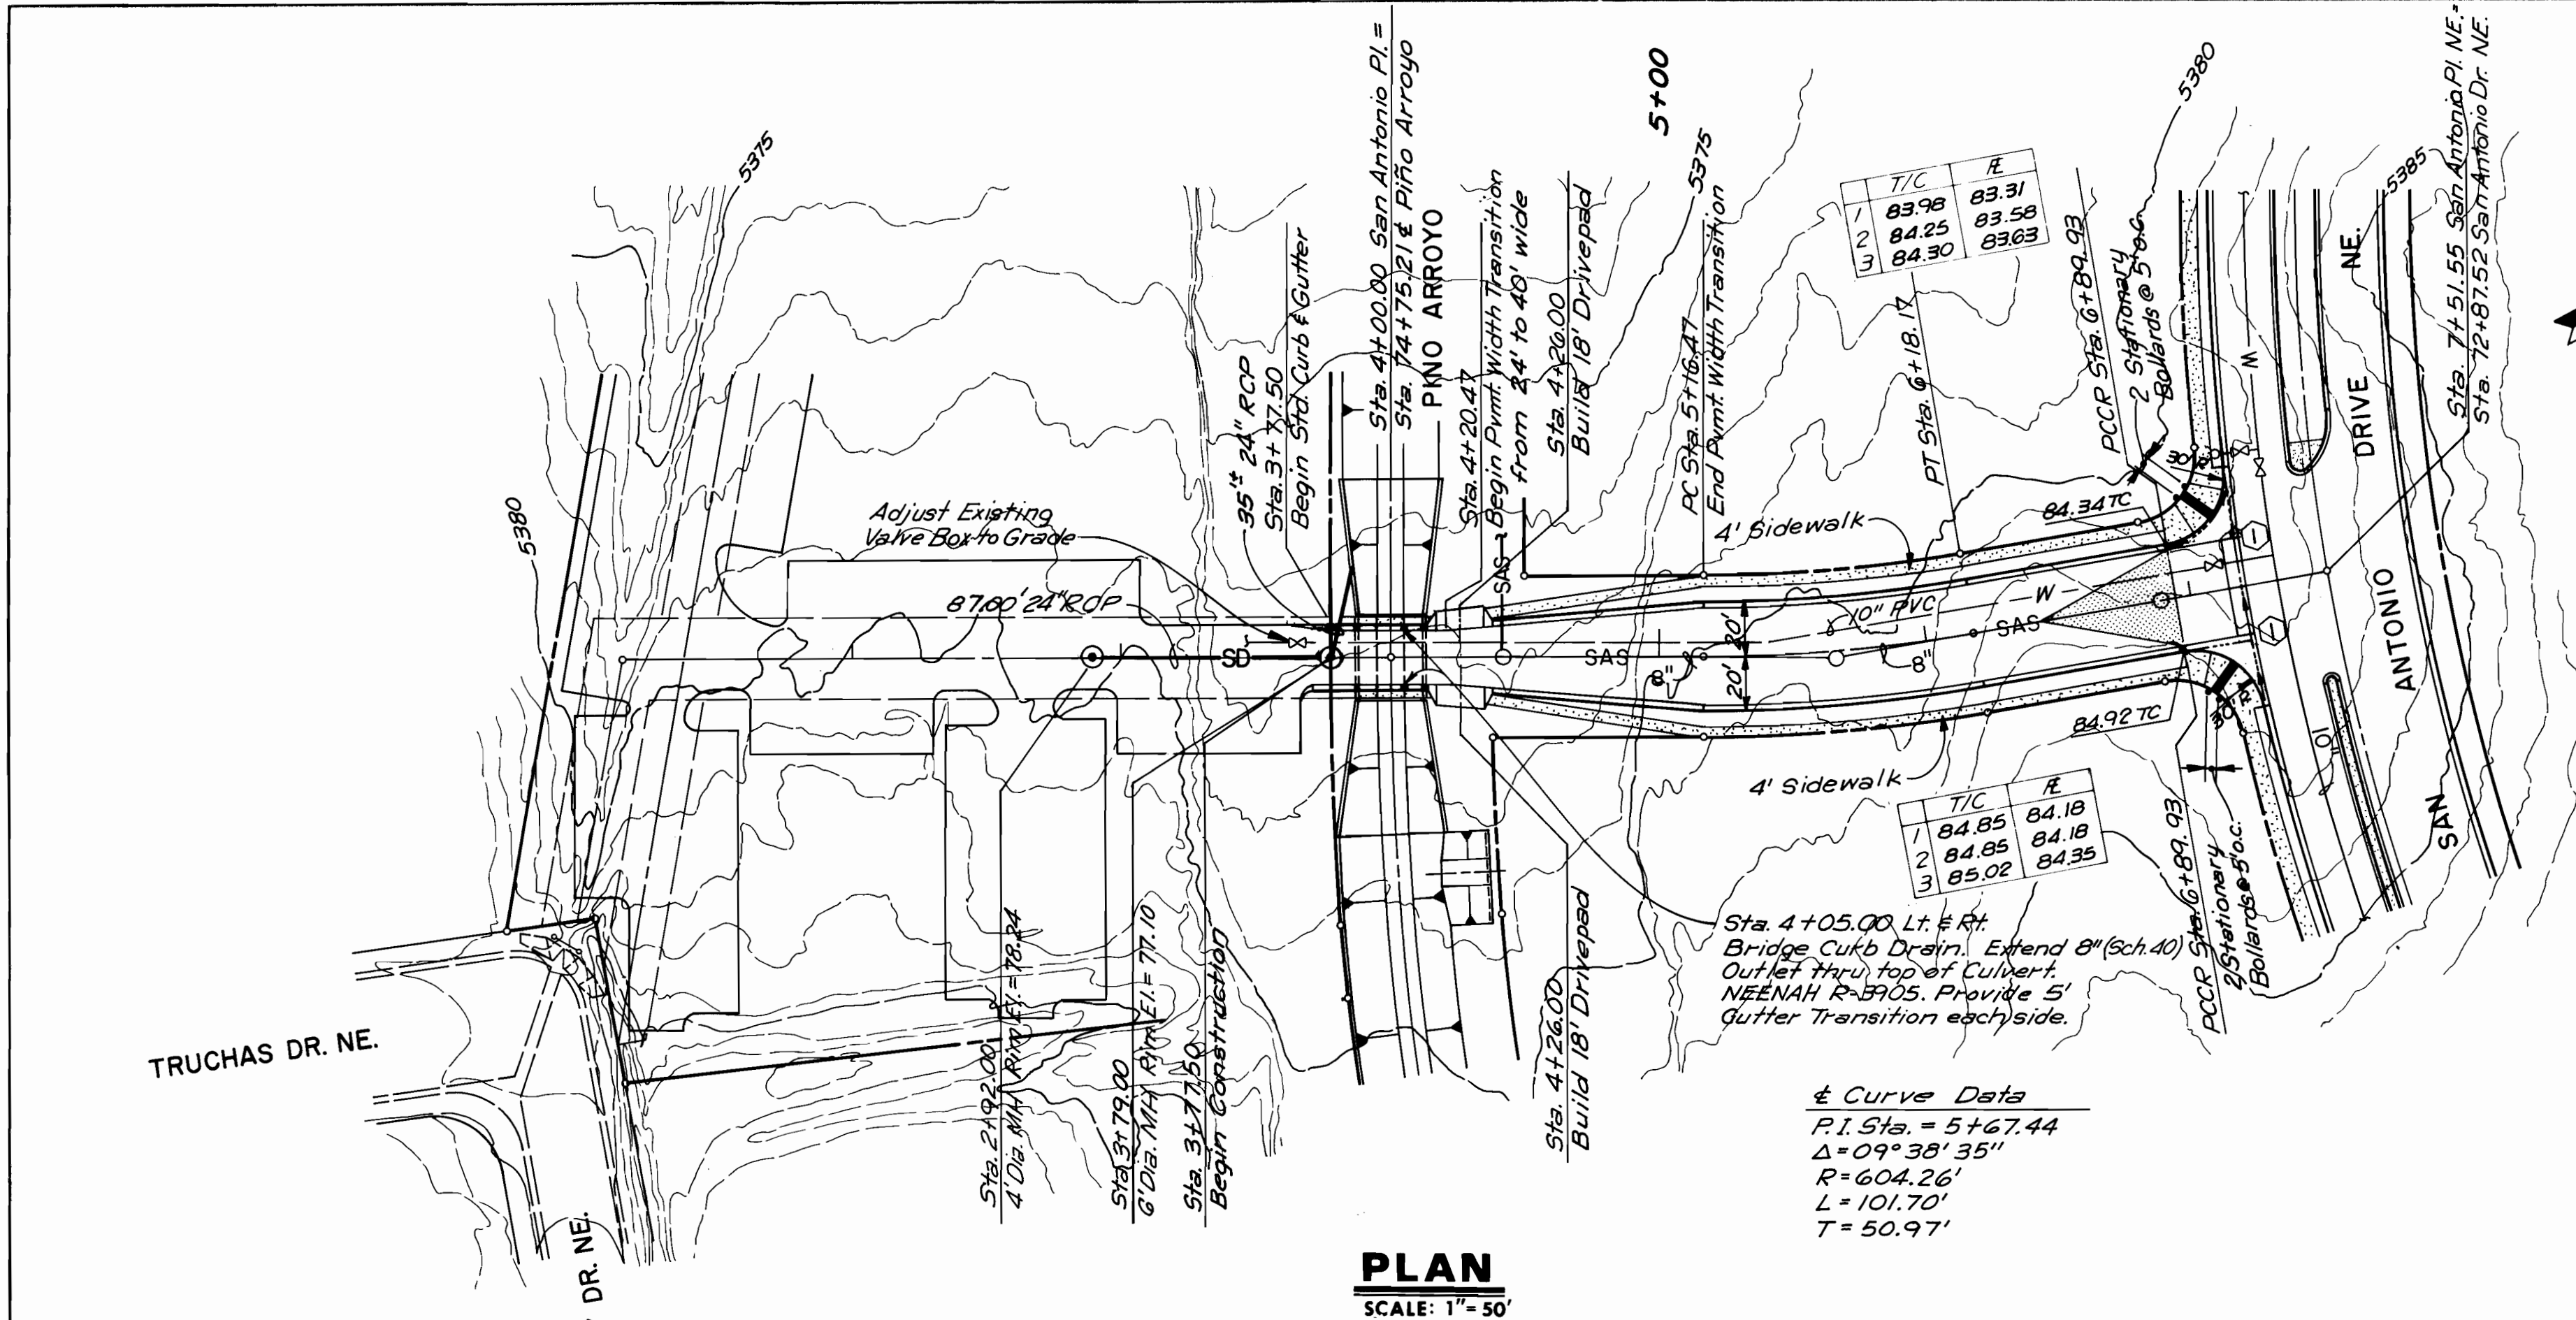

SAN ANTONIO PLACE NE.

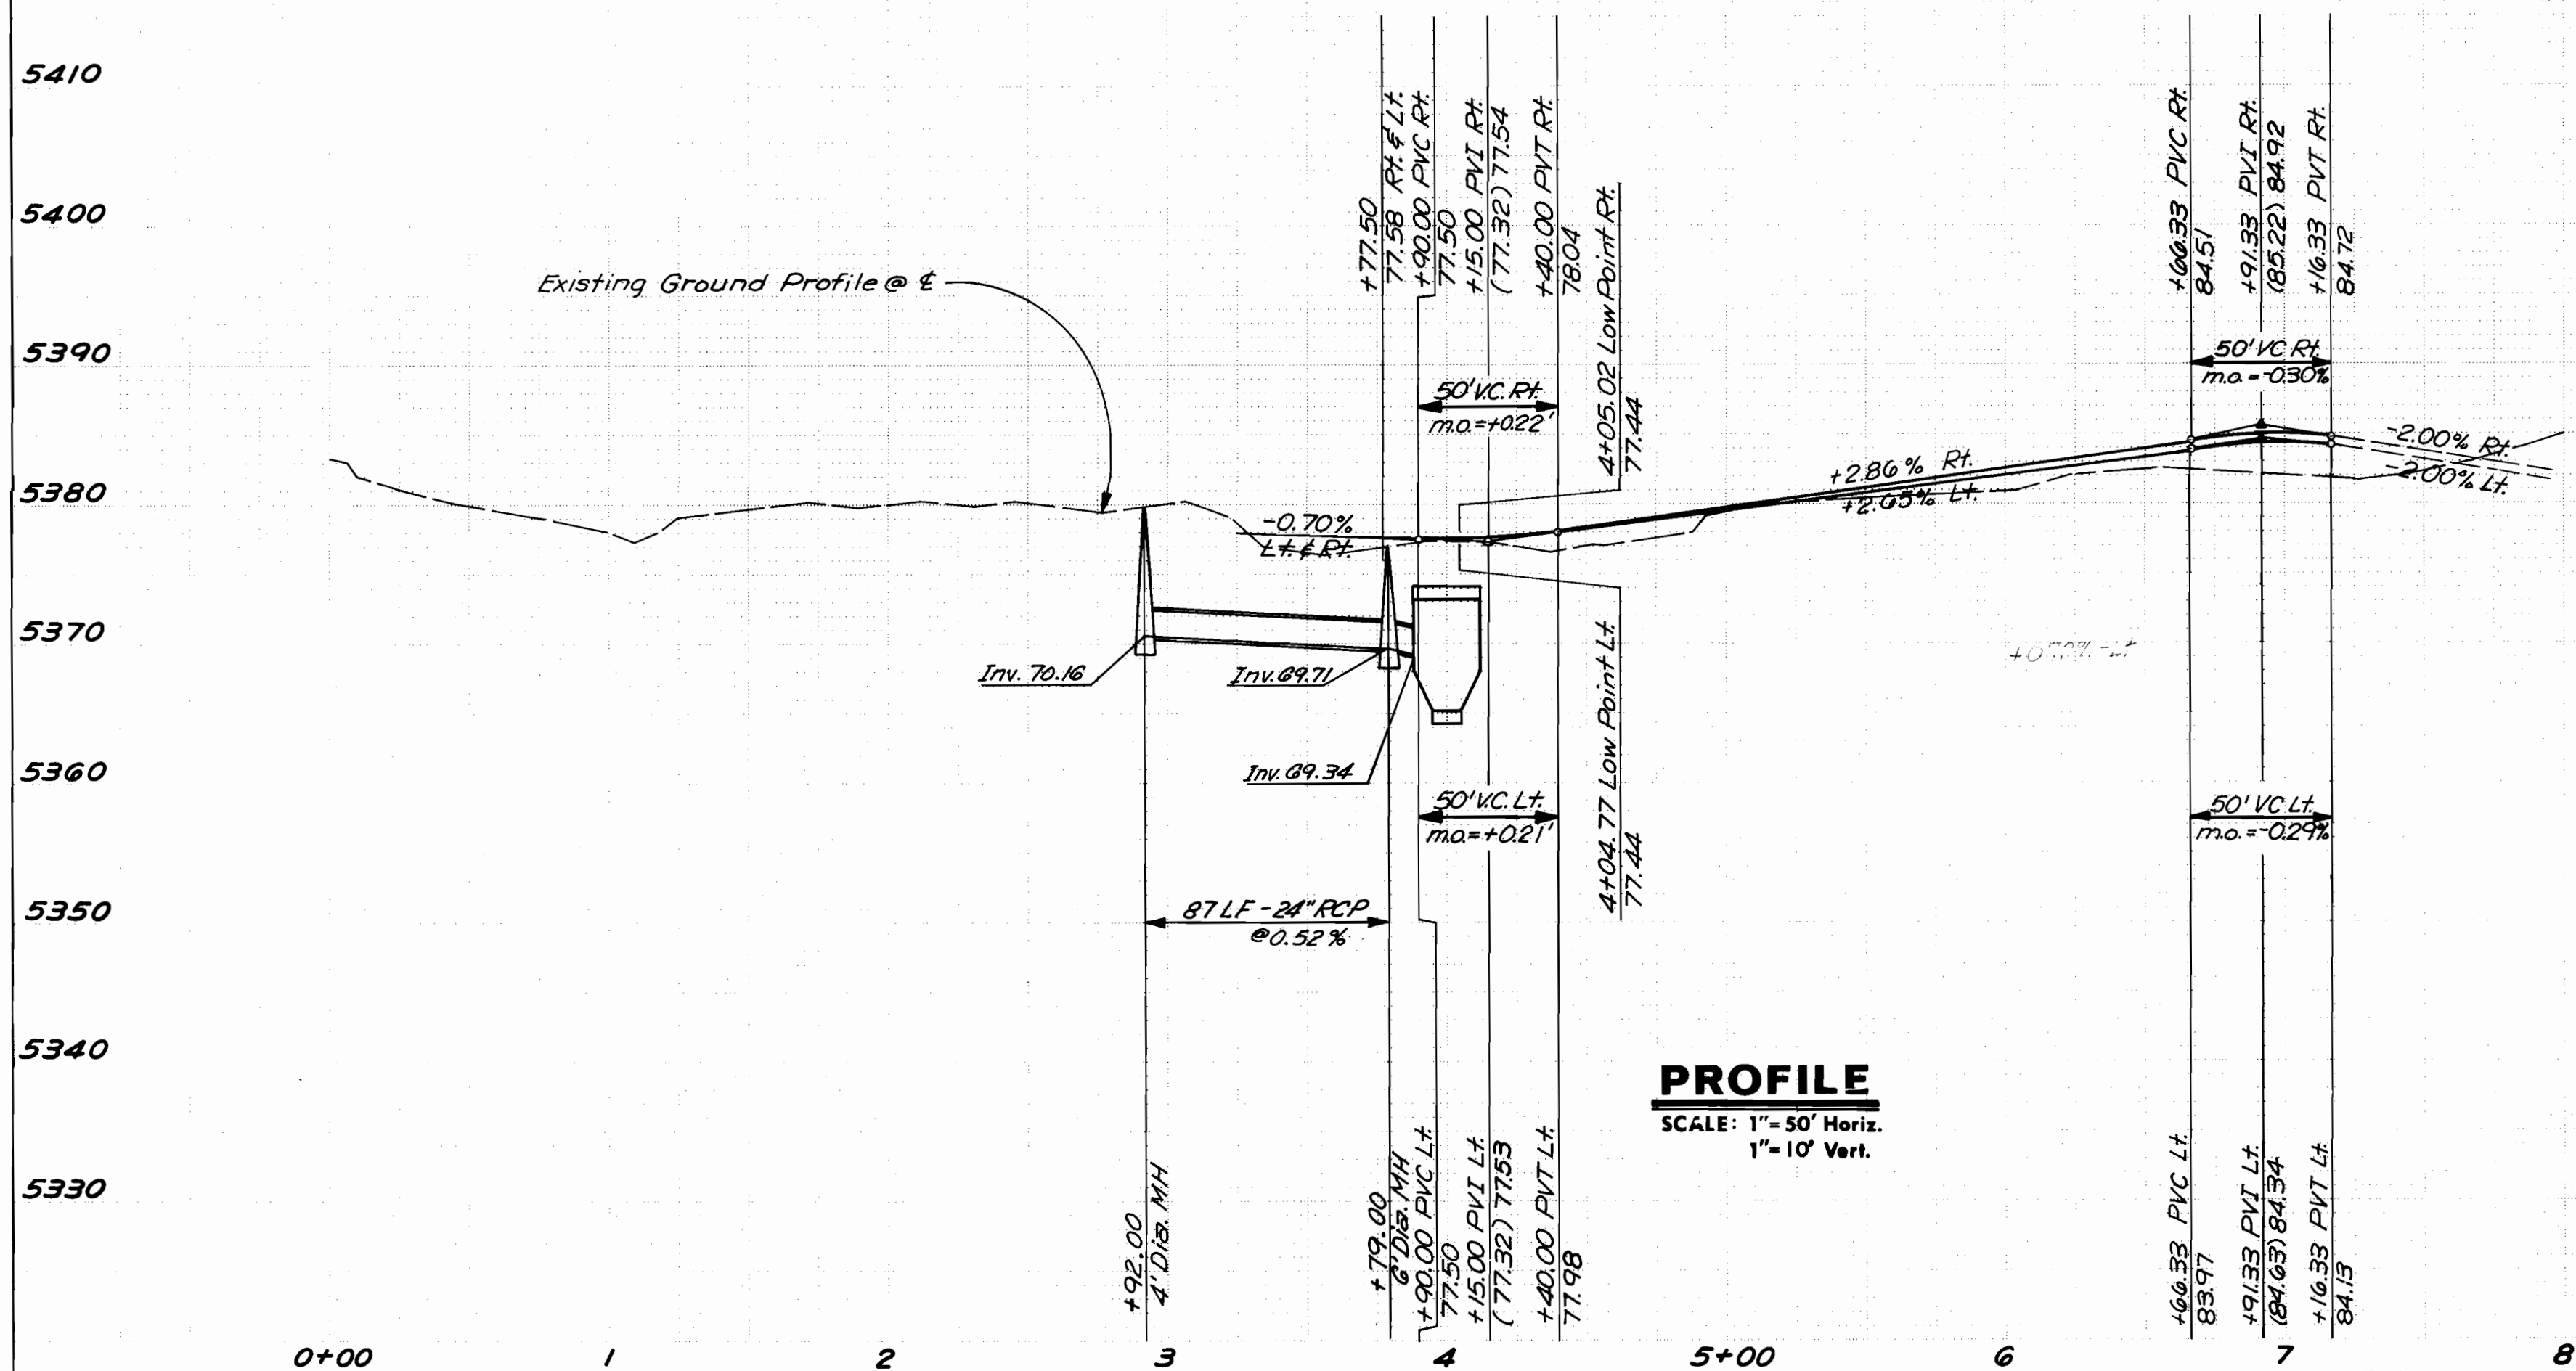


- NOTES
- SEE SHEET 17 FOR SAN ANTONIO DRIVE.
 - SEE SHEET FOR SANITARY SEWER LINE.

CURB RETURN CURVE DATA


① R = 30.00'
Δ = 86°49'47"
L = 45.46'
T = 28.38'

Curve Data
P.I. Sta. = 5+67.44
Δ = 09°38'35"
R = 604.26'
L = 101.70'
T = 50.97'

AS BUILT INFORMATION			BENCH MARKS			SURVEY INFORMATION			ENGINEER'S SEAL		
CONTRACT NO.	MOORE & COMPANY	DATE 10/97	ACS STA "12-E18 1978"	ELEVATION 5337.039	DATE	NO.	BY	DATE		ANDREWS, ASBURY & ROBERT, INC. ALBUQUERQUE CONSULTING ENGINEERS NEW MEXICO	
WORK ORDER NO.	44-1-PR	DATE 10/97	ACS BRASS TABLET SET ON CONCRETE POST FLUSH W/ GROUND								
INSPECTOR'S NAME	BY CH	DATE 10/97	LOCATED 41 FEET SOUTH OF THE CENTERLINE OF SAN ANTONIO DRIVE AND 34 FEET WEST OF THE CENTERLINE OF LOUISIANA BOULEVARD								
MICRO-FILM INFORMATION			REVISIONS			DESIGN			REVISIONS		
DATE 10/97	BY A.A.P.R.	DATE 10/97	NO.	DATE	REMARKS	DESIGNED BY	RSF	DATE	DRAWN BY	PMO	DATE
			CHECKED BY	JA	DATE						
CITY OF ALBUQUERQUE MUNICIPAL DEVELOPMENT DEPARTMENT ENGINEERING DIVISION											
PINO ARROYO CORRIDOR IMPROVEMENTS SAN ANTONIO PLACE NE. PLAN & PROFILE											
APPROVALS	ENGINEER	DATE	APPROVALS	ENGINEER	DATE						
City Engineer	John A. Andrews	11/20/94	Liquid Waste	B. R. Rios	1-31-96						
A.C.E. Design	John A. Andrews	1/31/95	Traffic	B. R. Rios	1-31-96						
Hydrology	John A. Andrews	1/31/95	Water	B. R. Rios	1-31-96						
DRAWING NO. 2151			MAP NO. E-18, E-19			SHEET 21			OF 34		

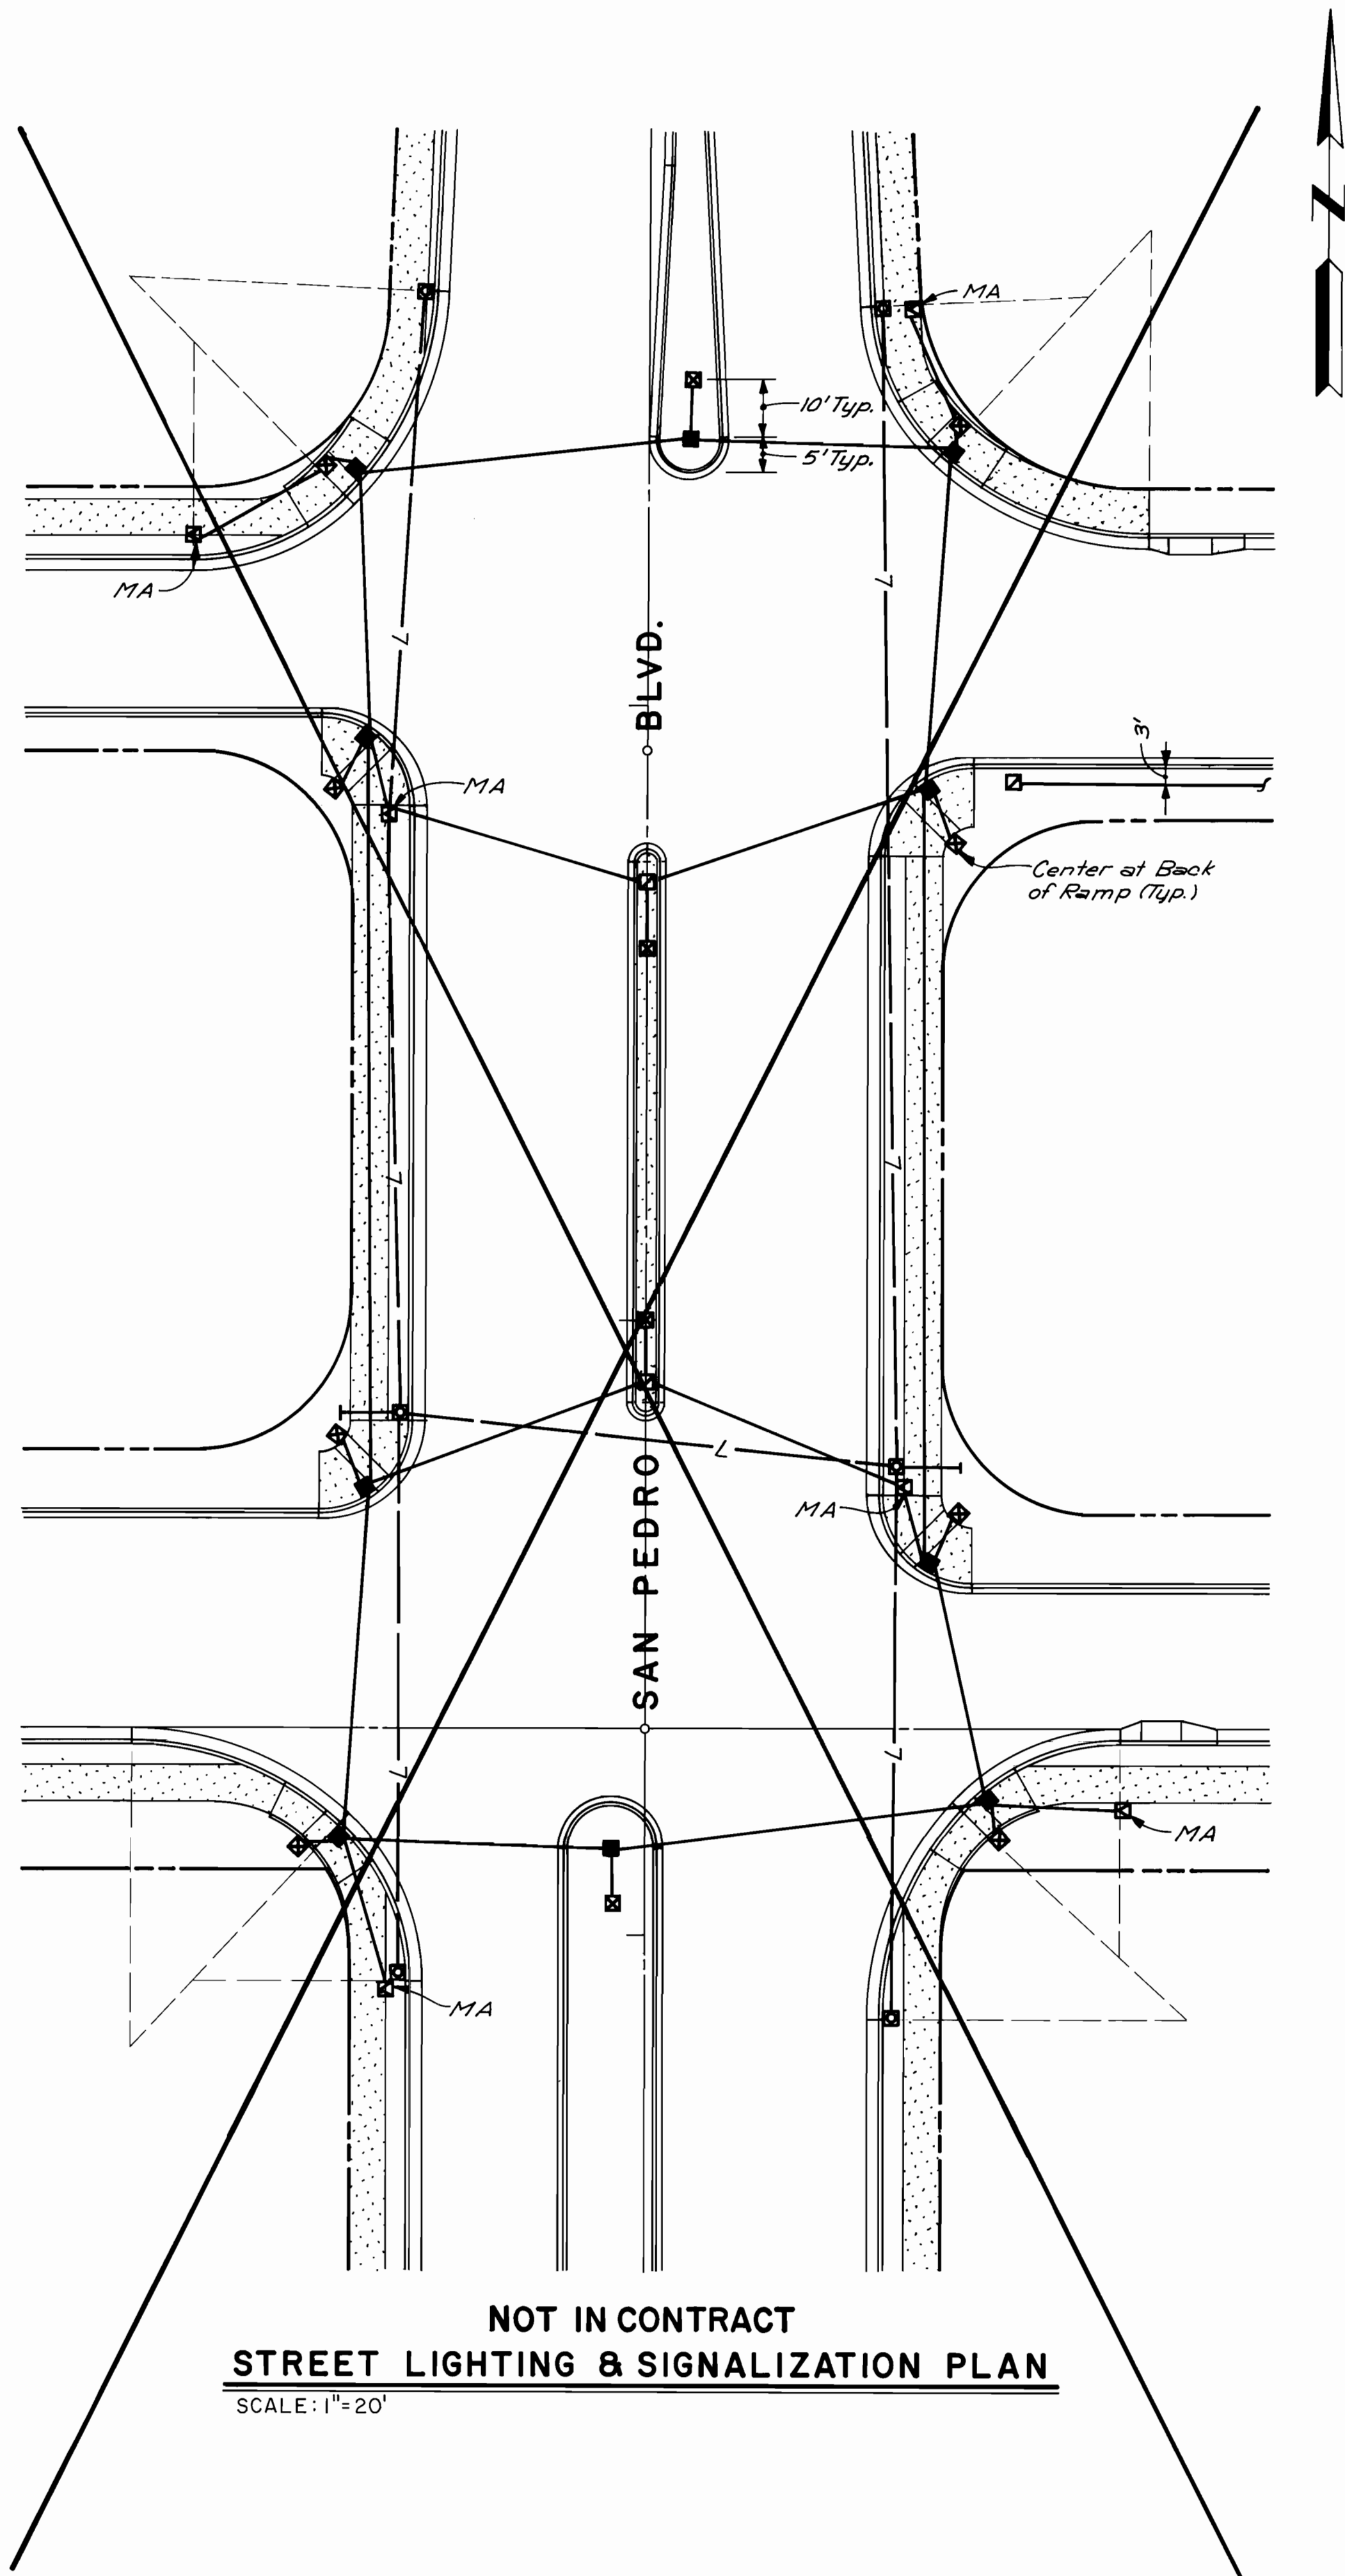

NOT IN CONTRACT
STREET LIGHTING & SIGNALIZATION PLAN
SCALE: 1"=20'

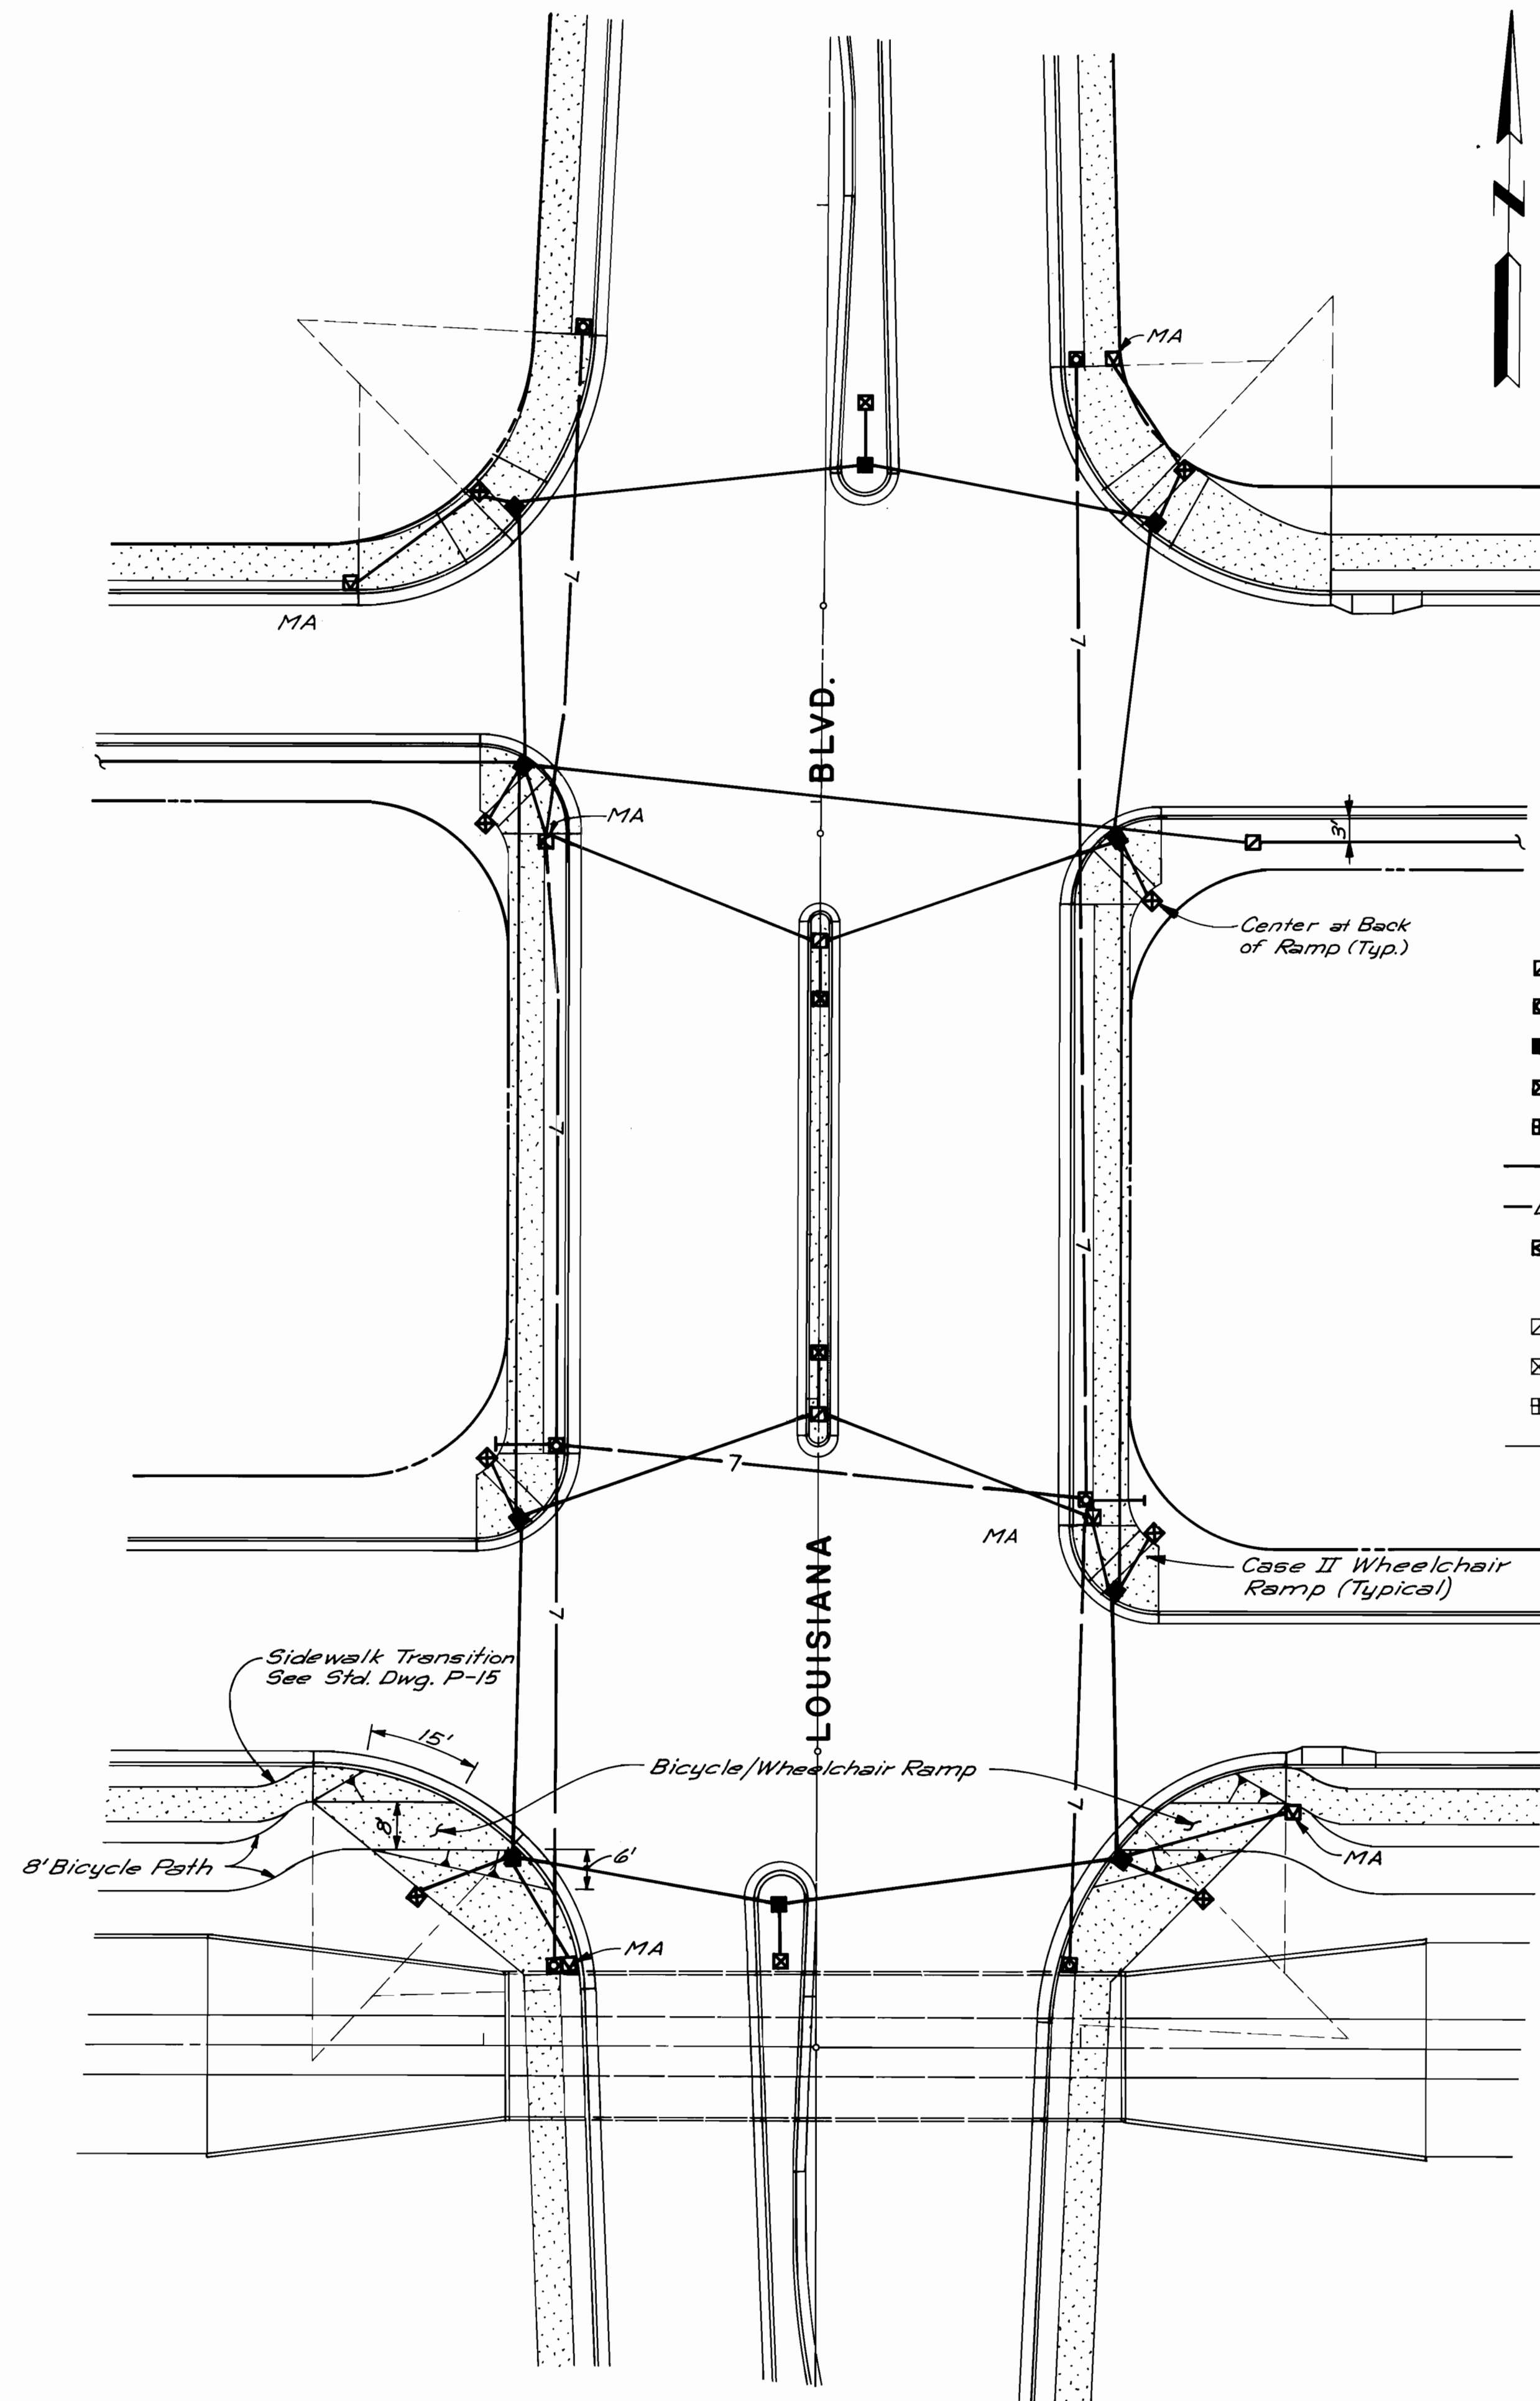




STREET LIGHTING & SIGNALIZATION PLAN
SCALE: 1"=20'

- LEGEND**
- ☒ NEW PULLBOX
 - ☒ NEW PULL BOX LIGHTING
 - ☒ NEW LARGE PULL BOX - SEE DETAIL SHEET 31.
 - ☒ NEW PEDESTAL SIGNAL FOUNDATION, TYPE I
 - ☒ NEW PEDESTAL CONTROLLER FOUNDATION, TYPE II
 - ☒ NEW SIGNAL CONDUIT (2" UNLESS OTHERWISE SHOWN)
 - ☒ NEW LIGHTING CONDUIT, 2"
 - ☒ NEW MAST ARM FOUNDATION, TYPE II
 - ☒ EXISTING PULLBOX
 - ☒ EXISTING PEDESTAL SIGNAL FOUNDATION, TYPE I
 - ☒ EXISTING PEDESTAL CONTROLLER FOUNDATION, TYPE II
 - ☒ EXISTING SIGNAL CONDUIT

John A. Andrews
RECORD DRAWING
26 21512387

CITY OF ALBUQUERQUE MUNICIPAL DEVELOPMENT DEPARTMENT ENGINEERING DIVISION					
PINO ARROYO CORRIDOR IMPROVEMENTS SAN ANTONIO DRIVE NE. STREET LIGHTING & SIGNALIZATION PLANS					
APPROVALS	ENGINEER	DATE	APPROVALS	ENGINEER	DATE
City Engineer	<i>[Signature]</i>	11/21/86	Liquid Waste	<i>M.A. GR.</i>	1-31-86
A.C.E. Design	<i>[Signature]</i>	1/31/86	Traffic	<i>R.A. Pardo</i>	1-31-86
A.C.E. Hydrology	<i>[Signature]</i>	1-31-86	Water	<i>M.A. GR.</i>	1-21-86
DRAWING NO.	2151	MAP NO.	E-18, E-19	SHEET OF	23 34

--	--	
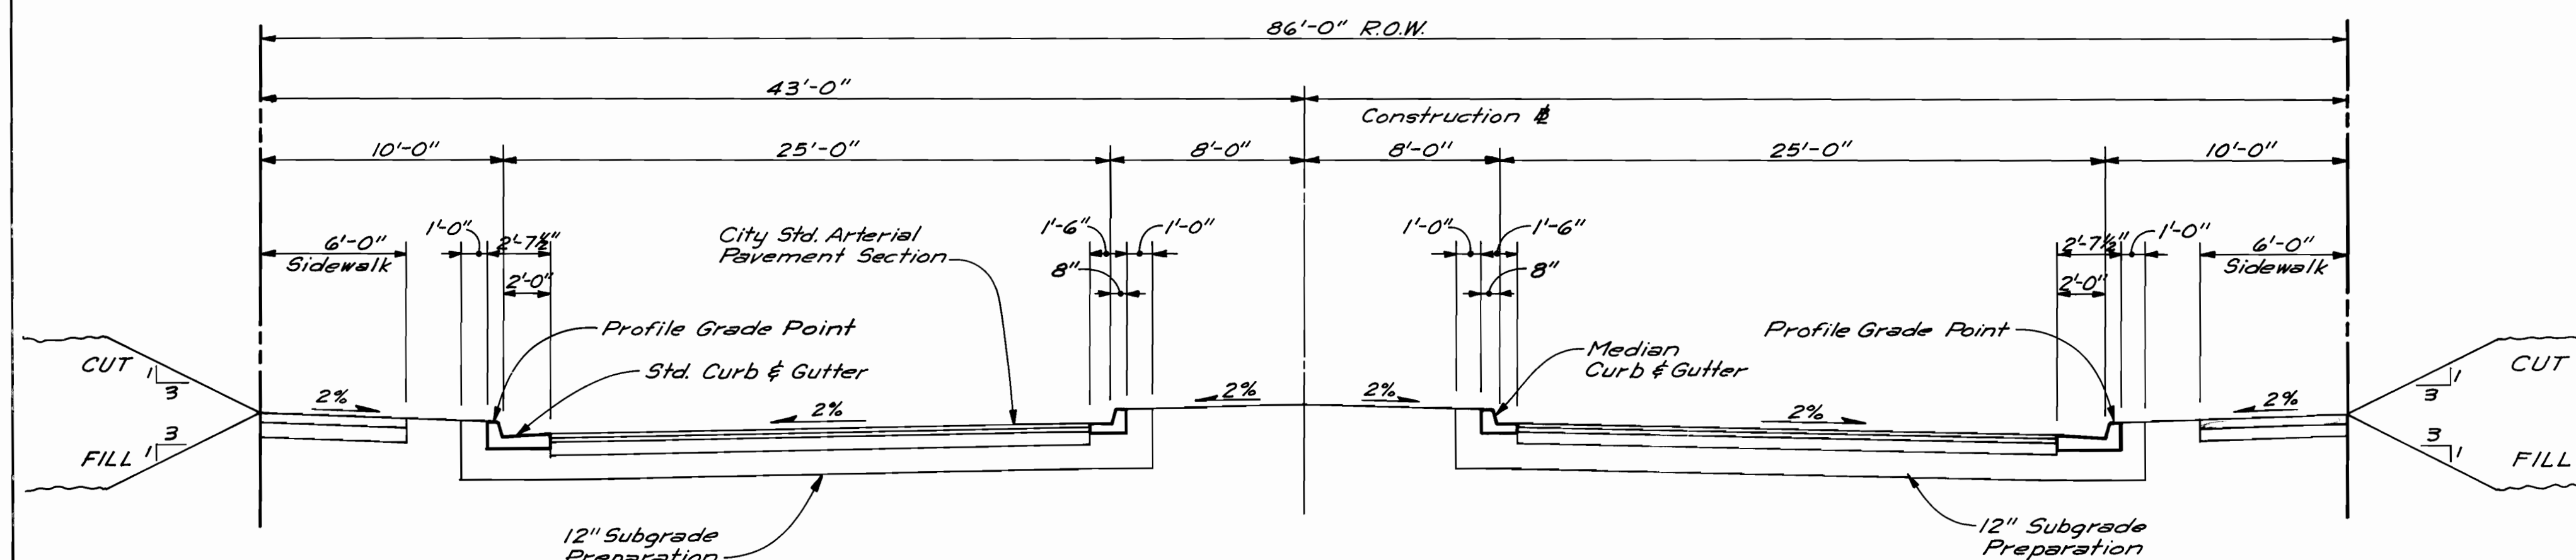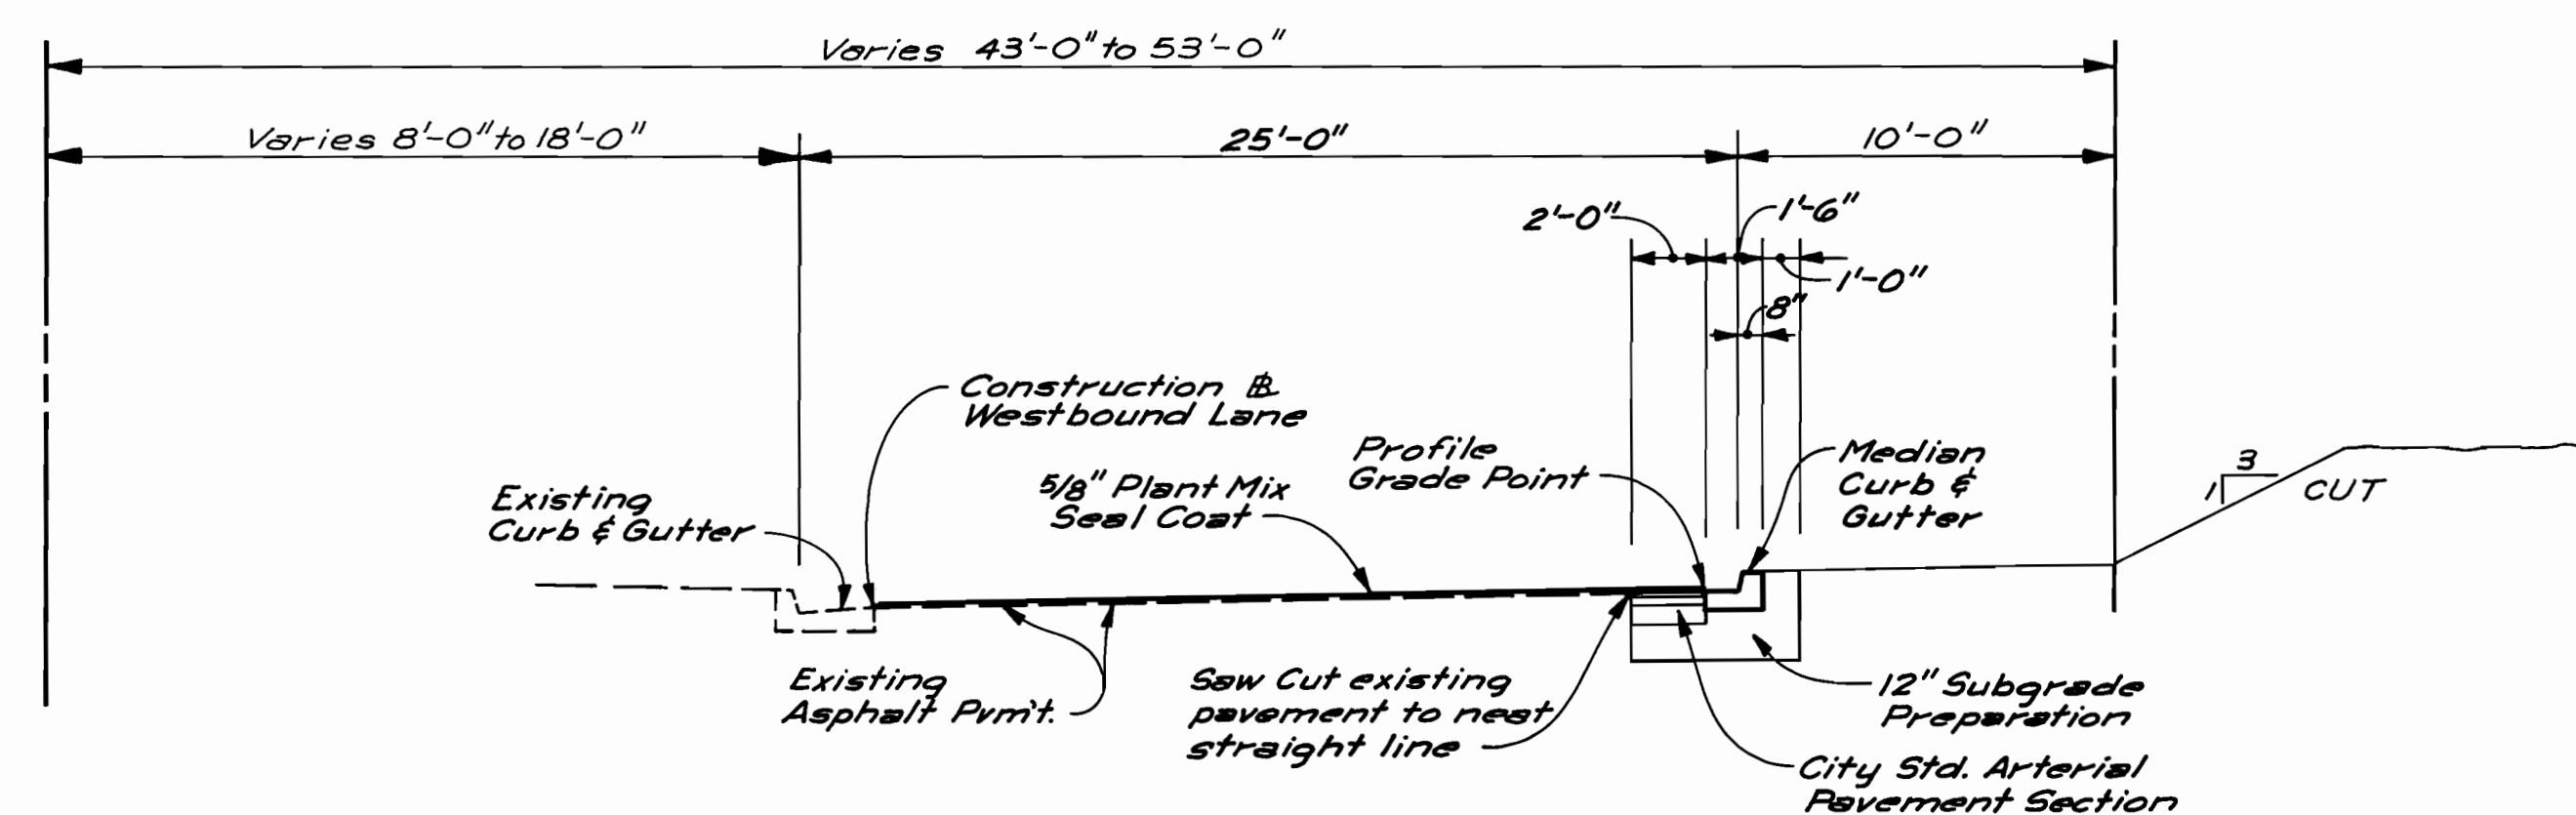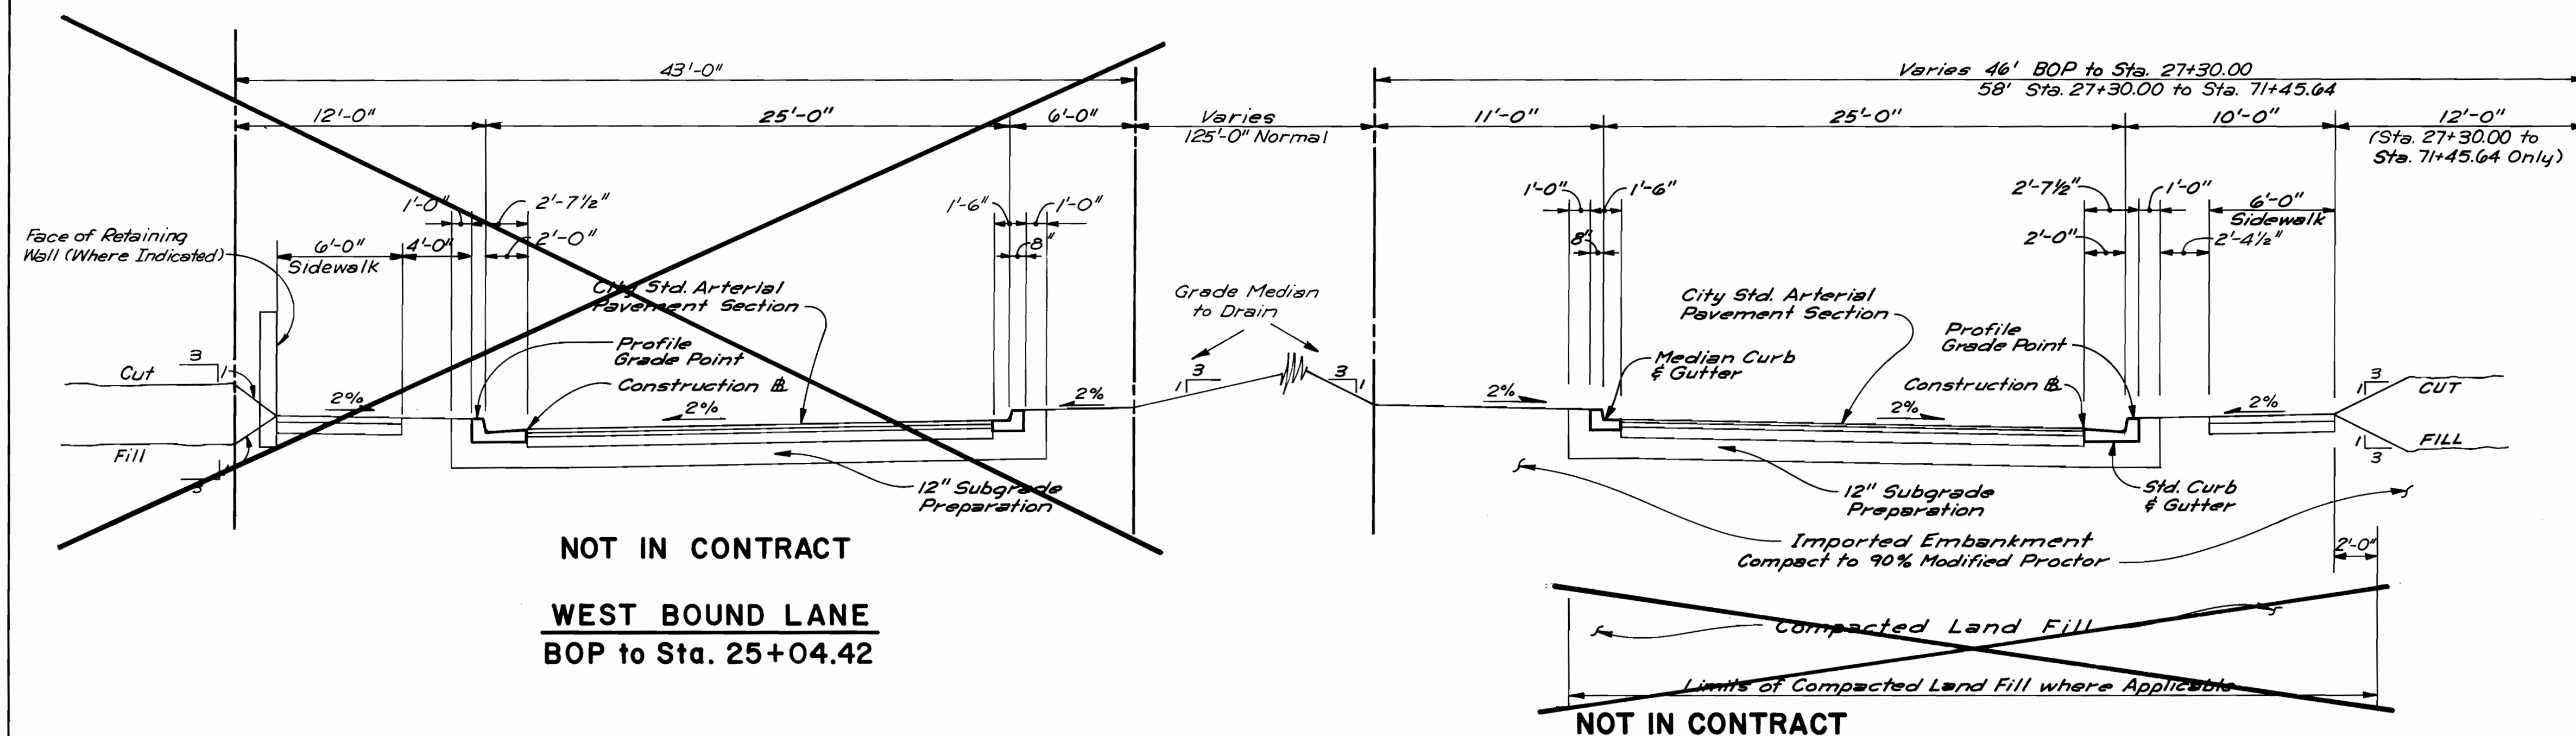

SAN ANTONIO DRIVE NE.
Sta. 71+45.64 to EOP

ENGINEER'S SEAL				SURVEY INFORMATION		BENCH MARKS		AS BUILT INFORMATION	
				FIELD NOTES				CONTRACTOR <i>Moore & Cowart</i>	
				NO.	BY	DATE	ELEVATION 5337.039	WORK IS BY <i>A.A.R.</i>	DATE <i>10/87</i>
REMARKS						ACS BRASS TABLET SET ON CONCRETE POST FLUSH W/GROUND			
NO. DATE		BY				LOCATED 41 FEET SOUTH OF THE CENTERLINE OF SAN ANTONIO DRIVE AND 34 FEET WEST OF THE CENTERLINE OF LOUISIANA BOULEVARD		FIELD INVESTIGATION BY <i>C. J. Andrews</i> DATE <i>10/87</i>	
				DESIGNED BY				DRAWINGS CORRECTED BY <i>A.A.R.</i> DATE <i>10/87</i>	
				DRAWN BY				MICRO-FILM INFORMATION	
				DATE				RECORDED BY	
				DATE				NO.	
								ANDREWS, ASSURBY & ROBERT, INC.	

John A. Andrew
RECORD DRAWING

1	2	3	4	5	6	7	8	9	10
26	21	51	25	8					

CITY OF ALBUQUERQUE
MUNICIPAL DEVELOPMENT DEPARTMENT
ENGINEERING DIVISION

PINO ARROYO CORRIDOR IMPROVEMENTS
TYPICAL STREET SECTIONS
SAN ANTONIO DRIVE NE.

APPROVALS	ENGINEER	DATE	APPROVALS	ENGINEER	DATE
City Engineer	<i>[Signature]</i>	11/20/86	Liquid Waste	N/A BR	1-31-86
A.C.E.-Design	<i>[Signature]</i>	1/31/86	Traffic	D.A. Parks	1-31-86
A.C.E.-Hydrology	K.K. Coyne	1-31-86	Water	N/A BR	1-31-86

DRAWING NO.	2151	MAP NO. E-18, E-19	SHEET 25	OF 34
----------------	------	-----------------------	-------------	----------

Plan view of a proposed 104' wide arterial highway section. The diagram shows a symmetrical layout with a 6' sidewalk on each side, a 2% cross-slope, and a 12' subgrade preparation area. Key features include a 'City Std. Arterial Pavement Section' on the left, a 'Construction #1' area in the center, and a 'Median Curb & Gutter' on the right. Dimensions for various sections are provided, ranging from 8' to 42'. The right side of the diagram shows a transition to a 'CUT' or 'FILL' area with a 3/1 slope.

16'-0"

25'-0"

Varies 86'-0" to 92'-0"

25'-0"

10'-0"

6'-0" Sidewalk

1'-0"

2'-7 1/2"

7 1/2"

Profile Grade Point

City Std. Arterial Pvm't. Section

Median Curb & Gutter

2%

12" Subgrade Preparation

1'-6"

1'-0"

5"

1'-0"

1'-6"

City Std. Arterial Pvm't. Section

Median Curb & Gutter

Profile Grade Point

Depressed Gutter

2%

12" Subgrade Preparation

2'-7 1/2"

1'-0"

6'-0" Sidewalk

7 1/2"

2%

2'-0"

3

1

CUT

FILL

20'-0"

Imported Embankment Compact to 90% Modified Proctor.

Compacted Land Fill

Limits of Compacted Land Fill where Applicable

Varies

Construction

John A. Andrews
RECORD DRAWING

PINO ARROYO CORRIDOR IMPROVEMENTS
TYPICAL STREET SECTIONS
WYOMING BLVD. NE. & SAN PEDRO DR. NE.

APPROVALS	ENGINEER	DATE	APPROVALS	ENGINEER	DATE
City Engineer	<i>[Signature]</i>	11/20/86	Liquid Waste	N/A, BR	1-31-86
A.C.E. - Design	<i>[Signature]</i>	11/31/86	Traffic	D. A. Parks	1-31-86
A.C.E. - Hydrology	K. K. Loyall	1-31-86	Water	N/A, BR	1-31-86

DRAWING NO.	2151	MAP NO.	E-18, E-19	SHEET OF	26 34
-------------	------	---------	------------	----------	-------


SURVEY INFORMATION		BENCH MARKS		AS BUILT INFORMATION	
FIELD NOTES					
NO.	BY	DATE			
			ACS STA "12-E18 1978"	ELEVATION 5337.039	CONTRACTOR Moore & Conert
			ACS BRASS TABLET SET ON CONCRETE POST FLUSH W/GROUND		WORK STARTED BY A.A.F.R. DATE 10/87
			LOCATED 41 FEET SOUTH OF THE CENTERLINE OF SAN ANTONIO		FIELD CORRECTED BY A.A.F.R. DATE 10/87
			DRIVE AND 34 FEET WEST OF THE CENTERLINE OF LOUISIANA		FIELD CORRECTED BY CHA.A.A.F.R. DATE 10/87
			BOULEVARD		FIELD CORRECTED BY A.A.F.R. DATE 10/87
					MICRO-FILM INFORMATION
				RECORDED BY	DATE
				NO	

ENGINEER'S SEAL


Professional Engineer Seal for John A. Andrews, State of New Mexico, No. 12345. The seal is circular with the text "PROFESSIONAL ENGINEER" and "STATE OF NEW MEXICO" around the perimeter. The center contains the name "JOHN A. ANDREWS" and the number "12345". A signature is written across the seal.

ANDREWS, ASBURY & ROBERT, INC.
KATZBURG, ENGINEERS


[illegible]

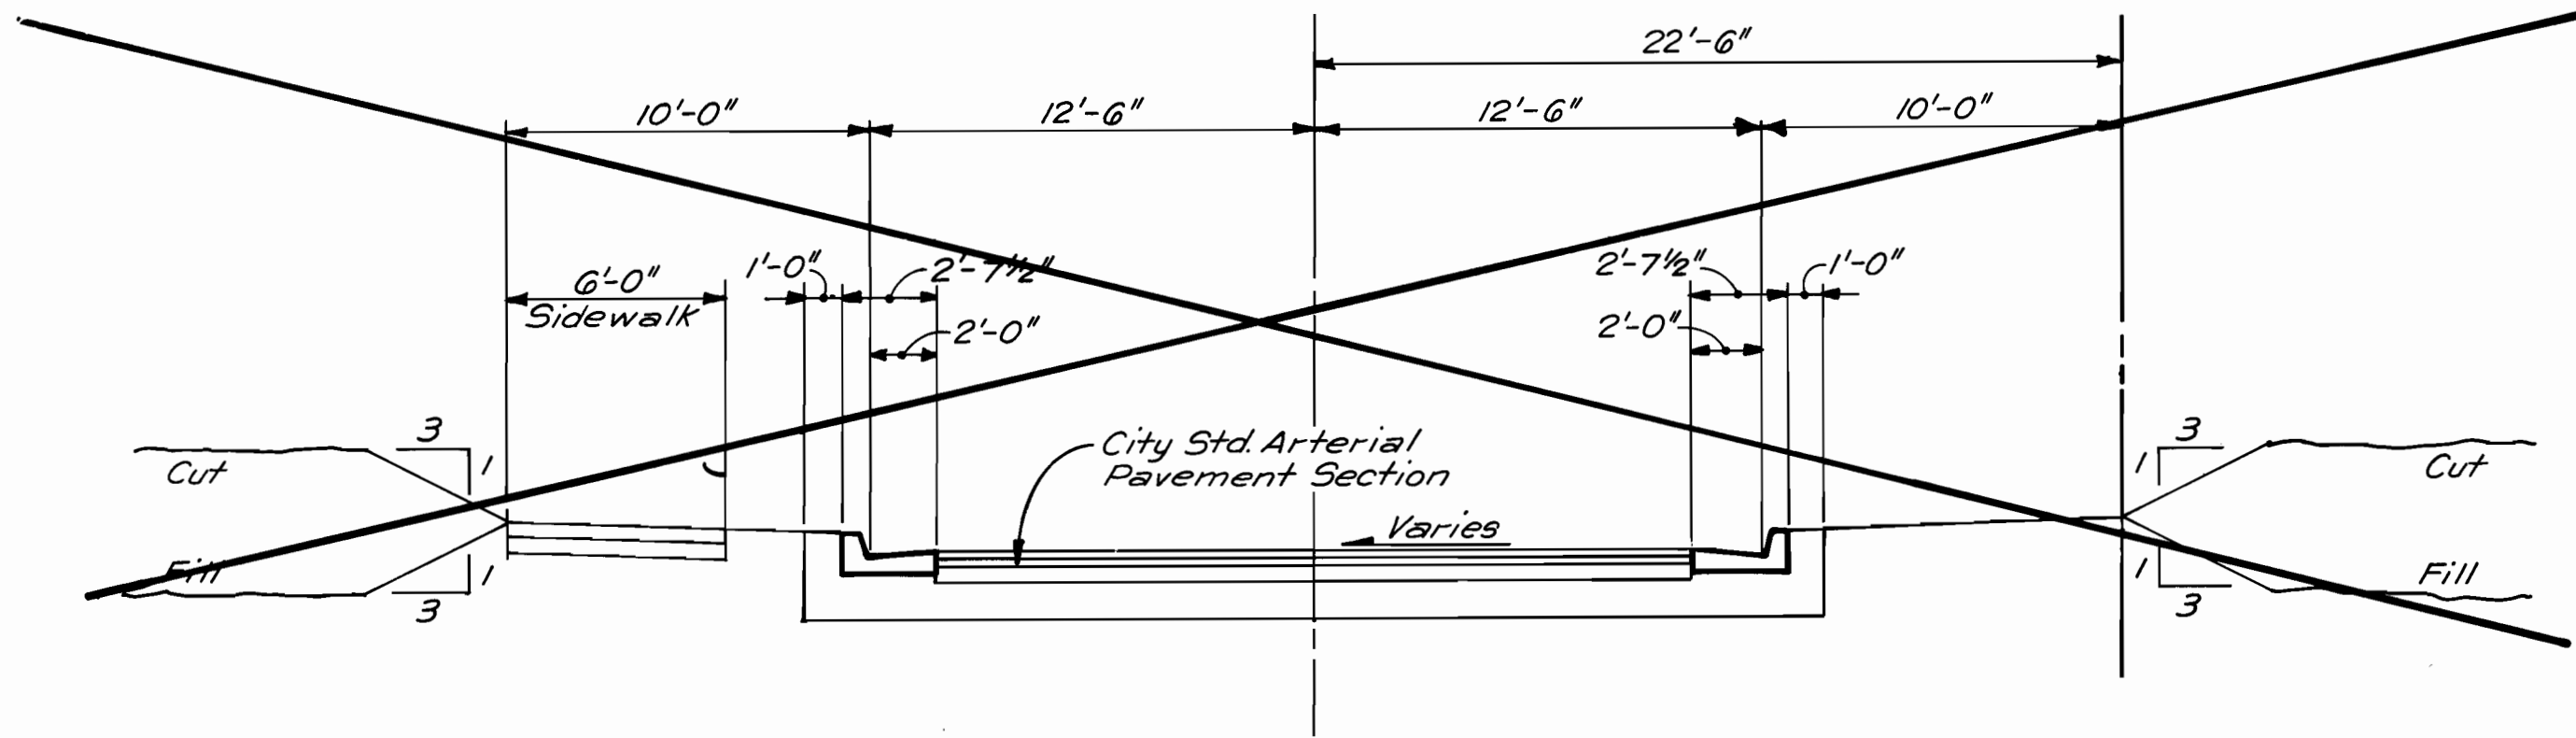

NOT IN CONTRACT
CROSS-STREET
SCALE: 1"=5'

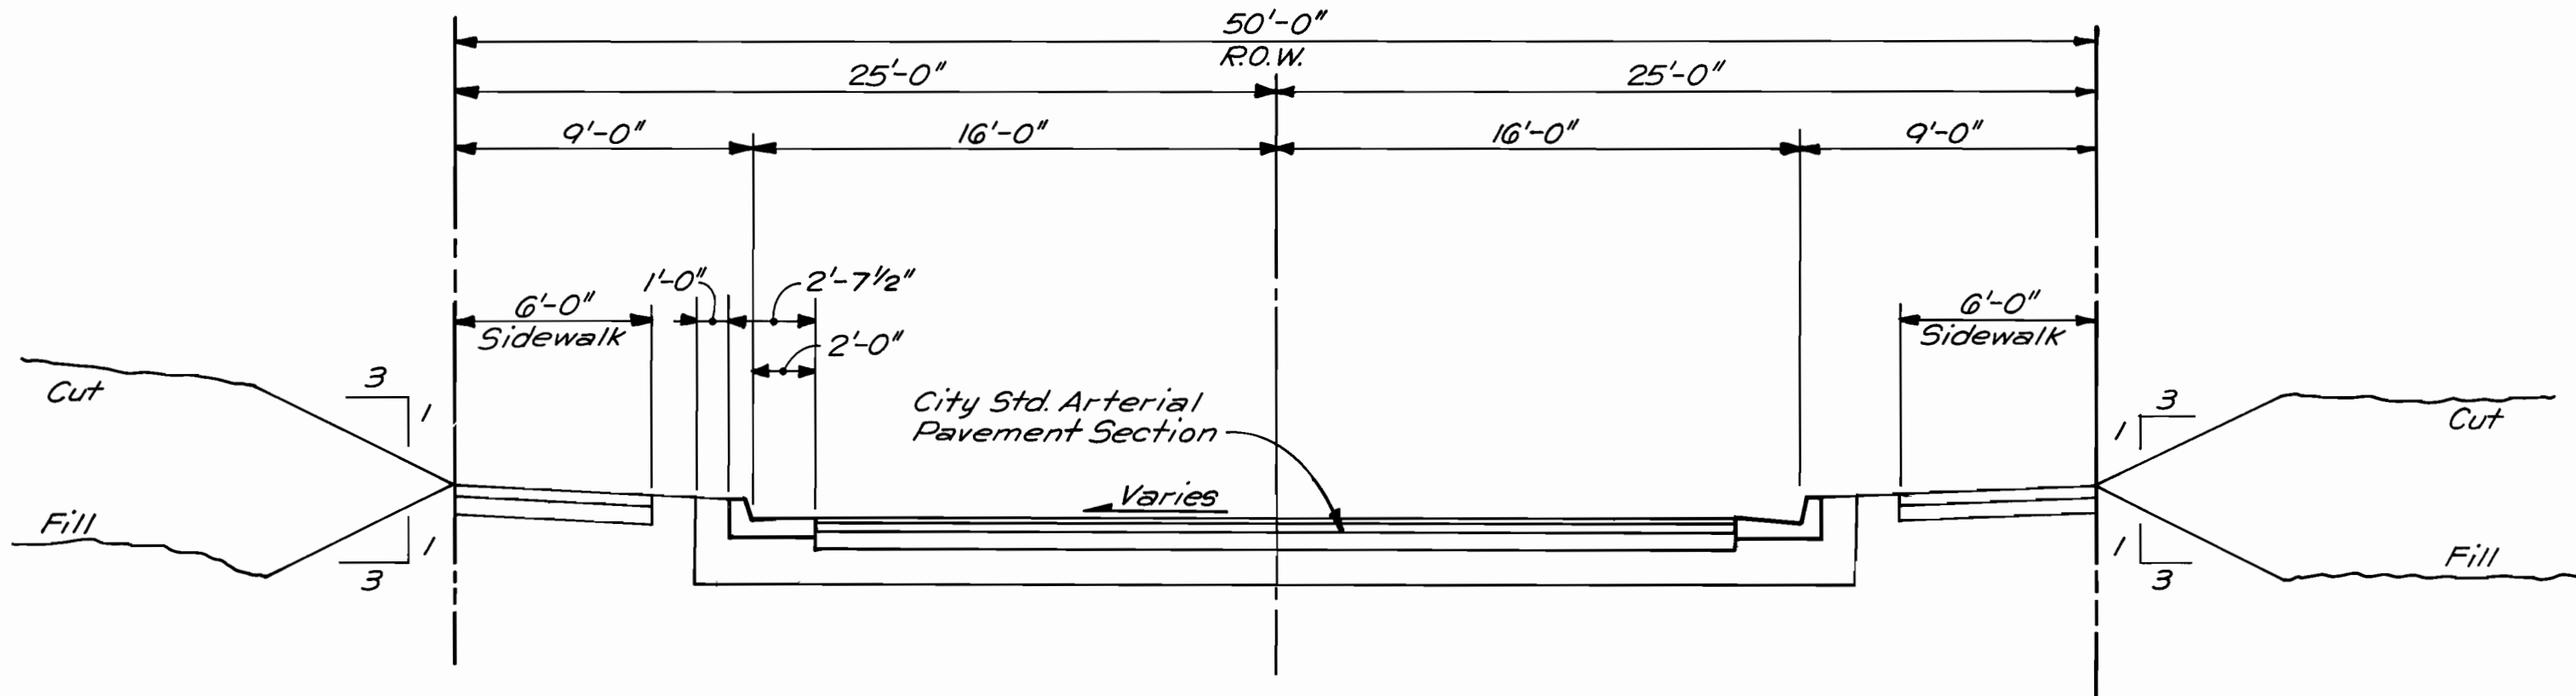

JOYCE DR. NE. & LEONA ST. NE.
SCALE: 1"=5'

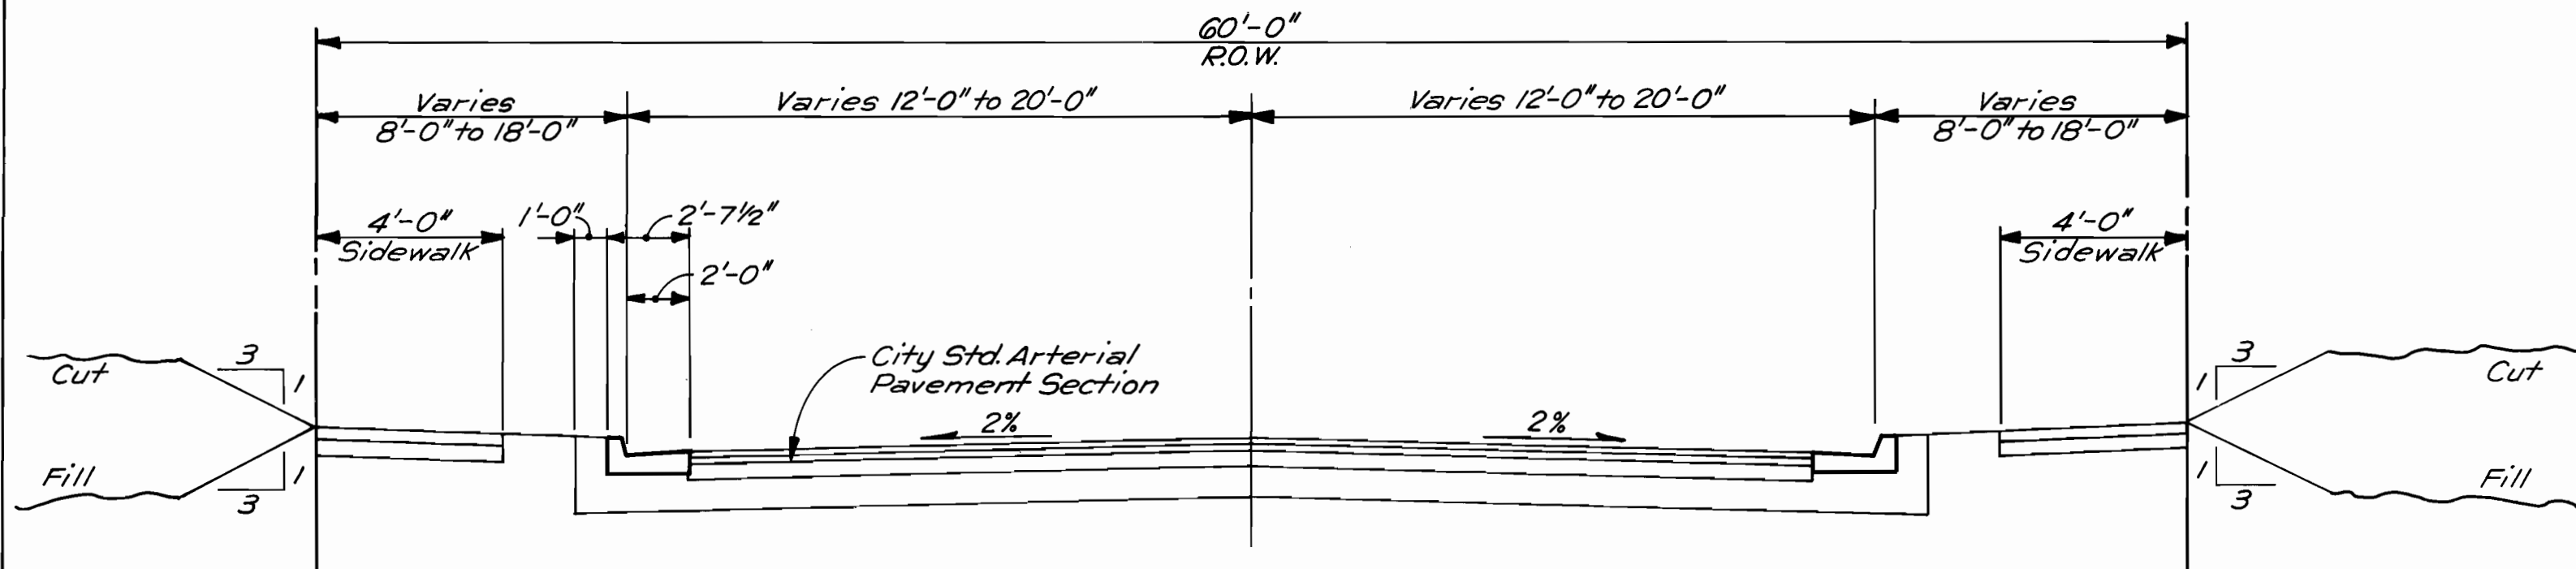

SAN ANTONIO PLACE NE.
SCALE: 1"=5'

AS BUILT INFORMATION			BENCH MARKS		SURVEY INFORMATION		ENGINEER'S SEAL		REVISIONS		DESIGNED BY		DRAWN BY		CHECKED BY	
CONTRACTOR: Moore & Conner			ACS STA. "12-E18 1978"		NO.		STATE OF NEW MEXICO		NO.		DATE		DATE		DATE	
WORK: ELEVATION 5337.039			ACS BRASS TABLET SET ON CONCRETE POST FLUSH W/GROUND		BY		REGISTERED PROFESSIONAL ENGINEER		REMARKS		DATE		DATE		DATE	
DATE: 10/87			LOCATED 41 FEET SOUTH OF THE CENTERLINE OF SAN ANTONIO DRIVE AND 34 FEET WEST OF THE CENTERLINE OF LOUISIANA BOULEVARD				ANDREWS, ASBURY & ROBERT, INC.		DESIGN		DATE		DATE		DATE	
FIELD ACCEPTANCE BY CITY							CONSULTING ENGINEERS									
DRAWINGS							NEW MEXICO									
CORRECTED BY: J.A.R.							75-158									
DATE: 10/87							ALBUQUERQUE									
MICRO-FILM INFORMATION																
RECORDED BY																
DATE																
NO.																

John A. Andrews
RECORD DRAWING

26 21512787


CITY OF ALBUQUERQUE
MUNICIPAL DEVELOPMENT DEPARTMENT
ENGINEERING DIVISION

PINO ARROYO CORRIDOR IMPROVEMENTS

TYPICAL STREET SECTIONS


APPROVALS	ENGINEER	DATE	APPROVALS	ENGINEER	DATE
City Engineer	<i>John A. Andrews</i>	1/2/88	Liquid Waste	<i>N.A. SR</i>	1-31-86
A.C.E. Design	<i>John A. Andrews</i>	1/31/86	Traffic	<i>N.A. SR</i>	1-31-86
Hydrology	<i>K.K. Royal</i>	1-31-86	Water	<i>N.A. SR</i>	1-31-86

DRAWING NO.	2151	MAP NO.	E-18, E-19	SHEET	27	OF	34
-------------	------	---------	------------	-------	----	----	----

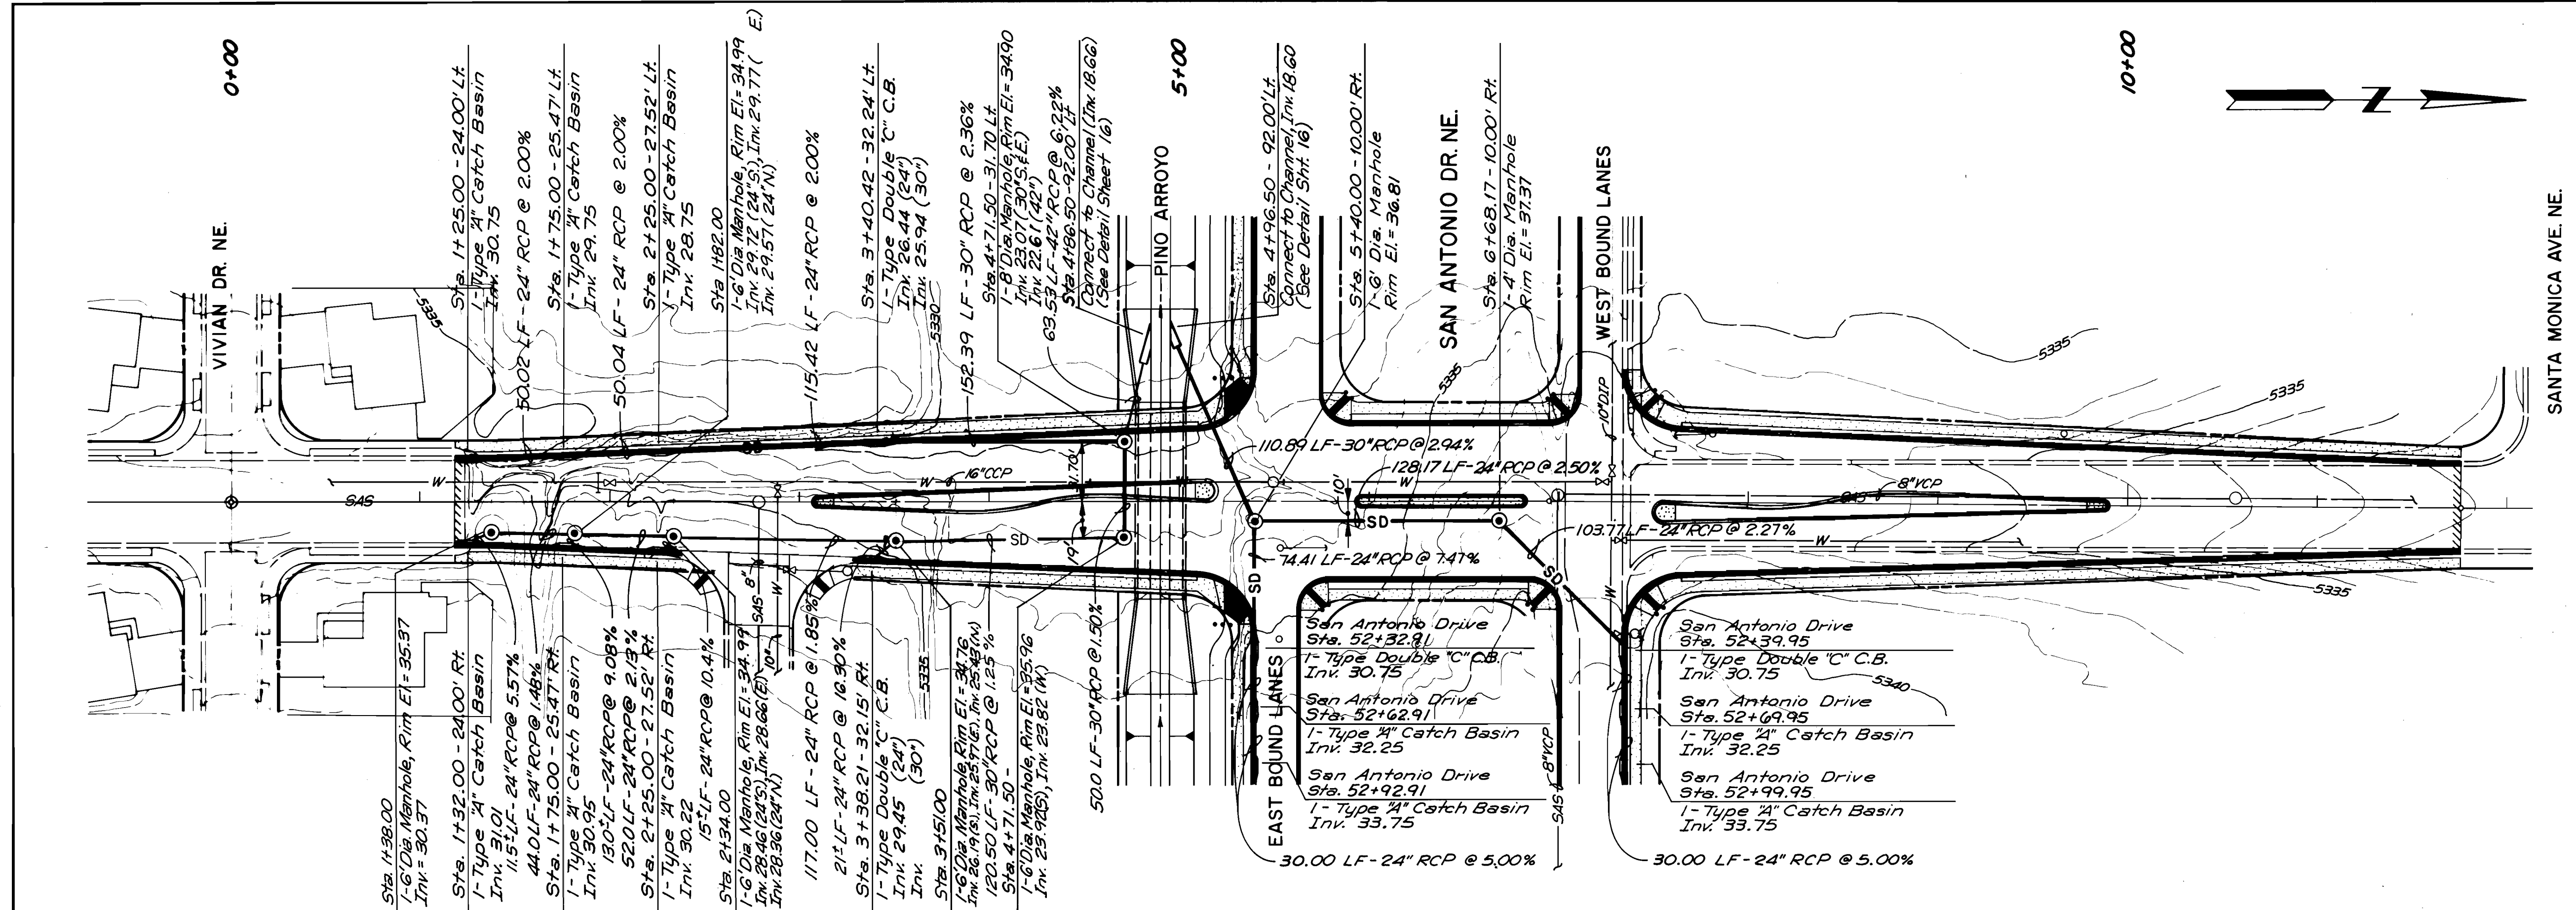

PLAN
SCALE: 1" = 50'

LOUISIANA BOULEVARD NE.

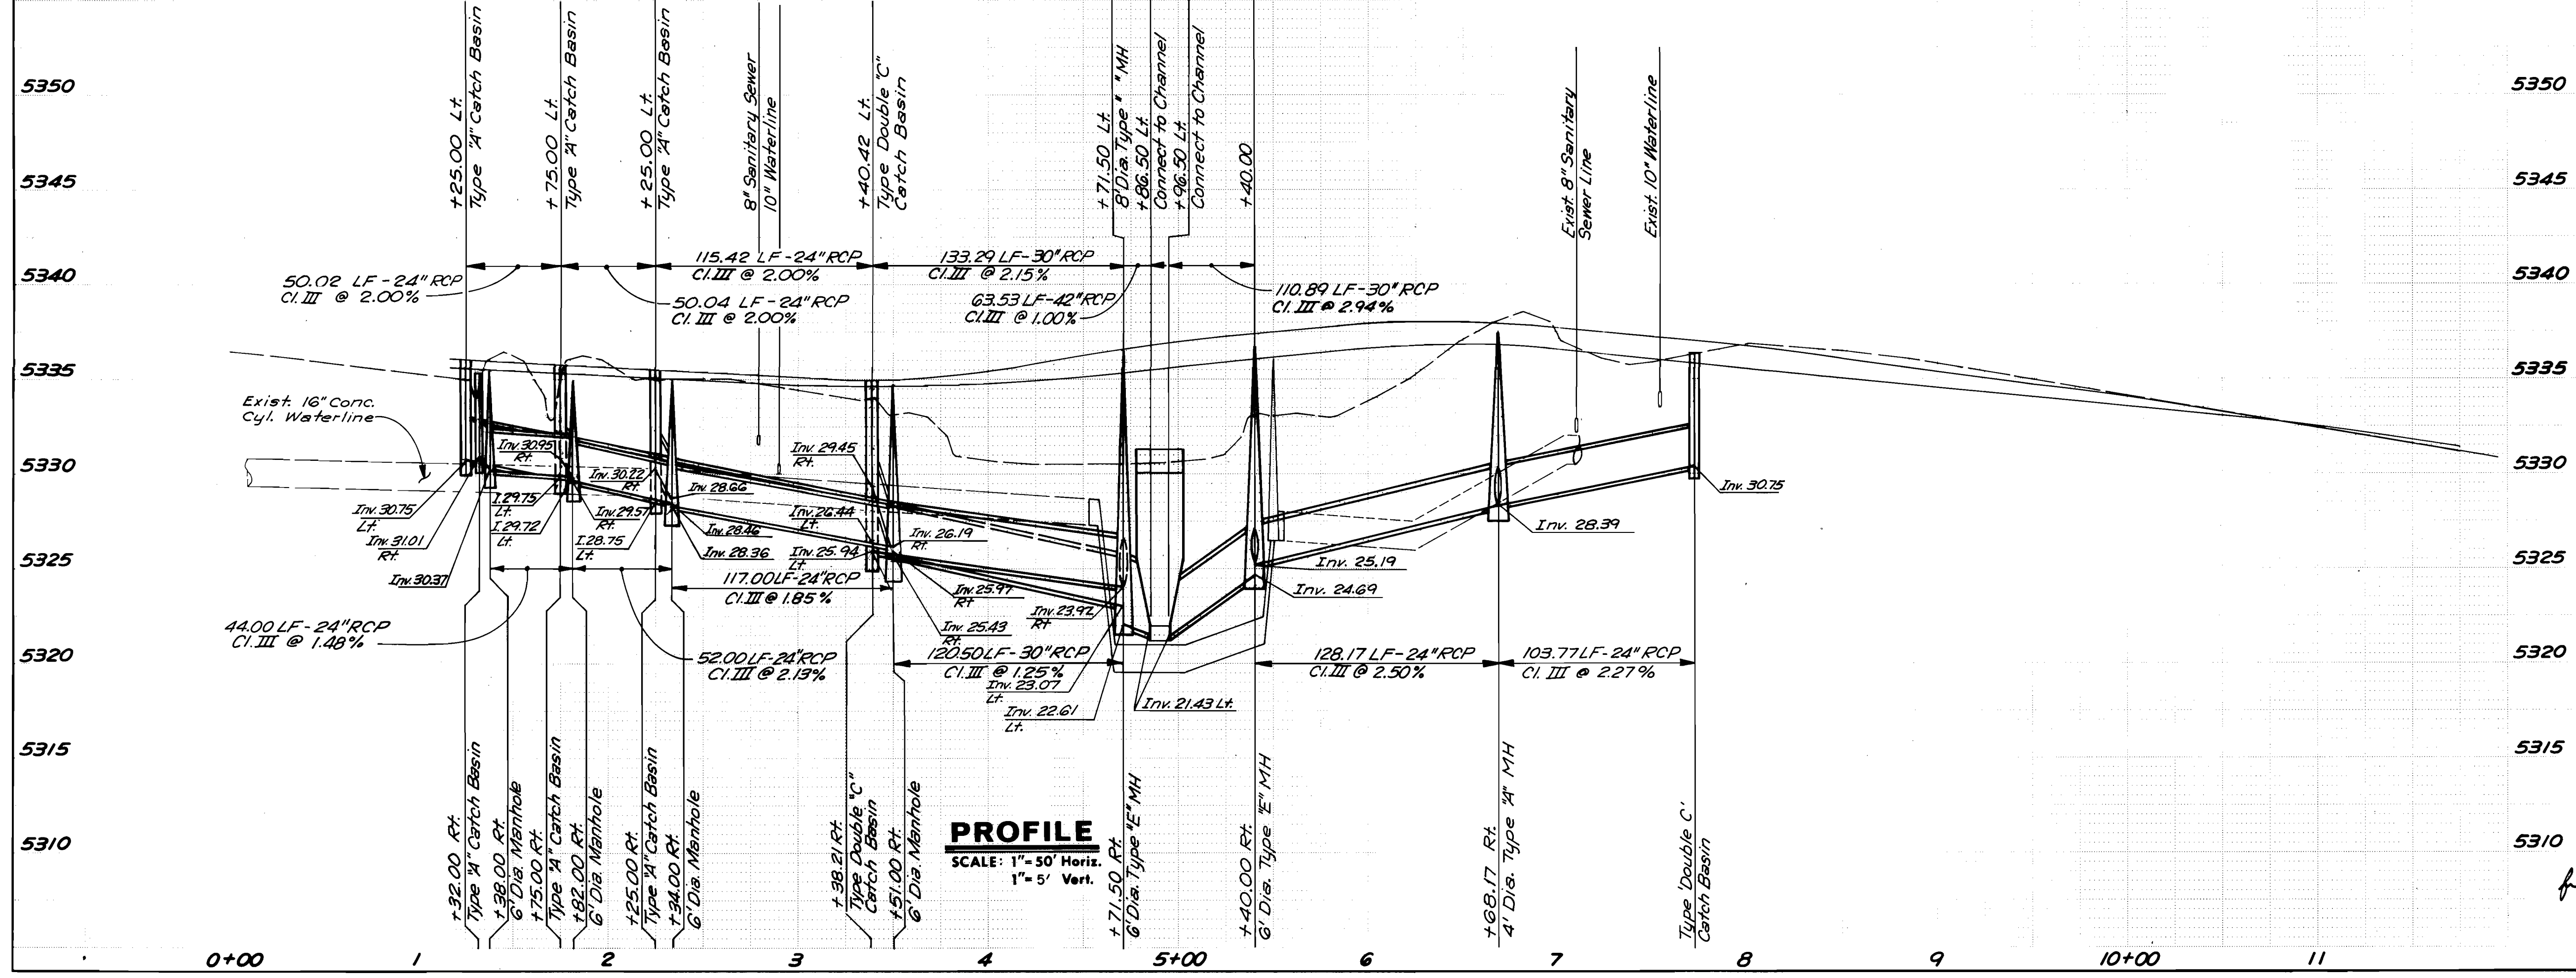


PROFILE
SCALE: 1" = 50' Horiz.
1" = 5' Vert.

John A. Anderson
RECORD DRAWING
26 2151 2887

CITY OF ALBUQUERQUE MUNICIPAL DEVELOPMENT DEPARTMENT ENGINEERING DIVISION					
PINO ARROYO CORRIDOR IMPROVEMENTS LOUISIANA BOULEVARD NE. STORM DRAIN PLAN & PROFILE					
APPROVALS	ENGINEER	DATE	APPROVALS	ENGINEER	DATE
City Engineer	<i>Metrix</i>	11/20/86	Liquid Waste	<i>B. K. Galt</i>	1-31-86
A.C.E. Design	<i>Metrix</i>	11/2/86	Traffic	<i>Da. Parks</i>	1-31-86
A.C.E. Hydrology	<i>K. K. Ayala</i>	1-31-86	Water	<i>B. K. Galt</i>	1-31-86

DRAWING NO.	2151	MAP NO.	E-18, E-19	SHEET OF	28 34
-------------	------	---------	------------	----------	-------

--	--	
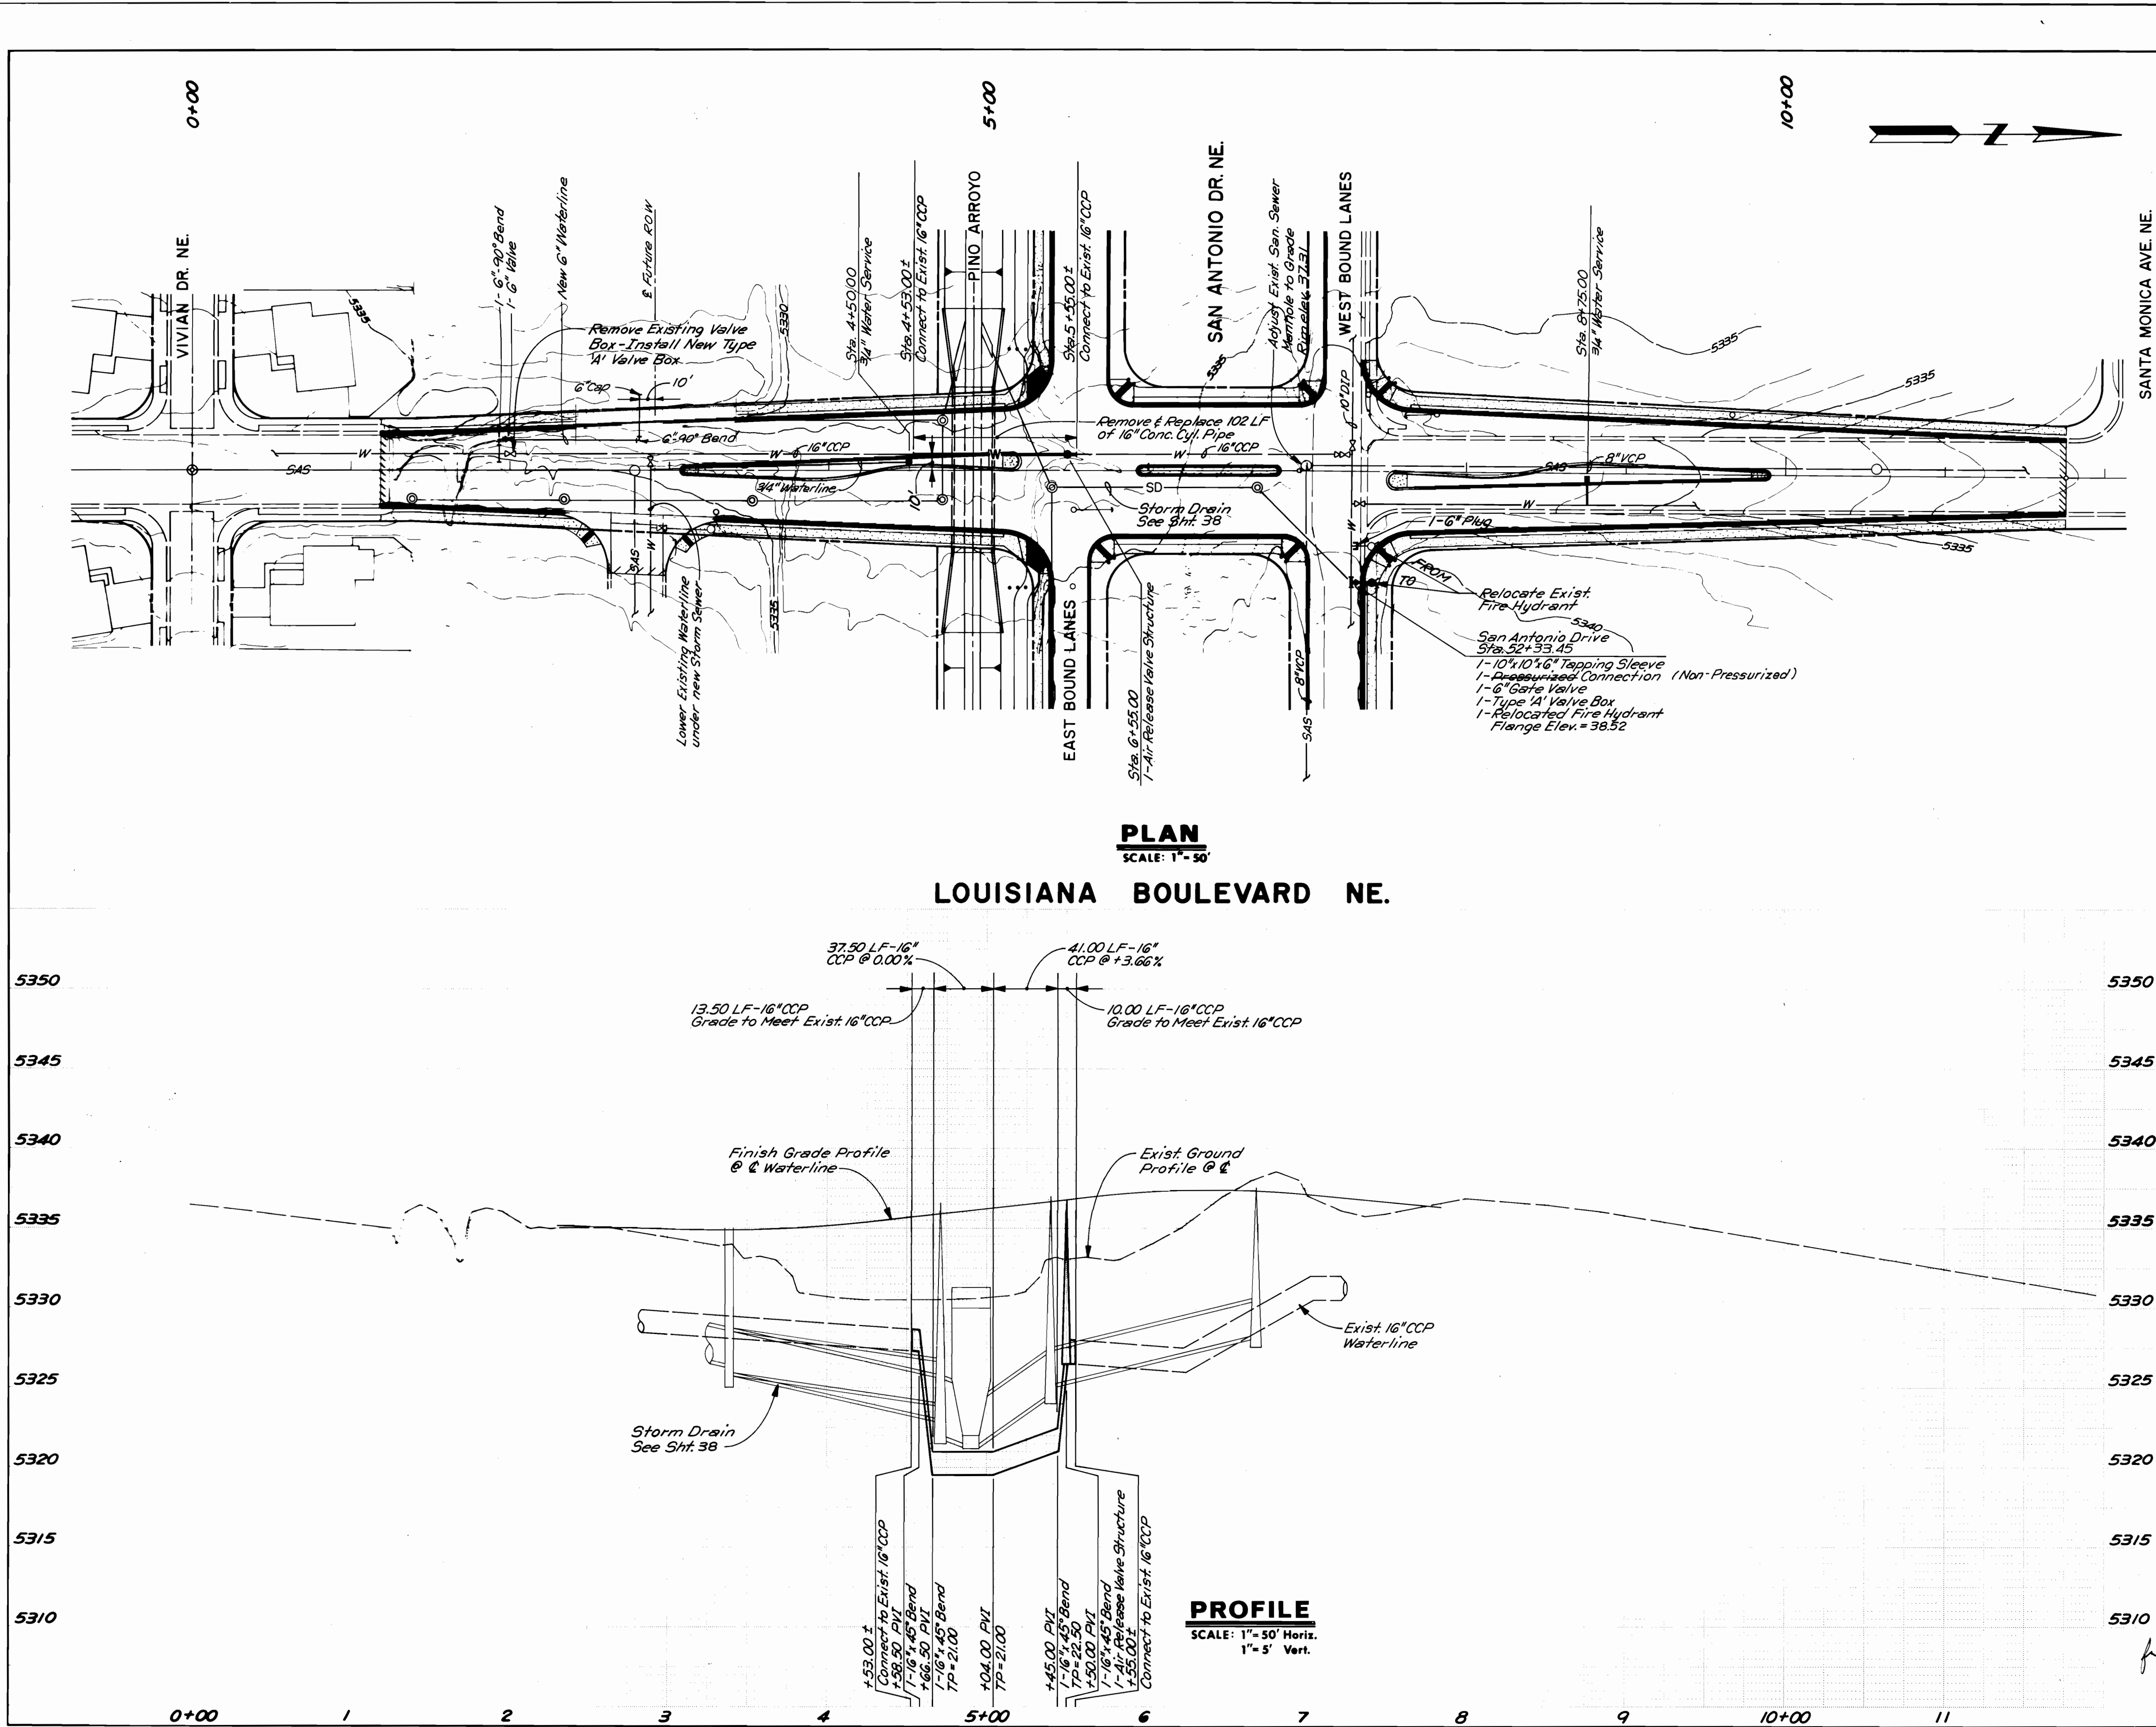

NOTES

- CONTACT THE CITY'S WATER SYSTEMS DIVISION AT 823-4052 TO COORDINATE SHUT DOWN OF THE EXISTING WATER SYSTEM.
- ALL CONCRETE CYLINDER PIPE JOINTS SHALL BE WELDED.

AS BUILT INFORMATION		BENCH MARKS		SURVEY INFORMATION		ENGINEER'S SEAL	
CONTRACTOR	DATE	ACCS STA	DATE	NO.	BY	NO.	BY
Moore & Conner <td>10/87<td>ELEVATION 5337.039<td>12-EIB 1978<td></td><td></td><td></td><td></td></td></td></td>	10/87 <td>ELEVATION 5337.039<td>12-EIB 1978<td></td><td></td><td></td><td></td></td></td>	ELEVATION 5337.039 <td>12-EIB 1978<td></td><td></td><td></td><td></td></td>	12-EIB 1978 <td></td> <td></td> <td></td> <td></td>				
WORK BY A.A.R. <td>10/87<td>ACCS BRASS TABLET SET ON CONCRETE POST FLUSH W/GROUND<td>DATE</td><td></td><td></td><td></td><td></td></td></td>	10/87 <td>ACCS BRASS TABLET SET ON CONCRETE POST FLUSH W/GROUND<td>DATE</td><td></td><td></td><td></td><td></td></td>	ACCS BRASS TABLET SET ON CONCRETE POST FLUSH W/GROUND <td>DATE</td> <td></td> <td></td> <td></td> <td></td>	DATE				
INSPECTED BY CITY <td>DATE</td> <td>LOCATED 41 FEET SOUTH OF THE CENTERLINE OF SAN ANTONIO DRIVE AND 34 FEET WEST OF THE CENTERLINE OF LOUISIANA BOULEVARD<td></td><td></td><td></td><td></td><td></td></td>	DATE	LOCATED 41 FEET SOUTH OF THE CENTERLINE OF SAN ANTONIO DRIVE AND 34 FEET WEST OF THE CENTERLINE OF LOUISIANA BOULEVARD <td></td> <td></td> <td></td> <td></td> <td></td>					
APPROVED BY CITY <td>DATE</td> <td></td> <td></td> <td></td> <td></td> <td></td> <td></td>	DATE						
REVISIONS <td>DATE<td></td><td></td><td></td><td></td><td></td><td></td></td>	DATE <td></td> <td></td> <td></td> <td></td> <td></td> <td></td>						
DESIGNED BY <td>DATE<td></td><td></td><td></td><td></td><td></td><td></td></td>	DATE <td></td> <td></td> <td></td> <td></td> <td></td> <td></td>						
DRAWN BY <td>DATE<td></td><td></td><td></td><td></td><td></td><td></td></td>	DATE <td></td> <td></td> <td></td> <td></td> <td></td> <td></td>						
CHECKED BY <td>DATE<td></td><td></td><td></td><td></td><td></td><td></td></td>	DATE <td></td> <td></td> <td></td> <td></td> <td></td> <td></td>						

RECORD DRAWING



26 21513087

CITY OF ALBUQUERQUE
MUNICIPAL DEVELOPMENT DEPARTMENT
ENGINEERING DIVISION

PINO ARROYO CORRIDOR IMPROVEMENTS
LOUISIANA BOULEVARD NE.
WATERLINE RELOCATION PLAN & PROFILE

APPROVALS	ENGINEER	DATE	APPROVALS	ENGINEER	DATE
City Engineer	Matthew	11/20/86	Liquid Waste	B. Gal	1-31-86
A.C.E. Design	John A. R.	1/31/86	Traffic	N/A	1-31-86
A.C.E. Hydrology	K. A. W. J. A. R.	1-31-86	Water	B. Gal	1-31-86

DRAWING NO. 2151 MAP NO. E-18, E-19 SHEET 30 OF 34

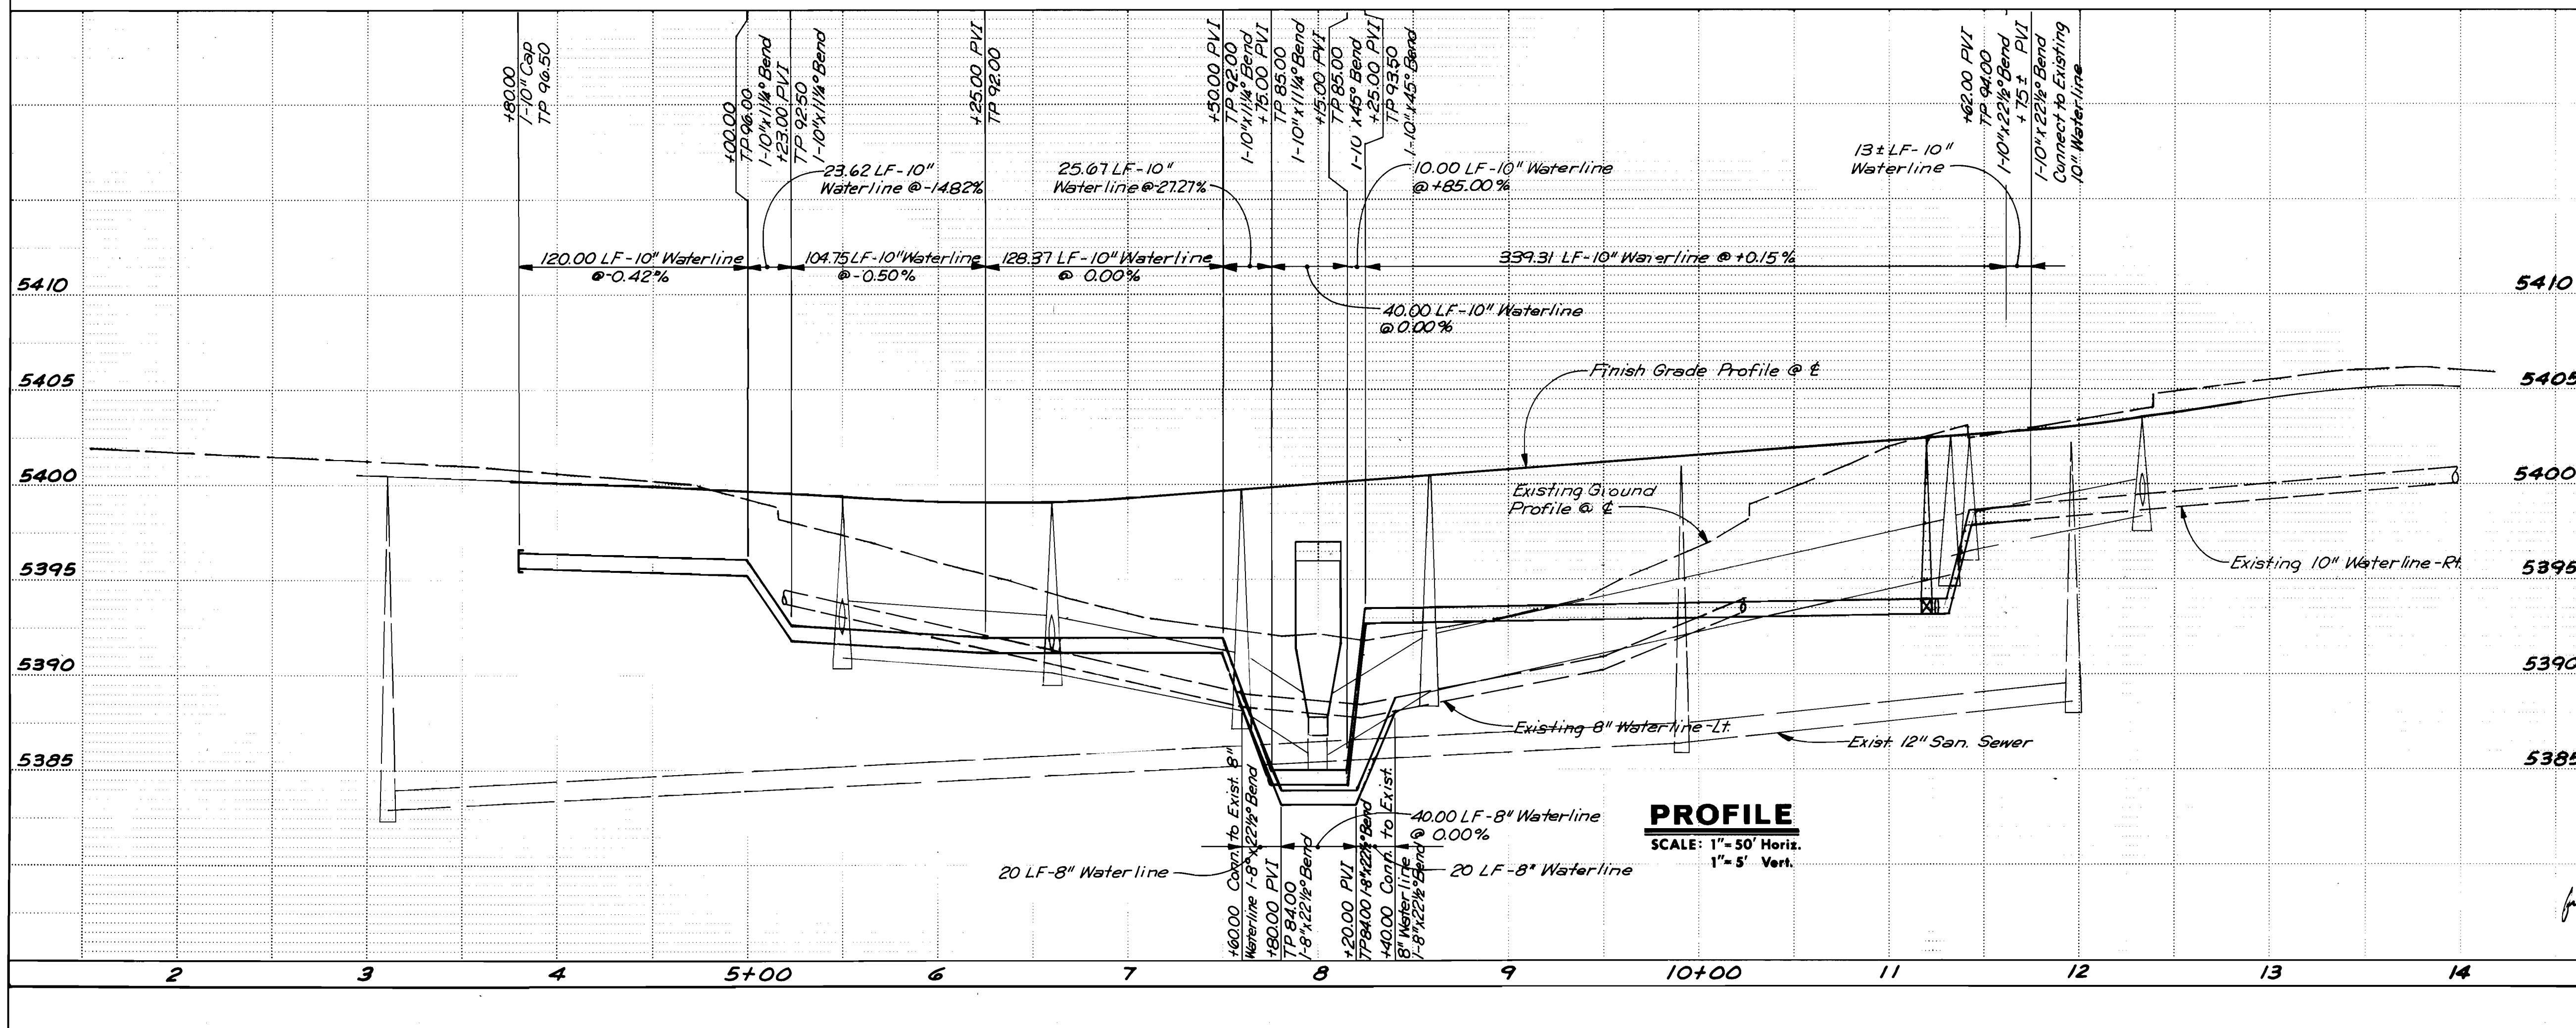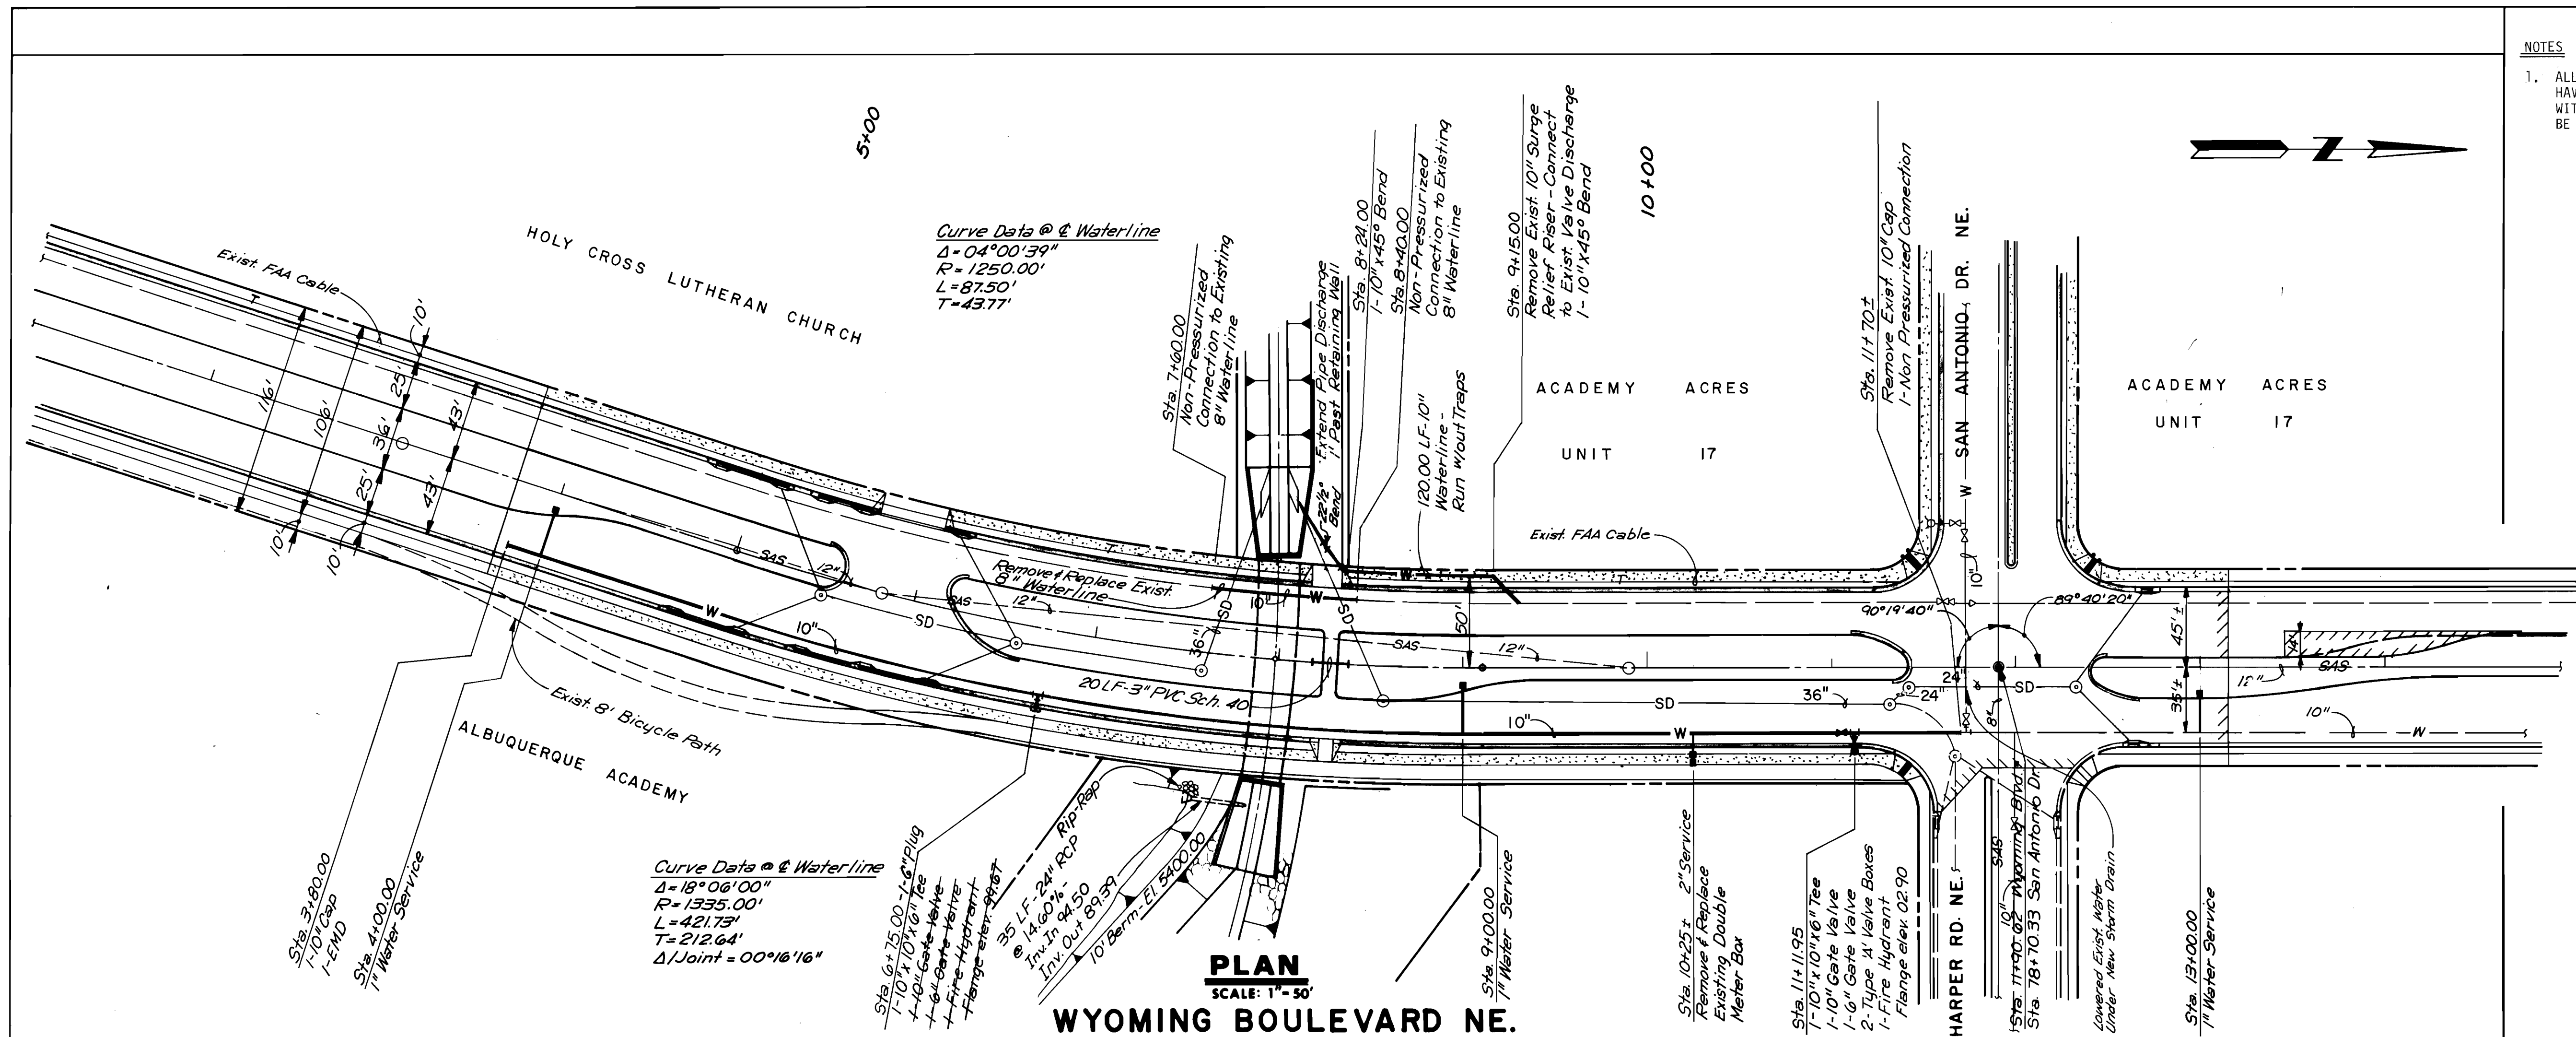

NOTES

- ALL VERTICAL BENDS IN WATERLINE SHALL HAVE RESTRAINED JOINTS. ALL JOINTS WITHIN 30' OF VERTICAL BENDS SHALL ALSO BE RESTRAINED.

ENGINEER'S SEAL

AS BUILT INFORMATION

NO.	DATE	BY	FIELD NOTES	BENCH MARKS
1	12-18-1978	ACS STA	ELEVATION 5337.039	
2	12-18-1978	ACS BRASS TABLET SET ON CONCRETE POST FLUSH W/GROUND		
3	12-18-1978	LOCATED 41 FEET SOUTH OF THE CENTERLINE OF SAN ANTONIO DRIVE AND 34 FEET WEST OF THE CENTERLINE OF LOUISIANA BOULEVARD		

REVISIONS

NO.	DATE	REVISIONS
1	12-18-1978	DESIGN

DESIGNED BY **DRAWN BY** **CHECKED BY**


DATE **DATE** **DATE**

CITY OF ALBUQUERQUE
 MUNICIPAL DEVELOPMENT DEPARTMENT
 ENGINEERING DIVISION

PINO ARROYO CORRIDOR IMPROVEMENTS
 WYOMING BOULEVARD NE.
 WATERLINE PLAN & PROFILE

APPROVALS	ENGINEER	DATE	APPROVALS	ENGINEER	DATE
City Engineer	Andrew	1/20/86	Liquid Waste	B. Rosh	1-31-86
A-C-E-Design	Andrew	1/31/86	Traffic	N/A	1-31-86
A-C-E-Hydrology	K. K. Goyal	1-31-86	Water	B. Rosh	1-31-86

DRAWING NO. 2151 **MAP NO.** E-18,E-19 **SHEET** 31 **OF** 34

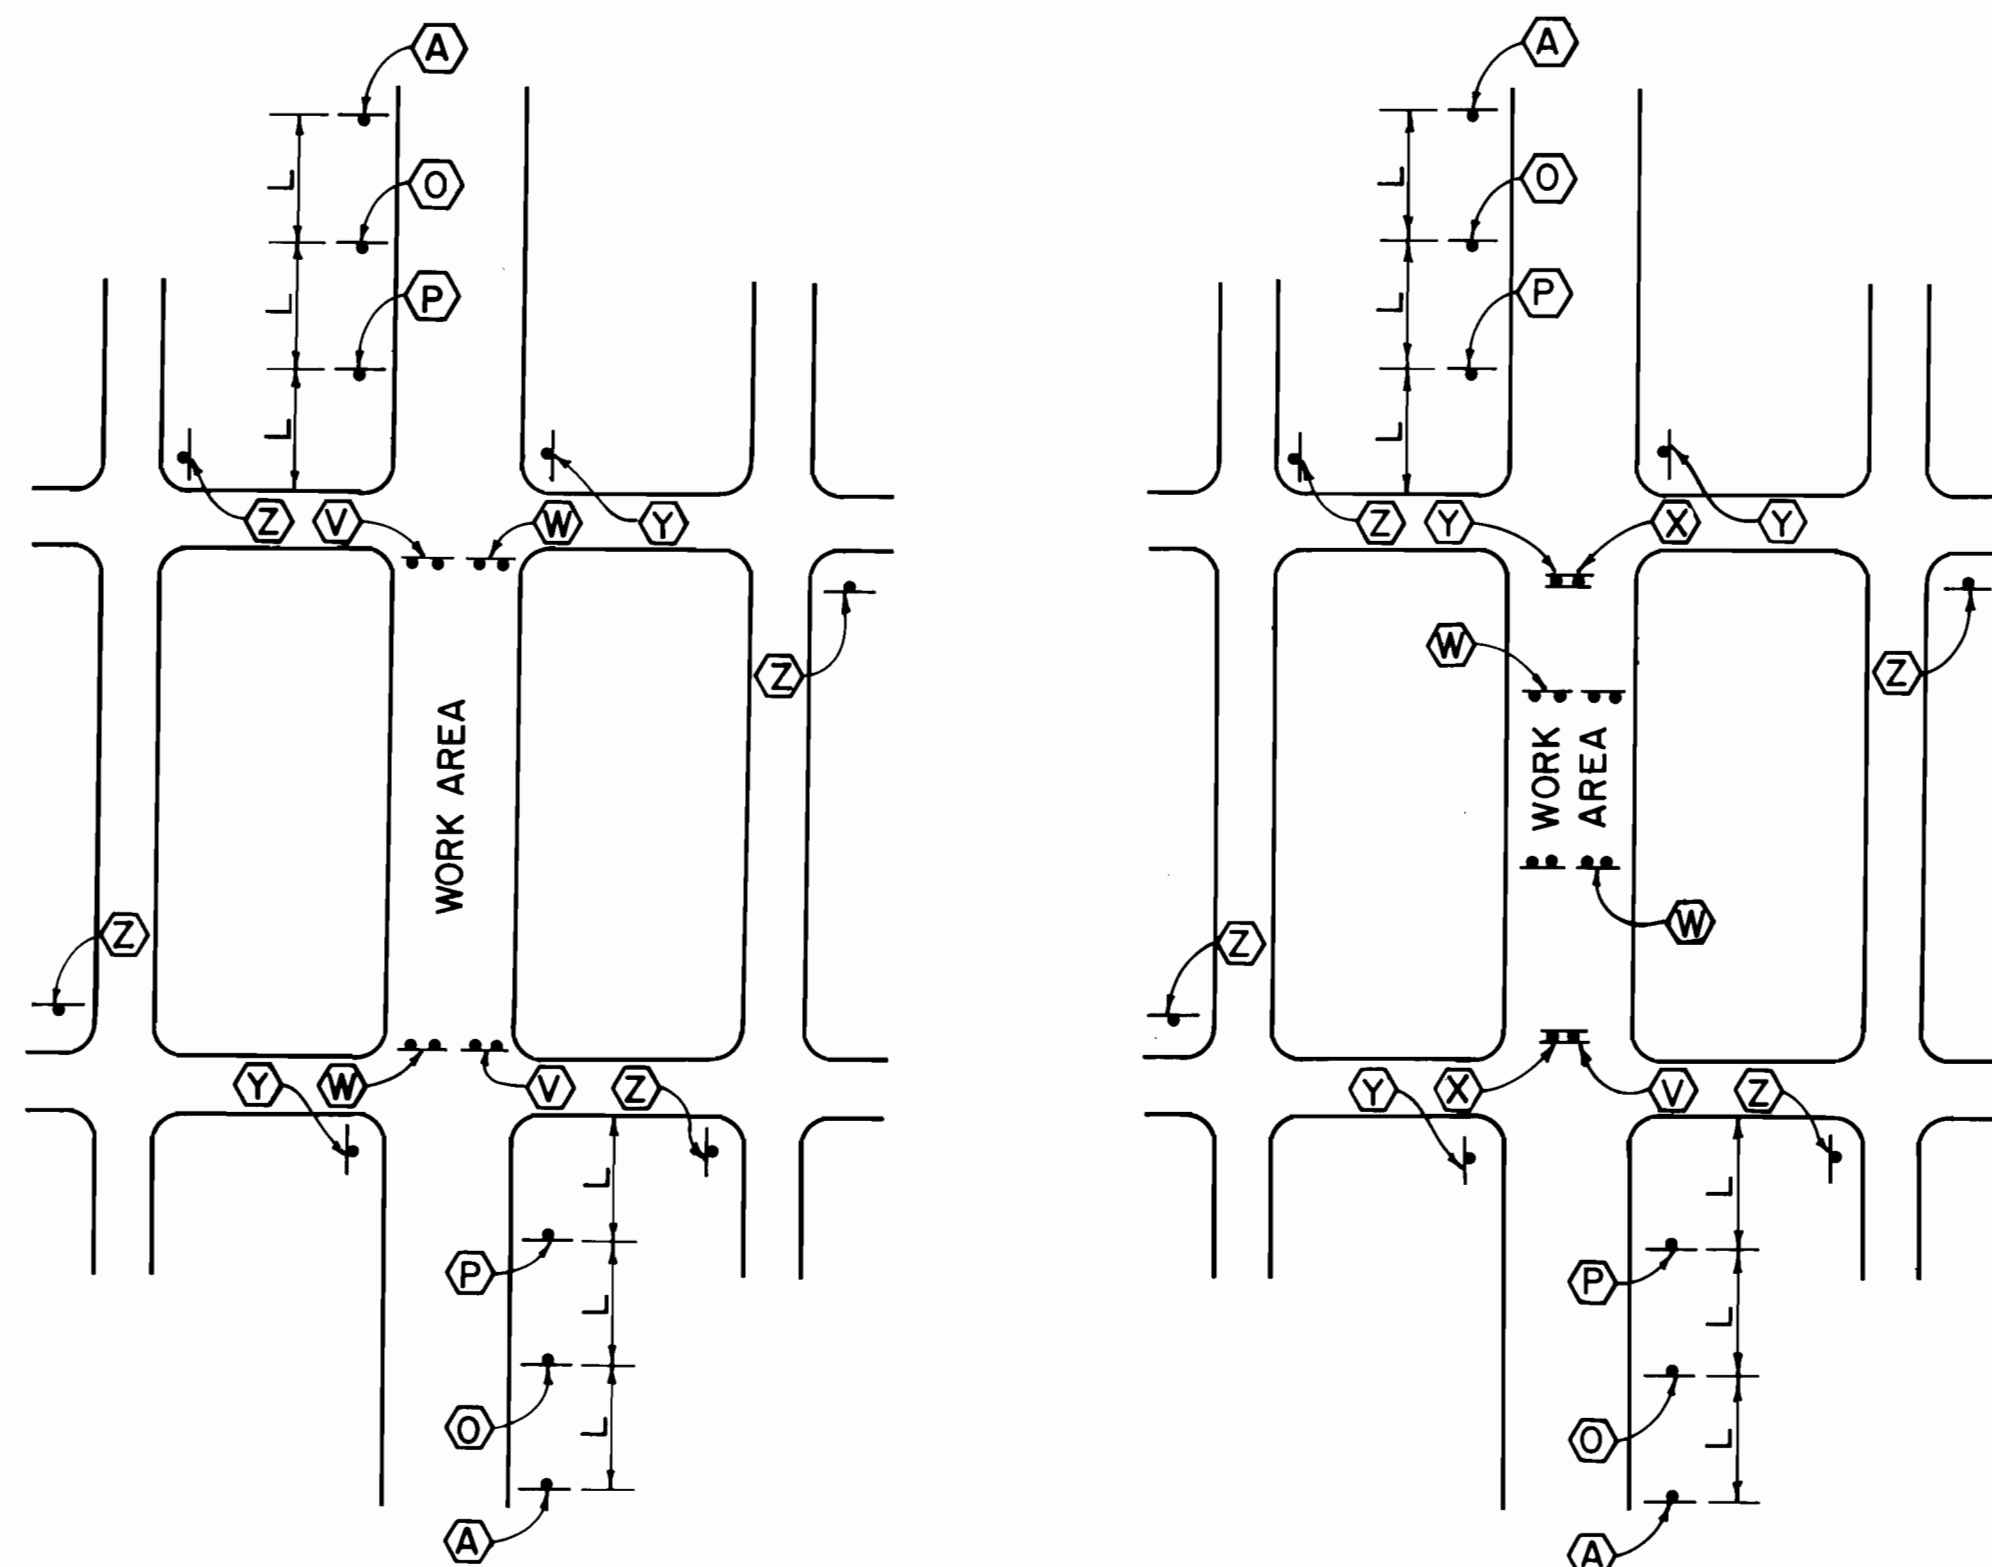

MID BLOCK
MINOR STREET ONLY

NO SCALE

LEGEND

- | | |
|---------|---|
| • | BARRICADE - BARREL |
| † | SIGN |
| M | VERTICAL PANEL |
| ‡ | BARRICADE - TYPE III |
| L | DISTANCE BETWEEN ADVANCE SIGNS - A
DISTANCE MEASURED IN FEET EQUAL TO
TEN TIMES THE SPEED LIMIT. |
| S | SPACING BETWEEN BARRICADES - MAXIMUM
SPACING TO BE A VALUE MEASURED IN FEET
EQUAL TO THE SPEED LIMIT. |
| TANGENT | TANGENT LENGTH EQUALS TAPER LENGTH
AS SHOWN IN SCHEDULE. |

NOTES

1. PRIOR TO THE START OF CONSTRUCTION, THE CONTRACTOR SHALL SUBMIT TO THE TRAFFIC ENGINEER A CONSTRUCTION SCHEDULE WHICH INCLUDES AN OUTLINE OF HOW TWO WAY TRAFFIC IS TO BE MAINTAINED ON THE REQUIRED ROADS.
2. THE CONTRACTOR MUST OBTAIN A BARRICADING PERMIT FROM THE TRAFFIC ENGINEERING OFFICE TWO DAYS PRIOR TO EACH PHASE OF CONSTRUCTION OR THE SHIFTING OF TRAFFIC
3. CONTRACTOR MUST COMPLY WITH SECTION 19 OF THE CITY OF ALBUQUERQUE'S INTERIM STANDARD SPECIFICATIONS FOR PUBLIC WORKS CONSTRUCTION.
4. TWO WAY TRAFFIC MUST BE MAINTAINED ON SAN ANTONIO DR., SAN PEDRO DR. NORTH OF SAN ANTONIO DR., LOUISIANA BLVD. NORTH OF SAN ANTONIO DR., WYOMING BLVD., AND HARPER BLVD. AT ALL TIMES.
5. WHILE MAINTAINING TWO WAY TRAFFIC ON THE EXISTING LANES OF SAN ANTONIO DR., CONSTRUCT THE PINO ARROYO CHANNEL AND THE SOUTH HALF OF SAN ANTONIO DR. TYPE III BARRICADES ARE TO BE PLACED AT EVERY ACCESS POINT TO PREVENT TRAFFIC FROM USING THE UNCOMPLETED ROADWAY.
6. WYOMING BLVD. TRAFFIC MAY NOT BE DIVERTED UNTIL SAN PEDRO DR. IS OPEN TO TWO WAY TRAFFIC BETWEEN MCKINNEY DR. AND SANTA MONICA AVE. WORK ON WYOMING BLVD. IS TO BE BROKEN UP INTO THREE PHASES. IN PHASE 1, SOUTH BOUND WYOMING BLVD. IS TO BE DIVERTED ONTO THE NORTH BOUND LANES OF WYOMING BLVD. AT OLD SAN ANTONIO DR. INTERSECTION AND RETURNED AT STA. 3+75.00. FROM STA. 3+75.00 TO STA. 2+25.00 THE CONTRACTOR SHALL REMOVE THE EXISTING ASPHALT MEDIAN AND PLACE A TEMPORARY ASPHALT PATCH IN THE MEDIAN AREA IN ORDER TO PROVIDE A CROSS OVER POINT FOR WYOMING BLVD. TRAFFIC. THE CONTRACTOR SHALL REMOVE THE ASPHALT PATCH AND REPLACE THE ASPHALT CURBING AT THE END OF THE PROJECT. PHASE 2 - USING THE SAME TWO MEDIAN CROSS OVER POINTS AS IN PHASE ONE, SHIFT NORTH BOUND TRAFFIC ONTO THE SOUTH BOUND LANES OF WYOMING BLVD. DURING THIS PHASE THE SOUTH HALF OF HARPER ROAD MAY BE CLOSED WITH EAST BOUND TRAFFIC SPLIT ONTO THE WEST BOUND LANES USING A TYPICAL SPLIT. PHASE 3 - WYOMING BLVD. TRAFFIC IS TO REMAIN ON THE EAST HALF OF THE ROAD WHILE HARPER ROAD TRAFFIC IS DIVERTED ONTO THE SOUTH BOUND LANES OF WYOMING BLVD. DURING THIS PHASE THE SOUTH HALF OF HARPER ROAD MAY BE CLOSED WITH EAST BOUND LANES USING A TYPICAL SPLIT.

7. ONCE THE SOUTH HALF OF SAN ANTONIO DR. HAS BEEN BUILT IN ITS ENTIRETY, EXCLUDING THE FRICTION COURSE OF ASPHALT, THE CONTRACTOR MAY THEN SHIFT SAN ANTONIO DR. TRAFFIC TO THE SOUTH HALF OF THE ROADWAY USING A TYPICAL TRAFFIC SPLIT. THE TRAFFIC MAY BE SPLIT ONLY IF THE NEW SECTION OF SAN ANTONIO DR. IS OPEN ENTIRELY BETWEEN WYOMING BLVD. AND SAN ANTONIO PL. WEST BOUND TRAFFIC IS TO BE SHIFTED TO THE SOUTH HALF OF SAN ANTONIO DR. AT SAN ANTONIO PL. AND RETURNED TO THE PROPER SIDE OF THE MEDIAN AT THE MEDIAN OPENING AT STA 3+22.2. SAN ANTONIO DR. TRAFFIC MUST BE ON THE PROPER SIDE OF THE MEDIAN AT THE INTERSECTION WITH THE EAST FRONTAGE ROAD. IN LIEU OF VERTICAL PANELS REGULATING THE LENGTH OF THE SPLIT THE CONTRACTOR MAY PROVIDE A DOUBLE YELLOW STRIPE PROVIDED IT IS PROPERLY MAINTAINED.

John A. Andrew
RECORD DRAWING


2	6		2	1	5	1	3	2	8	7
---	---	--	---	---	---	---	---	---	---	---

CITY OF ALBUQUERQUE
MUNICIPAL DEVELOPMENT DEPARTMENT
ENGINEERING DIVISION

TRAFFIC CONTROL DETAILS

APPROVALS	ENGINEER	DATE	APPROVALS	ENGINEER	DATE
City Engineer	<i>[Signature]</i>	11/24/84	Liquid Waste	N/A BR	1-21-86
A C E -Design	<i>[Signature]</i>	11/31/84	Traffic	D.A. Pando	1-31-86
A C E -Hydrology	E. K. Gogel	NA 1-31-86	Water	N/A BR	1-21-86

DRAWING NO.	2151	MAP NO.	E-18, F 19	SHEET OF	32 34
-------------	------	---------	------------	----------	-------

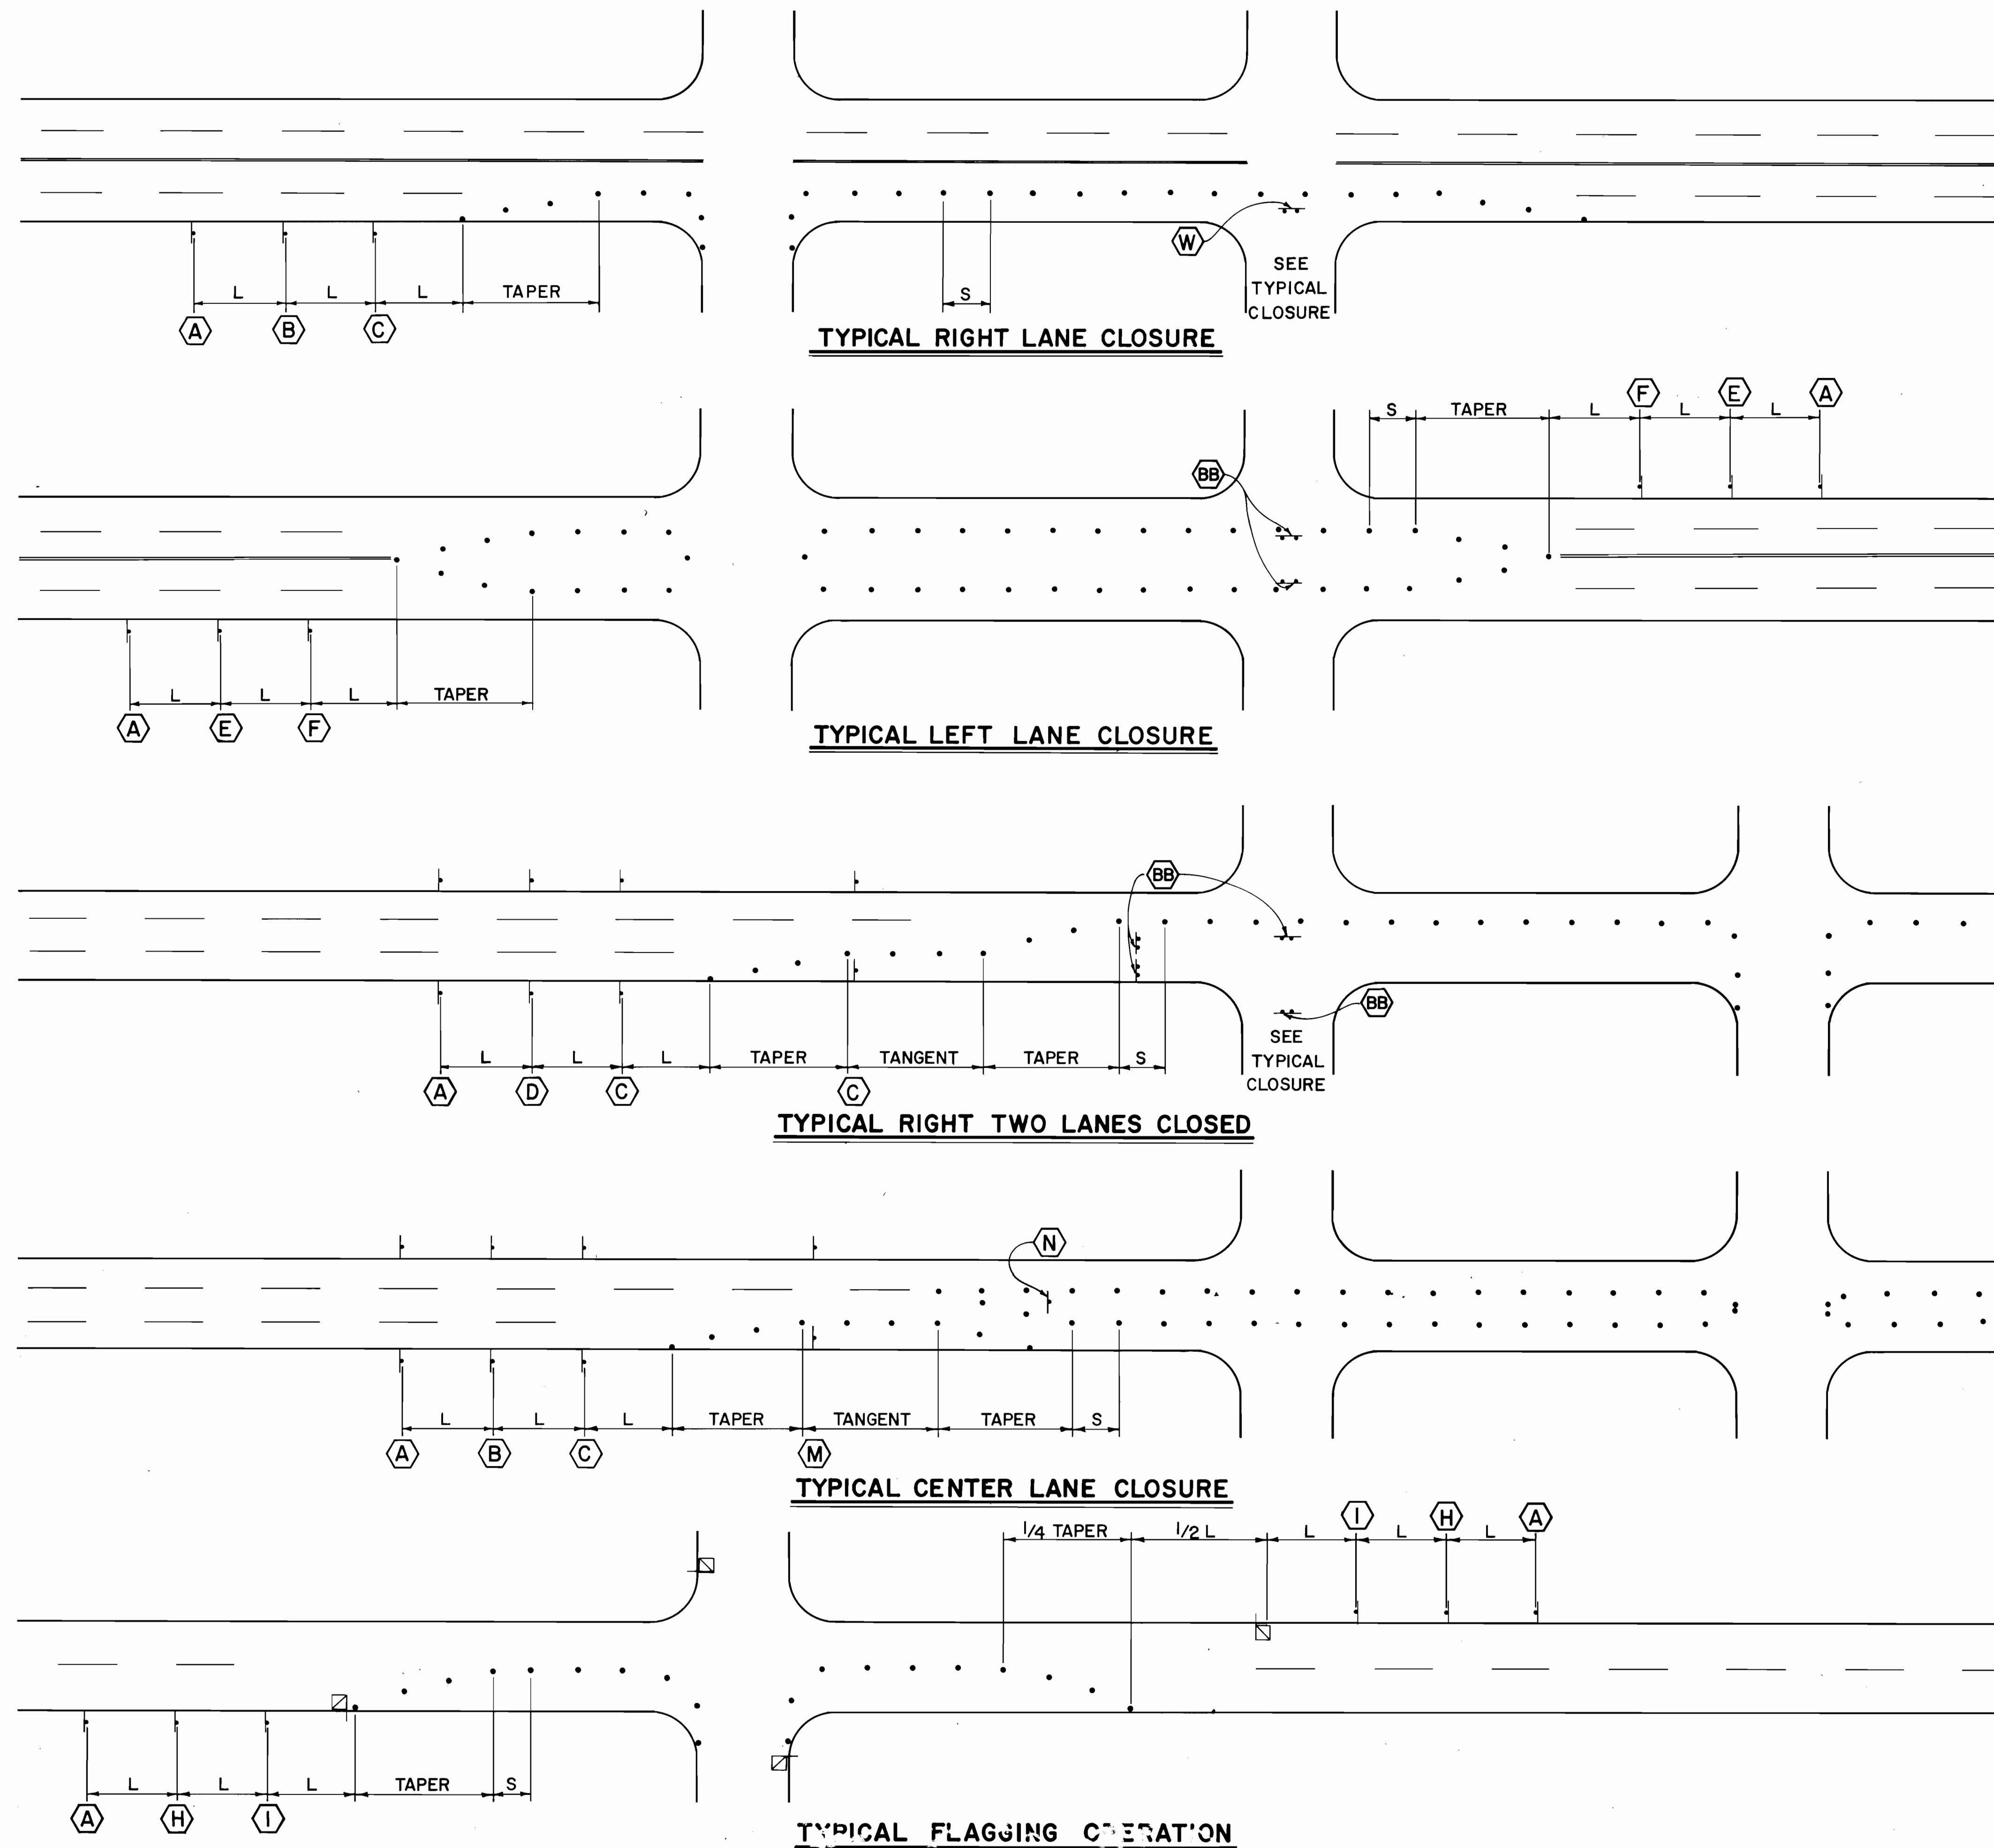


John A. Andrews
RECORD DRAWING
 EG 21513387


AS BUILT INFORMATION			BENCH MARKS			SURVEY INFORMATION			ENGINEER'S SEAL		
CONTRACTOR: Moore & Conner			ELEVATION: 5337.039			NO.					
WORK: BY 2-2-82			ACS BRASS TABLET SET ON CONCRETE POST FLUSH W/ GROUND			BY					
DATE: 10/87			LOCATED 41 FEET SOUTH OF THE CENTERLINE OF SAN ANTONIO DRIVE AND 34 FEET WEST OF THE CENTERLINE OF LOUISIANA BOULEVARD			DATE					
FIELD INSPECTION BY: C.C.Y.			DATE: 10/87			NO.					
DRAWINGS CORRECTED BY: J.A.A.R.			DATE: 10/87			BY					
MICRO-FILM INFORMATION			RECORDED BY			DATE					
NO.			NO.			NO.					

CITY OF ALBUQUERQUE MUNICIPAL DEVELOPMENT DEPARTMENT ENGINEERING DIVISION					
MINO ARROYO CORRIDOR IMPROVEMENTS					
TRAFFIC CONTROL DETAILS					
APPROVALS	ENGINEER	DATE	APPROVALS	ENGINEER	DATE
City Engineer	<i>[Signature]</i>	11/20/86	Liquid Waste	N/A BR	1-2-86
A.C.E.-Design	<i>[Signature]</i>	1/31/86	Traffic	D.A. Parks	1-31-86
A.C.E.-Hydrology	<i>[Signature]</i>	1-31-86	Water	N/A BR	1-2-86


DRAWING NO.	2151	MAP NO.	E-18, E-19	SHEET OF	33 34
-------------	------	---------	------------	----------	-------

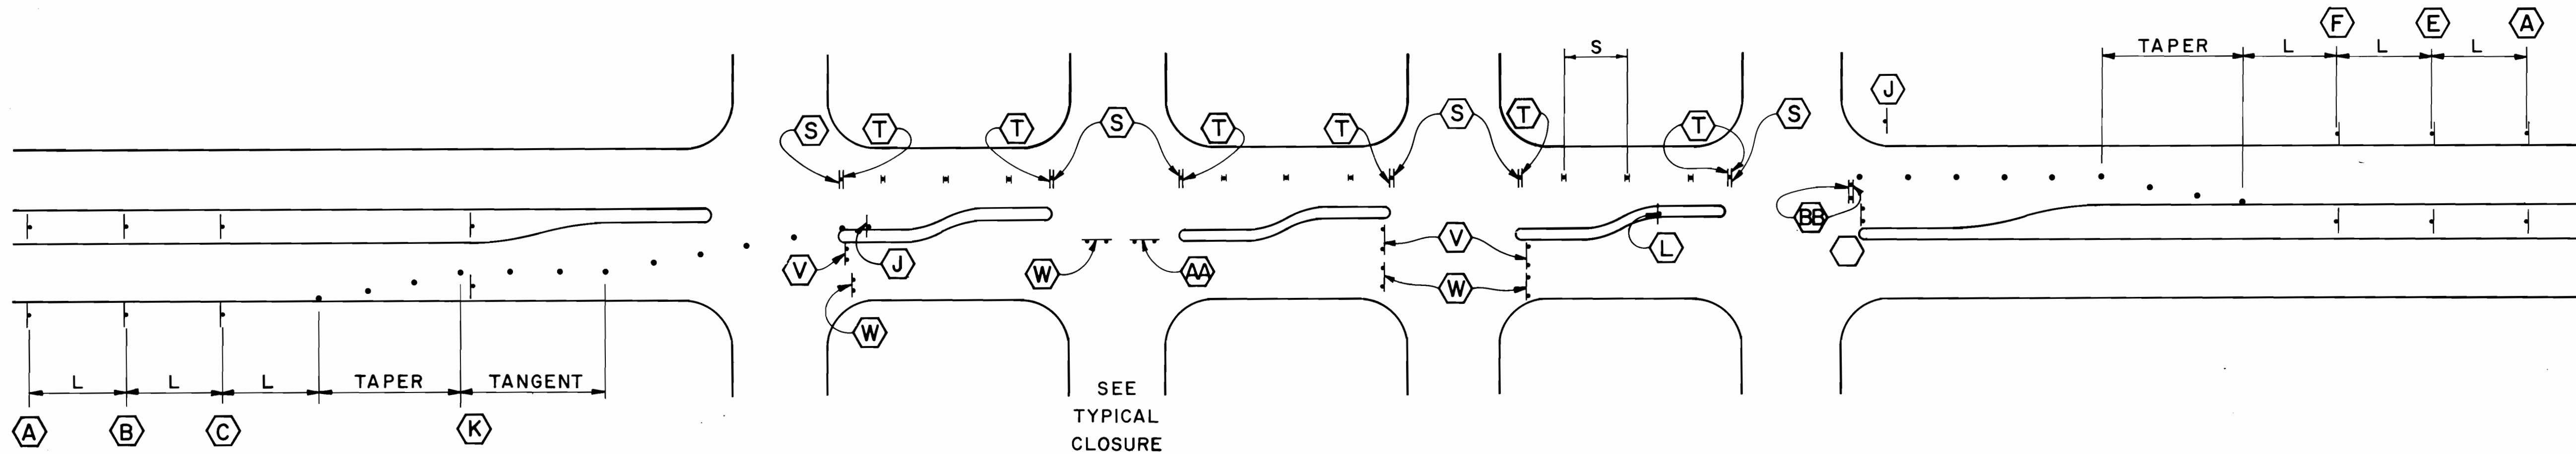


TYPICAL TRAFFIC SPLIT (RAISED MEDIAN)

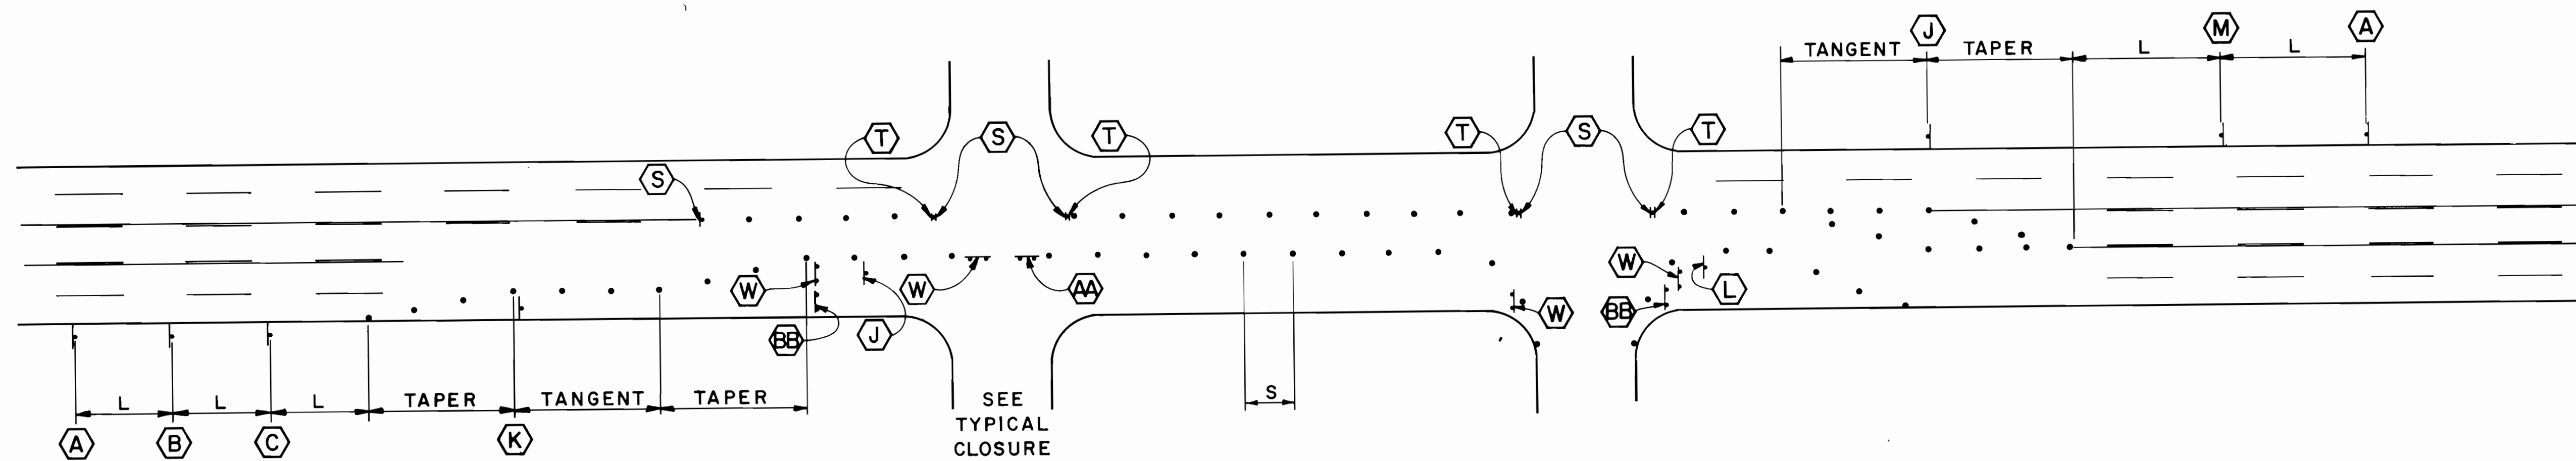

TYPICAL TRAFFIC SPLIT (PAINTED MEDIAN)

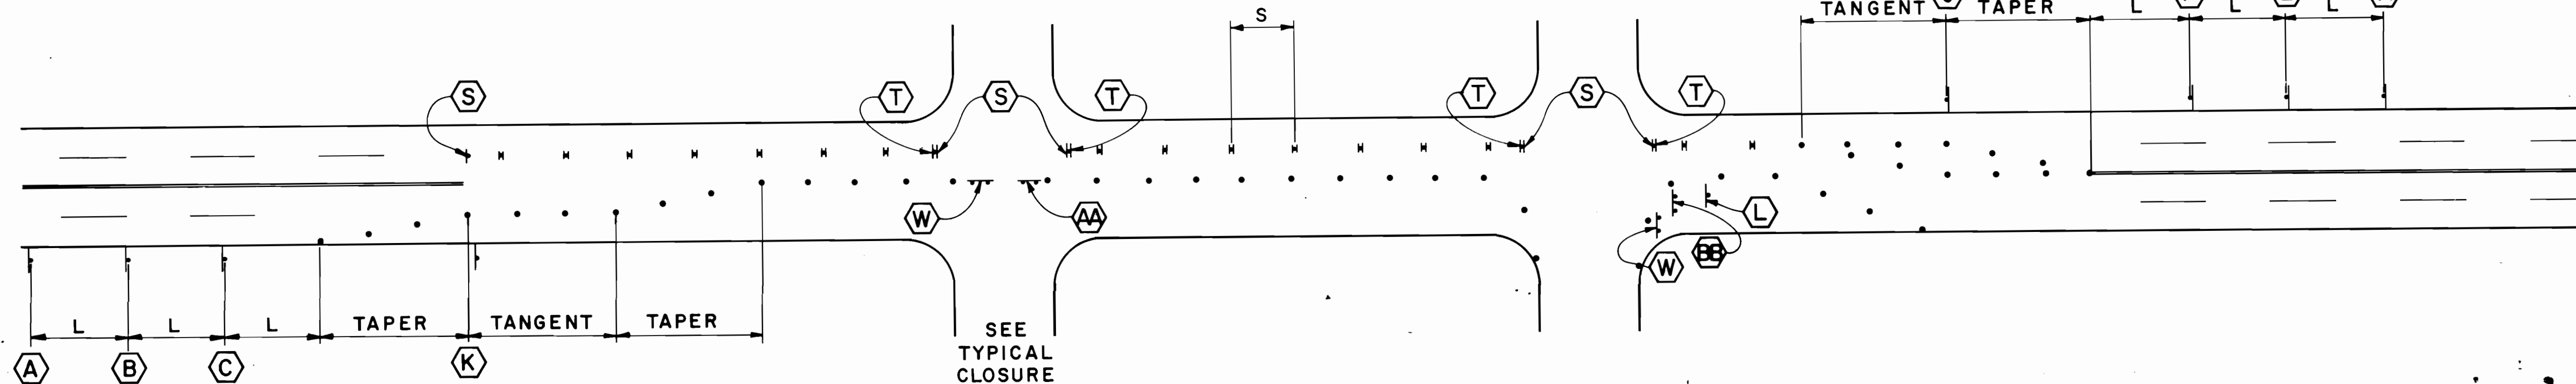

TYPICAL TRAFFIC SPLIT (NO MEDIAN)

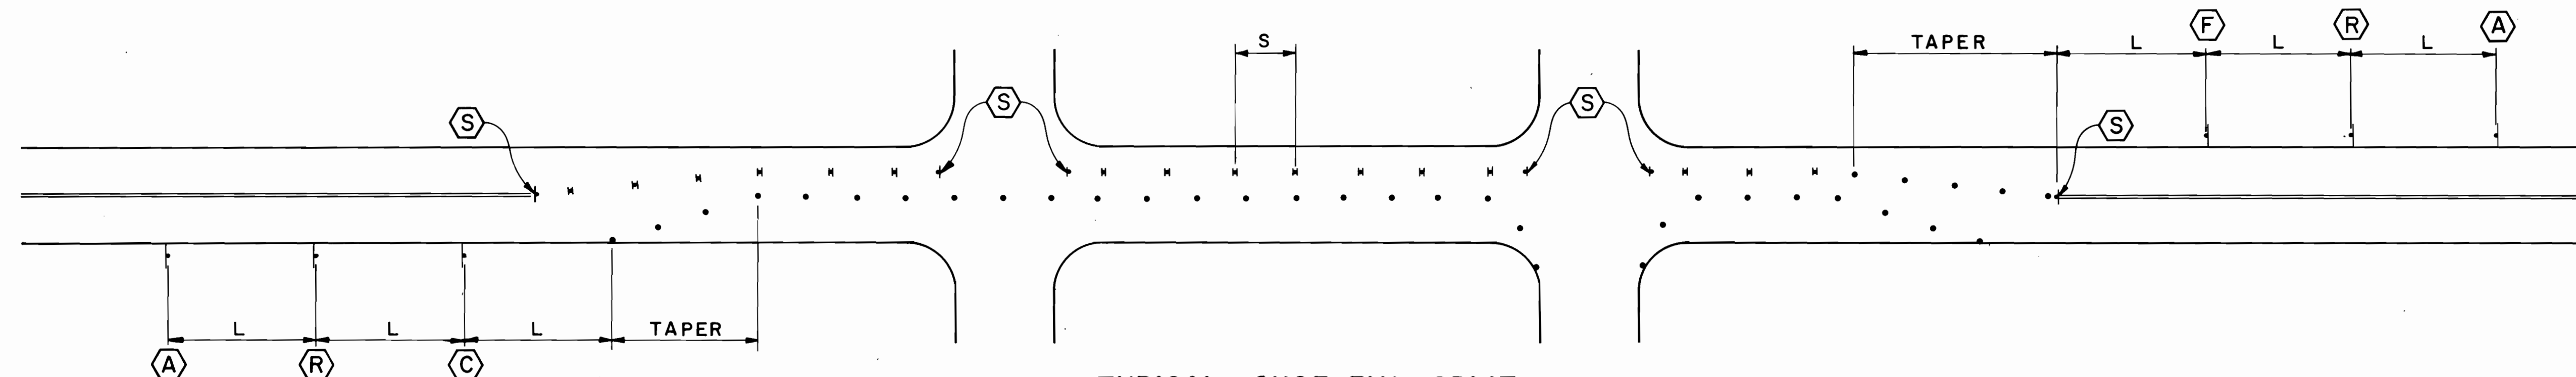

TYPICAL SHOE-FLY SPLIT

BENCH MARKS			SURVEY INFORMATION			ENGINEER'S SEAL		
CONTRACTOR: Moore & Covert ELEVATION: 5337.039 WORK: ACS BRASS TABLET SET ON CONCRETE POST FLUSH W/ GROUND STATIONED BY: J.A.H.R. DATE: 10/87 FIELD LOCATION: DRIVE AND 34 FEET WEST OF THE CENTERLINE OF LOUISIANA BOULEVARD DATE: 10/87 CORRECTED BY: J.A.H.R. DATE: 10/87 MICRO-FILM INFORMATION RECORDED BY: NO. DATE:			FIELD NOTES NO. BY DATE NO. BY DATE NO. BY DATE			ENGINEER'S SEAL PROFESSIONAL ENGINEER STATE OF NEW MEXICO NO. 3400 JOHN ANDREWS ANDREWS, ASBURY & ROBERT, INC. CONSULTING ENGINEERS ALBUQUERQUE, N.M. 87102		
REVISIONS NO. DATE NO. DATE NO. DATE			REMARKS NO. DATE NO. DATE NO. DATE			DESIGNED BY: DATE: 1-31-86 DRAWN BY: DATE: 1-31-86 CHECKED BY: DATE: 1-31-86		

John A. Andrews
RECORD DRAWING
26 21513487

CITY OF ALBUQUERQUE
MUNICIPAL DEVELOPMENT DEPARTMENT
ENGINEERING DIVISION

PINO ARROYO CORRIDOR IMPROVEMENTS

TRAFFIC CONTROL DETAILS

APPROVALS	ENGINEER	DATE	APPROVALS	ENGINEER	DATE
City Engineer	<i>[Signature]</i>	1/21/86	Liquid Waste	N/A B.R.	1-31-86
A.C.E. Design	<i>[Signature]</i>	1/31/86	Traffic	D.A. Pardo	1-31-86
A.C.E. Hydrology	<i>[Signature]</i>	1-31-86	Water	N/A B.R.	1-31-86

DRAWING NO. 2151 MAP NO. E-18, E. 19 SHEET 34 OF 34