

VAN CHRISTOPHER ST. NE
ALBUQUERQUE, NEW MEXICO


RECORD DRAWING

INDEX

RECORD DRAWING

DESCRIPTION	SHEET NO.
COVER SHEET	1
PAVING · PLAN & PROFILE	2
WATER · PLAN & PROFILE	3

RECORD DRAWING

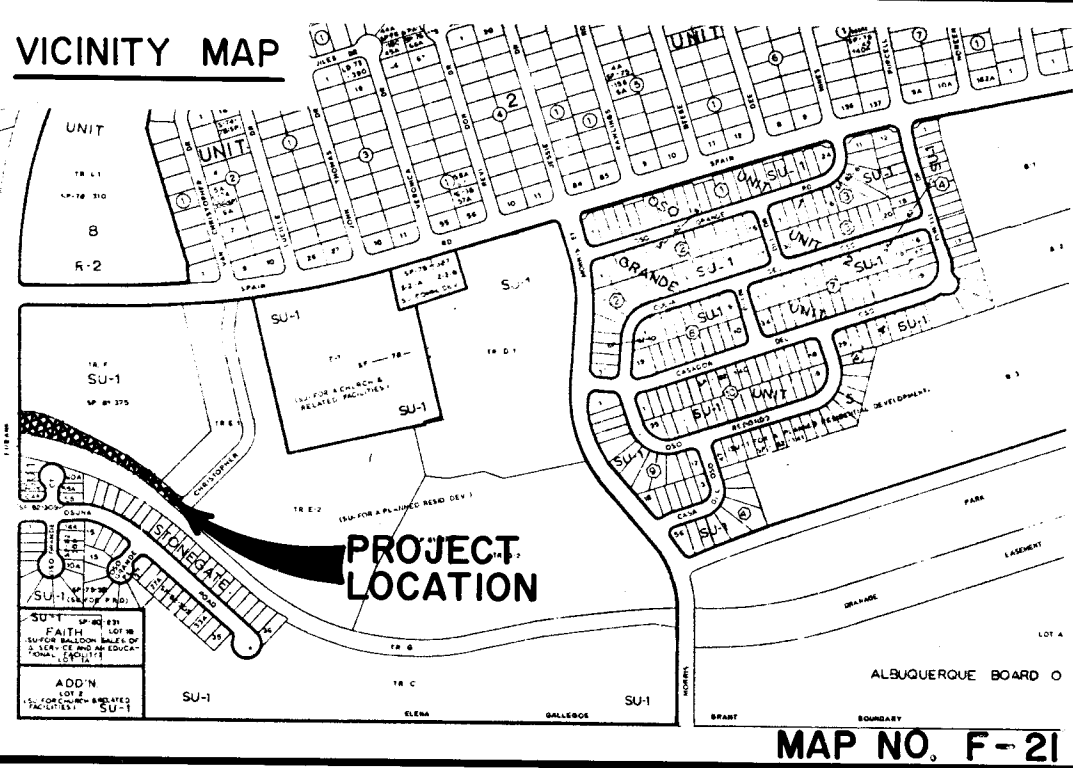

NOTES

ALL WORK DETAILED ON THESE PLANS TO BE PERFORMED UNDER CONTRACT SHALL, EXCEPT AS OTHERWISE STATED OR PROVIDED FOR HEREON, BE CONSTRUCTED IN ACCORDANCE WITH THE NEW MEXICO STANDARD SPECIFICATIONS FOR PUBLIC WORKS CONSTRUCTION - 1979 EDITION (REFERRED TO HEREIN AS THE STANDARD SPECIFICATIONS).


TWO (2) WORKING DAYS PRIOR TO ANY EXCAVATION, CONTRACTOR MUST CONTACT LINE LOCATING SERVICE, 765-1234, FOR LOCATION OF EXISTING UTILITIES.

PRIOR TO CONSTRUCTION, THE CONTRACTOR SHALL EXCAVATE AND VERIFY THE HORIZONTAL AND VERTICAL LOCATIONS OF ALL OBSTRUCTIONS. SHOULD A CONFLICT EXIST, THE CONTRACTOR SHALL NOTIFY THE ENGINEER OR SURVEYOR SO THAT THE CONFLICT CAN BE RESOLVED WITH MINIMUM AMOUNT OF DELAY.


APPROVAL AS BUILT DESIGN
ACST CITY ENGINEER FIELD
W.F. McManis
DATE 11-14-84

26 2167 0184

REV	SHEETS	CITY ENGR.	DATE	USER DEPT.	DATE	USER DEPT.	DATE
APPROVAL OF REVISIONS							
SUBMITTED BY:		WILSON & COMPANY ENGINEERS & ARCHITECTS ALBUQUERQUE, NEW MEXICO		APPROVED FOR CONSTRUCTION <i>C.D. Higgins</i> 9/14/84			
DATE: 6/27/84		PROJECT No. 2167		SHEET 1 OF 3			

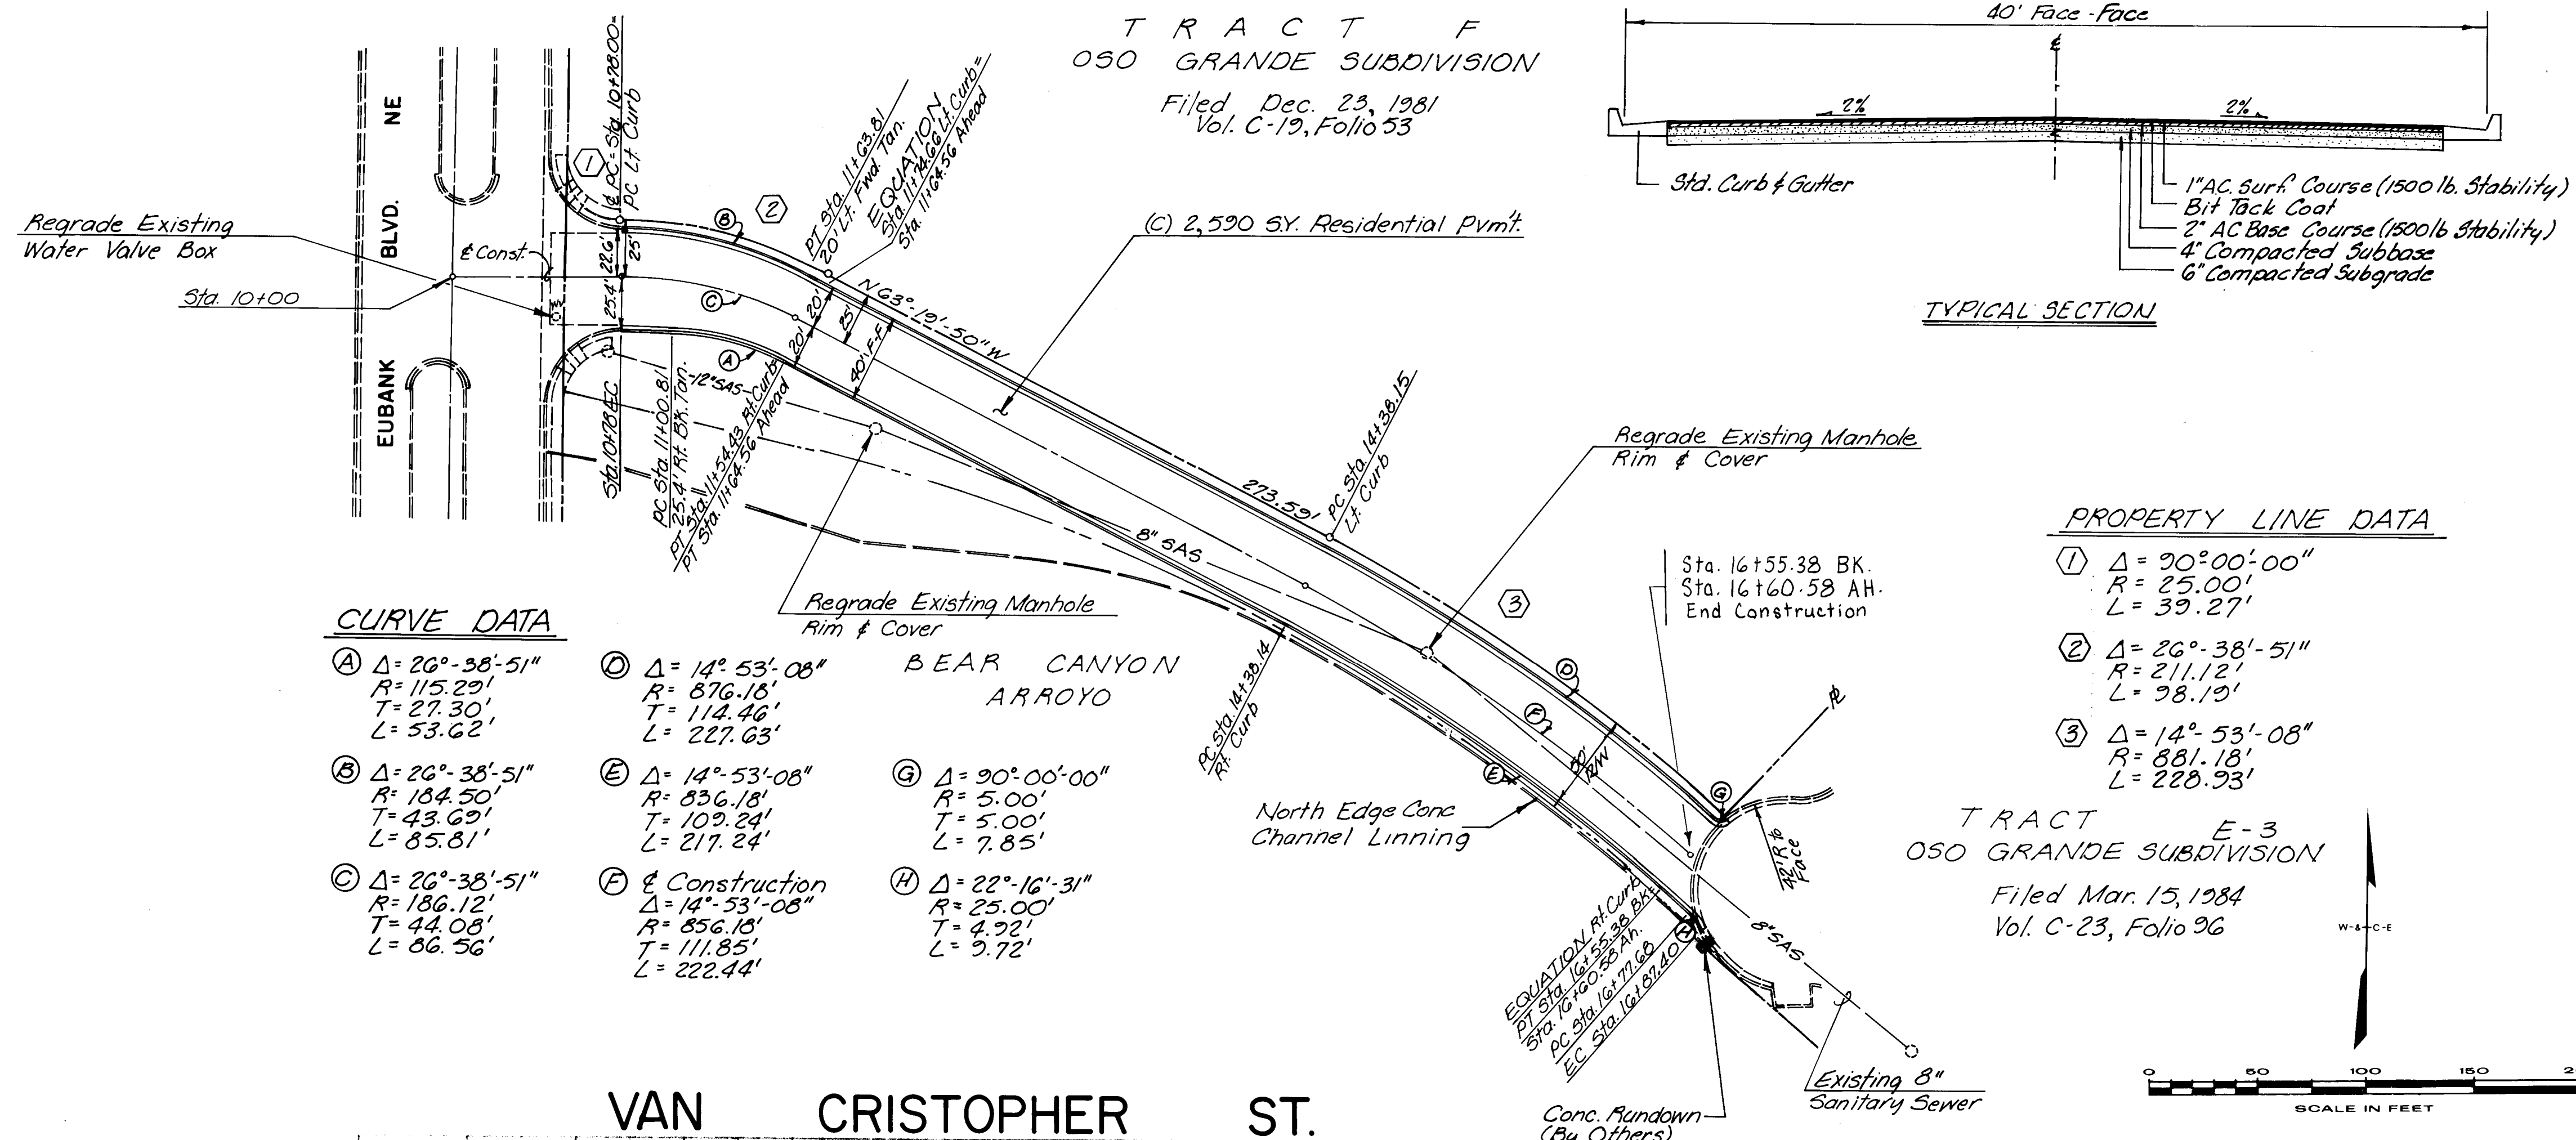

VAN CRISTOPHER ST.

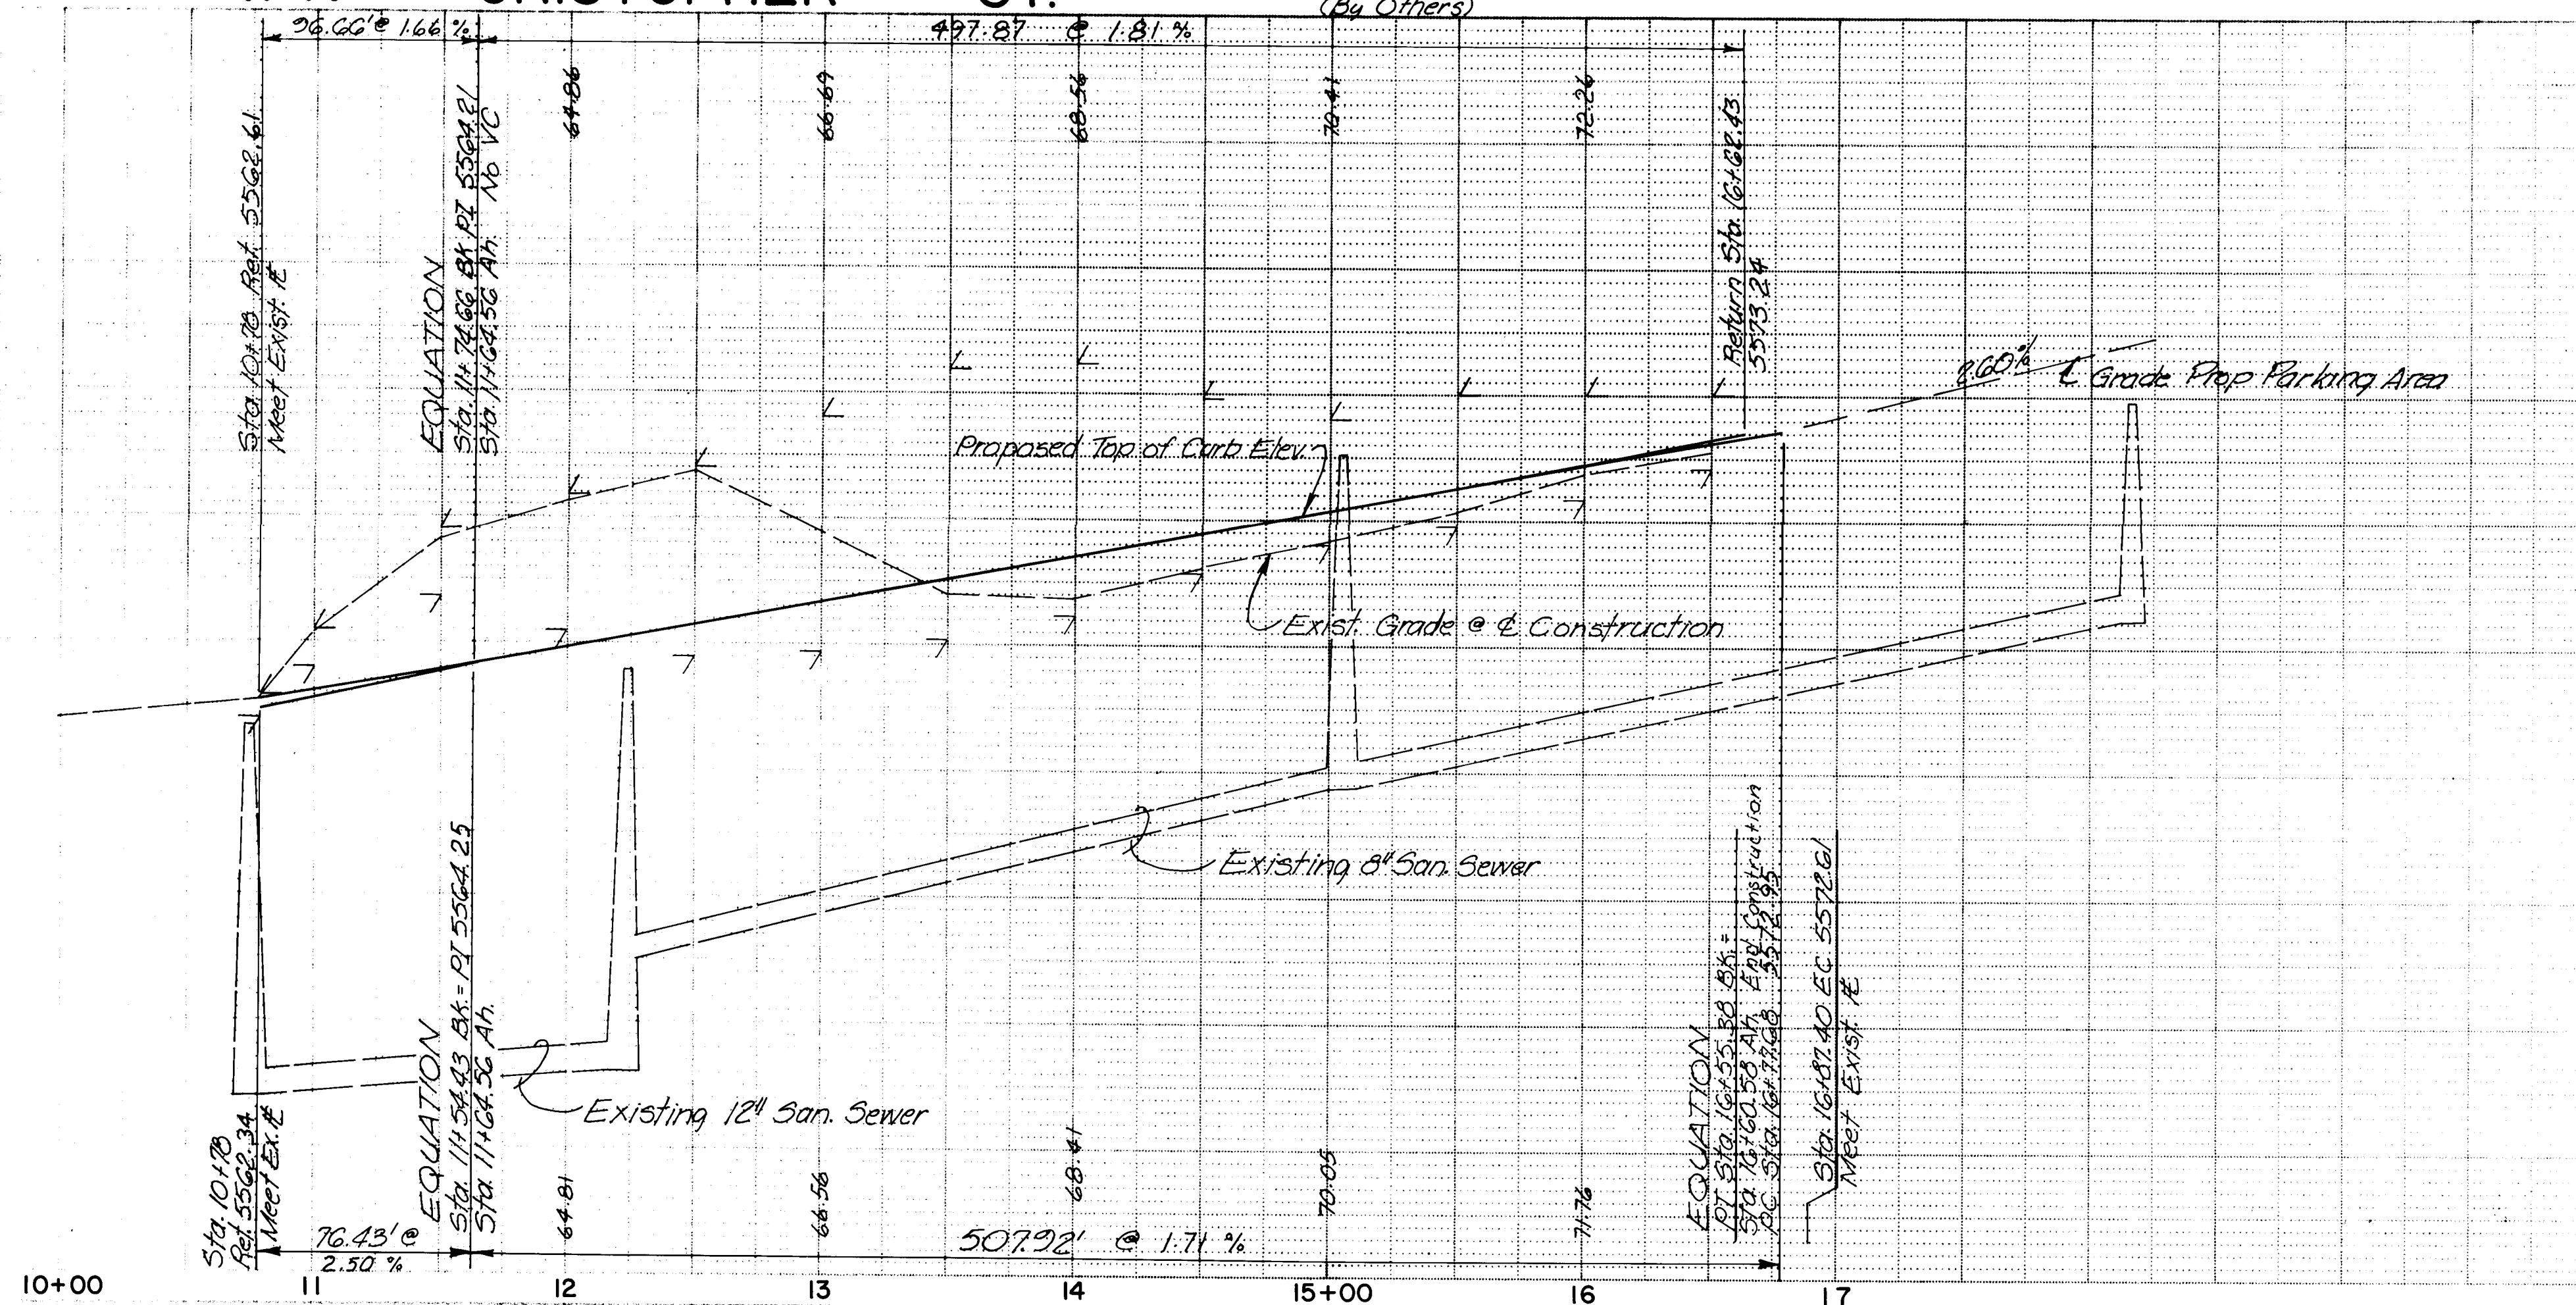

NOTE:
Street Improvements will be
Constructed in accordance with
City of Albuquerque Contract
Documents for Public Work
Contract 84-2

RECORD DRAWING
I, Claude A.L. Pilley, N.M.P.E. & L.S. No. 4981,
herby certify that this drawing has been
revised in accordance with information furnished
by KNC, Inc. Field surveys and that both the
revisions and field surveys were done under
my personal direction and control.

LEGEND

△ GRADE 25' LT.
▽ GRADE 25' RT.

26 2167 0284

CITY OF ALBUQUERQUE					
MUNICIPAL DEVELOPMENT					
VAN CRISTOPHER STREET					
PAVING PLAN					
APPROVALS	ENGINEER	DATE	APPROVALS	ENGINEER	DATE
City Engineer	<i>C. Pilley</i>	7/10/84	Liquid Waste	<i>R. Pena</i>	7/10/84
A.C.E. - Design	<i>C. Pilley</i>	6/5/84	Traffic	<i>R. Pena</i>	7/10/84
A.C.E. - Hydrology	<i>C. Pilley</i>	7/10/84	Water	<i>R. Pena</i>	7/10/84
DRAWING NO.	MAP NO.	SHEET 2 OF 3			
2167	F-21				

