


CITY OF ALBUQUERQUE, NEW MEXICO

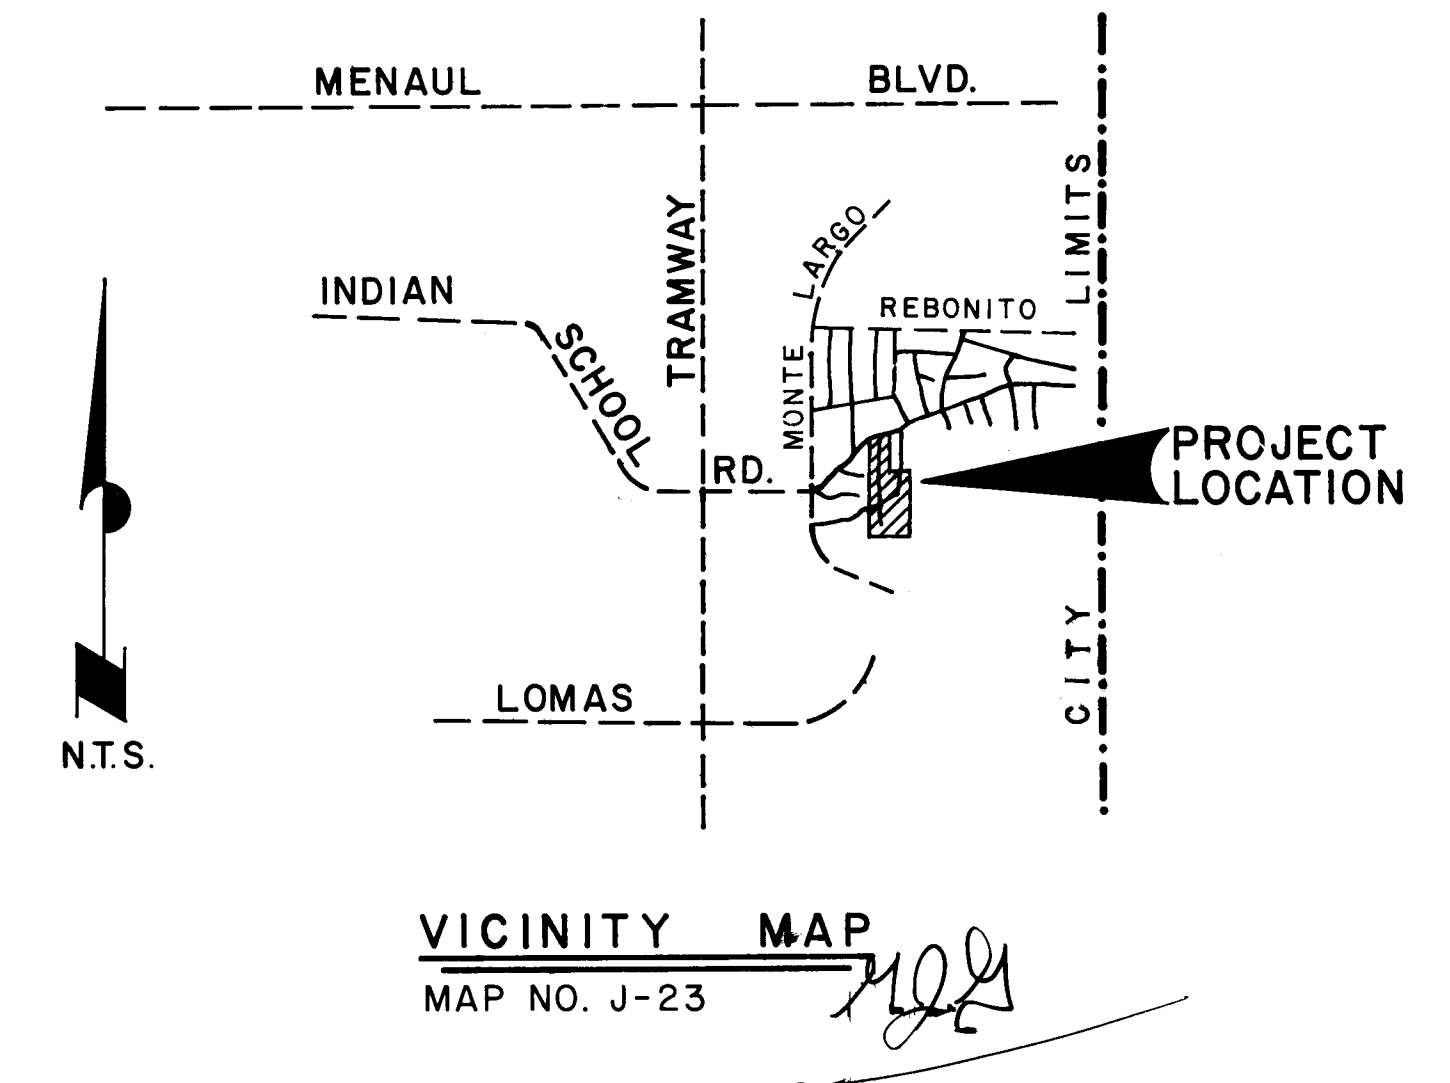

PORTIONS OF BLOCKS 11,12,13, & 14

REBONITO SUBDIVISION

PAVING, UTILITIES & DRAINAGE

OCTOBER , 1984

INDEX

SHEET No.	DESCRIPTION
1.	TITLE and INDEX SHEET
2.	GENERAL NOTES and LEGEND
3.	PLAT (Sheet 1 of 2)
4.	PLAT (Sheet 2 of 2)
5.	GRADING PLAN
6.	WATER and SANITARY SEWER LAYOUT SHEET W/ PIPE GATE DETAIL
7.	PLAN & PROFILE (WELLS DRIVE AND ARCHULETA DRIVE)
8.	PLAN & PROFILE (BELLAMAH AVENUE)
9.	PLAN & PROFILE (ARCHULETA DRIVE CONTINUED)
10.	PLAN & PROFILE (INDIAN SCHOOL ROAD)
11.	TYPICAL DETAIL SECTIONS
12.	DETAIL SECTIONS
13.	BELLAMAH INTERSECTION DRAINAGE DETAILS

APPROVED FOR AS BUILT DRAWINGS
BY ENGINEER FIELD
W. J. McNamee
DATE 1-6-86

26 21760186

REV.	SHEETS	CITY ENGR.	DATE	USER DEPT.	DATE	USER DEPT.	DATE
APPROVAL OF REVISIONS							



DENNEY-GROSS & ASSOCIATES, INC.
ENGINEERS-PLANNERS
ALBUQUERQUE, NEW MEXICO 87107

RECORD DRAWING
Date: DEC 6 1985

	DENNEY-GROSS & ASSOC., INC. ENGINEERS SURVEYORS PLANNERS 2400 COMANCHE RD. N.E., ALBUQ. N.M. 87107 (505) 884-0696	APPROVED FOR CONSTRUCTION <i>C. D. [Signature]</i> 5/6/85 C.E.
	2176	SHEET 1 OF 13

