


IMPROVEMENT PLANS

COORS ROAD SANITARY SEWER FROM SEQUOIA SOUTH

CITY OF ALBUQUERQUE
NEW MEXICO

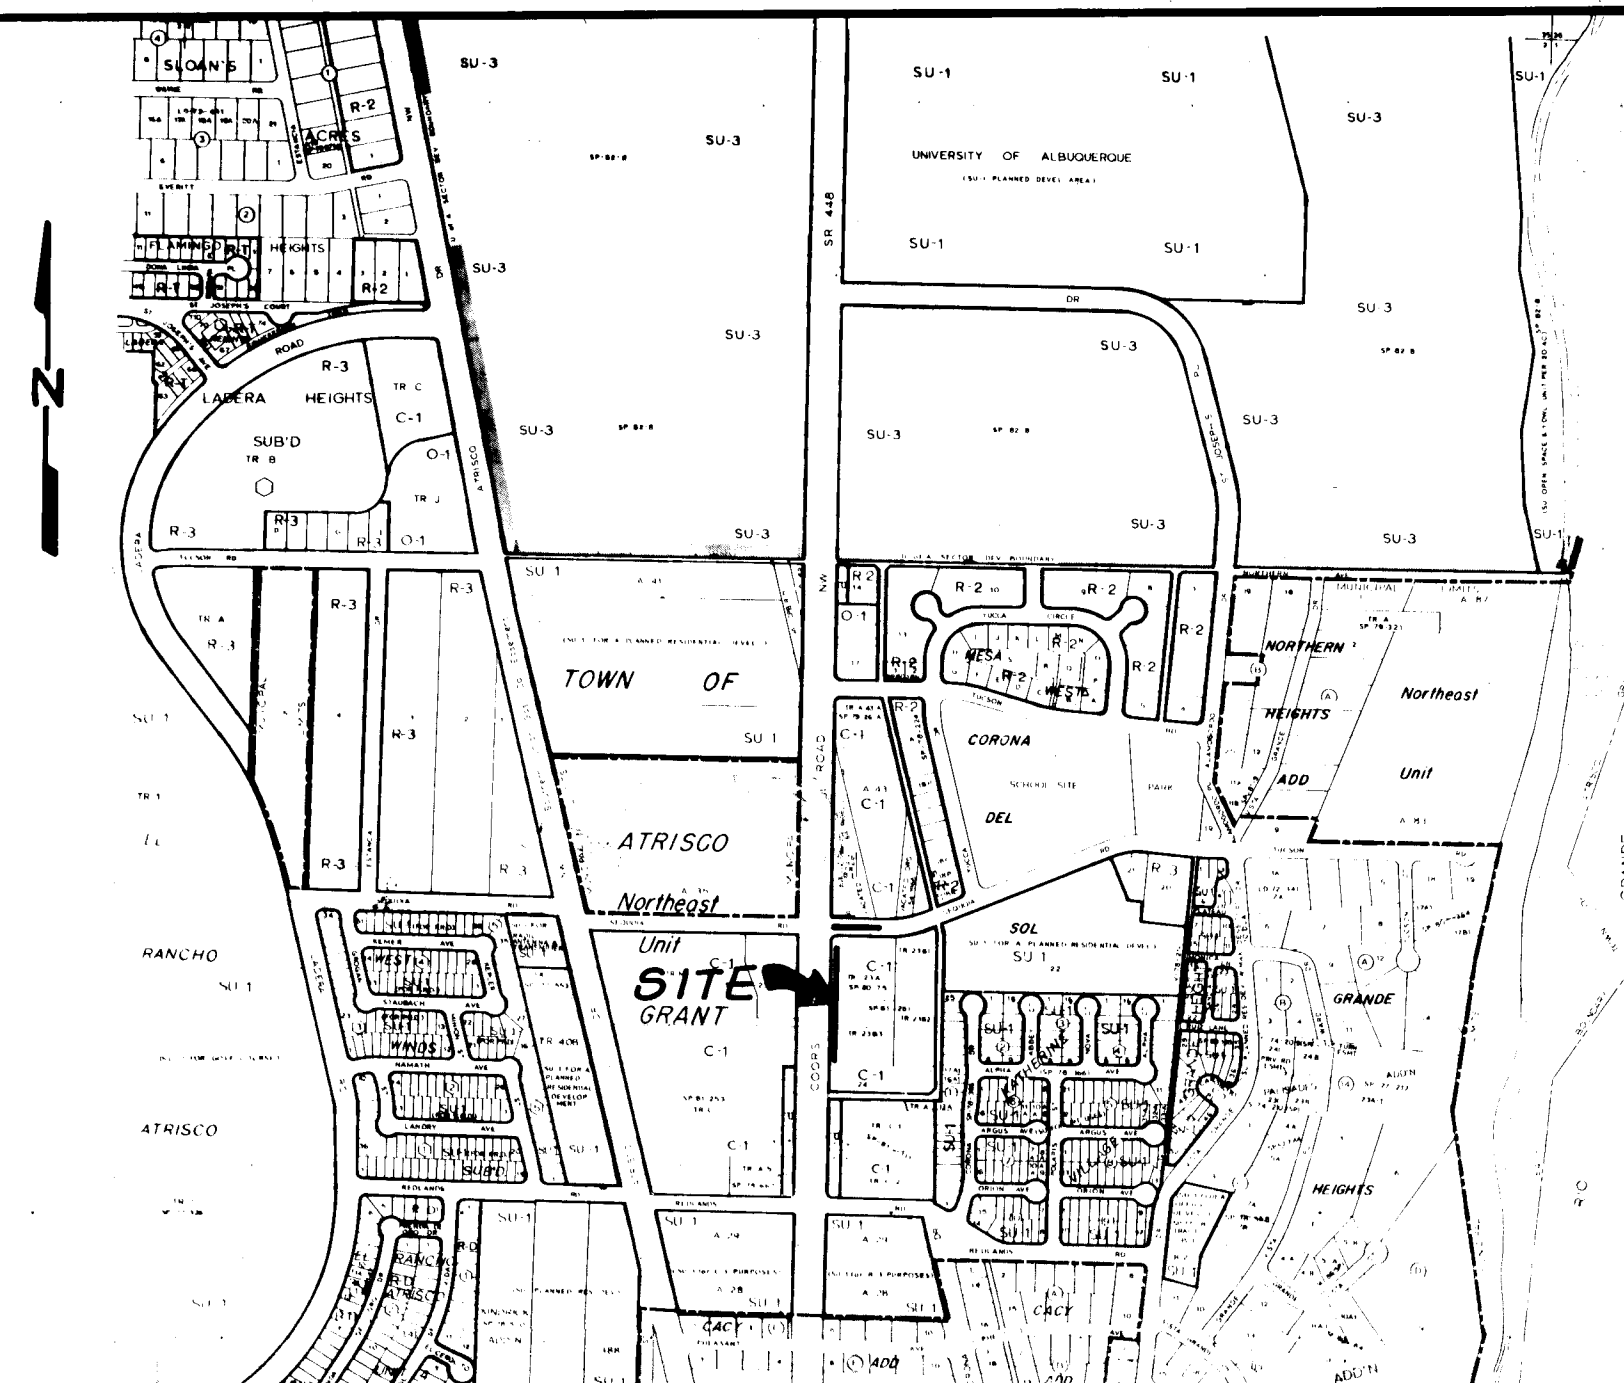

VICINITY MAP G-II

INDEX

COVER SHEET	1
WATER AND SEWER P & P	2


GENERAL NOTES

1. New Mexico Standard Specifications for Public Works Construction-1970 Edition, will be referred to hereon as the "Standard Specifications".
2. All work detailed on these plans to be performed under contract shall, except as otherwise stated or provided for hereon, be constructed in accordance with "Contract Documents for Public Works Contract No. 84-2 and the Standard Specifications".
3. All utilities and utility lines shall be installed prior to paving.
4. Where a water line passes beneath or less than 18" above an existing sewer line, the sewer line shall be encased in concrete 6" thick for at least 10' on each side of the water line, or the sewer line shall be replaced with ductile iron pipe from manhole to manhole. This shall also apply where a parallel water line is less than 10' horizontally and less than 2' above the sewer.
5. Backfill compaction shall be according to specified street use.
6. Stations shown are centerline stations.
7. Two working days prior to any excavation, contractor must contact Line Locating Service, 765-1234, for location of existing lines.
8. Prior to construction, the contractor shall excavate and verify the horizontal and vertical locations of all obstructions. Should a conflict exist, the contractor shall notify the engineer or surveyor so that the conflict can be resolved with a minimum amount of delay.
9. All manholes on this project are 4 ft. in diameter, unless otherwise noted. Invert elevations shown are at edge of manhole. All sewer line stations refer to centerline street stations.
10. Sewer pipe lengths are from ϵ of manhole to ϵ of manhole.
11. All waterline stations refer to centerline street stations.
12. The existence and location of existing underground facilities shown on these plans were obtained by a search of the available records. To the best of our knowledge, there are no other existing facilities except as shown on these plans. However, the contractor is required to take precautionary measures to protect any existing facility shown hereon and any other which is not of record or not shown on these plans.



W.F. McManis
9-9-85

26 21870185

REV.	SHEETS	CITY ENGINEER	DATE	USER	DEPT.	DATE	USER	DEPT.	DATE
APPROVAL OF REVISIONS									


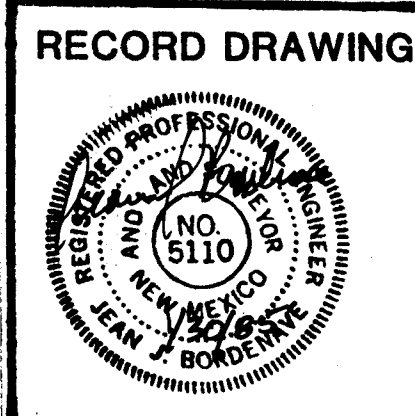


	DWJM/Adam, Hamlyn, Anderson Suite A 4055 Montgomery Boulevard N.E. Albuquerque, New Mexico 87109 Telephone: 505/881-1808	Planning Engineering Systems Economics	APPROVED FOR CONSTRUCTION C.D. Sheppard C.E.
	2187		SHEET 1 OF 2

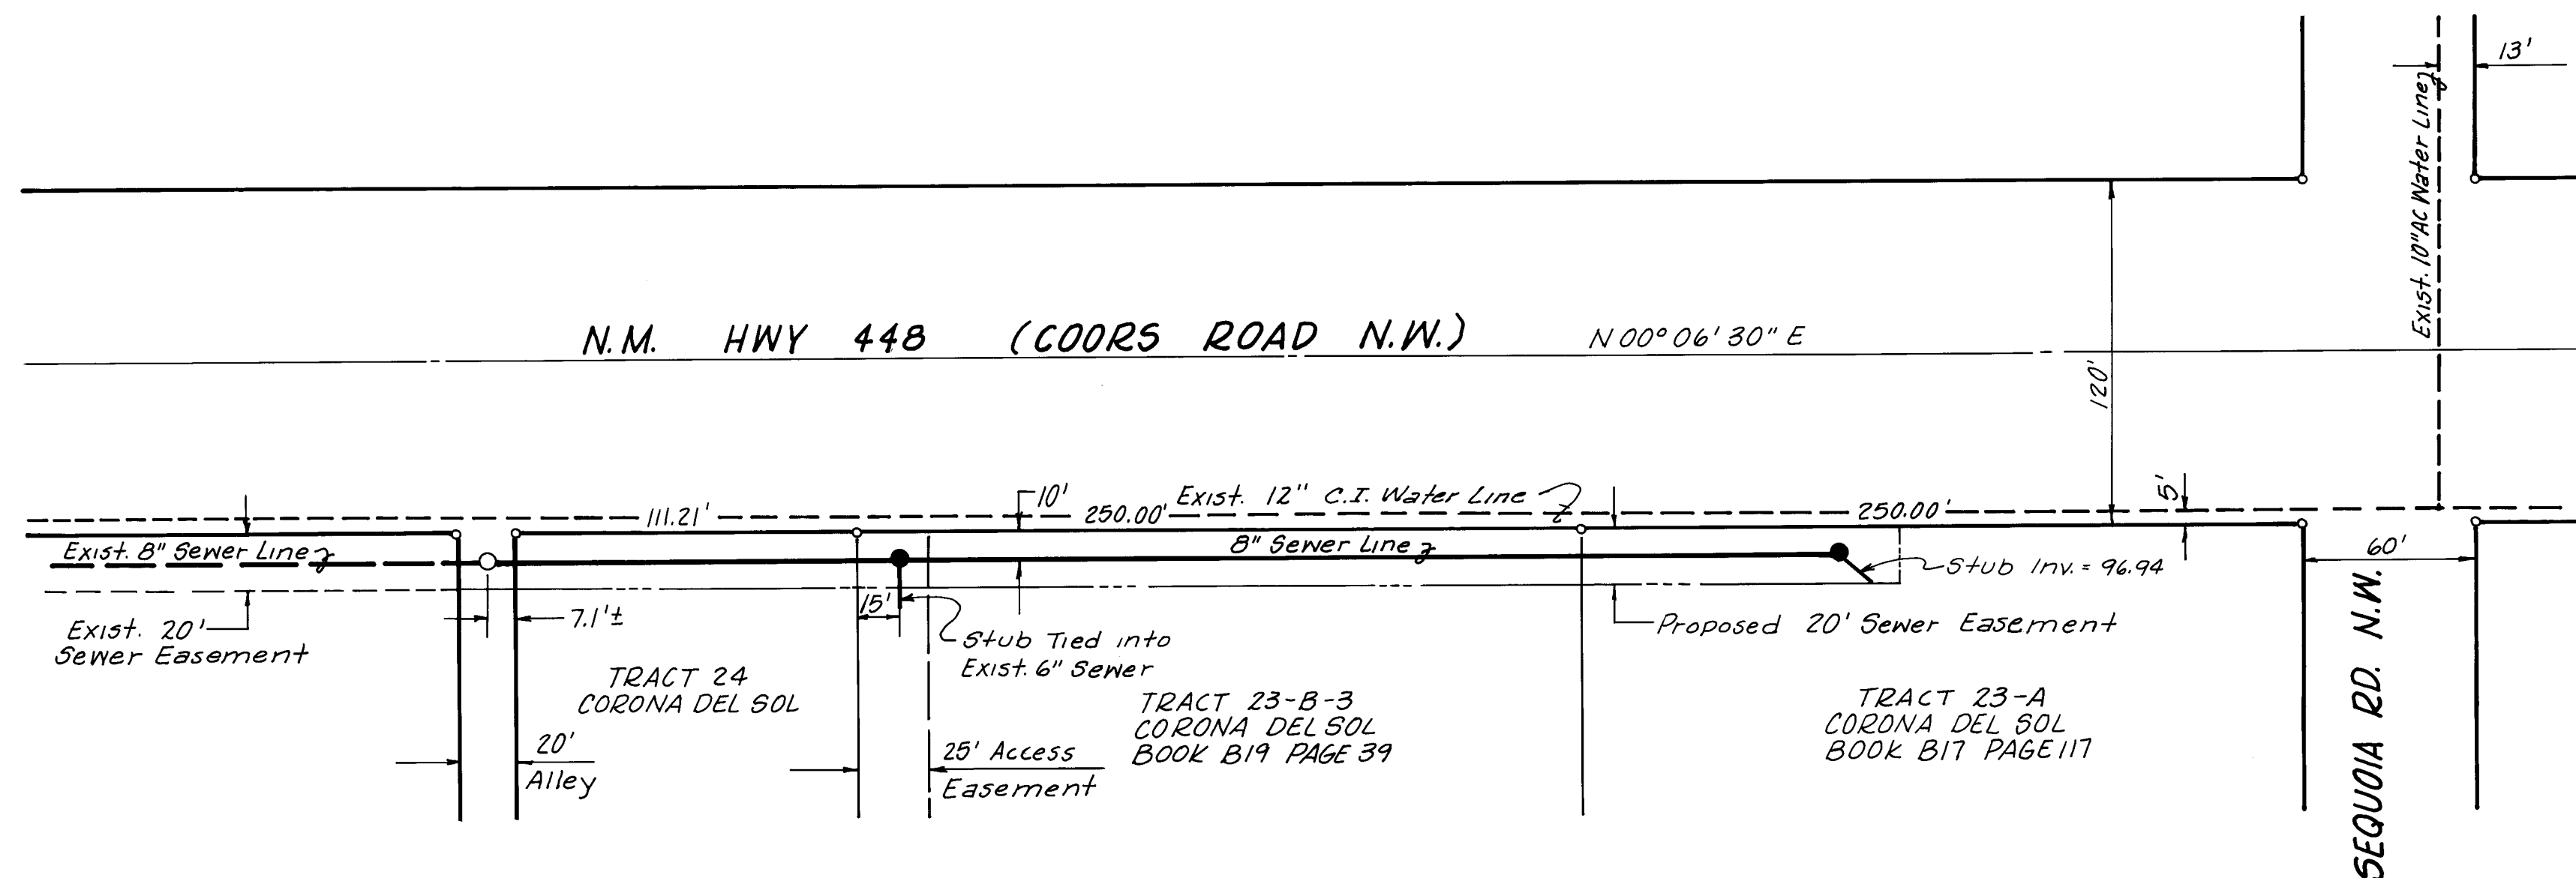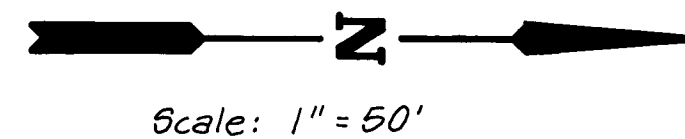


COORS ROAD N.W.

NOTE: Basis of Bearings is from the Summary Plat of Tract 23 Corona Del Sol Subdivision Book B17 Page 117

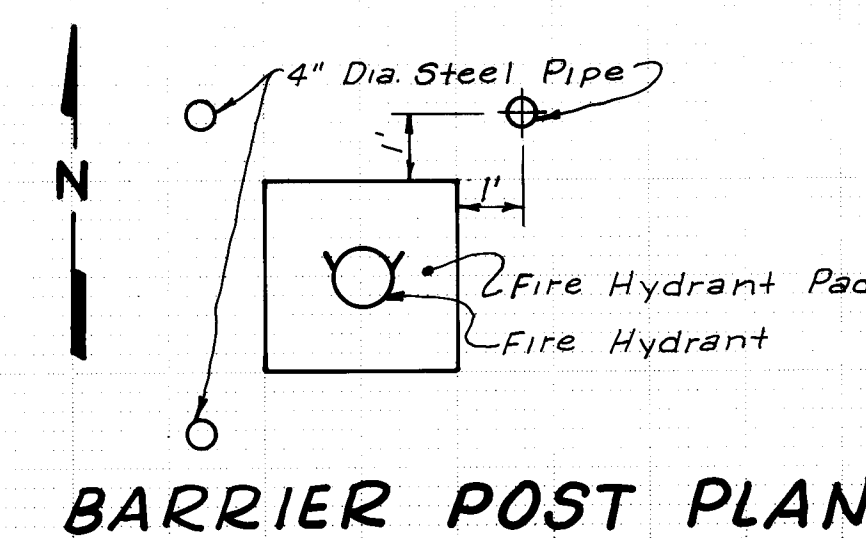
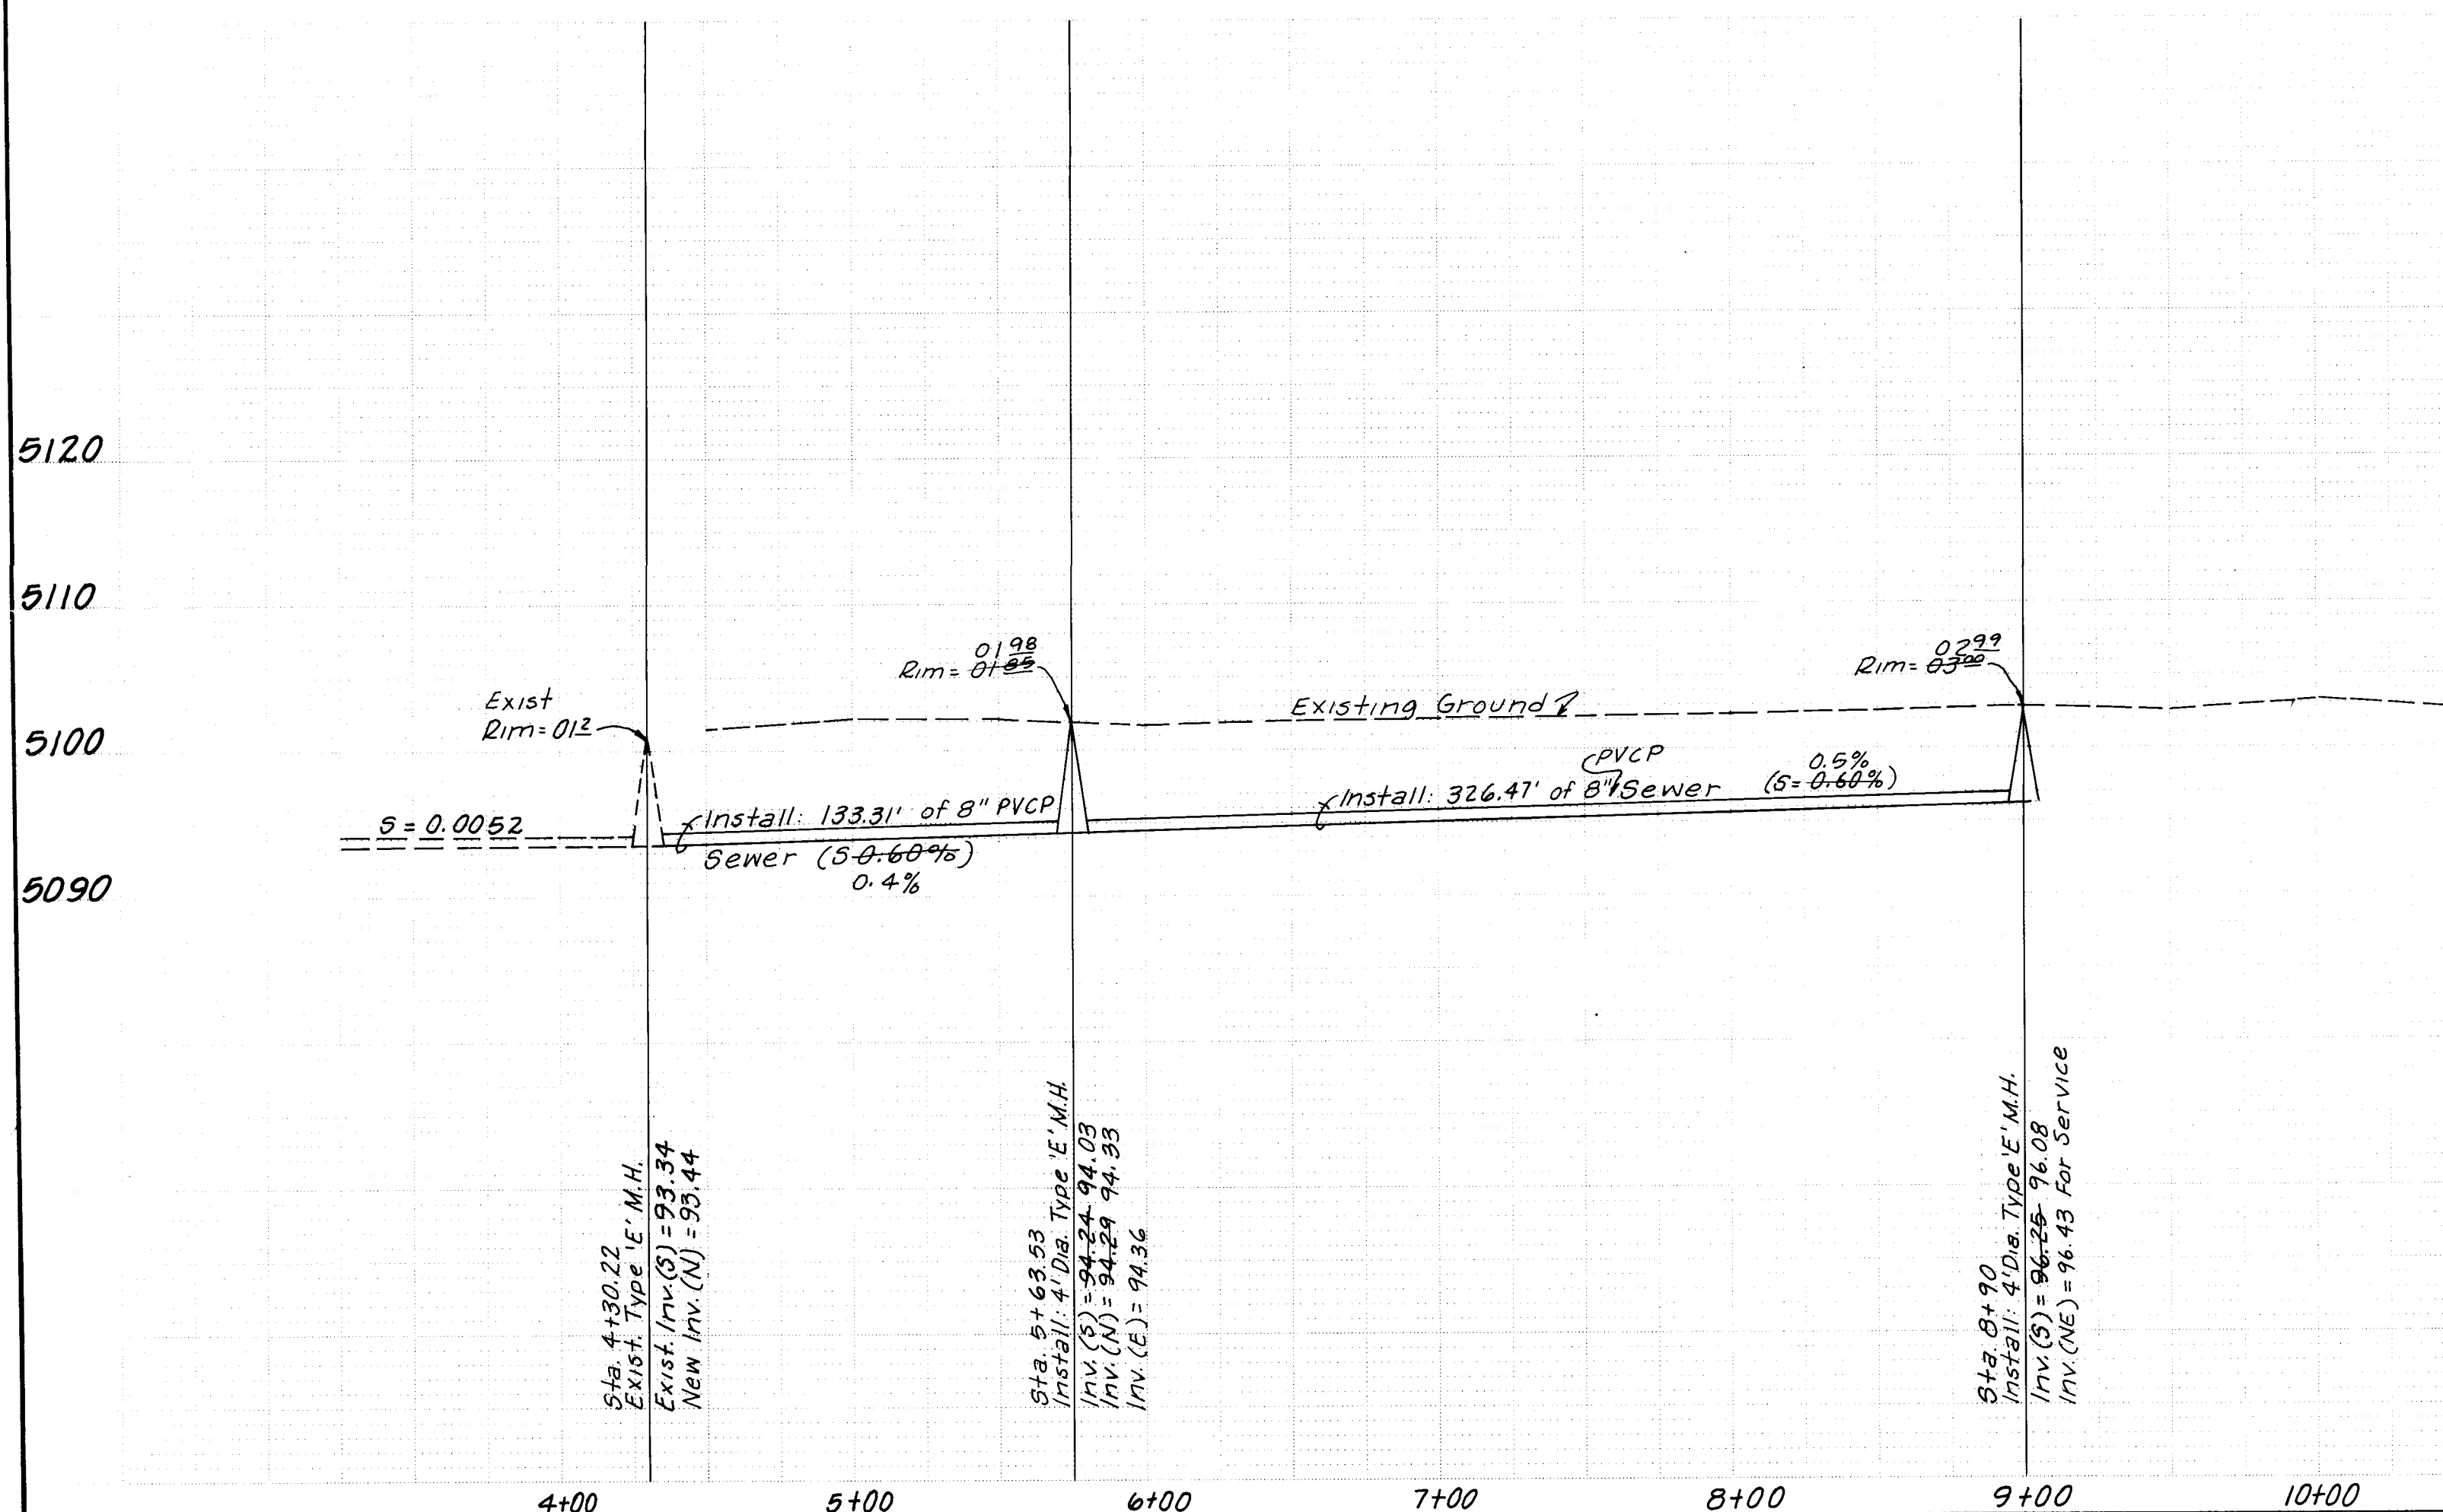


BARRIER POST PLAN

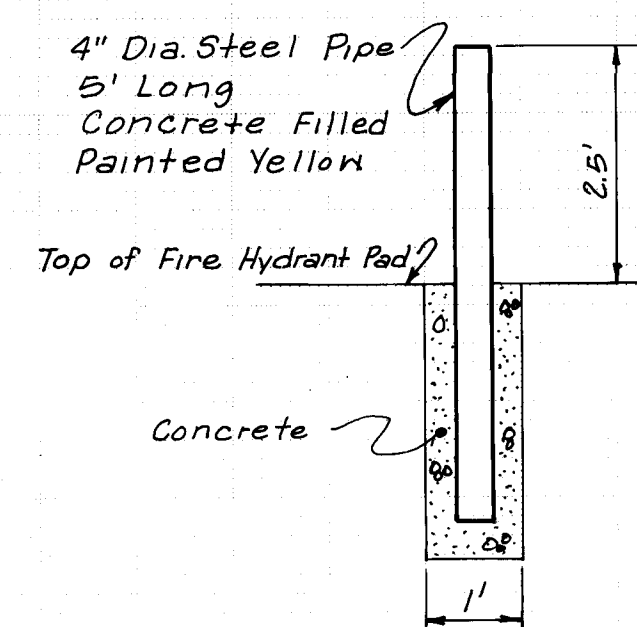


BARRIER POST DETAIL

Scale: 1"=50'

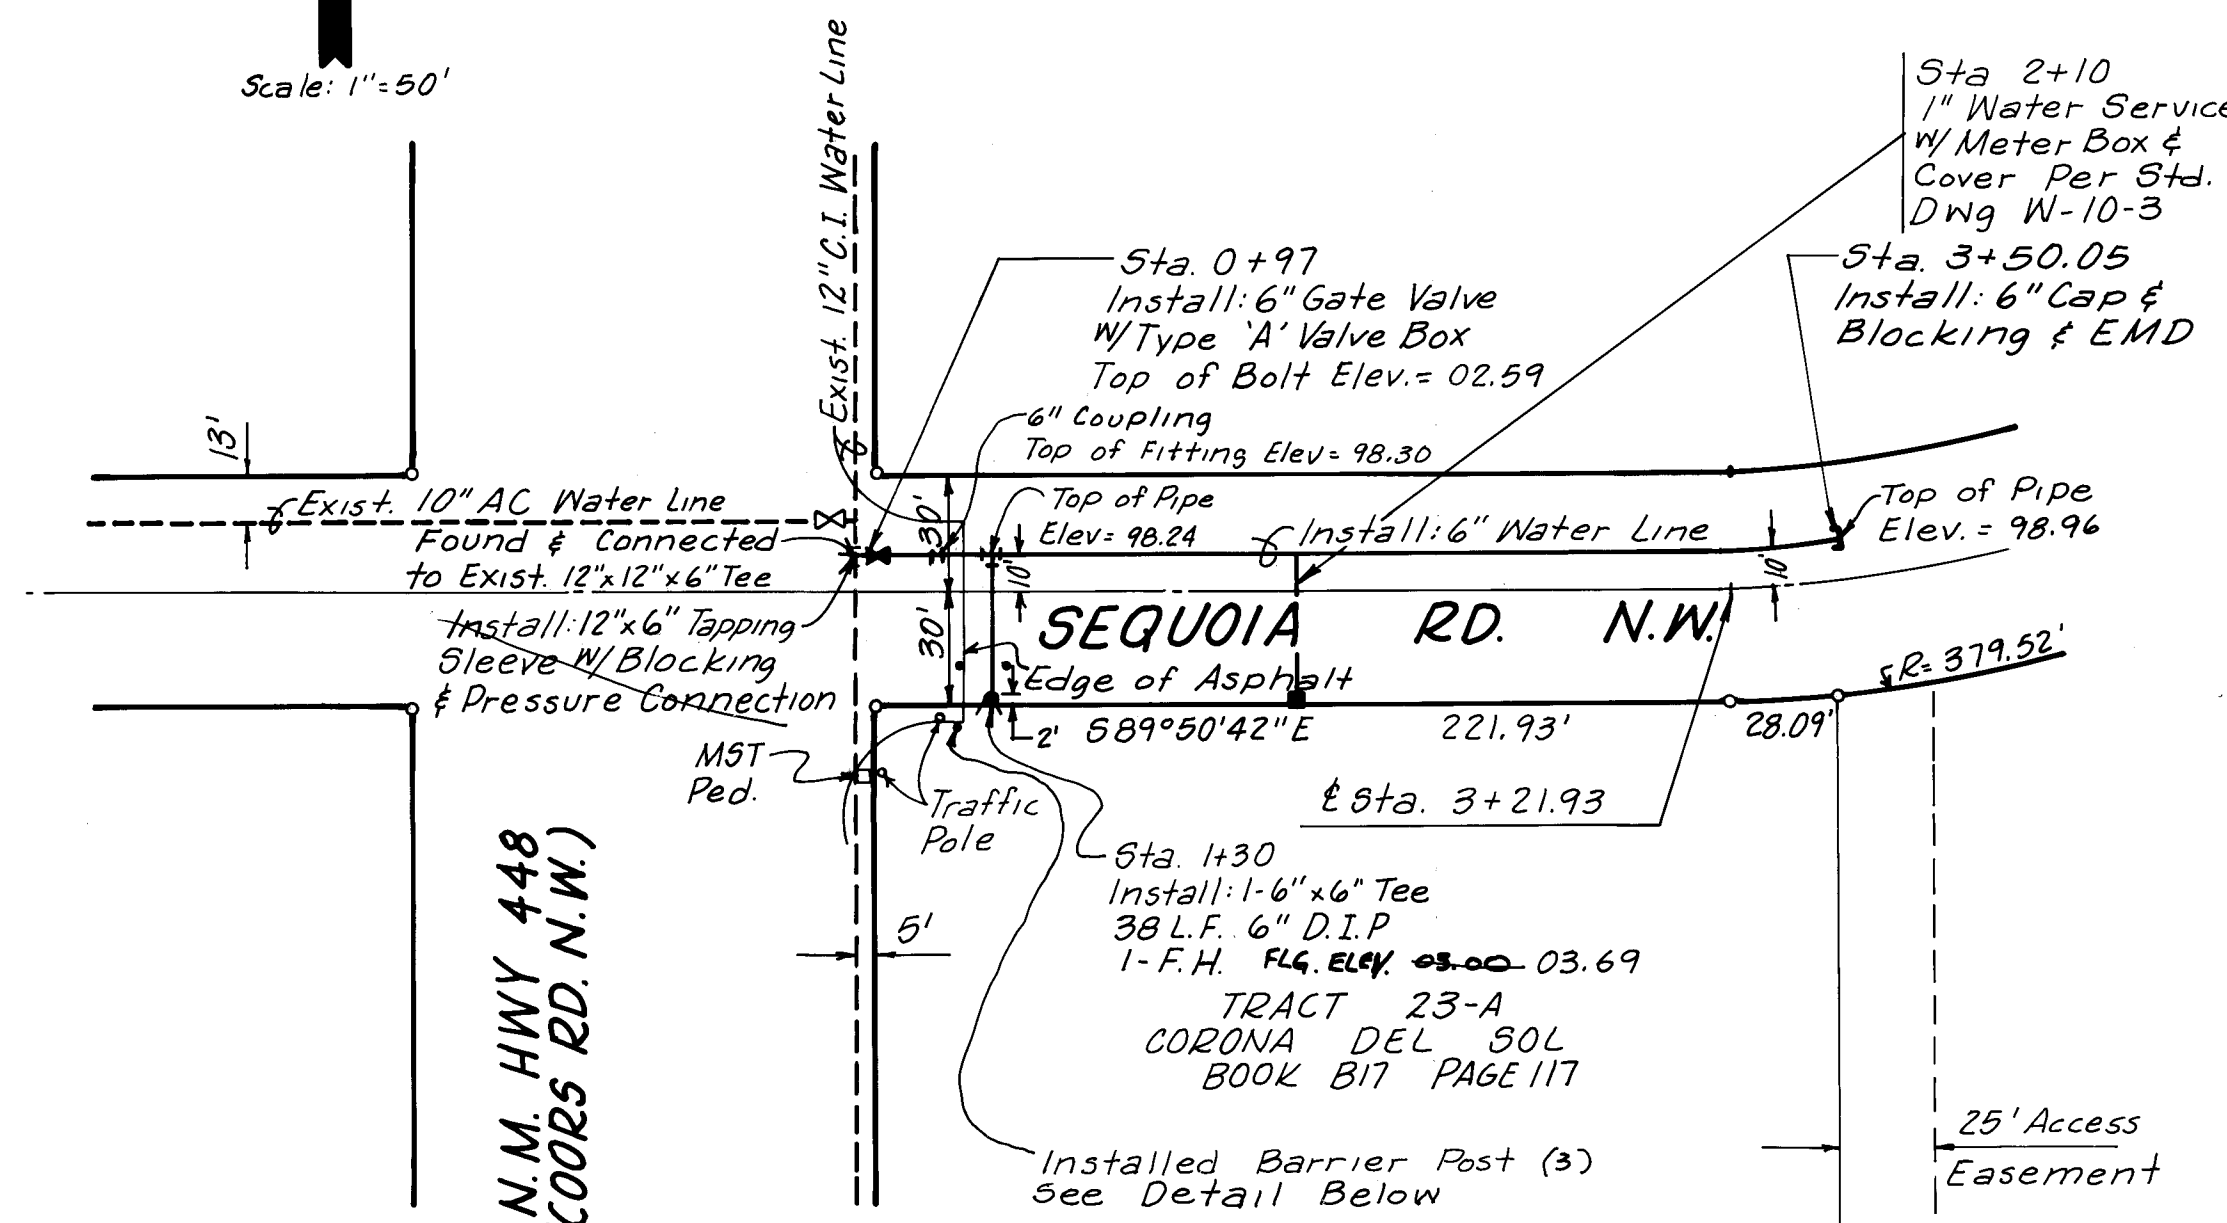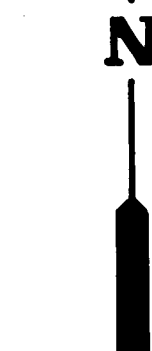

SEQUOIA ROAD N.W.

Vertical: 1"=10'
Horizontal: 1"=50'

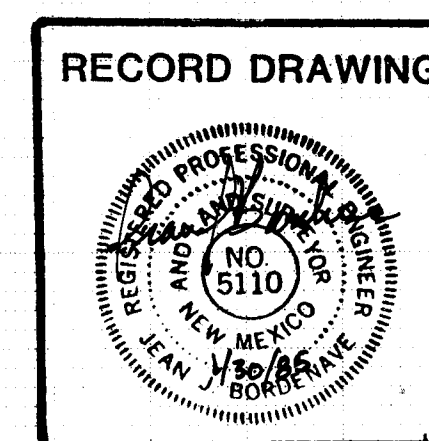

PLANS PREPARED UNDER THE DIRECTION OF	
APPROVED FOR CONSTRUCTION	
CITY ENGINEER	DATE

CITY OF ALBUQUERQUE MUNICIPAL DEVELOPMENT DEPARTMENT ENGINEERING DIVISION			
TITLE: COORS ROAD SANITARY SEWER WATER AND SEWER P&P			
APPROVALS	ENGINEER	DATE	APPROVALS
City Engineer	<i>[Signature]</i>	5/14/80	Liquid Waste
A.C.E. Design	<i>[Signature]</i>	5/14/80	Traffic
A.C.E. Hydrology	<i>[Signature]</i>	5/14/80	Water
DRAWING NO.		SHEET 2 OF 2	

AS BUILT INFORMATION			
CONTRACTOR	WORK	DATE	DATE
ACS NM 448-N3	5099.527	5/14/80	5/14/80
BENCH MARKS			
ACS NM 448-N3	Elev. 5099.527	DATE	DATE
9th. NMSHC Brass Tablet in conc. mon.	DATE	DATE	DATE
on East side Coors Rd. at West Mesa Blvd.	DATE	DATE	DATE
(Source: ACS BL; Pg. C-104 with no revisions)	DATE	DATE	DATE
TBM	Elev. 5102.044	DATE	DATE
Chiseled Square in top of curb in SE corner	DATE	DATE	DATE
of Ladera Shopping Center parking lot at	DATE	DATE	DATE
N.E. corner of Security Federal.	DATE	DATE	DATE

REFERENCES	NO.	DATE	BY
MAP NO. G-11	EST. NO.	W.O. NO.	NO.
5120			
5110			
5100			
5090			

REVISIONS	NO.	DATE	REMARKS
1			
2			
3			
