


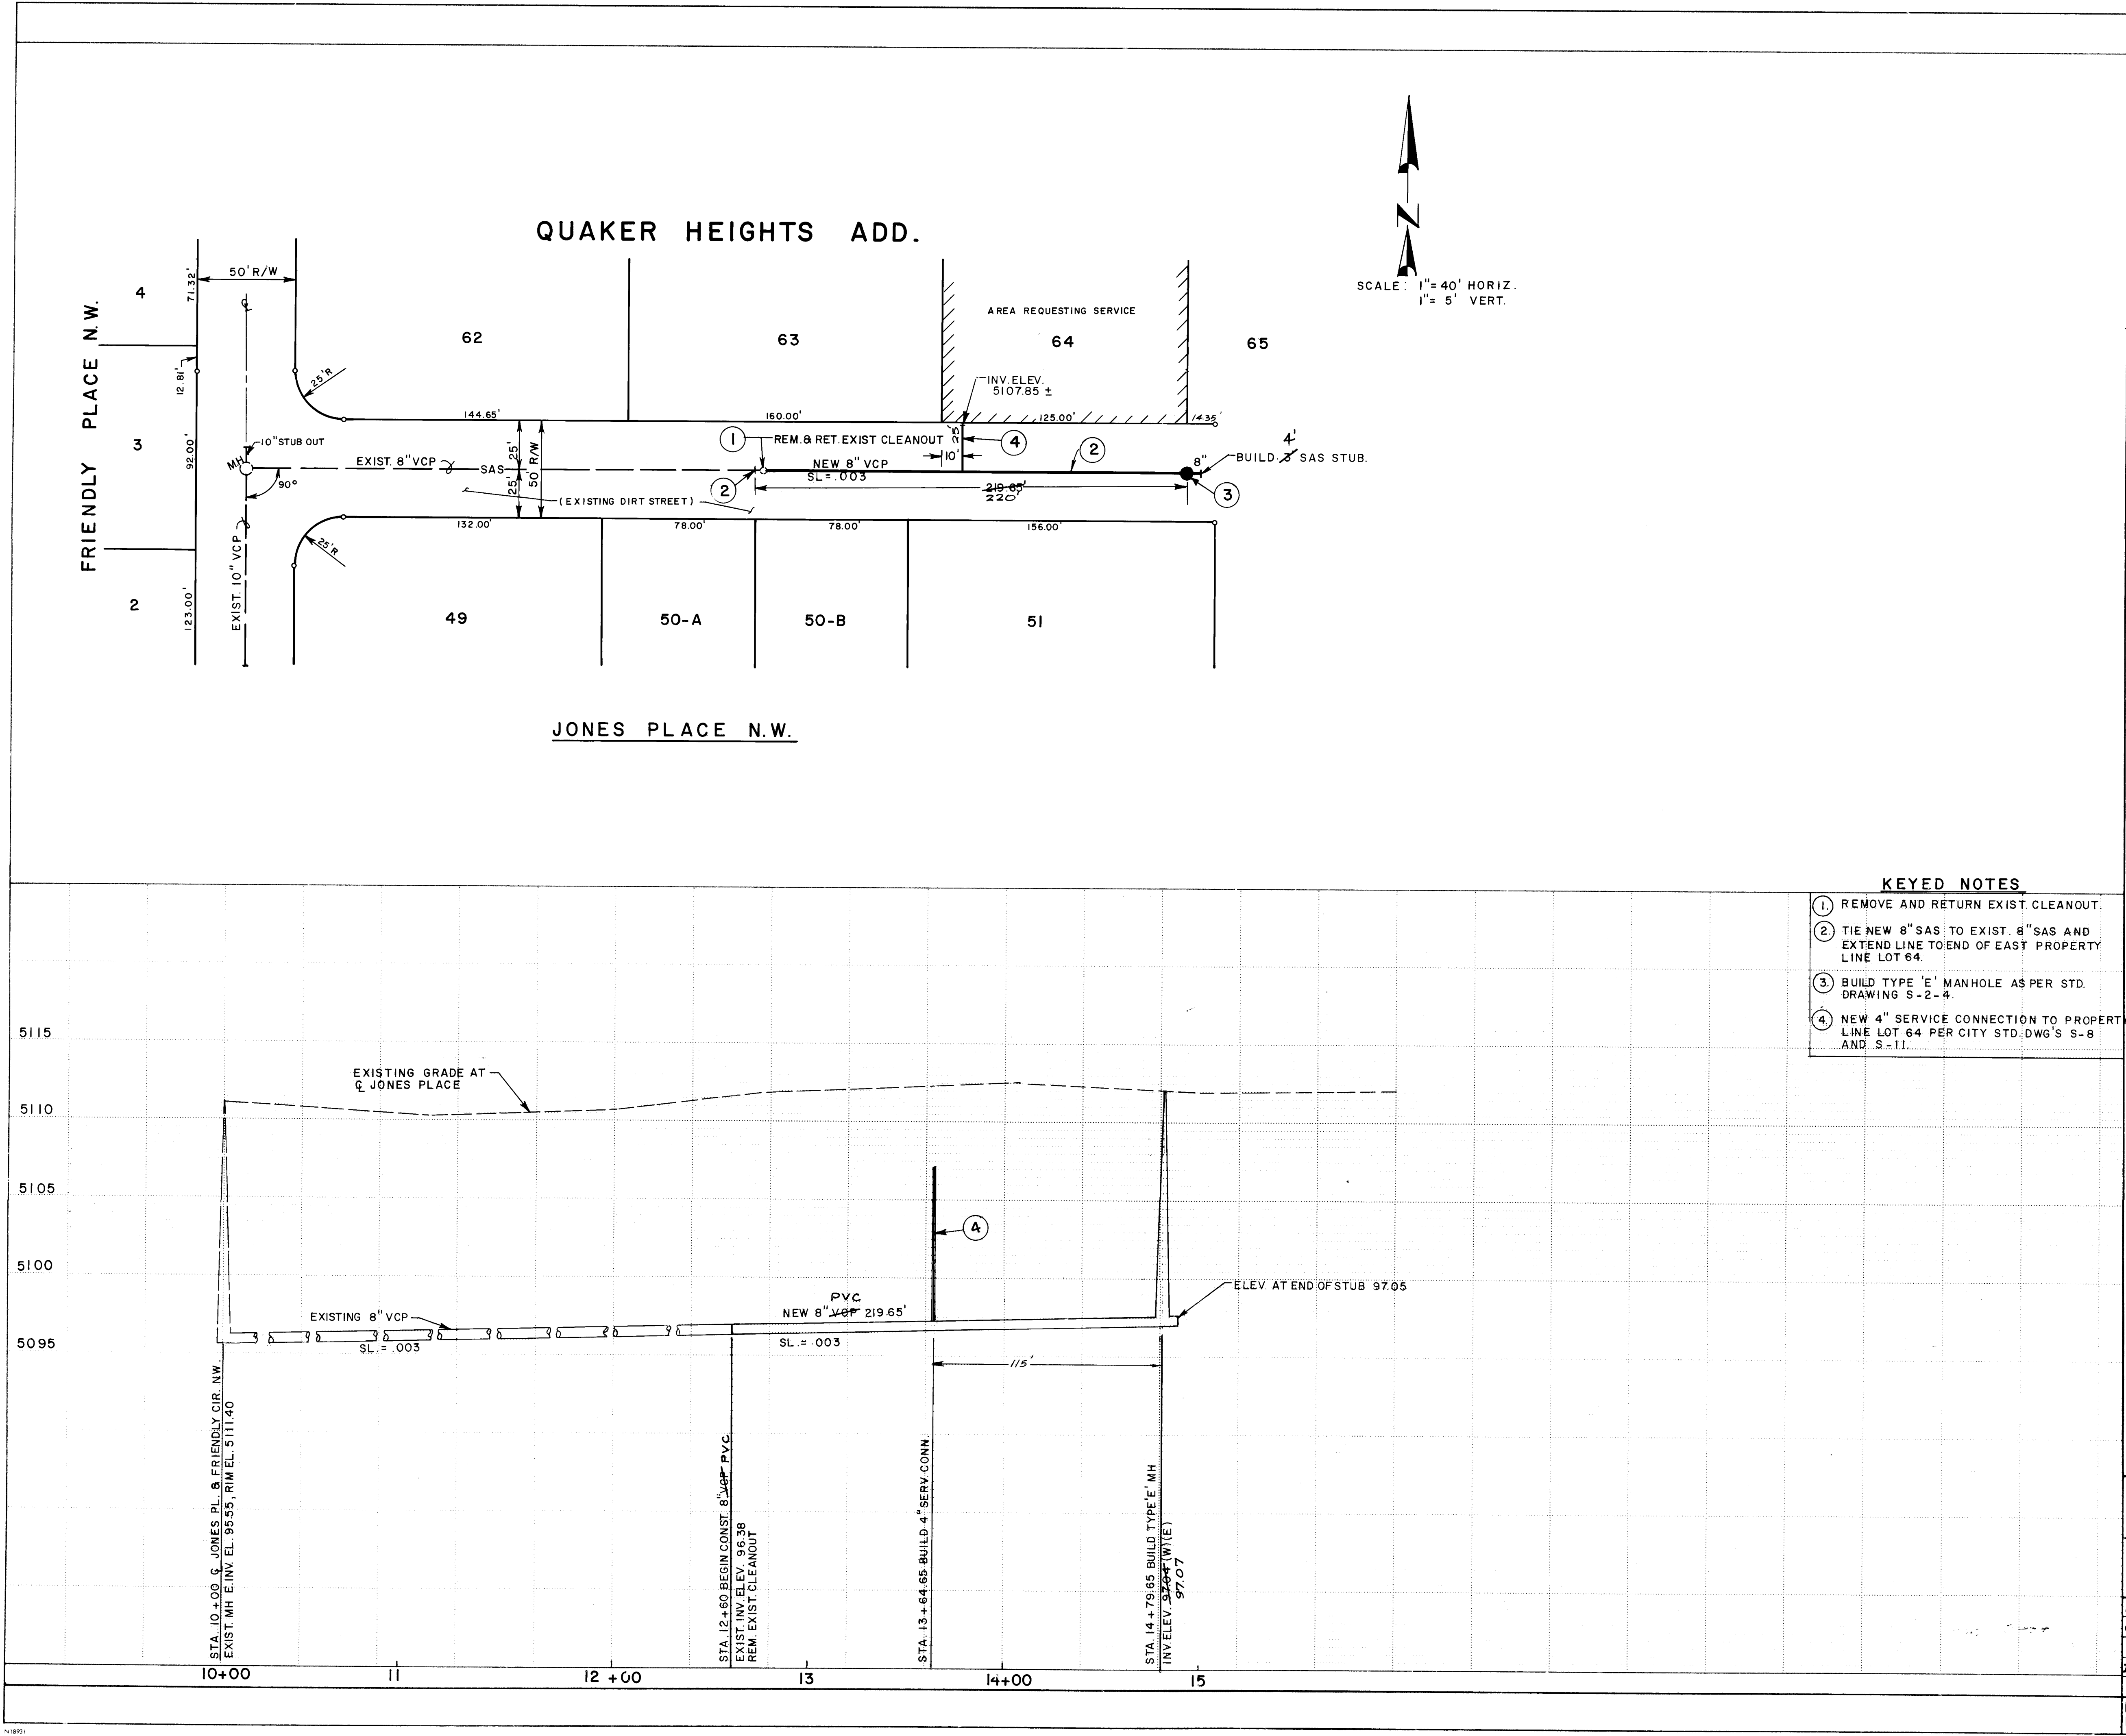

NOTICE TO CONTRACTORS

1. All work detailed on these plans to be performed under contract shall, except as otherwise stated or provided for hereon, be constructed in accordance with the New Mexico Standard Specifications for Public Works Construction - 1979 Edition (referred to herein as the 'Standard Specifications') and the Contract Documents for Public Works Contract 84-2.

2. Two (2) working days prior to any excavation, the contractor must contact Line Locating Service, 765-1234, for location of existing utilities.

3. Prior to construction, the contractor shall excavate and verify the horizontal and vertical locations of all obstructions. Should a conflict exist, the contractor shall notify the engineer or surveyor so that the conflict can be resolved with minimum amount of delay.

KEYED NOTES

1. REMOVE AND RETURN EXIST. CLEANOUT.

2. TIE NEW 8" SAS TO EXIST. 8" SAS AND EXTEND LINE TO END OF EAST PROPERTY LINE LOT 64.

3. BUILD TYPE 'E' MANHOLE AS PER STD. DRAWING S-2-4.

4. NEW 4" SERVICE CONNECTION TO PROPERTY LINE LOT 64 PER CITY STD. DWG'S S-8 AND S-11.

Legend

— EXISTING SANITARY SEWER

— NEW 8" SANITARY SEWER

○ EXISTING MANHOLE

● NEW MANHOLE

26 12/89 01/85

APPROVAL OF AS BUILT DRAWINGS

ASST. CITY ENGINEER - FIELD

W. J. P. [Signature]

DATE 5-23-85

26 12/89 01/85

AS BUILT INFORMATION

CONTRACT NO. 84-2

ENGINEER BY [Signature]

DATE 12/89

FILED NAME BY M. NEPHEW

DATE 12/89

REVISION BY [Signature]

DATE 12/89

MICRO-FILM INFORMATION

NO. 448-NS

DATE 12/89

BENCH MARKS

NAIL AT BASE P.P. 100 ± NORTH OF WESTERN TR. AND W. SIDE FRIENDLY PL. ELEV. 5111.85

ORIGIN: NM 448-NS LOCATED 4.5 MILES NW OF DOWNTOWN ALBUQ. AT THE INTERSECTION OF COORS. RD. (N) AND WESTERN TRAIL. A BRASS TABLET STAMPED "NM 448-NS" ELEV. 5105.202

SURVEY INFORMATION

FIELD NOTES

DATE

BY

NO.

ENGINEER'S SEAL

NO.

DATE

REMARKS

DESIGN

DESIGNED BY P. FISCHER

DRAWN BY D. ZAMORA

CHECKED BY

CITY OF ALBUQUERQUE

MUNICIPAL DEVELOPMENT DEPARTMENT

ENGINEERING DIVISION

TITLE: SANITARY SEWER LINE EXTENSION ON JONES PLACE TO SERVE LOT 64.

APPROVALS	ENGINEER	DATE	APPROVALS	ENGINEER	DATE
City Engineer	[Signature]	12/89	Liquid Waste	R. H. [Signature]	8/10/84
ACE - Design	[Signature]	11/5/84	Traffic	NA [Signature]	8/14/84
Hydrology	NA [Signature]	8/15/84	Water	NA [Signature]	8/10/84

DRAWING NO. 2189

MAP NO. F-11

SHEET 1 OF 1