


PLAN	DATE	BY
SURVEYED		
PLOTTED		
NOTE BOOK		
NO.		

SCALE 1" = 20' HORIZ.
1" = 5' VERT.

MAP NO. J-19

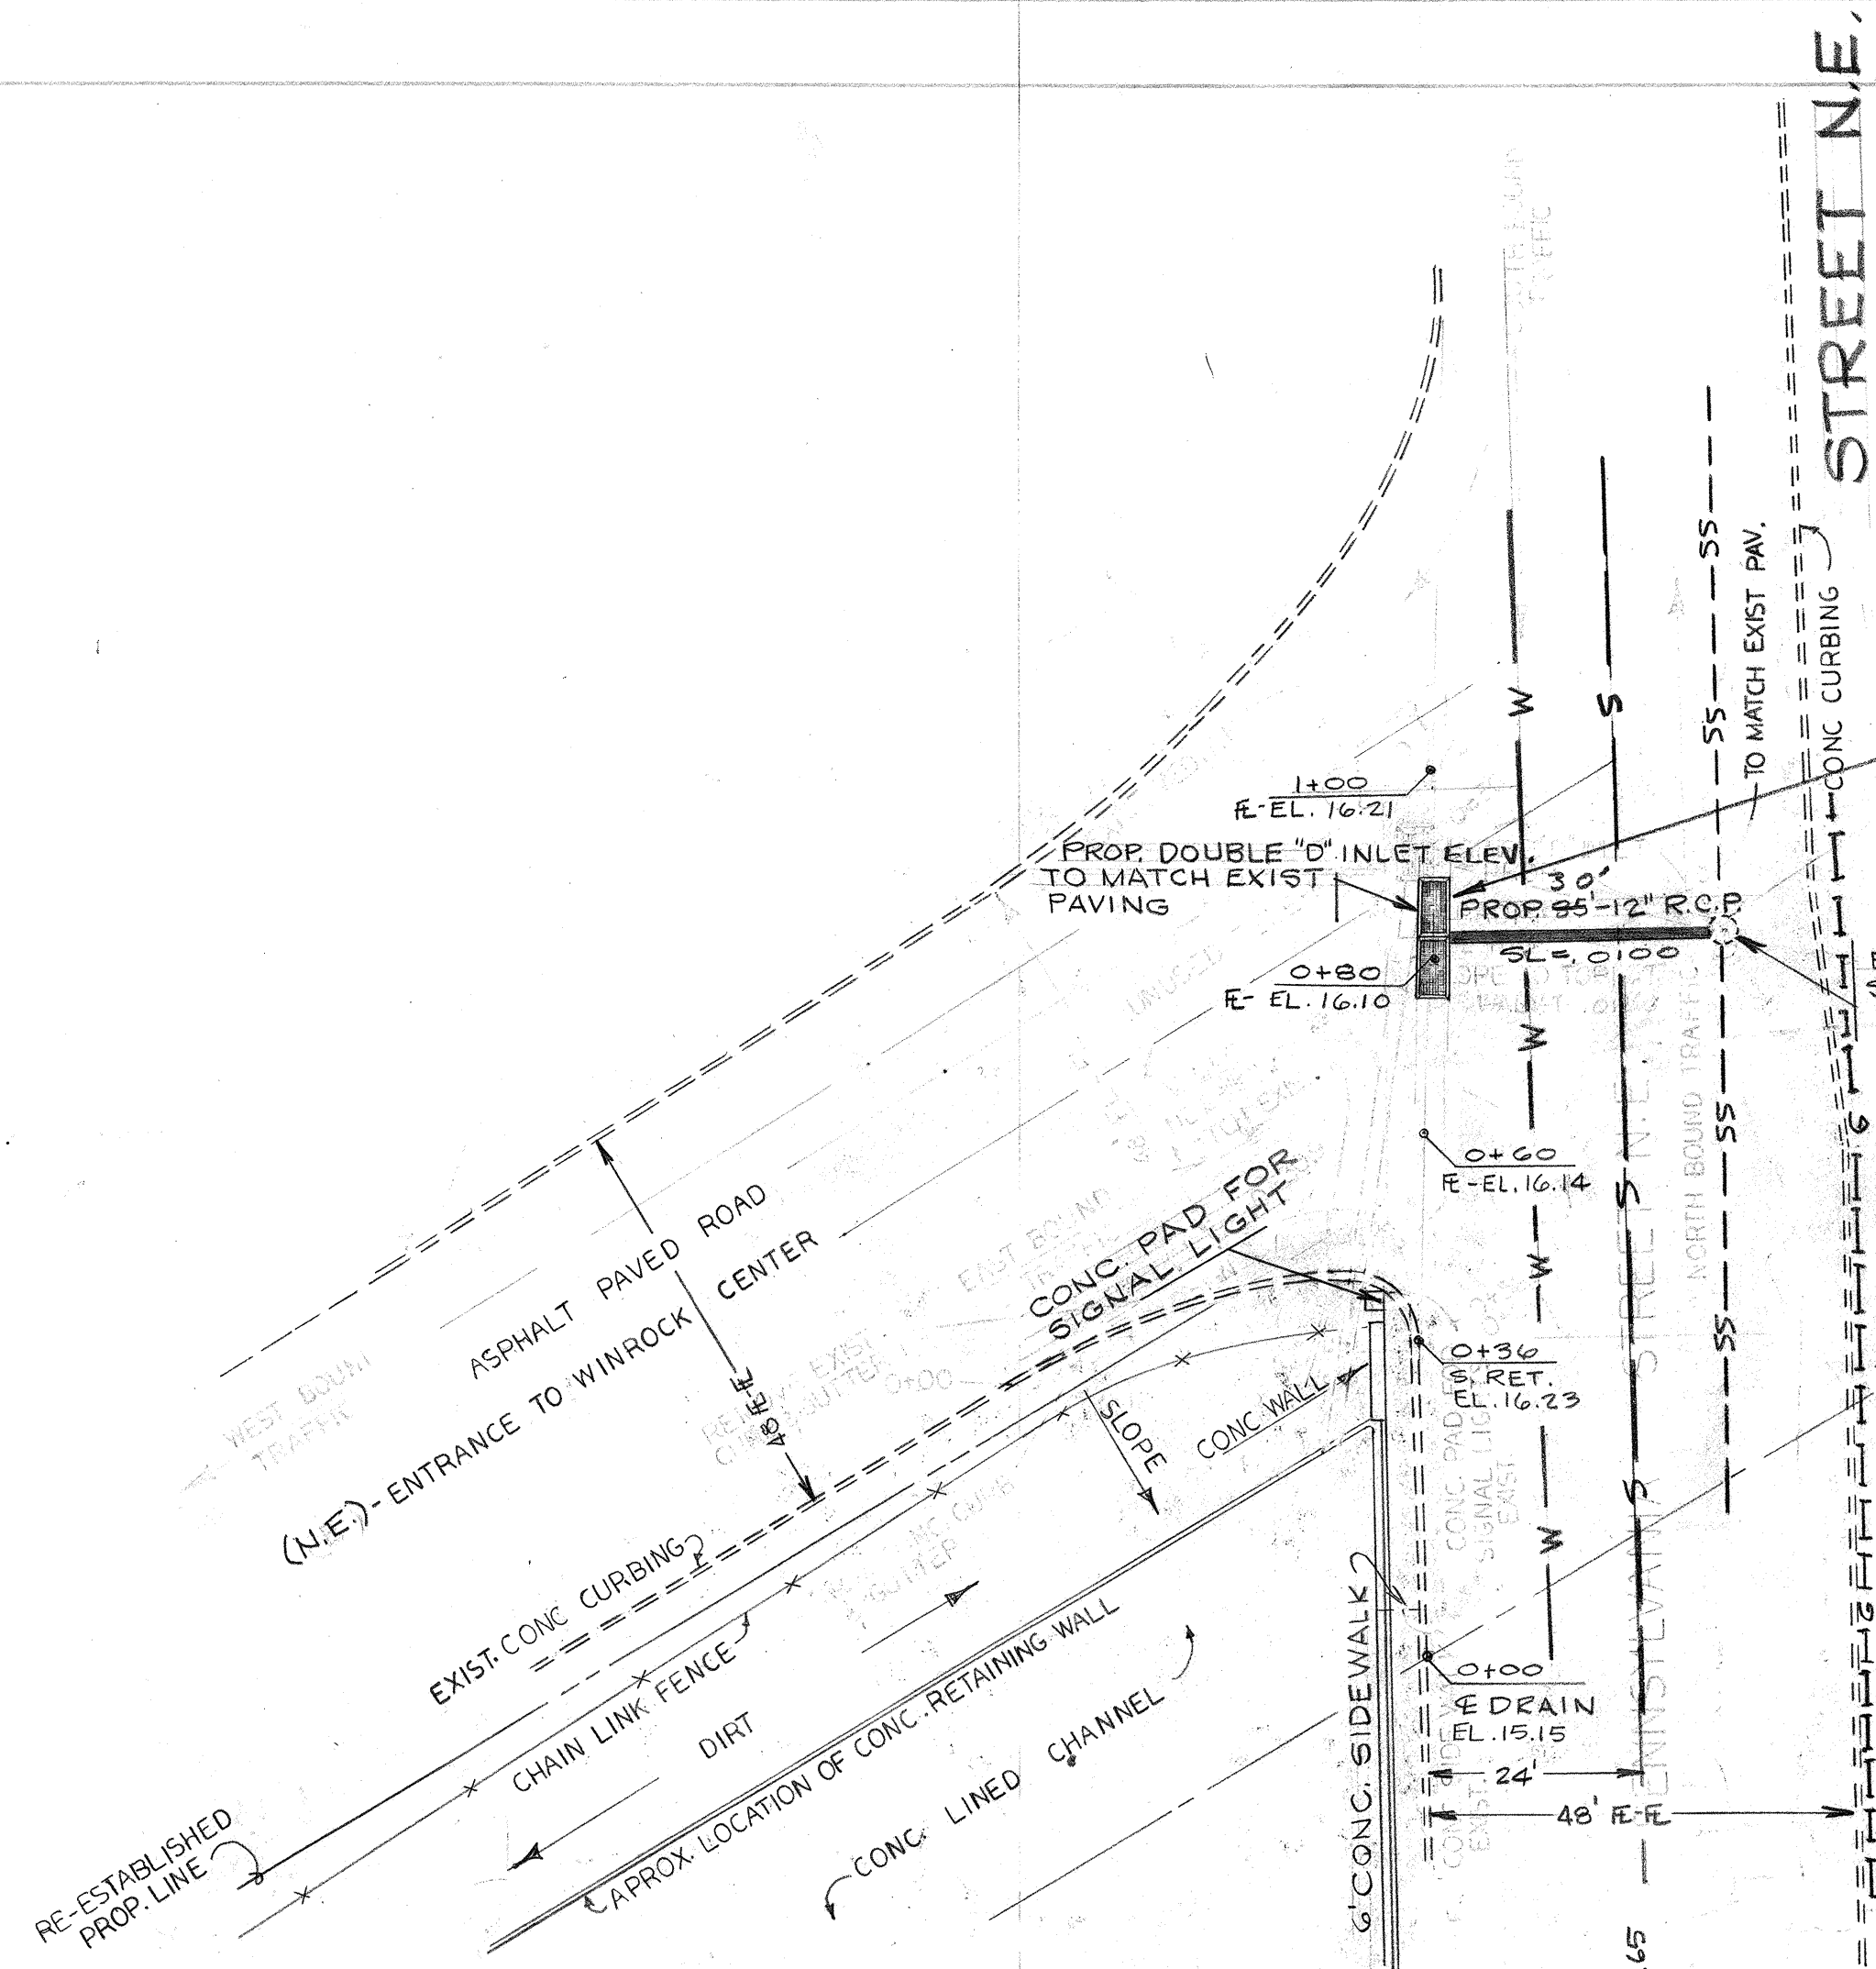

- NOTE:
1. SEE CITY STANDARD PAGE 217 FOR CONSTRUCTION OF INLET
 2. CAUTION BURIED TRAFFIC LIGHT and FIRE ALARM CABLE IN SAME AREA.

BENCHMARK:

NAIL AT BASE OF R.P. 120' SOUTH OF DRAIN EL. 5316.14

54 L.F.
57 L.F.
1 00.
70' L.F.
25 SY

LEGEND

- W — Existing Water Line
- SS --- Existing Storm Sewer
- S — Existing Sanitary Sewer
- ||||| Existing Gas Line

PROFILE	DATE	BY
SURVEYED		
PLOTTED		
NOTE BOOK		
NO.		

"AS STAKED"

1	2	3	4	5	6	7	8	9	10	11	12	13	14	15	16	17	18	19	20	21	22	23	24	25	26	27	28	29	30	31
22	01	2	01	75																										

GENERAL REVISIONS		RECORDED BY
NO.	DATE	REMARKS
REVISIONS		
CITY OF ALBUQUERQUE PUBLIC WORKS DEPARTMENT ENGINEERING DIVISION		
TITLE PROPOSED DROP INLET and GUTTER, PENNSYLVANIA ST AT SOUTH ENTRANCE TO WINROCK SHOPPING CENTER		
DESIGNED BY	DRAWN BY	AS BUILT
TITLE	TITLE	SUBMITTED BY
DATE	DATE	DATE
APPROVAL		
ASS'T CITY ENGINEER	CITY ENGINEER	RECORDED BY
DATE	DATE	DATE
WATER ENGINEER	LIQUID WASTE ENGINEER	SHEET NO.
DATE	DATE	OF SHEETS
DRAWING NUMBER	SS-12-75 Rev. 1	