
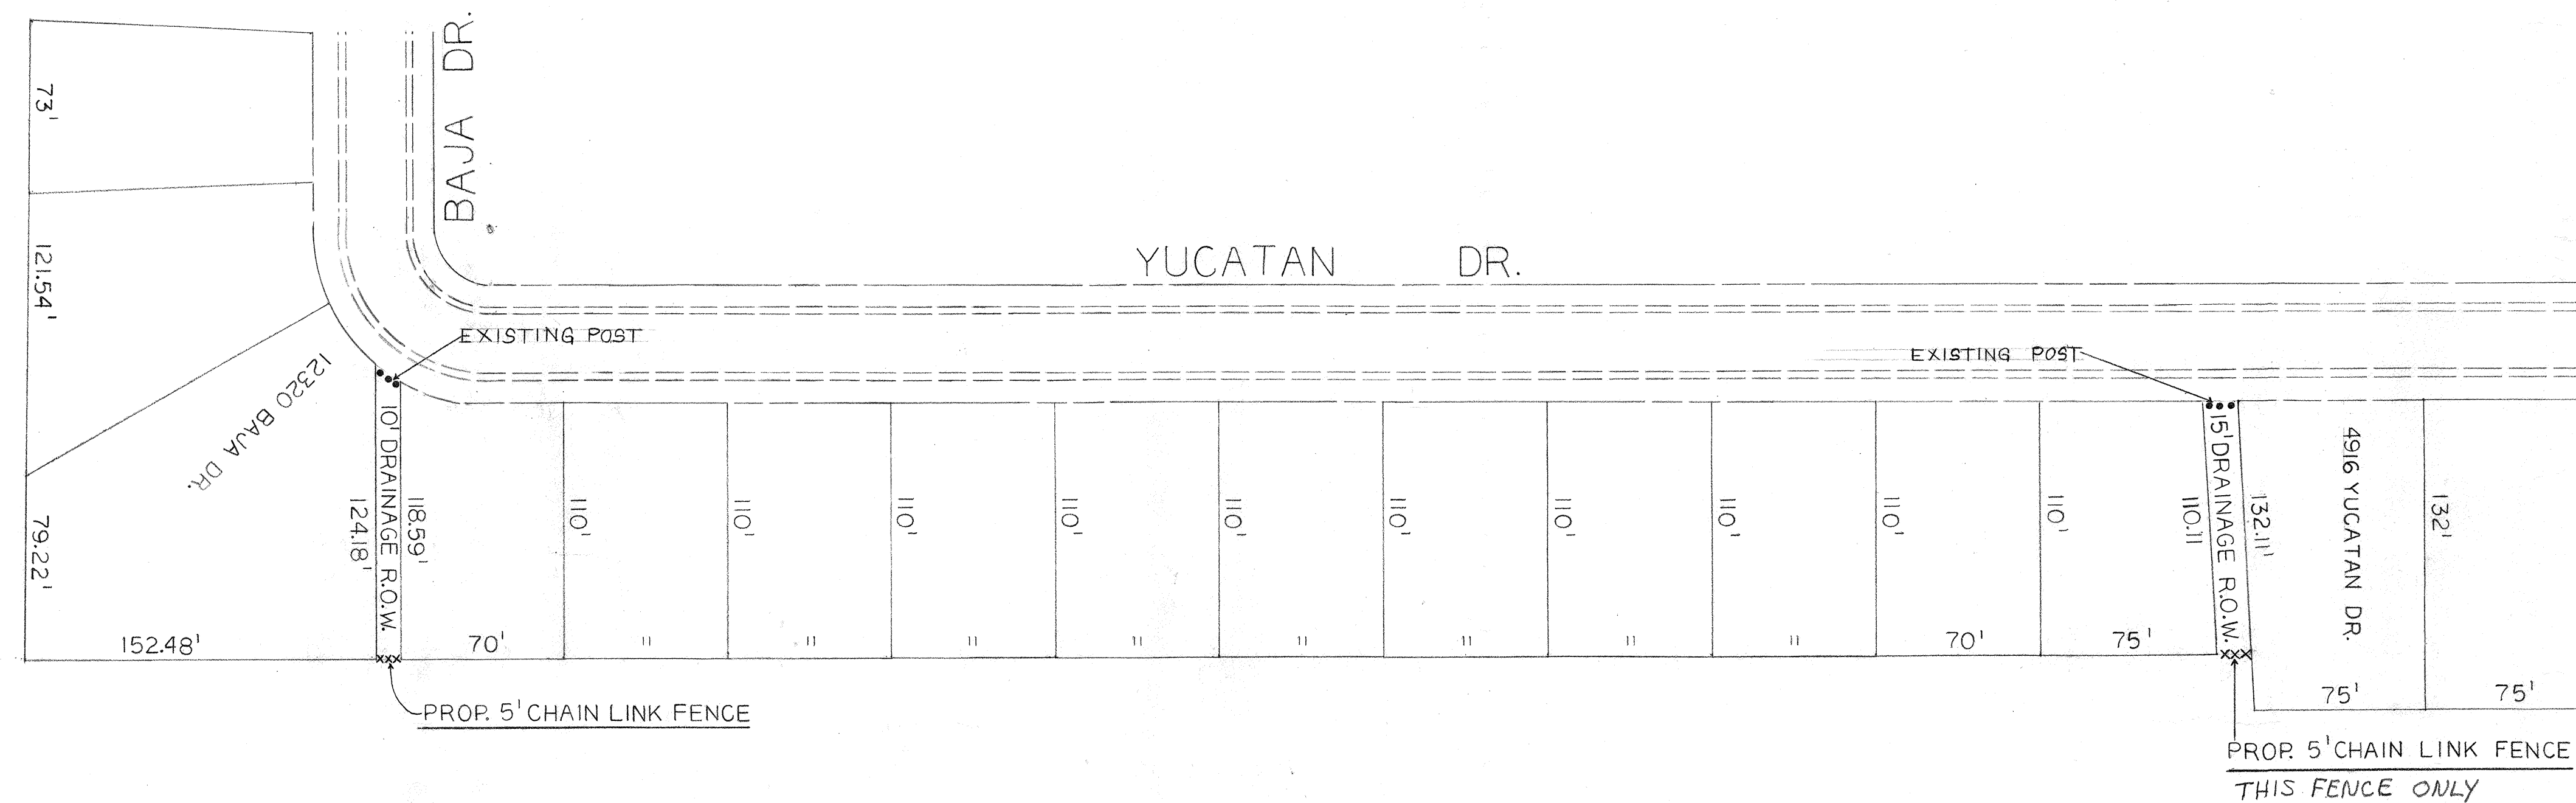


SCALE 1" = 50'

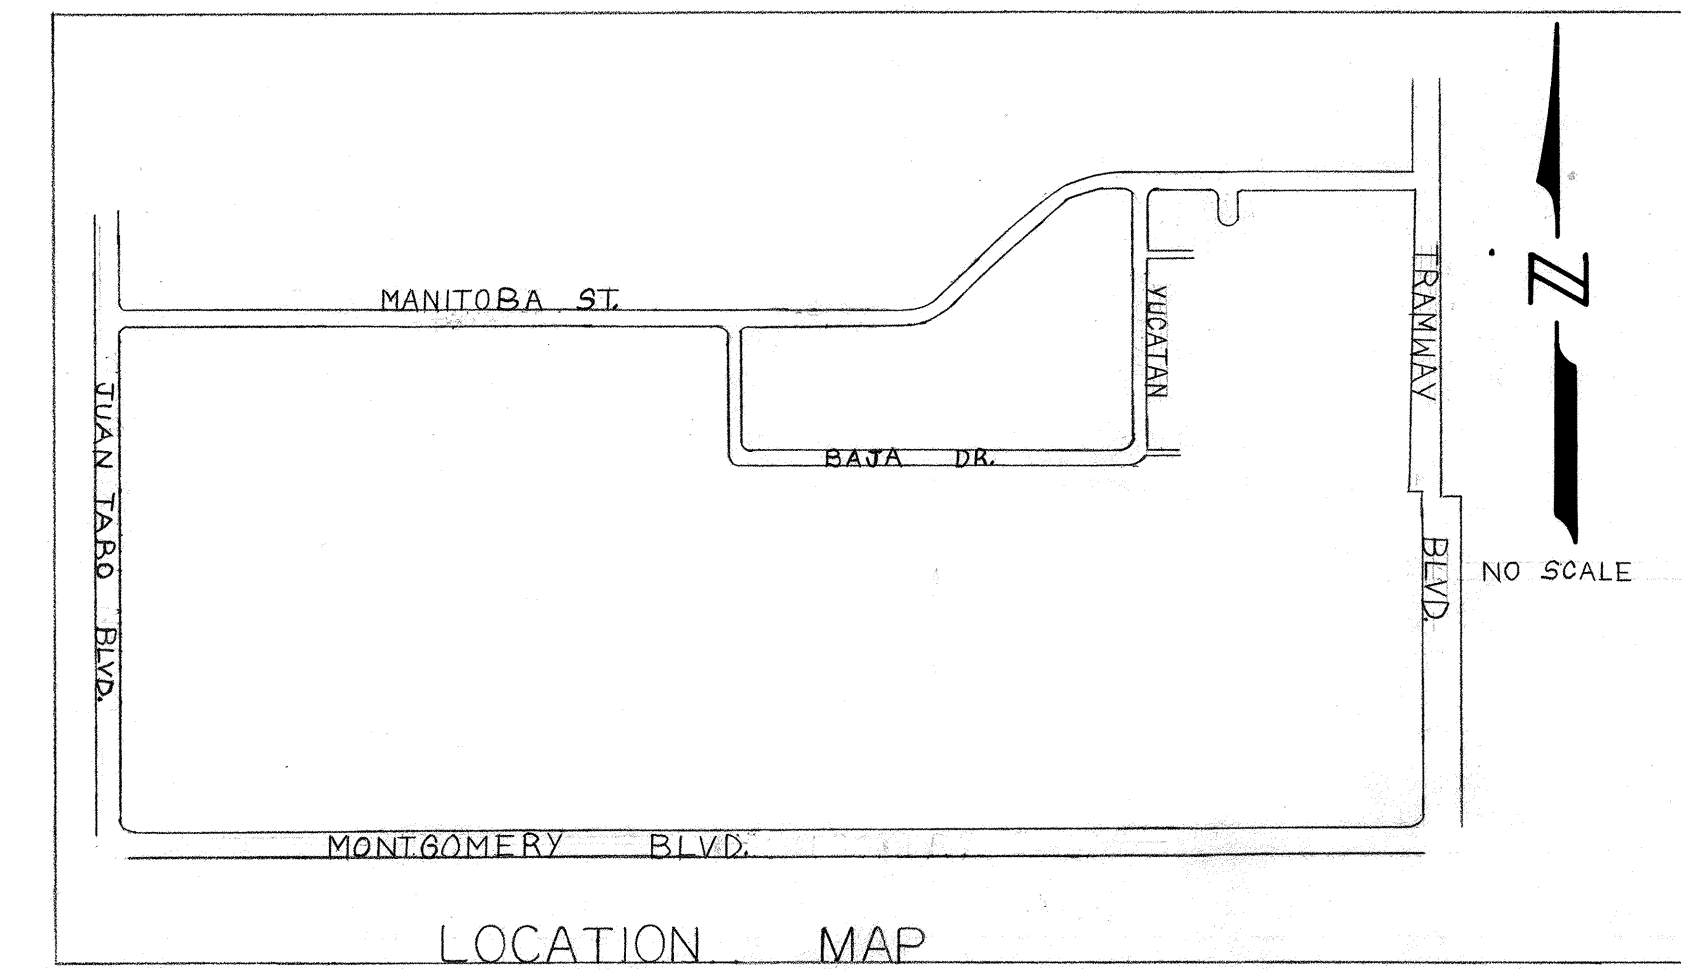

APPROVAL OF AS BUILT DRAWINGS
ASST. CITY ENGINEER - FIELD
M. Kearney
DATE *10-7-82*

1	2	3	4	5	6	7	8	9	10	11	12
2	2		0	1	2		0	1	7	8	

APPROVED FOR
CONSTRUCTION

 5-3-78

CITY ENGINEER DATE

CITY OF ALBUQUERQUE PUBLIC WORKS DEPARTMENT ENGINEERING DIVISION					
TITLE: PROPOSED CHAIN LINK GATE FOR DRAINAGE R.O.W. ON BAJA DR. AND YUCATAN DR.					
APPROVALS	ENGINEER	DATE	APPROVALS	ENGINEER	DATE
City Engineer	<i>[Signature]</i>	5-9-78	Liquid Waste		
A.C.E.-Design	<i>[Signature]</i>	3 May 78	Traffic		
A.C.E.-Hydrology			Water		
DRAWING NO.			SHEET OF		