


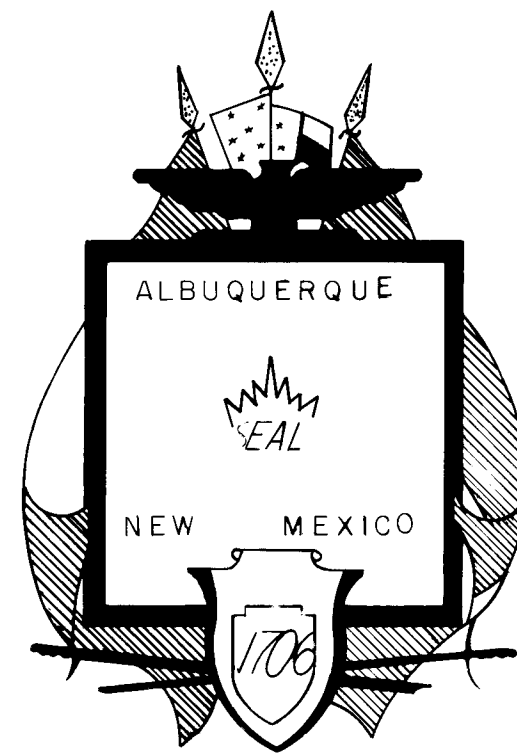


CITY OF ALBUQUERQUE, NEW MEXICO

THE J. GROUP ADDITION

SANITARY SEWER EXTENSION

OCTOBER 1984

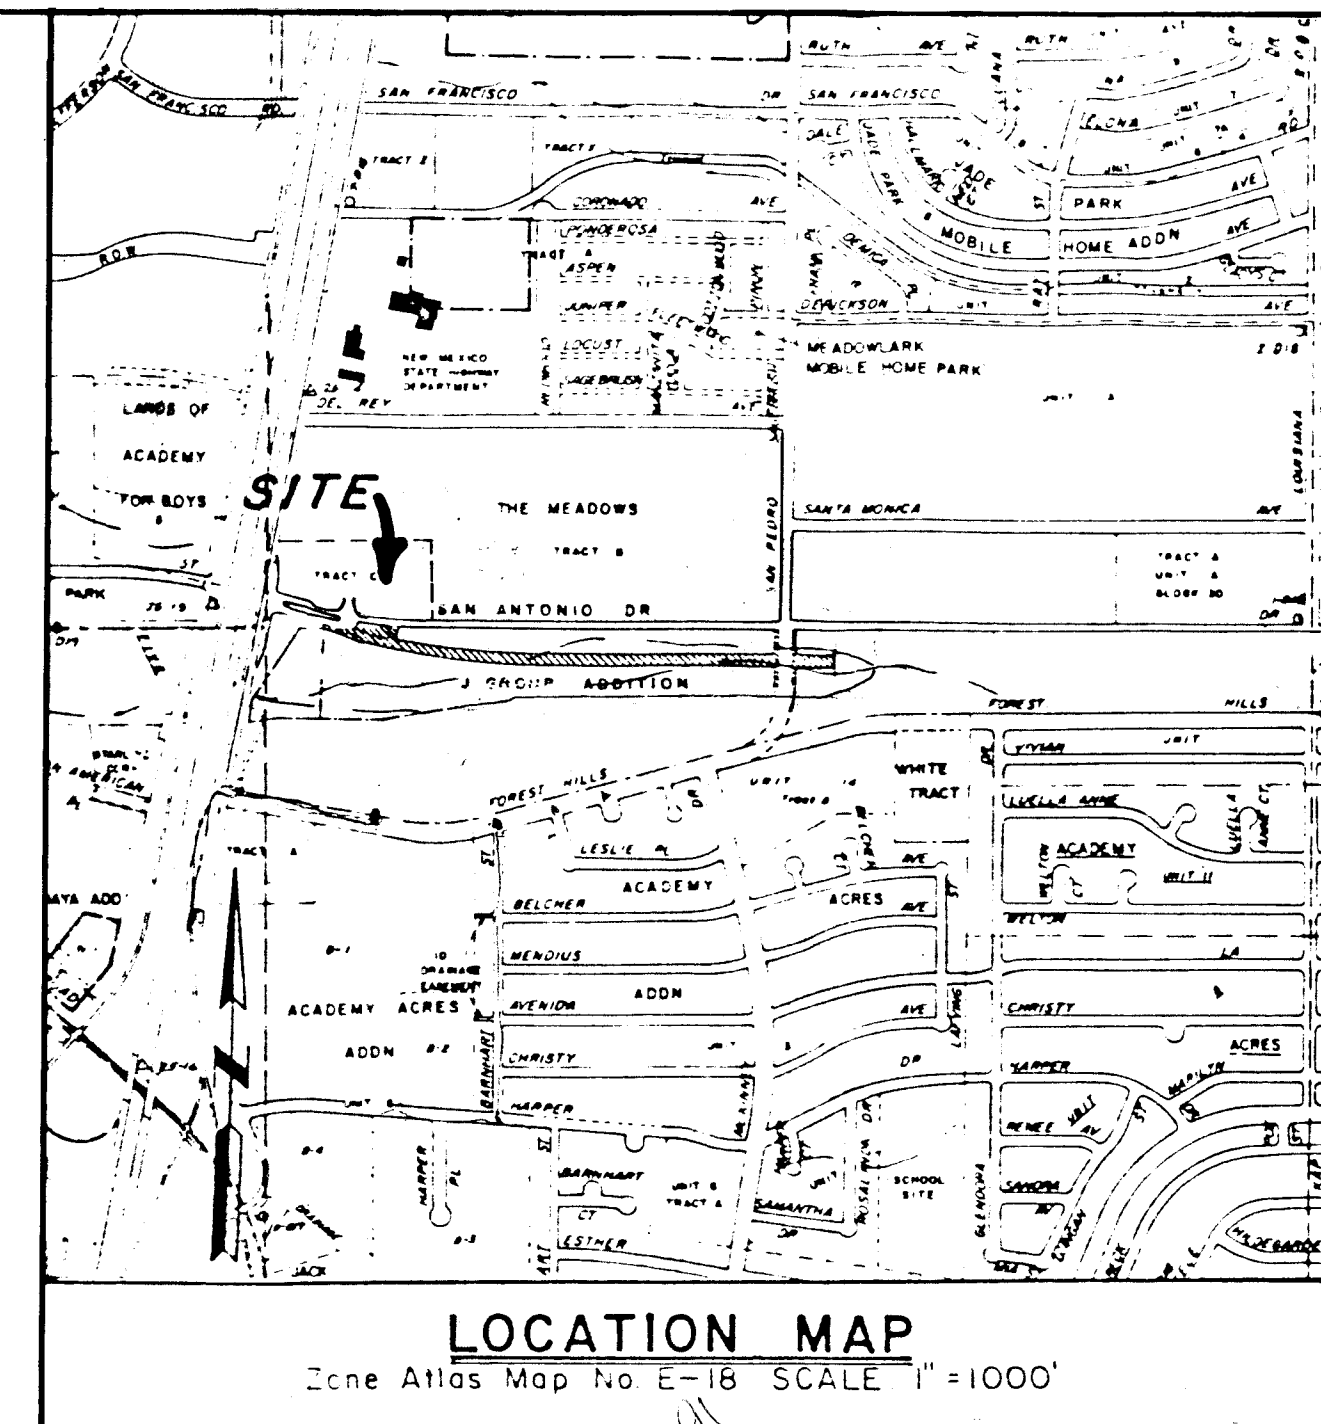

2 1 6 2 2 0 3 0 1 8 5


APPROVAL OF AS BUILT DRAWINGS
W.F. Myer
DATE 7-16-85

REV.	SHEETS	CITY ENGR	DATE	USER OF PT	DATE	USER DEPT	DATE

APPROVAL OF REVISIONS



DENNEY-GROSS & ASSOCIATES, INC.
ENGINEERS-PLANNERS
ALBUQUERQUE, NEW MEXICO 87107

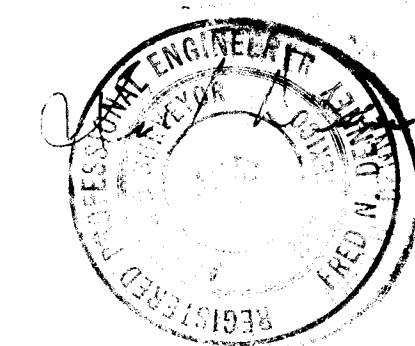

DENNEY-GROSS & ASSOC., INC.
ENGINEERS SURVEYORS PLANNERS
2400 COMANCHE RD. N.E., ALBUQ. N.M. 87107
(505) 884-0696

APPROVED FOR
CONSTRUCTION

C. D. Huppert
3/15/85 C.E.

2203

SHEET 1 OF 2

D.G.A. JOB NO. 745.11



- ## NOTES

- ① This project to be completed prior to paving of San Antonio by NMSHD. If paving precedes SAS construction revised Plan & Estimate will be required.
- ② Contractor must submit a traffic control plan and receive a barricading permit prior to construction. Coordinate traffic control, construction with NMSHD project I-25 Frontage Roads.



ENGINEER'S SEAL		SURVEY INFORMATION		BENCH MARKS		AS BUILT INFORMATION	
		FIELD NOTES					
		NO.	BY	DATE			
Δ	6/24/85	Remarks from Inspector's Mark-up			WORK DONE BY	CONTRACTOR	
					INSPECTOR'S		
					ACCEPTANCE BY	DATE	
					FIELD VERIFICATION BY	DATE	
					DRAWINGS	DATE	
					CORRECTED BY	DATE	
				MICRO-FILM INFORMATION			
				RECORDED BY			
				DATE			
				ON TOP OF A CONCRETE POST FLUSH WITH THE GROUND.			

26 22030285

CITY OF ALBUQUERQUE
MUNICIPAL DEVELOPMENT DEPARTMENT
ENGINEERING DIVISION

TITLE: THE J GROUP ADDITION
SANITARY SEWER EXTENSION

APPROVALS	ENGINEER	DATE	APPROVALS	ENGINEER	DATE
City Engineer	<i>C. A. Hays</i>	<i>12/19/84</i>	Liquid Waste	<i>V. Balch</i>	<i>12/19/84</i>
A C E - Design	<i>A. Wilson</i>	<i>1/24/85</i>	Traffic	<i>N. D. H.</i>	<i>12/19/84</i>
ACE - Hydrology	<i>N. A. B. B.</i>	<i>12/19/84</i>	Water	<i>V. Balch</i>	<i>12/19/84</i>

DRAWING NO.	2203	MAP NO.	F - 18	SHEET	2	OF	2
-------------	------	---------	--------	-------	---	----	---