


CITY OF ALBUQUERQUE
NEW MEXICO

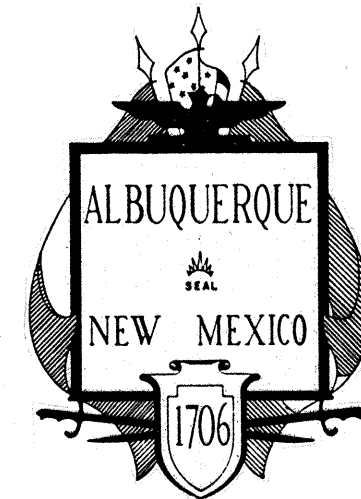

EAGLE RANCH STORMDRAIN

COLLECTOR STORMSEWER
W/ TEMPORARY INLETS & DESILTING PONDS

AUGUST, 1985

BELLAMAH COMMUNITY DEVELOPMENT

INDEX TO DRAWINGS

SHEET NO.	DESCRIPTION
1	TITLE SHEET
2 & 3	PLATS
4 - 7	EAGLE RANCH ROAD STORMDRAIN - PLANS & PROFILE
8	GRADING PLAN - PERMANENT DETENTION POND & TRACT 13
9 & 10	EAGLE RANCH ROAD STORMDRAIN - PLAN & PROFILE
11	IRVING BLVD. STORMDRAIN - PLAN
12	IRVING BLVD. STORMDRAIN - PROFILE & OUTLET DETAILS
13	INLET STRUCTURE DETAILS - PERMANENT DETENTION POND
14 - 16	EAGLE RANCH ROAD STORMDRAIN - OUTLET STRUCTURE DETAILS
17	TYPICAL DETAILS - DESILTING POND STRUCTURES
18	TYPICAL R.C.P. DETAILS
19	STORMDRAIN MANHOLE DETAILS


RECORD DRAWINGS

THESE DRAWINGS HAVE BEEN
REVISED IN ACCORDANCE
WITH INFORMATION PROVIDED
BY COMMUNITY SCIENCES
CORP., HUGG SURVEYING CO.
AND EASTERLING & ASSO-
CIATES, INC. TO REFLECT
THE CONSTRUCTION AS
ACCOMPLISHED.



CONSTRUCTION SAFETY

These drawings do not include
necessary components for con-
struction safety which shall
remain the contractor's
responsibility.

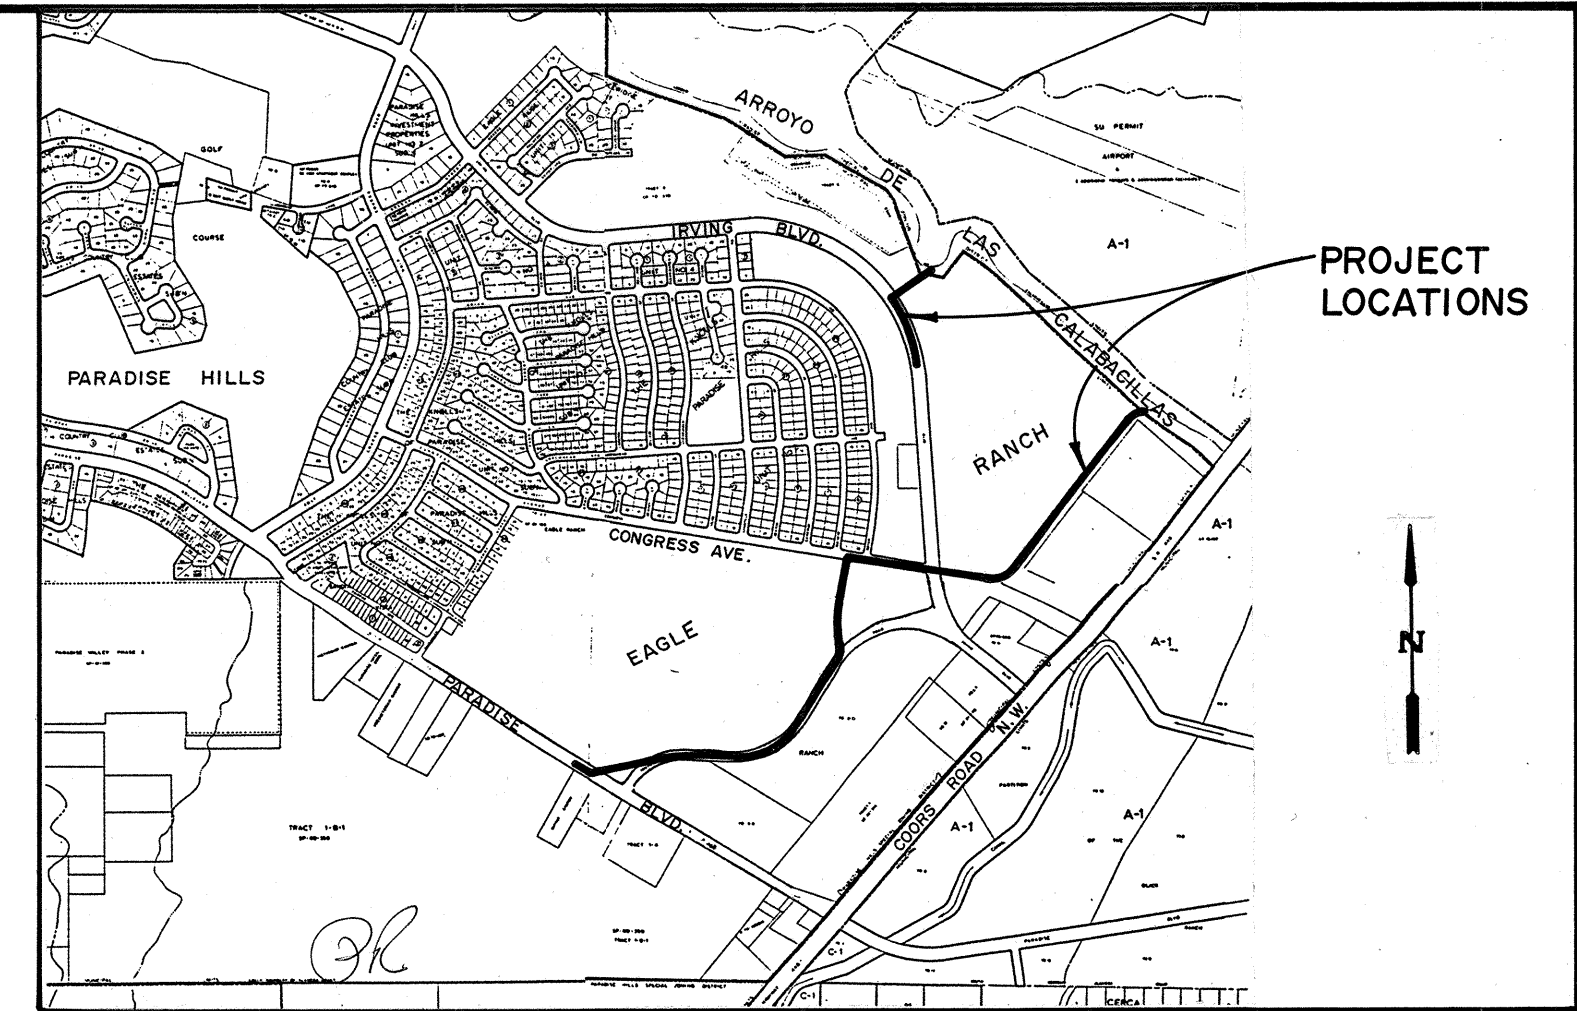

VICINITY MAP


CITY MAP NOS. B-13, C-12 & 13

GENERAL NOTES:

GENERAL NOTES:


- All work detailed on these plans to be performed under this Contract shall, except as otherwise stated or provided for in the Special Provisions of the Contract, be constructed in accordance with the City of Albuquerque Interim Standard Specifications - Public Works Construction - 1985 Edition.
- Two (2) working days prior to any excavation, Contractor must contact Line Locating Service, 765-1234, for locating of existing utilities.
- Prior to construction, the Contractor shall excavate and verify the horizontal and vertical locations of all obstructions. Should a conflict exist, the Contractor shall notify the engineer or surveyor so that the conflict can be resolved with minimum amount of delay.
- All utilities and utility service lines shall be installed prior to paving.
- Backfill compaction shall be according to specified street use.
- Tack coat requirements shall be determined by the City Engineer.
- Sidewalks and wheelchair ramps within the curb returns shall be constructed wherever a new curb return is constructed.
- If curb is depressed for a drivepad or a handicap ramp, the drivepad or ramp shall be constructed prior to acceptance of the curb and gutter.
- All storm drainage facilities shall be completed prior to final acceptance.
- Disposal of all waste material shall be the responsibility of the Contractor as specified in Section 6.14 of the General Conditions in the City of Albuquerque Interim Standard Specifications - Public Works Construction - 1985 Edition.
- All construction, inspection, and certification shall be in conformance with the approved Subdivision Improvements Agreement.
- The Contractor shall submit a traffic control plan and receive a barricading permit from the City Traffic Engineer prior to construction within the Paradise Blvd. and Irving Blvd. right-of-ways.

1	2	3	4	5	6	7	8	9	10	11	12
2	6	2	2	0	4	0	1	8	6		

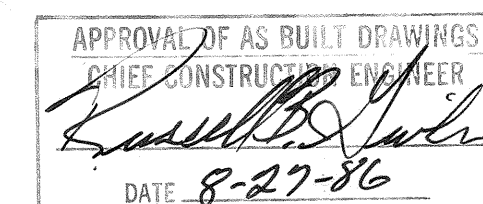


REV.	SHEETS	CITY ENGINEER	DATE	USER	DEPT.	DATE	USER	DEPT.	DATE
APPROVAL OF REVISIONS									



PLANS PREPARED UNDER DIRECTION OF: DATE 6-6-85	EASTERLING & ASSOCIATES, INC. CONSULTING ENGINEERS 5643 PARADISE BLVD. N.W. ALBUQUERQUE, NEW MEXICO 87114 (505) 898-8021 PROJECT NO. 2204	APPROVED FOR CONSTRUCTION CITY ENGINEER 11/1/85 SHEET 1 OF 19
---	---	--

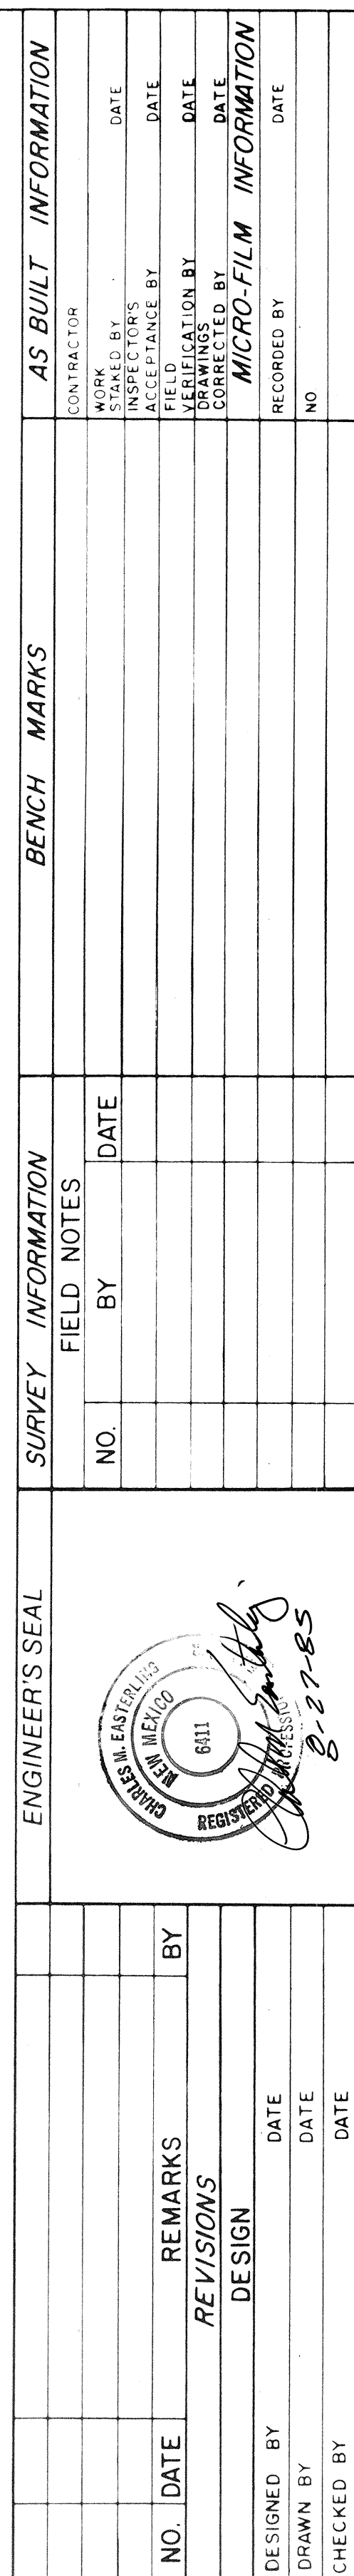

8 THESE DRAWINGS HAVE BEEN
REVISED IN ACCORDANCE
WITH INFORMATION PROVIDED
BY COMMUNITY SCIENCES
CORP., HUGG SURVEYING CO.
AND EASTERLING & ASSO-
CIATES, INC. TO REFLECT
THE CONSTRUCTION AS
ACCOMPLISHED.










TITLE:					
PLAT - TRACTS 13-17					
APPROVALS	ENGINEER	DATE	APPROVALS	ENGINEER	DATE
City Engineer			Waste		
A C E - Design			Traffic		
A C E - Hydrology			Water		
DRAWING NO.	2204		MAP NO.	SHEET 2 OF 19	
			B - 12 8 13		
			C - 12 8 13		

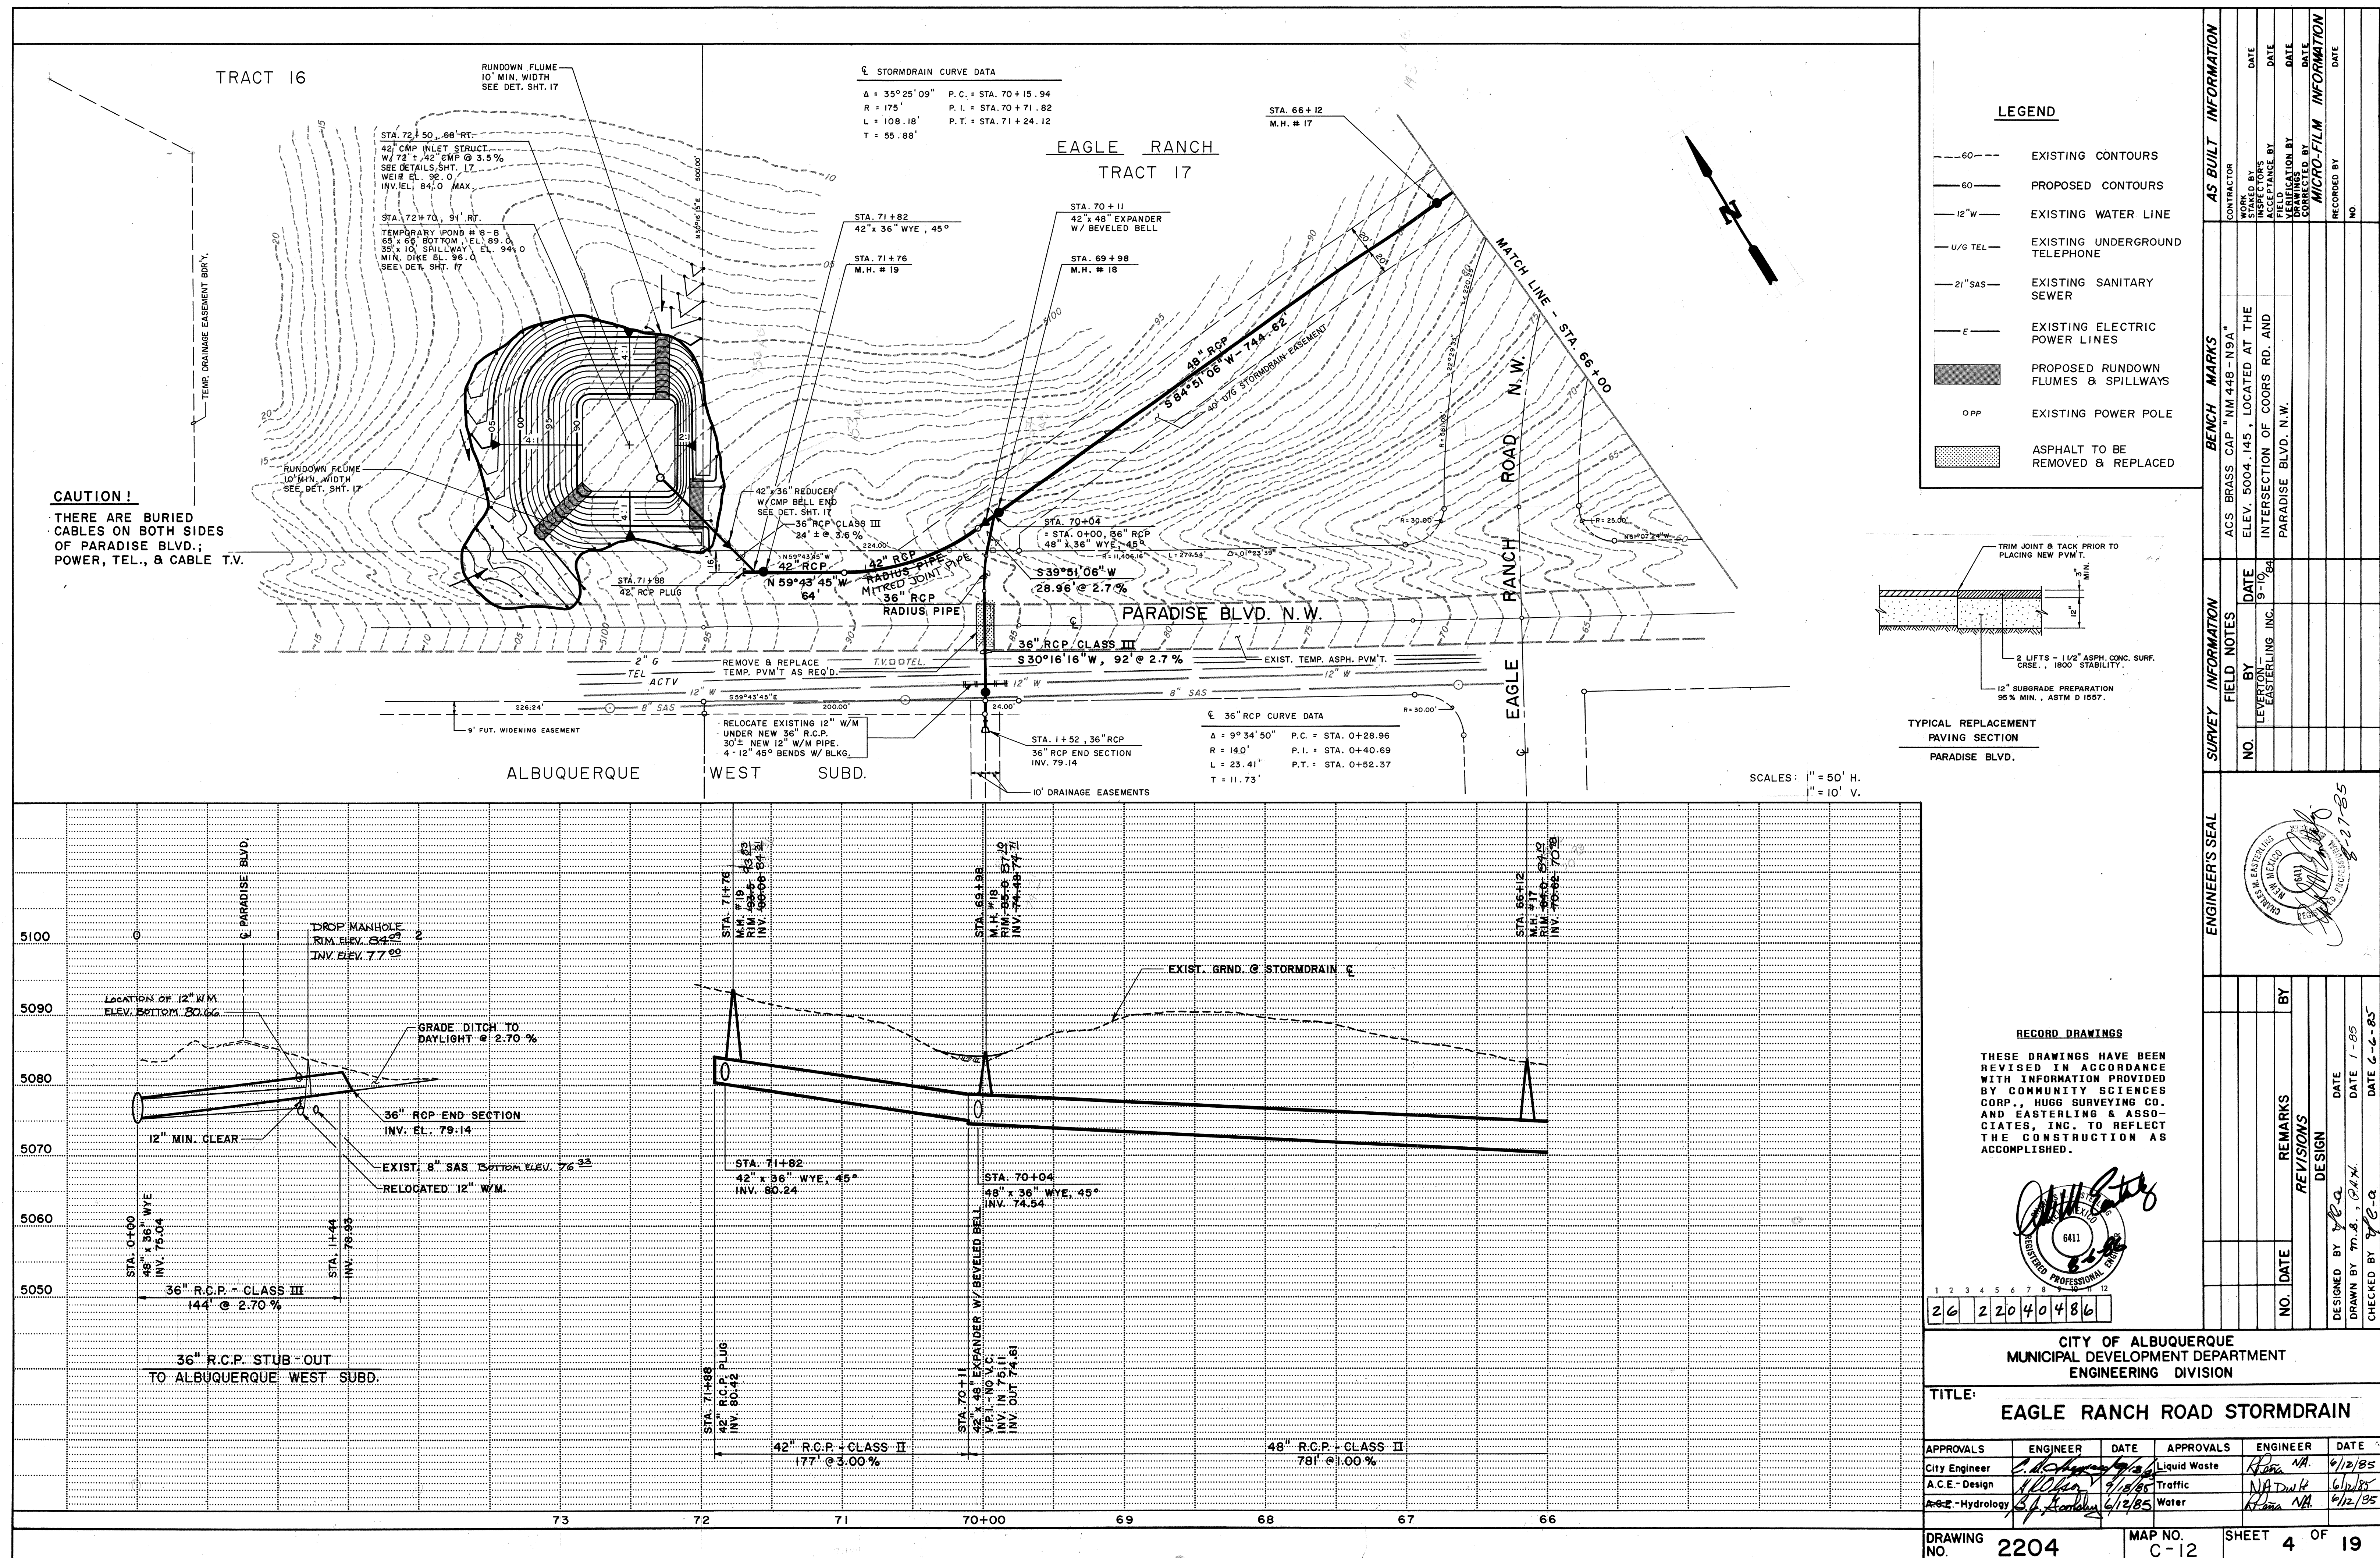

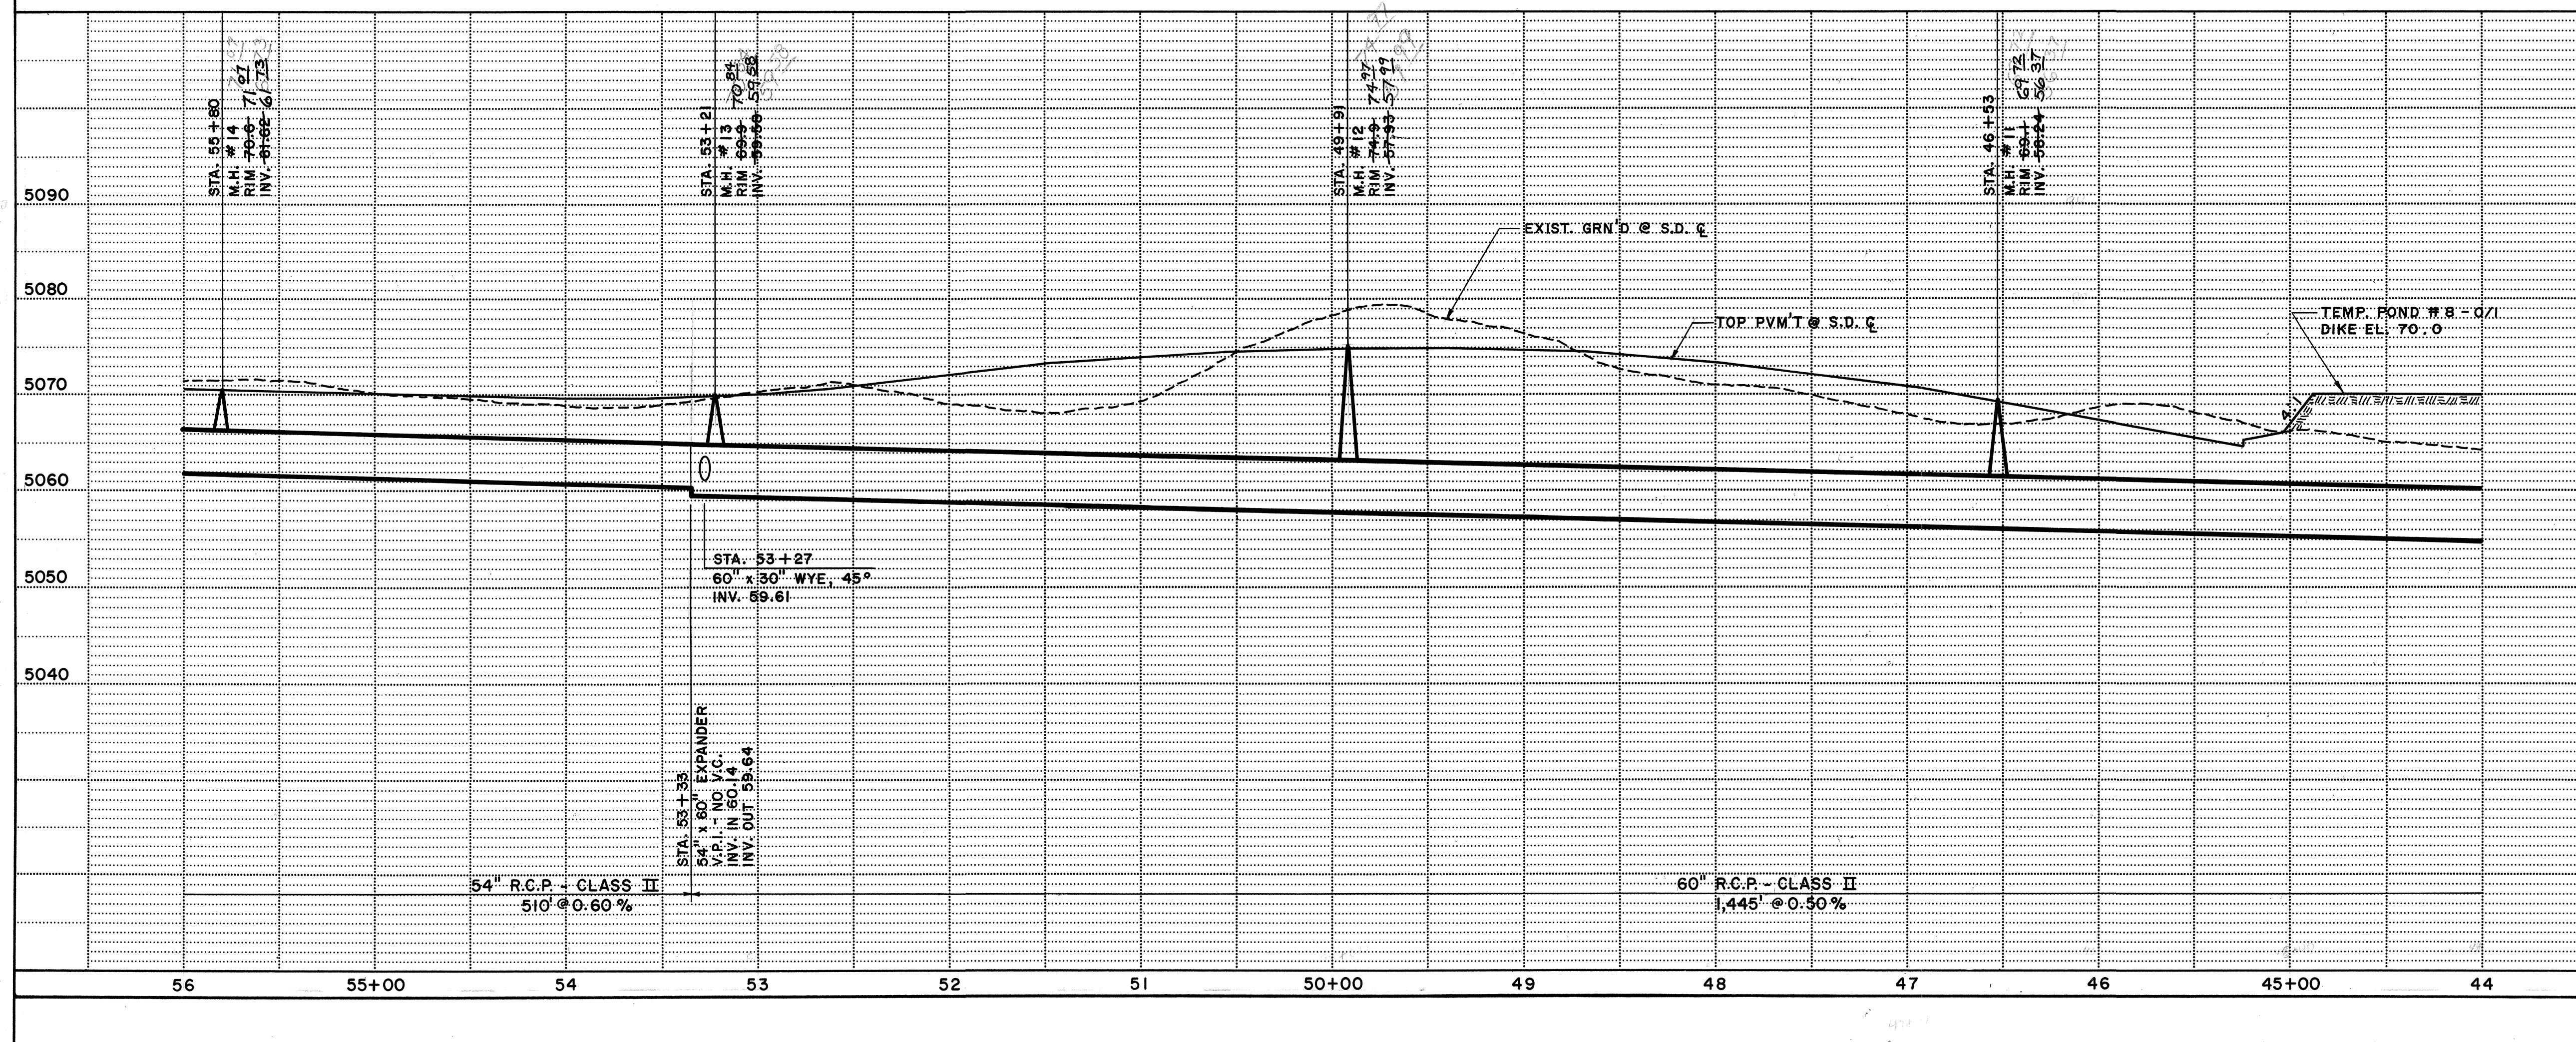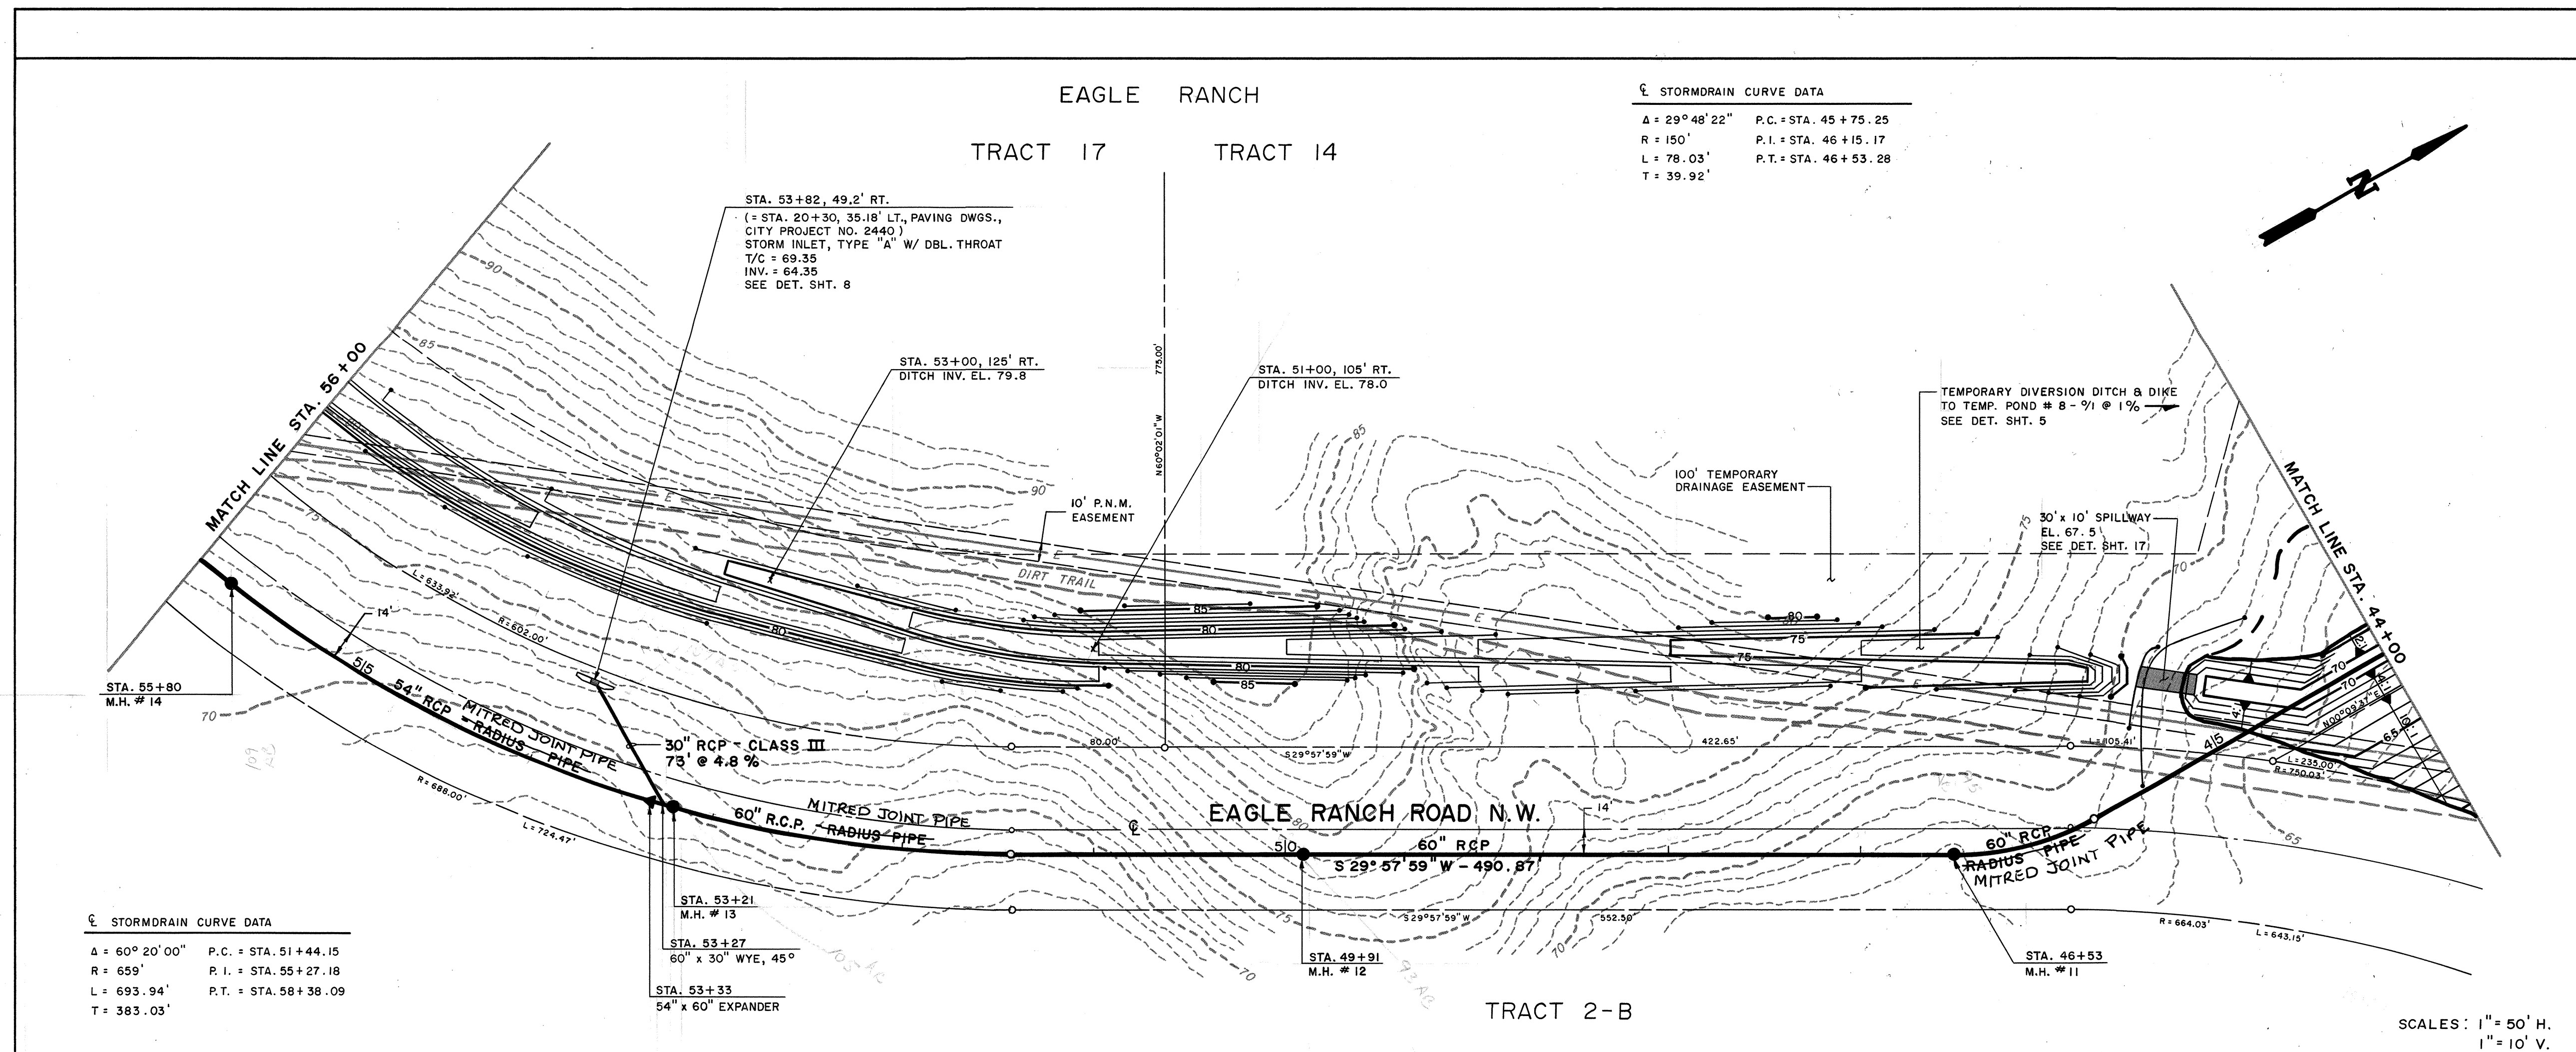[illegible]

STORMDRAIN CURVE DATA

$\Delta = 9^{\circ}00'59''$	P.C. = STA. 40+01.92
R = 150'	P.I. = STA. 40+13.75
L = 23.60'	P.T. = STA. 40+25.52
T = 11.83'	

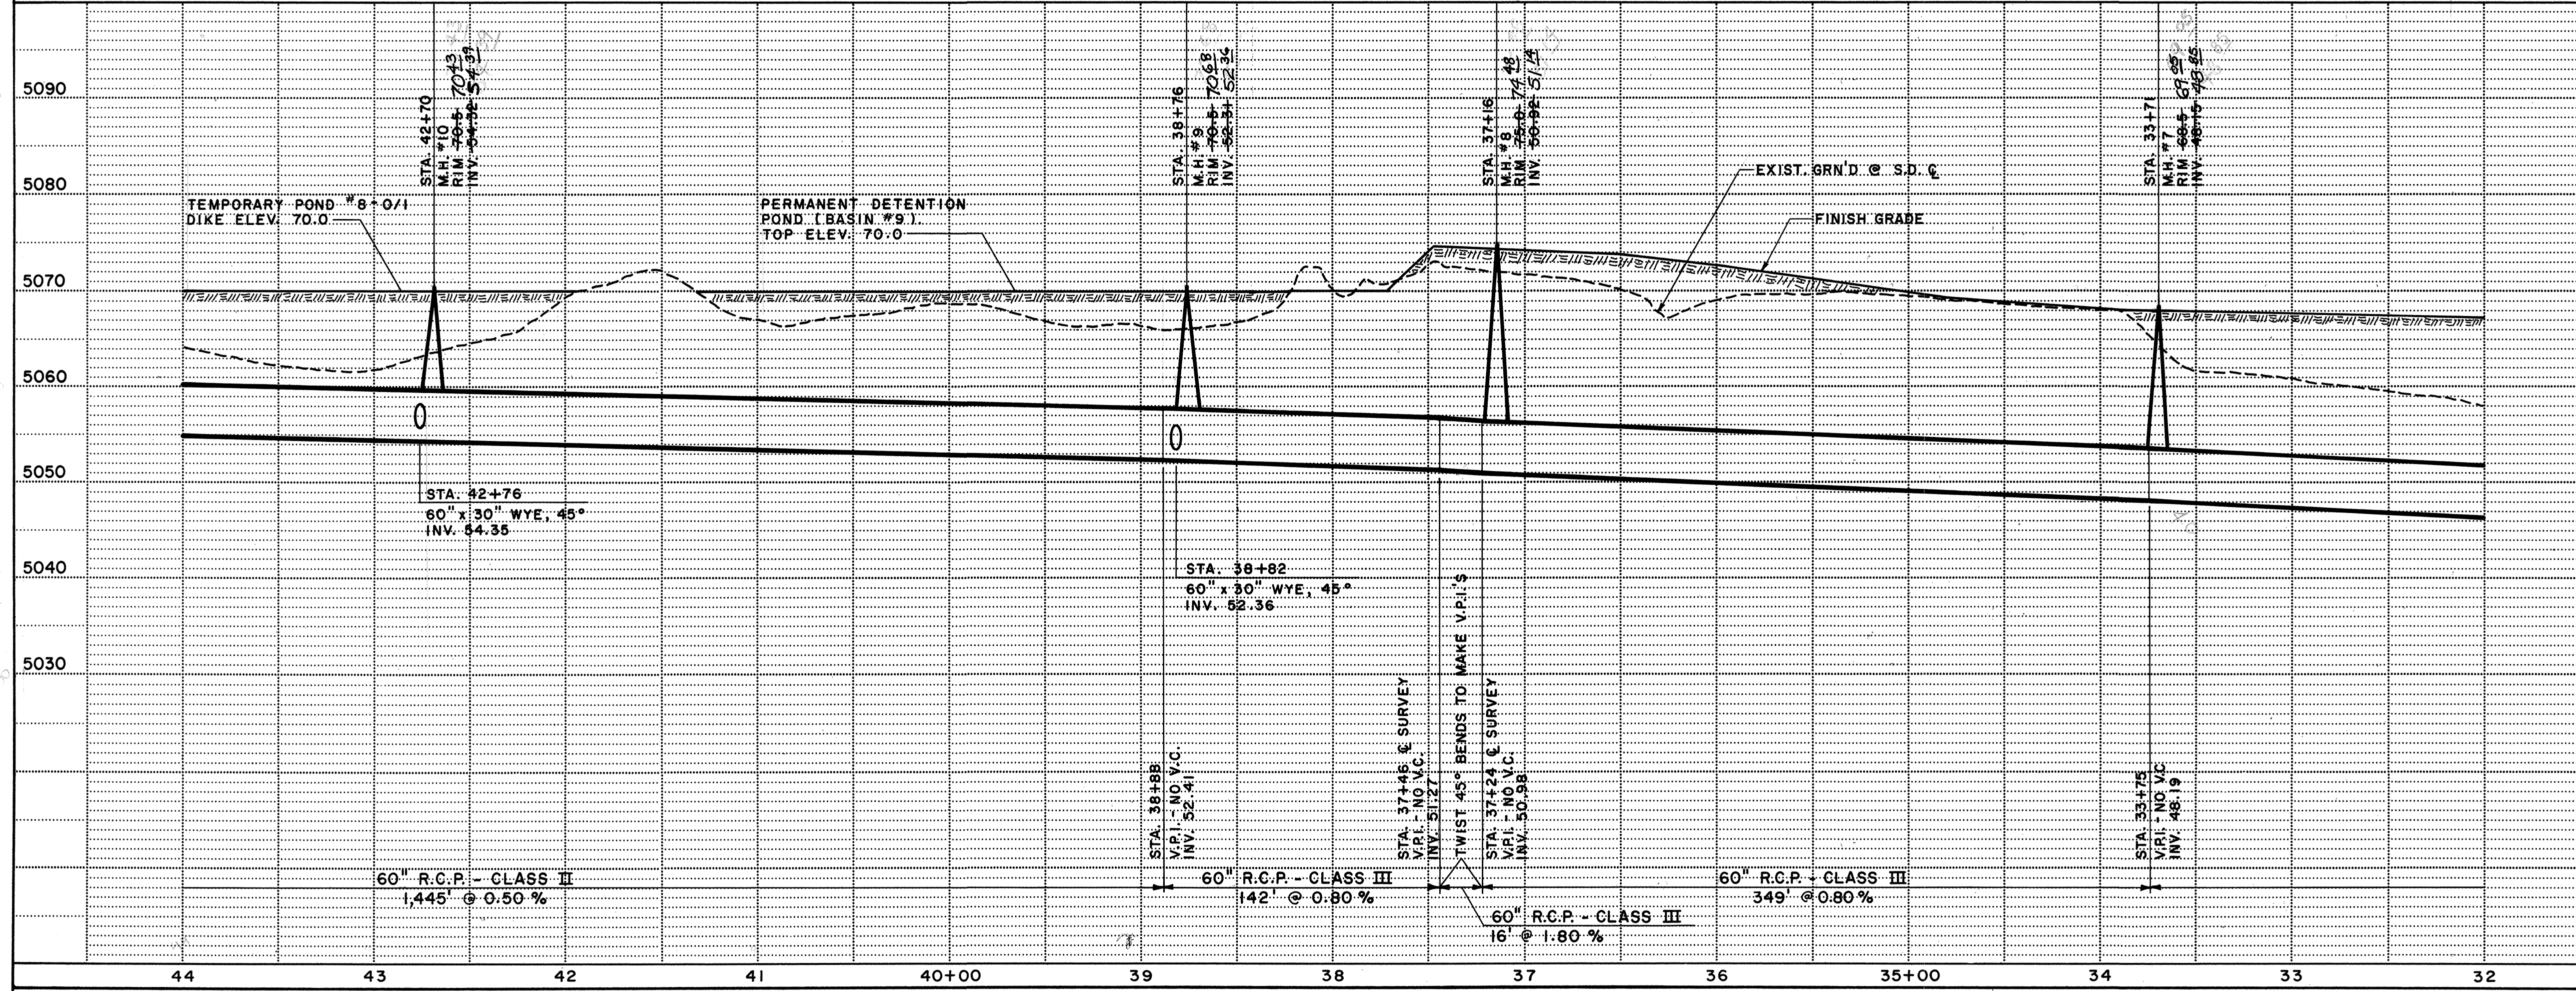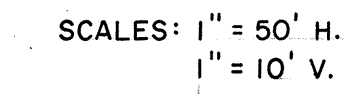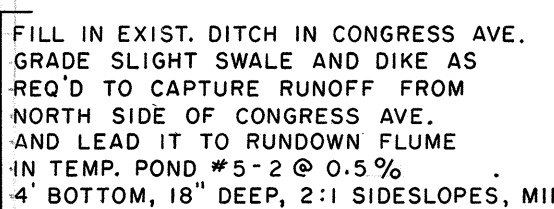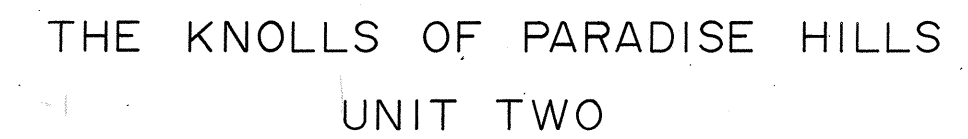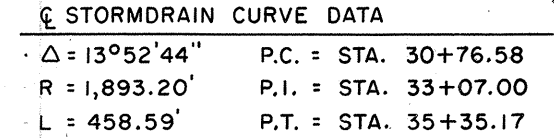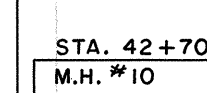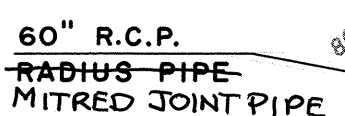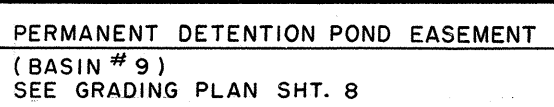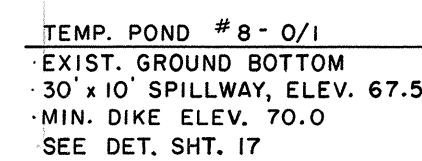

RECORD DRAWINGS

THESE DRAWINGS HAVE BEEN
REVISED IN ACCORDANCE
WITH INFORMATION PROVIDED
BY COMMUNITY SCIENCES
CORP., HUGG SURVEYING CO.
AND EASTERLING & ASSO-
CIATES, INC. TO REFLECT
THE CONSTRUCTION AS
ACCOMPLISHED.



1	2	3	4	5	6	7	8	9	10	11	12
2	6		2	2	0	4	0	7	8	6	

CITY OF ALBUQUERQUE
MUNICIPAL DEVELOPMENT DEPARTMENT
ENGINEERING DIVISION

EAGLE RANCH ROAD STORMDRAIN


APPROVALS	ENGINEER	DATE	APPROVALS	ENGINEER	DATE
City Engineer	<i>E. J. [Signature]</i>	<i>9/12/85</i>	Liquid Waste	<i>R. [Signature]</i> NA.	<i>6/12/85</i>
A.C.E.-Design	<i>J. [Signature]</i>	<i>9/12/85</i>	Traffic	<i>N. [Signature]</i> DWH	<i>6/12/85</i>
A.C.E. -Hydrology	<i>S. J. [Signature]</i>	<i>6/12/85</i>	Water	<i>R. [Signature]</i> NA.	<i>6/12/85</i>




DRAWING NO.	2204	MAP NO. B & C - 13	SHEET 7 OF 19
-------------	------	-----------------------	---------------

[illegible]


Professional Engineer Seal for the State of Texas, No. 12567, signed by M. M. S. and dated 8-27-83.

						<i>REV'SIONS</i>			
								DESIGN	
DESIGNED BY							<i>J.P.G.</i>		DATE
DRAWN BY							<i>M.B., P.A.Y.</i>		DATE <i>1-25</i>
CHECKED BY							<i>J.P.G.</i>		DATE <i>2-2-85</i>

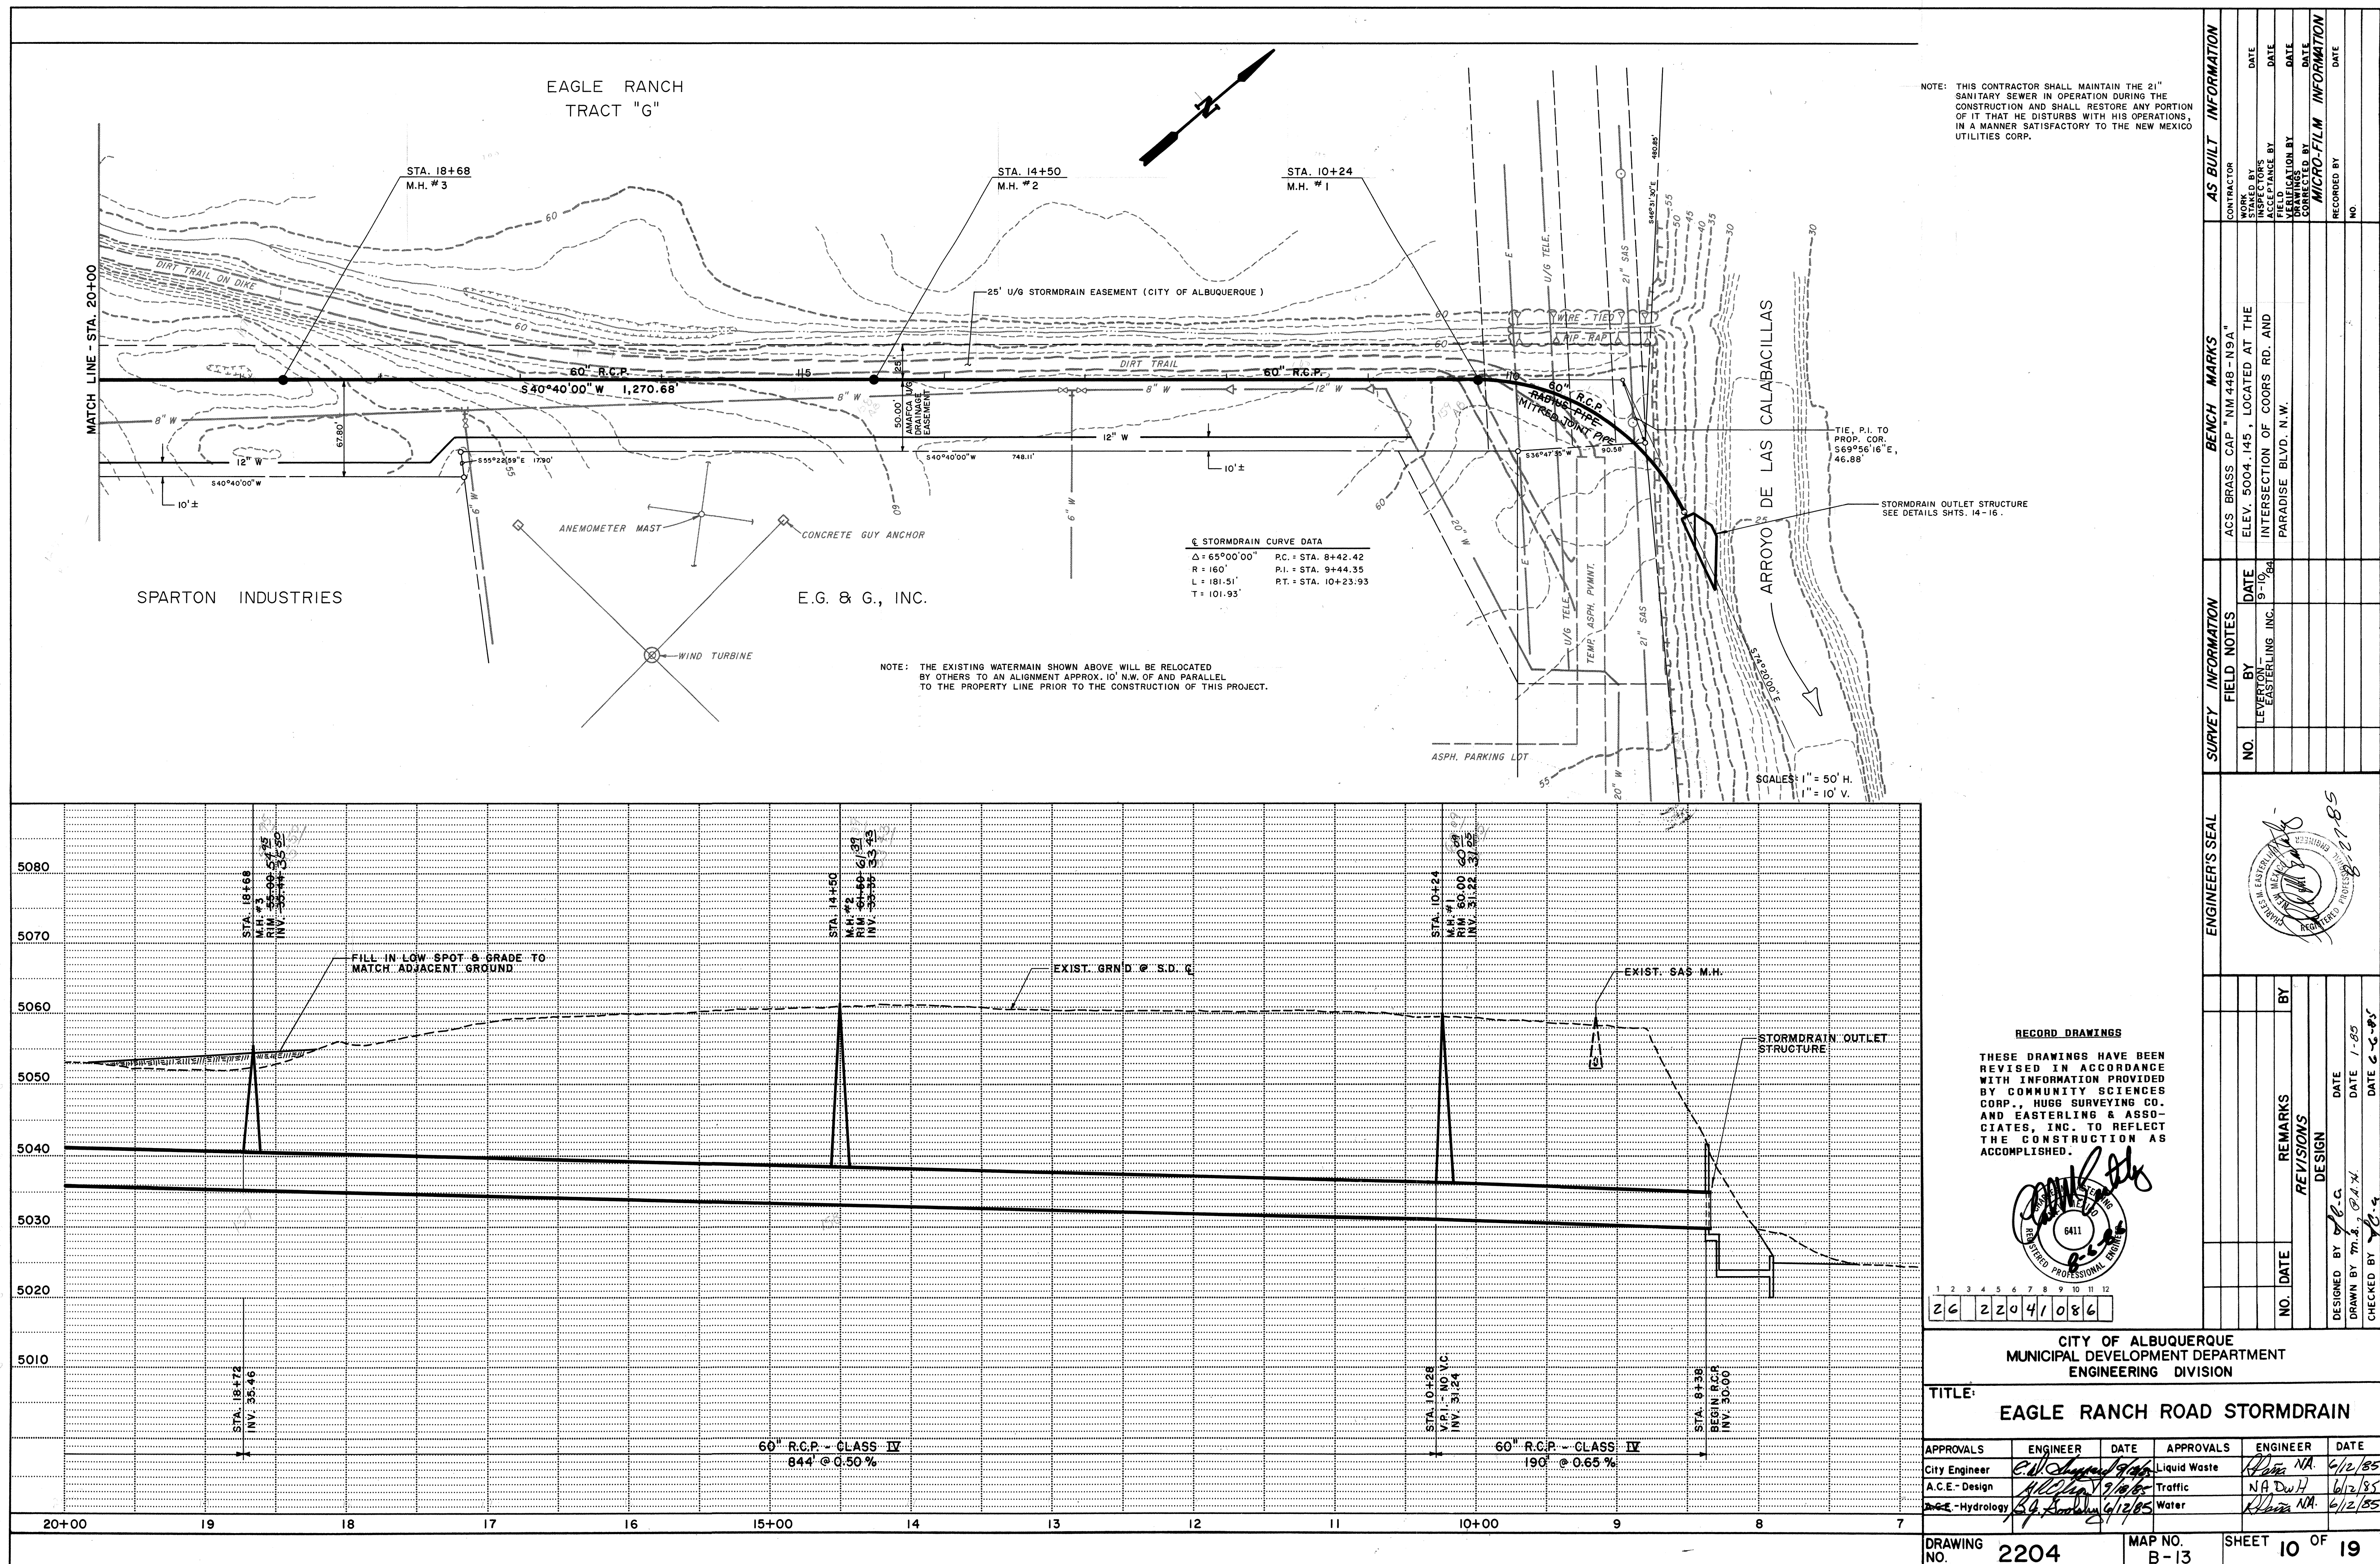


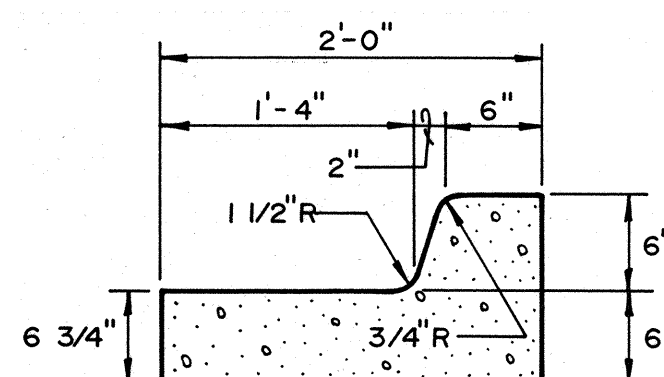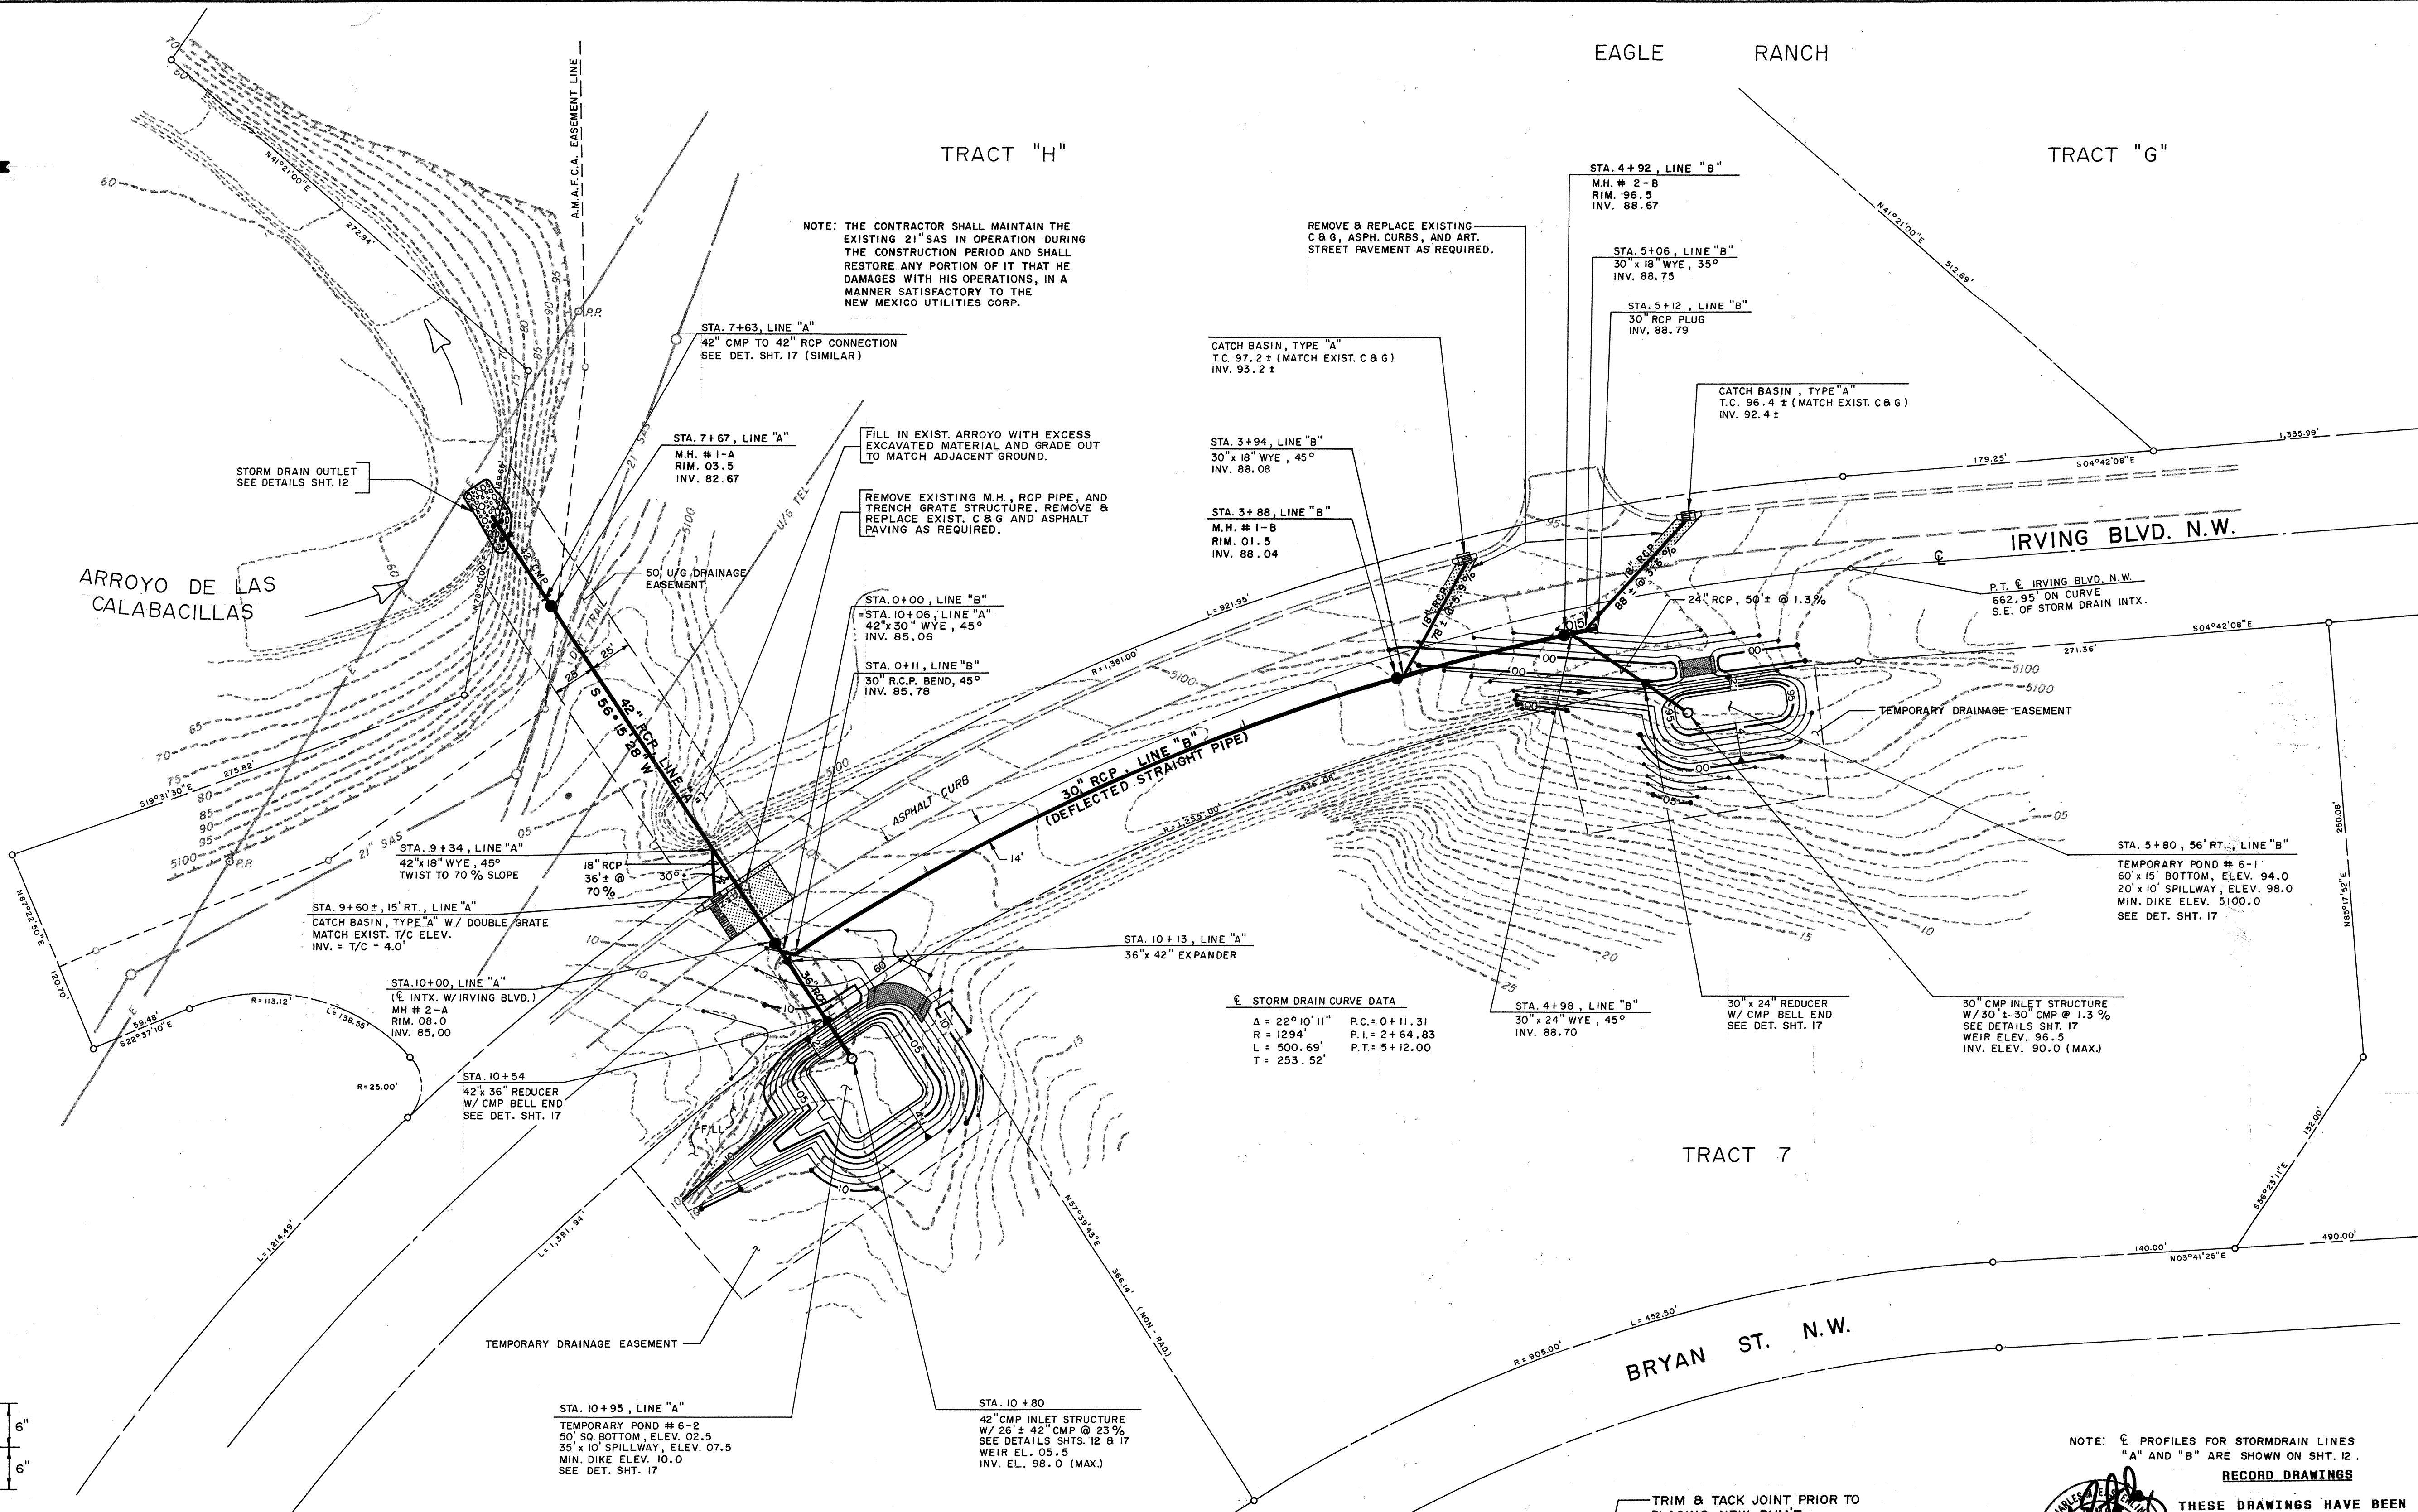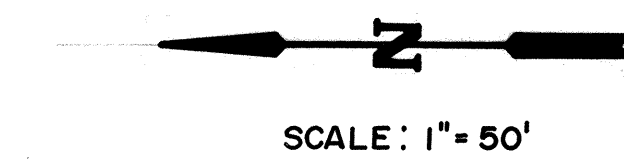


STANDARD CURB
NO SCALE

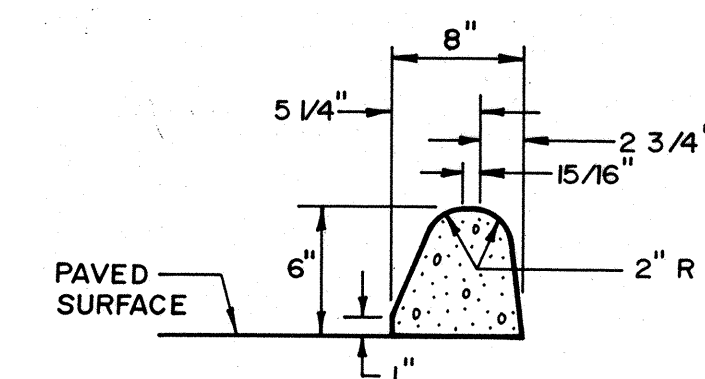


ASPHALT CURB
NO SCALE

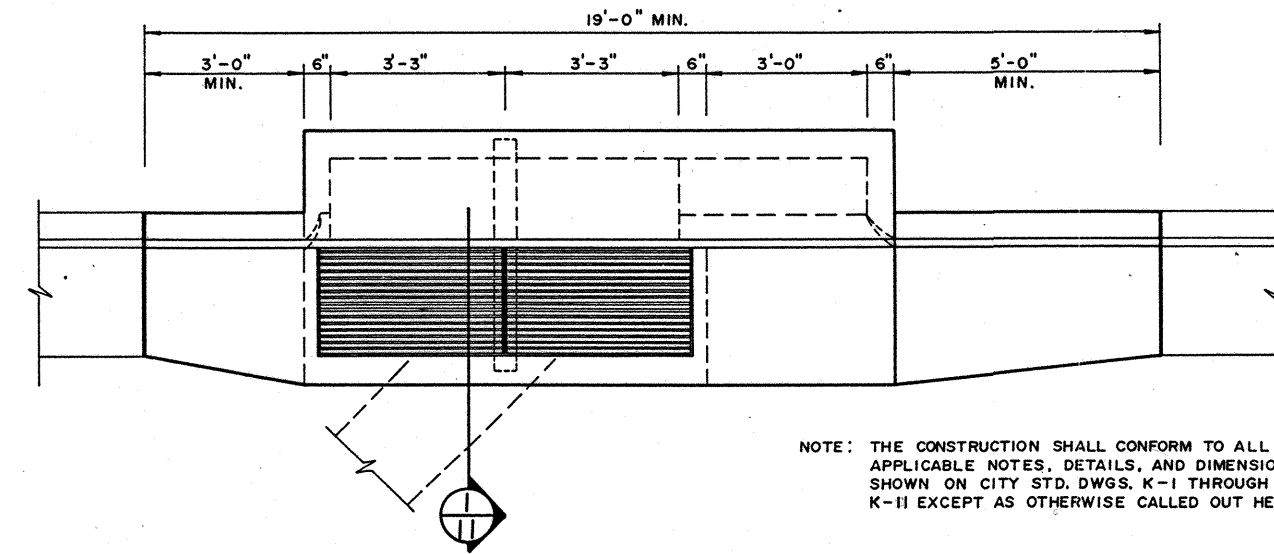

CATCH BASIN, TYPE "A" W/ DOUBLE GRATE
NO SCALE

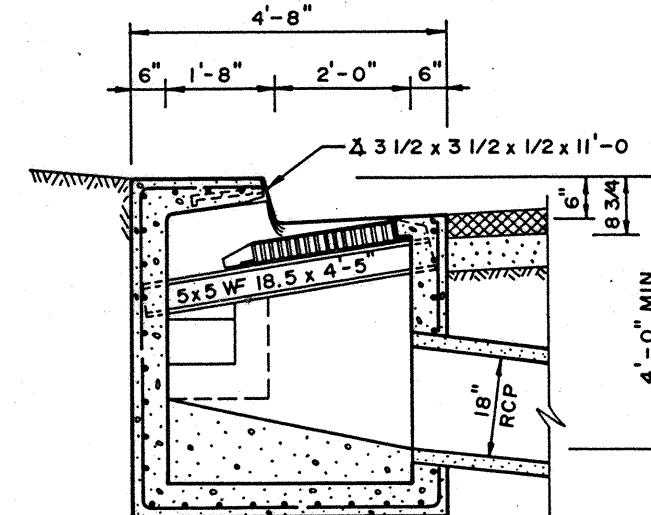


SECTION

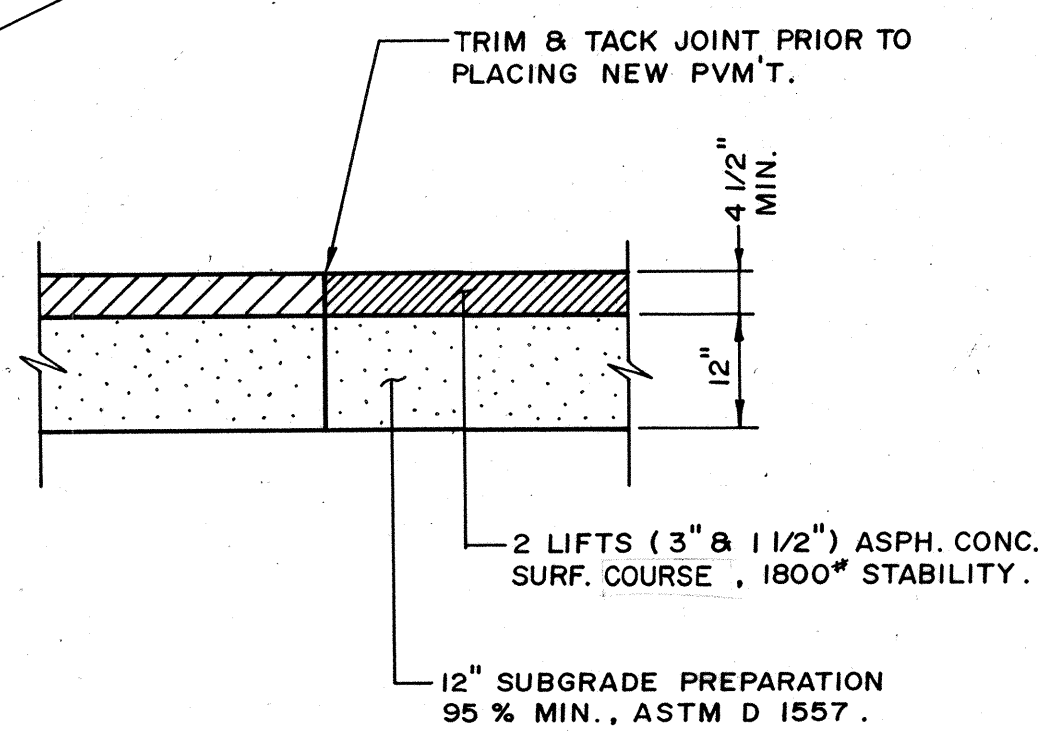

TYPICAL REPLACEMENT
PAVING SECTION
IRVING BLVD.

1 2 3 4 5 6 7 8 9 10 11 12
26 22 04 11 86


NOTE: E PROFILES FOR STORMDRAIN LINES
"A" AND "B" ARE SHOWN ON SHT. 12.
RECORD DRAWINGS

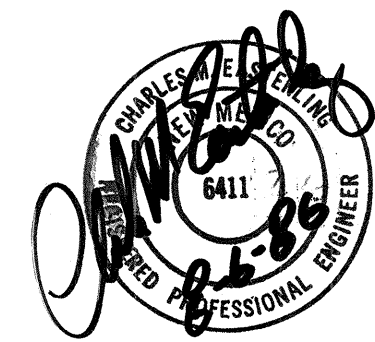


THESE DRAWINGS HAVE BEEN
REVISED IN ACCORDANCE
WITH INFORMATION PROVIDED
BY COMMUNITY SCIENCES
CORP., HUGG SURVEYING CO.
AND EASTERLING & ASSO-
CIATES, INC. TO REFLECT
THE CONSTRUCTION AS
ACCOMPLISHED.

CITY OF ALBUQUERQUE MUNICIPAL DEVELOPMENT DEPARTMENT ENGINEERING DIVISION					
TITLE: IRVING BLVD. STORMDRAIN PLAN					
APPROVALS	ENGINEER	DATE	APPROVALS	ENGINEER	DATE
City Engineer	<i>[Signature]</i>	9/12/85	Liquid Waste	<i>[Signature]</i>	9/12/85
A.C.E.-Design	<i>[Signature]</i>	9/12/85	Traffic	<i>[Signature]</i>	6/12/85
Hydrology	<i>[Signature]</i>	6/12/85	Water	<i>[Signature]</i>	6/12/85
DRAWING NO.	2204	MAP NO.	B-13	SHEET	11 OF 19


AS BUILT INFORMATION		BENCH MARKS		SURVEY INFORMATION		ENGINEER'S SEAL		REVISIONS		DESIGN	
CONTRACTOR	DATE	ACS BRASS CAP "NM 448-N9A"	DATE	NO.	BY	ENGINEER'S SEAL	REVISIONS	NO.	DATE	DESIGN	DATE
WORK	DATE	ELEV. 5004.145, LOCATED AT THE	DATE								
INSPECTOR'S	DATE	INTERSECTION OF COORS RD. AND	DATE								
FIELD	DATE	PARADISE BLVD. N.W.	DATE								
VERIFICATION BY	DATE		DATE								
CORRECTED BY	DATE		DATE								
NO.	DATE		DATE								

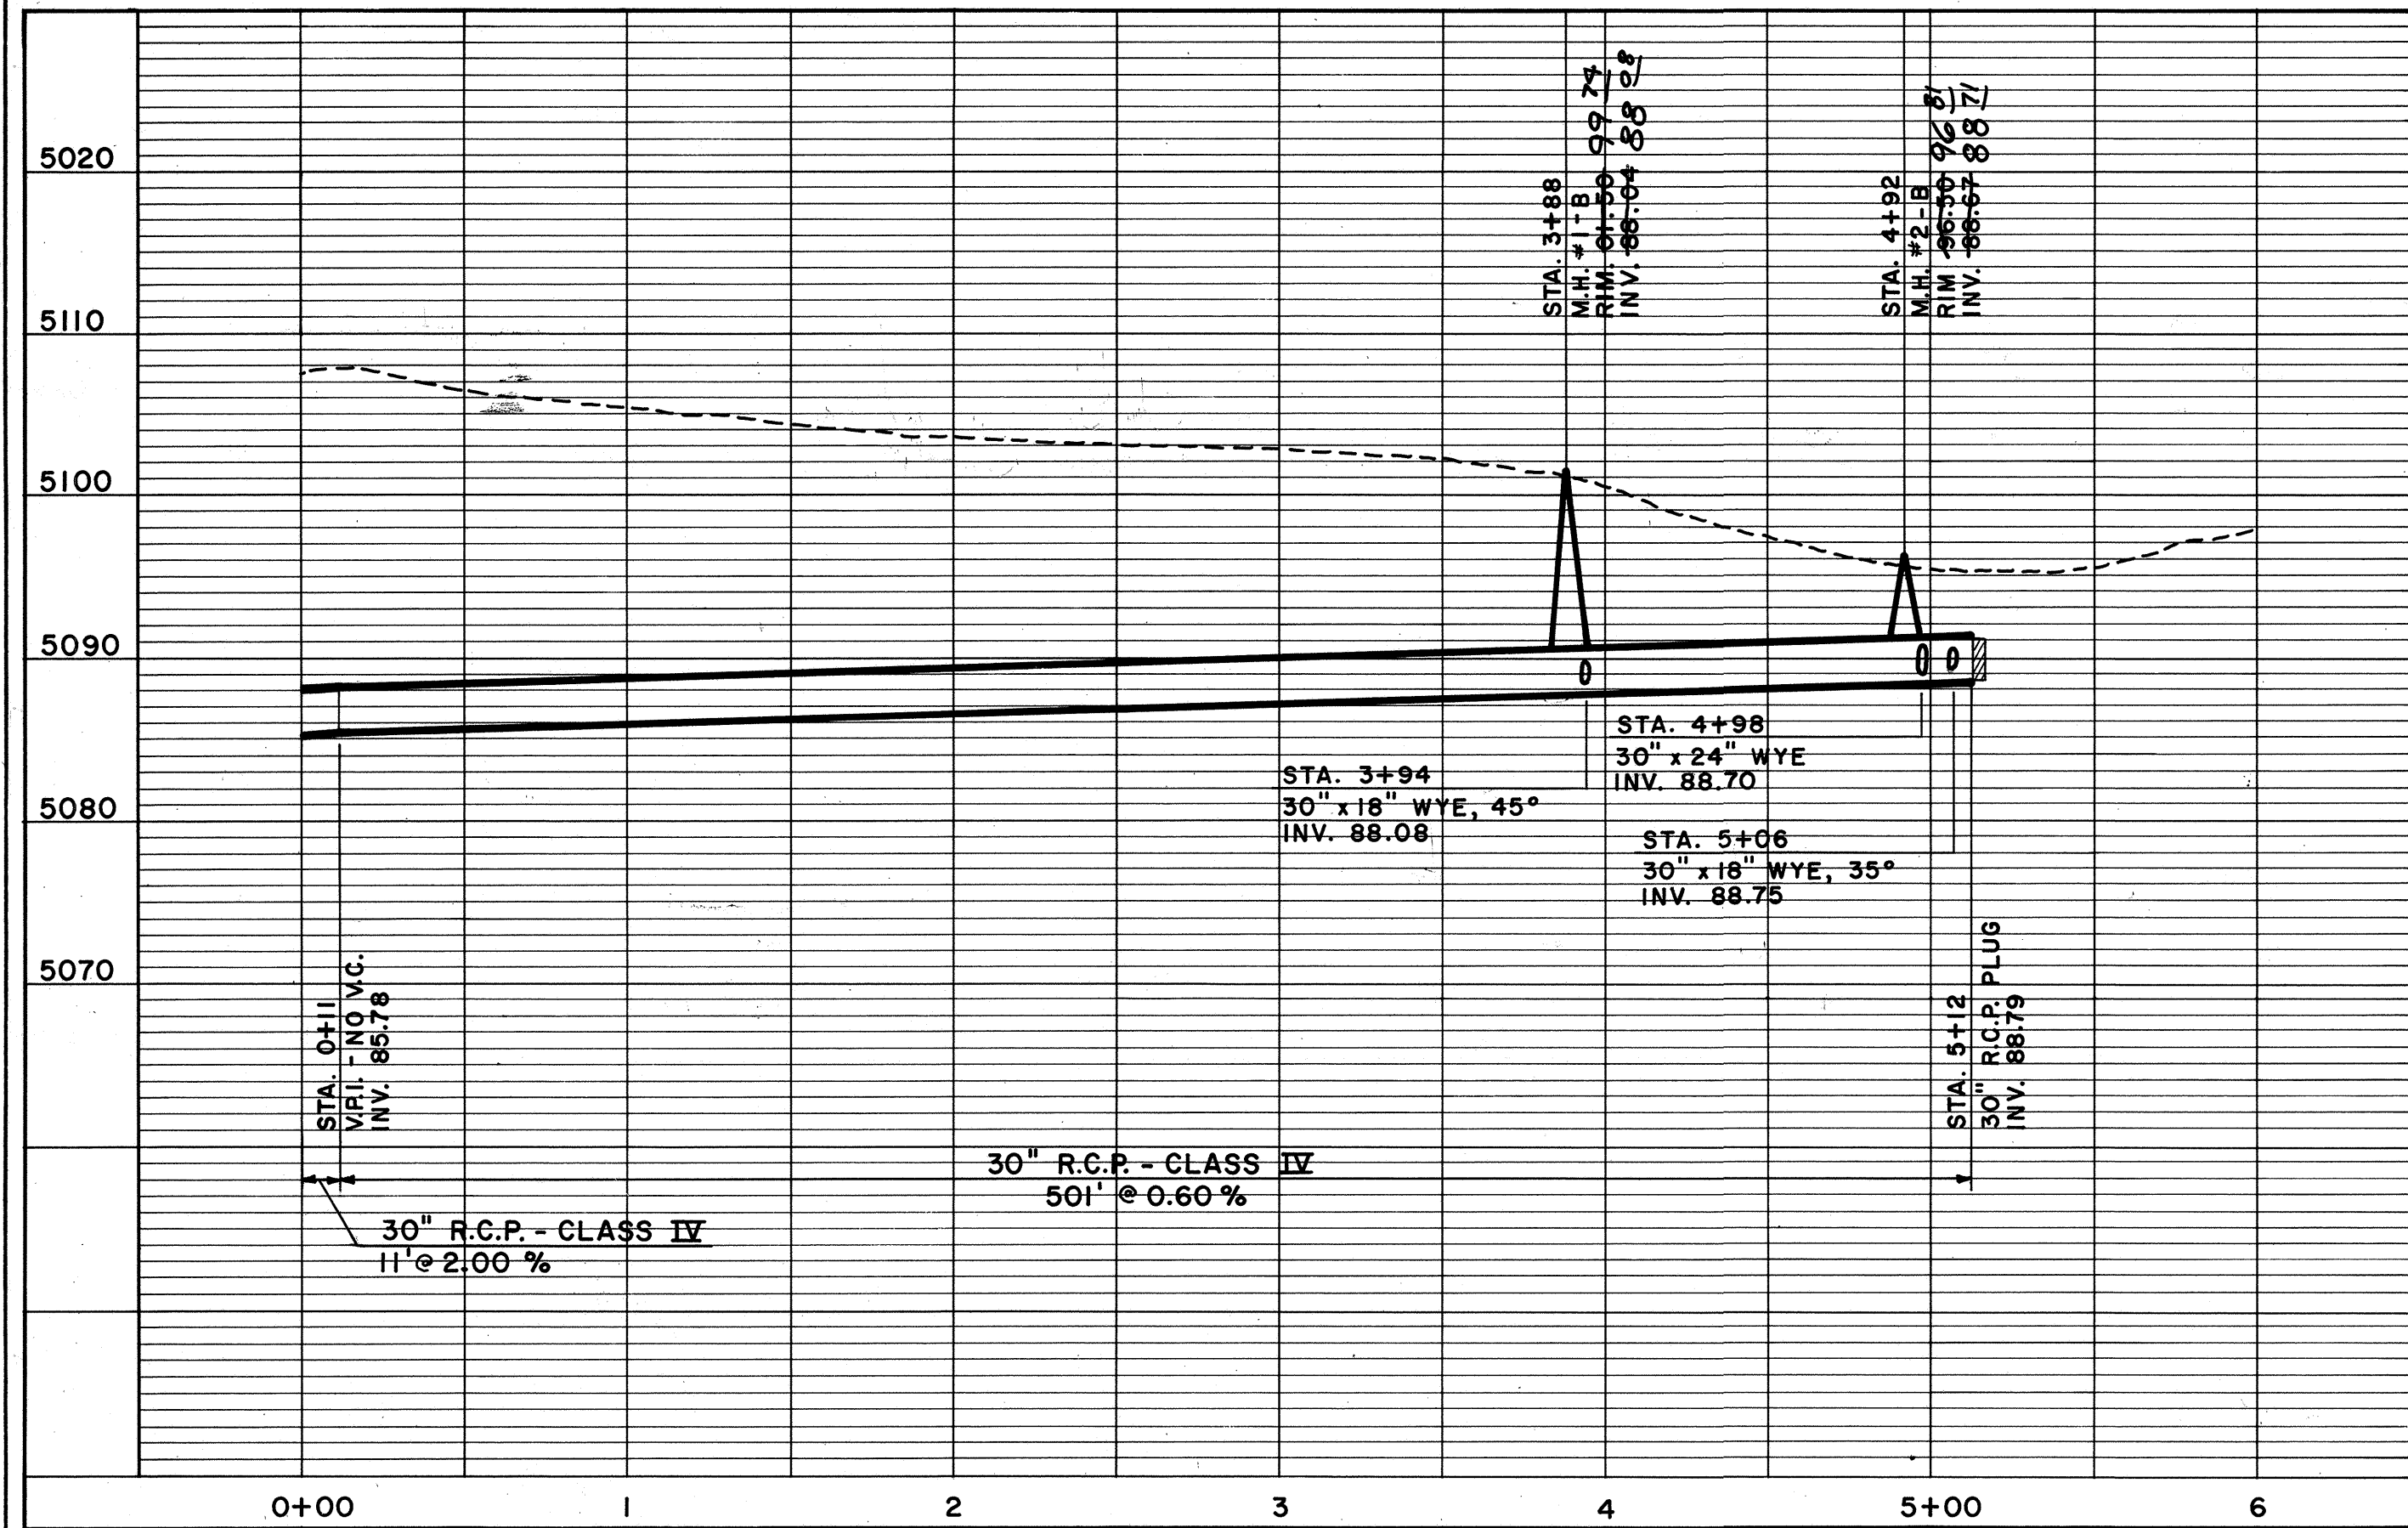


PROFILE LINE "B"

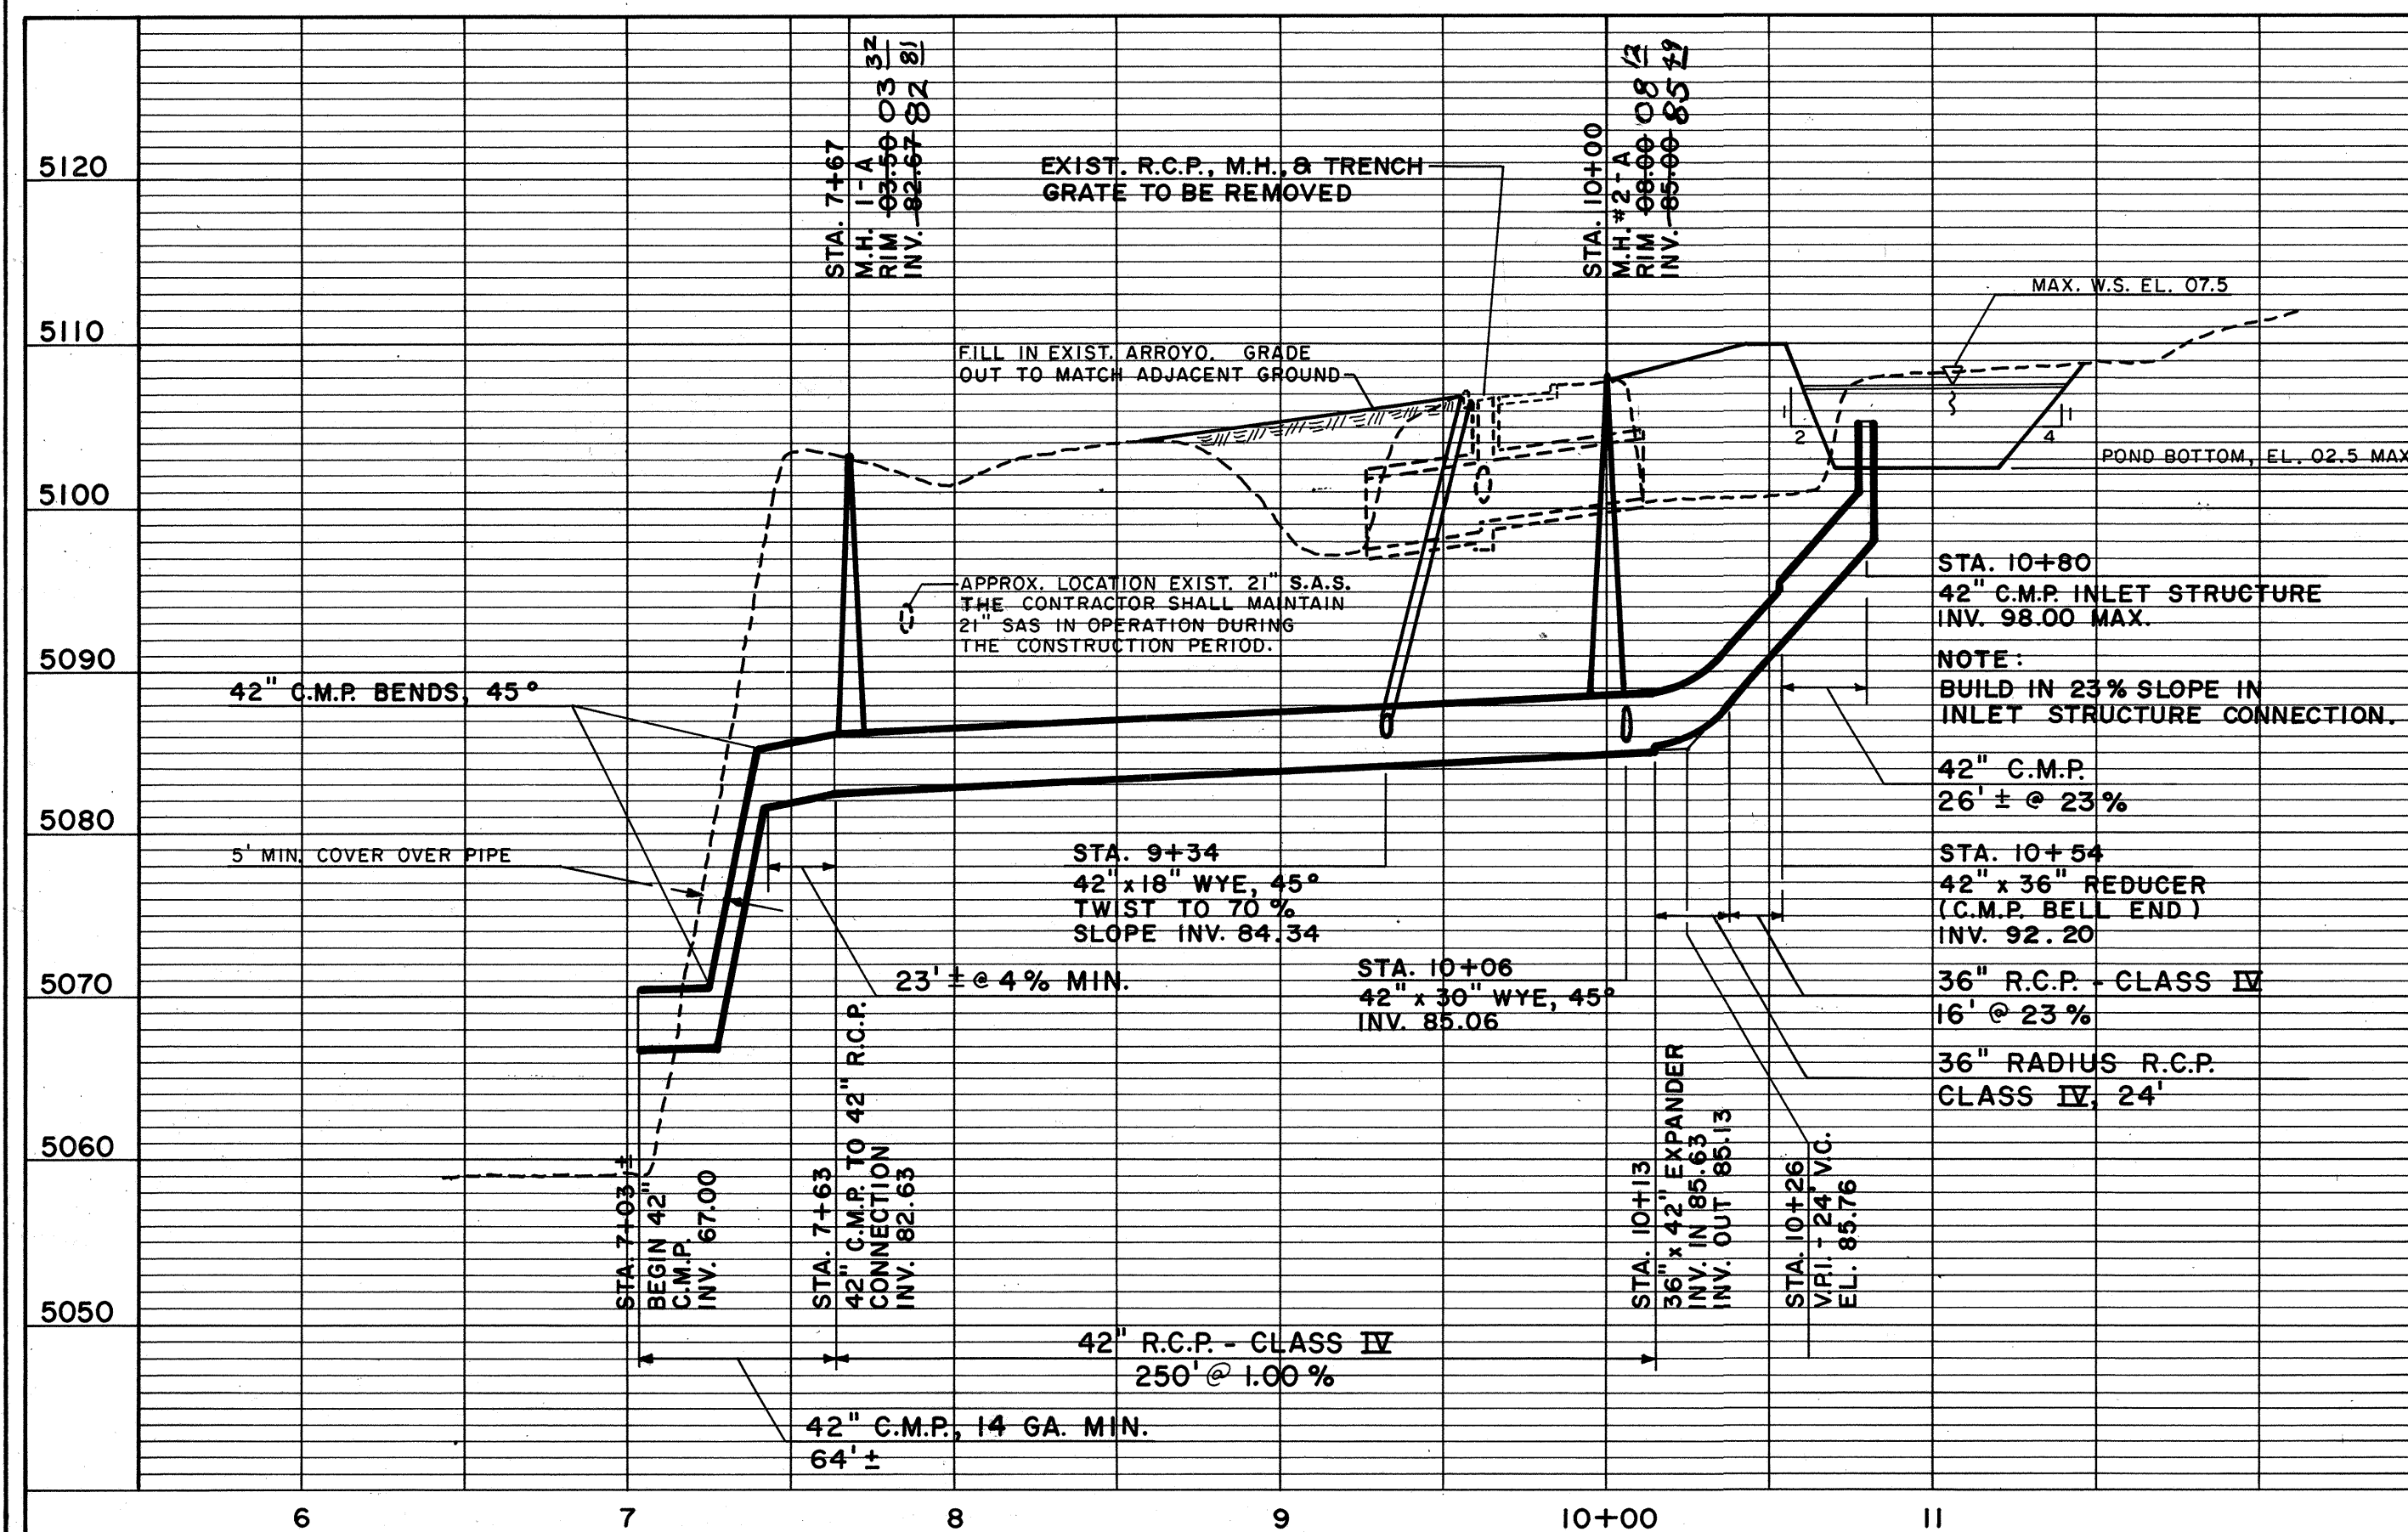

PROFILE LINE "A"

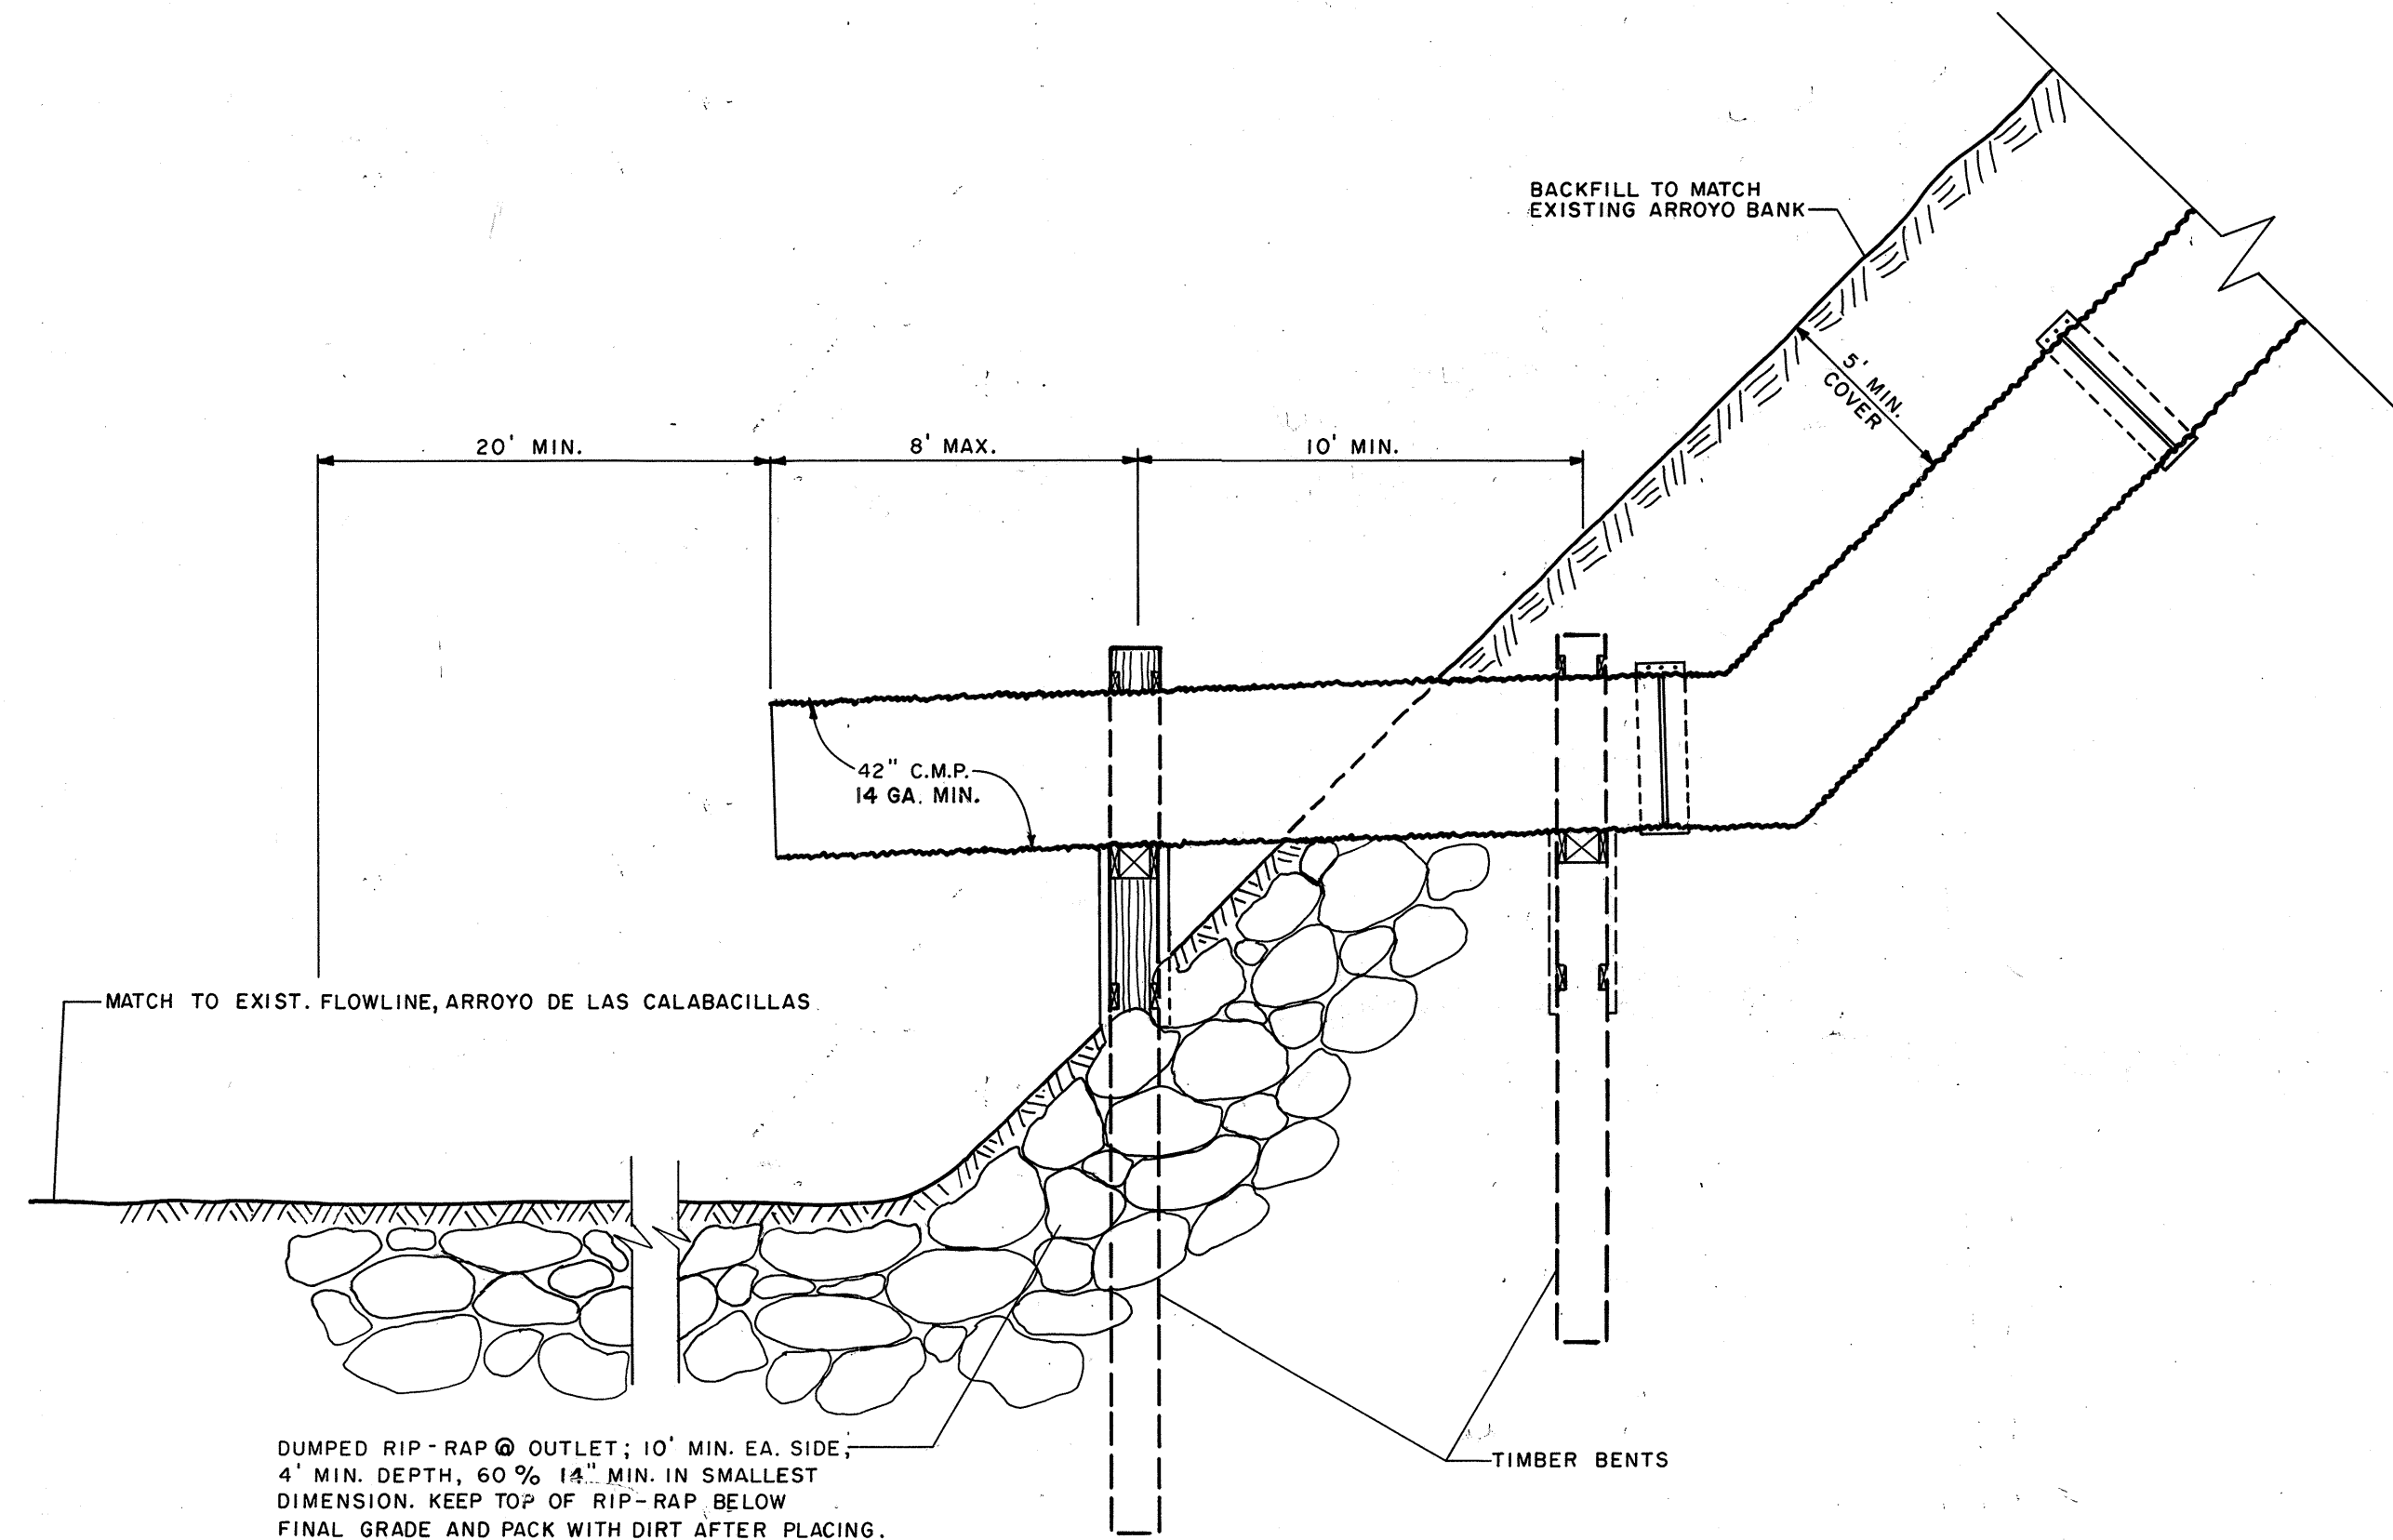

STORMDRAIN OUTLET
FROM IRVING BLVD. TO ARROYO DE LAS CALABACILLAS
NO SCALE

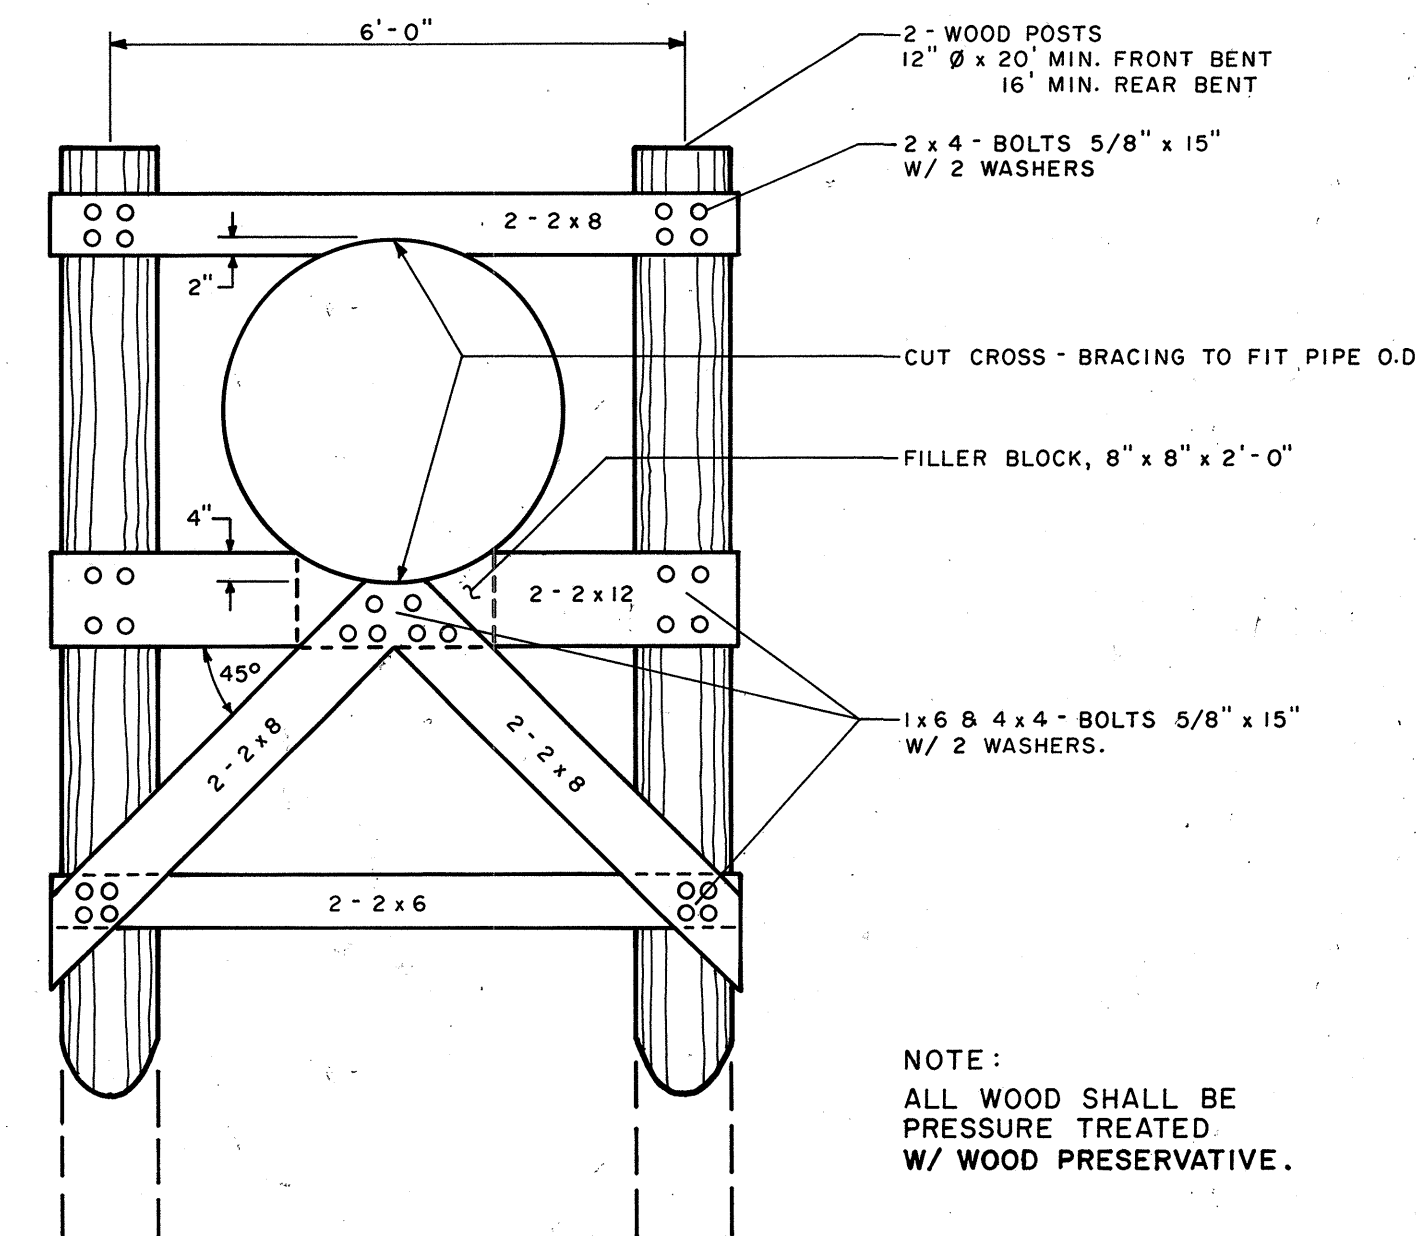

FRONT VIEW

SIDE VIEW








TIMBER BENT DETAILS
NO SCALE

RECORD DRAWINGS
THESE DRAWINGS HAVE BEEN REVISED IN ACCORDANCE WITH INFORMATION PROVIDED BY COMMUNITY SCIENCES CORP., HUGG SURVEYING CO. AND EASTERLING & ASSOCIATES, INC. TO REFLECT THE CONSTRUCTION AS ACCOMPLISHED.

ENGINEER'S SEAL
Professional Engineer
6411
8-6-85

SURVEY INFORMATION		BENCH MARKS		AS BUILT INFORMATION	
NO.	DATE	BY	DATE	CONTRACTOR	DATE
1	9-10-84	LEVERTON EASTERLING INC.	9-10-84	ACS BRASS CAP "NM 448-N9A"	
2				ELEV. 5004.145, LOCATED AT THE INTERSECTION OF COORS RD. AND PARADISE BLVD. N.W.	
REVISIONS		MICRO-FILM INFORMATION		RECORDED BY	
NO.	DATE	BY	DATE	NO.	DATE
1	9-10-84	DESIGN			
2	9-10-84	REVISIONS			
3	9-10-84	REVISIONS			
CITY OF ALBUQUERQUE MUNICIPAL DEVELOPMENT DEPARTMENT ENGINEERING DIVISION					
TITLE: IRVING BLVD. STORMDRAIN PROFILES & OUTLET DETAILS					
APPROVALS	ENGINEER	DATE	APPROVALS	ENGINEER	DATE
City Engineer	<i>[Signature]</i>	9/10/85	Liquid Waste	<i>[Signature]</i>	9/12/85
A.C.E.-Design	<i>[Signature]</i>	9/10/85	Traffic	<i>[Signature]</i>	9/12/85
Hydrology	<i>[Signature]</i>	9/10/85	Water	<i>[Signature]</i>	9/12/85
DRAWING NO.	2204	MAP NO.	B-13	SHEET	12 OF 19

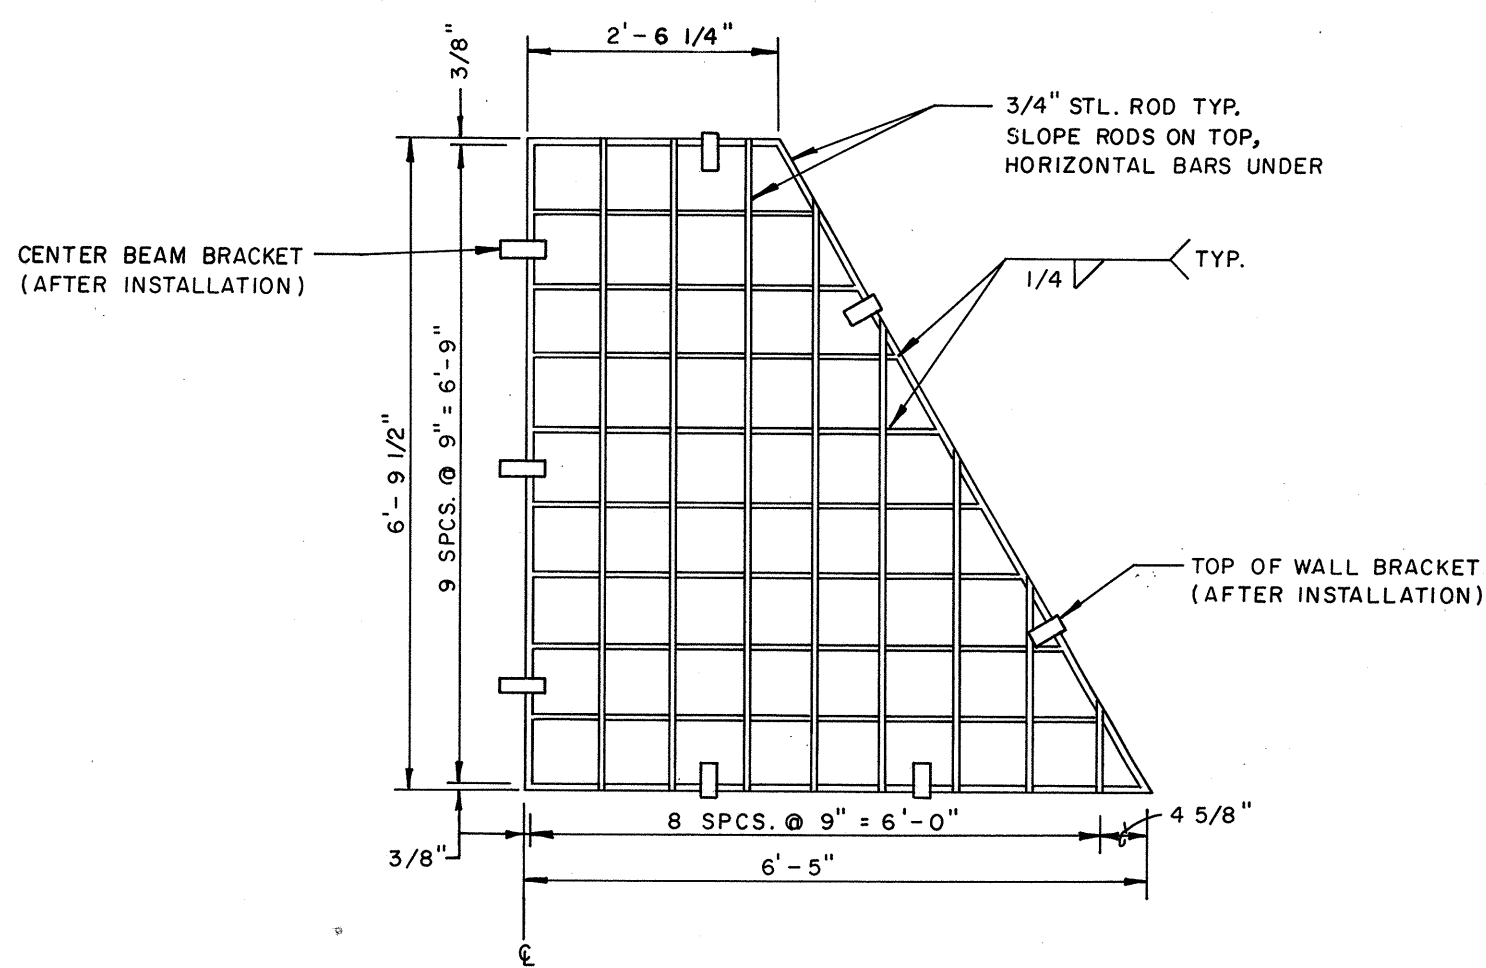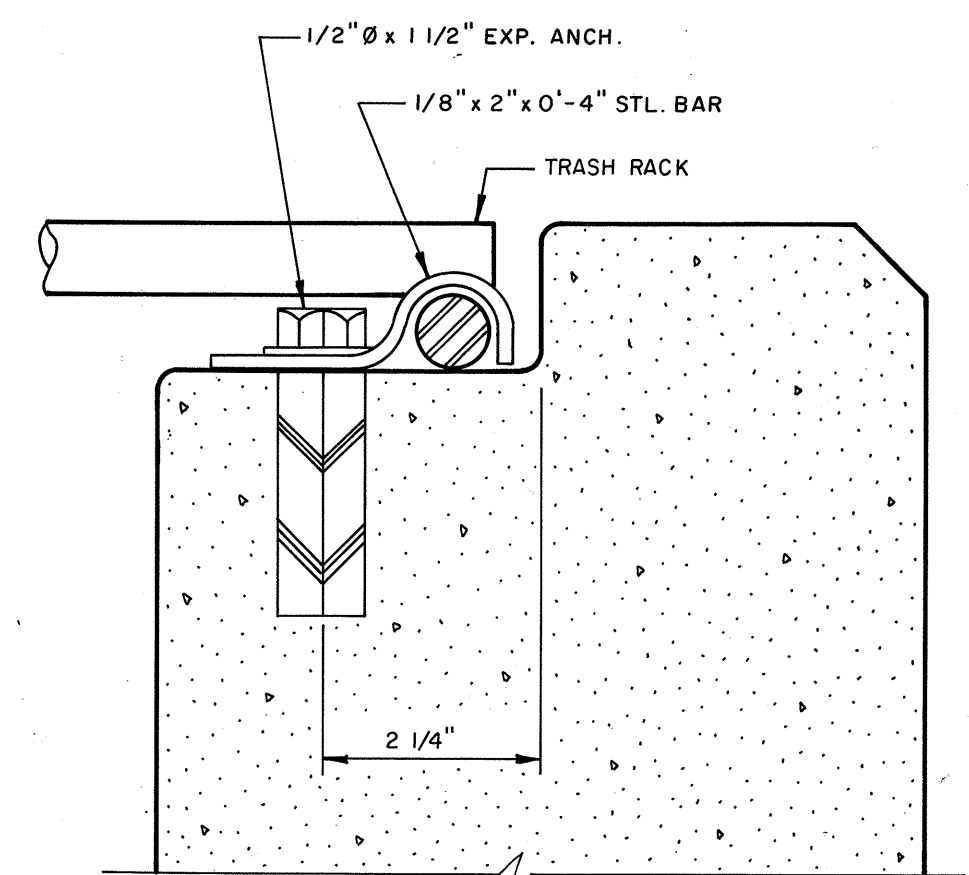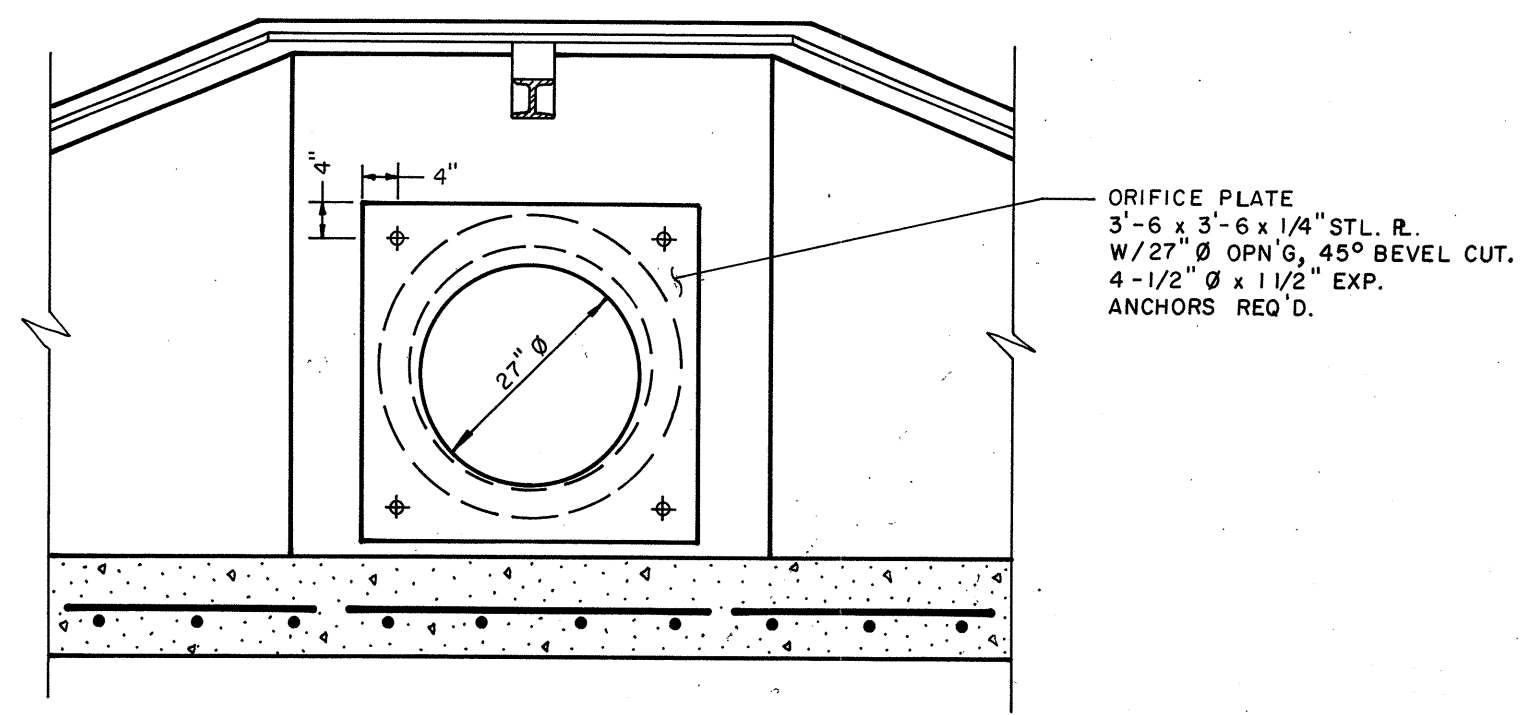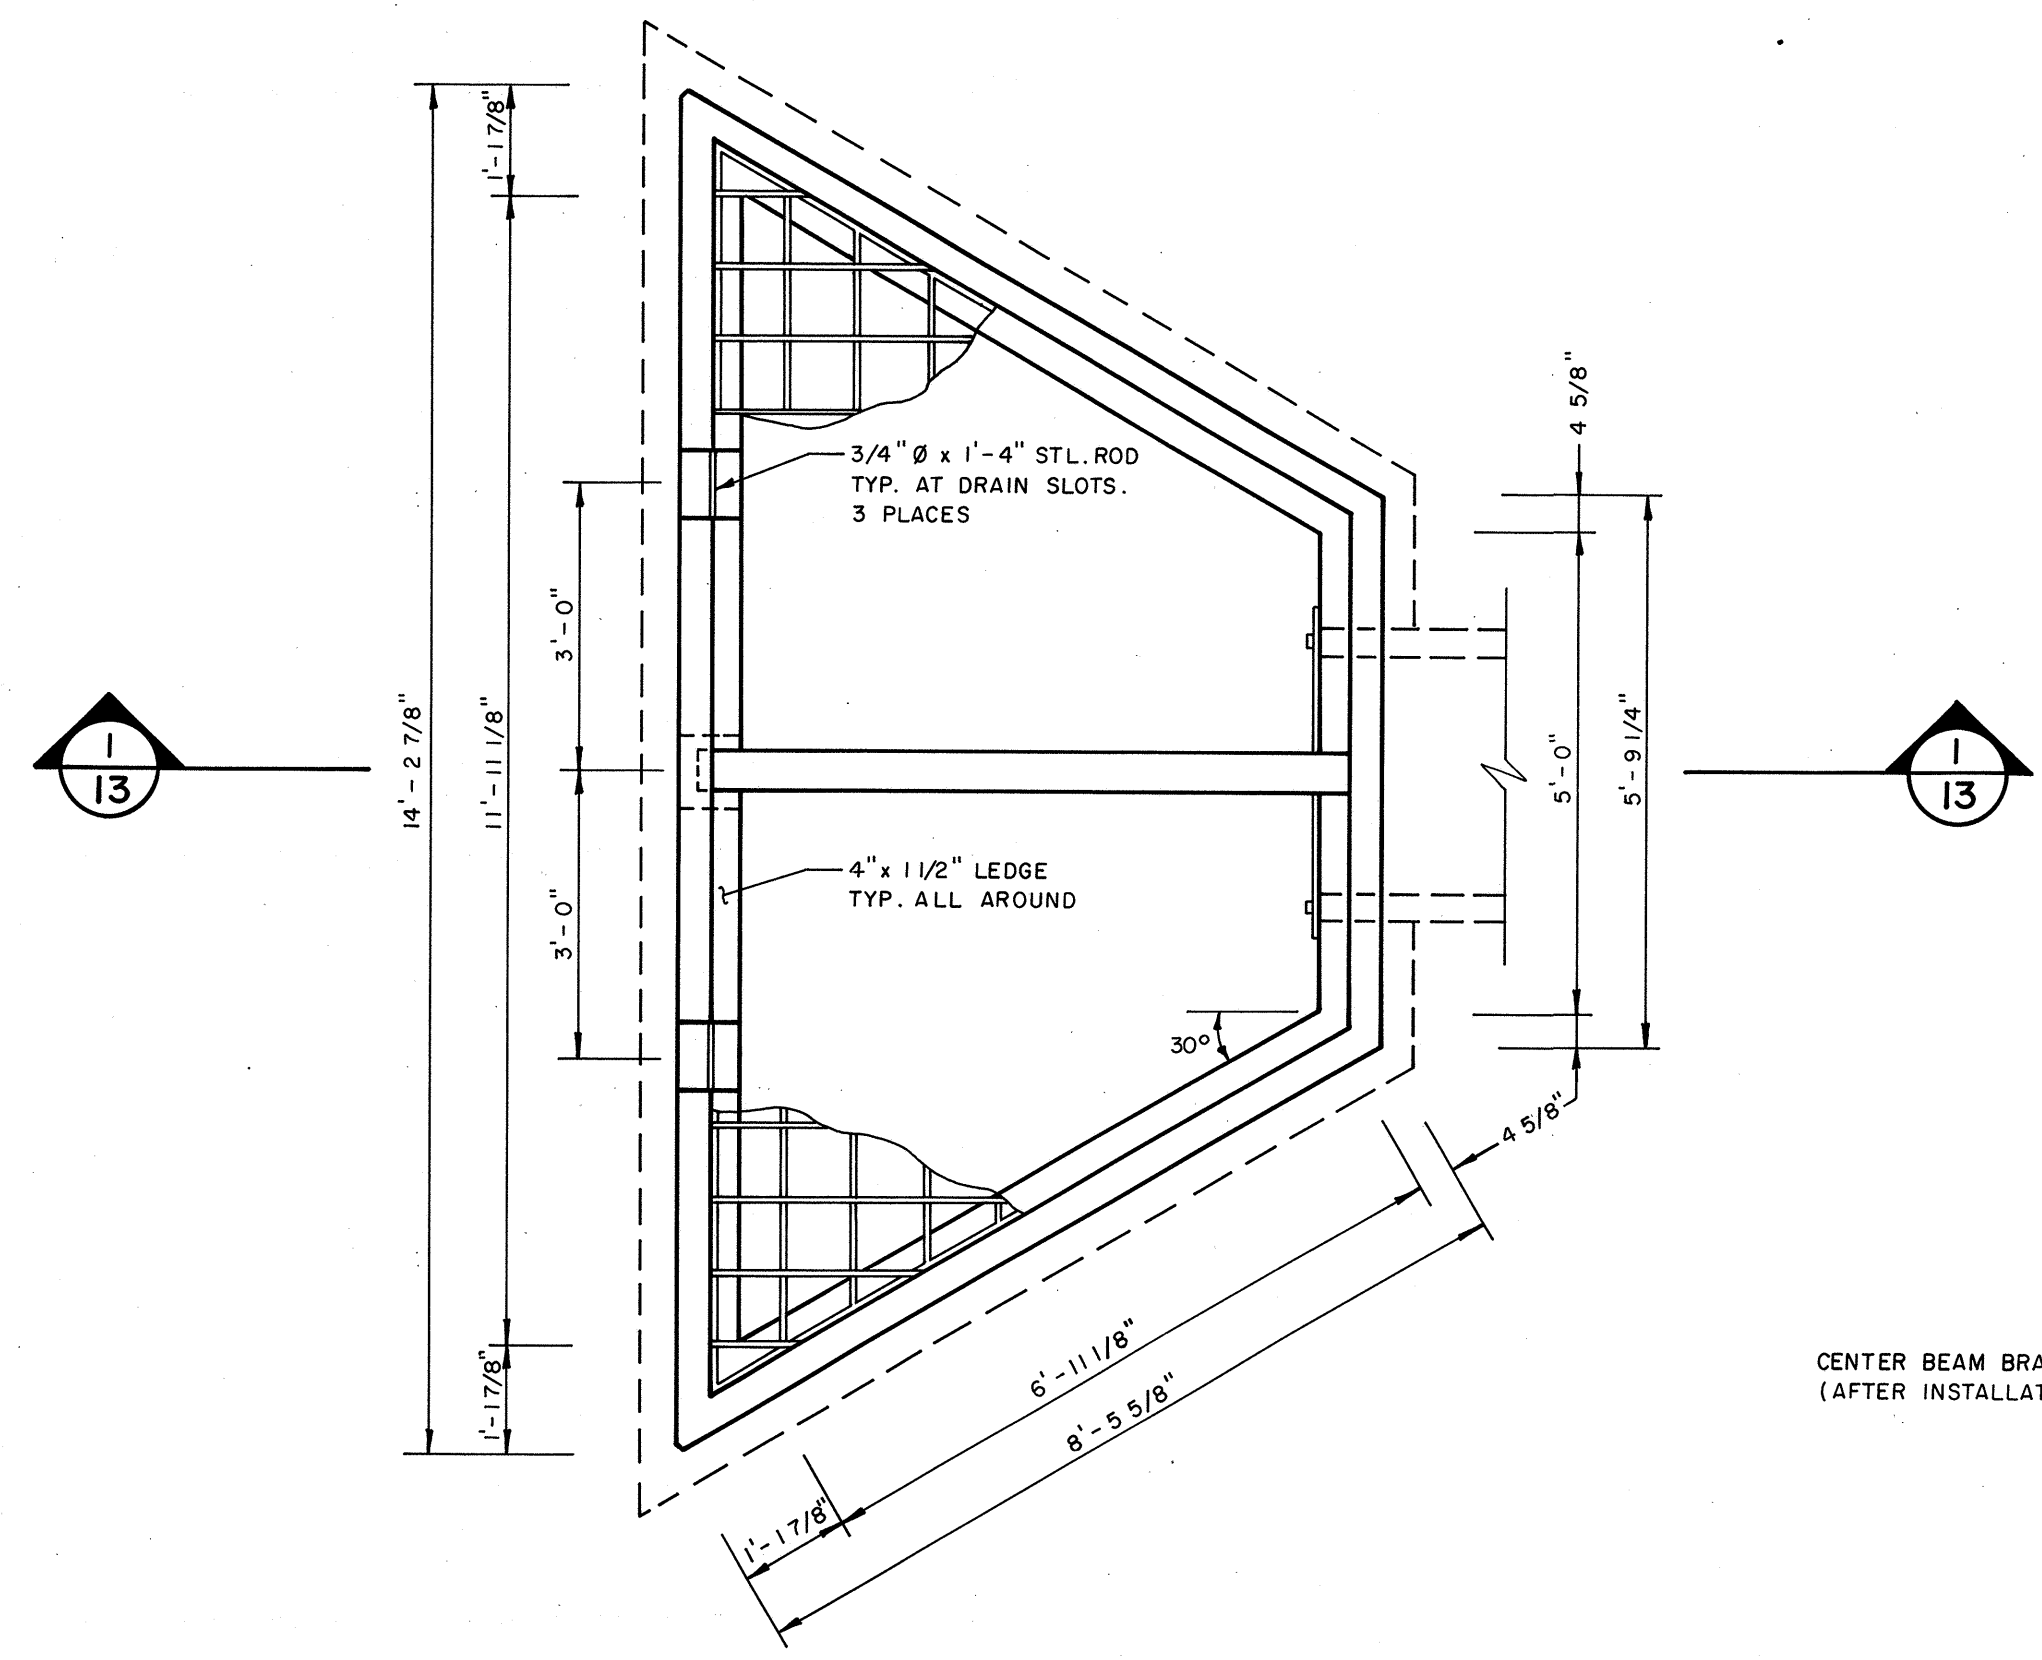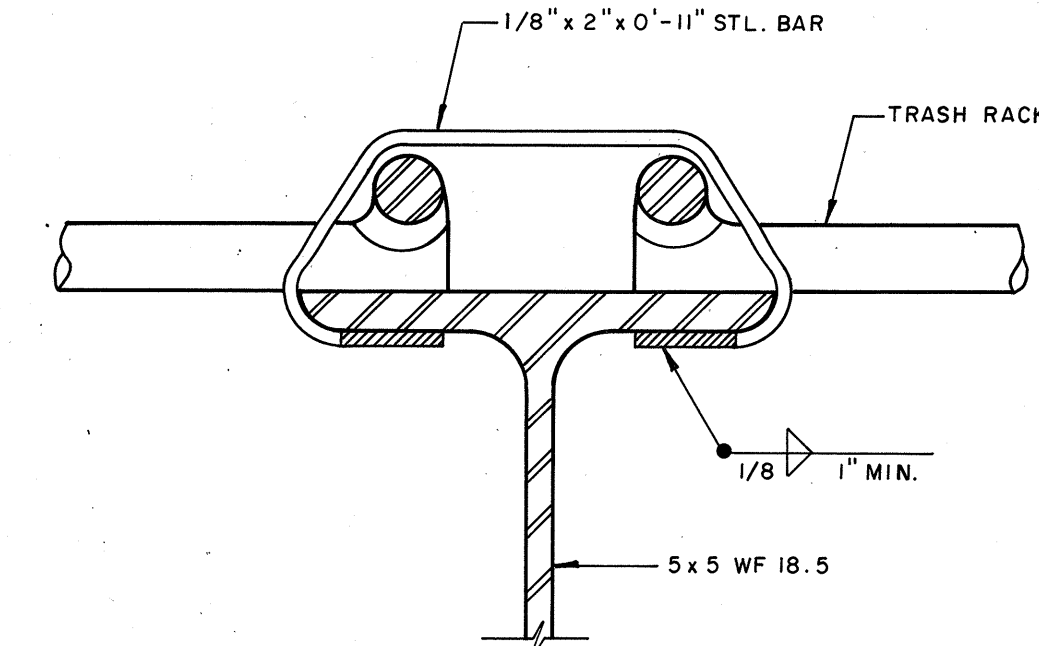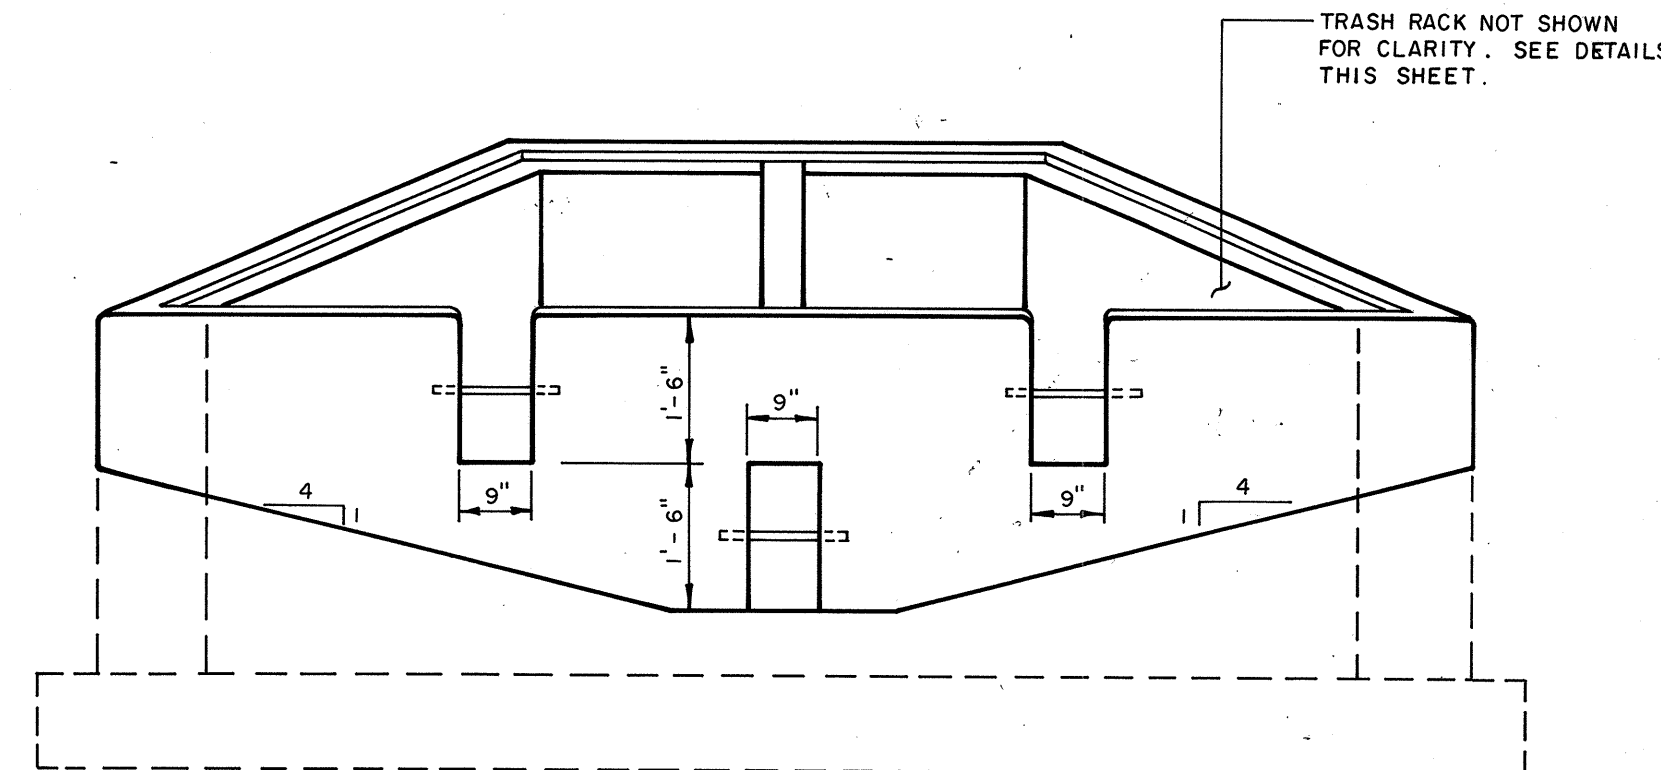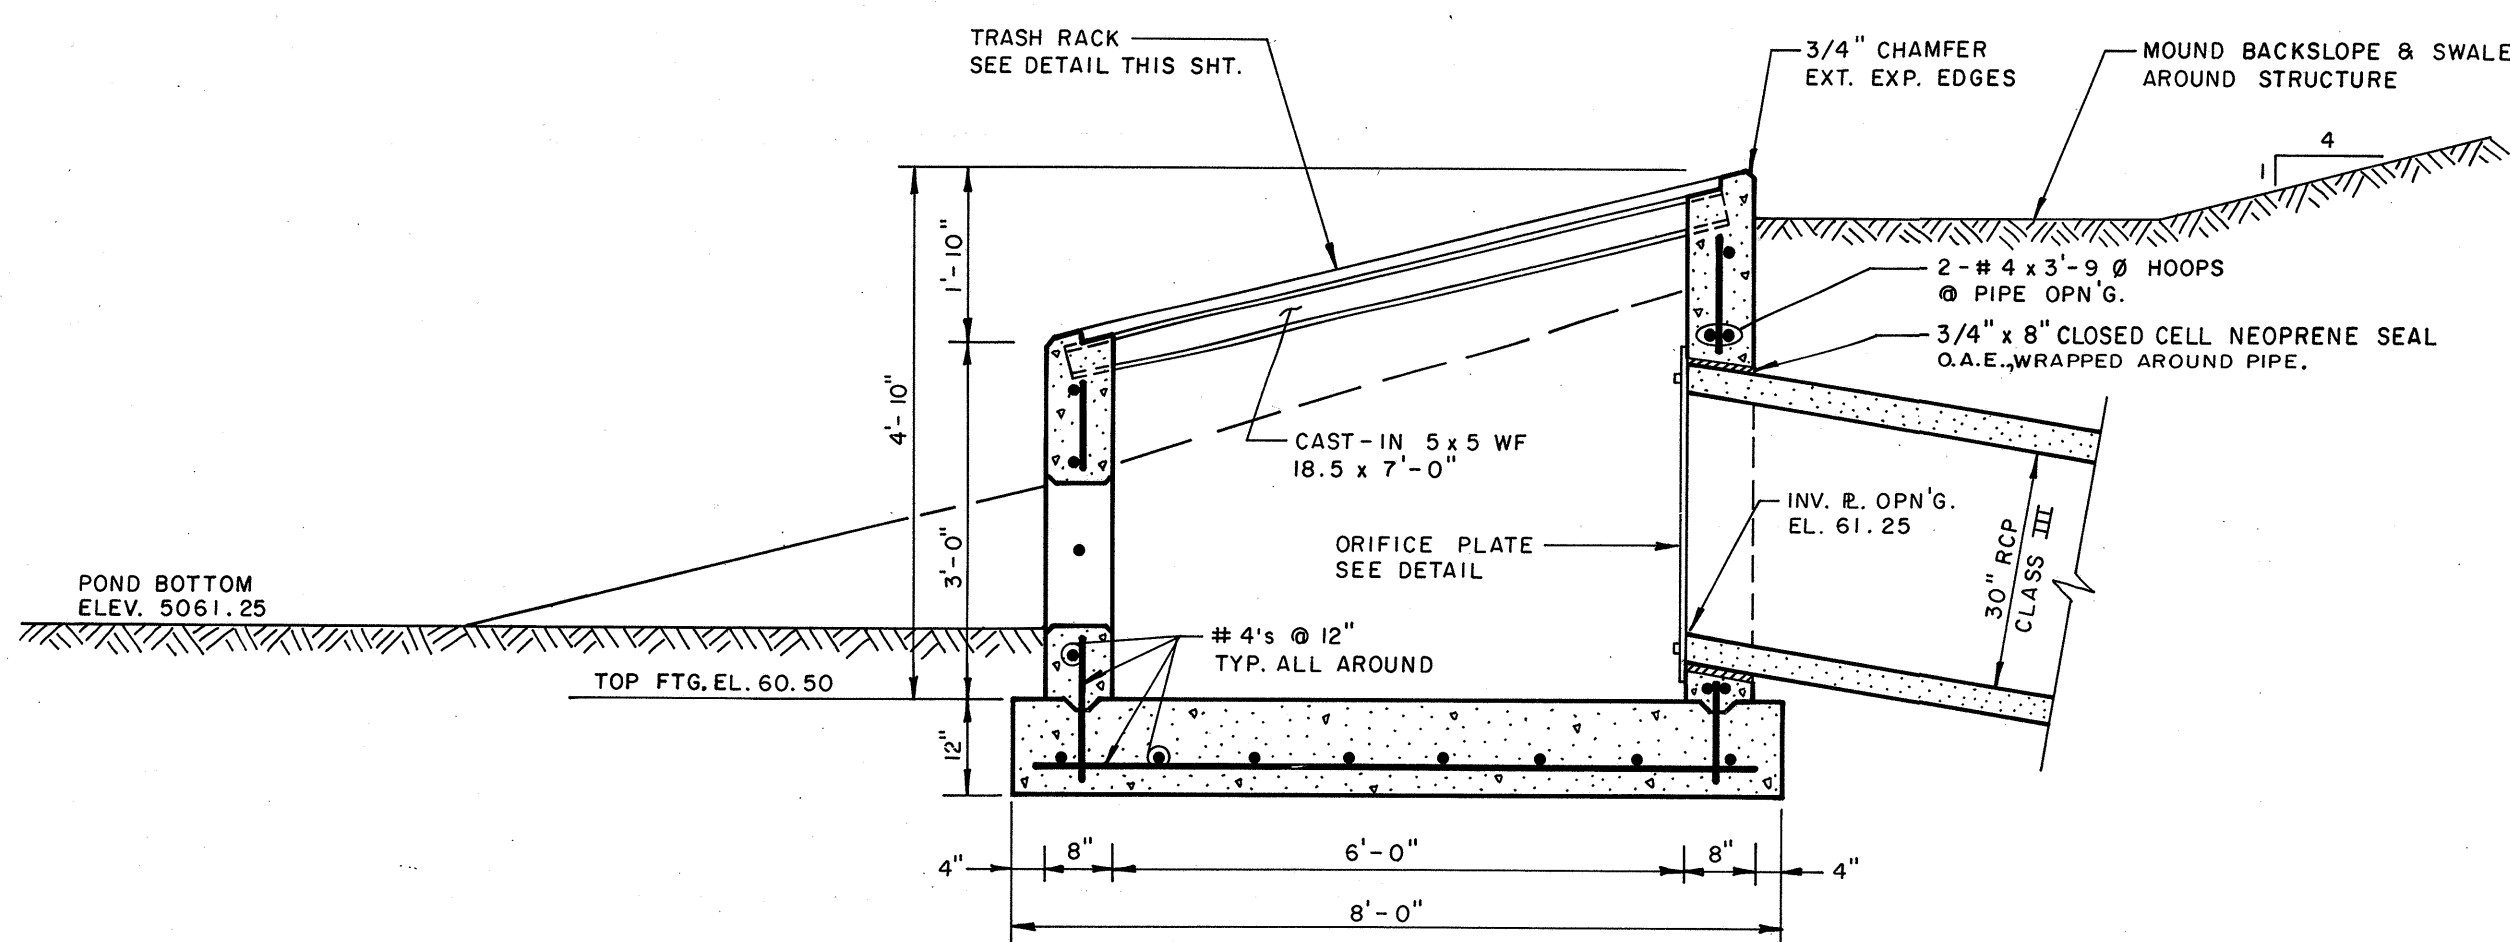

NOTES: REINFORCING STEEL SHALL BE DETAILED IN ACCORDANCE WITH C.R.S.I. RECOMMENDED PRACTICE; 20 BAR DIAMETERS MIN. LAPS.

ALL EXPOSED STRUCTURAL STEEL SHALL BE SHOP PRIMED AND PAINTED WITH TWO COATS OF ALUMINUM PAINT. (AASHTO M-69).

PORTLAND CEMENT CONCRETE SHALL BE 3,000 PSI @ 28 DAYS W/ AIR ENTRAINMENT, 4" MAX. SLUMP.

EXPOSED CONCRETE SURFACE SHALL HAVE CLASS II SURFACE FINISH.

RECORD DRAWINGS


THESE DRAWINGS HAVE BEEN REVISED IN ACCORDANCE WITH INFORMATION PROVIDED BY COMMUNITY SCIENCES CORP., HUGG SURVEYING CO. AND EASTERLING & ASSOCIATES, INC. TO REFLECT THE CONSTRUCTION AS ACCOMPLISHED.

DESIGNED BY *[Signature]*
DRAWN BY *[Signature]*
CHECKED BY *[Signature]*


(APPROXIMATELY 7 C.Y. CONCRETE IS REQUIRED.)

CITY OF ALBUQUERQUE MUNICIPAL DEVELOPMENT DEPARTMENT ENGINEERING DIVISION					
TITLE: INLET STRUCTURE DETAILS PERMANENT DETENTION POND					
APPROVALS	ENGINEER	DATE	APPROVALS	ENGINEER	DATE
City Engineer	<i>[Signature]</i>	6/12/85	Liquid Waste	<i>[Signature]</i>	6/12/85
A.C.E.-Design	<i>[Signature]</i>	6/12/85	Traffic	<i>[Signature]</i>	6/12/85
-Hydrology	<i>[Signature]</i>	6/12/85	Water	<i>[Signature]</i>	6/12/85
DRAWING NO. 2204		MAP NO. C-13		SHEET 13 OF 19	


AS BUILT INFORMATION		BENCH MARKS		SURVEY INFORMATION		ENGINEER'S SEAL	
CONTRACTOR	DATE	ACS BRASS CAP "NM 448-N9A"	DATE	FIELD NOTES	NO.		NO. DATE REMARKS REVISIONS DESIGN DESIGNED BY <i>[Signature]</i> DRAWN BY <i>[Signature]</i> CHECKED BY <i>[Signature]</i>
WORKED BY	DATE	ELEV. 5004.145, LOCATED AT THE	DATE	BY	DATE		
INSPECTED BY	DATE	INTERSECTION OF COORS RD. AND	DATE	DATE	DATE		
VERIFIED BY	DATE	PARADISE BLVD. N.W.	DATE	DATE	DATE		
MICRO-FILM INFORMATION		MICRO-FILM INFORMATION		MICRO-FILM INFORMATION		MICRO-FILM INFORMATION	
RECORDED BY	DATE	RECORDED BY	DATE	RECORDED BY	DATE	DESIGNED BY <i>[Signature]</i> DRAWN BY <i>[Signature]</i> CHECKED BY <i>[Signature]</i>	

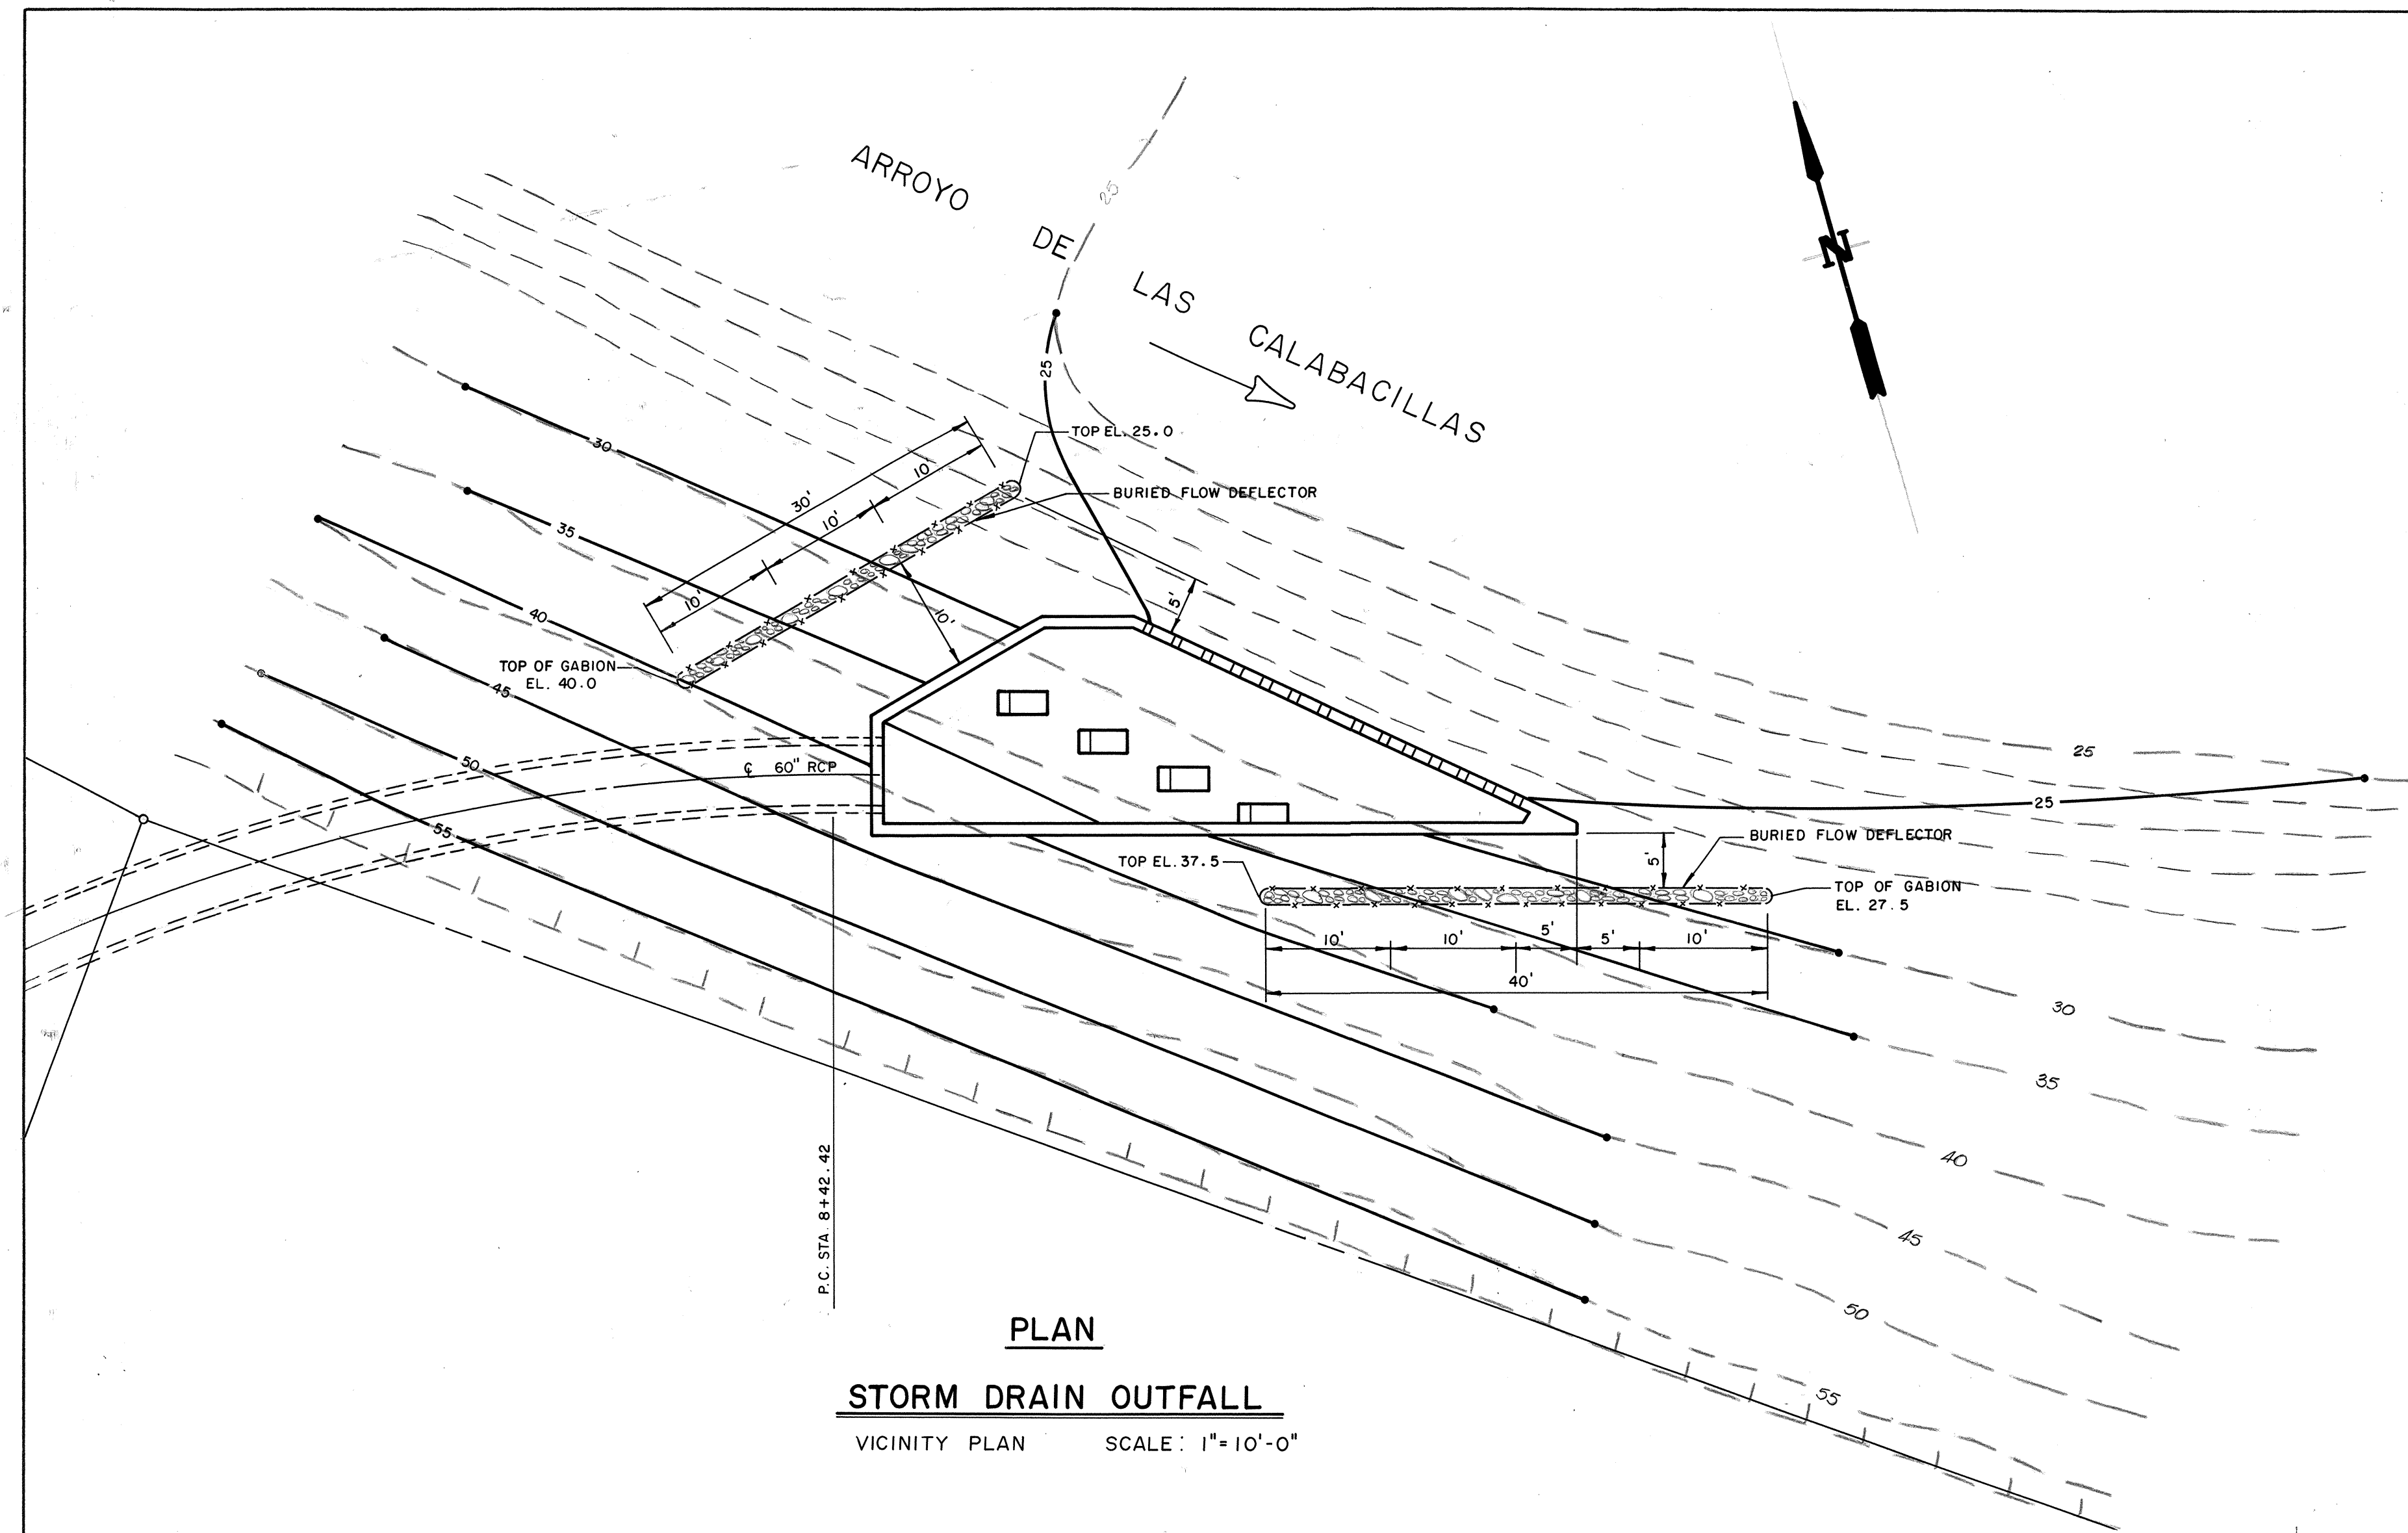

PLAN
STORM DRAIN OUTFALL
 VICINITY PLAN SCALE: 1"=10'-0"

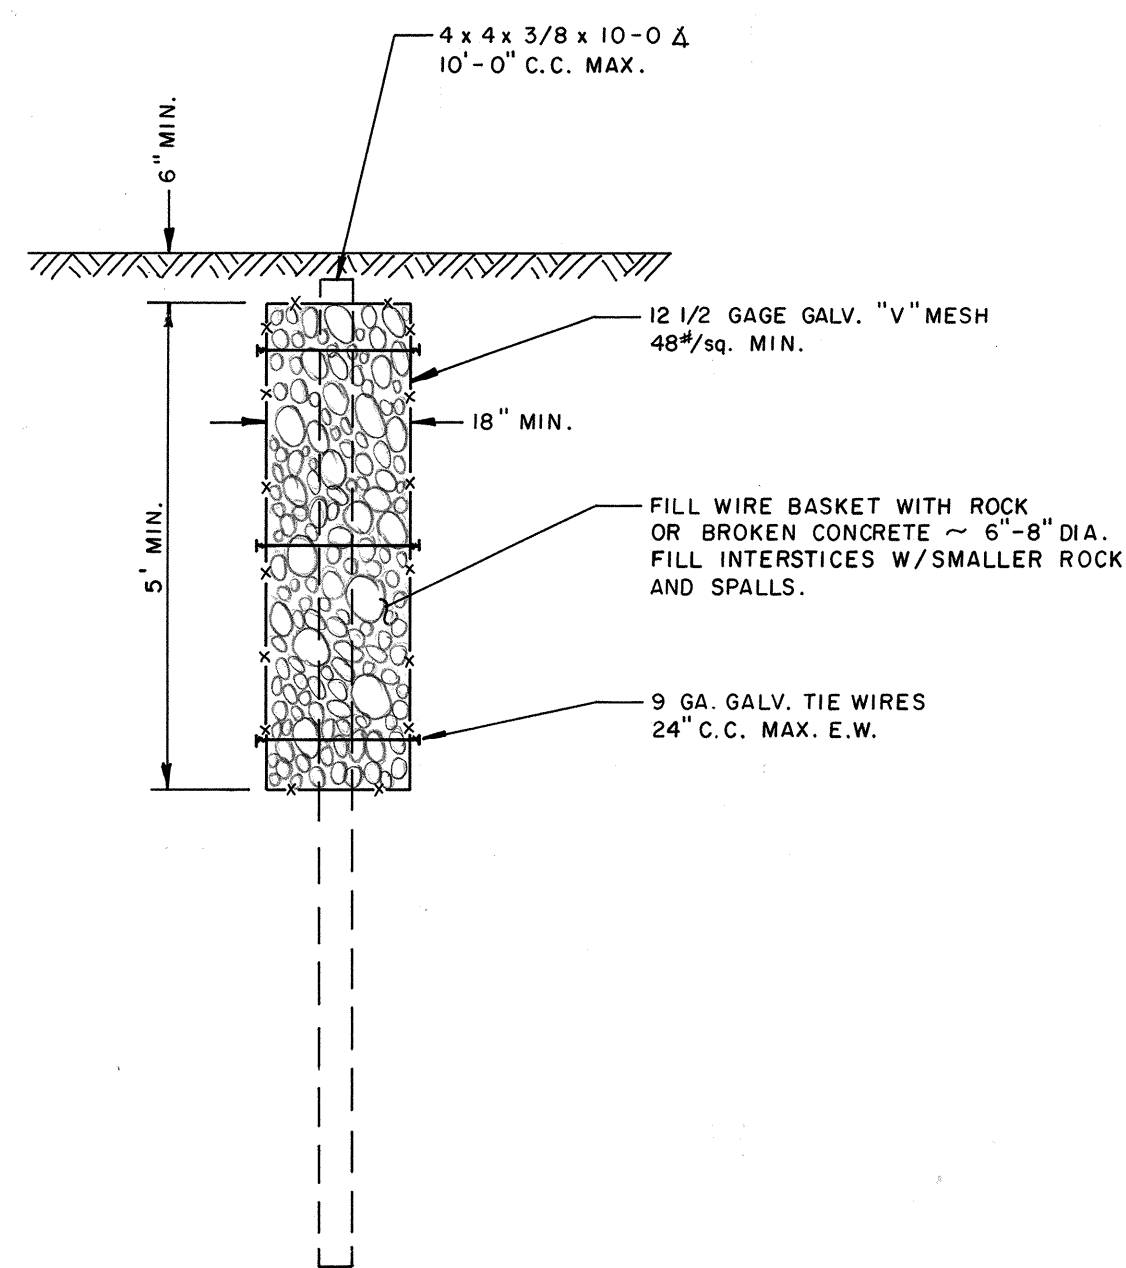

SECTION

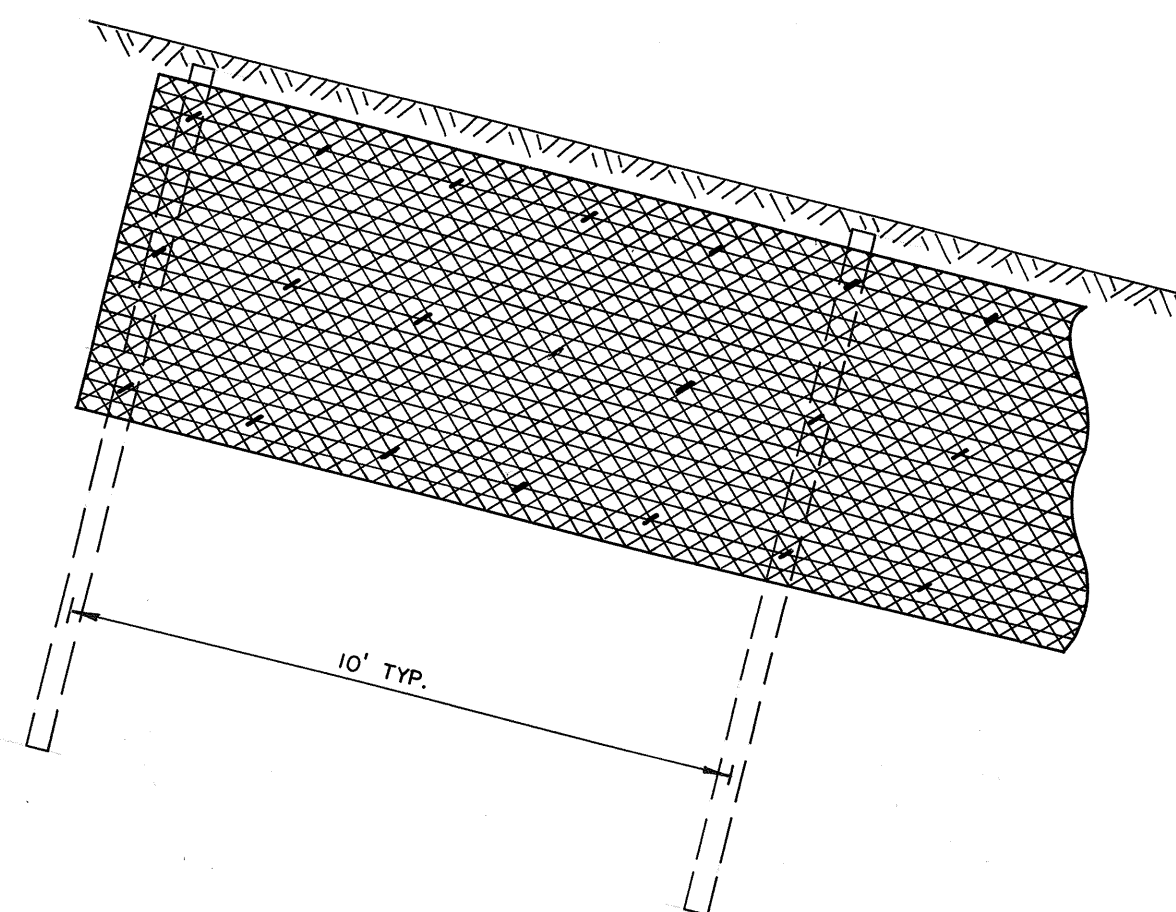

PART ELEVATION

BURIED ROCK GABION FLOW DEFLECTOR
 NO SCALE


RECORD DRAWINGS
 THESE DRAWINGS HAVE BEEN REVISED IN ACCORDANCE WITH INFORMATION PROVIDED BY COMMUNITY SCIENCES CORP., HUGG SURVEYING CO. AND EASTERLING & ASSOCIATES, INC. TO REFLECT THE CONSTRUCTION AS ACCOMPLISHED.




1	2	3	4	5	6	7	8	9	10	11	12
26	22	04	14	86							

CITY OF ALBUQUERQUE MUNICIPAL DEVELOPMENT DEPARTMENT ENGINEERING DIVISION			
TITLE: EAGLE RANCH ROAD STORMDRAIN OUTFALL STRUCTURE DETAILS			
APPROVALS	ENGINEER	DATE	APPROVALS
City Engineer	<i>[Signature]</i>	6/12/85	Liquid Waste
A.C.E. - Design	<i>[Signature]</i>	6/12/85	Traffic
Hydrology	<i>[Signature]</i>	6/12/85	Water
DRAWING NO.	2204	MAP NO.	B-13
SHEET	14	OF	19


SURVEY INFORMATION		BENCH MARKS		AS BUILT INFORMATION	
NO.	BY	DATE	CONTRACTOR	WORK	DATE
1	LEVERTON - EASTERLING INC.	9-10-84	ACS BRASS CAP "NM 448-N9A"	REVISIONS	DATE
2			ELEV. 5004.145, LOCATED AT THE INTERSECTION OF COORS RD. AND PARADISE BLVD. N.W.	FIELD ACCEPTANCE BY	DATE
3				DRAWINGS	DATE
4				CORRECTED BY	DATE
5				MICRO-FILM	DATE
6				RECORDED BY	DATE
7					
8					
9					
10					
11					
12					

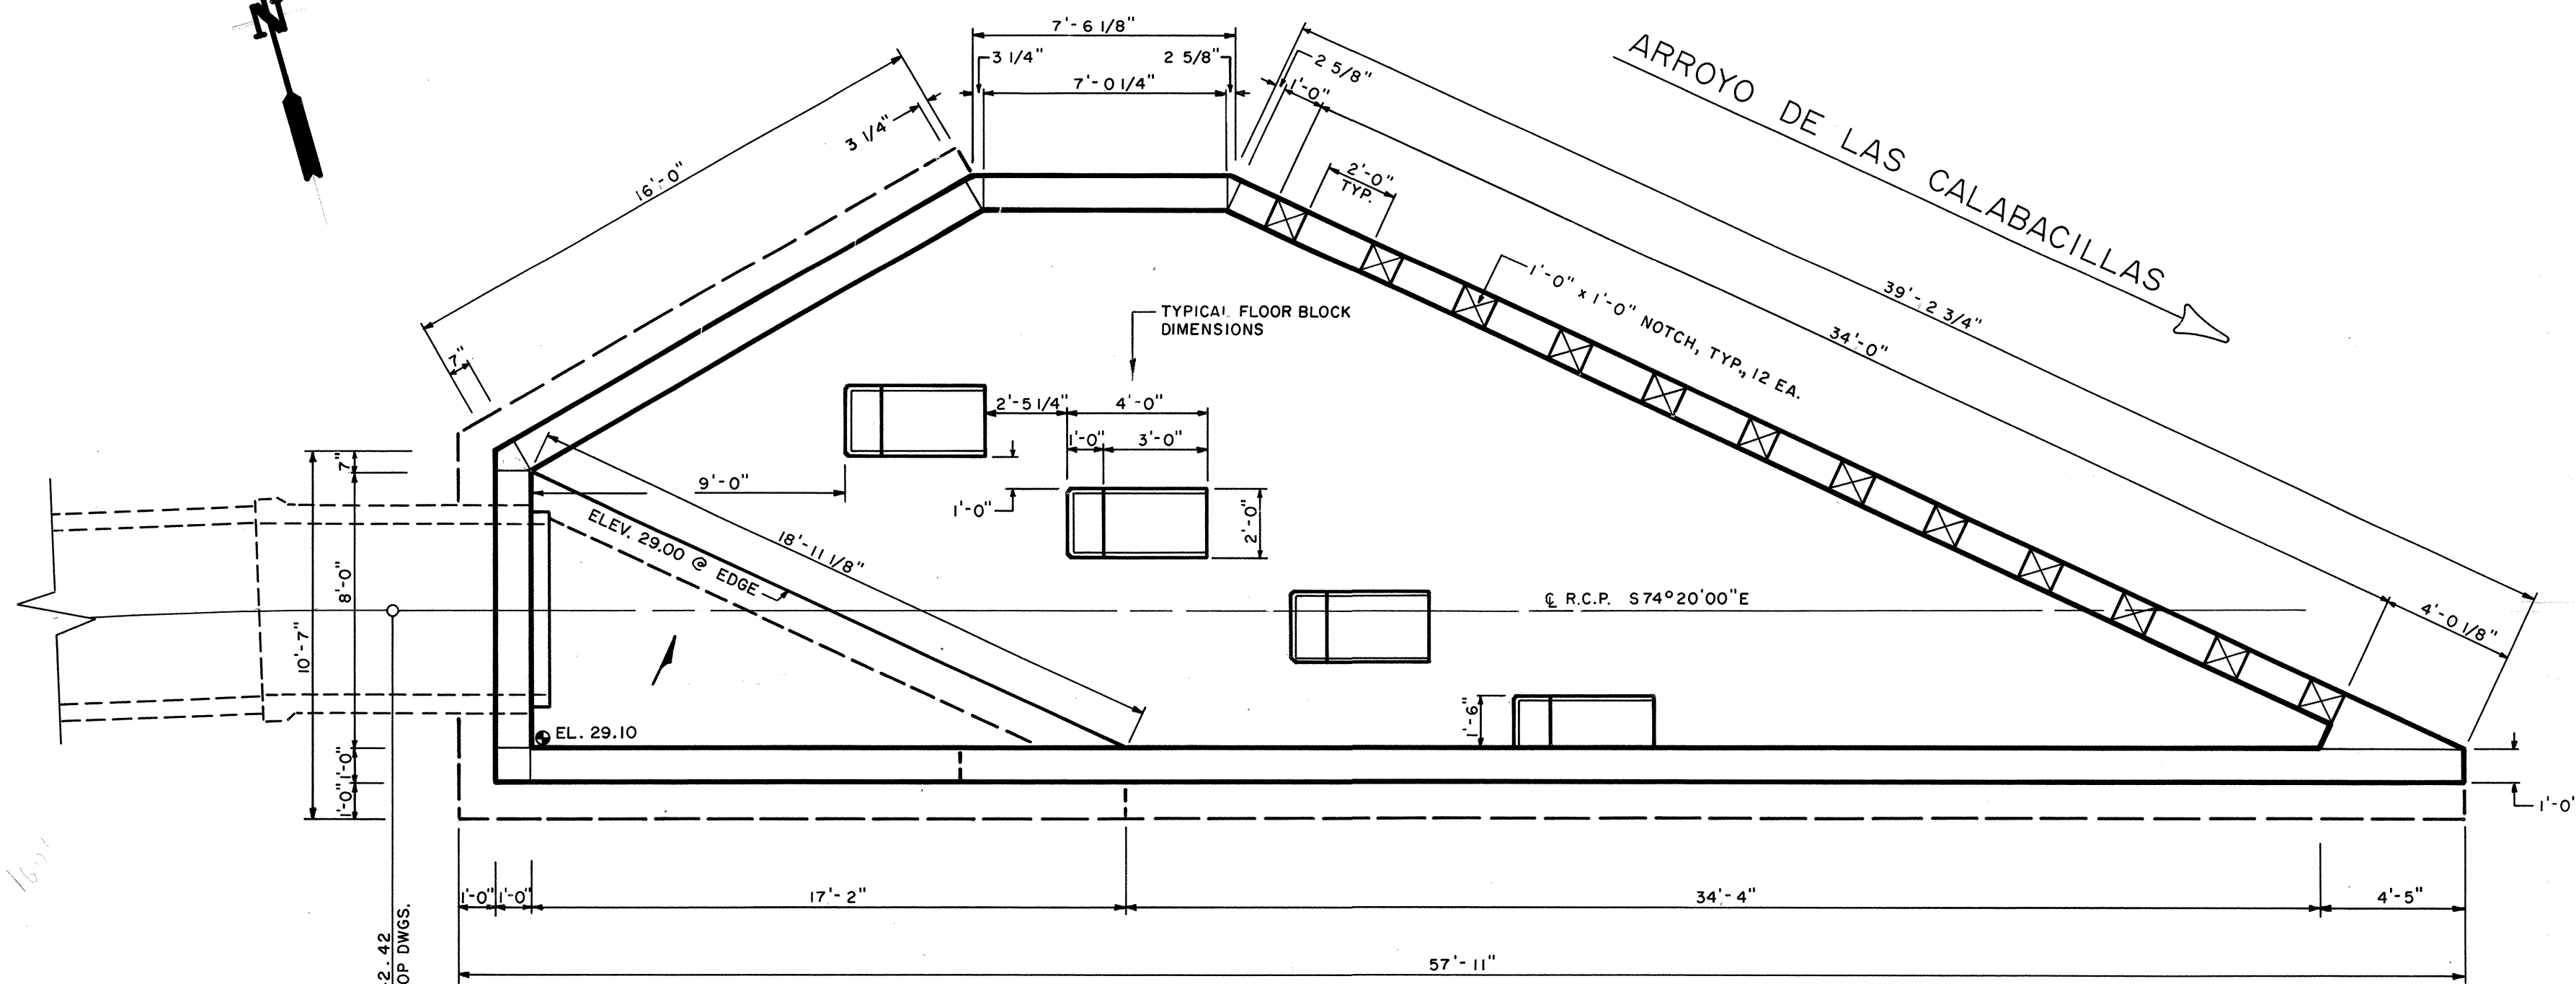

PLAN
SCALE: 1/4" = 1'-0"

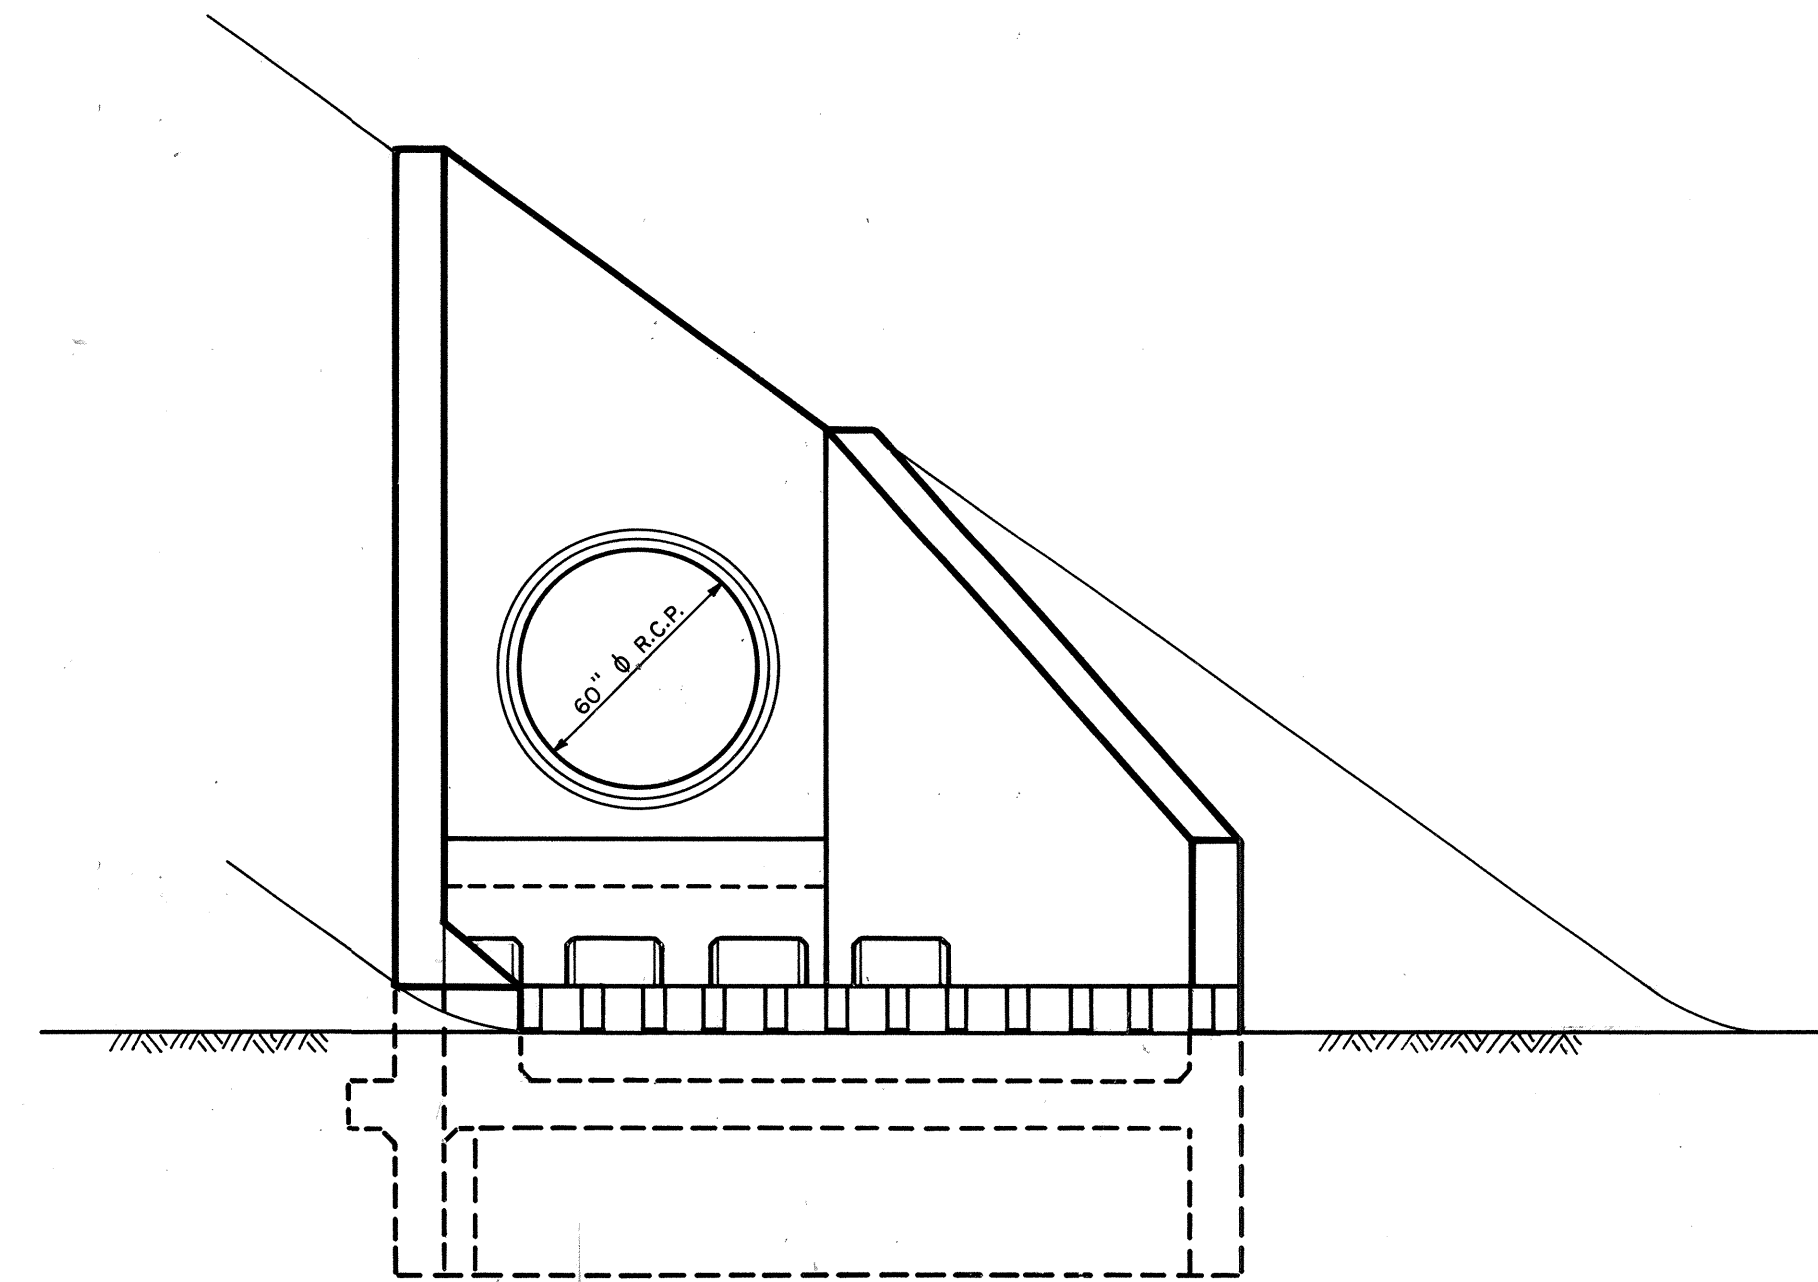

EAST ELEVATION
SCALE: 1/4" = 1'-0"

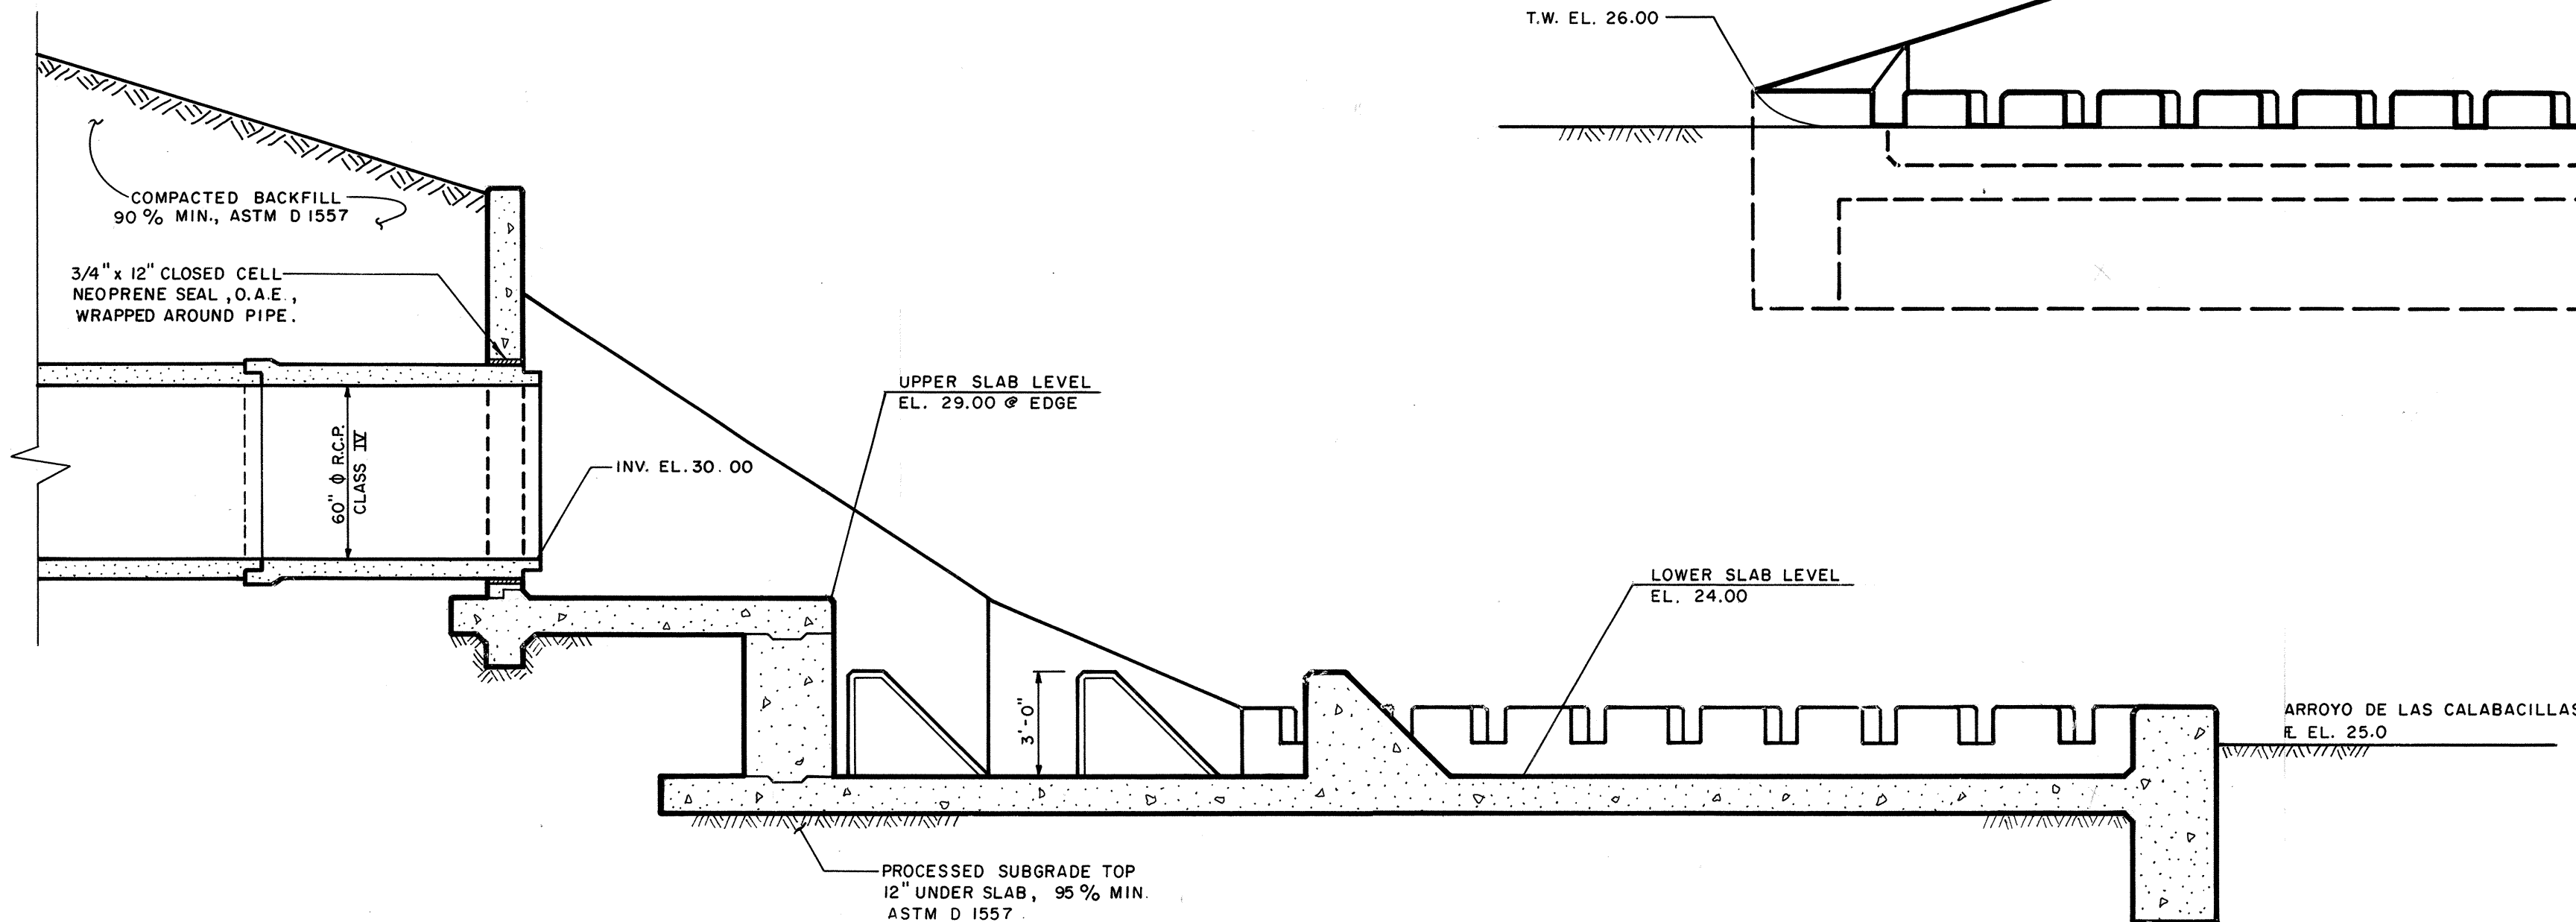

SECTION @ PIPE 2
SCALE: 1/4" = 1'-0"

NORTH ELEVATION
SCALE: 1/4" = 1'-0"

NOTES: PORTLAND CEMENT CONCRETE SHALL MEET THE REQUIREMENTS OF SECTION 339 - PORTLAND CEMENT FLYASH CONCRETE CHANNEL LINING - EXCEPT THAT 3/4" MAXIMUM SIZE AGGREGATE SHALL BE USED. THE CONCRETE SHALL BE MIXED WITH A MAXIMUM SLUMP OF 3 INCHES. HRWRA ("SUPER PLASTICIZER") MAY BE ADDED AT THE JOB SITE TO ACHIEVE THE CONSISTENCY THE CONTRACTOR DESIRES TO PLACE THE WORK AT HAND.

EXPOSED CONCRETE SURFACES SHALL BE GIVEN A CLASS II SURFACE FINISH.

RECORD DRAWINGS


THESE DRAWINGS HAVE BEEN REVISED IN ACCORDANCE WITH INFORMATION PROVIDED BY COMMUNITY SCIENCES CORP., HUGG SURVEYING CO. AND EASTERLING & ASSOCIATES, INC. TO REFLECT THE CONSTRUCTION AS ACCOMPLISHED.












26 2204 1586


CITY OF ALBUQUERQUE MUNICIPAL DEVELOPMENT DEPARTMENT ENGINEERING DIVISION							
TITLE: EAGLE RANCH ROAD STORMDRAIN OUTLET STRUCTURE DETAILS							
APPROVALS	ENGINEER	DATE	APPROVALS	ENGINEER	DATE		
City Engineer	<i>[Signature]</i>	6/12/85	Liquid Waste	<i>[Signature]</i>	6/12/85		
A.C.E. - Design	<i>[Signature]</i>	6/12/85	Traffic	<i>[Signature]</i>	6/12/85		
Hydrology	<i>[Signature]</i>	6/12/85	Water	<i>[Signature]</i>	6/12/85		
DRAWING NO. 2204		MAP NO. B-13		SHEET 15 OF 19			

SURVEY INFORMATION		BENCH MARKS		AS BUILT INFORMATION	
NO.	BY	DATE	CONTRACTOR	WORK	DATE
1	LEVINGTON	9-10-84	ACS BRASS CAP "NM 448-NSA"	CONTRACTOR	DATE
2	EASTERLING INC.		ELEV. 5004.145, LOCATED AT THE	INSPECTOR'S	DATE
3			INTERSECTION OF COORS RD. AND	FIELD	DATE
4			PARADISE BLVD. N.W.	ACCEPTANCE BY	DATE
5				DRAWINGS	DATE
6				CONSTRUCTION	DATE
7				MICRO-FILM	DATE
8				RECORDED BY	DATE
9				NO.	

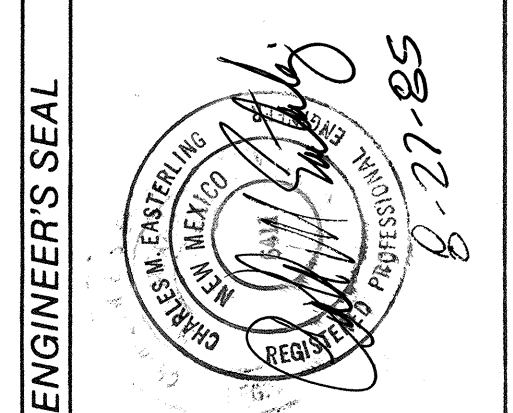


ENGINEER'S SEAL		REVISIONS		DESIGN	
NO.	BY	DATE	NO.	BY	DATE
1			1		
2			2		
3			3		
4			4		
5			5		
6			6		
7			7		
8			8		
9			9		
10			10		
11			11		
12			12		

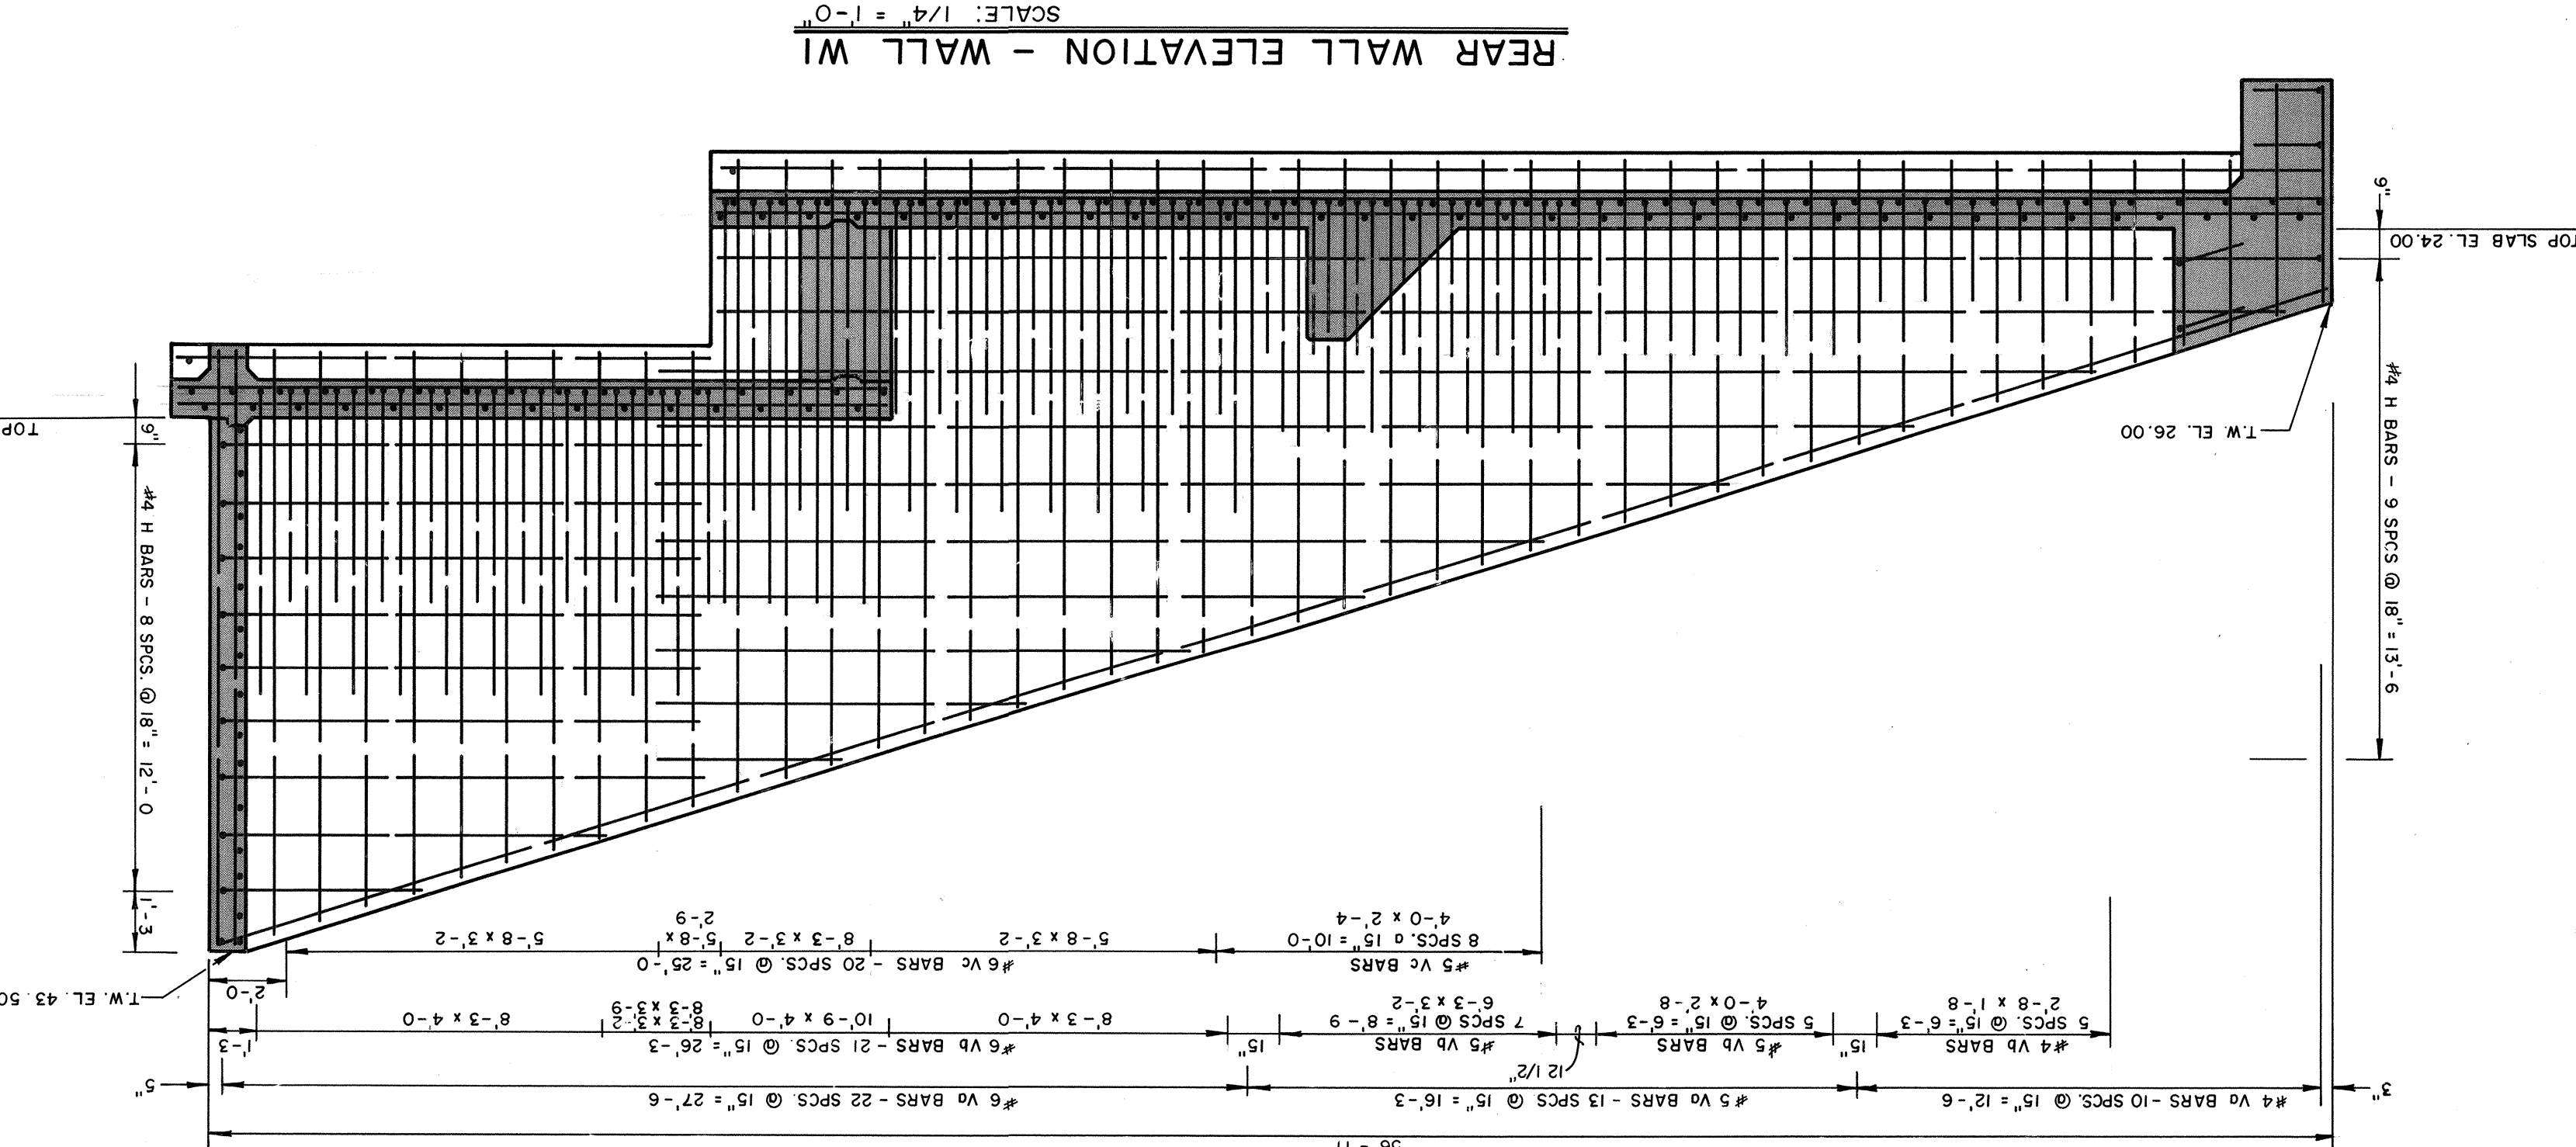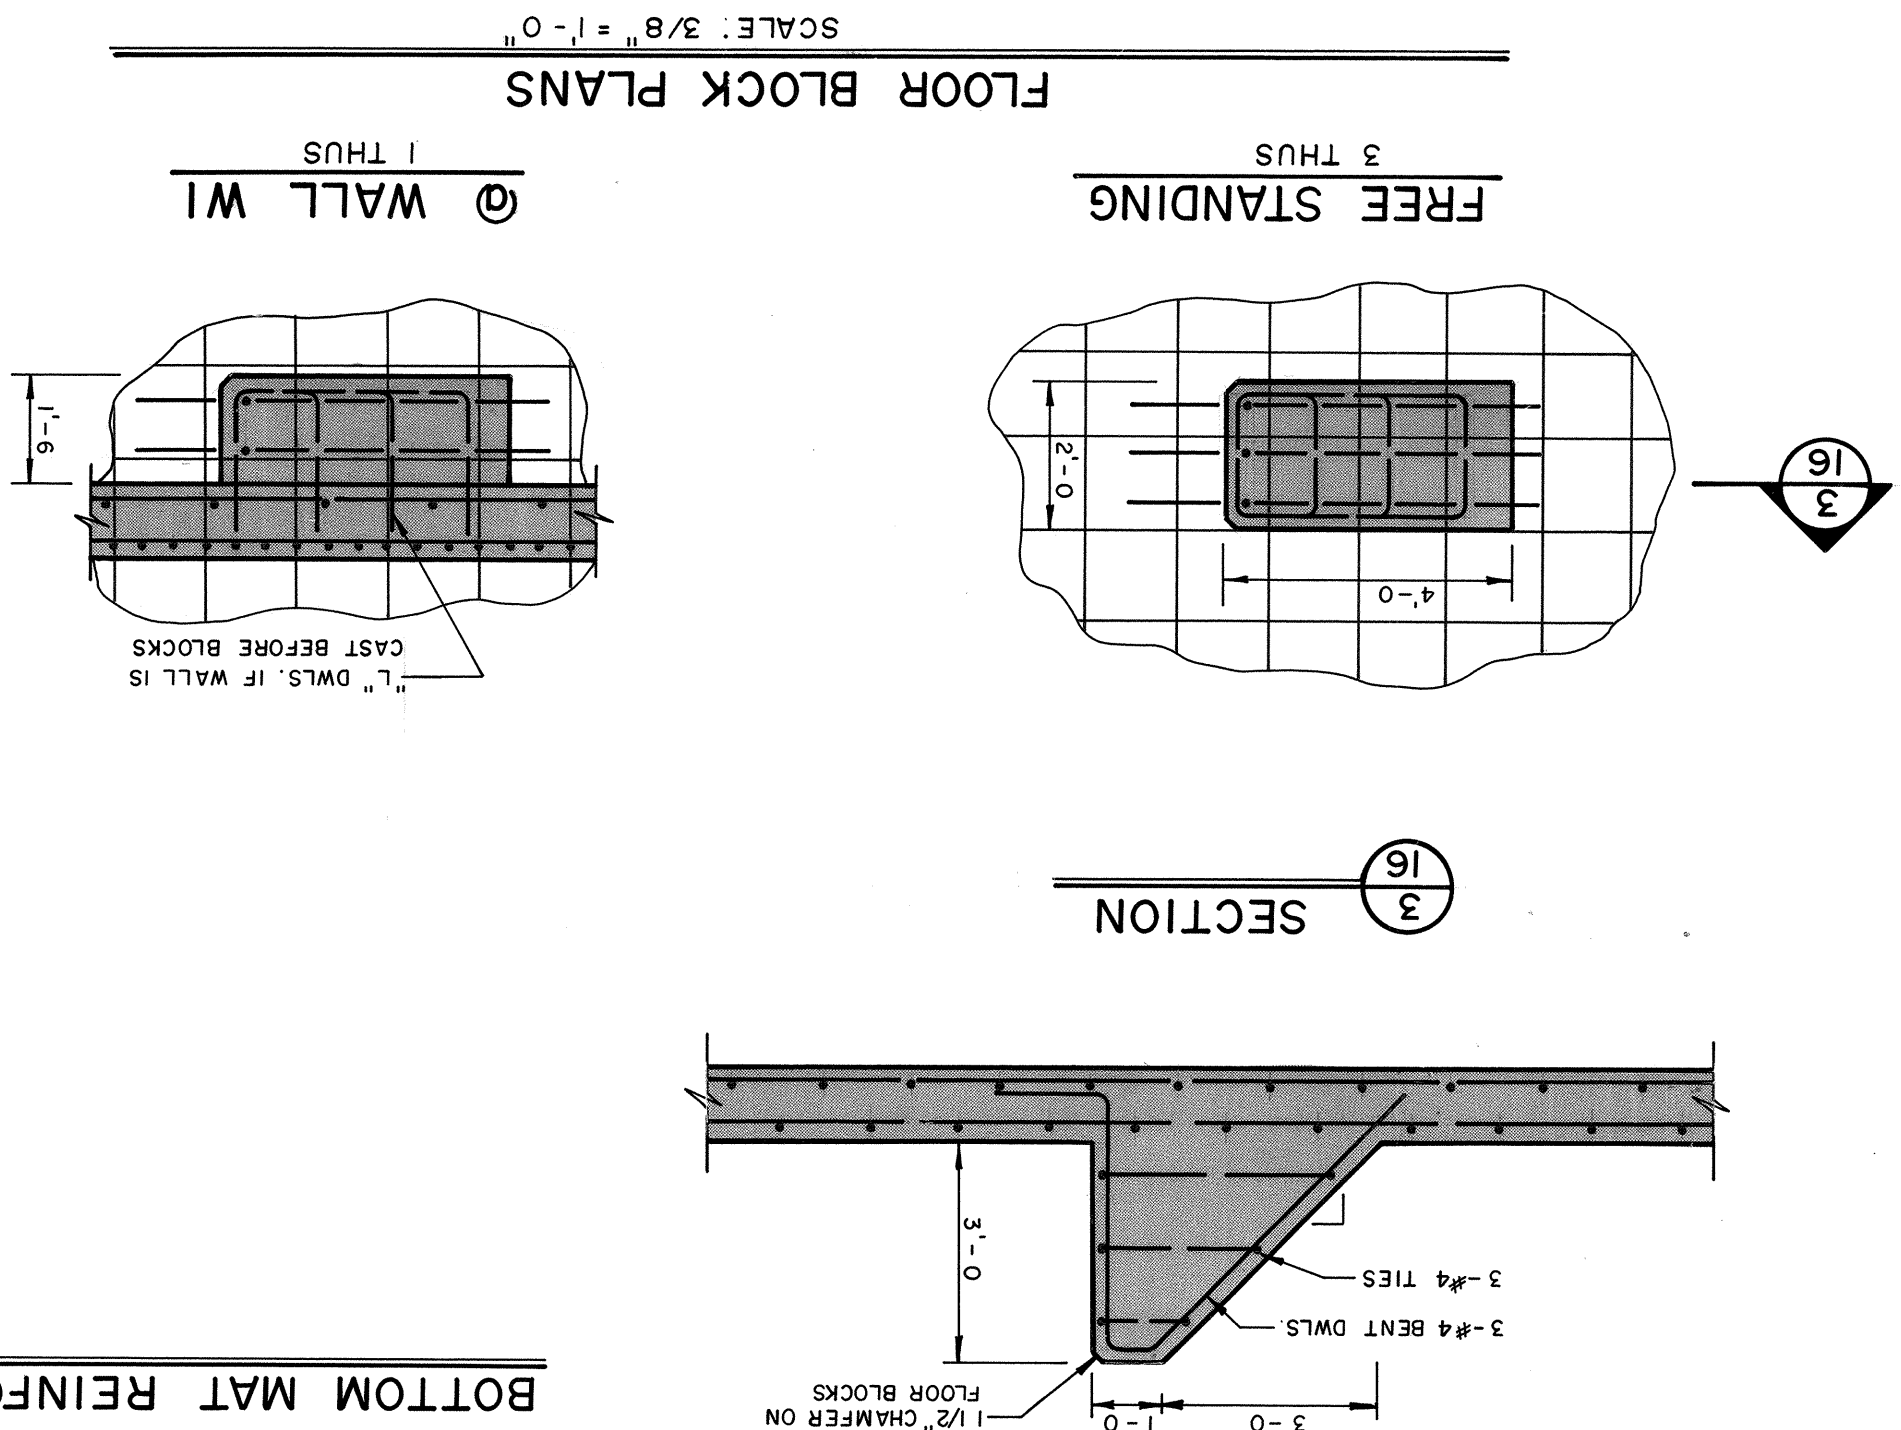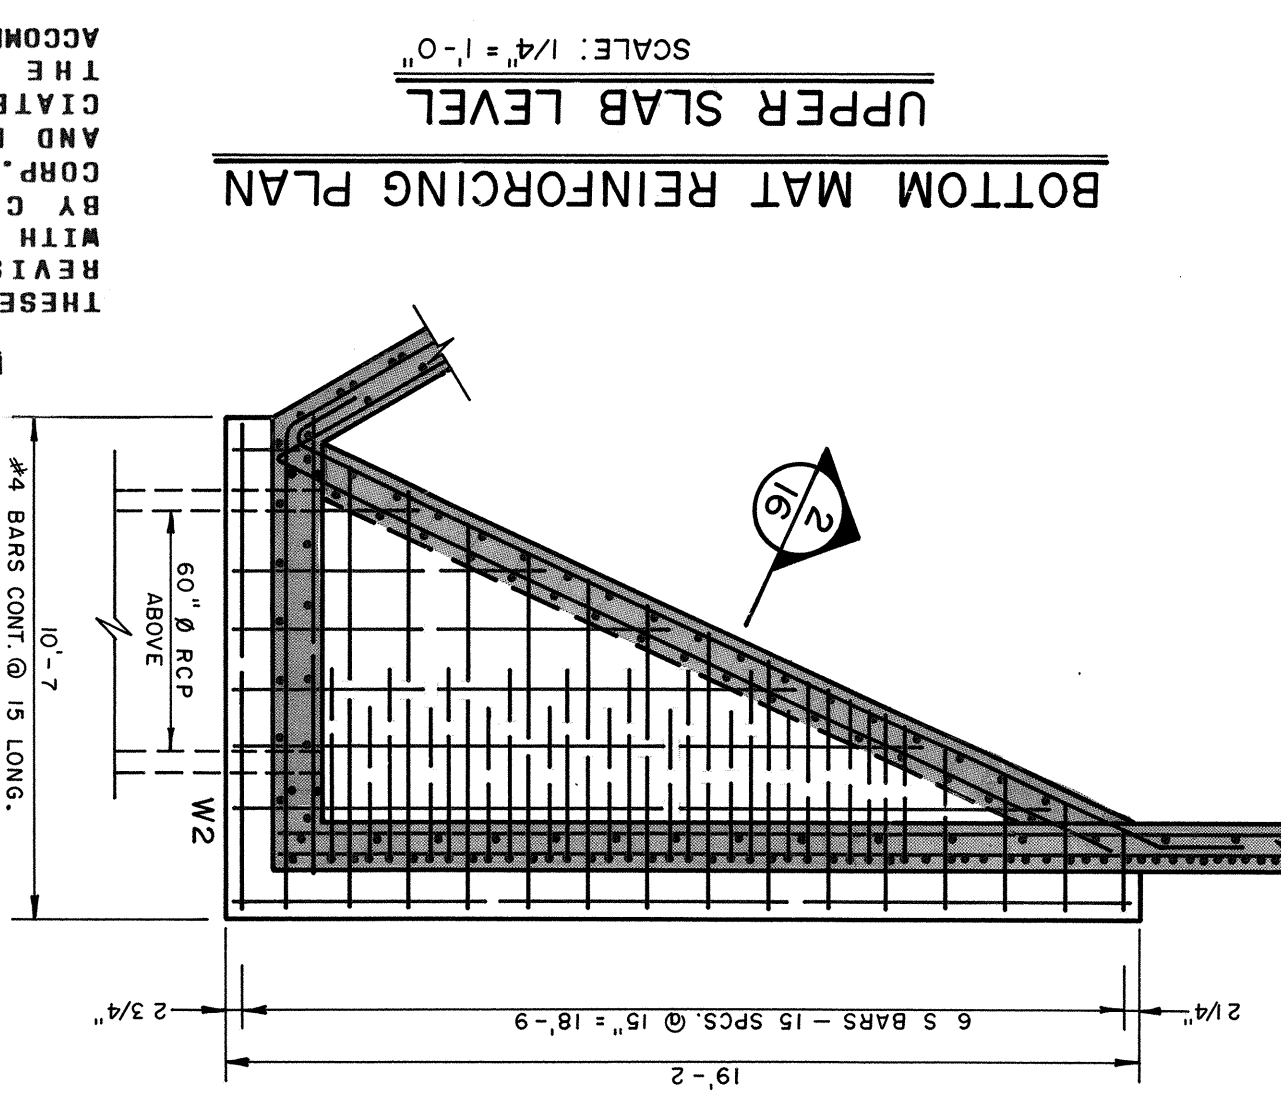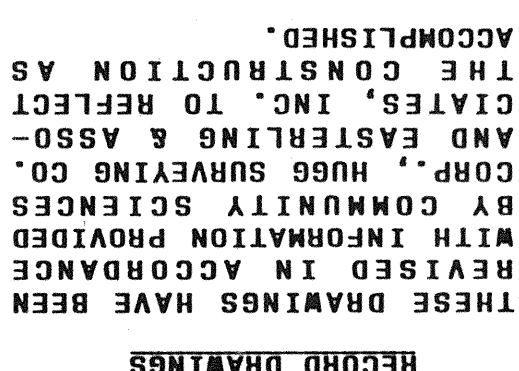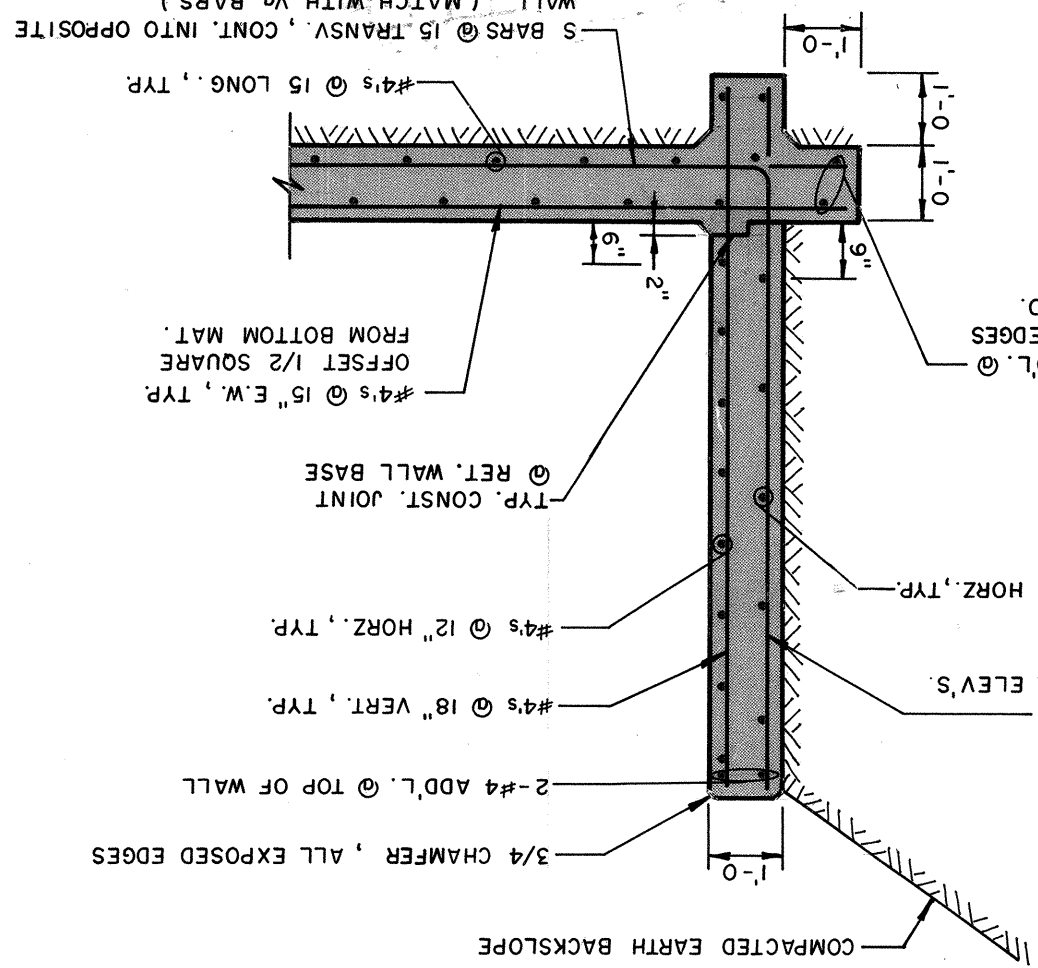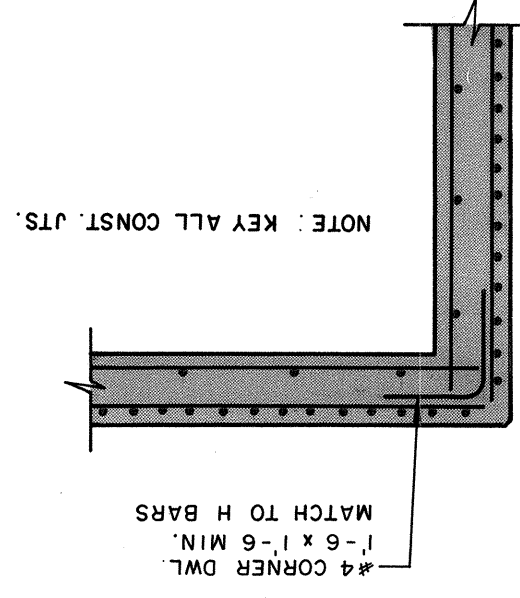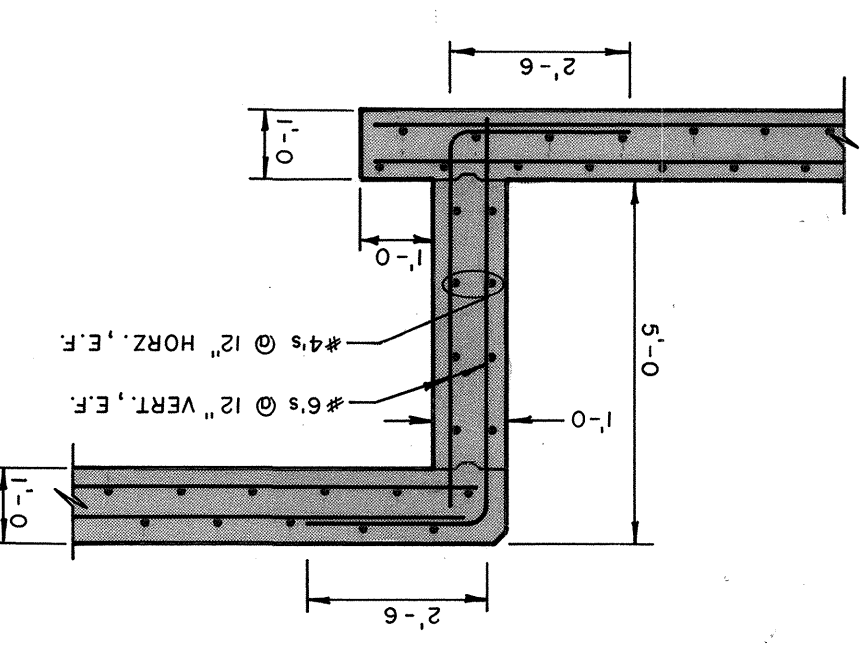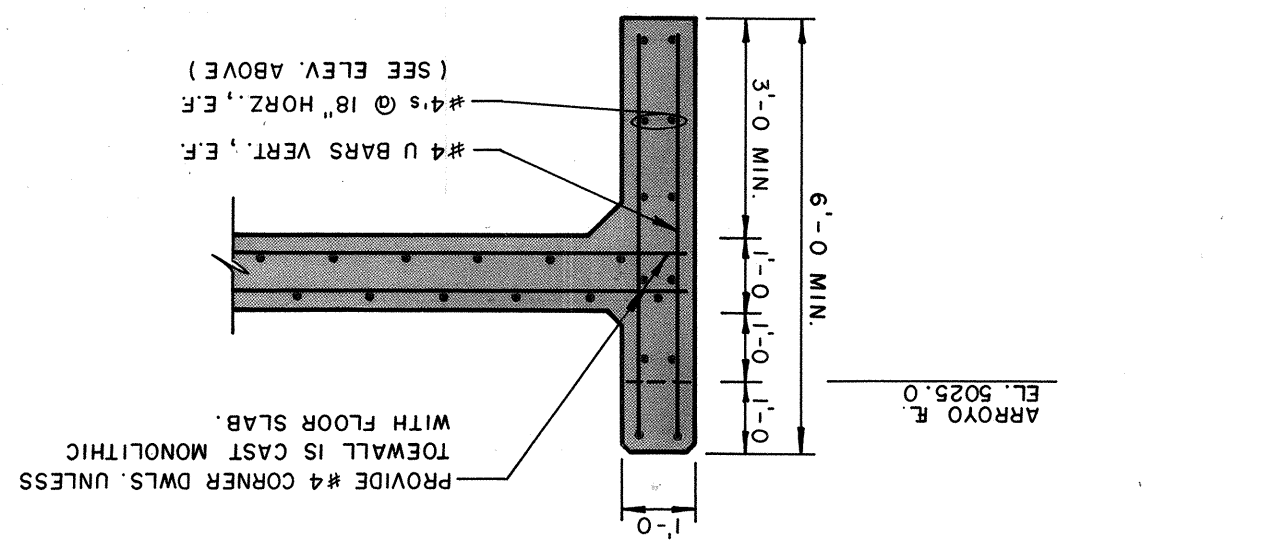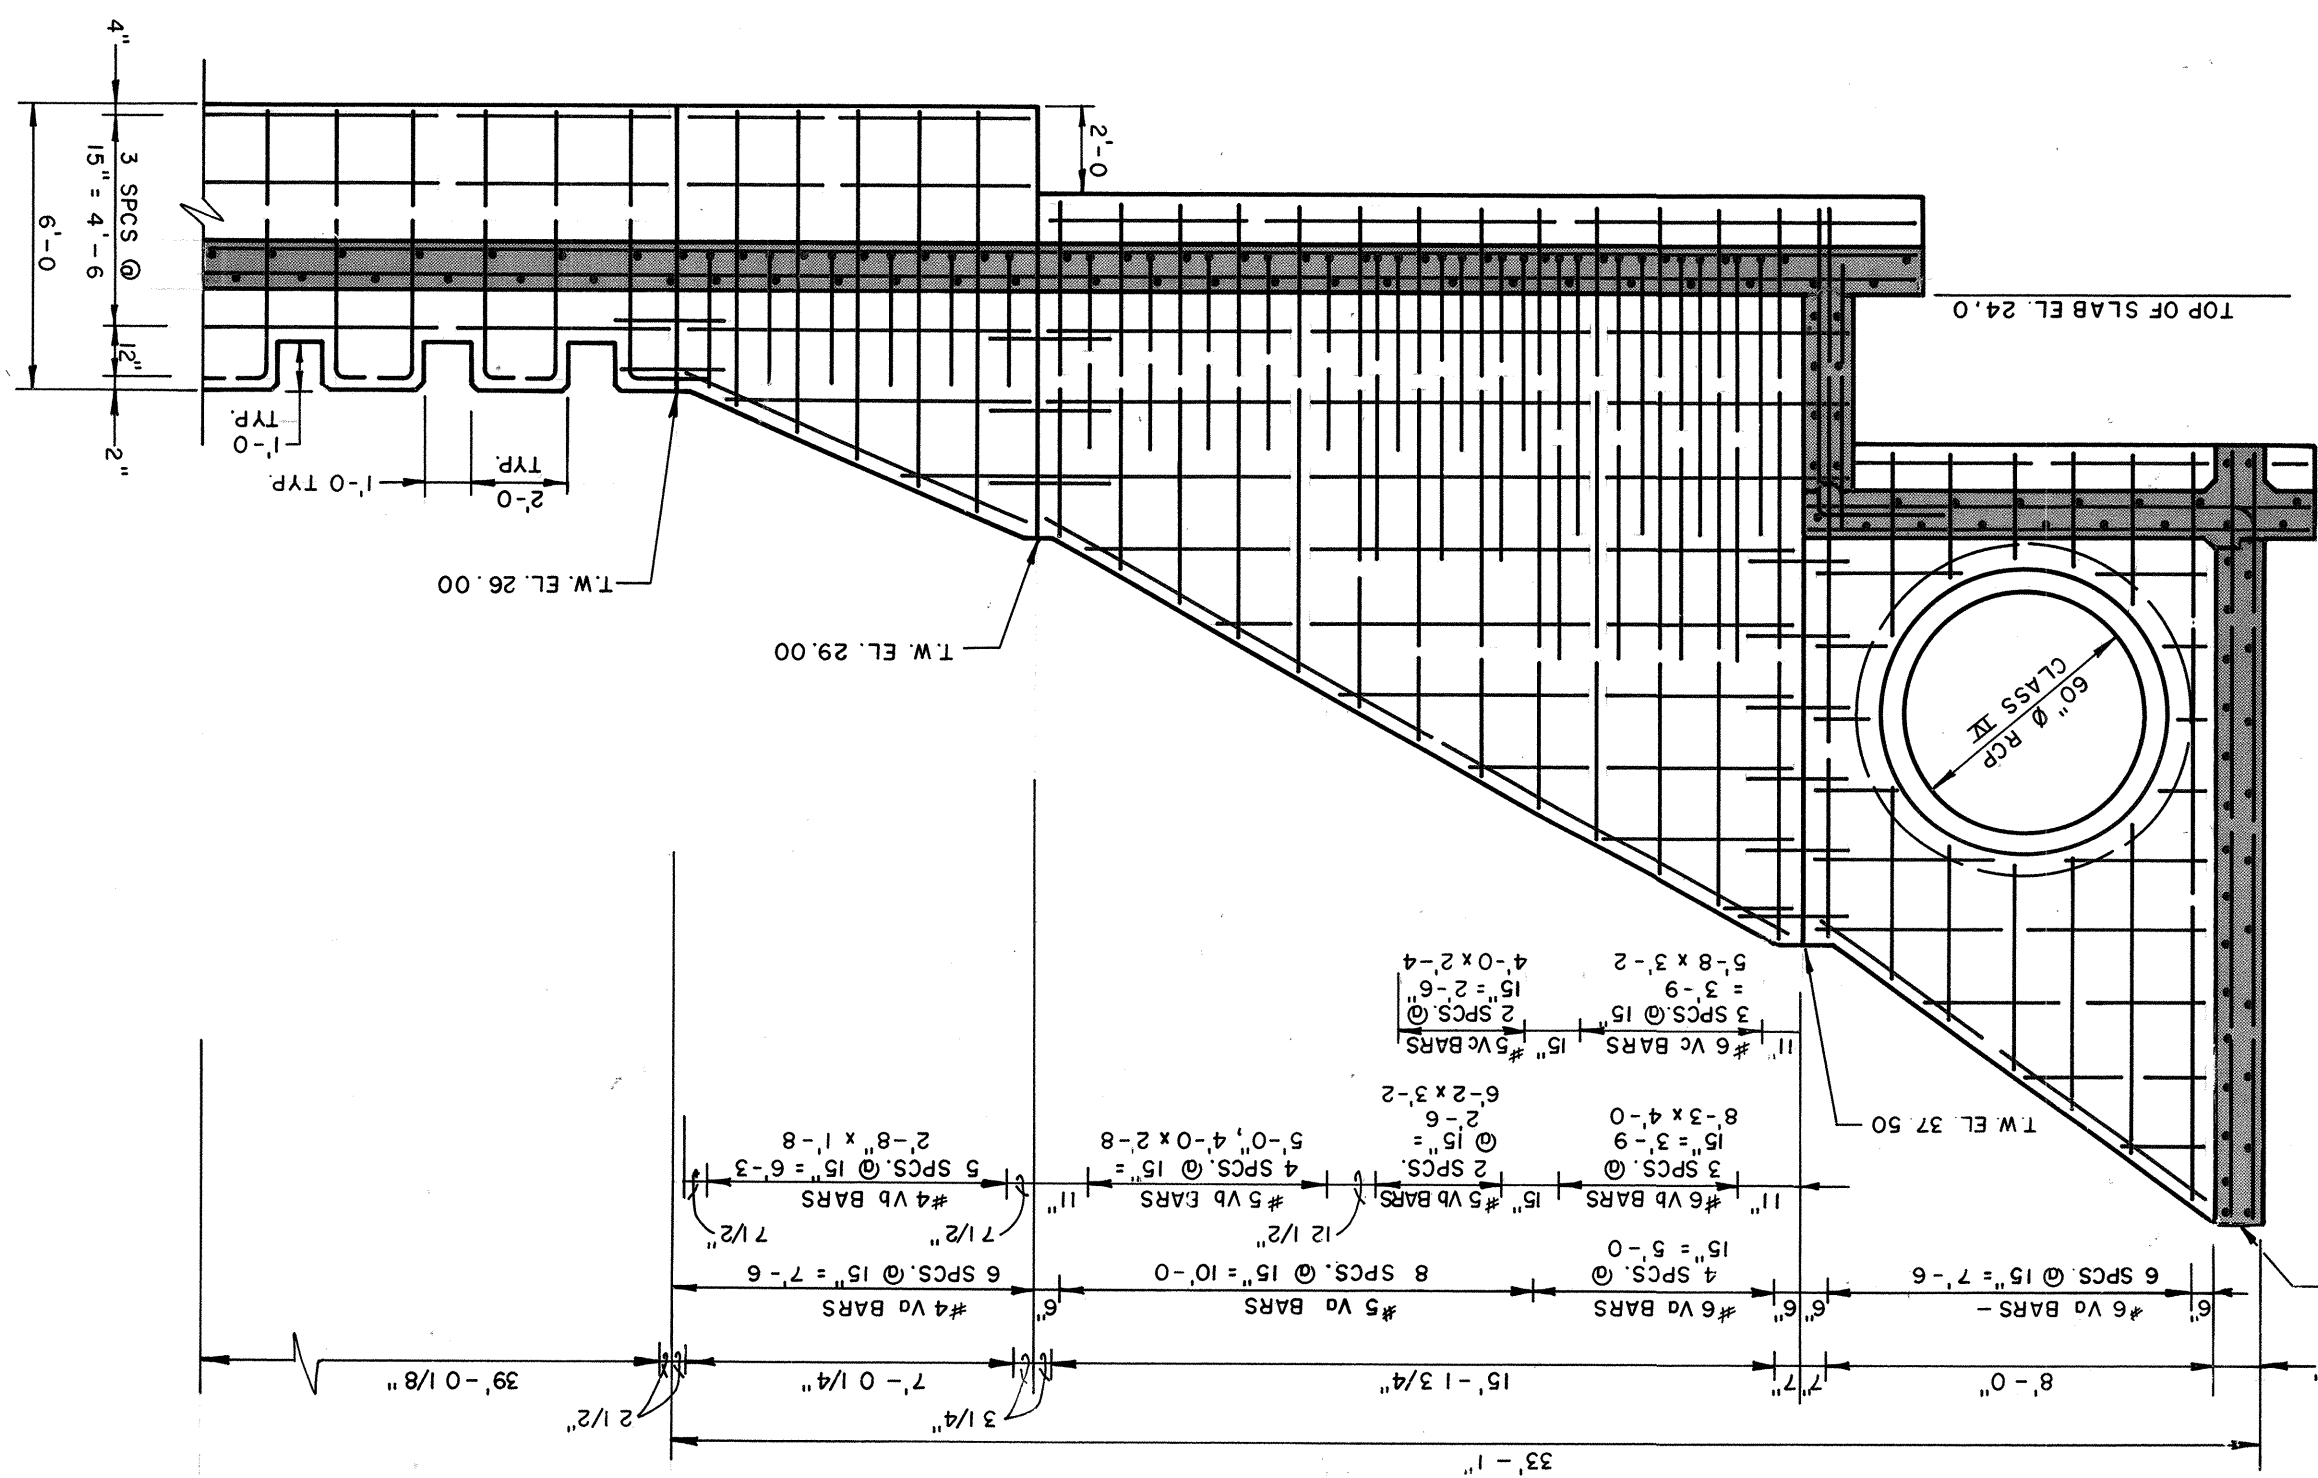[illegible]

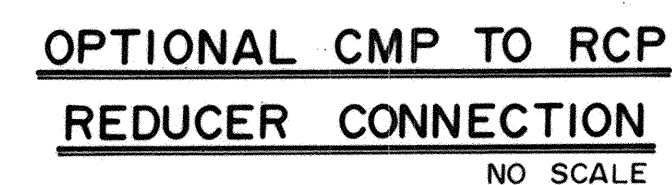


NOTE: CUT CONTOUR DITCHES AFTER POND SLOPES
HAVE BEEN ROUGH GRADED.

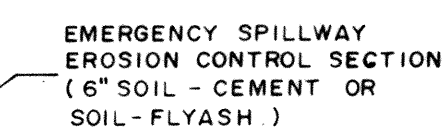


RECORD DRAWINGS

THESE DRAWINGS HAVE BEEN
REVISED IN ACCORDANCE
WITH INFORMATION PROVIDED
BY COMMUNITY SCIENCES
CORP., HUGG SURVEYING CO.
AND EASTERLING & ASSO-
CIATES, INC. TO REFLECT
THE CONSTRUCTION AS
ACCOMPLISHED.

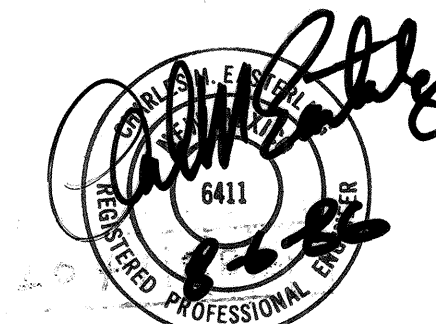
[illegible]

CITY OF ALBUQUERQUE MUNICIPAL DEVELOPMENT DEPARTMENT ENGINEERING DIVISION					
TITLE:					
TYPICAL DETAILS DESILTING POND STRUCTURES					
APPROVALS	ENGINEER	DATE	APPROVALS	ENGINEER	DATE
City Engineer	<i>E. H. [Signature]</i>	7/9/85	Liquid Waste	<i>R. [Signature] N.H.</i>	8/25/85
A.C.E. - Design	<i>[Signature]</i>	7/9/85	Traffic	<i>N.H. D.W. H.</i>	8/25/85
ASCE - Hydrology	<i>D. J. [Signature]</i>	6/2/85	Water	<i>R. [Signature] N.H.</i>	8/25/85
DRAWING NO.		MAP NO.		SHEET OF	
2204				17 OF 19	

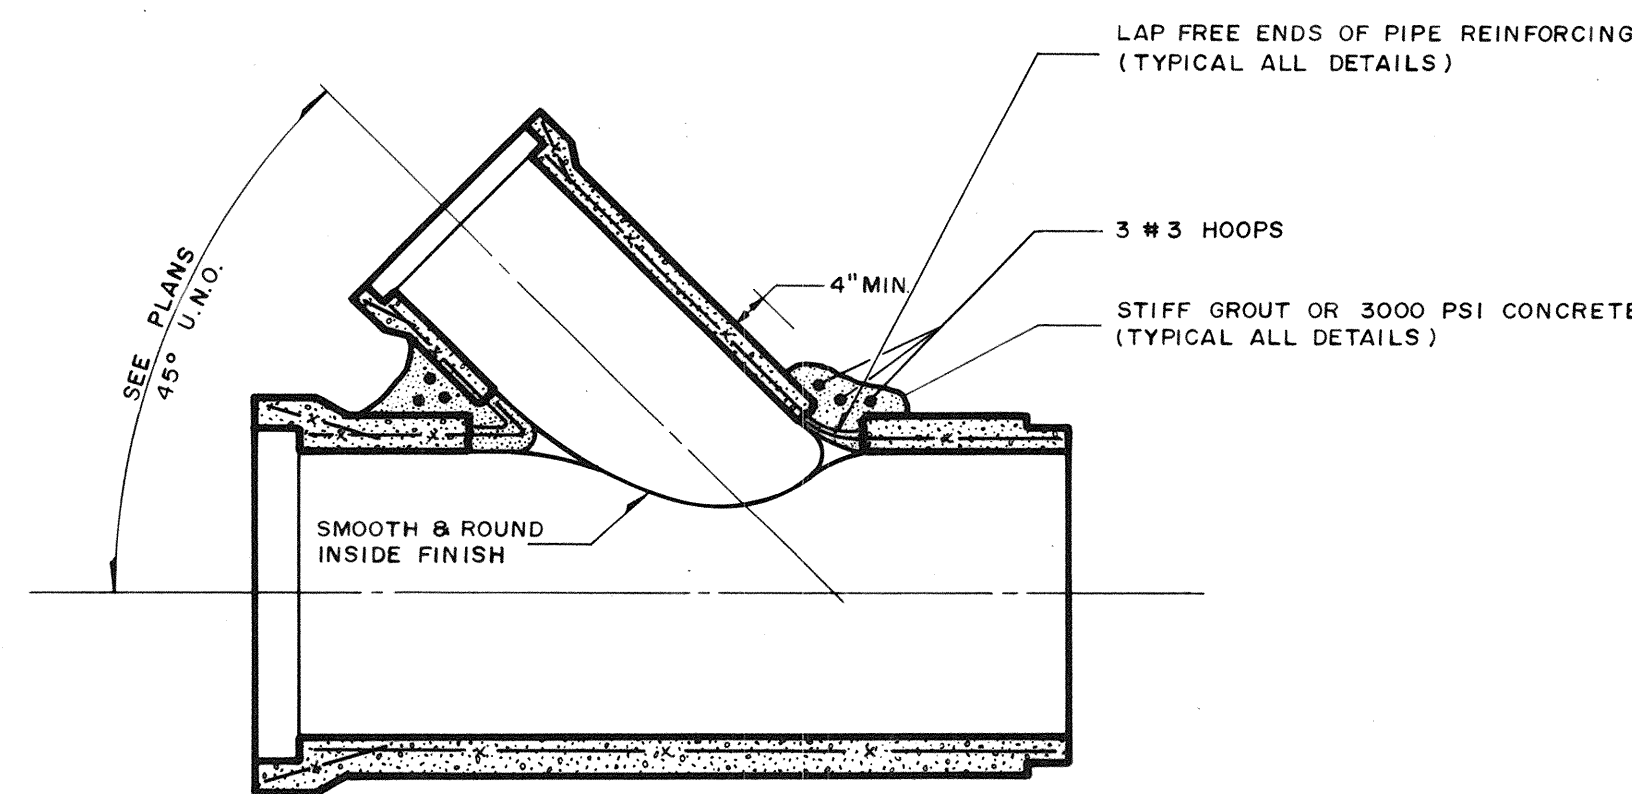


WYE CONNECTION

NO SCALE

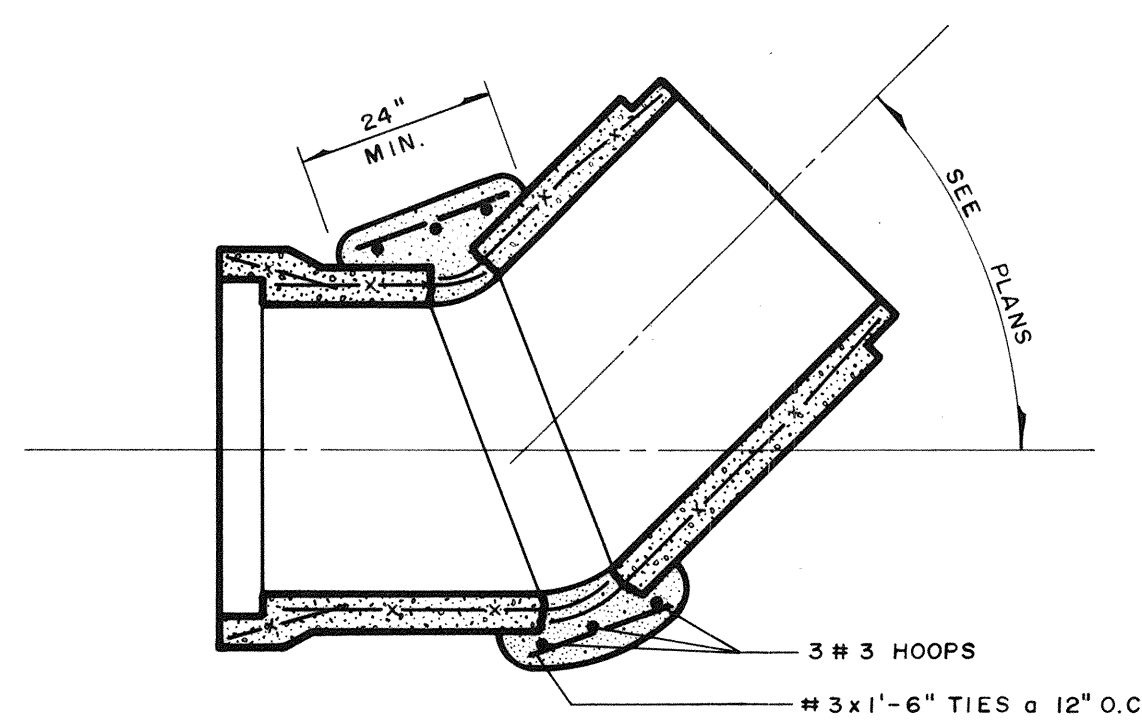


SHORT RADIUS BEND

NO SCALE

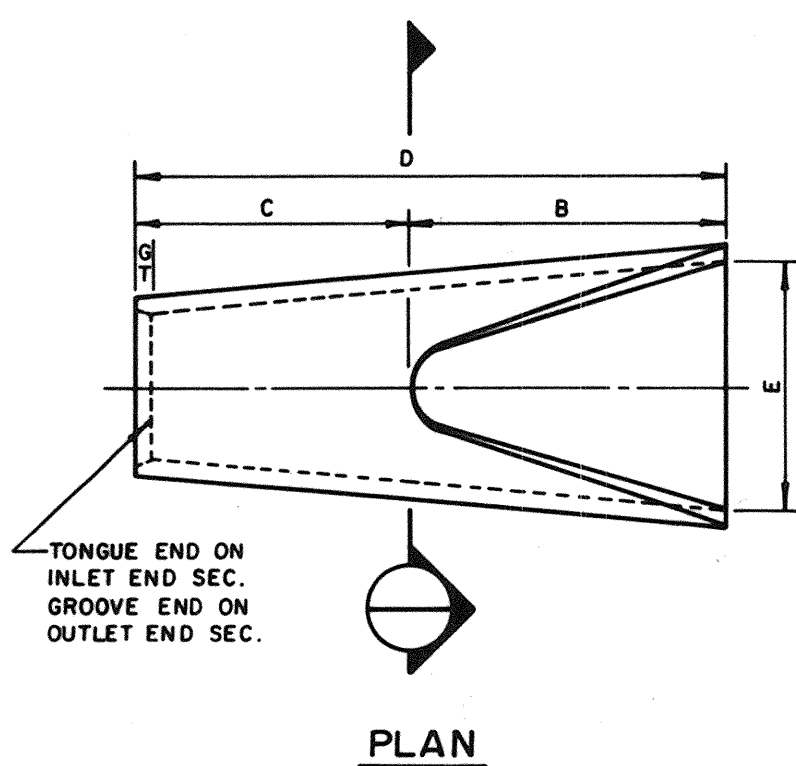

PLAN

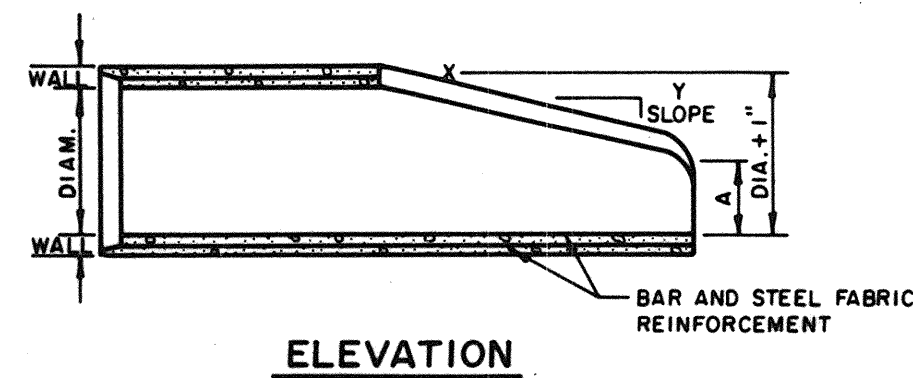


ELEVATION

FLARED END SECTIONS FOR REINFORCED CONCRETE CULVERT PIPE

LAP FREE ENDS OF PIPE REINFORCING
(TYPICAL ALL DETAILS)

3 #3 HOOPS


STIFF GROUT OR 3000 PSI CONCRETE
(TYPICAL ALL DETAILS)

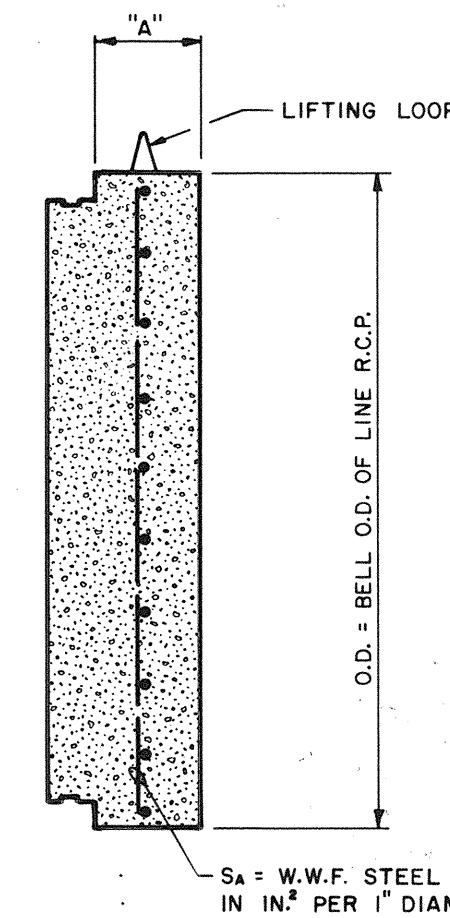

R.C.P. I.D.	"A"	S _A
24" & SMALLER	5"	0.02
30" - 42"	6"	0.04
48" - 72"	8"	0.06
78" - 96"	10"	0.08


R.C.P. END PLUG

NO SCALE

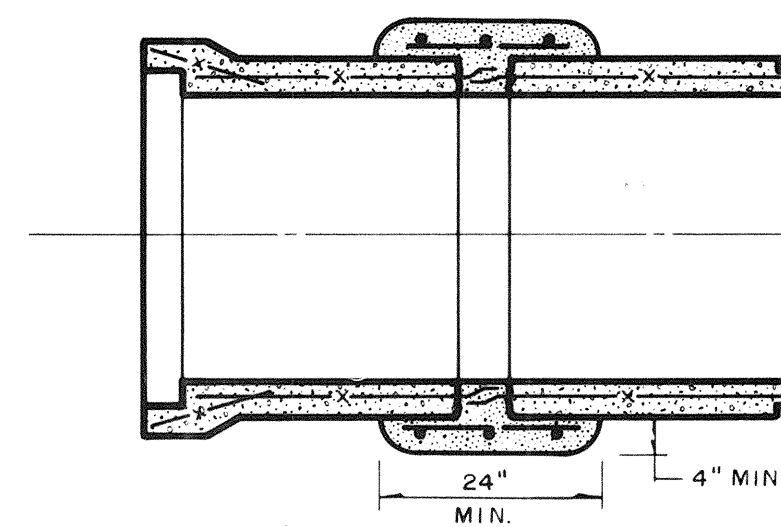


MAKE-UP JOINT

NO SCALE

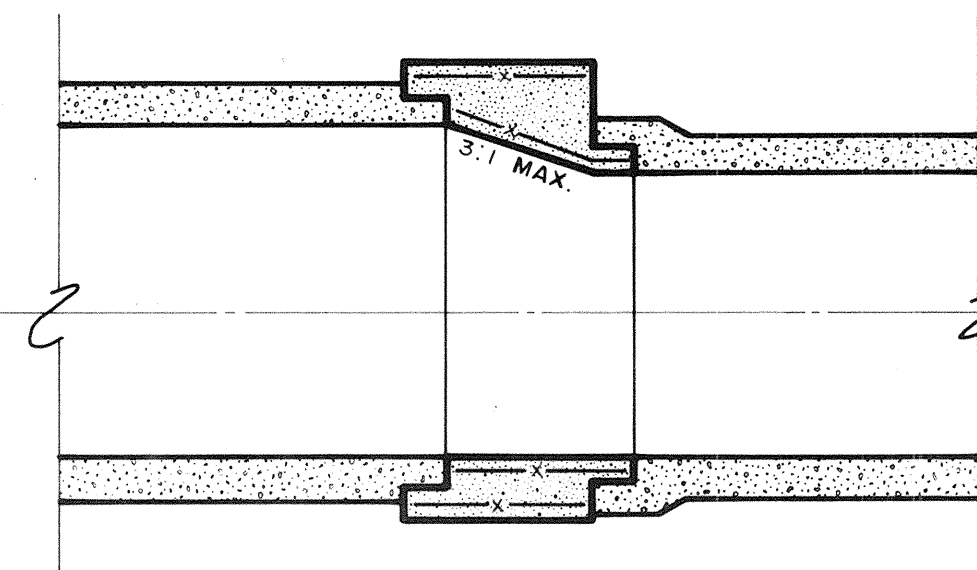

R.C.P. REDUCER

(TO BE DETAILED BY PIPE MFR.)
NO SCALE

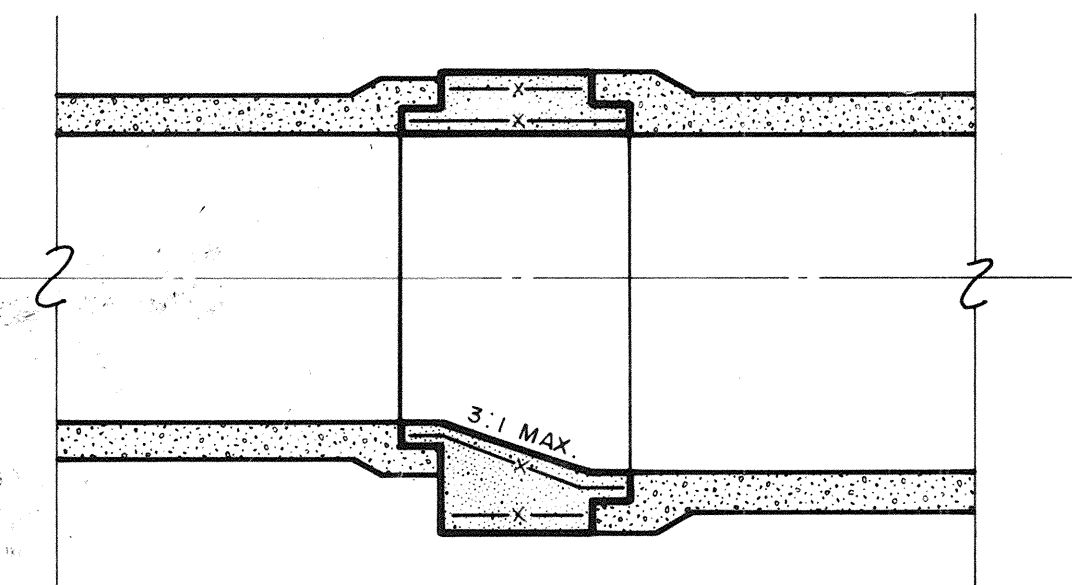

R.C.P. EXPANDER

(TO BE DETAILED BY PIPE MFR.)
NO SCALE



GENERAL NOTES:

SHOP DRAWINGS SHALL BE FURNISHED WITH DETAILS FOR A COMPLETE SYSTEM, INCLUDING LAYOUT DIMENSIONS AND STATIONING, CURVE DATA, ETC. SHOWN ON THE PLANS MAY BE ADJUSTED AS REQUIRED TO FIT THE MFR'S STANDARD SECTIONS PROVIDED THE INTENT OF THE DESIGN FEATURES ARE PRESERVED.

R.C.P. FITTINGS AND BENDS SHALL GENERALLY BE SHOP FABRICATED BY THE PIPE MANUFACTURER. FIELD FABRICATION AS SHOWN ON THE DETAILS ON THIS SHEET SHALL ONLY BE PERMITTED TO MEET UNFORESEEN CONDITIONS, AND SHALL BE SUBJECT TO THE ENGINEER'S APPROVAL FOR EACH INSTANCE. ADDITIONAL CONCRETE BLOCKING, ECT. MAY BE REQUIRED DEPENDING ON THE CIRCUMSTANCES.

RECORD DRAWINGS

THESE DRAWINGS HAVE BEEN REVISED IN ACCORDANCE WITH INFORMATION PROVIDED BY COMMUNITY SCIENCES CORP., HUGG SURVEYING CO. AND EASTERLING & ASSOCIATES, INC. TO REFLECT THE CONSTRUCTION AS ACCOMPLISHED.

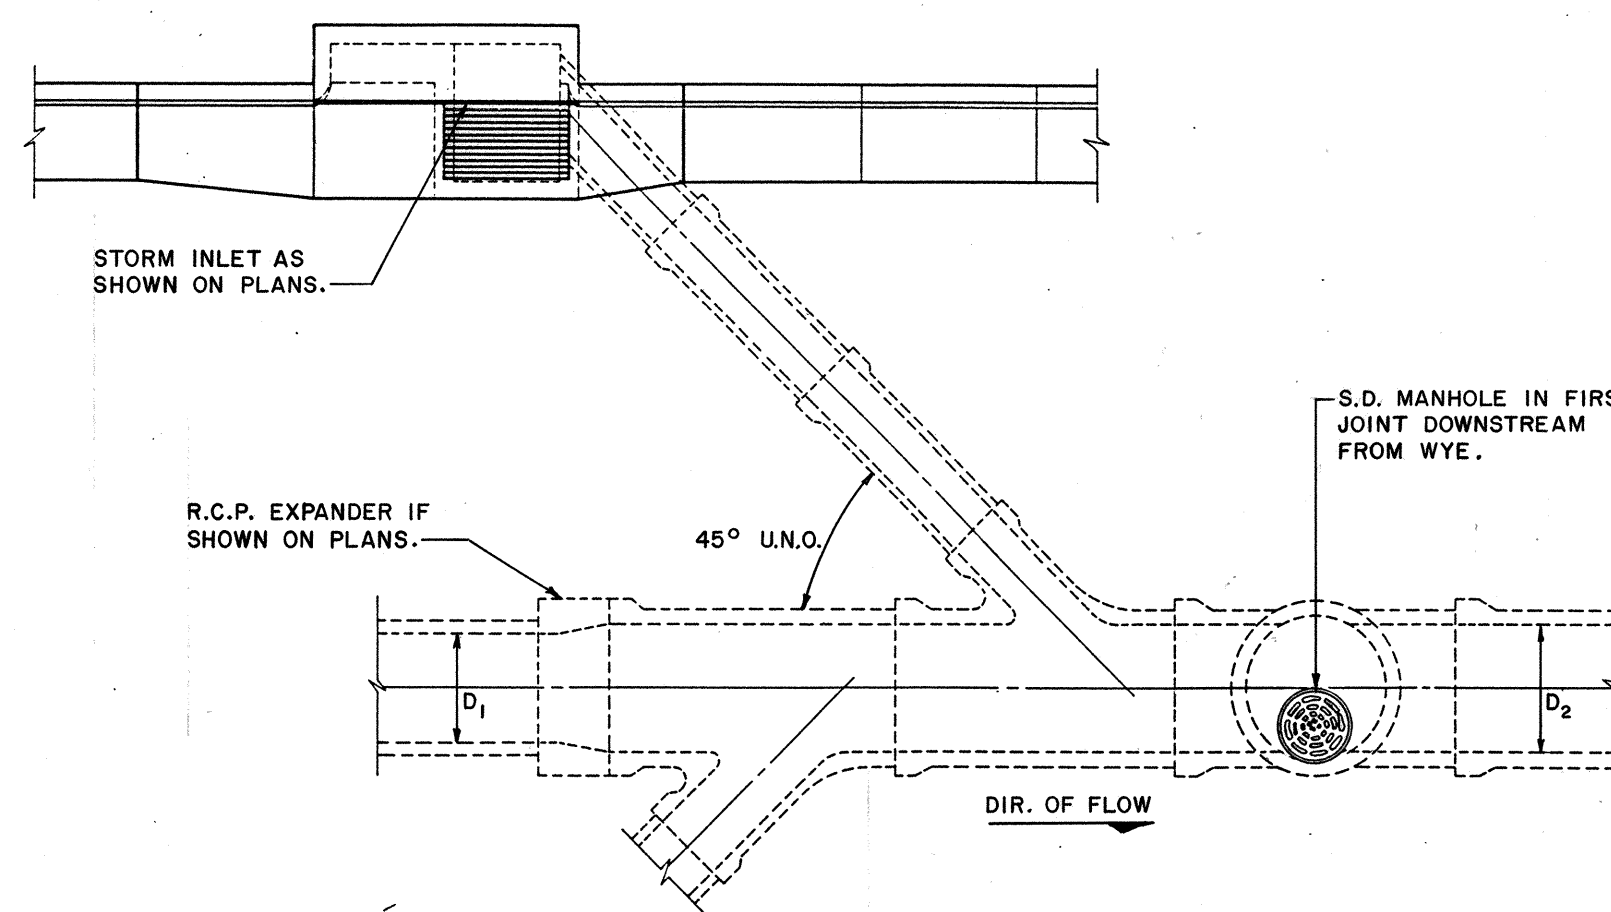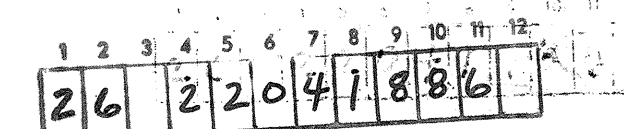




TYPICAL STREET INLET CONNECTION

NO SCALE




AS BUILT INFORMATION		BENCH MARKS		SURVEY INFORMATION		ENGINEER'S SEAL		REVISIONS		BY		DATE		DATE		DATE	
CONTRACTOR	DATE	CONTRACTOR	DATE	NO.	DATE	DATE	DATE	NO.	DATE	NO.	DATE	NO.	DATE	NO.	DATE	NO.	DATE
ACS BRASS CAP "NM 448-N9A"	DATE	ACS BRASS CAP "NM 448-N9A"	DATE	DATE	DATE	DATE	DATE	DATE	DATE	DATE	DATE	DATE	DATE	DATE	DATE	DATE	DATE
ELEV. 5004.145, LOCATED AT THE	DATE	ELEV. 5004.145, LOCATED AT THE	DATE	BY	DATE	BY	DATE	BY	DATE	BY	DATE	BY	DATE	BY	DATE	BY	DATE
INTERSECTION OF COORS RD. AND	DATE	INTERSECTION OF COORS RD. AND	DATE	DATE	DATE	DATE	DATE	DATE	DATE	DATE	DATE	DATE	DATE	DATE	DATE	DATE	DATE
PARADISE BLVD. N.W.	DATE	PARADISE BLVD. N.W.	DATE	DATE	DATE	DATE	DATE	DATE	DATE	DATE	DATE	DATE	DATE	DATE	DATE	DATE	DATE
VERIFICATION BY	DATE	VERIFICATION BY	DATE	DATE	DATE	DATE	DATE	DATE	DATE	DATE	DATE	DATE	DATE	DATE	DATE	DATE	DATE
CORRECTED BY	DATE	CORRECTED BY	DATE	DATE	DATE	DATE	DATE	DATE	DATE	DATE	DATE	DATE	DATE	DATE	DATE	DATE	DATE
RECORDED BY	DATE	RECORDED BY	DATE	DATE	DATE	DATE	DATE	DATE	DATE	DATE	DATE	DATE	DATE	DATE	DATE	DATE	DATE




CITY OF ALBUQUERQUE MUNICIPAL DEVELOPMENT DEPARTMENT ENGINEERING DIVISION					
TITLE: TYPICAL R.C.P. DETAILS					
APPROVALS	ENGINEER	DATE	APPROVALS	ENGINEER	DATE
City Engineer	R. J. Hugg	6/12/85	Liquid Waste	R. J. Hugg	6/12/85
A.C.E. Design	R. J. Hugg	7/6/85	Traffic	R. J. Hugg	6/12/85
Hydrology	R. J. Hugg	6/12/85	Water	R. J. Hugg	6/12/85
DRAWING NO.	2204	MAP NO.	SHEET	18	OF 19

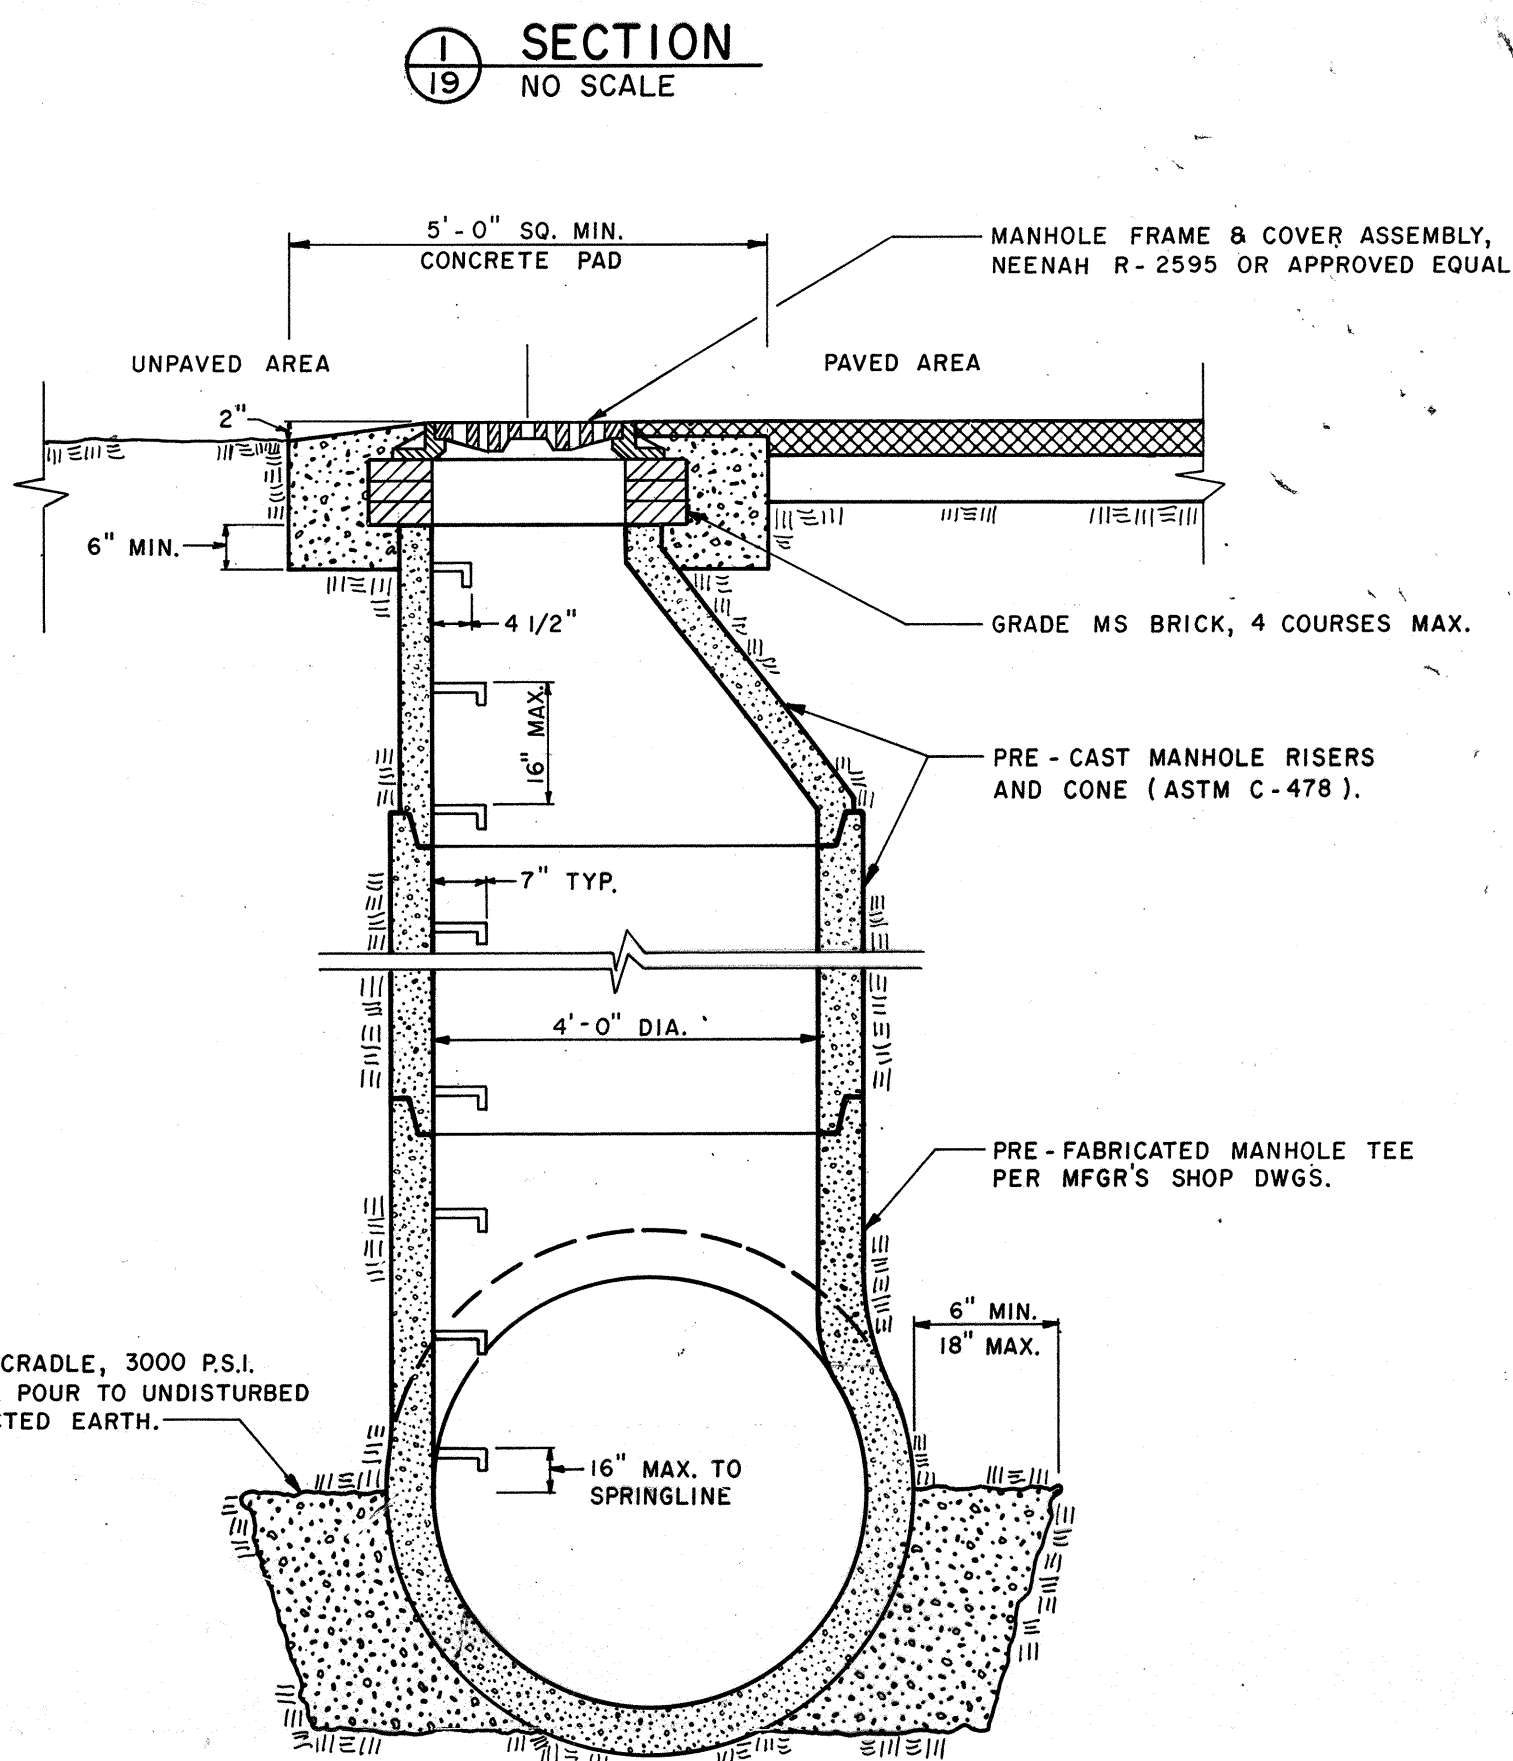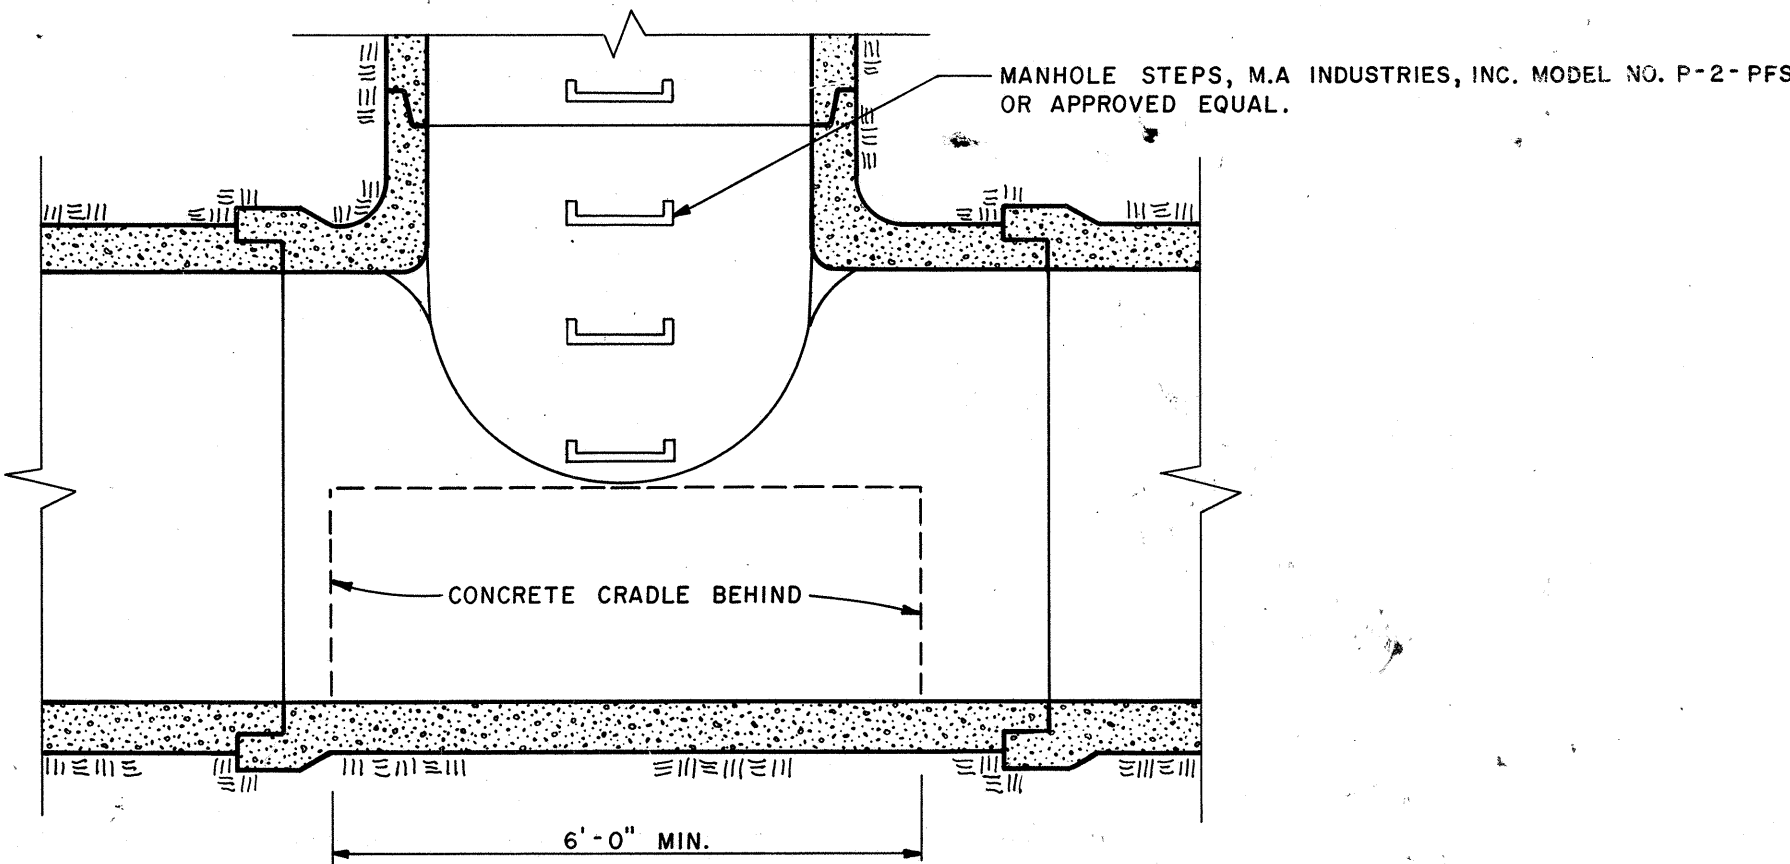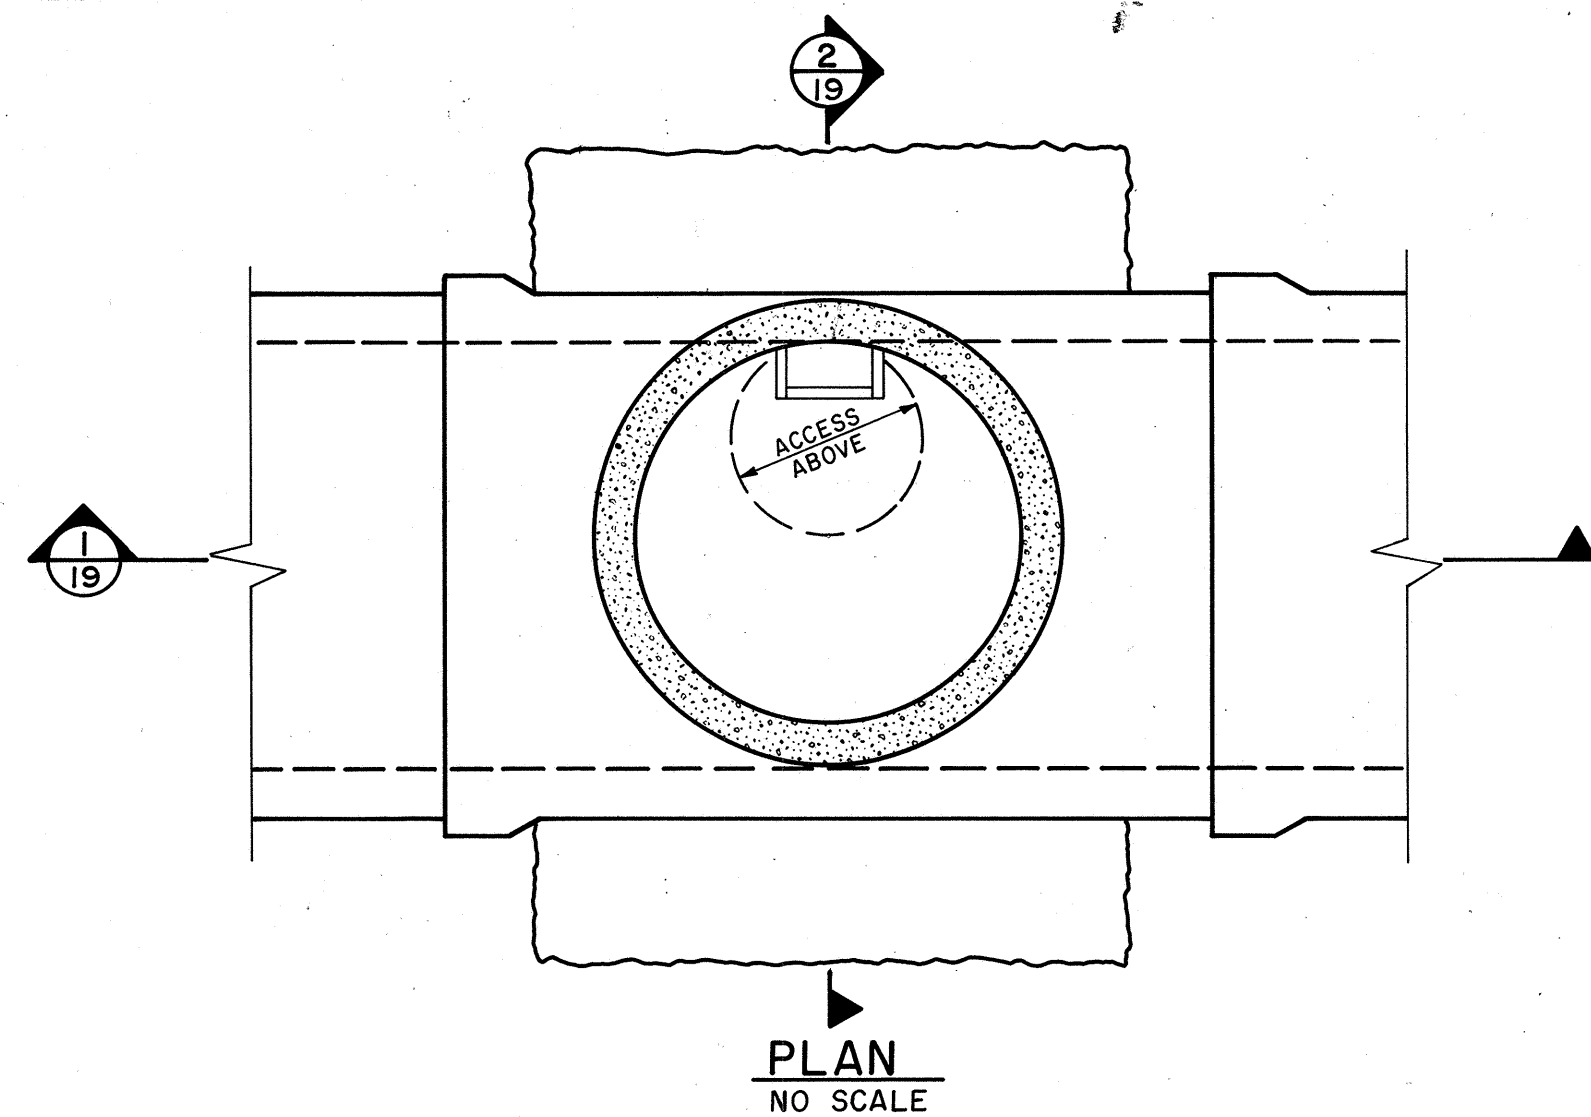


ACCESS MANHOLE
PIPE DIA. $\geq 48"$

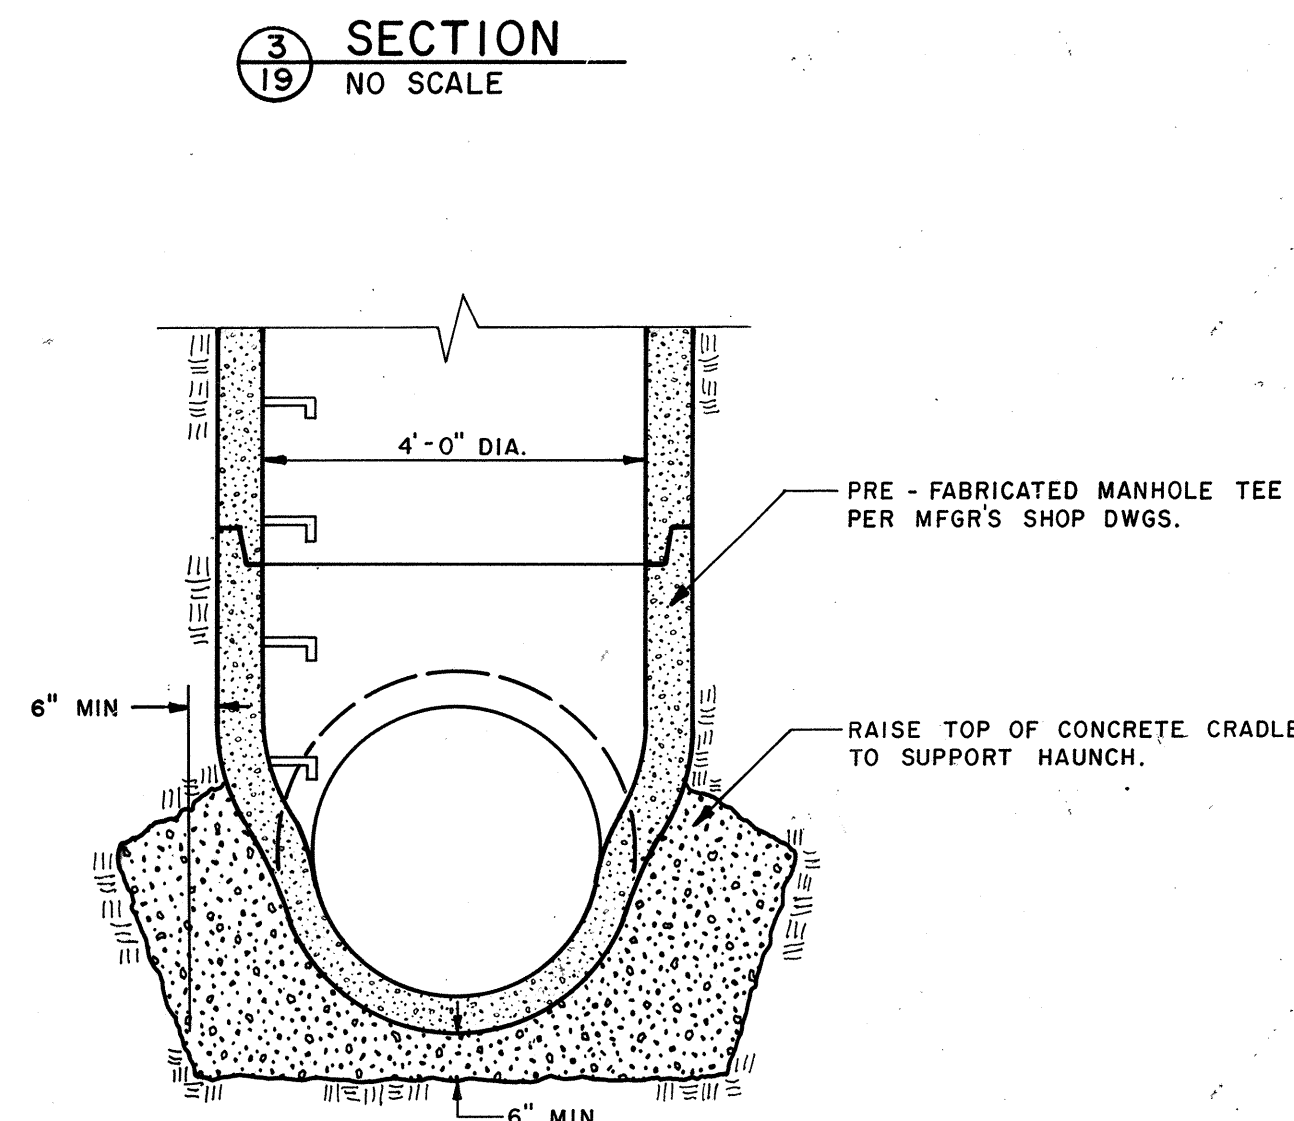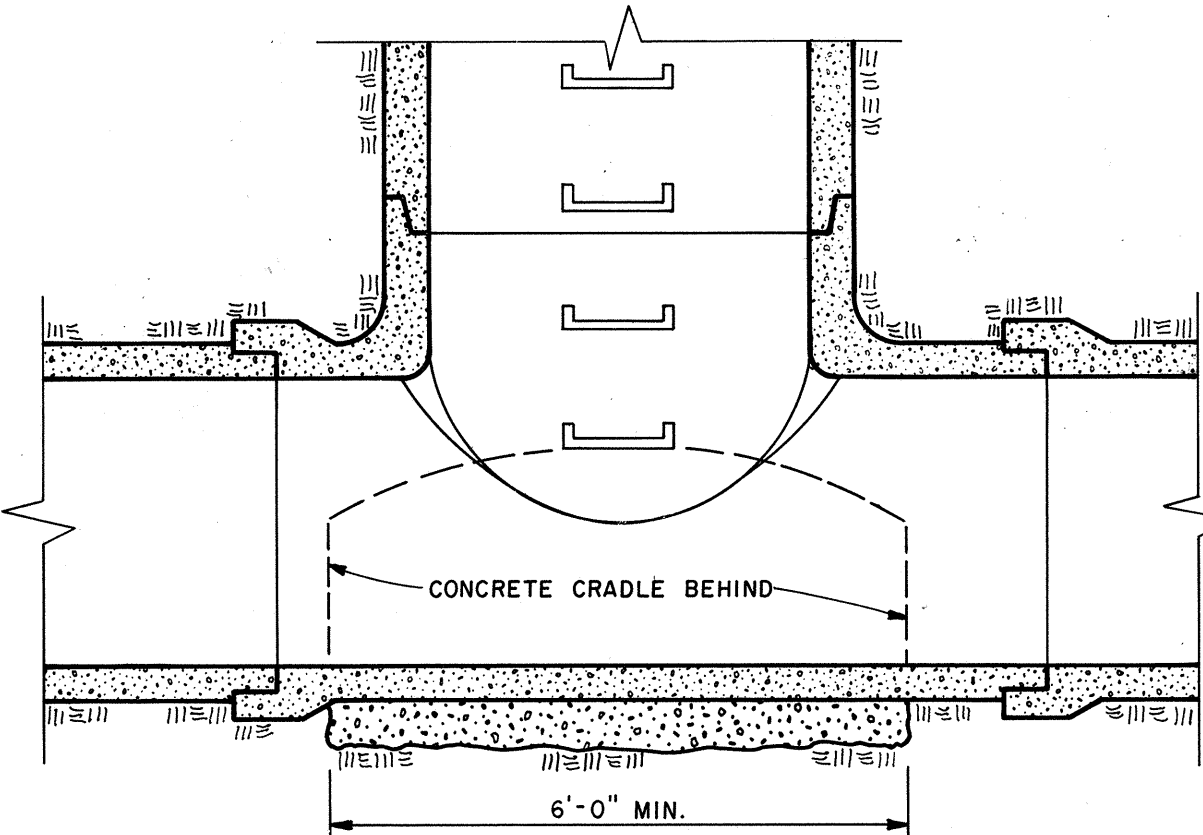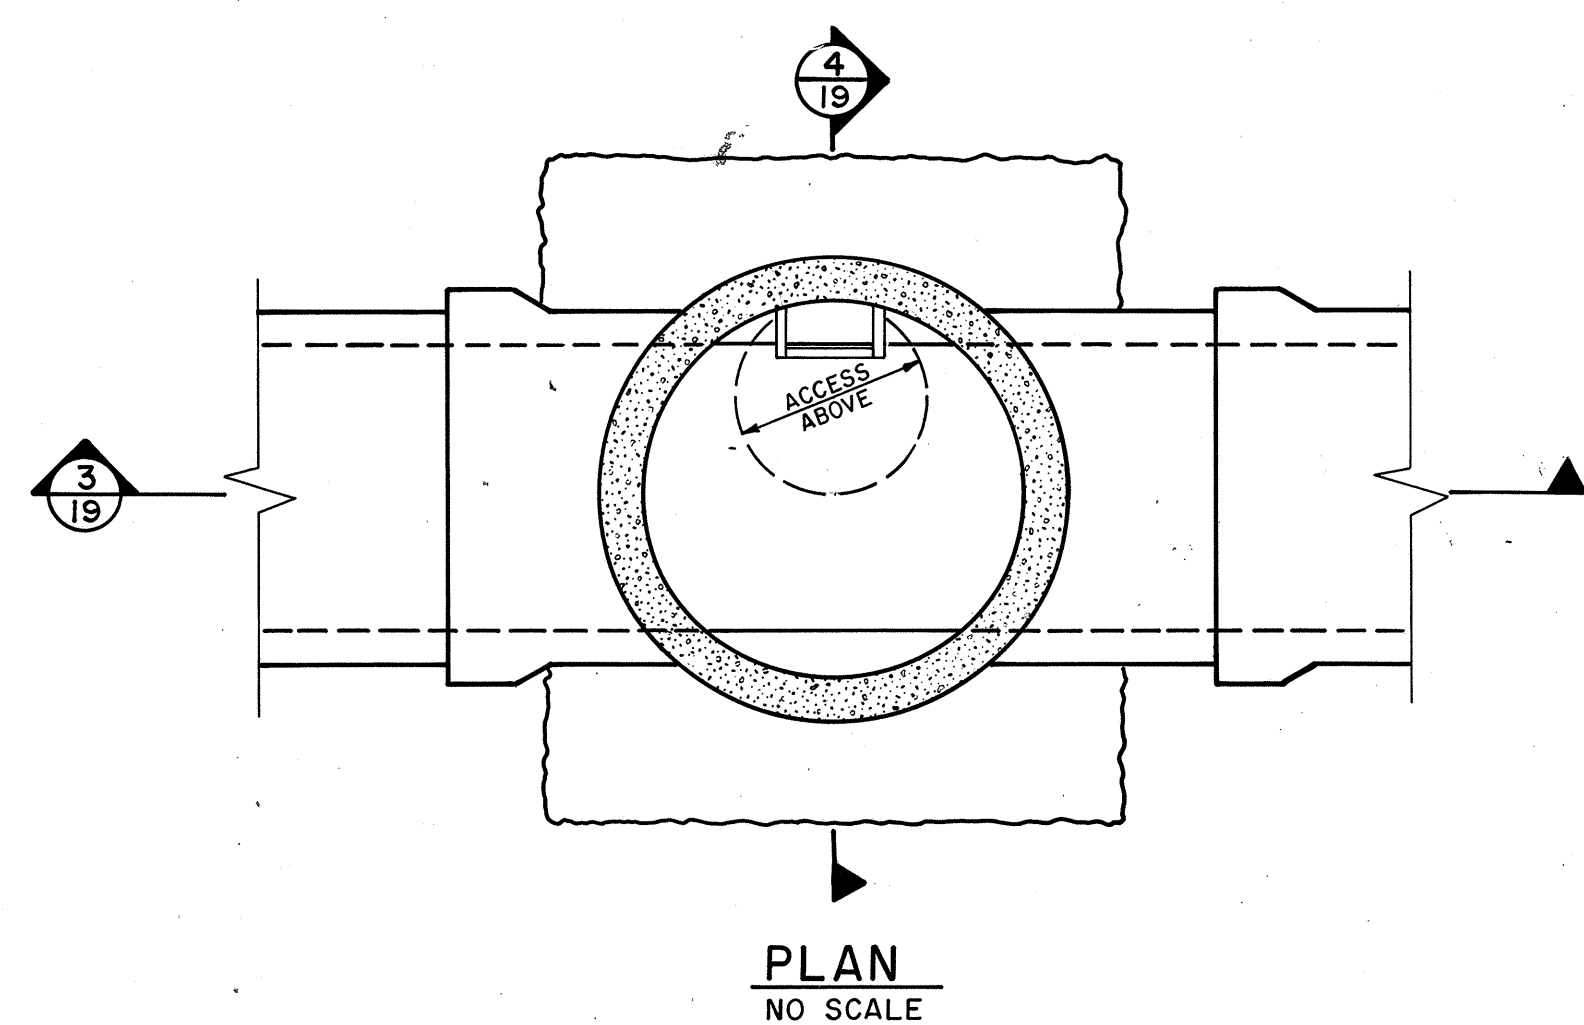

ACCESS MANHOLE
PIPE DIA. = 36" OR 42"



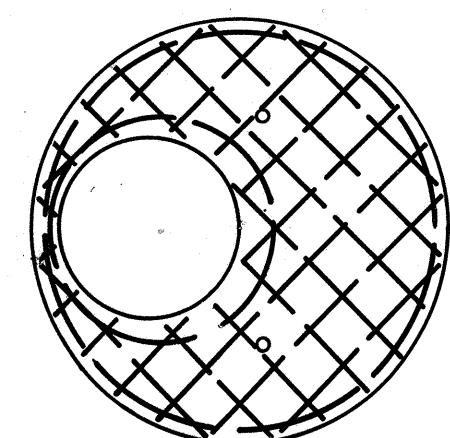


BOTTOM MAT

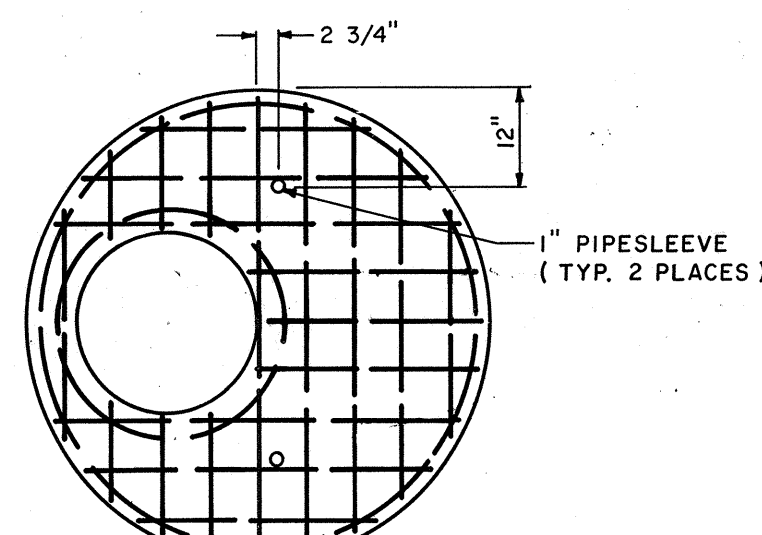


TOP MAT

CONCRETE COVER FOR SHALLOW MANHOLE
NO SCALE

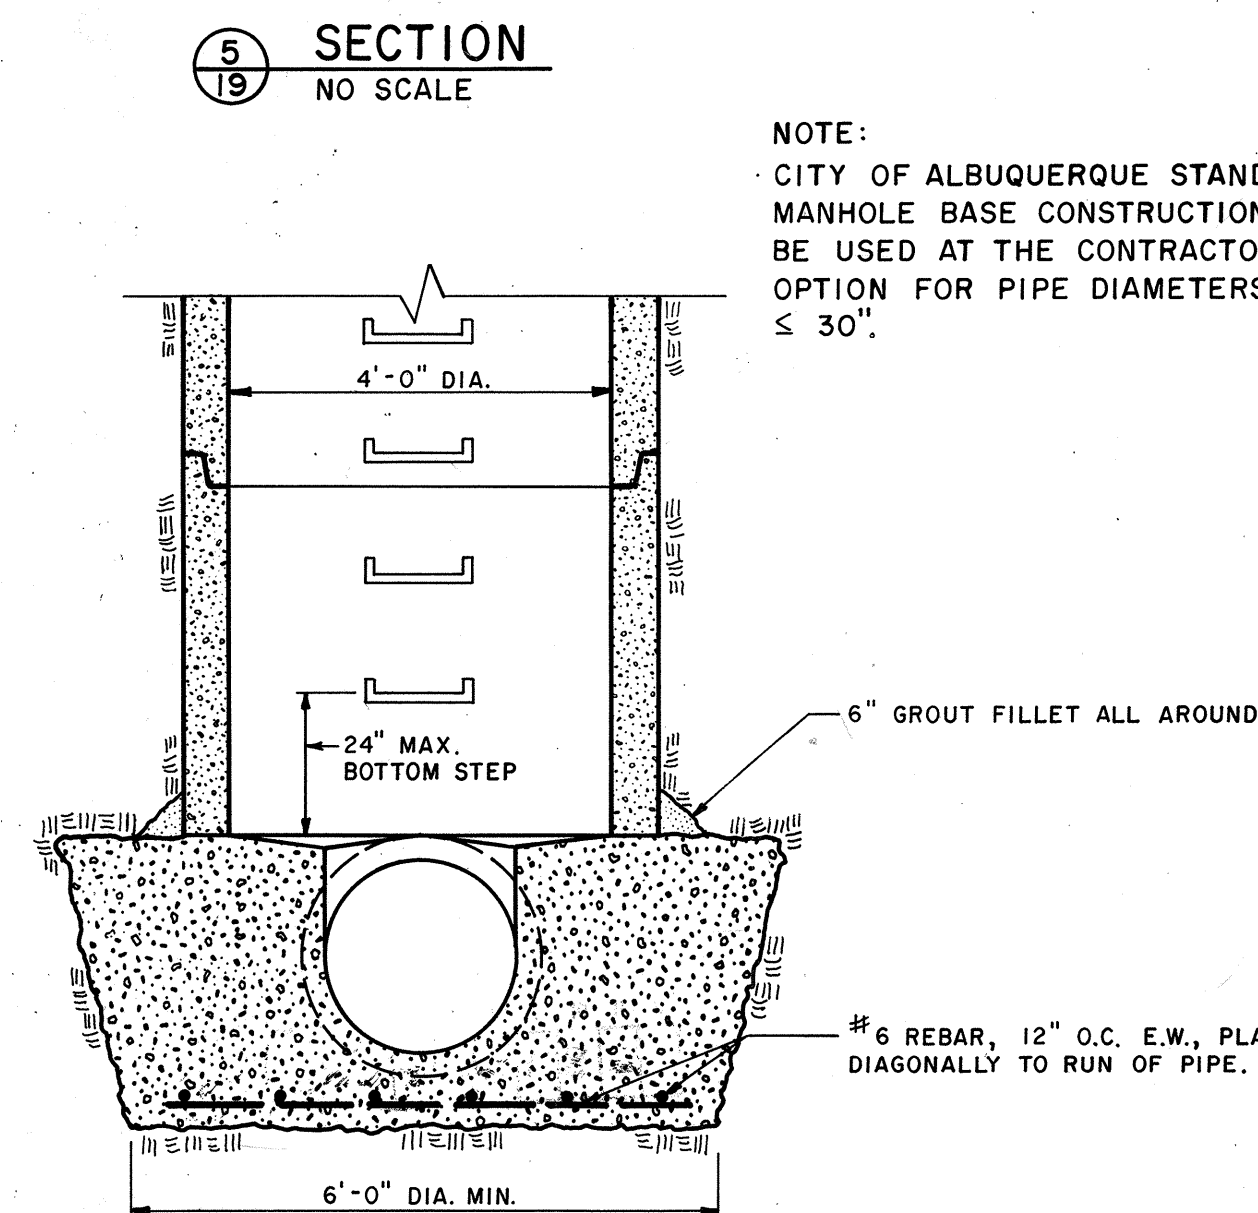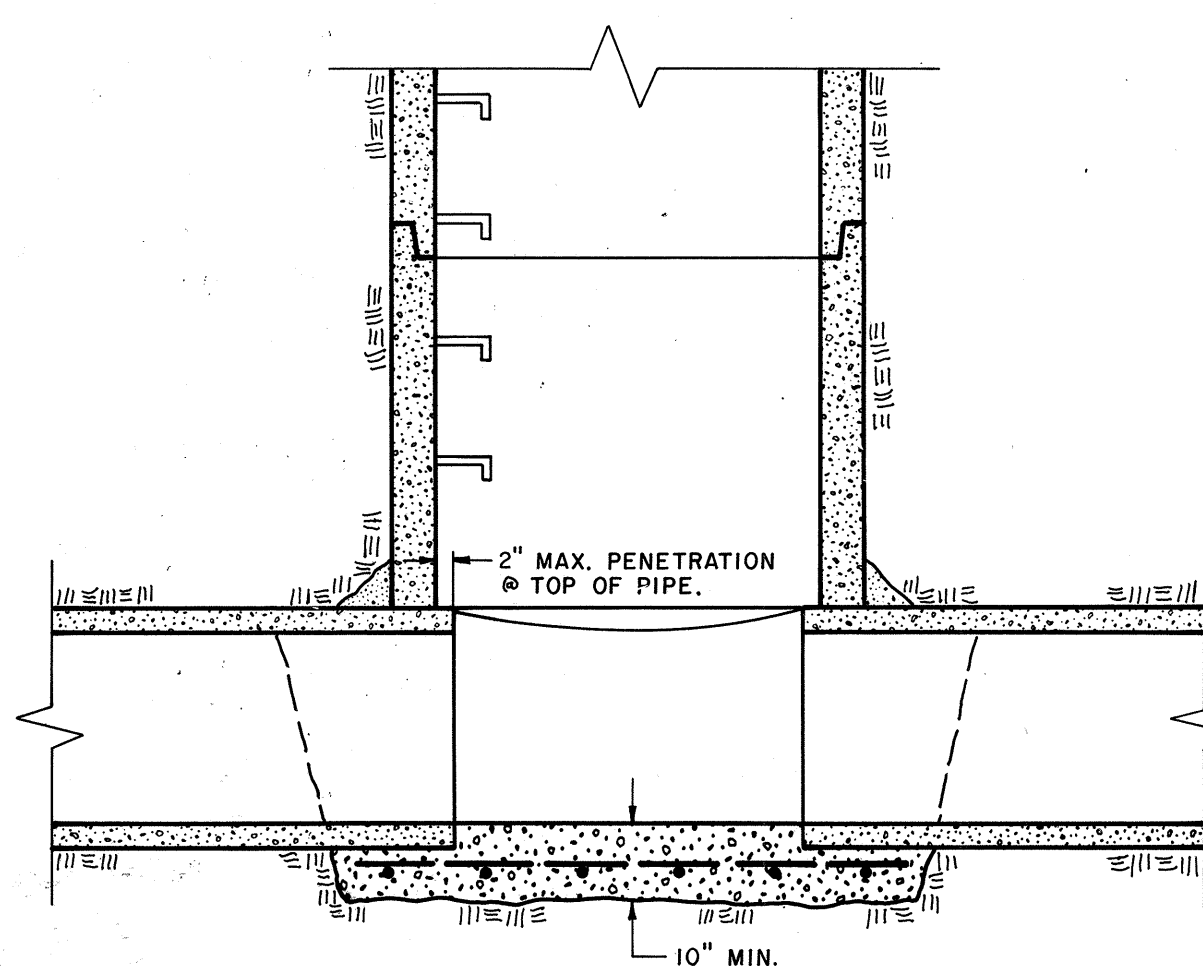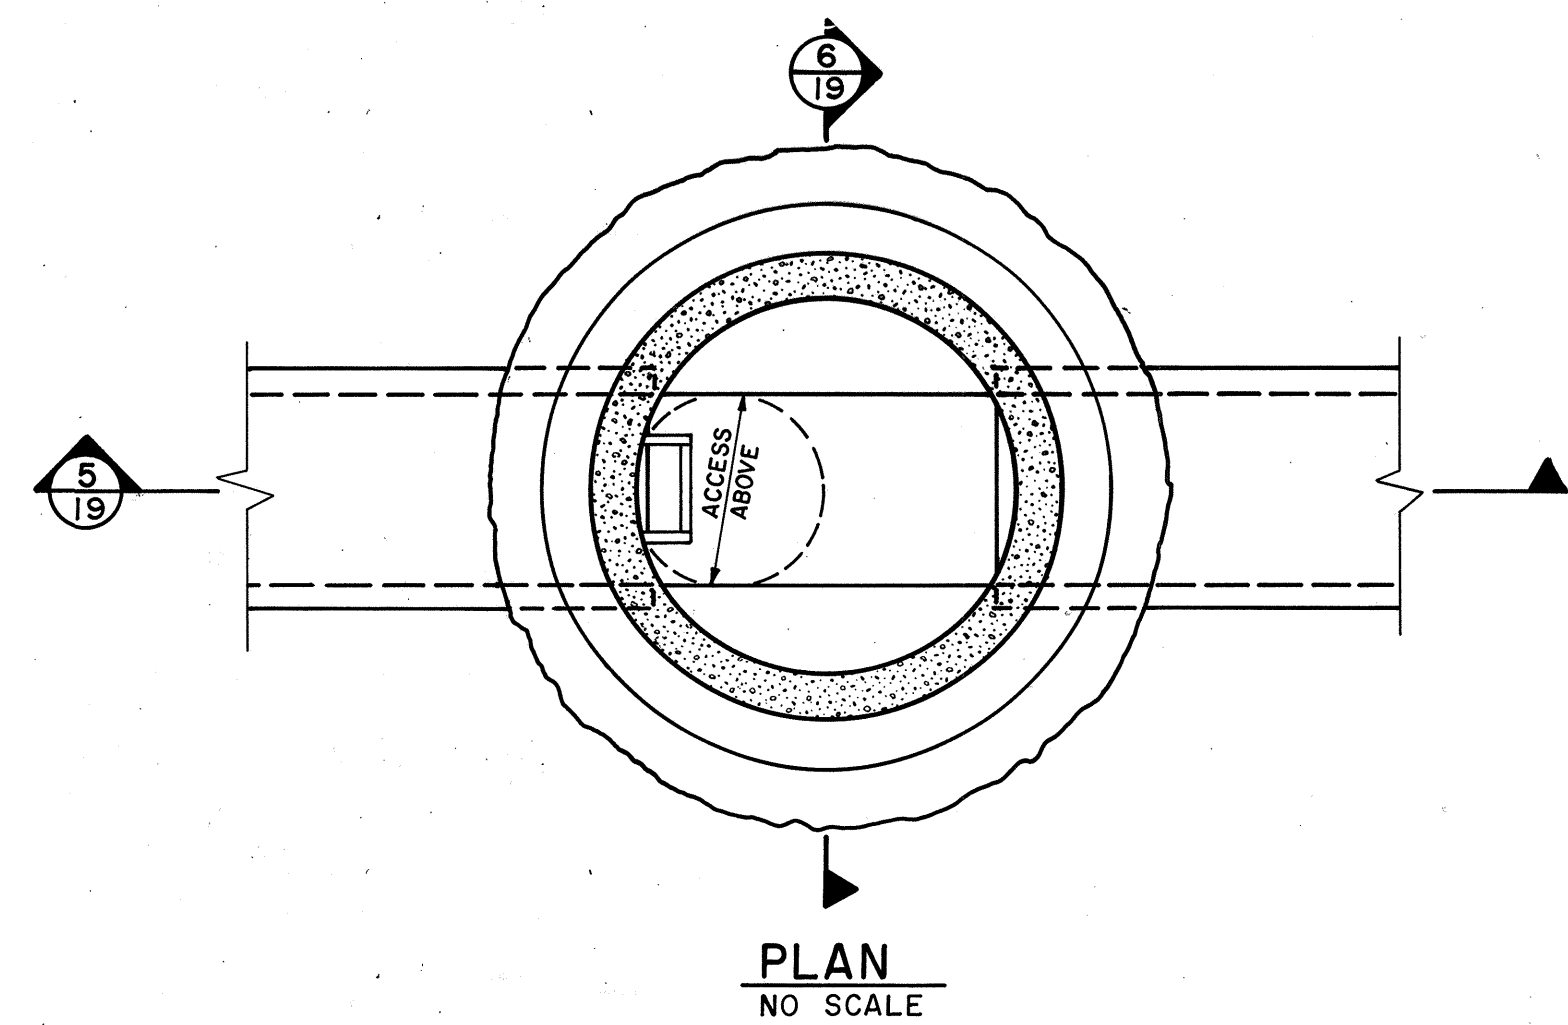

ACCESS MANHOLE
PIPE DIA. $\leq 30"$

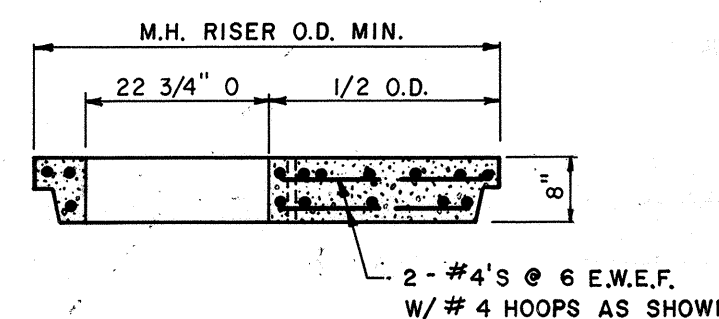

SECTION

NOTE:
CITY OF ALBUQUERQUE STANDARD TYPE C COVER
MAY BE USED IF TOP OF MANHOLE RISER IS
CUT SQUARE.

NOTE:
CITY OF ALBUQUERQUE STANDARD
MANHOLE BASE CONSTRUCTION MAY
BE USED AT THE CONTRACTORS
OPTION FOR PIPE DIAMETERS
 $\leq 30"$

SURVEY INFORMATION			BENCH MARKS			AS BUILT INFORMATION		
NO.	DATE	BY	CONTRACTOR	DATE	CONTRACTOR	NO.	DATE	CONTRACTOR
1	9-10-84	LEVERTON - EASTERLING INC.	ACS BRASS CAP "NM 448 - N9A"	DATE	DATE	2	DATE	CONTRACTOR
2			ELEV. 5004.145	DATE	DATE	3	DATE	CONTRACTOR
3			INTERSECTION OF COORS RD. AND	DATE	DATE	4	DATE	CONTRACTOR
4			PARADISE BLVD. N.W.	DATE	DATE	5	DATE	CONTRACTOR
5				DATE	DATE	6	DATE	CONTRACTOR
6				DATE	DATE	7	DATE	CONTRACTOR
7				DATE	DATE	8	DATE	CONTRACTOR
8				DATE	DATE	9	DATE	CONTRACTOR
9				DATE	DATE	10	DATE	CONTRACTOR
10				DATE	DATE	11	DATE	CONTRACTOR
11				DATE	DATE	12	DATE	CONTRACTOR

DESIGN			REVISIONS		
NO.	DATE	BY	NO.	DATE	BY
1	6/12/85	NA	1	6/12/85	NA
2	6/12/85	NA	2	6/12/85	NA
3	6/12/85	NA	3	6/12/85	NA
4	6/12/85	NA	4	6/12/85	NA
5	6/12/85	NA	5	6/12/85	NA
6	6/12/85	NA	6	6/12/85	NA
7	6/12/85	NA	7	6/12/85	NA
8	6/12/85	NA	8	6/12/85	NA
9	6/12/85	NA	9	6/12/85	NA
10	6/12/85	NA	10	6/12/85	NA
11	6/12/85	NA	11	6/12/85	NA
12	6/12/85	NA	12	6/12/85	NA

CITY OF ALBUQUERQUE MUNICIPAL DEVELOPMENT DEPARTMENT ENGINEERING DIVISION		
TITLE:	STORMDRAIN MANHOLE DETAILS	
APPROVALS	ENGINEER	DATE
City Engineer	NA	6/12/85
A.C.E. Design	NA	6/12/85
Hydrology	NA	6/12/85
DRAWING NO.	2204	MAP NO.
SHEET	19	OF 19