


PLAN	DATE	BY
DESIGNED		
CHECKED		
NOTE BOOK		
NO.		




PROFILE	DATE	BY
DESIGNED		
CHECKED		
NOTE BOOK		
NO.		

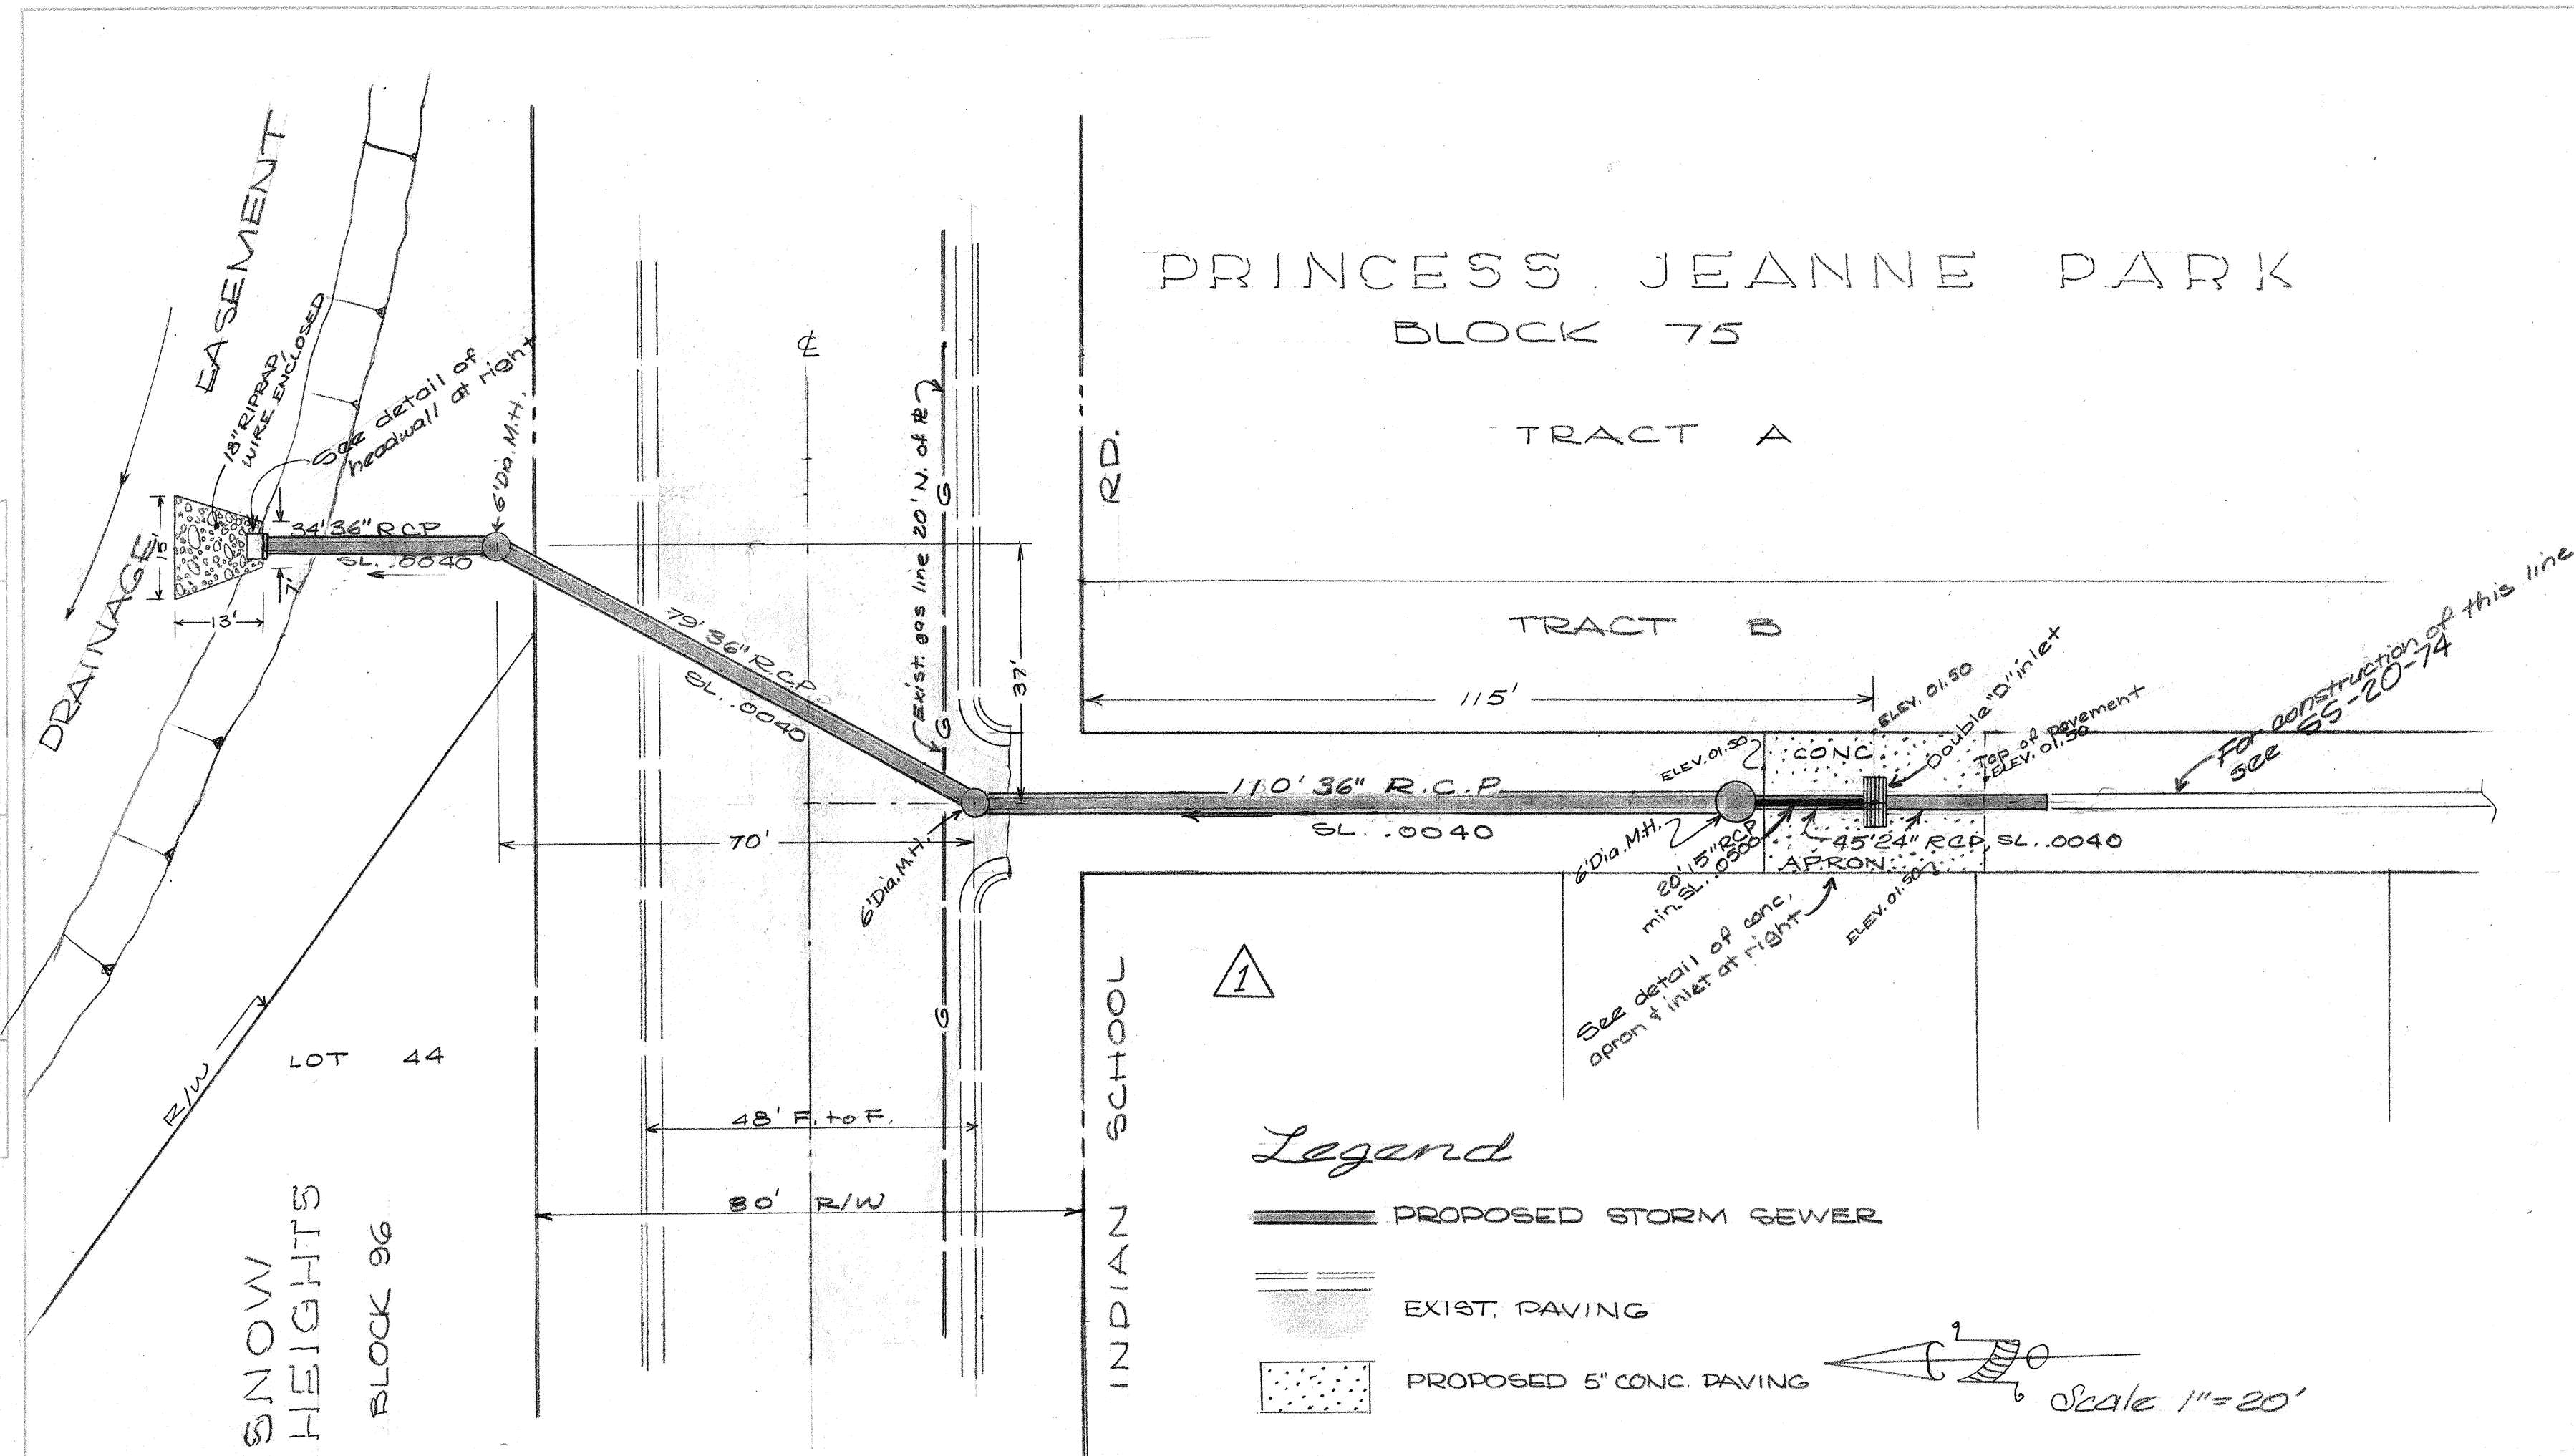


Legend

- PROPOSED STORM SEWER
- EXIST. PAVING
- PROPOSED 5' CONC. PAVING

Scale 1" = 20'

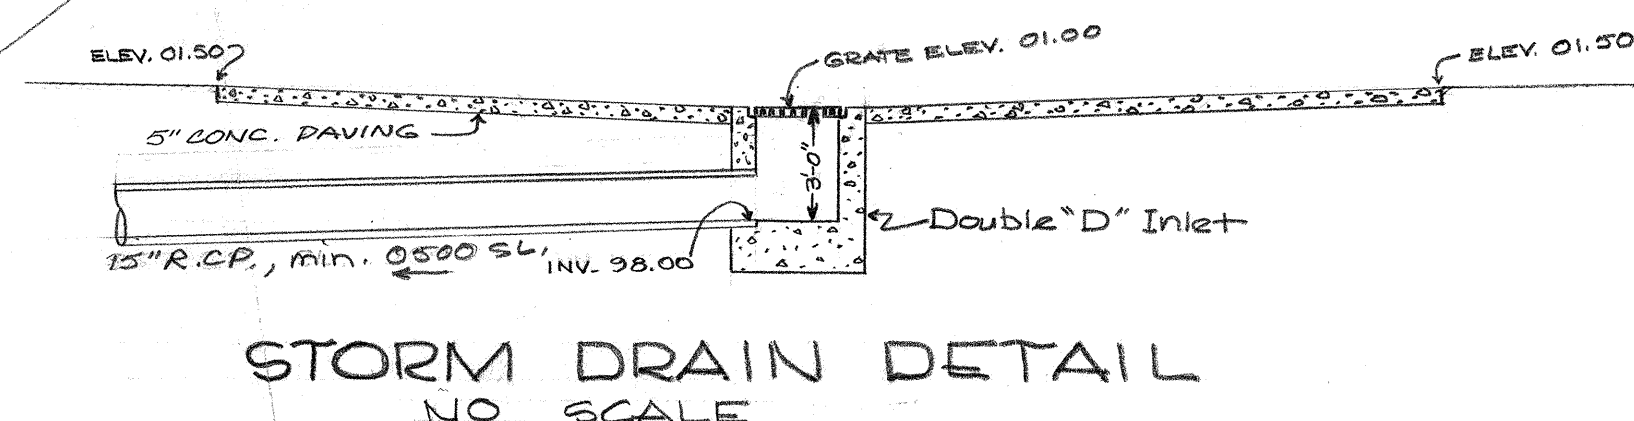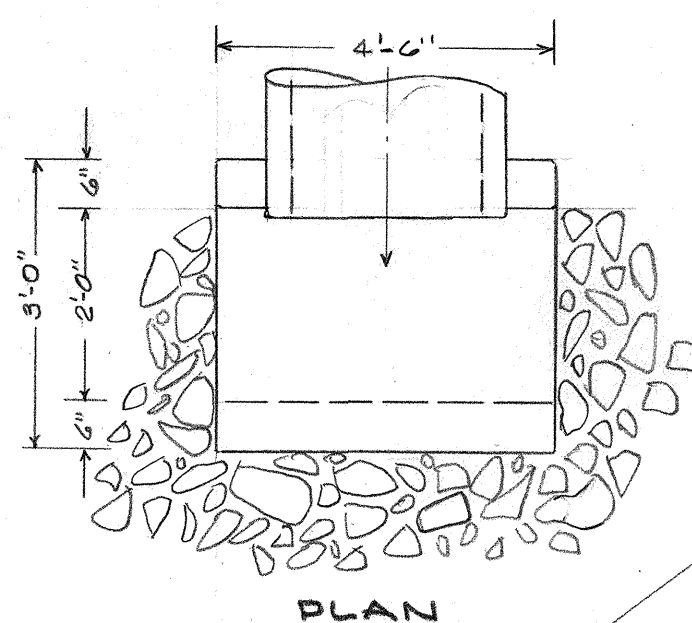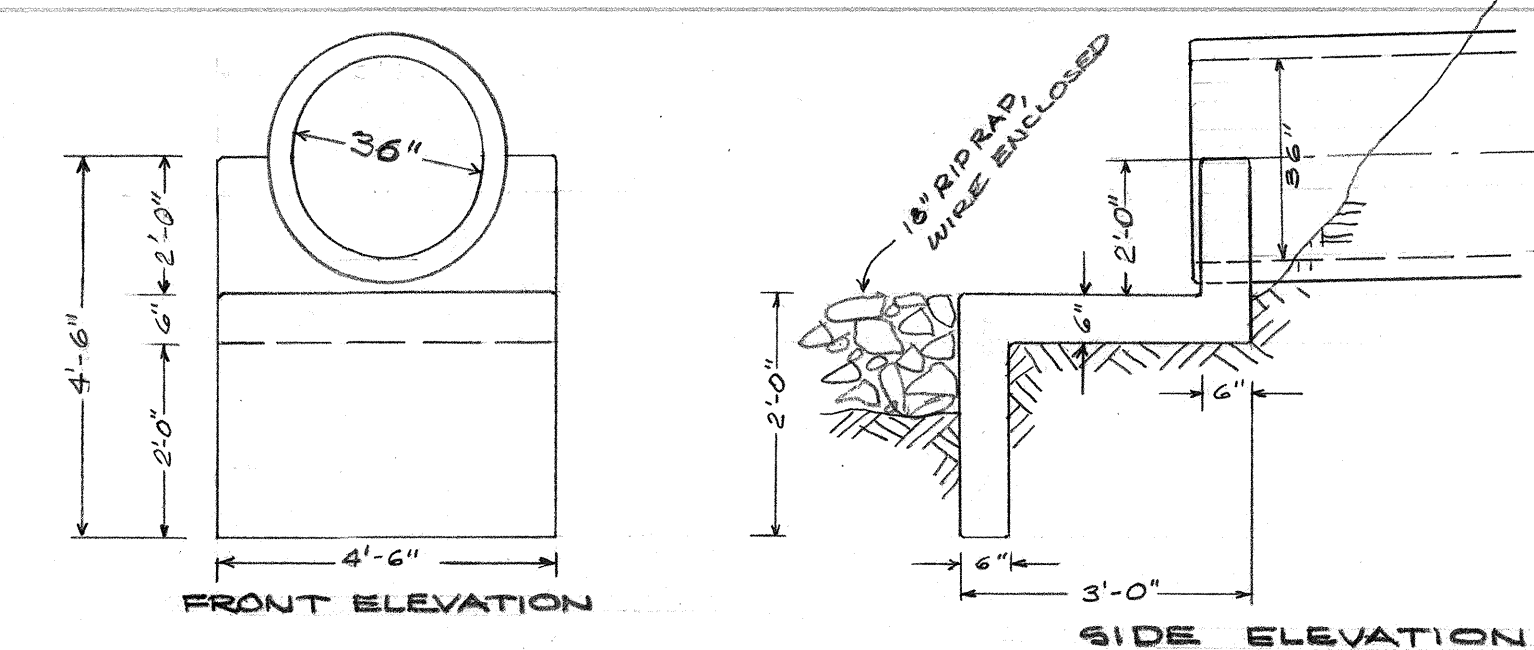

B.M. - Top of brass cap in conc., S. median nose @ Inter. Juan Tabo Blvd. & Haines Ave. ELEV. 5614.30

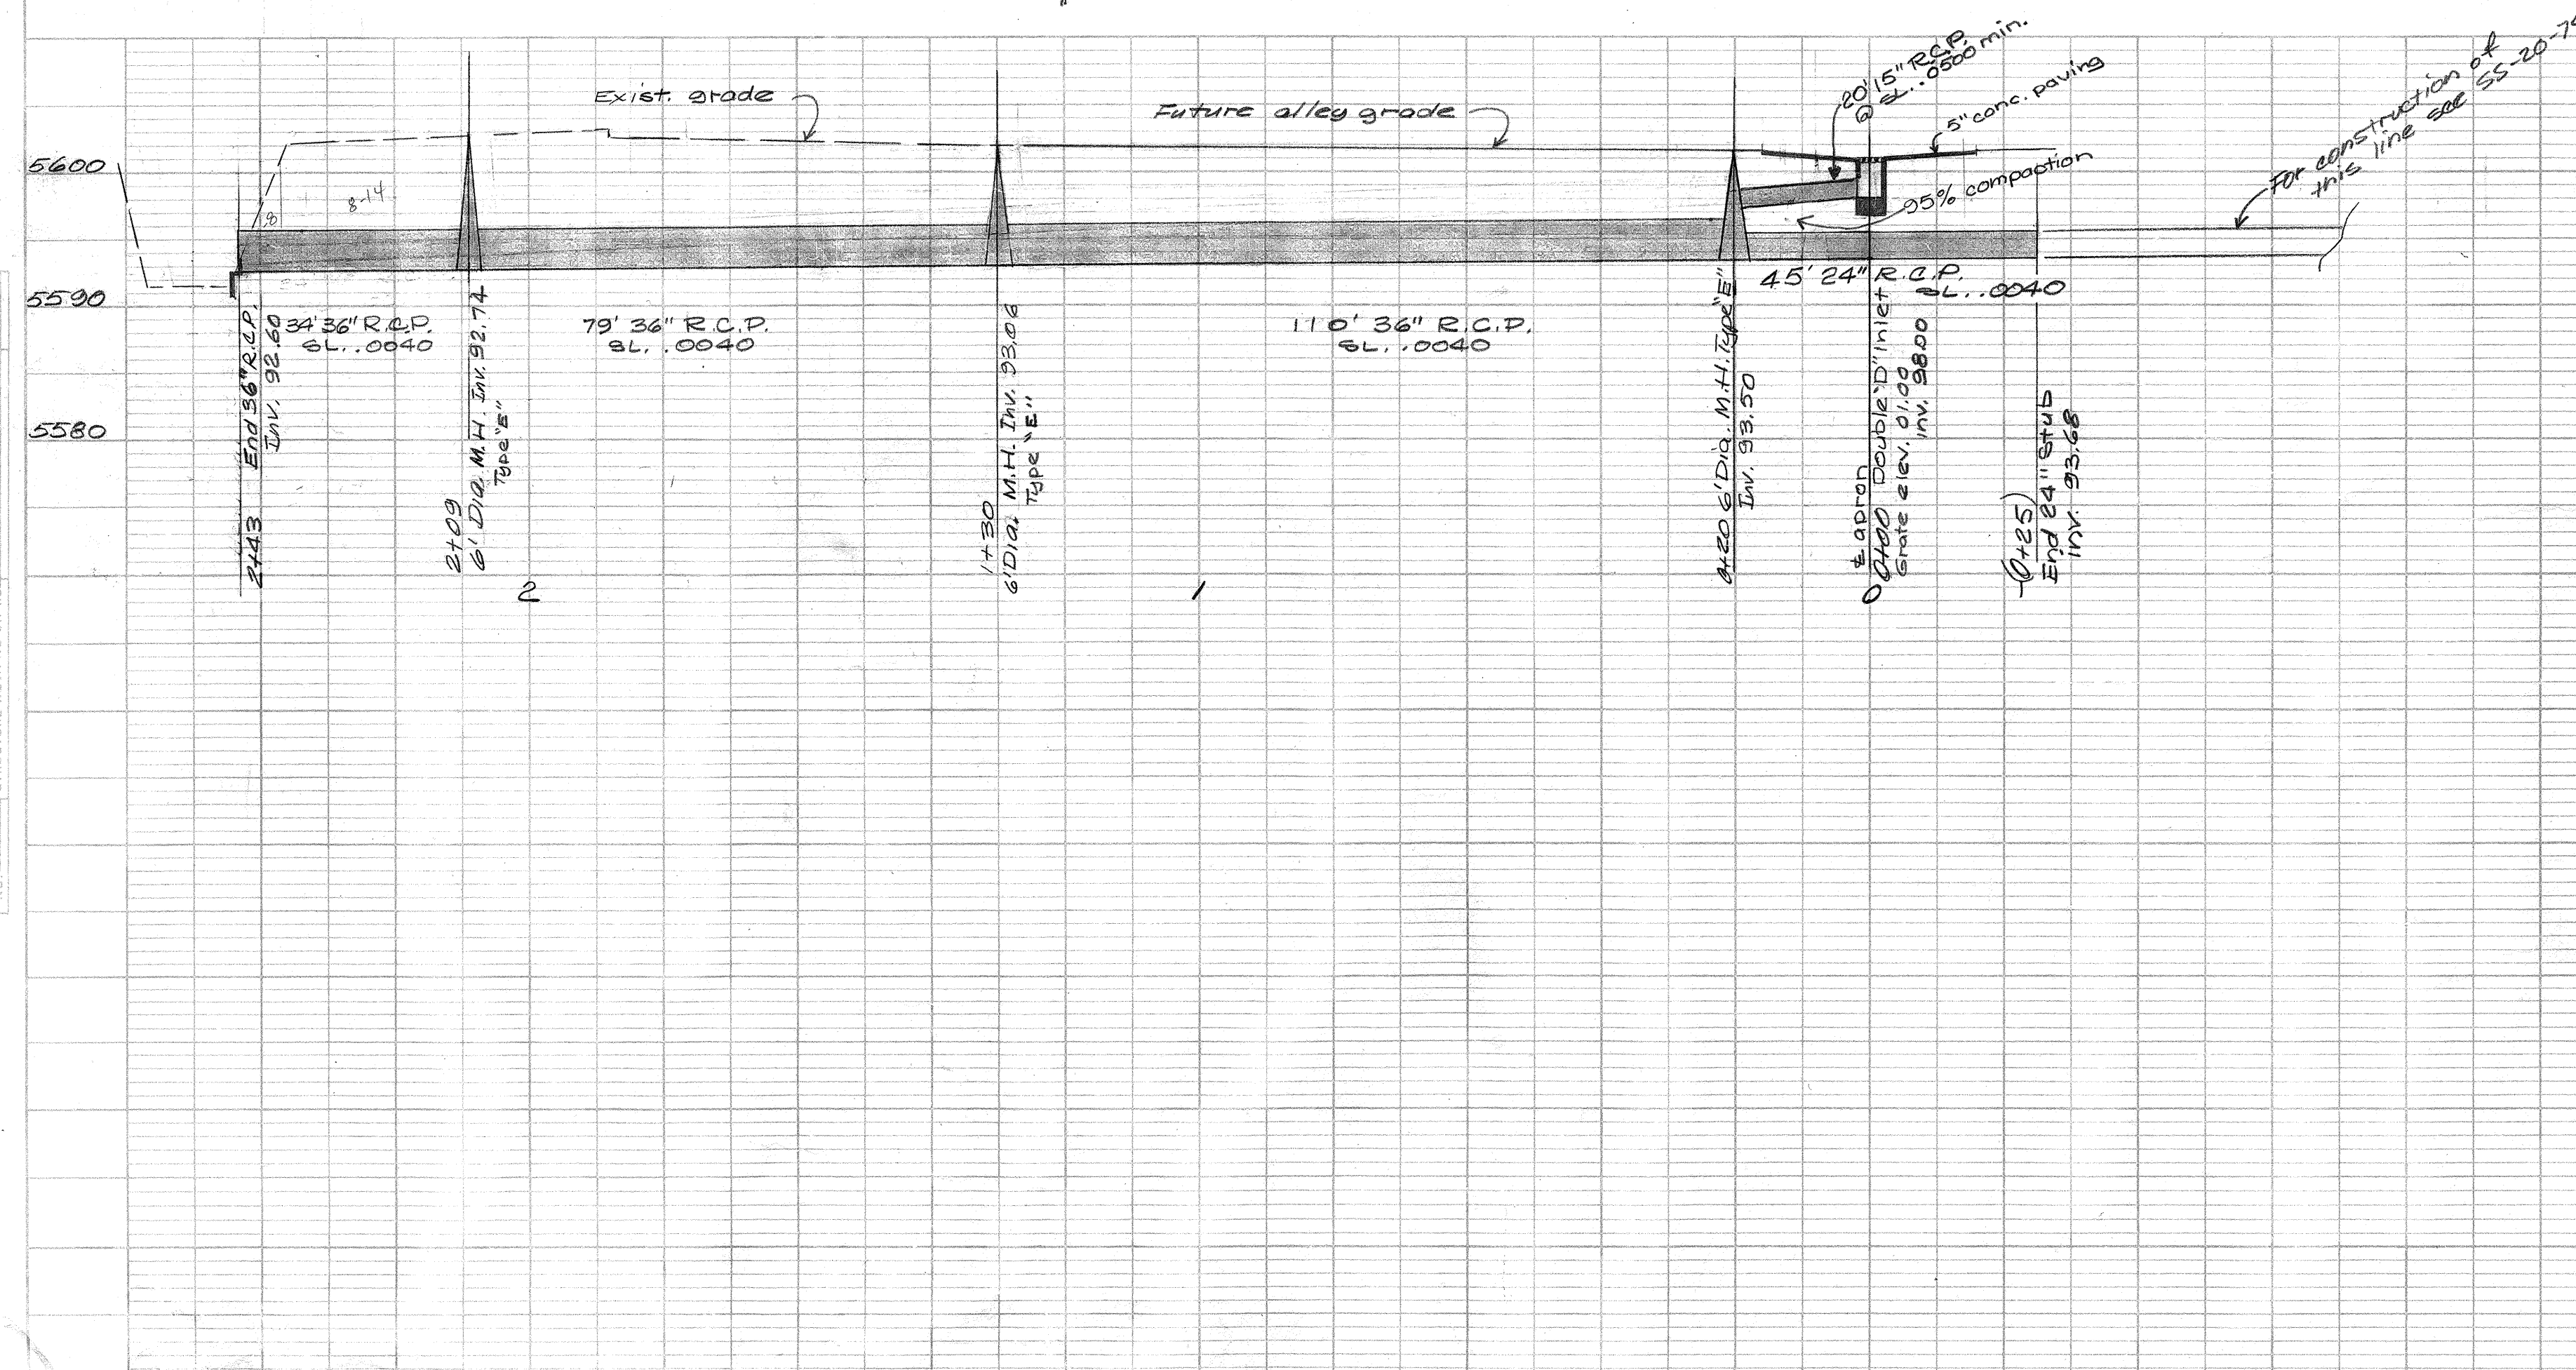

1	2	3	4	5	6	7	8	9	10	11	12	13	14	15	16	17	18	19	20	21	22	23	24	25	26	27	28	29	30	31
22	0	1	1	0	1	7	4																							

Grade lowered for extension to south - 7/23/74
Map No. J-2110

CITY OF ALBUQUERQUE PUBLIC WORKS DEPARTMENT ENGINEERING DIVISION			
TITLE JUAN TABO PLAZA SHOPPING CENTER - STORM SEWER DESIGN			
SUBMITTED BY	APPROVED BY	PRELIMINARY DRWG.	
DATE	DATE	DATE	
DESIGNED BY	APPROVED BY	CONSTRUCTION DRWG.	
DATE	DATE	DATE	
DRAWN BY	APPROVED BY	AS BUILT DRWG.	
DATE	DATE	DATE	
CHECKED BY	APPROVED BY	FILE NO.	
DATE	DATE	DATE	
REV. BY	NOTES	SHEET NO. 1 OF 1	
DATE	NOTES	SHEETS	