
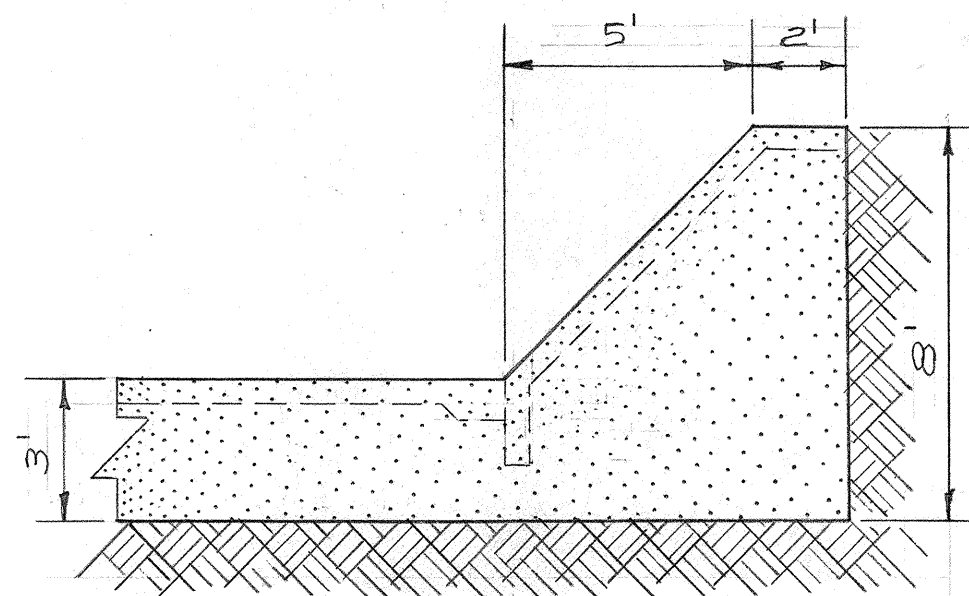



FOUR HILLS VILLAGE 9 & 10 INSTALLMENT

SCALE 1"=20'


NOTE: Provide 1/2" expansion joint at end of existing concrete-lined channel and every 45 feet thereafter in the new construction; contraction joint every 15 feet.

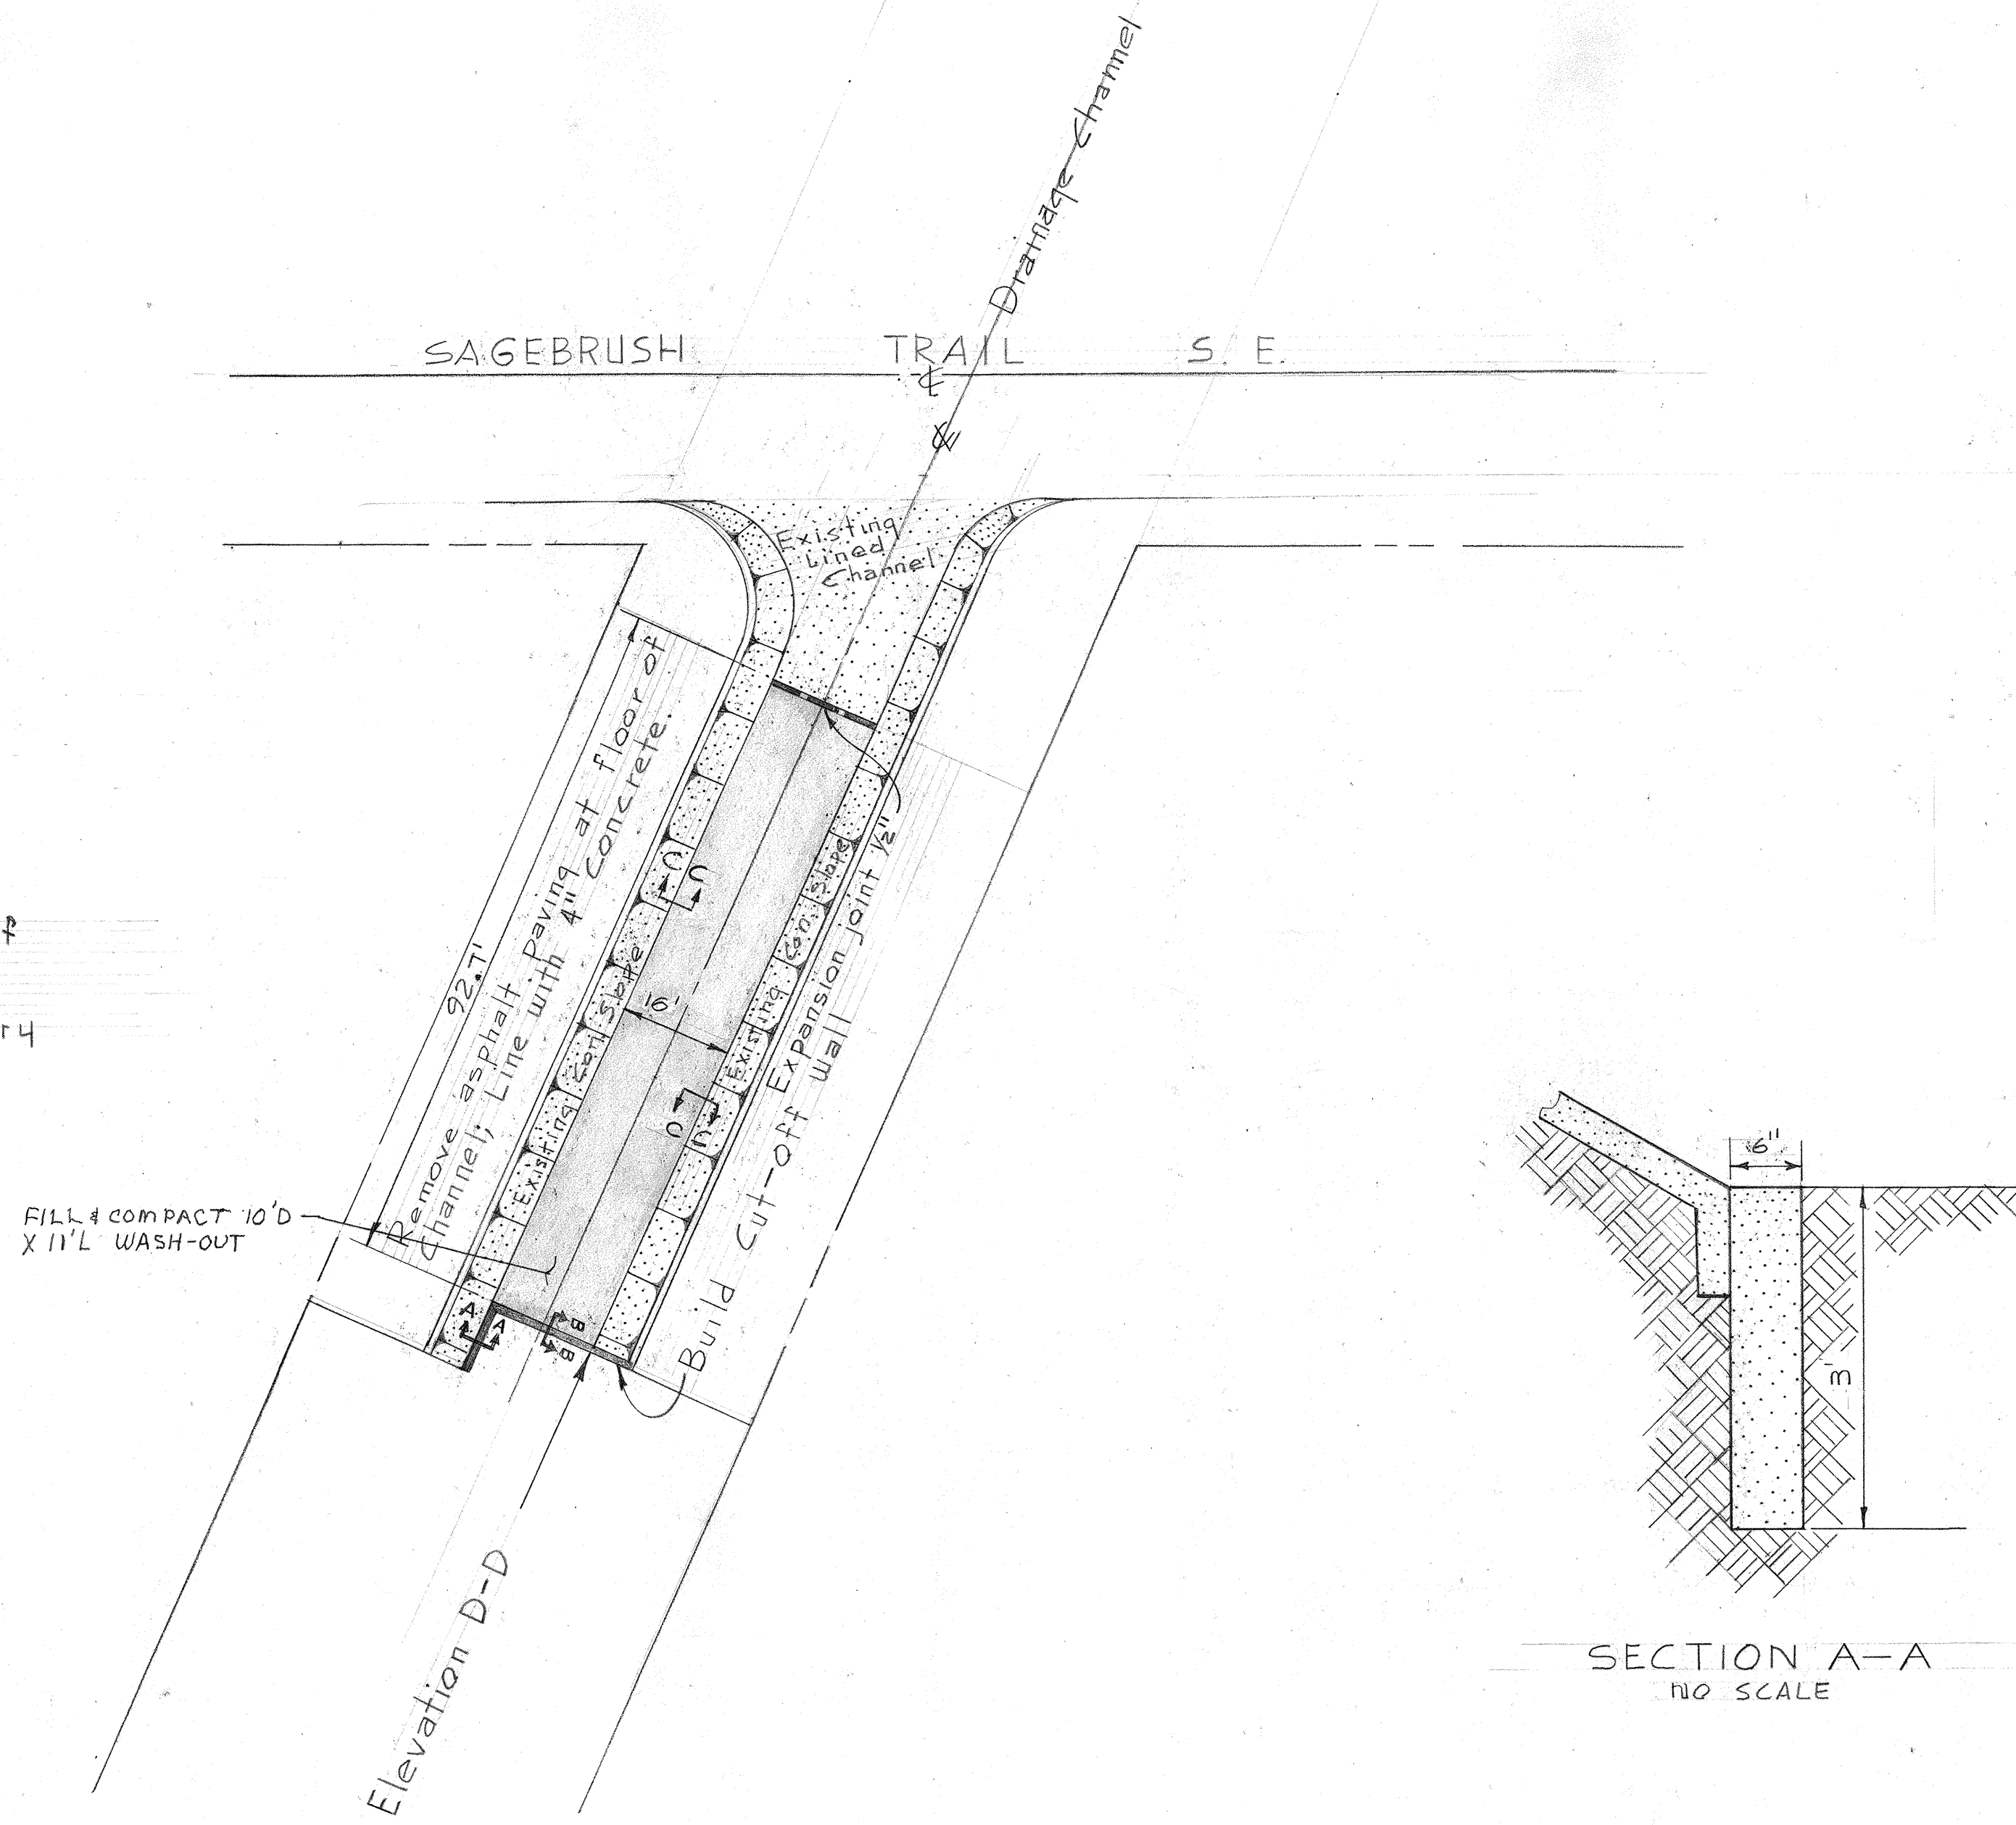


ELEVATION D-D  
NO SCALE

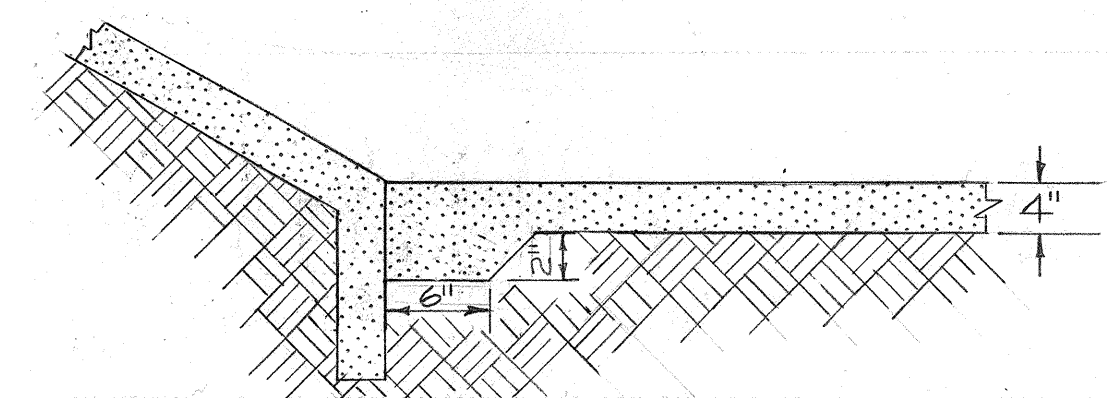

SECTION C-C  
NO SCALE

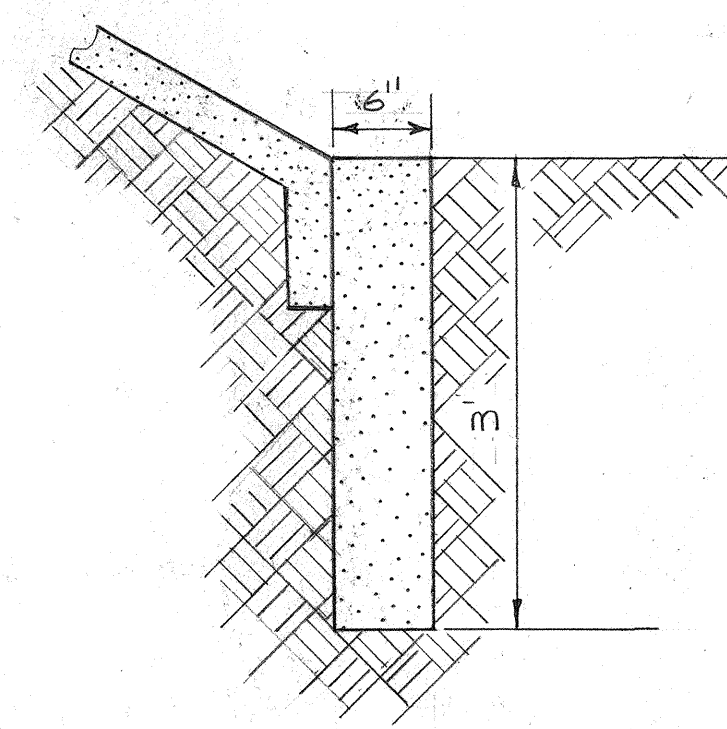

SECTION A-A  
NO SCALE

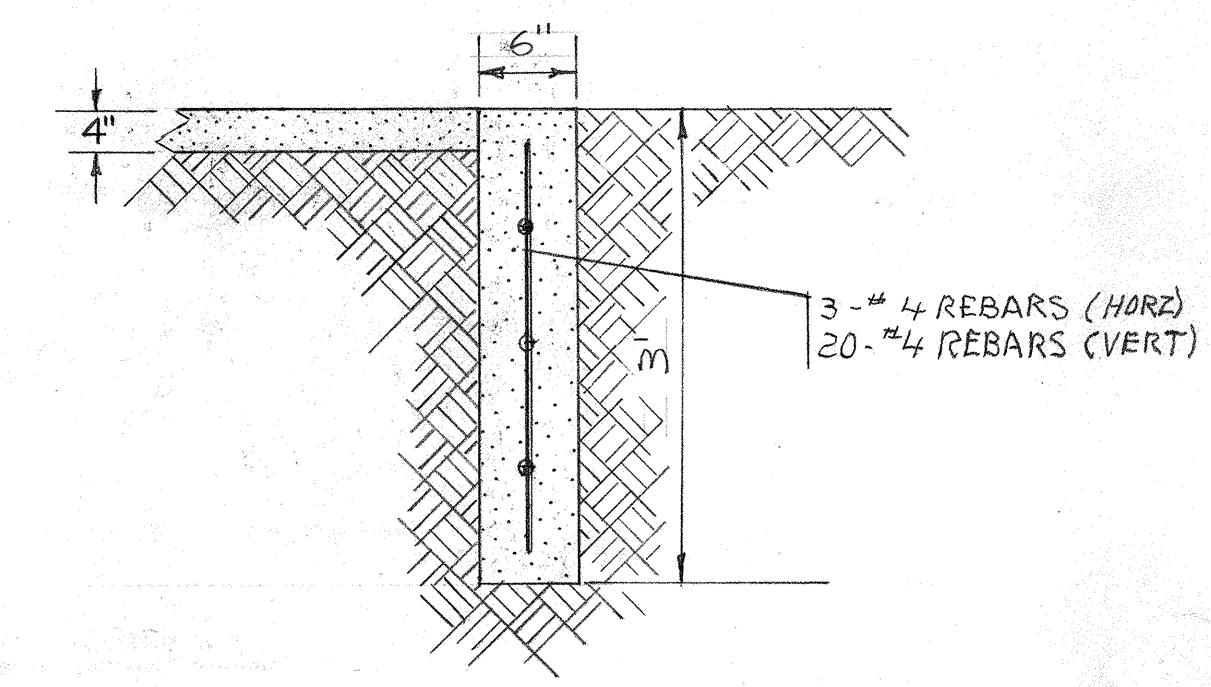

SECTION B-B  
NO SCALE

22 016 0178

APPROVAL OF AS BUILT DRAWINGS  
ASST. CITY ENGINEER - FIELD  
DATE 10-7-88

APPROVED FOR CONSTRUCTION  
CITY ENGINEER  
DATE 1-5-89

CITY OF ALBUQUERQUE PUBLIC WORKS DEPARTMENT ENGINEERING DIVISION					
TITLE: CONCRETE PAVING FOR CHANNEL BOTTOM					
APPROVALS	ENGINEER	DATE	APPROVALS	ENGINEER	DATE
City Engineer		5-22-88	Liquid Waste		
A.C.E.-Design		5-22-88	Traffic		
A.C.E.-Hydrology			Water		
DRAWING NO. SS-16-78			SHEET 1 OF 1		

SURVEY INFORMATION			BENCH MARKS			AS-BUILT INFORMATION		
FIELD NOTES						CONTRACTOR		
NO.			BY			WORKED BY		
DATE			DATE			DRAWING		
						CORRECTED BY		
						MICRO-FILM INFORMATION		
						RECORDED BY		
						NO.		