

PLAN	DATE
SURVEYED	
PLOTTED	
CHECKED	
BY	
NO.	


PROFILE	DATE
SURVEYED	
PLOTTED	
CHECKED	
BY	
NO.	

Remove existing Conc. and Construct new 6" Conc. Apron reinforced per original design.

See Revision 5, sheet 2, for revised outlet structure

Remove existing A.C. Pavement and replace with 6" Concrete Slab reinforced of W.W.F., 6"x6"/6-6

Contractor shall exercise caution in trenching through this area to avoid the existing 6" & 2" H.P. Gas line. Contractor shall verify exact location of Gas Main with the Southern Union Gas Company, 1401 San Pedro Drive N.E. Albuquerque, New Mexico. Mr. Bill Daughy, Tel. (505) 247-4101

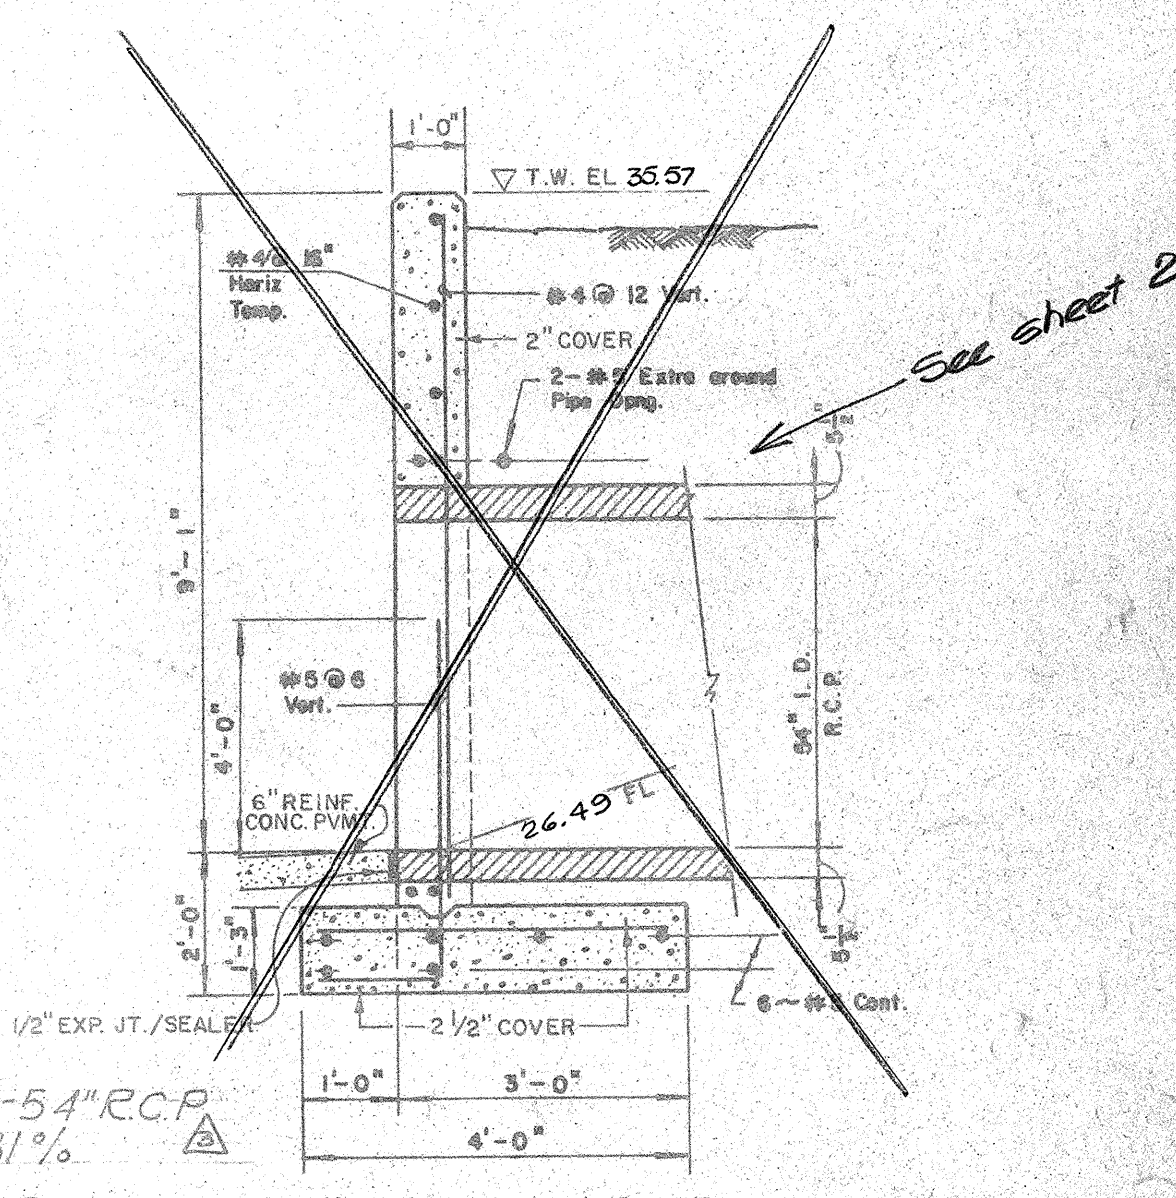

Remove exist. 68.23'-54" R.C.P. & install on new alignment as shown. Existing C.B. See sheet CA/U-1

- Notes:
- 1- For Construction notes see Plan CA/U-1
 - 2- All Survey line Stations, existing improvements and existing utilities are per topographic map prepared by Albuquerque surveying company.
 - 3- Elev. shown as T.R. are for Top of Pipe.

Note: Existing improvements such as Driveways, Lawns, Sidewalk, Curb, etc. required to be removed shall be replaced "in kind" as part of this Contract.

Construct single drop inlet per city of Albuquerque std. Page 215

"AS STAKED"

REVISION NO. 3

APPROVAL - CITY OF ALBUQUERQUE	
Celia J. Johnson	5/19/75
CIVIL ENGINEER - DESIGN	DATE
Quantia P. Kibich	12 May 75
CITY ENGINEER - DESIGN	DATE
5/19/75	DATE
CITY ENGINEER	DATE
5/24/75	DATE
LIQUID WASTE ENGINEER	DATE

NO	DATE	REVISIONS
1	8/29/74	Relocate exist. Water line & Gen. Notes added F.L. Rev.
2	9/23/74	54" S.D. FL. revised
3	5-7-75	Rev. location of 54" R.C.P. & reconstruct Part of Exist. Conc. Apron
4	6-5-75	Lower Re-Align
5	6-13-75	Lower 54" R.C.P. and conc. apron Added sheet 2

SAN PEDRO DRIVE N.E. Storm Drain



JOB CAPT. R.Y.S.	CHECKED BY W.A.H.
DRAWN BY: a.z.v.	DATE: 8-5-74
SCALE: 1" = 50'	JOB NO. 73125

U	1	A
1	1	1


SS-17-74 REV. 5
SH. 1 of 3

PLAN	DATE	BY	DATE	BY
REVIEWED				
PLOTTED				
NOTE BOOK				
NO				

PROFILE	DATE	BY	DATE	BY
REVIEWED				
PLOTTED				
NOTE BOOK				
NO				

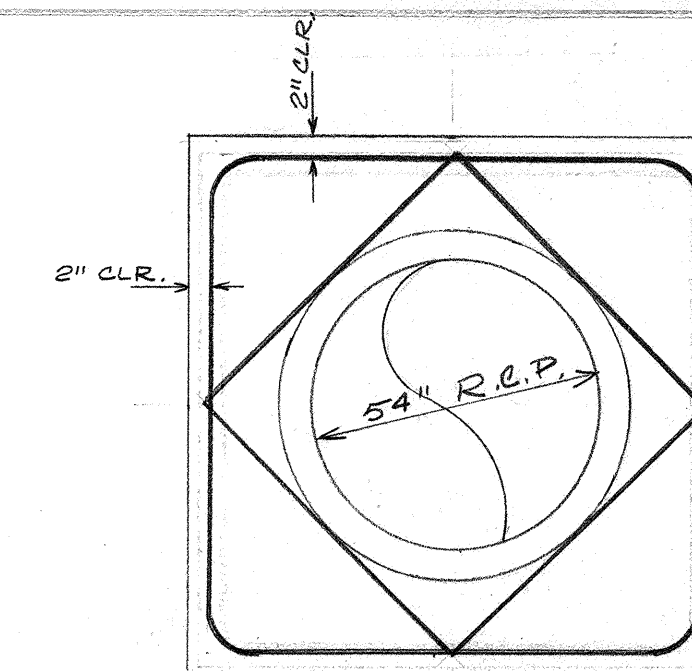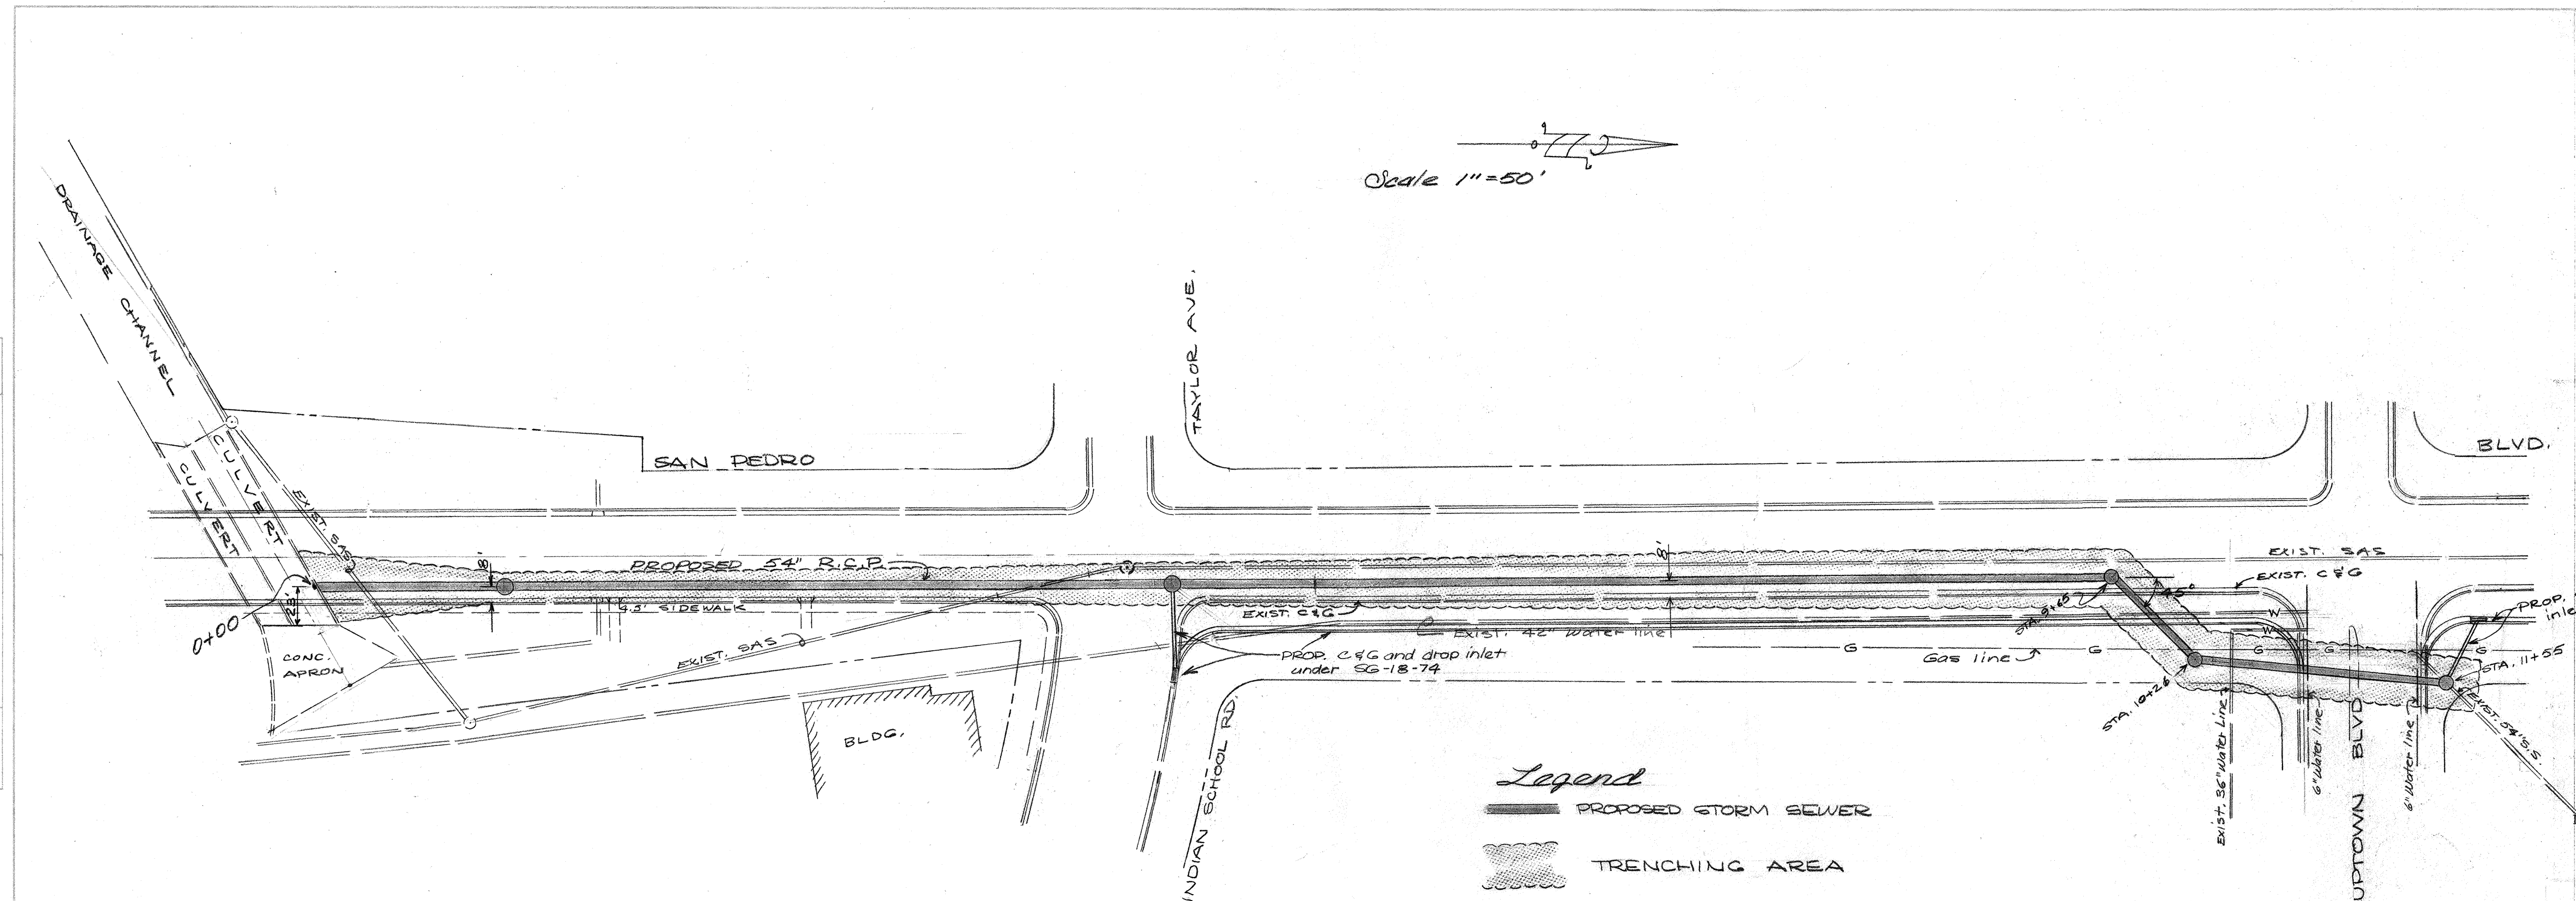


FRONT VIEW

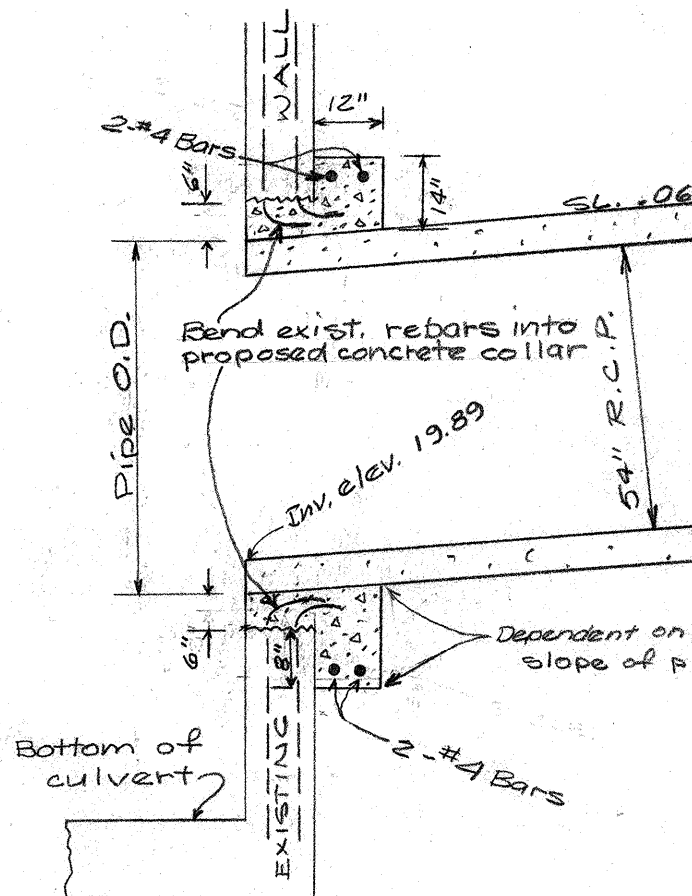

SIDE VIEW


CONCRETE COLLAR
NO SCALE

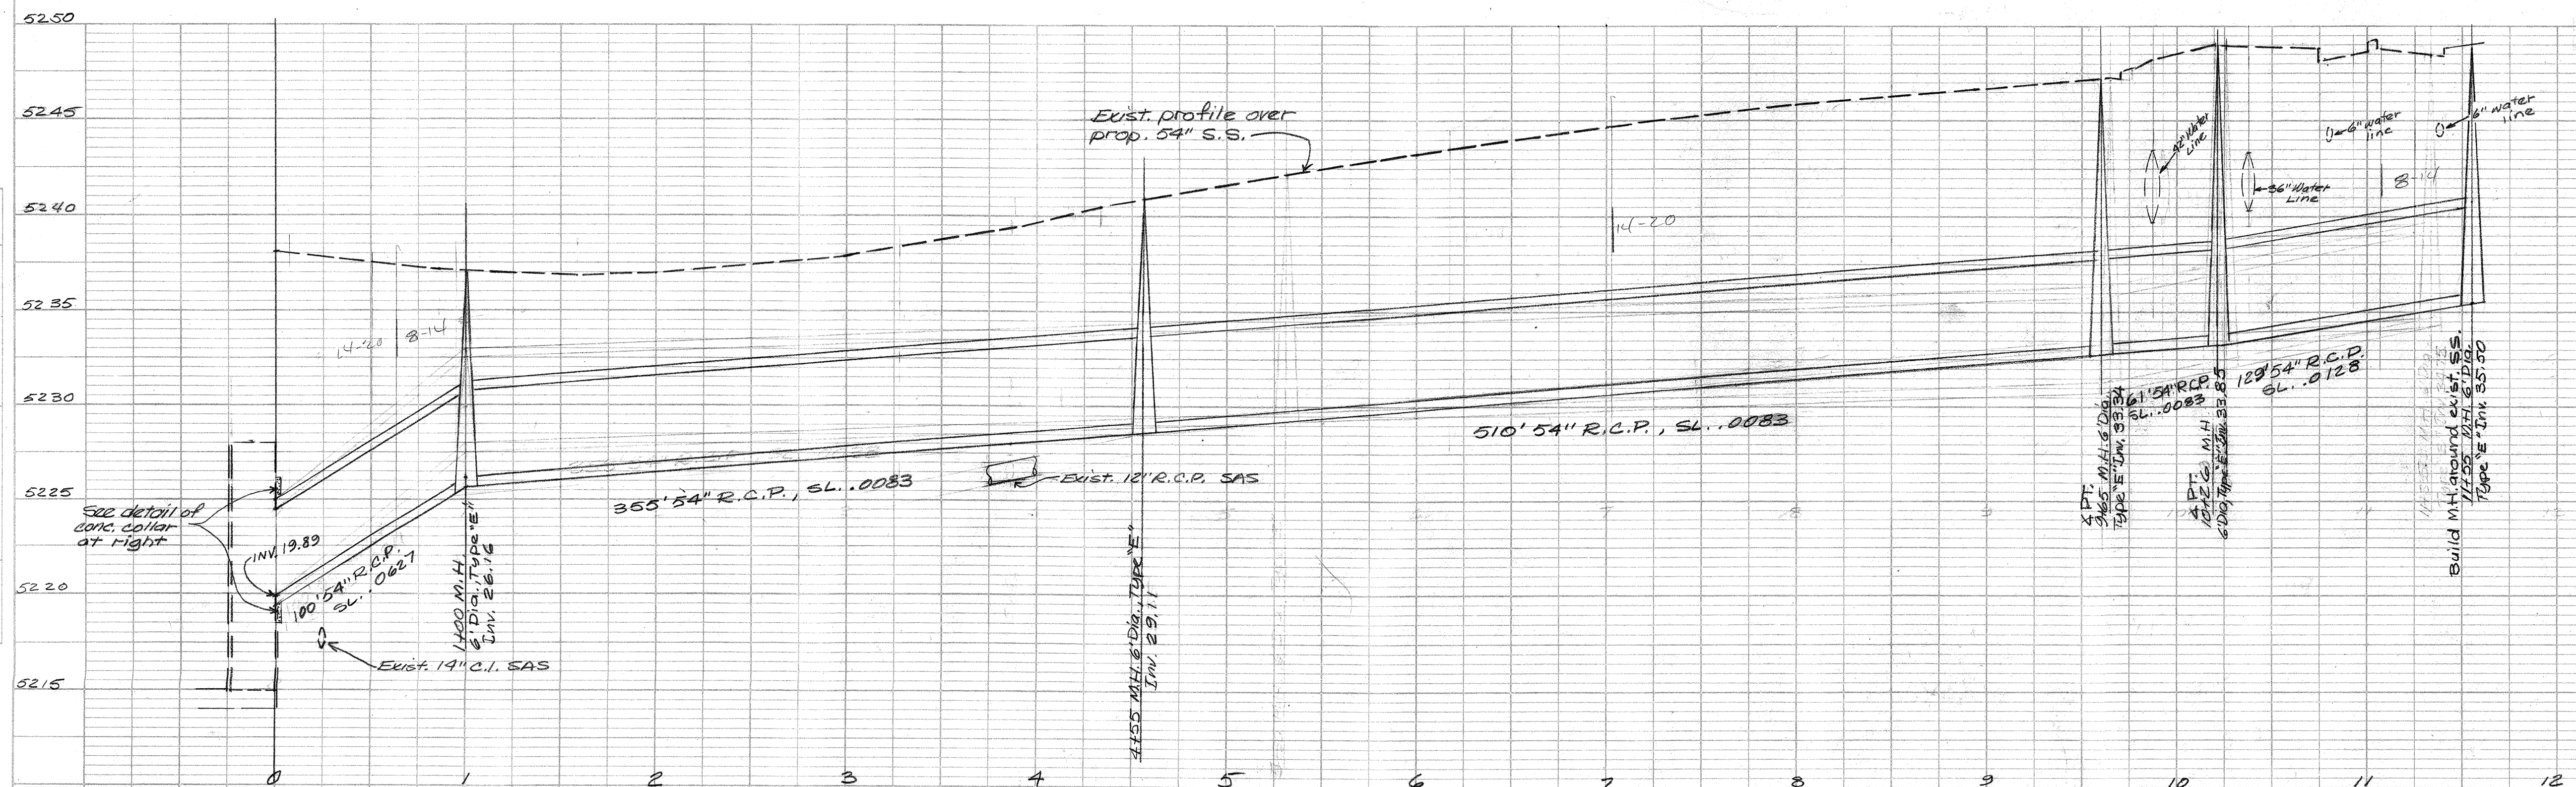


B.M. - B.C. SW. COR.
SAN PEDRO & UPTOWN
ELEV. 5248.15

MAP NO. H-18


NO.	DATE	REMARKS	RECORDED BY
CITY OF ALBUQUERQUE PUBLIC WORKS DEPARTMENT ENGINEERING DIVISION			
TITLE SAN PEDRO BLVD. - STORM SEWER FROM UPTOWN TO 1-040			
DESIGNED BY <i>C. J. Jones</i>	DRAWN BY <i>S. Emmett</i>	AS BUILT	
TITLE <i>Civil Engineer</i>	DATE <i>3/27/75</i>	SUBMITTED BY	TITLE
DATE <i>3/27/75</i>	DATE	DATE	DATE
APPROVAL		RECORDED BY	
ASS'T CITY ENGINEER	CITY ENGINEER	TITLE	DATE
DATE <i>3/27/75</i>	DATE <i>3/27/75</i>	DATE	DATE
WATER ENGINEER	LIQUID WASTE ENGINEER	SHEET NO.	SHEETS
DATE	DATE <i>3/27/75</i>	32	32
DRAWING NUMBER	95-17-74 REV. 2		

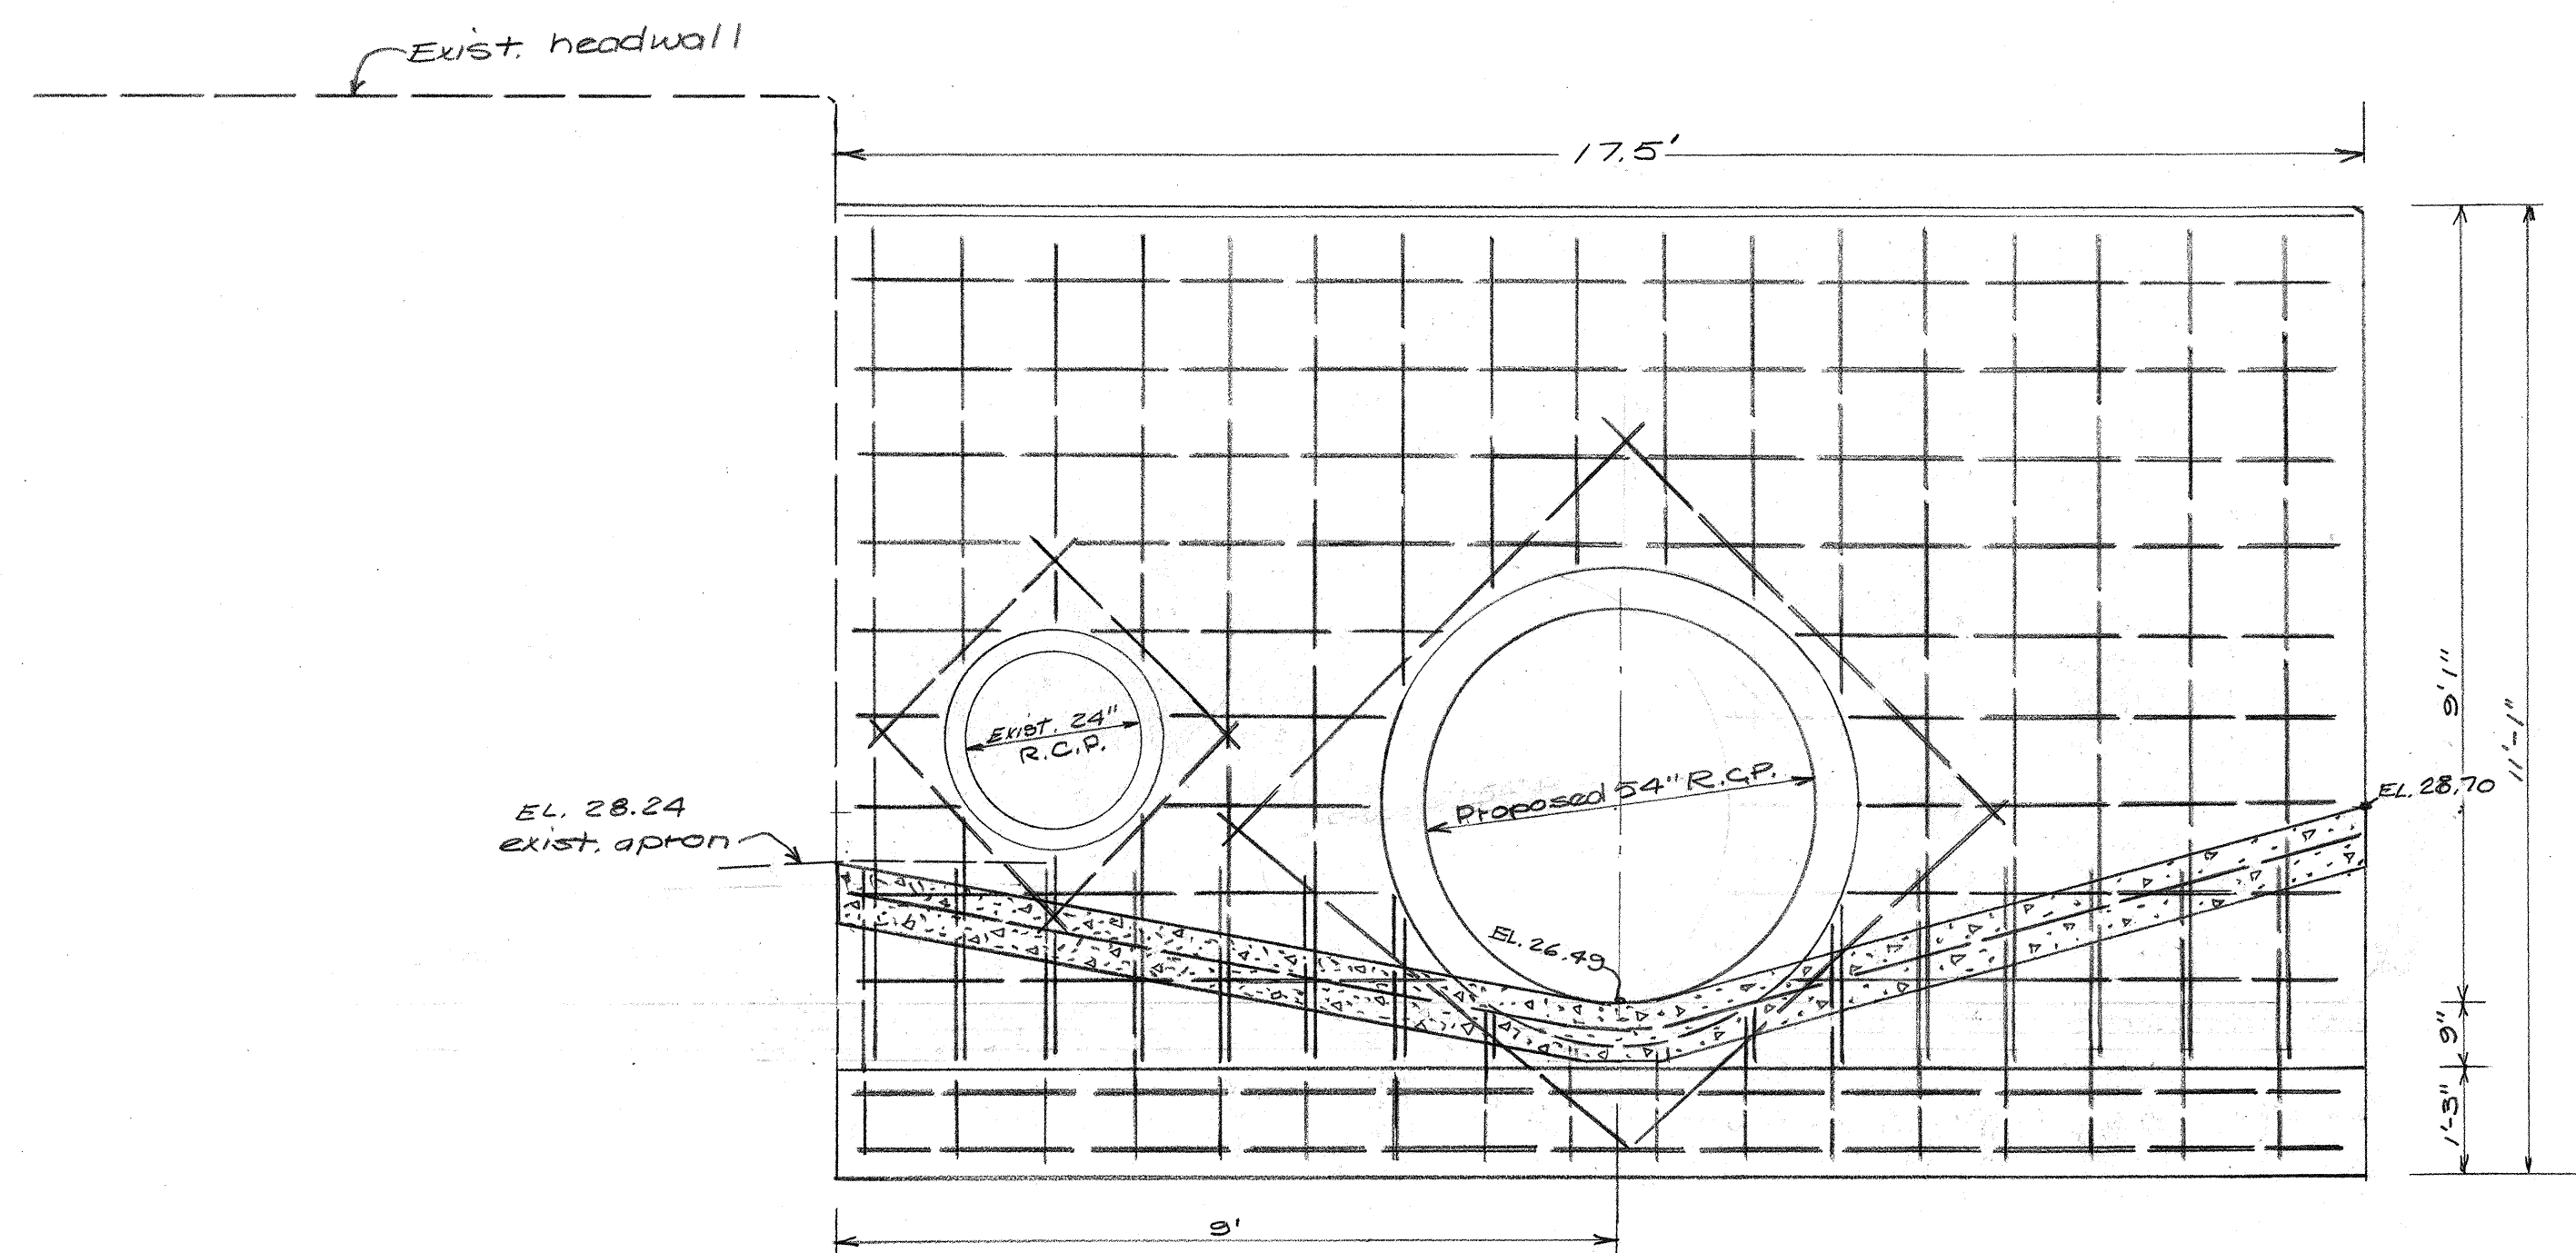


ELEVATION OF HEADWALL
Scale 1/2" = 1'

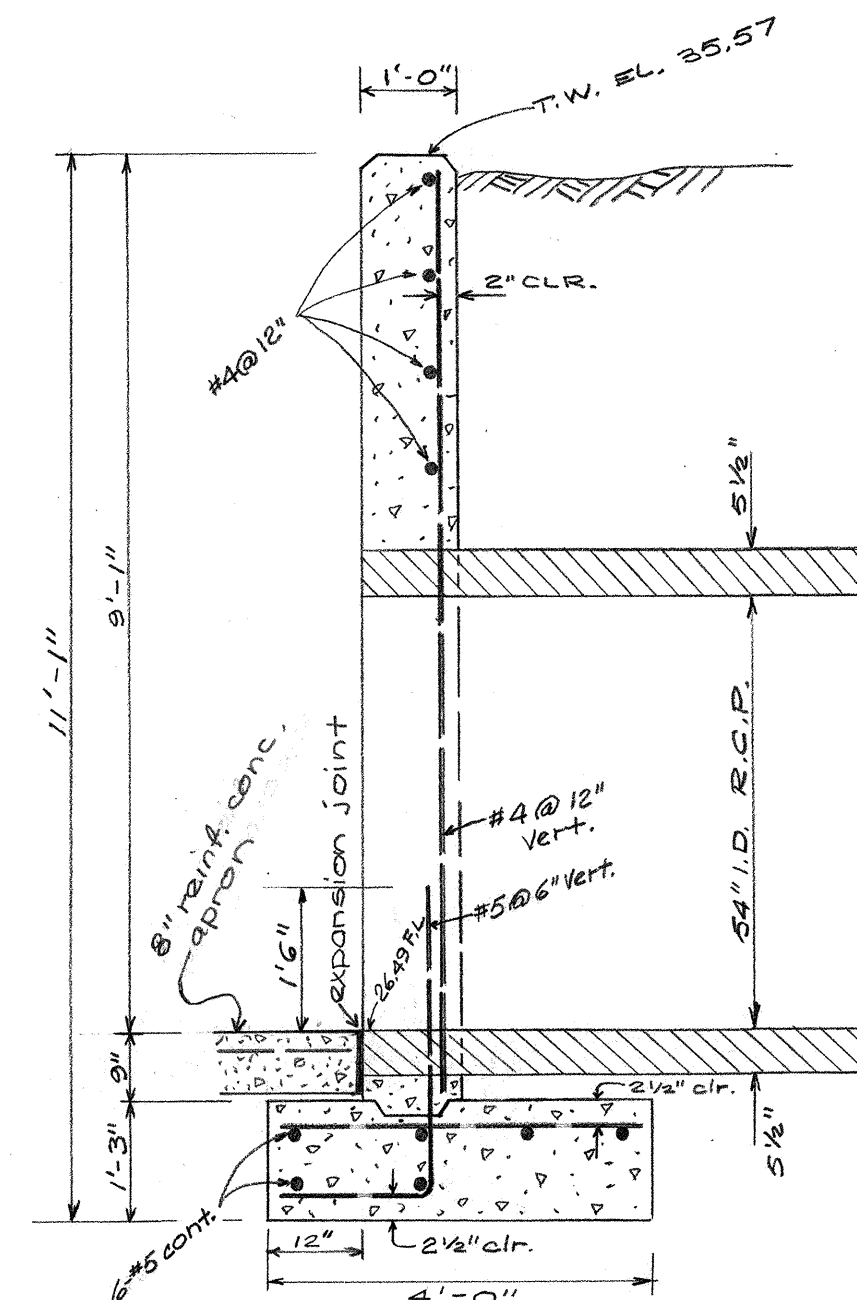


SECTION A-A
Scale 1/2" = 1'

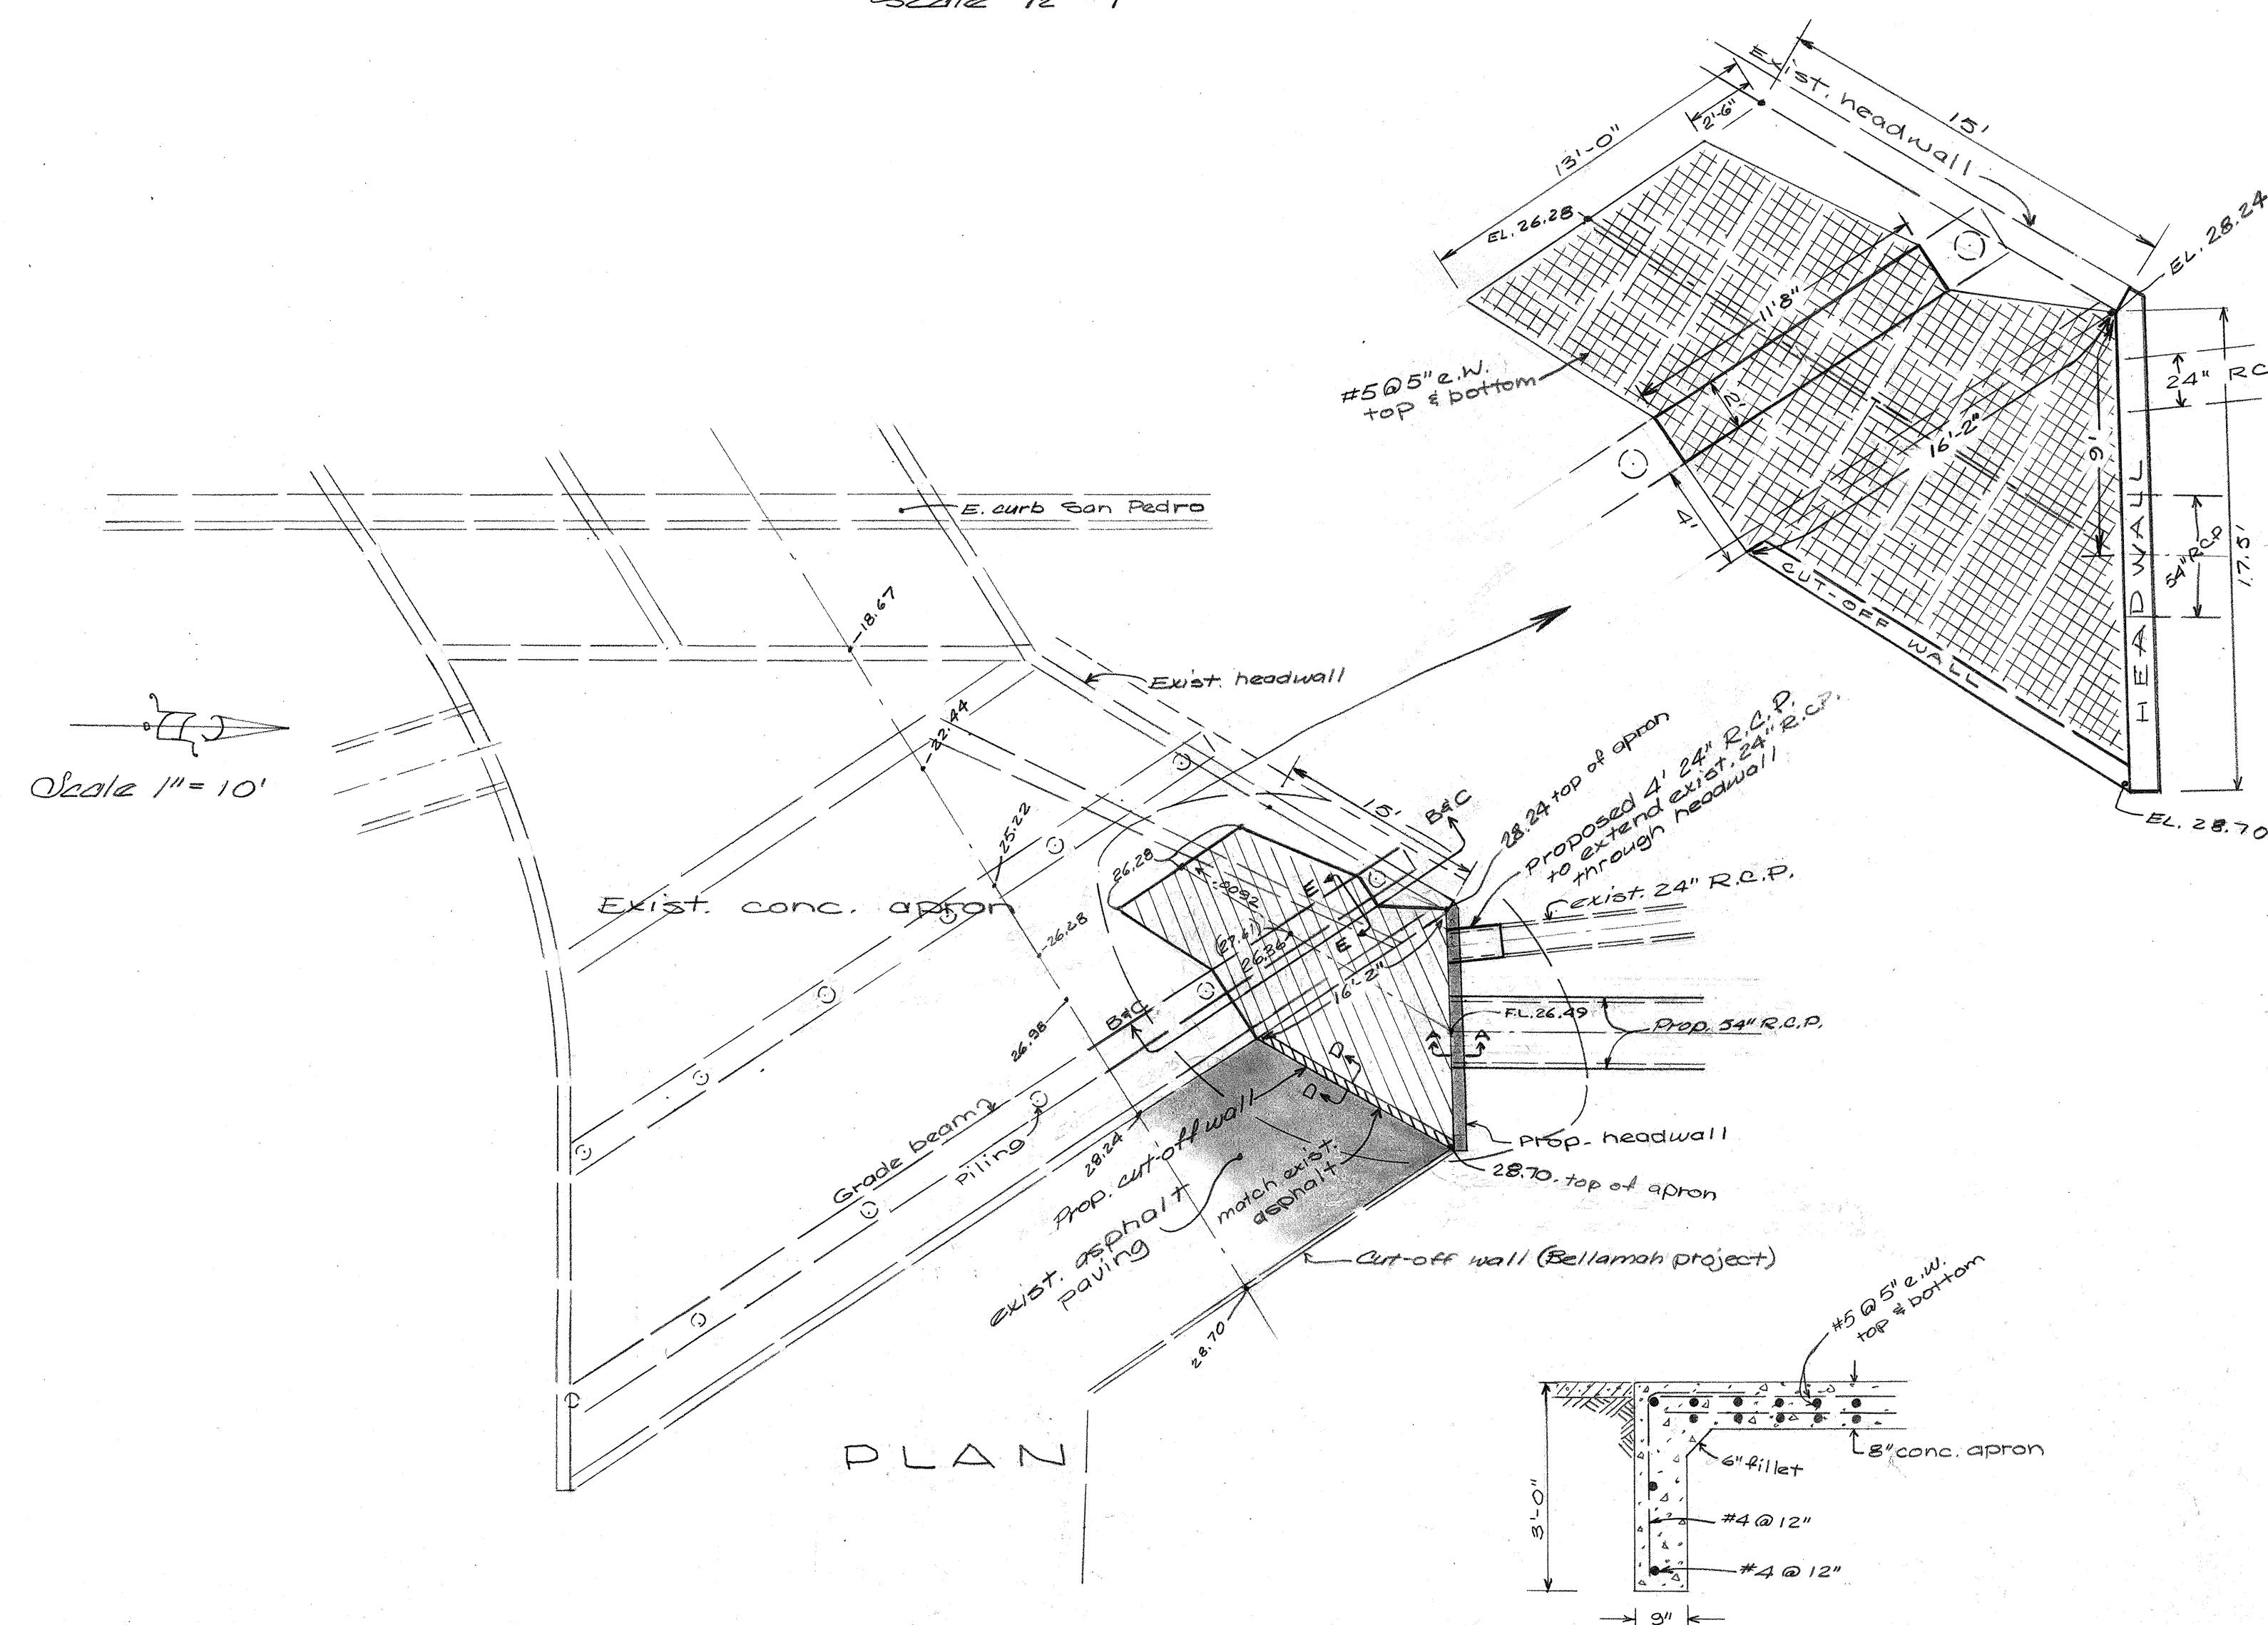


PLAN

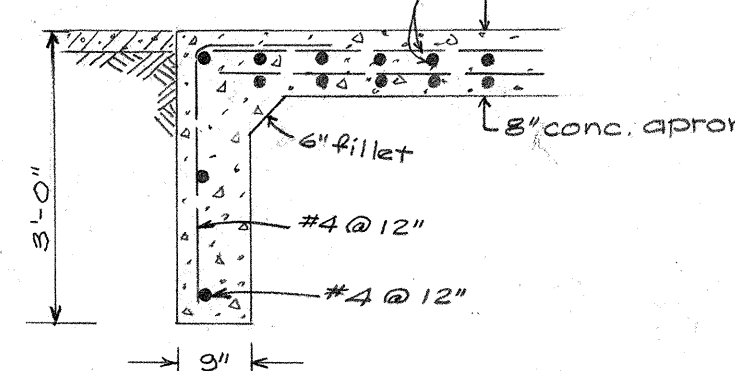


Section D-D
Cut-off wall - Scale 1/2" = 1'

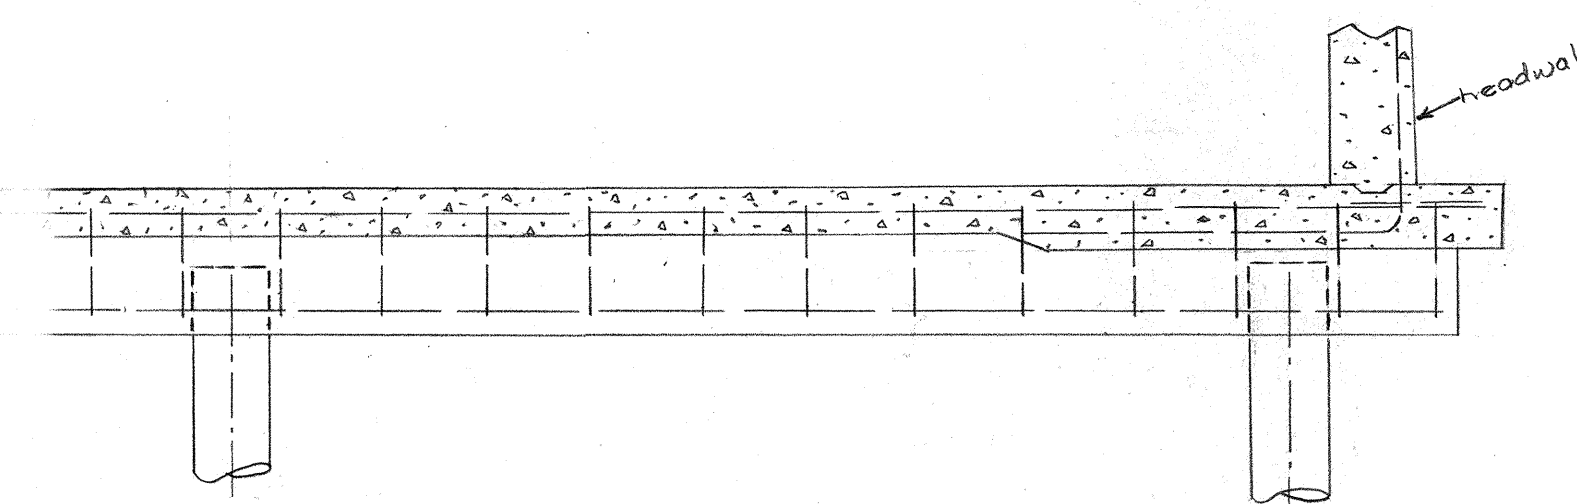


SECTION B-B Existing Grade Beam and piling
Scale 3/8" = 1'

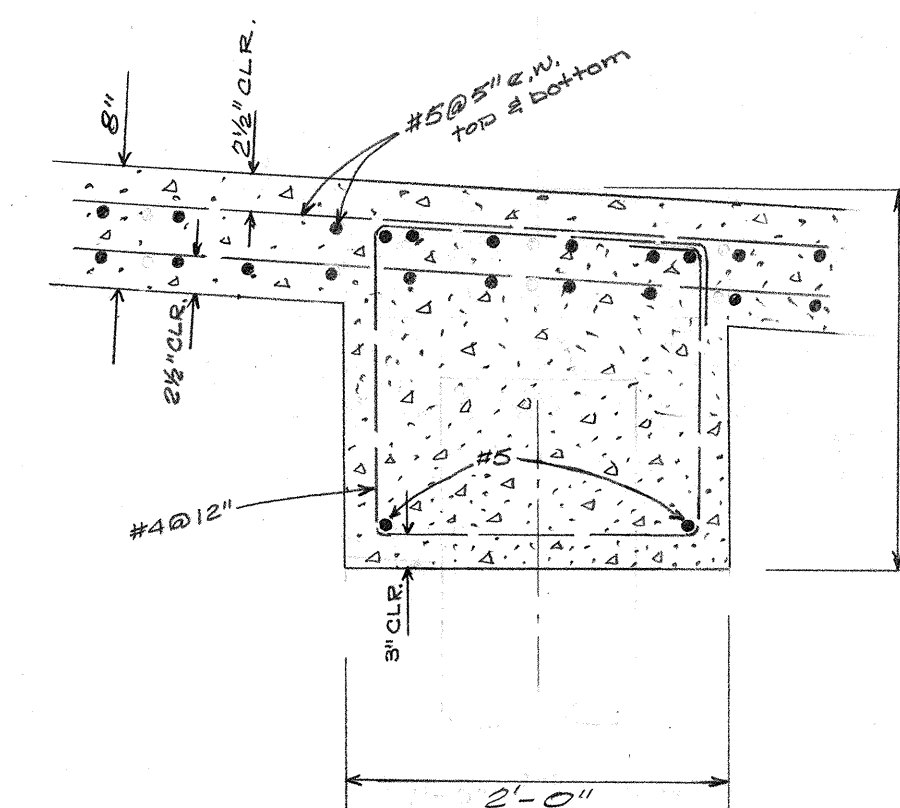

SECTION E-E Grade Beam

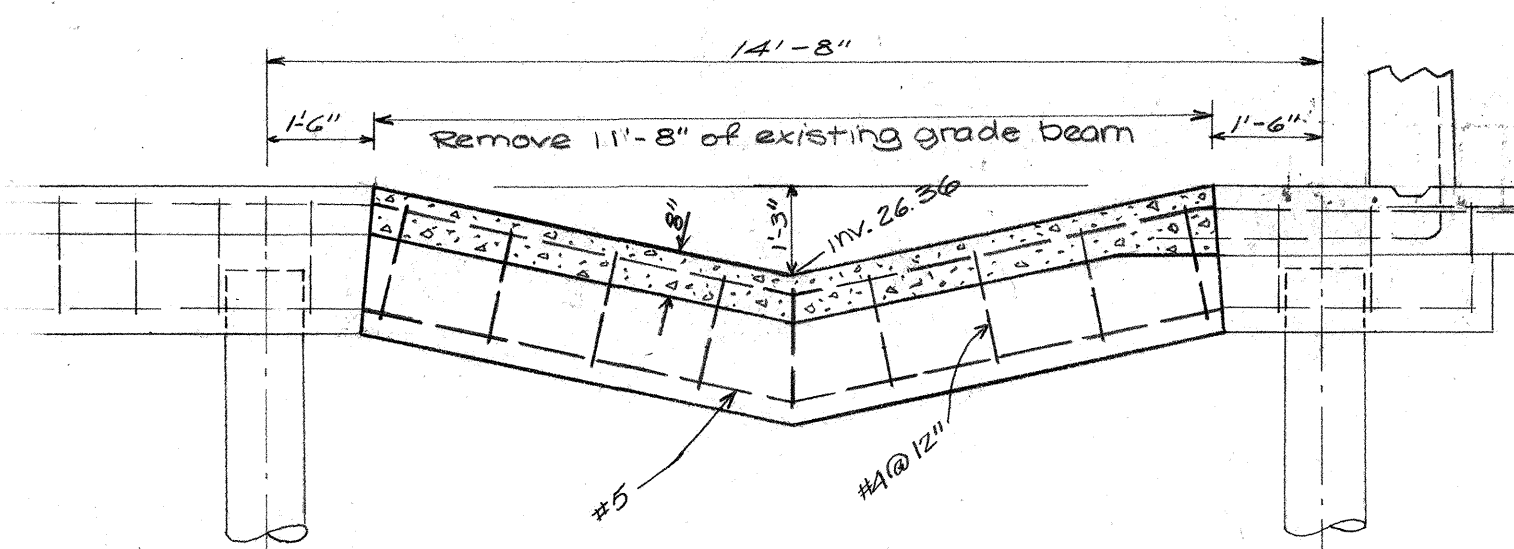

SECTION C-C Proposed new construction
of grade beam
Scale 3/8" = 1'

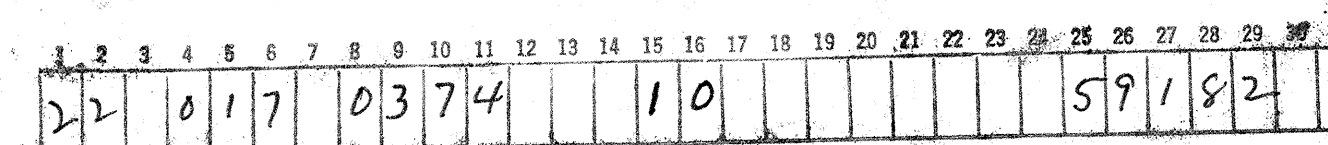

Map No. H-18

613-75	Added sheet 2, details of headwall & apron		
NO.	DATE	REMARKS	RECORDED BY
REVISIONS			
CITY OF ALBUQUERQUE PUBLIC WORKS DEPARTMENT ENGINEERING DIVISION			
TITLE Details of headwall for 54" S.S. in San Pedro Blvd. @ drainage channel			
DESIGNED BY <i>Curt</i>	DRAWN BY <i>E. Emmett</i>	AS BUILT	
TITLE <i>Draftsman</i>	TITLE <i>Draftsman</i>	CREATED BY	
DATE <i>6/18/75</i>	DATE <i>6/18/75</i>	DATE	
APPROVAL			
ASS'T CITY ENGINEER <i>[Signature]</i>	CITY ENGINEER <i>[Signature]</i>	RECORDED BY	
DATE <i>25 Jun 75</i>	DATE <i>25 Jun 75</i>	TITLE	
WATER ENGINEER	LIQUID WASTE ENGINEER	DATE	
DATE	DATE	SHEET NO. <i>2</i> OF <i>2</i>	
DRAWING NUMBER	55-17-74	REV. 5	