


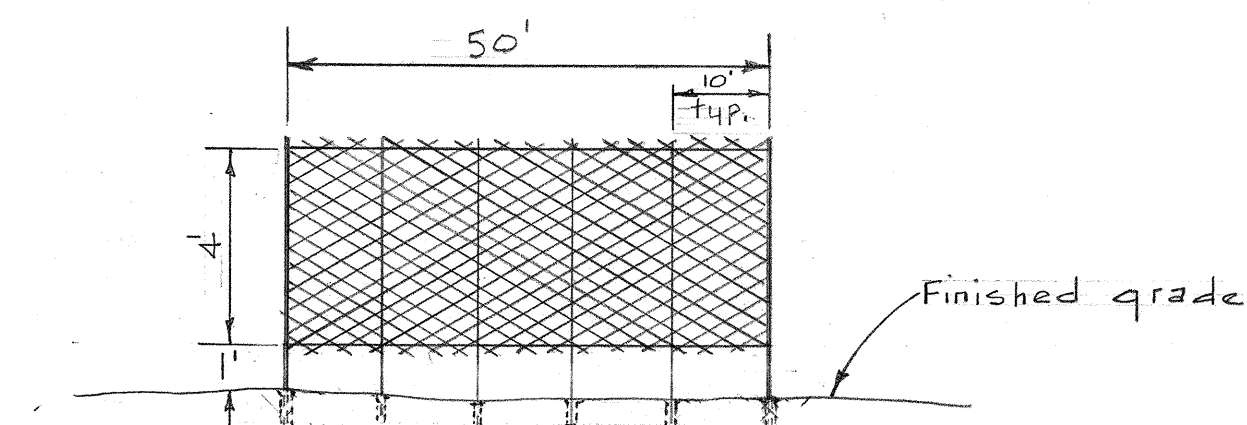


DETAIL "A"
NO SCALE




SCALE: 1"=20'

[illegible]


CITY OF ALBUQUERQUE PUBLIC WORKS DEPARTMENT ENGINEERING DIVISION					
TITLE: PROPOSED CHAINLINK FENCE ACROSS OPENING ON BURLISON DR. N.E.					
APPROVALS	ENGINEER	DATE	APPROVALS	ENGINEER	DATE
City Engineer	<i>C.A. Hymel</i>	<i>9/15/78</i>	Liquid Waste		
A.C.E.- Design	<i>J.R. Nelson</i>	<i>24 Aug 78</i>	Traffic		
A.C.E.-Hydrology			Water		
DRAWING NO. SS-25-78			SHEET 1 OF 1		

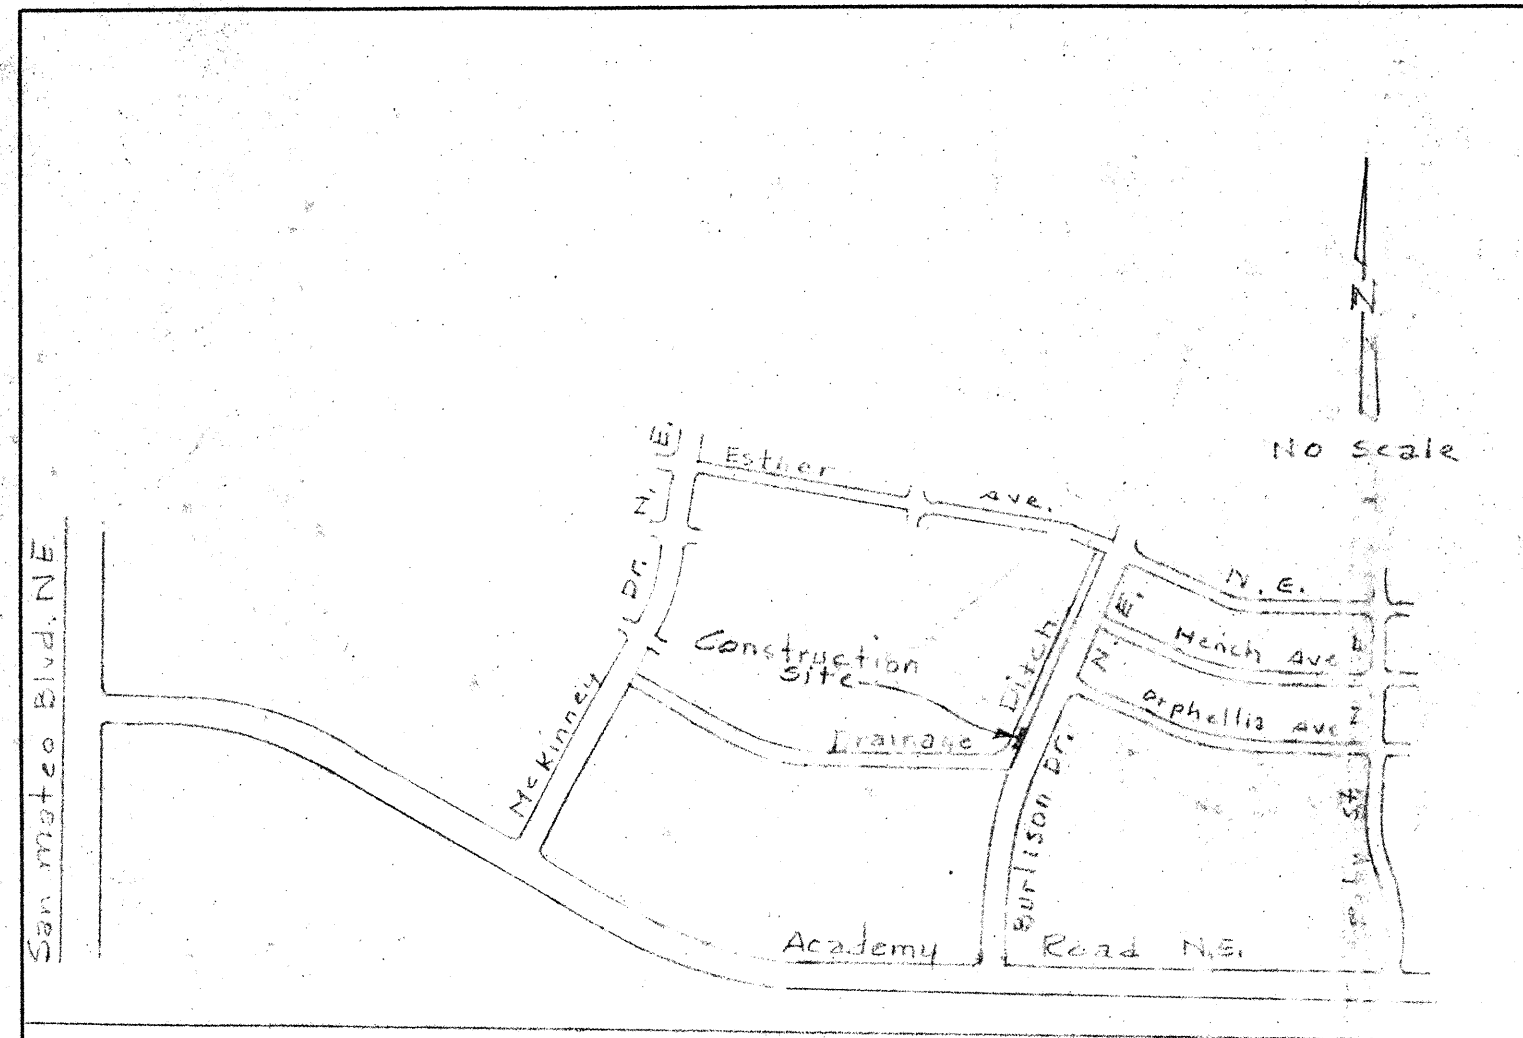

LOCATION MAP

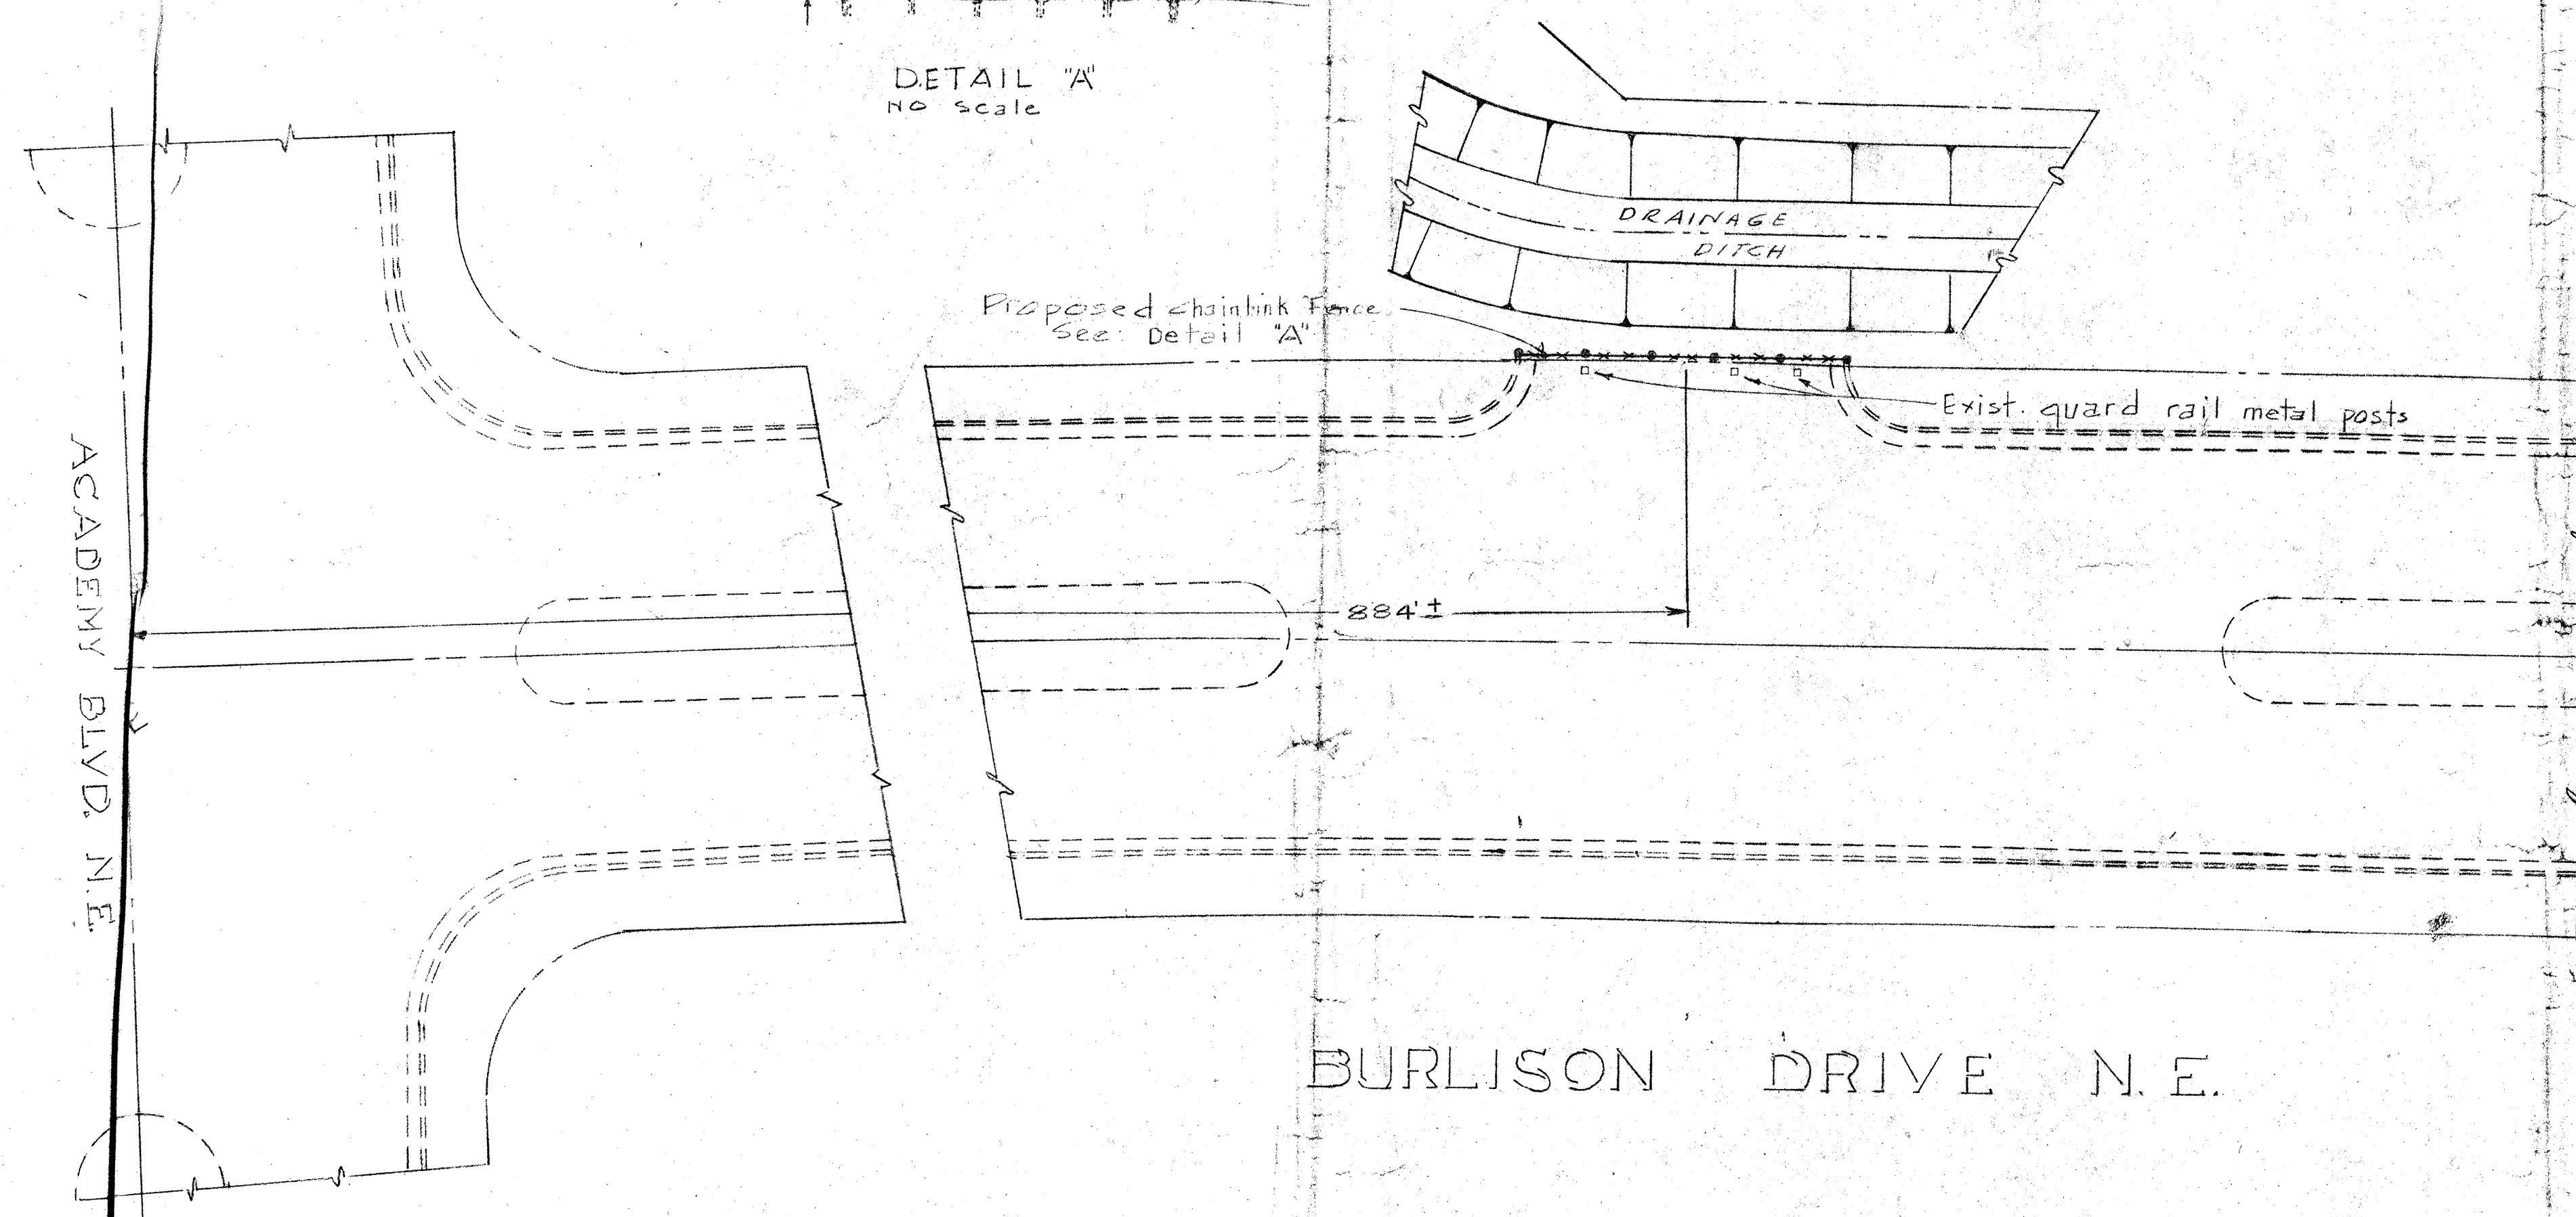

NOTE
Posts shall be imbedded in 18" deep,
12" diameter hole filled with concrete class 542000

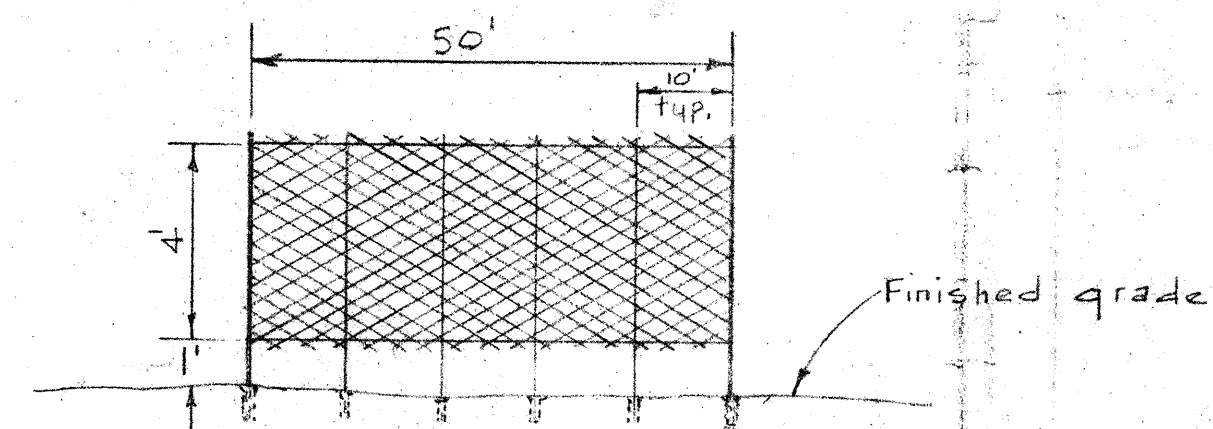

DETAIL "A"
No scale

SCALE: 1"=20'

BURLISON DRIVE N.E.

APPROVAL OF AS-BUILT DRAWINGS
CITY ENGINEER
DATE 12-7-82

APPROVED FOR
CONSTRUCTION
CITY ENGINEER
DATE 9/6/82

CITY OF ALBUQUERQUE PUBLIC WORKS DEPARTMENT ENGINEERING DIVISION					
TITLE: PROPOSED CHAINLINK FENCE ACROSS OPENING ON BURLISON DR. N.E.					
APPROVALS	ENGINEER	DATE	APPROVALS	ENGINEER	DATE
City Engineer	<i>[Signature]</i>	10/1/78	Liquid Waste		
A.C.E.-Design	<i>[Signature]</i>	24 Aug 78	Traffic		
A.C.E.-Hydrology			Water		
DRAWING NO. SS-25-78			SHEET 1 OF 1		

REFERENCES			SURVEY INFORMATION			BENCH MARKS			AS BUILT INFORMATION		
MAP NO.	E-18		EST. NO.	SS-25-78	W.O. NO.	NO.	BY	DATE	CONTRACTOR	WORK	DATE
										INSPECTOR'S	DATE
										FIELD	DATE
										VERIFICATION BY	DATE
										CORRECTED BY	DATE
										MICRO-FILM	DATE
										RECORDED BY	DATE
										NO.	

DESIGNED BY *[Signature]* DATE 8-27-78
DRAWN BY T. SANCHEZ DATE 8-16-78
CHECKED BY