


PAVING & WATERLINE REPLACEMENT
ON CARLTON ST.
NORTH OF GRIEGOS RD. N.W.

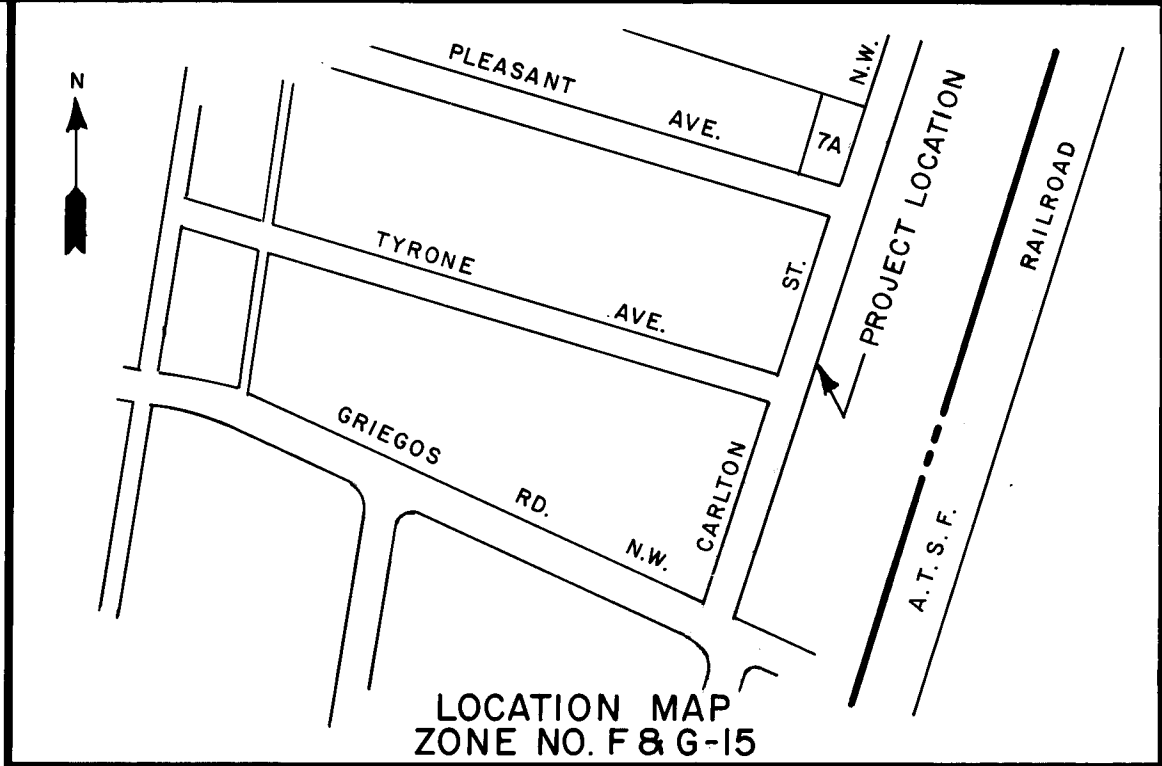

NOTICE TO CONTRACTORS

1. All work detailed on these plans to be performed under contract shall, except as otherwise stated or provided for hereon, be constructed in accordance with the "Interim Standard Specifications for Public Works Construction, 1985."
2. Two (2) working days prior to any excavation, contractor must contact Line Locating Service, 765-1234 for location of existing utilities.
3. Prior to construction, contractor shall excavate and verify the horizontal and vertical locations of all obstructions. Should a conflict exist, the contractor shall notify the engineer or surveyor so that the conflict can be resolved with minimum amount of delay.

THE FOLLOWING NOTES ALSO APPLY
WHEN CHECKED






- ☒ All utilities and utility service lines shall be installed prior to paving.
- ☒ Backfill compaction shall be according to specified street use.
- ☒ Tack coat requirements shall be determined by the City Engineer.
- ☒ Sidewalks and wheelchair ramps within curb returns shall be constructed wherever a new curb return is constructed.
- ☒ If curb is depressed for a drivepad or a handicap ramp, drivepad or ramp shall be constructed prior to acceptance of the curb and gutter.
- ☒ All storm drainage facilities shall be completed prior to final acceptance.

INDEX		
SHEET NO.		DESCRIPTION
1 OF 4		TITLE SHEET
2 OF 4	PLAN & PROFILE STA. 10+00 TO STA. 18+00	
3 OF 4	PLAN & PROFILE STA. 18+00 TO STA. 20+43	
4 OF 4	CROSS SECTIONS	

26 223 10186

W. J. McManis
5-16-85



	CITY OF ALBUQUERQUE		APPROVED FOR CONSTRUCTION
			<i>[Signature]</i> 5/16/85
			CITY ENGINEER DATE
DRAWING NO.		SHEET OF	
2231		1 4	

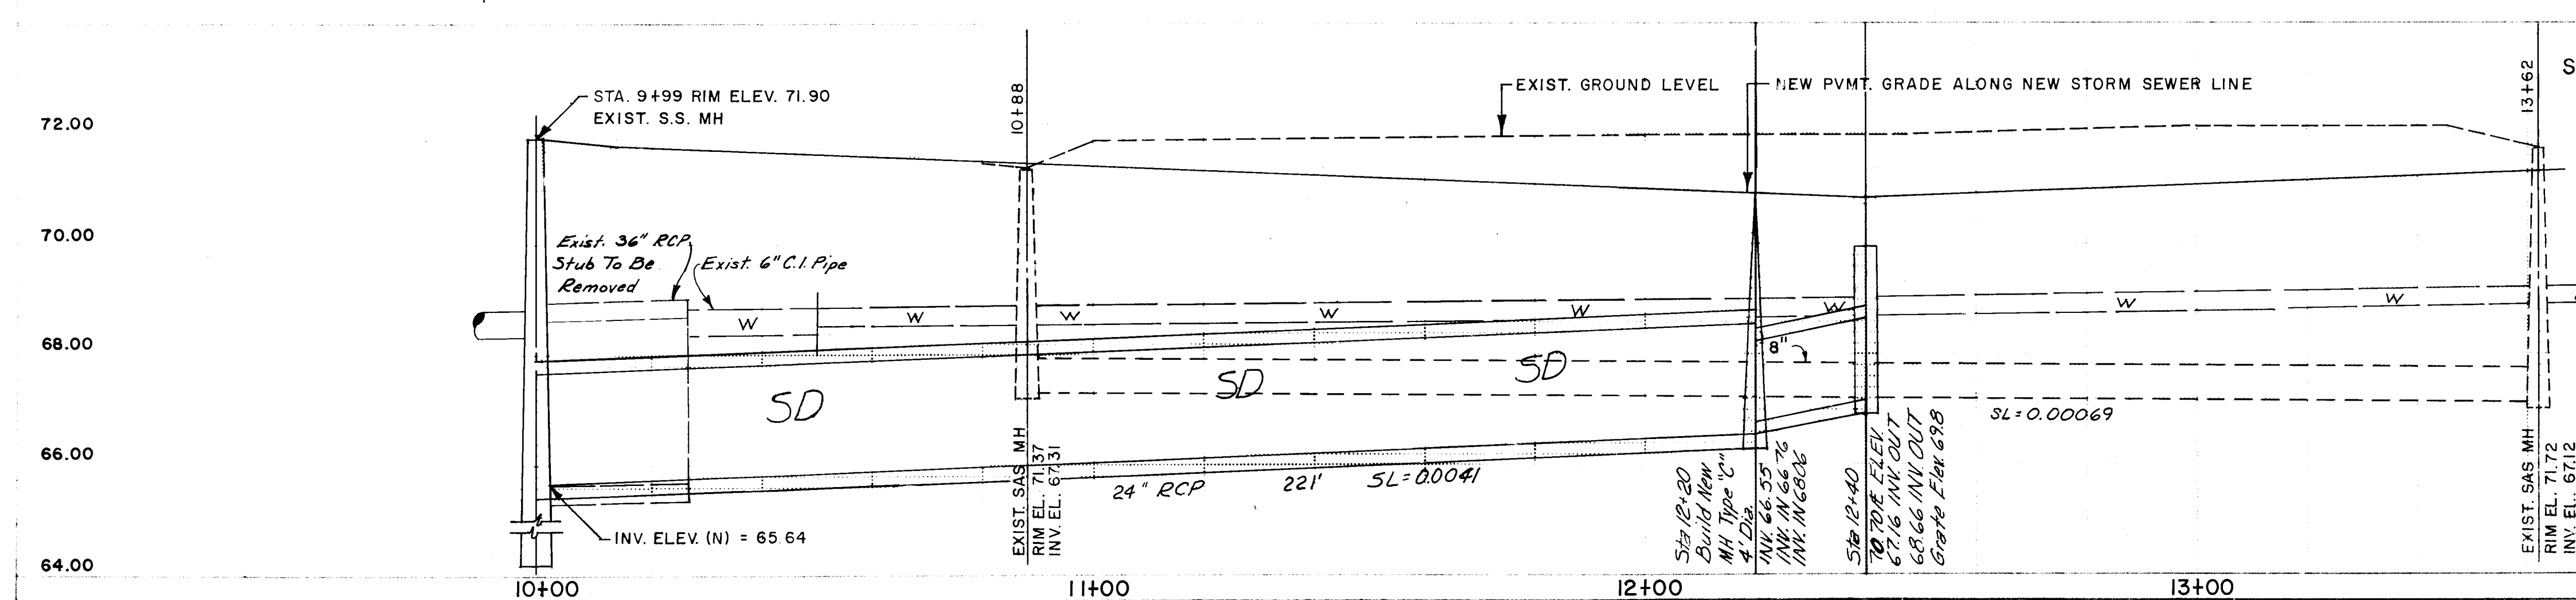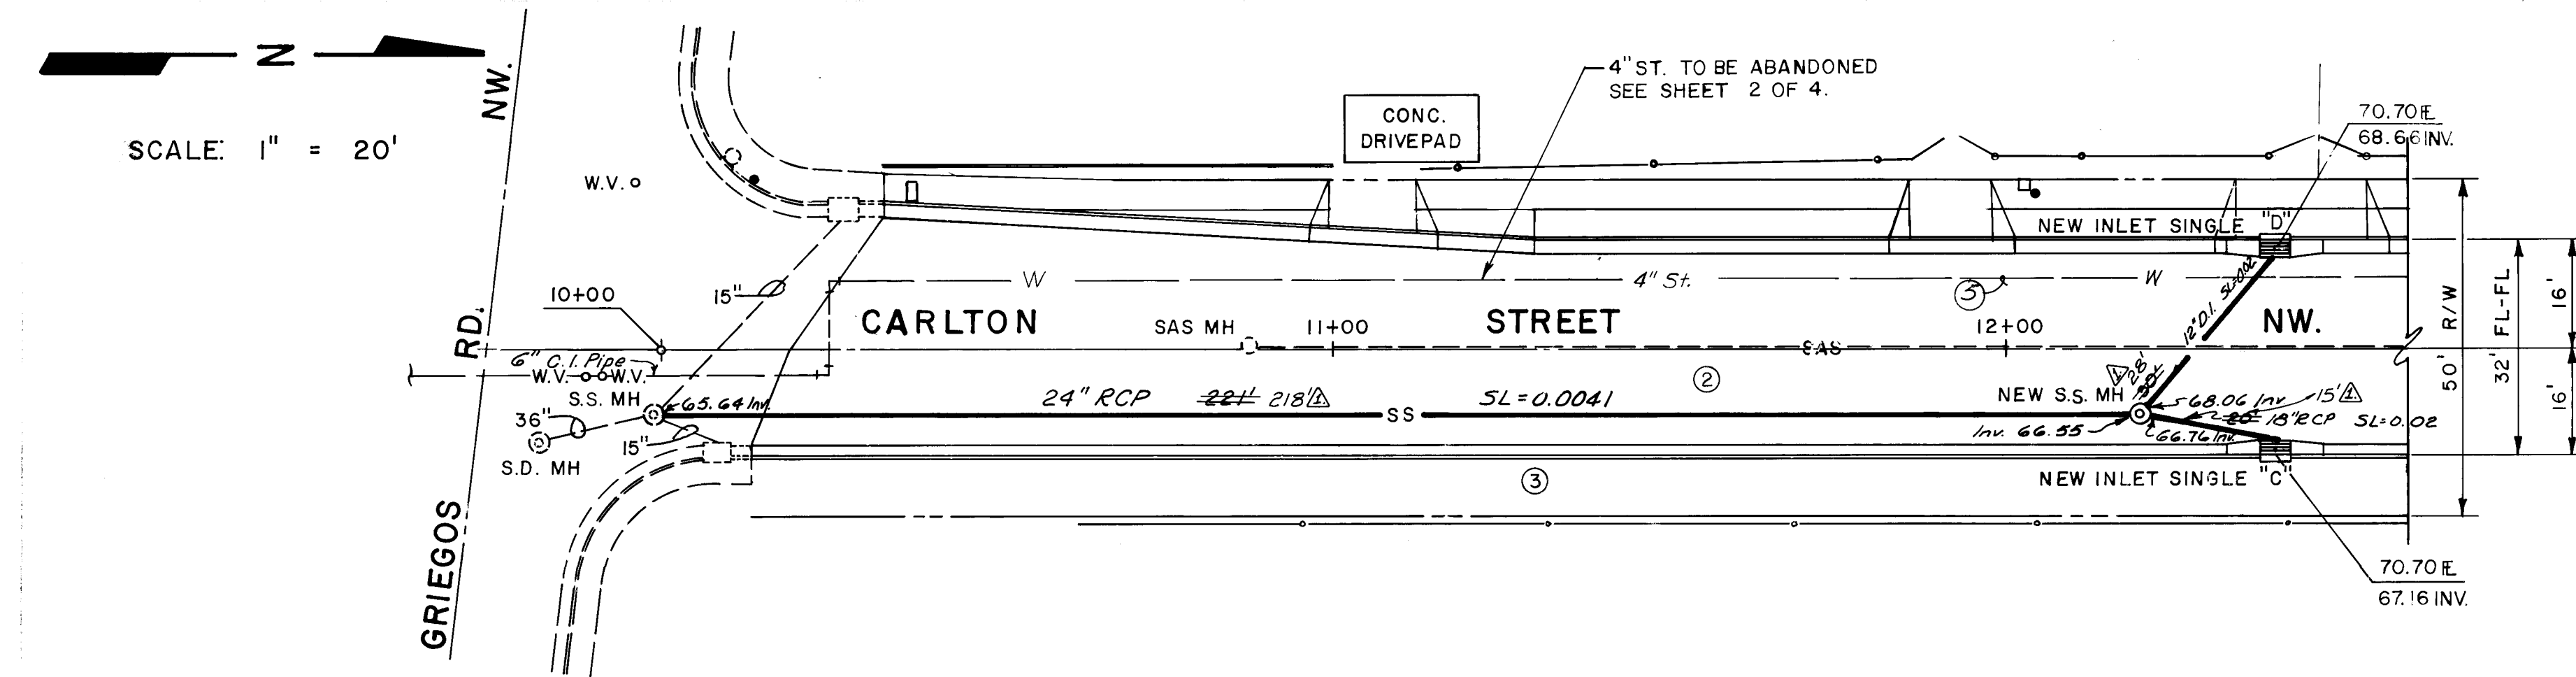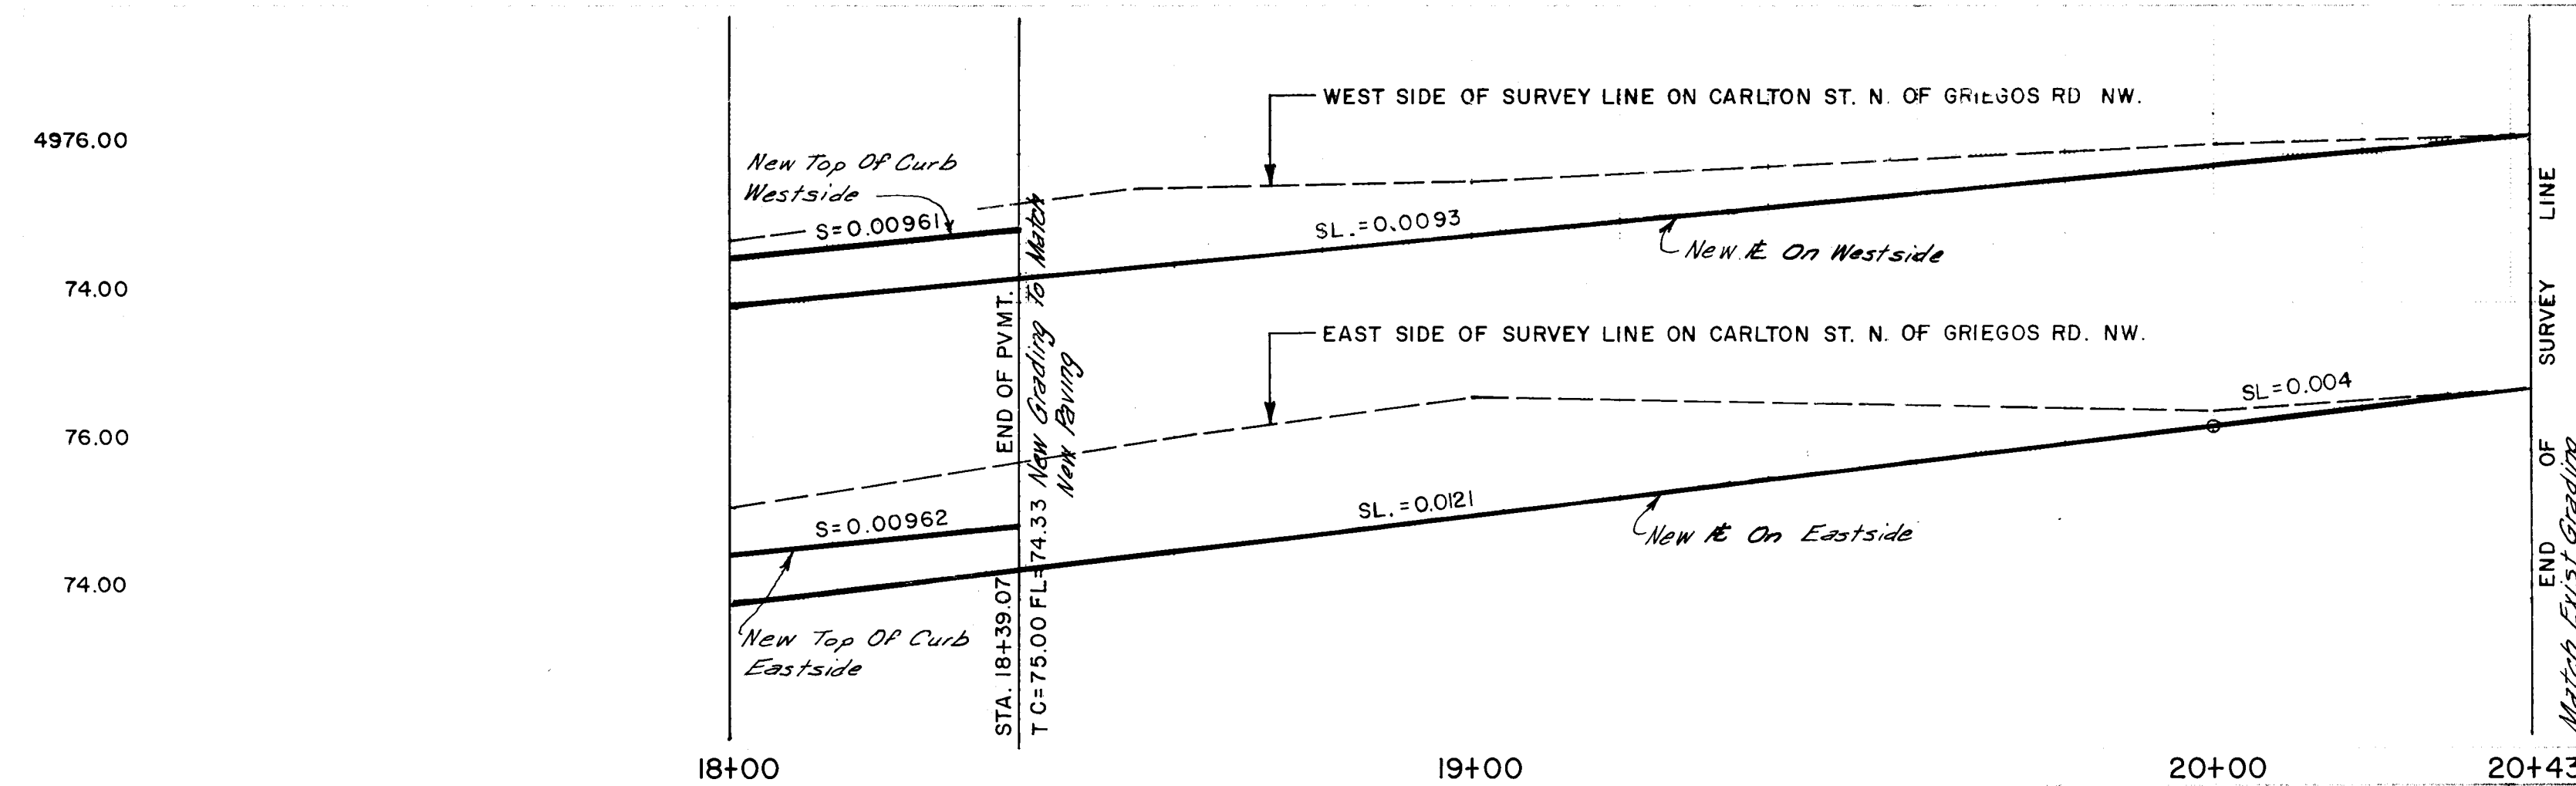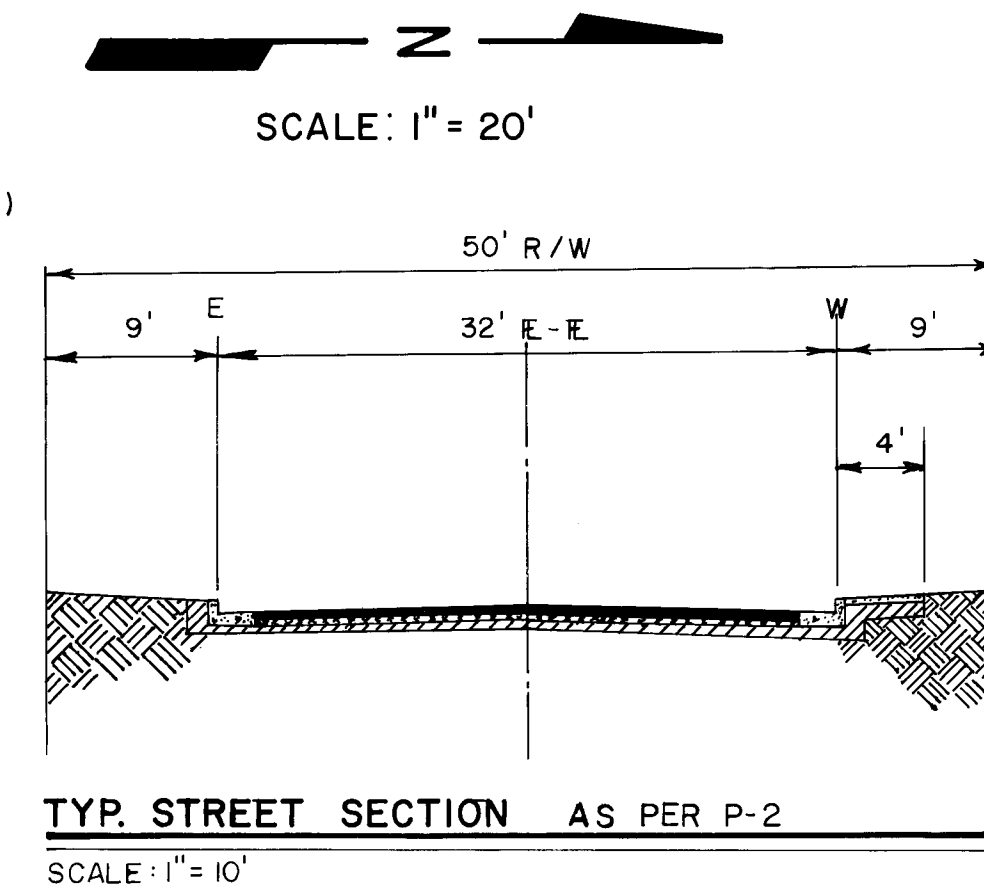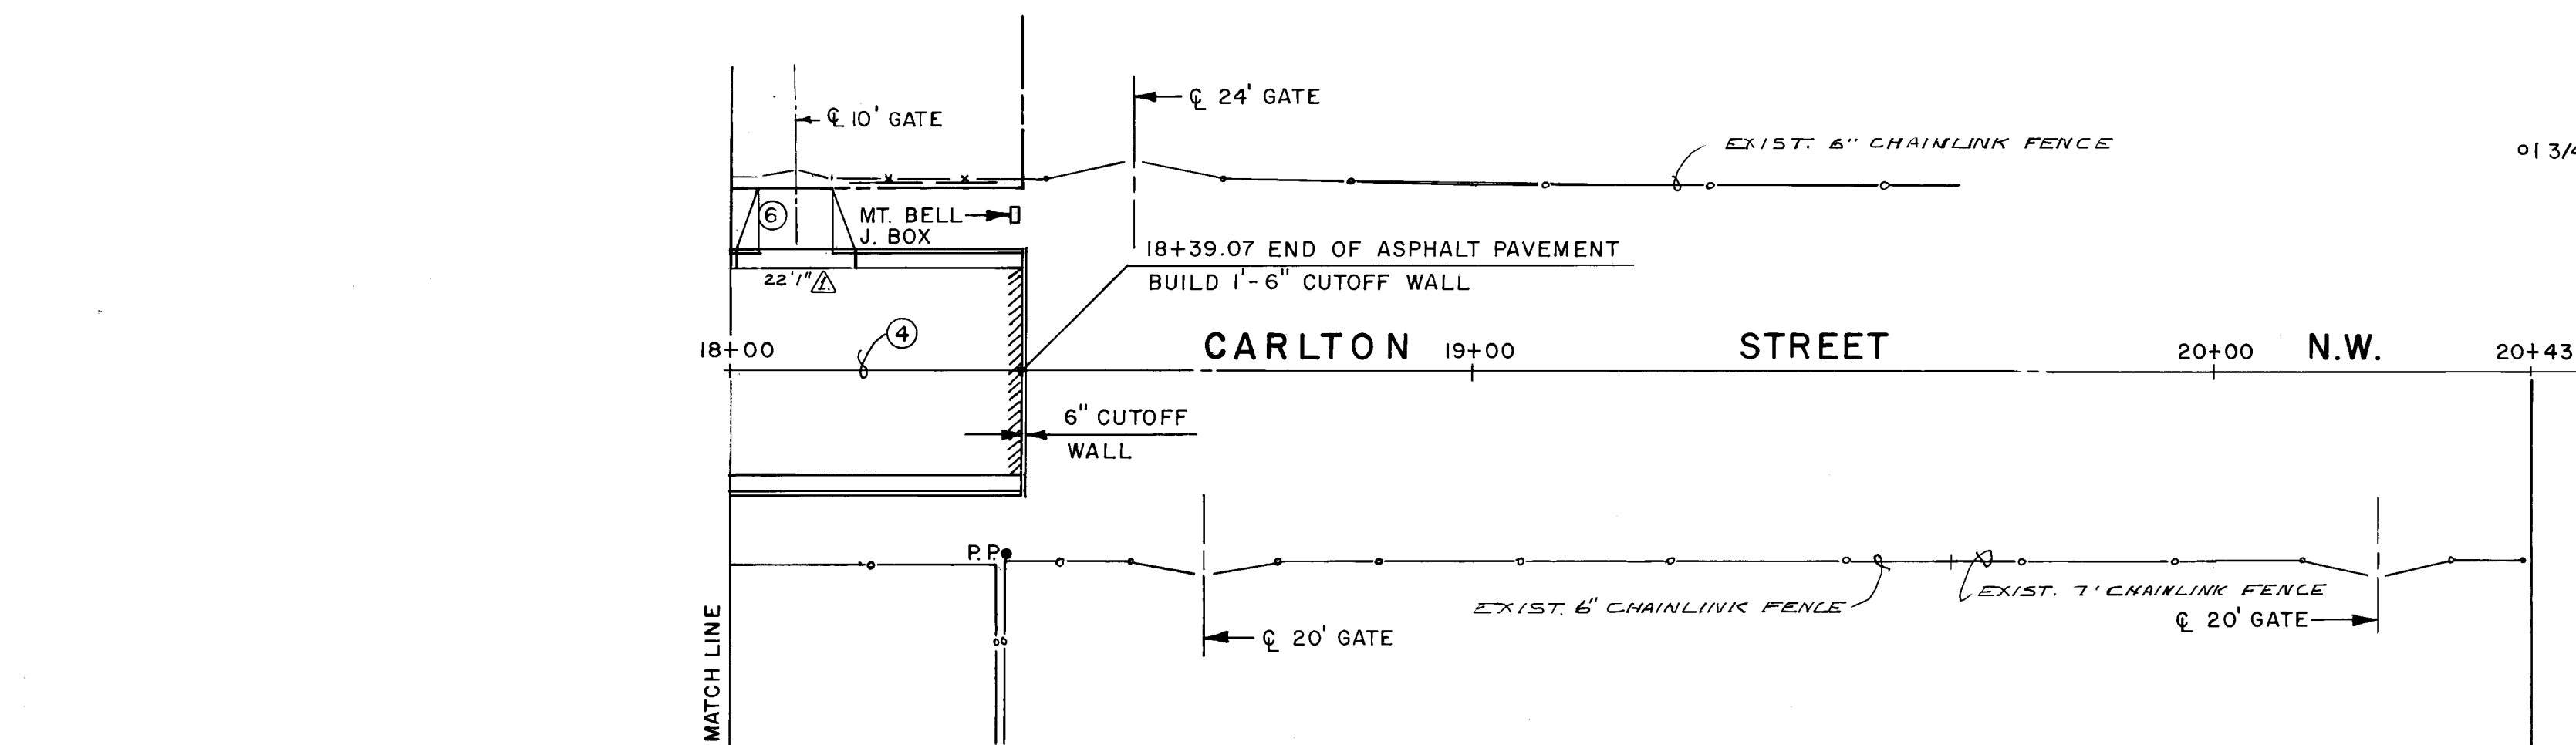

SCALE: HORIZ. 1" = 20'
VERT. 1" = 02'

SCALE: HORIZ. 1" = 20'
VERT. 1" = 02'

AS BUILT INFORMATION			BENCH MARKS		
DATE	BY	NO.	DATE	BY	NO.
11/27/85	H. Mercer	DS-42	11/27/85	H. Mercer	DS-42
REVISIONS			REVISIONS		
NO.	DATE	BY	NO.	DATE	BY
1	11/27/85	H. Mercer	1	11/27/85	H. Mercer
DESIGN			DESIGN		
DESIGNED BY	LOVATO, J. S.	DATE	NOV. 1985	DESIGNED BY	LOVATO, J. S.
DRAWN BY	ISAAC E. LARGA	DATE	NOV. 1985	DRAWN BY	ISAAC E. LARGA
CHECKED BY	Sergio Miranda	DATE	NOV. 1985	CHECKED BY	Sergio Miranda
CITY OF ALBUQUERQUE MUNICIPAL DEVELOPMENT DEPARTMENT ENGINEERING DIVISION					
TITLE: PAVING ON CARLTON ST. NORTH OF GRIEGOS RD. N.W.					
APPROVALS	ENGINEER	DATE	APPROVALS	ENGINEER	DATE
City Engineer	H. Mercer	11/27/85	Liquid Waste	H. Mercer	11/27/85
ACE - Design	H. Mercer	11/27/85	Traffic	H. Mercer	11/27/85
ACE - Hyatology	H. Mercer	11/27/85	Water	H. Mercer	11/27/85
DRAWING NO.	2231	MAP NO.	F&G-15	SHEET	3 OF 4

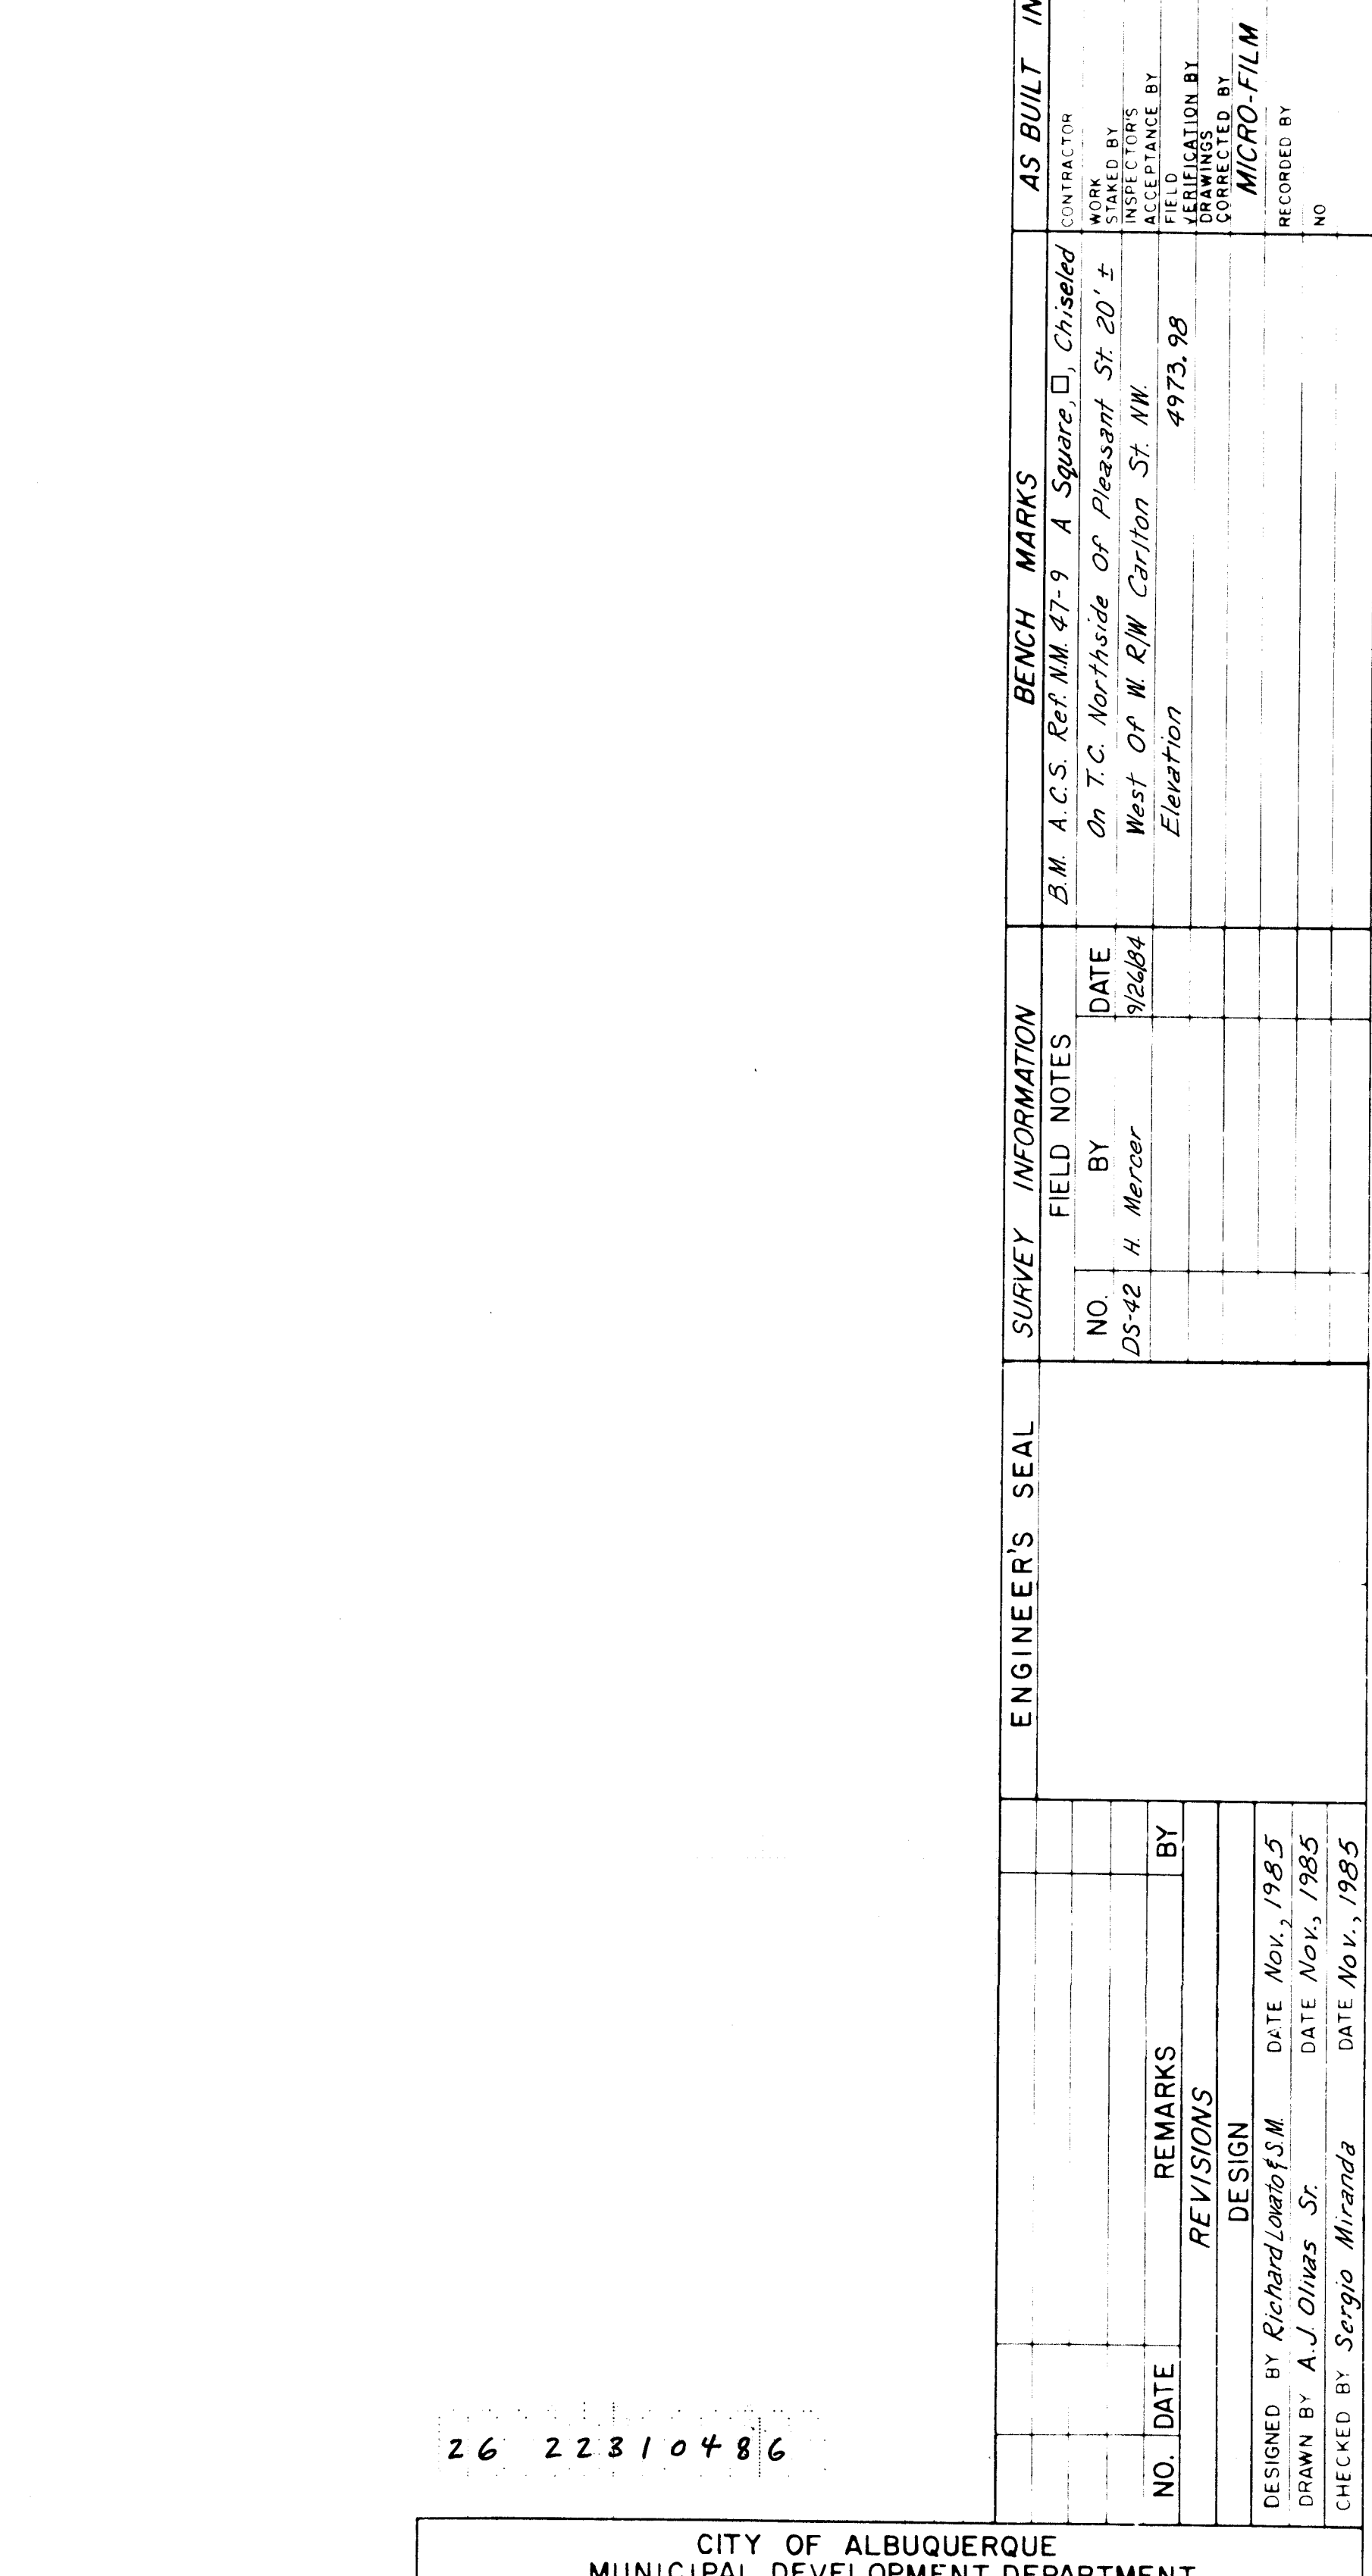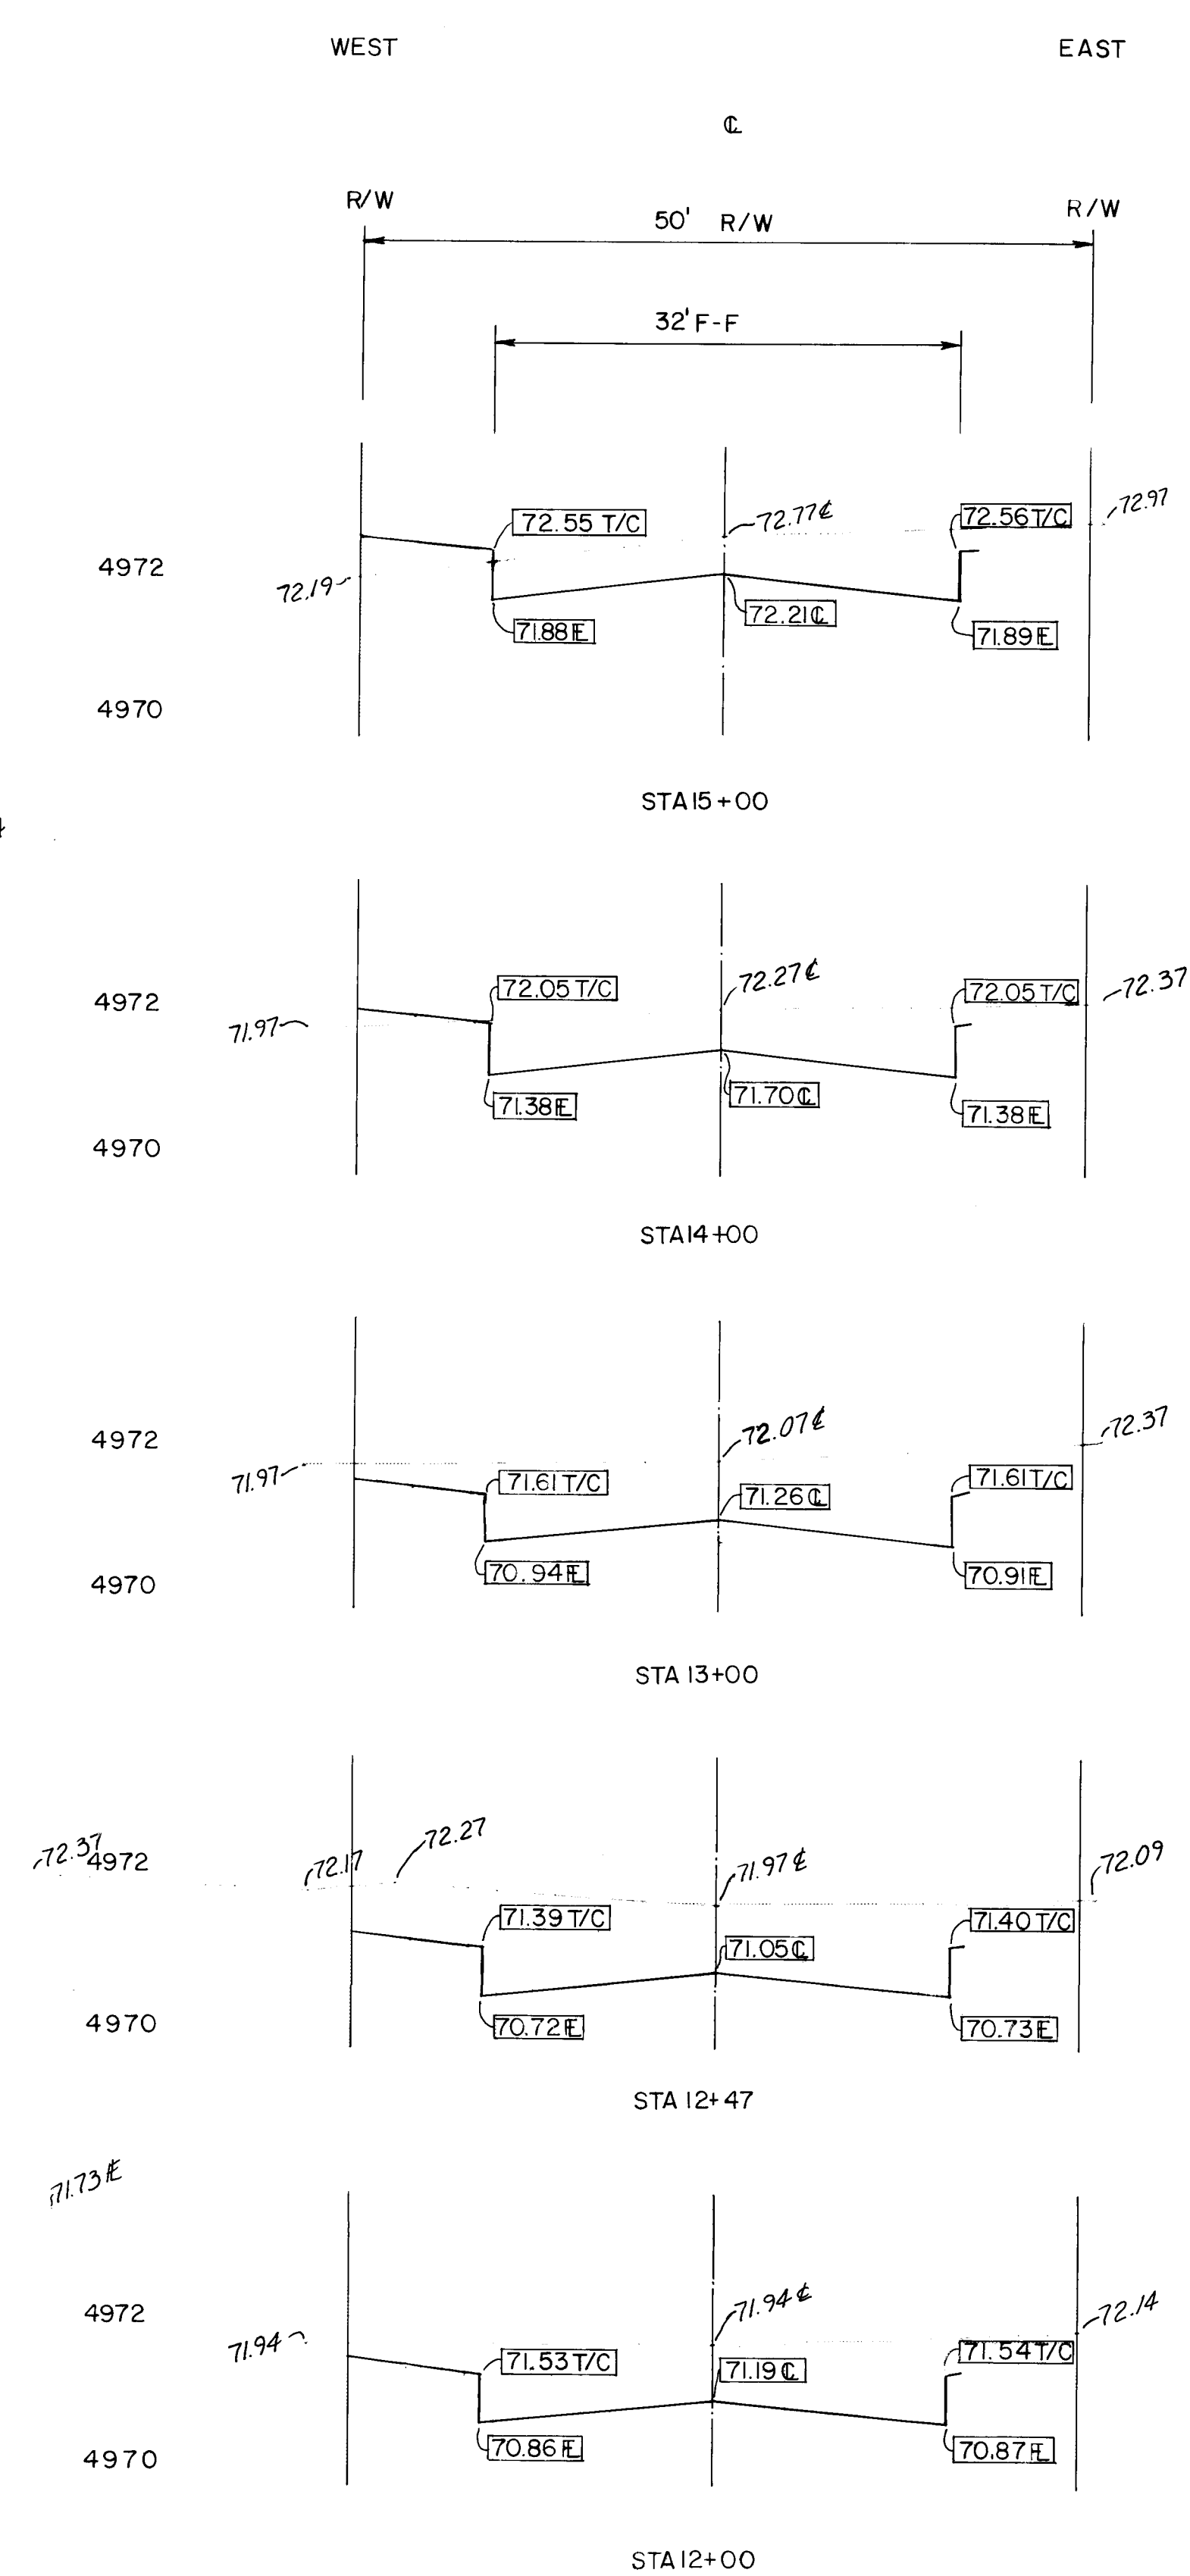

HORIZONTAL SCALE: 1"=10'
VERTICAL SCALE: 1"= 2'

CITY OF ALBUQUERQUE MUNICIPAL DEVELOPMENT DEPARTMENT ENGINEERING DIVISION					
TITLE: CARLTON ST. NORTH OF GRIEGOS RD. NW. (CROSS SECTION)					
APPROVALS	ENGINEER	DATE	APPROVALS	ENGINEER	DATE
City Engineer	<i>H.P. Chan</i>	11/26/85	Liquid Waste	NA <i>M. J. B.</i>	11/27/85
A C E - Design	<i>H.P. Chan</i>	11/16/85	Traffic	<i>B. A. Pardo</i>	11/27/85
A C E - Laboratory	<i>[Signature]</i>		Water	NA <i>M. J. B.</i>	11/27/85

DRAWING NO.

2231

F-G-15

SHEET

4

OF

4