

HERITAGE EAST


UNIT TWO

"MASTERPLAN IMPROVEMETS"

ALBUQUERQUE, NEW MEXICO

INDEX TO SHEETS


SHEET NO.	DESCRIPTION
1	COVER SHEET AND INDEX TO DRAWINGS
2-3	PLAT OF GEOMETRY
4	
5-12 	COMPOSITE SANITARY SEWER AND WATER PLAN
13-14 4-6	SANITARY SEWER AND WATER PLAN AND PROFILES
	OFFSITE WATER LINE

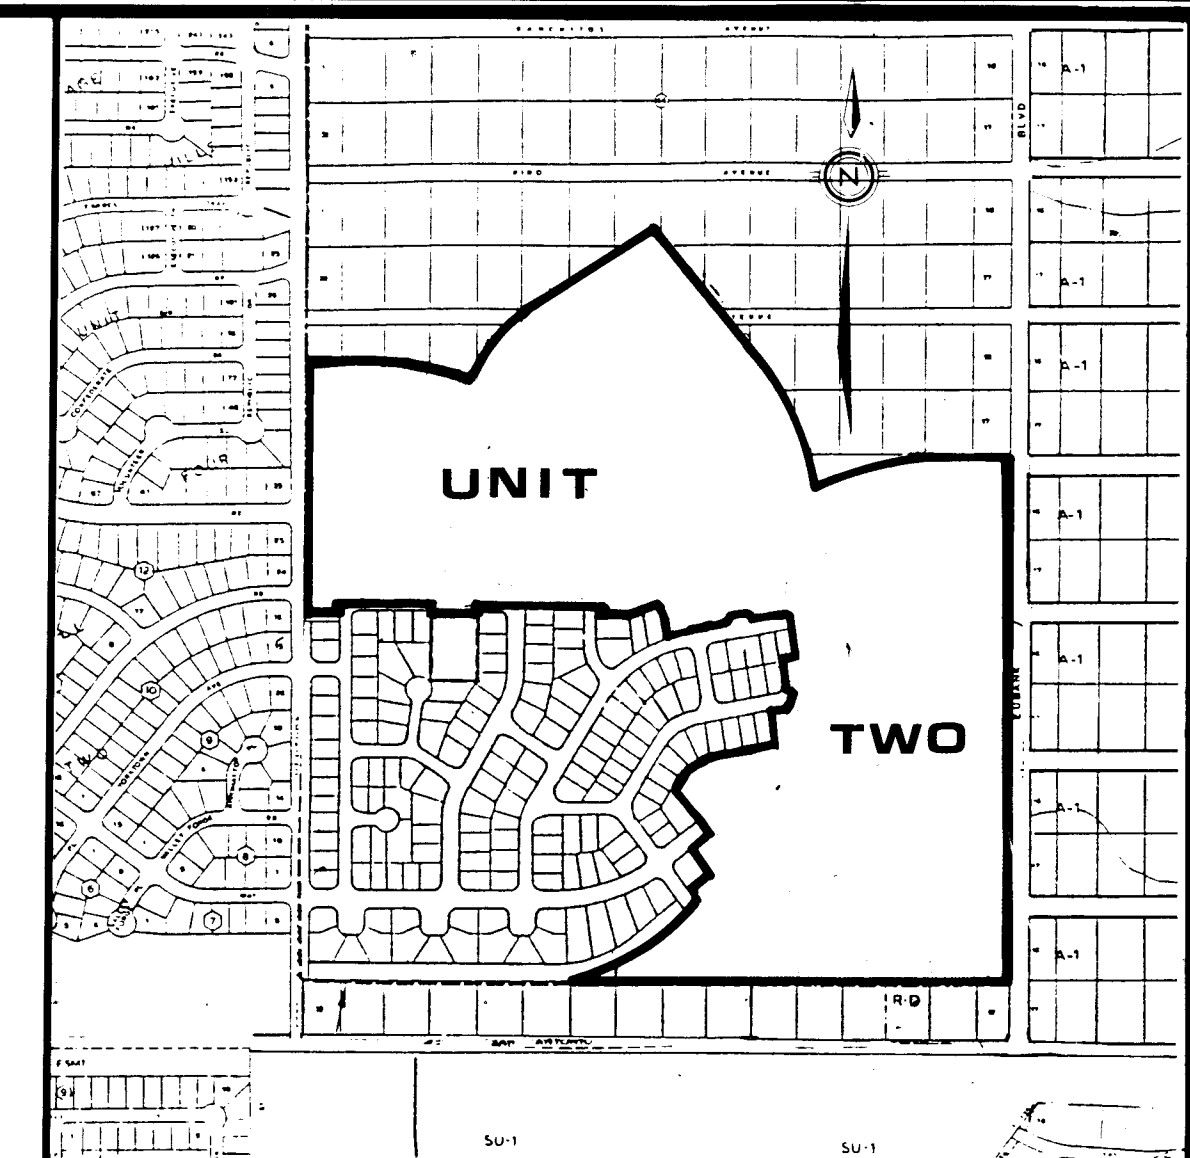

VICINITY MAP

GENERAL NOTES



- All work detailed on these plans to be performed under contract shall, except as otherwise stated or provided for hereon, be constructed in accordance with the New Mexico Standard Specifications for Public Works Construction - 1979 Edition (referred to herein as the Standard Specifications and the Contract Documents for Public Works Contract #84-3).
- Two (2) working days prior to any excavation, contractor must contact Line Locating Service, 765-1234, for location of existing utilities.
- Prior to construction, the contractor shall excavate and verify the horizontal and vertical locations of all obstructions. Should a conflict exist, the contractor shall notify the engineer or surveyor so that the conflict can be resolved with minimum amount of delay.
- All utilities and utility service lines shall be installed prior to paving.
- Backfill compaction shall be according to specified street use.
- Tack coat requirements shall be determined by the City Engineer.
- Sidewalks and wheelchair ramps within the curb returns shall be constructed wherever a new curb return is constructed.
- If curb is depressed for a driveway or a handicap ramp, the driveway or ramp shall be constructed prior to acceptance of the curb and gutter.
- All storm drainage facilities shall be completed prior to final acceptance.


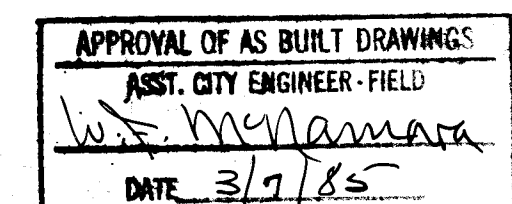




26 2237 01/85

6	C. S. C.	12/5/84	WRD-R. Pina	12/5/84	
546	C. S. C.	12/5/84	WRD-R. Pina	11/27/84	County Roads - JR 11/28/84
1,445	C. S. C.	12/5/84	WRD-R. Pina	4/27/84	
REV	SHEETS	CITY ENGINEER	DATE	USER DEPARTMENT	DATE




APPROVAL OF REVISIONS

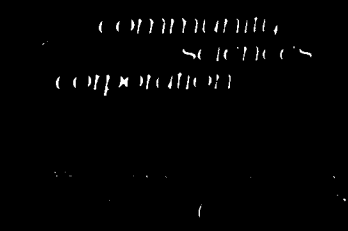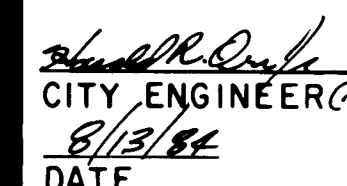	DATE	4-16-84		APPROVED FOR CONSTRUCTION	
	SCALE	NONE			
	DESIGNED	K. M. W.			
	DRAWN	C. S. C.			
JOB NO		75-03-PR	PROJECT NO.		2237
SHEET		1	SHEET		OF 6

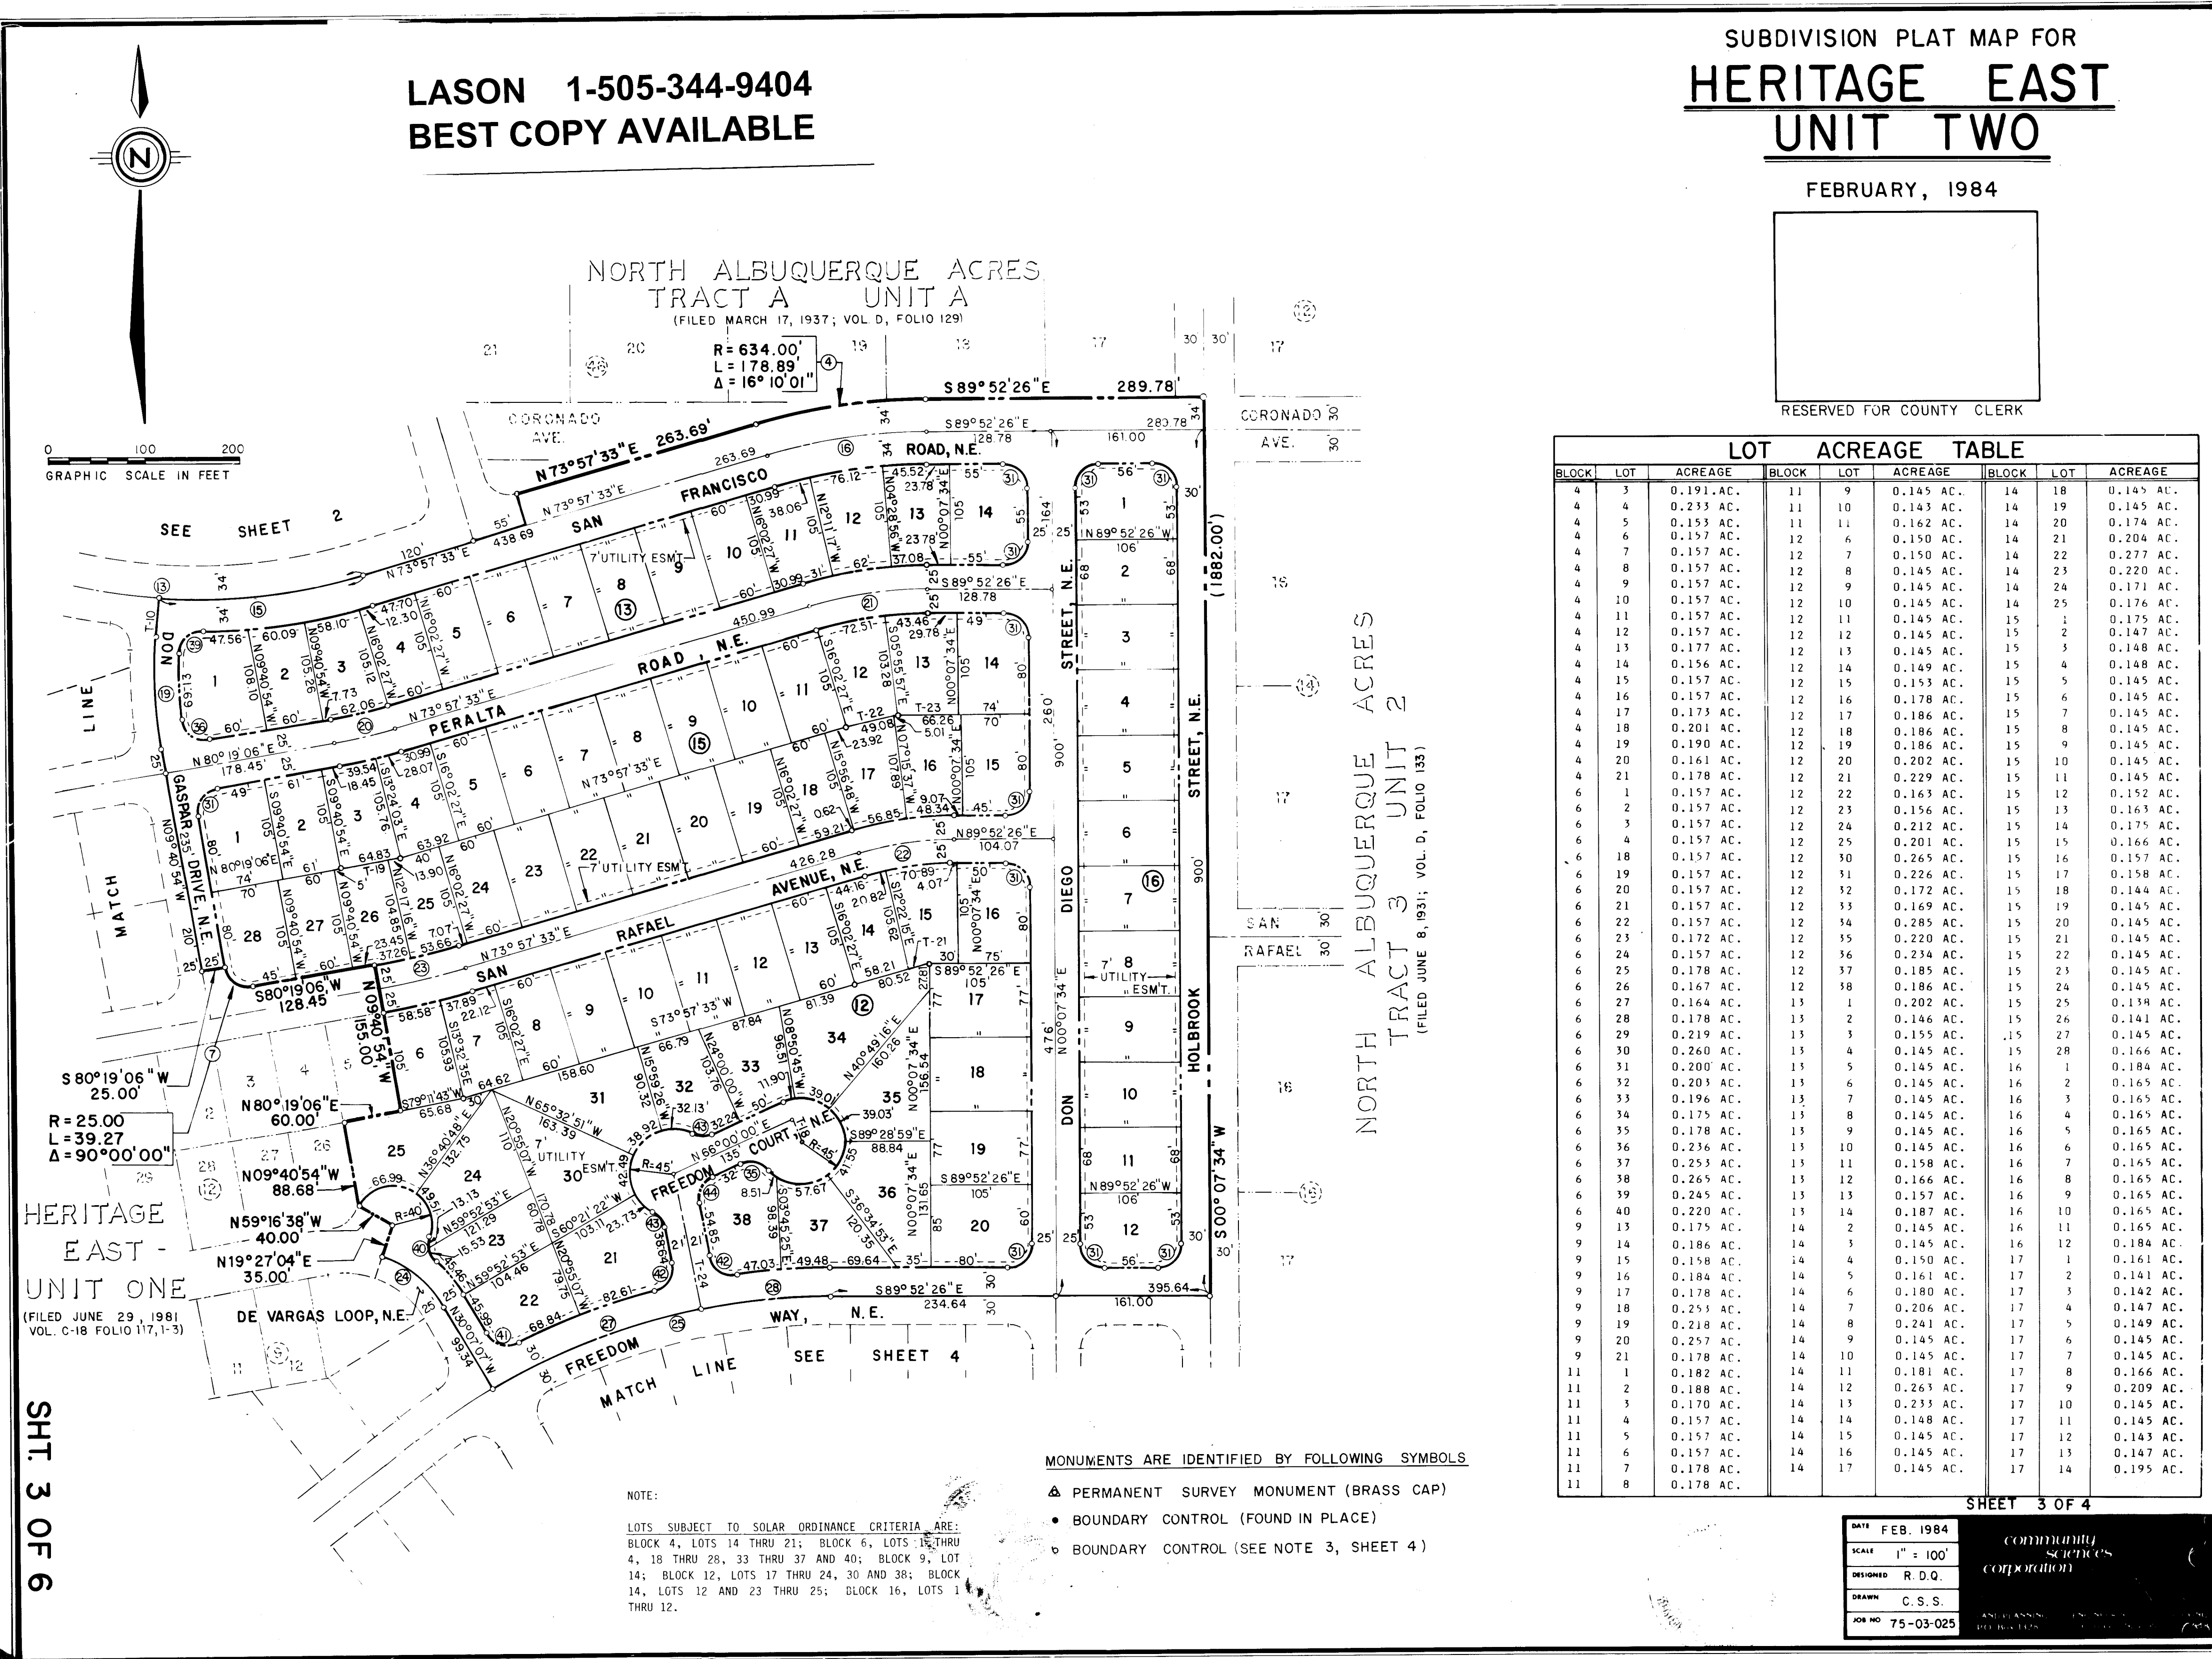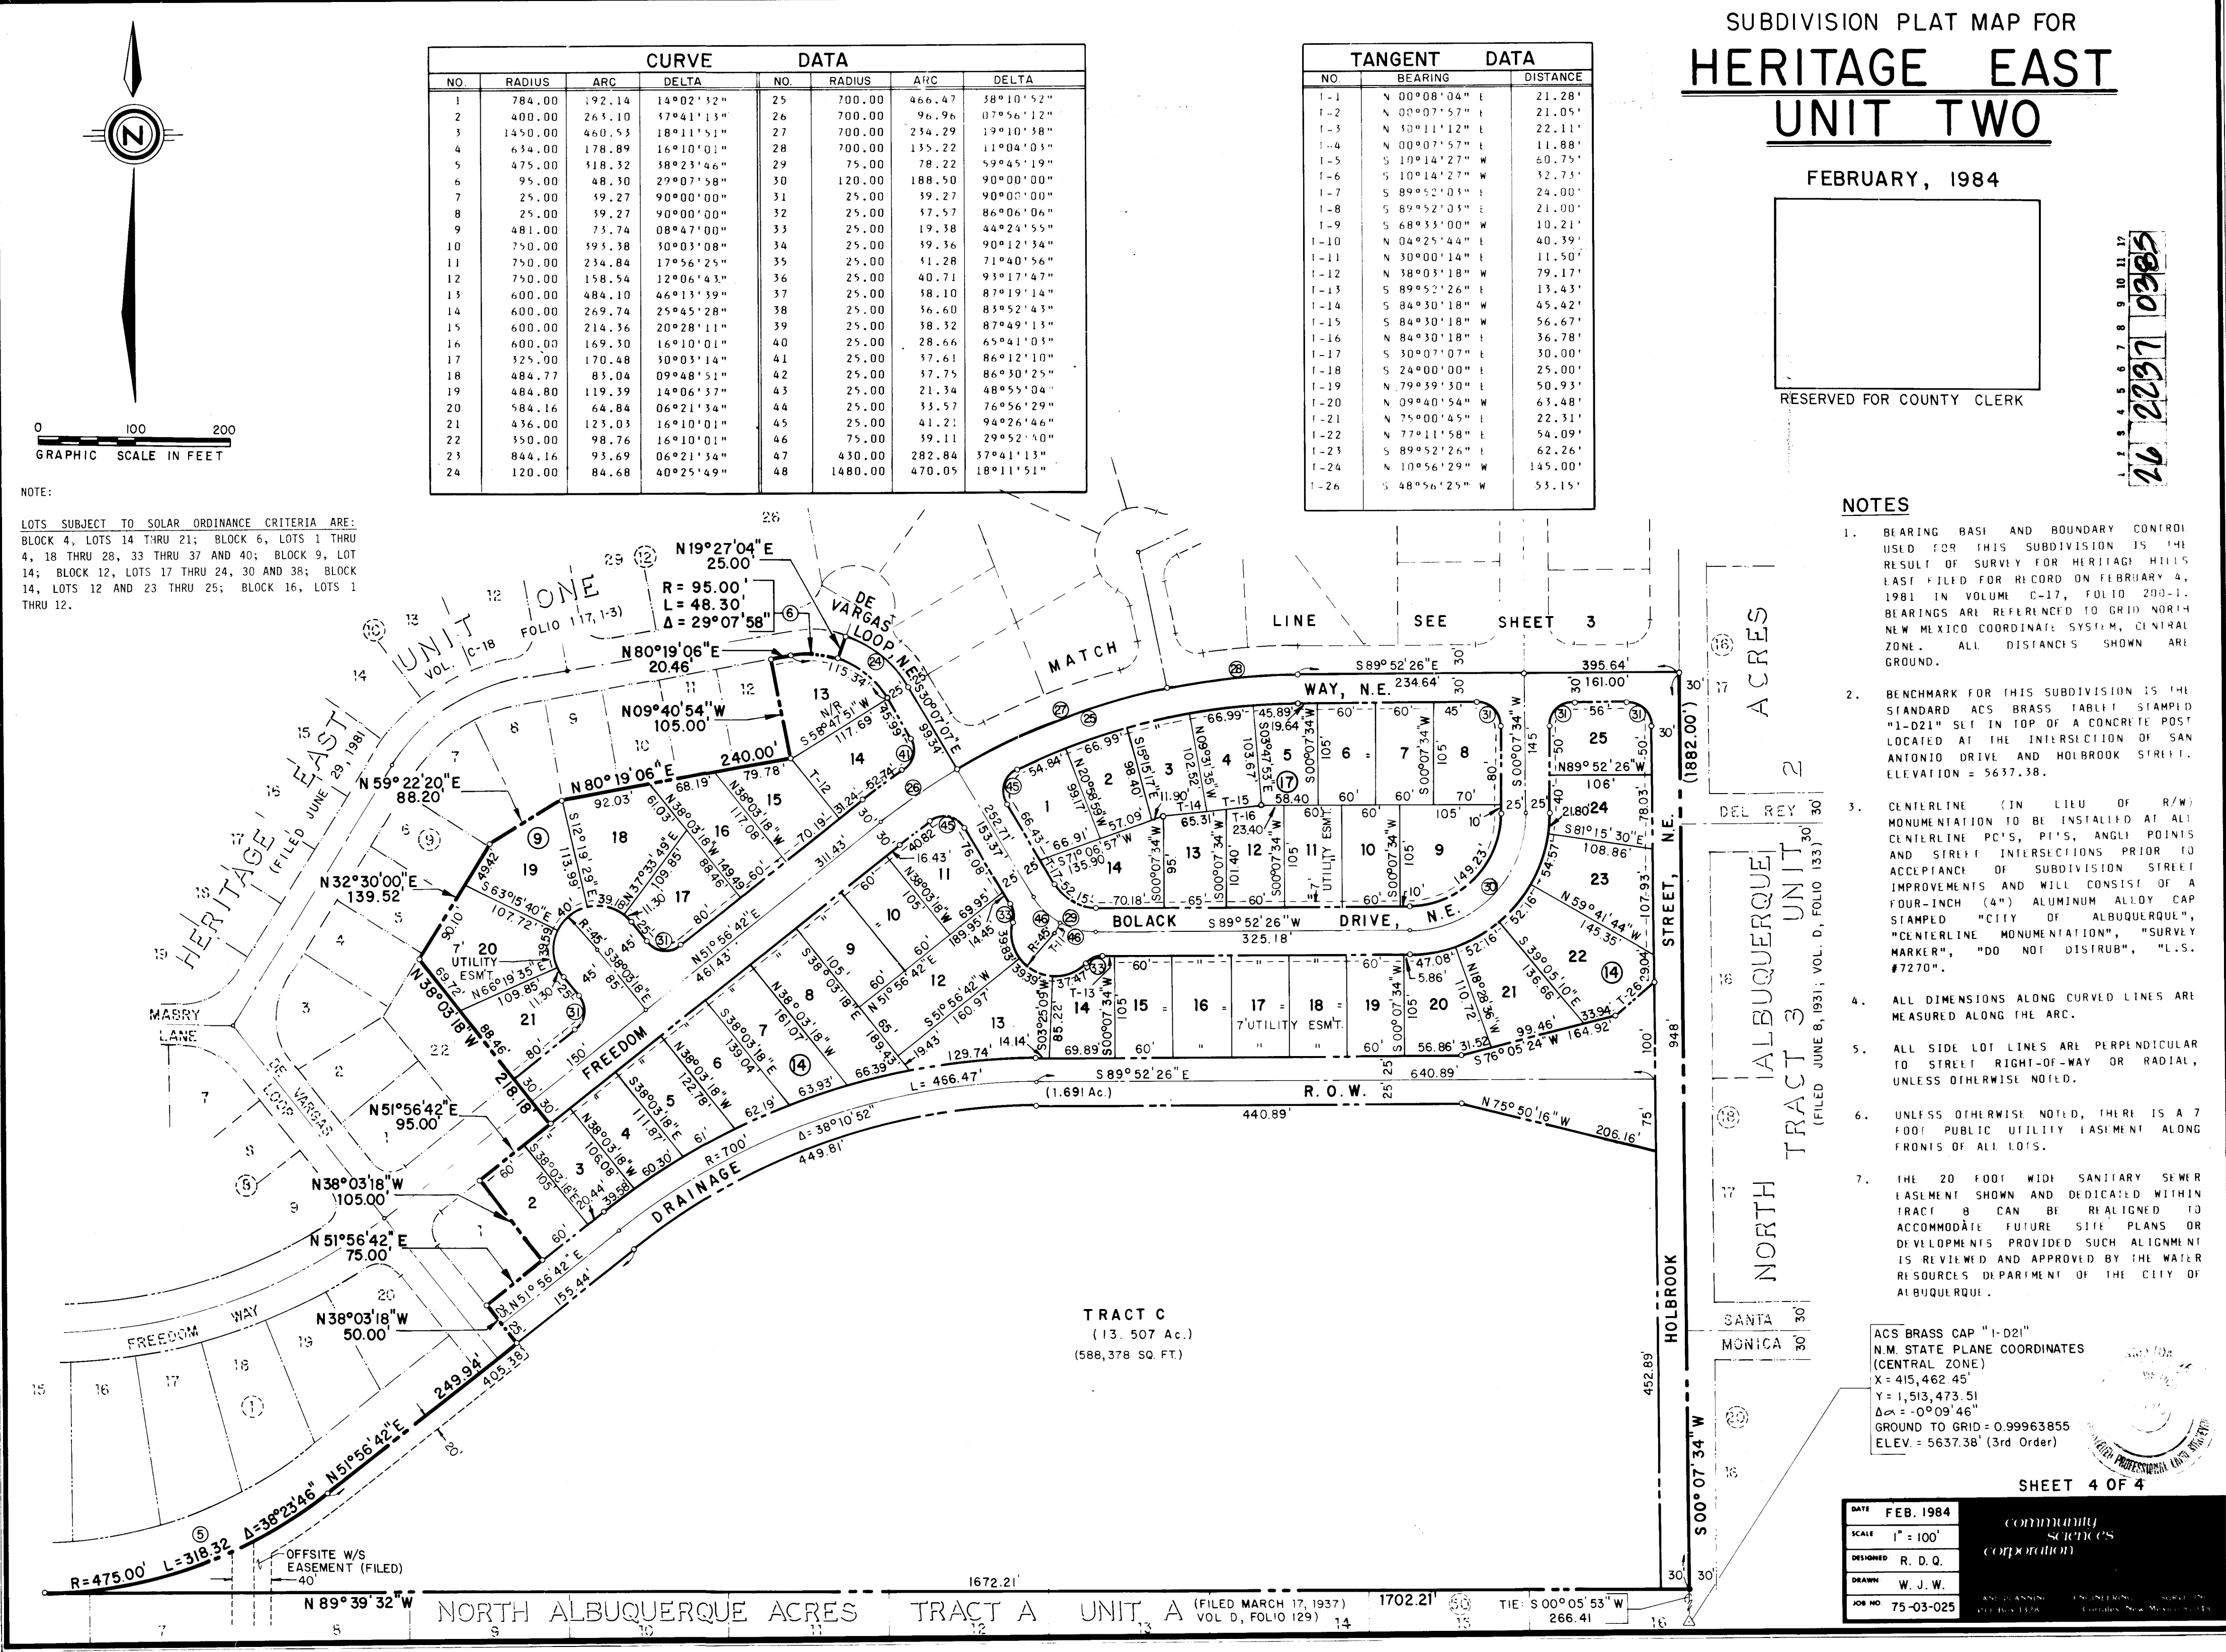

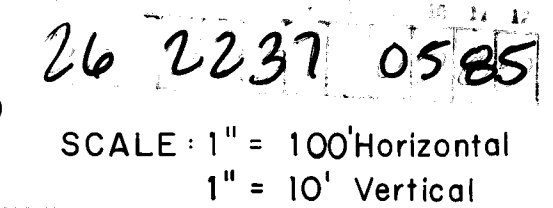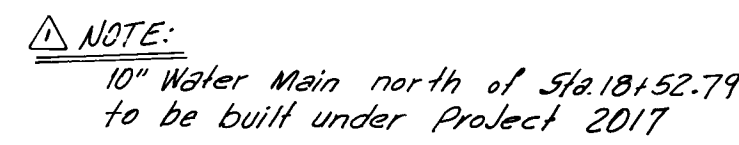

CITY OF ALBUQUERQUE					
MUNICIPAL DEVELOPMENT DEPARTMENT					
ENGINEERING DIVISION					
TITLE: HERITAGE EAST - UNIT TWO - UTILITY PLAN & PROFILE					
OFFSITE WATER LINE					
APPROVALS	ENGINEER	DATE	APPROVALS	ENGINEER	DATE
City Engineer: <i>(Signature)</i>	<i>(Signature)</i>	<i>8/13/84</i>			
A.C.E. Design	<i>(Signature)</i>	<i>8/13/84</i>	Traffic		
A.C.E. Hydrology	<i>(Signature)</i>	<i>8/11/84</i>	Water Resources	<i>NADWH</i> <i>R. Pava</i>	<i>8/1/84</i> <i>8/1/84</i>
DRAWING NO	2237		MAP NO	D-20	
			SHEET	5	OF 6

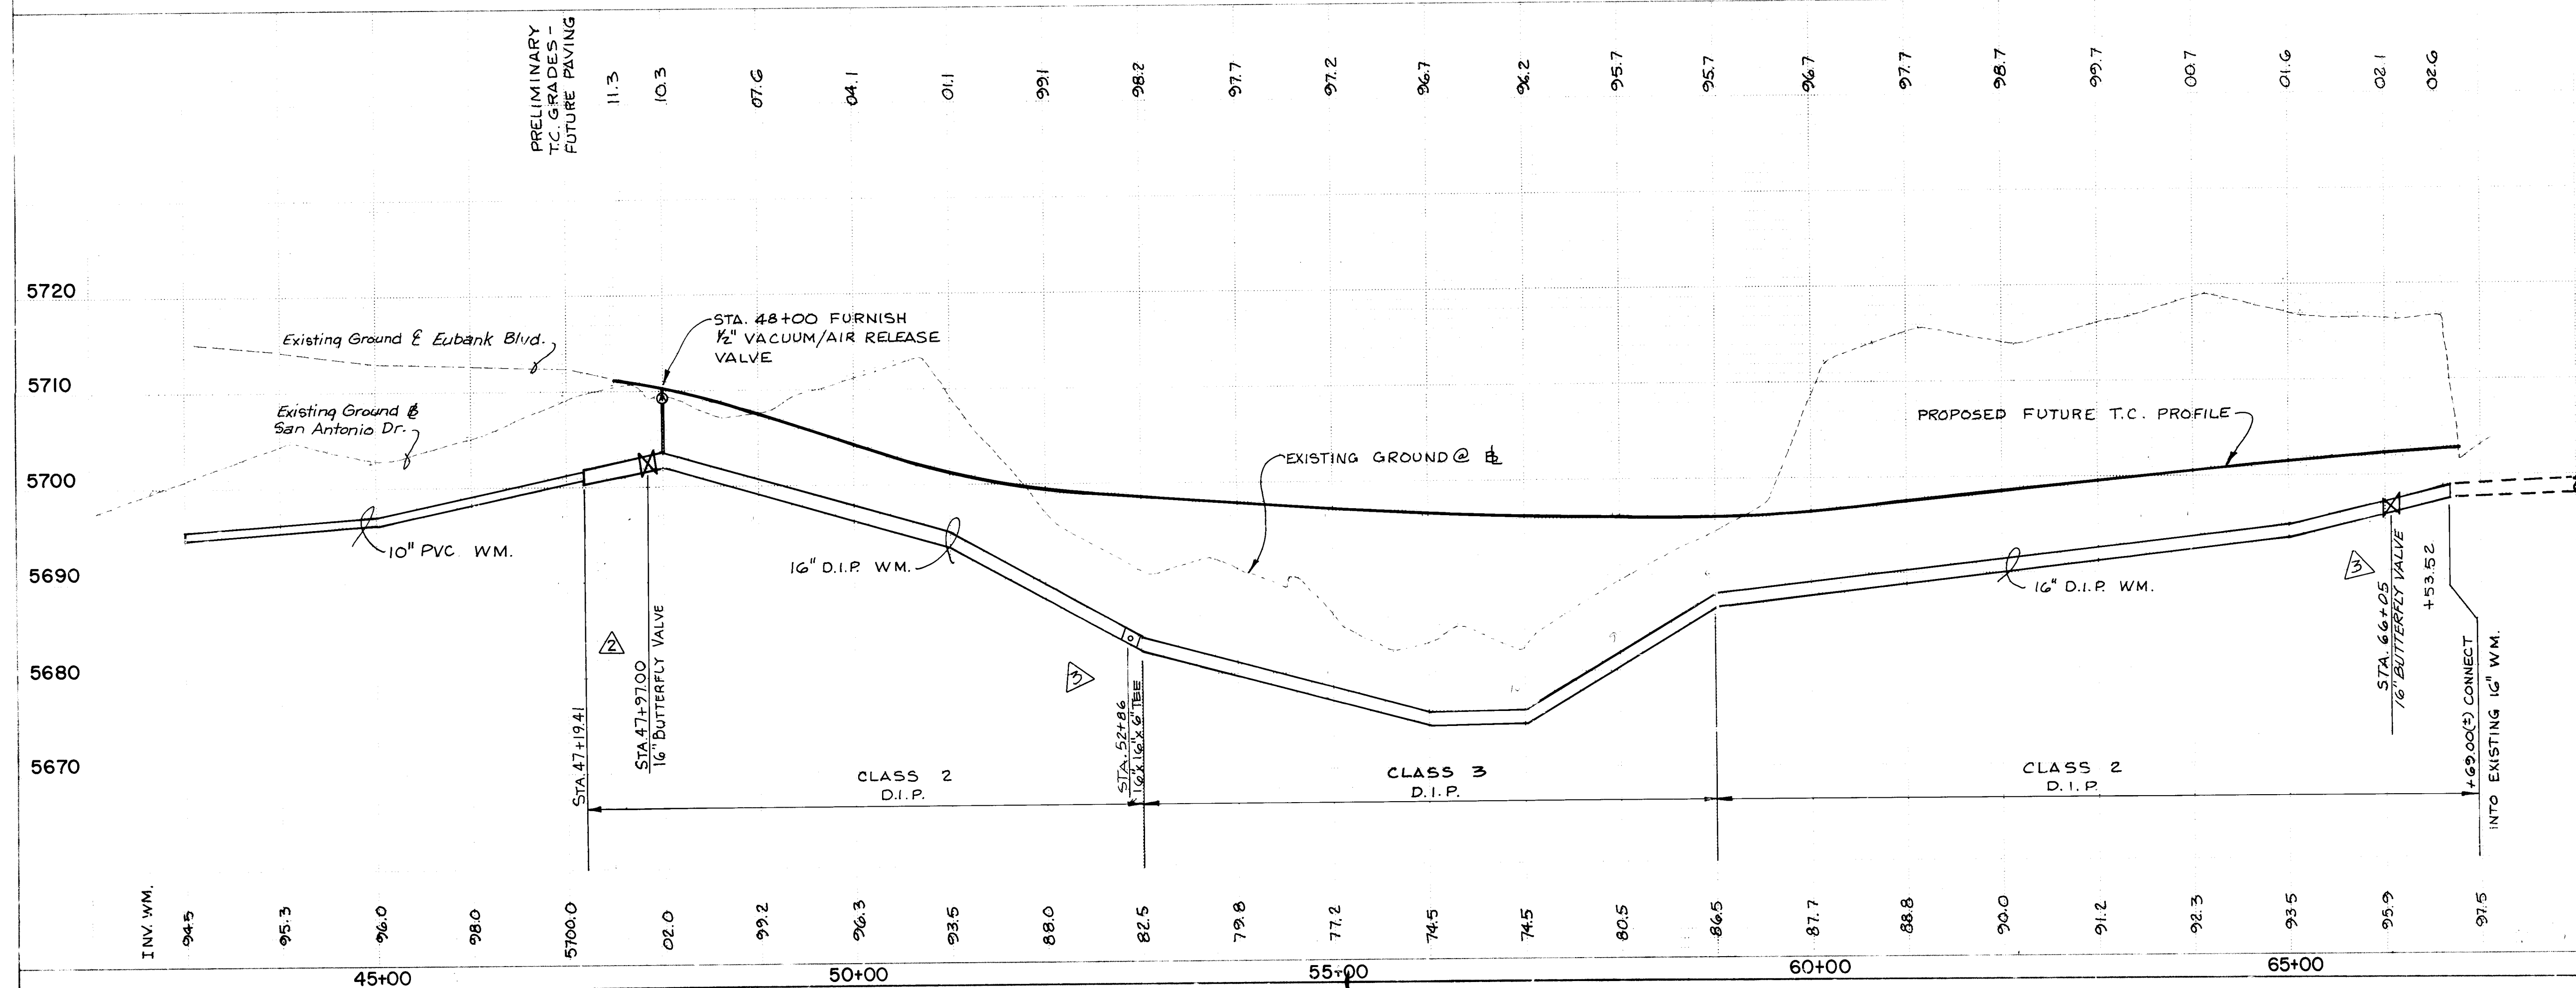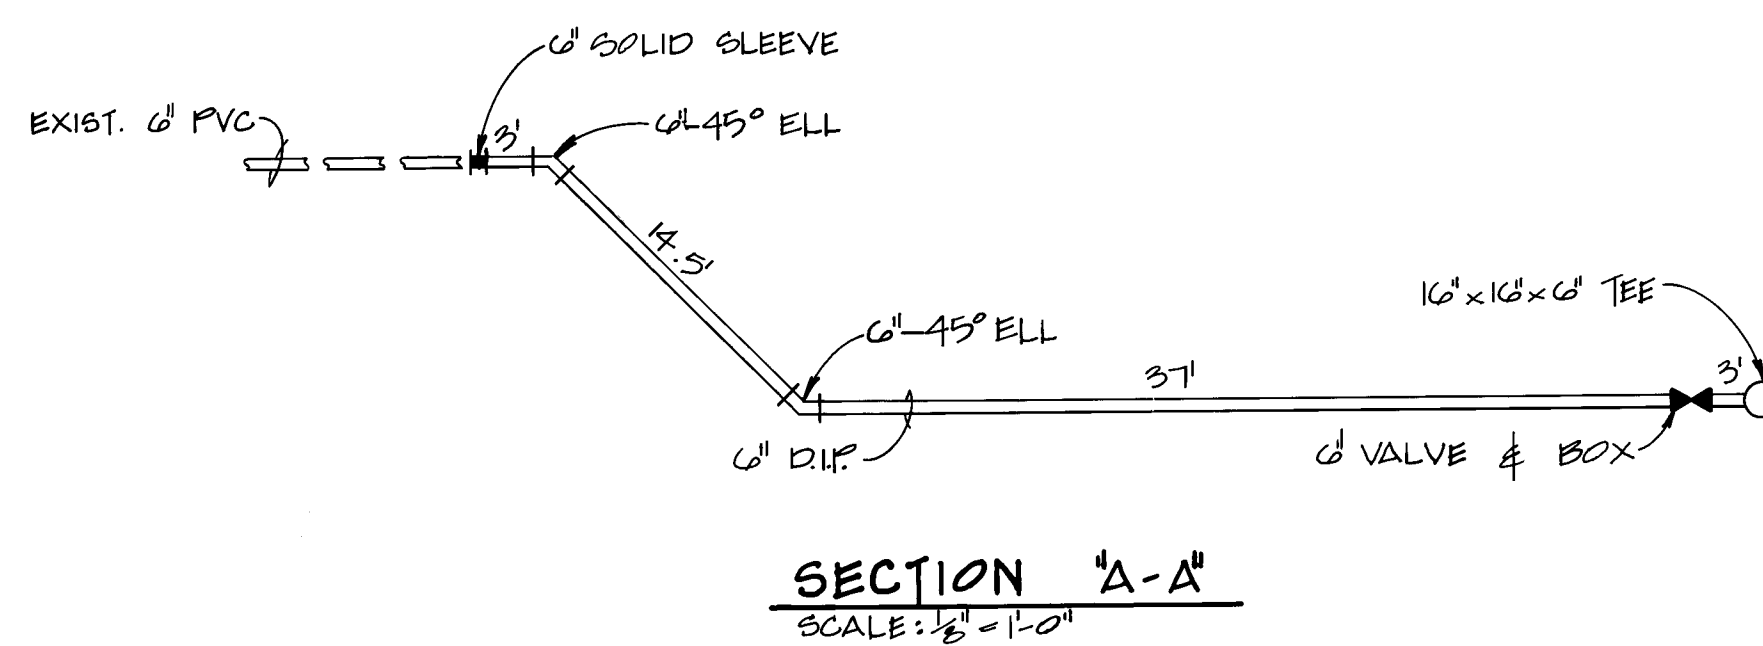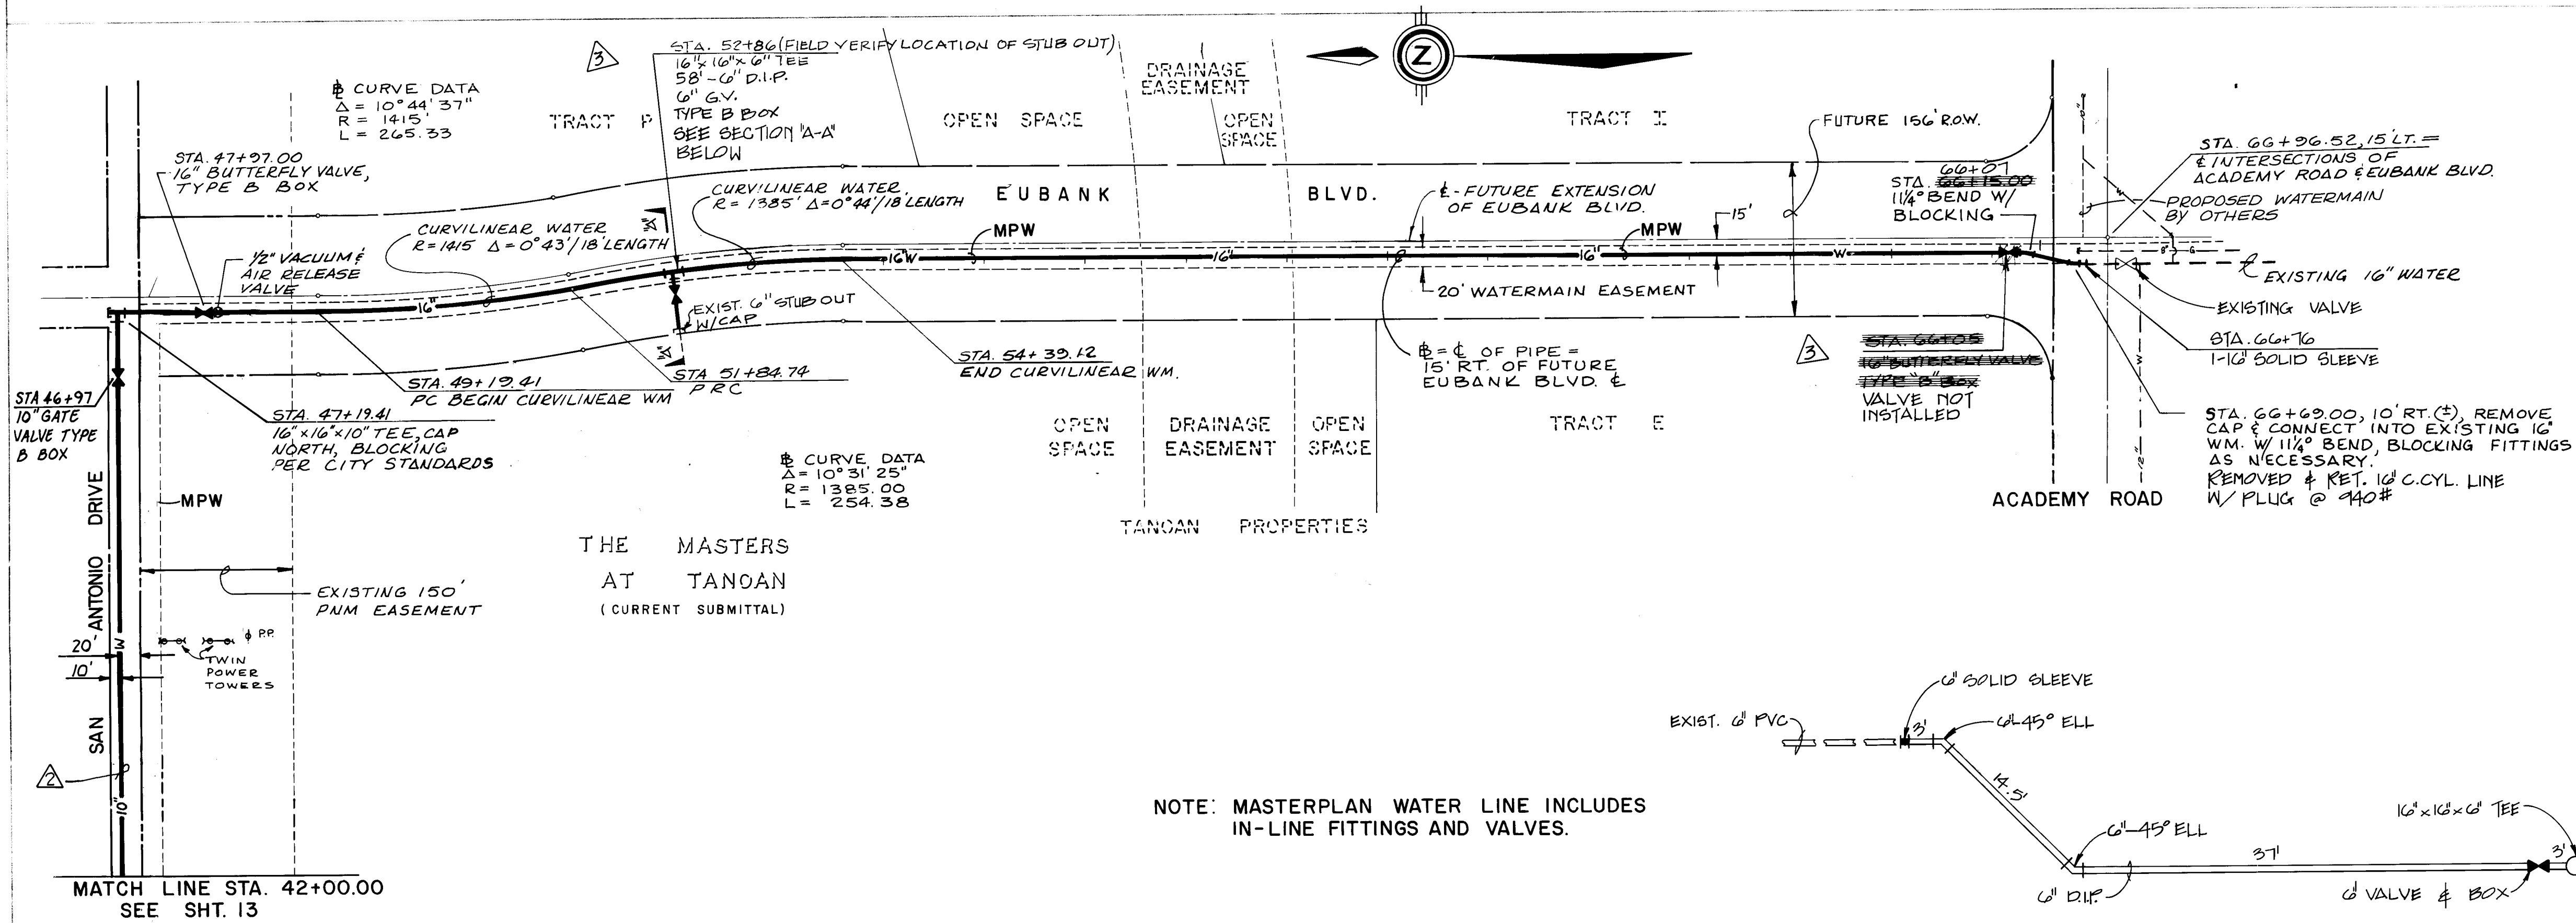

5720		5710		5700		5690		5680	
SCALE: 1" = 100' Horizontal 1" = 10' Vertical									
CITY OF ALBUQUERQUE MUNICIPAL DEVELOPMENT DEPARTMENT ENGINEERING DIVISION									
TITLE: HERITAGE EAST-UNIT TWO-UTILITY PLAN & PROFILE									
OFFSITE WATER LINE									
APPROVALS	ENGINEER	DATE	APPROVALS	ENGINEER	DATE				
City Engineer	NA. B. B.	8/1/84	City Engineer	NA. B. B.	8/1/84				
A.C.E. - Design	NA. B. B.	8/1/84	A.C.E. - Hydrology	NA. B. B.	8/1/84				
DRAWING NO. 2237						MAP NO. D-20		SHEET 6 OF 6	

REVISIONS		REVISIONS		REVISIONS		REVISIONS		REVISIONS	
NO.	DATE	NO.	DATE	NO.	DATE	NO.	DATE	NO.	DATE
1	12/14/84	2	11/19/84	3	11/19/84	4	11/19/84	5	11/19/84
16" INVERT VALVE & FITTINGS		16" INVERT VALVE & FITTINGS		16" INVERT VALVE & FITTINGS		16" INVERT VALVE & FITTINGS		16" INVERT VALVE & FITTINGS	
11/19/84 Move Water Line 28' North		11/19/84 Move Water Line 28' North		11/19/84 Move Water Line 28' North		11/19/84 Move Water Line 28' North		11/19/84 Move Water Line 28' North	
REMARKS		REMARKS		REMARKS		REMARKS		REMARKS	
DESIGN		DESIGN		DESIGN		DESIGN		DESIGN	
BY		BY		BY		BY		BY	
NA. B. B.		NA. B. B.		NA. B. B.		NA. B. B.		NA. B. B.	

ENGINEER'S SEAL		ENGINEER'S SEAL		ENGINEER'S SEAL		ENGINEER'S SEAL		ENGINEER'S SEAL	
NA. B. B.		NA. B. B.		NA. B. B.		NA. B. B.		NA. B. B.	
NA. B. B.		NA. B. B.		NA. B. B.		NA. B. B.		NA. B. B.	
NA. B. B.		NA. B. B.		NA. B. B.		NA. B. B.		NA. B. B.	
NA. B. B.		NA. B. B.		NA. B. B.		NA. B. B.		NA. B. B.	