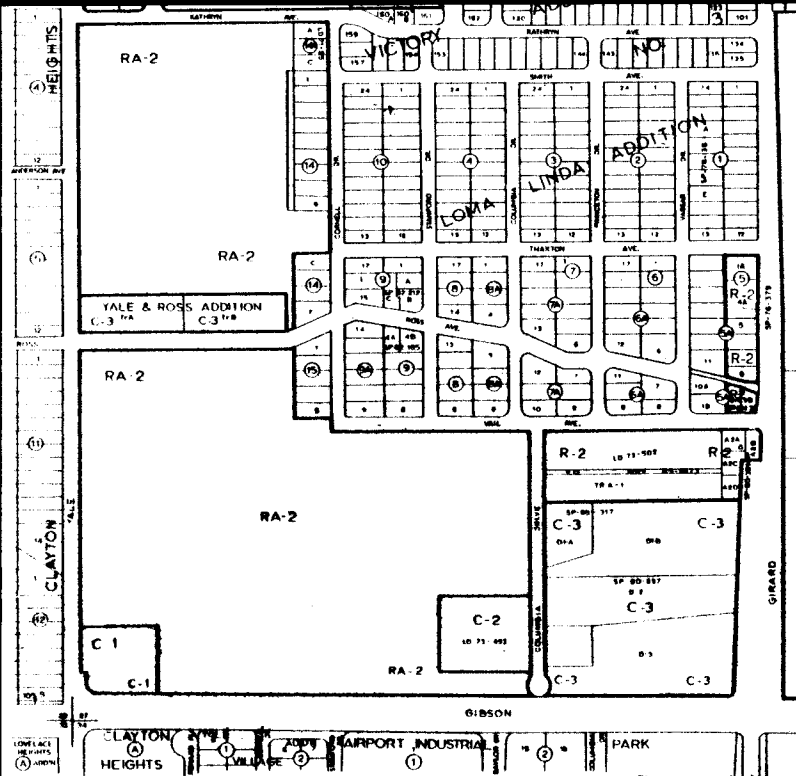


LANDS OF PIERCE AND PAGE
TRACT D-2
T.11N., R.3 E., SEC. 27
ALBUQUERQUE, NEW MEXICO
AUGUST 1984

NATIONAL SELF STORAGE

TITLE	SHEET NO.
TITLE SHEET	1
WATER & SEWER LAYOUT	2 (FOR INFORMATION ONLY)
MEDIAN RELOCATION	3



VICINITY MAP ZONE ATLAS PAGE L-16

NOTICE TO CONTRACTORS:

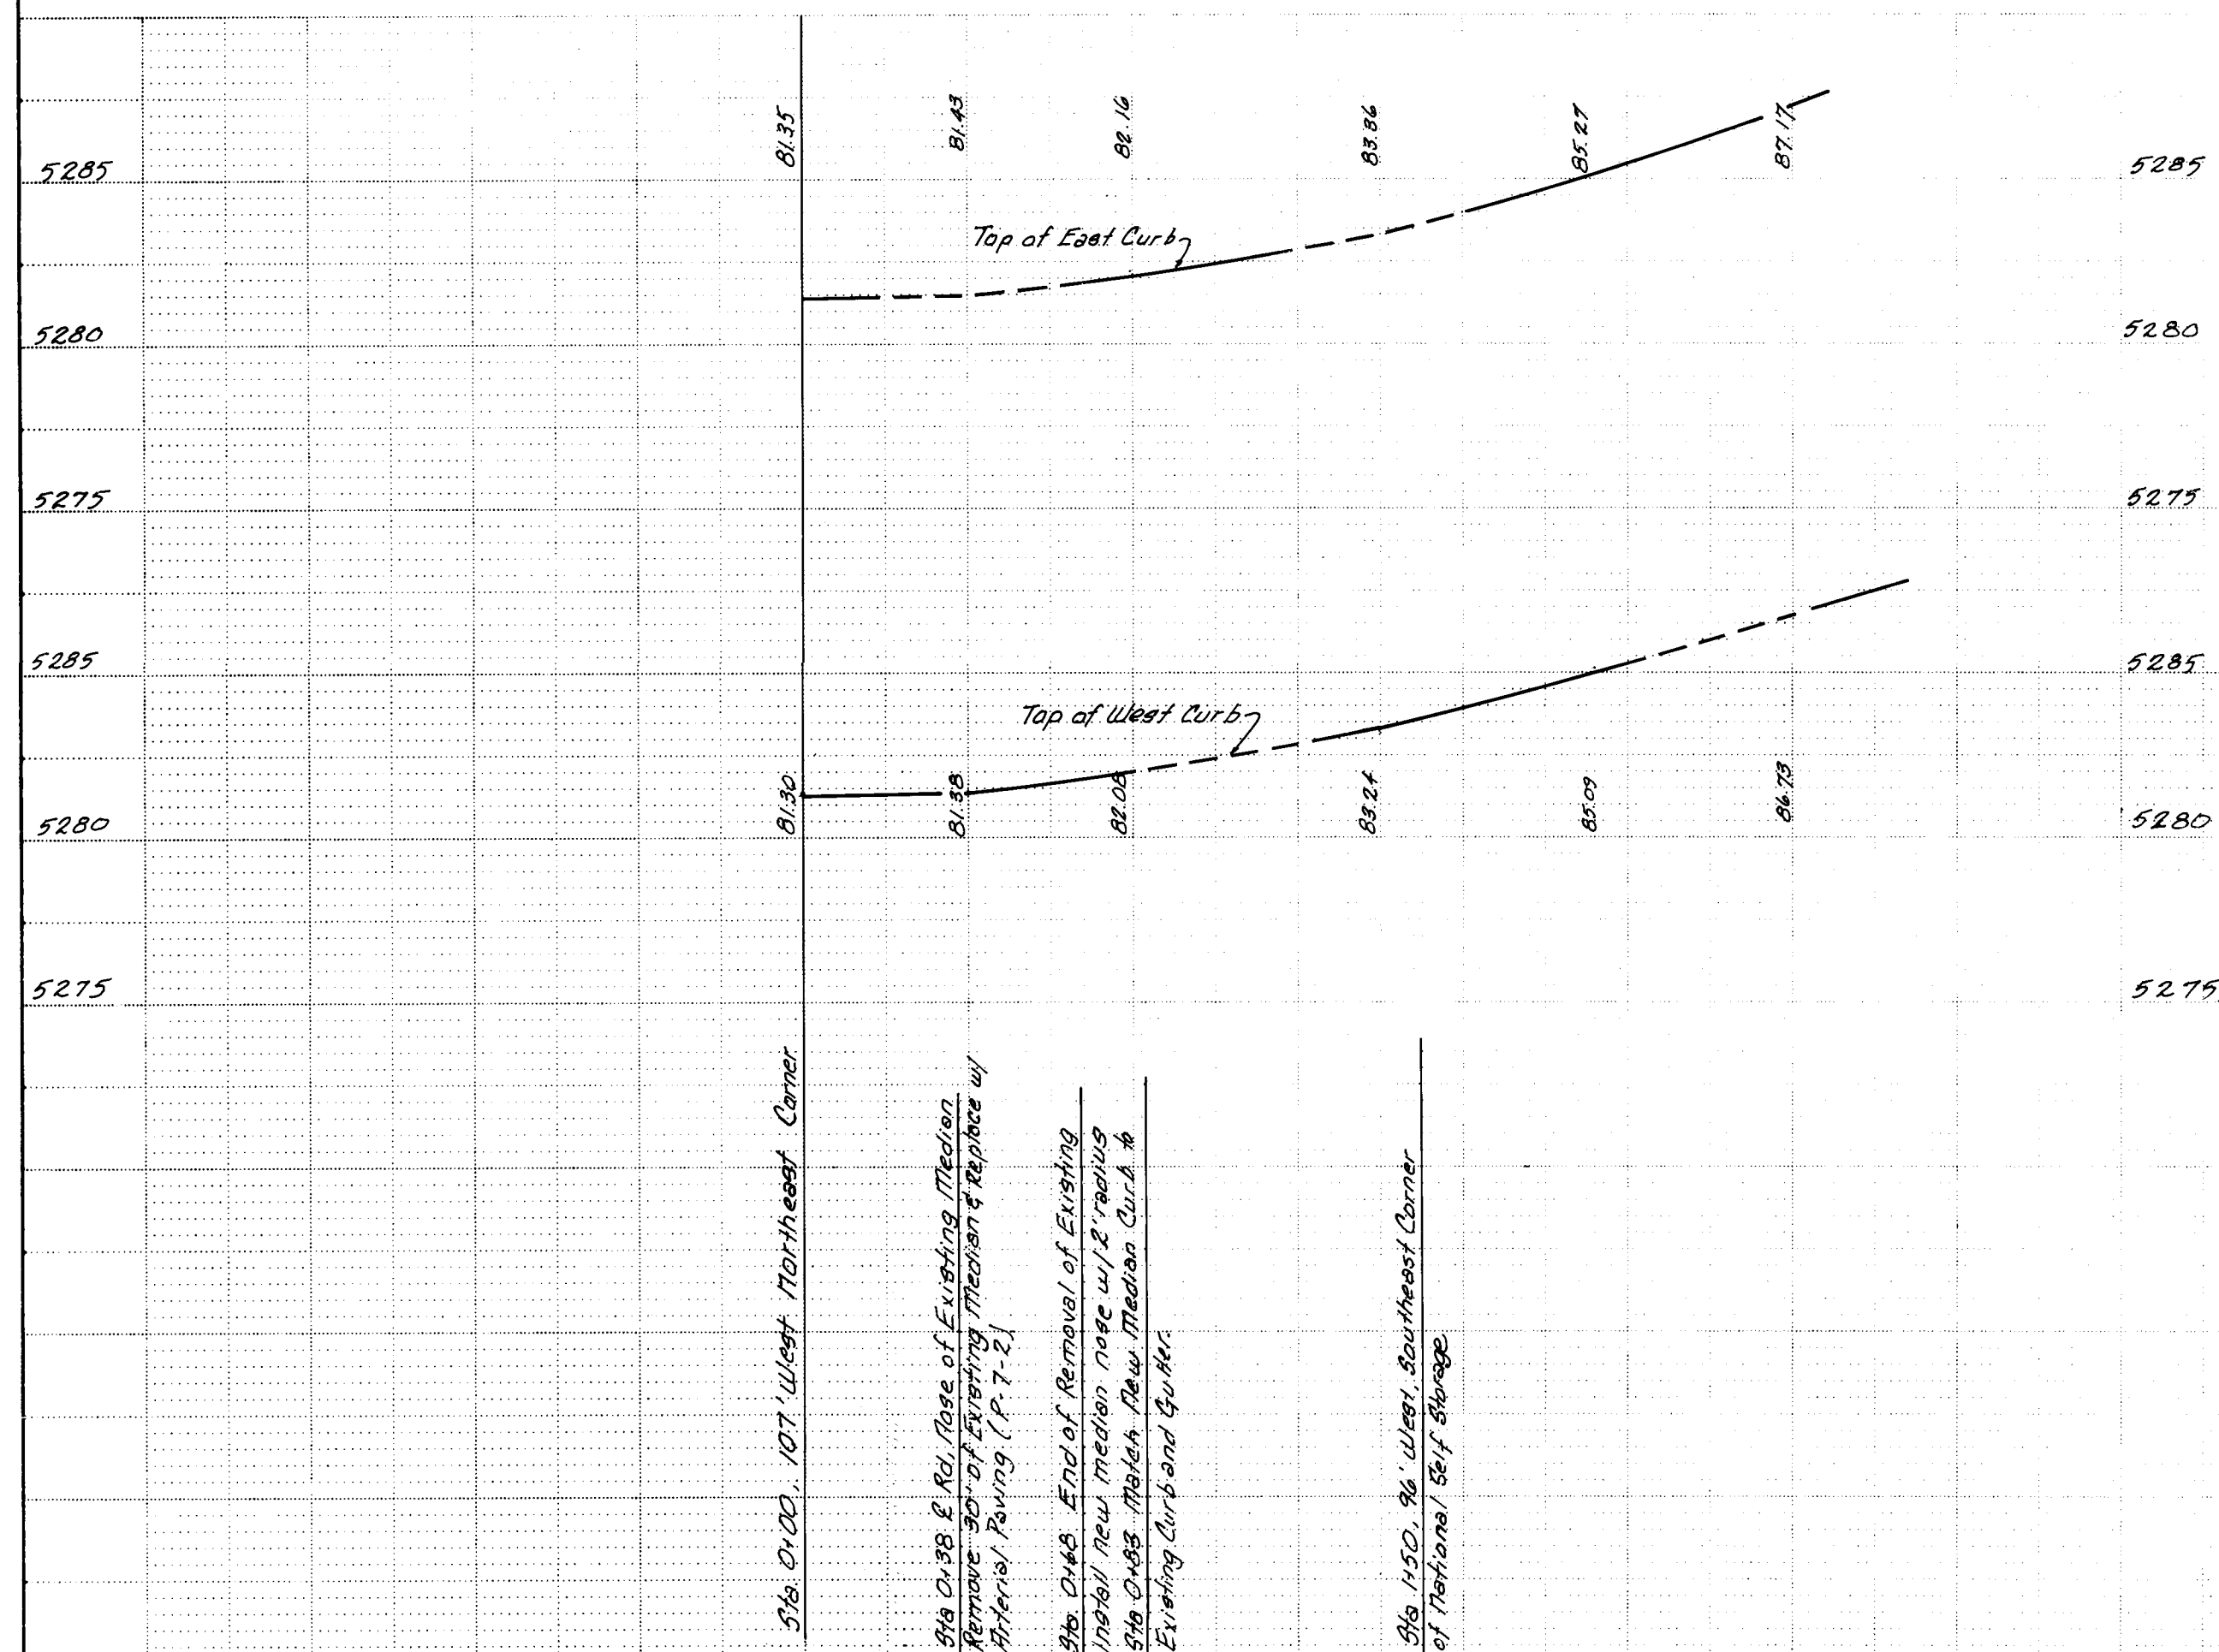
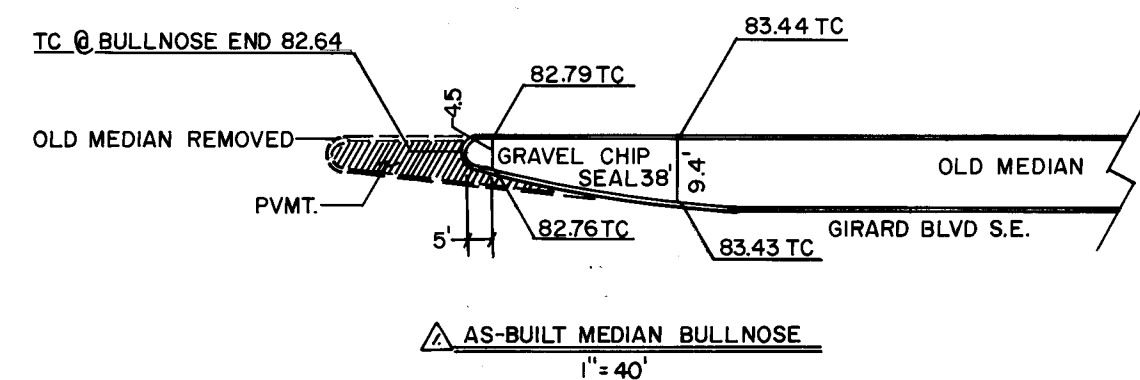
- 1) New Mexico Standard Specifications for Public Works Construction 1979 Edition will be referred to hereon as the Standard Specifications.
- 2) All work detailed on these plans to be performed under contract shall, except as otherwise stated or provided for hereon, be constructed in accordance with Public Works Contract No. 84-2.
- 3) Two working days prior to any excavation contractor must contact Line Location Service, 765-1234, for location of existing utilities.
- 4) Prior to construction, the contractor shall excavate and verify the horizontal and vertical locations of all obstructions. Should a conflict exist the contractor shall notify the engineer or surveyor so that the conflict can be resolved with minimum delay.

THE FOLLOWING NOTES APPLY IF CHECKED:

- ☒ All utilities and utility service lines shall be installed prior to paving.
- ☒ Backfill compaction shall be according to residential street use.
- ☐ Tack coat requirements (Residential) shall be determined by the City Engineer.
- ☐ Sidewalks and wheelchair ramps within the curb returns shall be constructed wherever a new curb return is constructed.
- ☐ If a curb is depressed for a driveway, the driveway shall be constructed prior to acceptance of the curb and gutter.

APPROVED FOR
CONSTRUCTION
C. D. Shepard
ENGINEER DATE

CITY OF ALBUQUERQUE MUNICIPAL DEVELOPMENT DEPARTMENT ENGINEERING DIVISION					
TITLE: <i>Nation Self Storage Title Sheet</i>					
APPROVALS	ENGINEER	DATE	APPROVALS	ENGINEER	DATE
City Engineer	<i>C. D. Shepard</i>	<i>9/18/84</i>	Liquid Waste	<i>R. Pava</i>	<i>9/18/84</i>
A.C.E. Design	<i>W. C. La</i>	<i>9/18/84</i>	Traffic	<i>D. W. Hansen</i>	<i>9/30/84</i>
Hydrology	<i>N. A. B. R.</i>	<i>9/18/84</i>	Water	<i>R. Pava</i>	<i>9/18/84</i>
DRAWING NO. 2252		MAP NO. <i>2</i>		SHEET 1 OF 3	

[illegible]

CITY OF ALBUQUERQUE
MUNICIPAL DEVELOPMENT DEPARTMENT
ENGINEERING DIVISION

TITLE: *National Self Storage
Median Relocation*

APPROVALS	ENGINEER	DATE	APPROVALS	ENGINEER	DATE
City Engineer	<i>E.D. Hyatt</i>	<i>9/10/84</i>	Liquid Waste	<i>R. Pina</i>	<i>9/4/84</i>
A.C.E. Design	<i>E.K. Lisa</i>	<i>9/10/84</i>	Traffic	<i>Dan D. Hanna</i>	<i>8/30/84</i>
ACE - Hydrology	<i>N.A. B.A.A.</i>	<i>9/5/84</i>	Water	<i>R. Pina</i>	<i>9/4/84</i>

DRAWING NO. 2252	MAP NO. L-16	SHEET 3	OF 3
---------------------	-----------------	---------	------