


TRACTION PARK & CITY ELECTRIC ADDITION

SCALE: 1" = 20' HORIZ.
1" = 5' VERT.

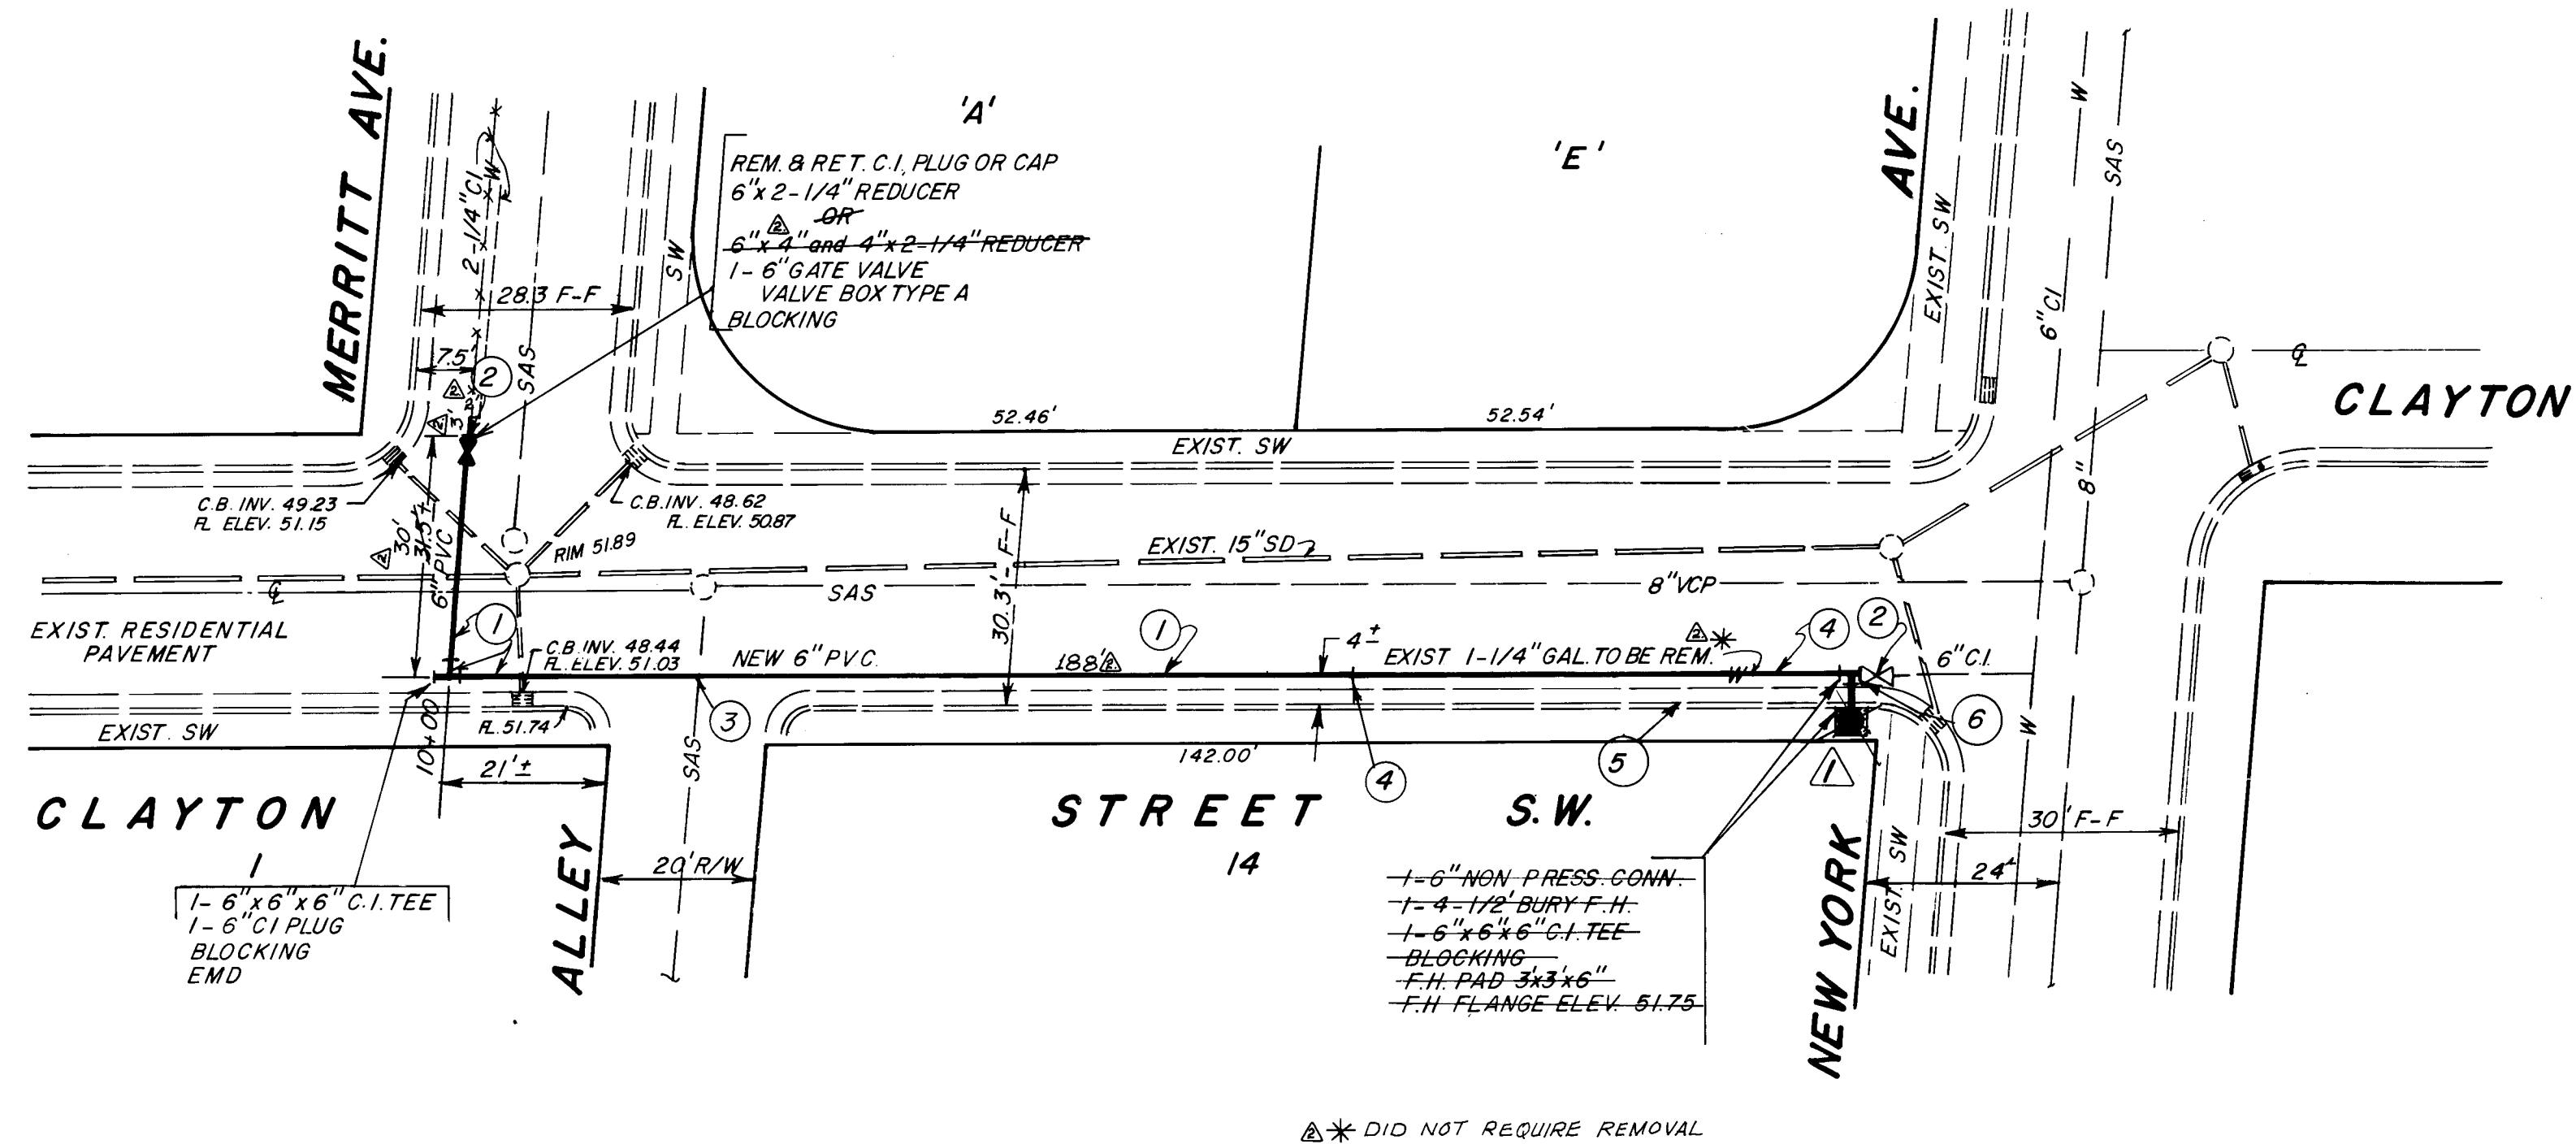

NOTES:


- BUILD 6" DIA. PVC WATER LINE
- EXACT LOCATION AND DEPTH OF EXISTING WATER LINE TO BE VERIFIED IN THE FIELD.
- PLACE WATERLINE 4" DEEP TO AVOID CONFLICT WITH STORM DRAIN LINES AT CLAYTON AND MERRITT. MAINTAIN 2' SEPARATION BETWEEN WATER LINE AND SANITARY SEWER LINE AT CLAYTON AND ALLEY. IF 2' SEPARATION IS UNOBTAINABLE, ENCASE SAS LINE AS PER CITY STD. DWG. S-10.
- REMOVE EXIST. 1-1/4" GAL. WATERLINE FROM EXIST. VALVE NORTH TO END OF LINE TO BE VERIFIED IN FIELD.
- REMOVE CURB & GUTTER ONLY AS NECESSARY. IF CURB & GUTTER IS TO BE REMOVED ALONG WATER LINE EXTENSION, REPLACE CURB AND GUTTER ON A STRAIGHT LINE GRADE BETWEEN LIMITS OF CONSTRUCTION.
- FIRE HYDRANT TO BE PLACED NORTH OF GATE VALVE AT CURB RETURN.
- RECONNECT ANY EXISTING SERVICES FROM EXISTING 1-1/4" LINE ON CLAYTON ST. TO NEW 6" MAIN.

THE FOLLOWING NOTES ALSO APPLY WHEN CHECKED

- ☐ All utilities and utility service lines shall be installed prior to paving.
- ☒ Backfill compaction shall be according to specified street use. (RESIDENTIAL)
- ☒ Tack coat requirements shall be determined by the City Engineer.
- ☐ Sidewalks and wheelchair ramps within the curb returns shall be constructed wherever a new curb return is constructed.
- ☐ If curb is depressed for a driveway or a handicap ramp, the driveway or ramp shall be constructed prior to acceptance of the curb and gutter.
- ☐ All storm drainage facilities shall be completed prior to final acceptance.

REV.	SHEETS	CITY ENGINEER	DATE	USER	DEPARTMENT	DATE
1		C. H. Chapman	1/16/85	PEV		1-16-85

APPROVAL OF REVISIONS

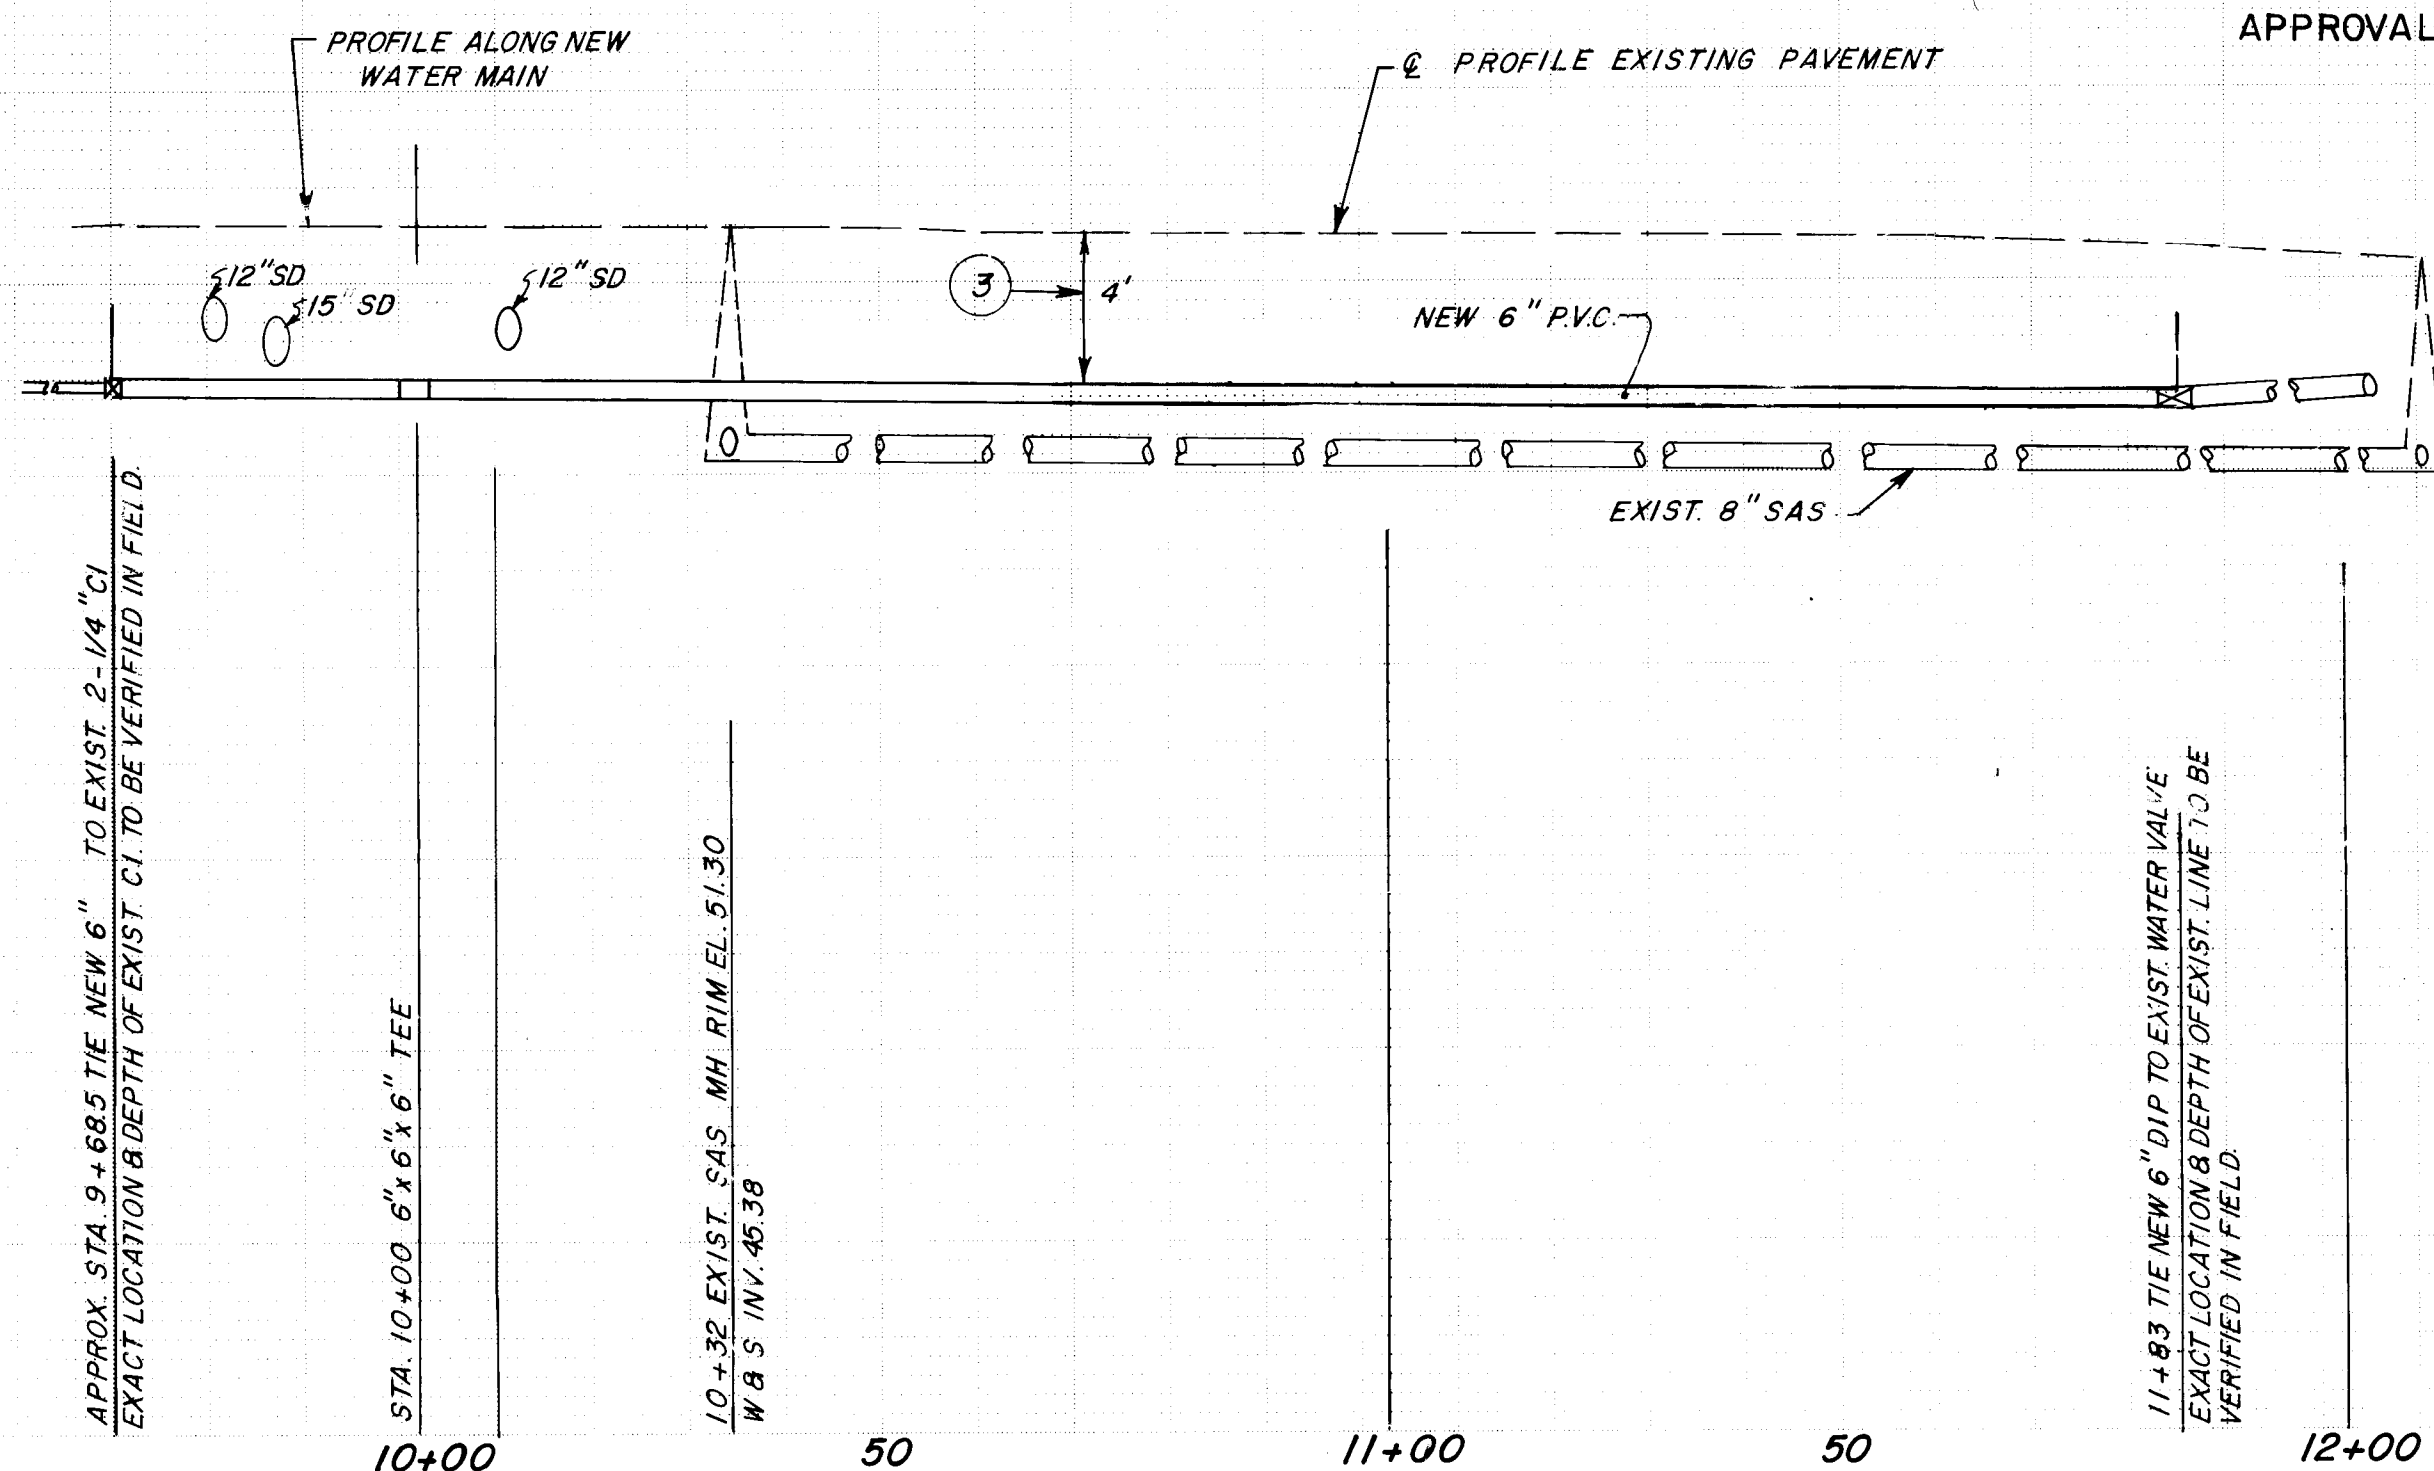

LEGEND

- NEW 6" PVC WATER LINE
- EXIST. MH
- EXIST. GATE VALVE
- NEW GATE VALVE
- EXIST. CATCH BASIN
- EXIST. WATER LINE
- EXIST. SAS
- EXIST. STORM DRAIN

CITY OF ALBUQUERQUE
MUNICIPAL DEVELOPMENT DEPARTMENT
ENGINEERING DIVISION

TITLE: WATER LINE REPLACEMENT & EXTENSION ON
CLAYTON ST. FROM MERRITT AVE TO NEW YORK AVE.
S.W.

APPROVALS	ENGINEER	DATE	APPROVALS	ENGINEER	DATE
City Engineer	C. H. Chapman	1/16/85	Liquid Waste	R. P. Bora	11/16/84
A.C.E. Design	M. R. Olson	12/6/84	Traffic	N. H. Smith	11/20/84
Hydrology	B. J. Boudreau	11/2/84	Water	R. P. Bora	11/16/84

DRAWING NO.	MAP NO.	SHEET OF
2270	J-13	1 1