


CONSTRUCTION PLANS
FOR
ACADEMY RIDGE EAST
PHASE I
ALBUQUERQUE, NEW MEXICO

NO.	DESCRIPTION
1	TITLE SHEET
2-6	PLAT
7	PAVING LAYOUT
8	WATER DISTRIBUTION PLAN
9	SANITARY SEWER LAYOUT
10-11	GRADING PLAN
12	RETAINING WALL & DRAINAGE DETAILS
13	CARRUTHERS STREET
14	MALAGUENA LANE
15	MALAGUENA LANE - ACADEMY RIDGE COURT
16	ACADEMY RIDGE ROAD
17	PUBLIC DRAINAGE & ACCESS RIGHT-OF-WAY
18	MISCELLANEOUS DETAILS
19	PROSPECTOR'S POINT ALLEYWAY

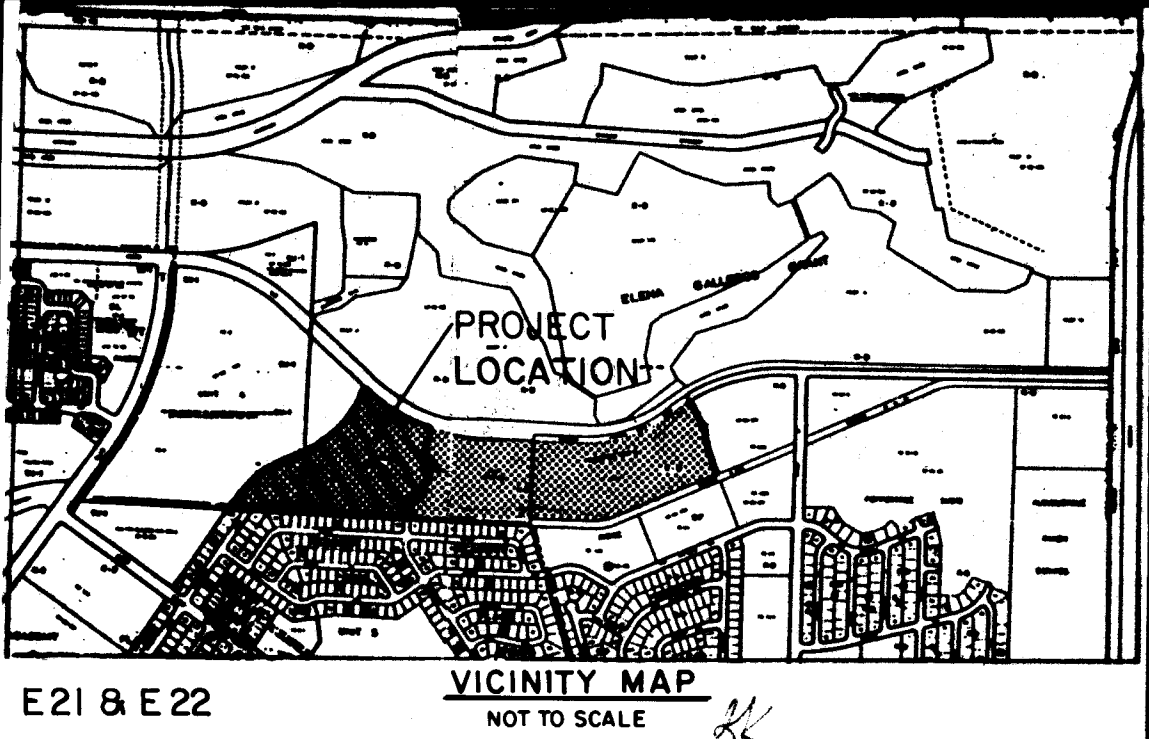

GENERAL NOTES

NOTICE TO CONTRACTORS

- NEW MEXICO STANDARD SPECIFICATIONS FOR PUBLIC WORKS CONSTRUCTION-1979 EDITION WILL BE REFERRED TO HEREON AS THE "STANDARD SPECIFICATION."
- ALL WORK DETAILED ON THESE PLANS TO BE PERFORMED UNDER CONTRACT SHALL, EXCEPT AS OTHERWISE STATED OR PROVIDED FOR HEREON, BE CONSTRUCTED IN ACCORDANCE WITH "PUBLIC WORKS CONTRACT 85-1" AND THE NEW MEXICO STANDARD SPECIFICATIONS FOR PUBLIC WORKS CONSTRUCTION, 1979 EDITION.
- TWO WORKING DAYS PRIOR TO ANY EXCAVATION, CONTRACTOR MUST CONTACT LINE LOCATING SERVICE, 765-1234, FOR LOCATION OF EXISTING UTILITIES.
- PRIOR TO CONSTRUCTION, THE CONTRACTOR SHALL EXCAVATE AND VERIFY THE HORIZONTAL AND VERTICAL LOCATIONS OF ALL OBSTRUCTIONS. SHOULD A CONFLICT EXIST, THE CONTRACTOR SHALL NOTIFY THE ENGINEER OR SURVEYOR SO THAT THE CONFLICT CAN BE RESOLVED WITH A MINIMUM AMOUNT OF DELAY.

THE FOLLOWING NOTES ALSO APPLY WHEN CHECKED


- ☒ ALL UTILITIES AND UTILITY SERVICE LINES SHALL BE INSTALLED PRIOR TO PAVING.
- ☒ BACKFILL COMPACTION SHALL BE ACCORDING TO SPECIFIED STREET USE.
- ☒ TACK COAT REQUIREMENTS SHALL BE DETERMINED BY THE CITY ENGINEER.
- ☒ SIDEWALKS AND WHEELCHAIR RAMPS WITHIN THE CURB RETURNS SHALL BE CONSTRUCTED WHEREVER A NEW CURB RETURN IS CONSTRUCTED.
- ☐ IF CURB IS DEPRESSED FOR A DRIVEPAD, THE DRIVEPAD SHALL BE CONSTRUCTED PRIOR TO ACCEPTANCE OF CURB AND GUTTER.
- ☒ ALL STORM DRAINAGE FACILITIES SHALL BE COMPLETED PRIOR TO FINAL ACCEPTANCE.
- ☒ THE REQUESTOR OR DEVELOPER SHALL BE RESPONSIBLE FOR REPAIR OR REPLACEMENT OF ALL CURB AND GUTTER OR SIDEWALK DAMAGED AFTER APPROVAL BY THE CITY ENGINEER OF WORK COMPLETED BY THE CONTRACTOR.

1	2	3	4	5	6	7	8	9	10	11	12
Z	C	Z	Z	8	9	0	1	9	6		


APPROVAL OF AS-BUILT DRAWINGS
ASST. CITY ENGINEER - FIELD
W. J. Myrnamara
DATE 1-20-86

REV	SHEETS	CITY ENGINEER	DATE	USER	DEPT.	DATE	USER	DEPT.	DATE
3	1-19	As - BUILT	12/85	B. H. Vandy B.H. Inc.		1/17/86			
2	1-19	<i>C. D. Shupard</i>	9/9/85	ACE-D ALDIA		9/25/85			Revised to include new data
1	1-18	<i>A. D. Olson</i> For CDS	7/23/85	ACE-D ALDIA		8/5/85			Revised to include new data

APPROVAL OF REVISIONS
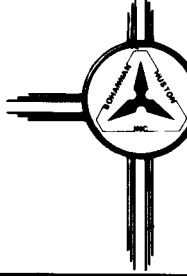
<i>Bohannon</i> 5-23-85	 BOHANNAN - HUSTON INC. ALBUQUERQUE - SANTA FE - EL PASO ENGINEERS PLANNERS PHOTOGRAMMETRISTS	APPROVED FOR CONSTRUCTION <i>C. D. Shupard</i> 4/29/86 C.E.
	PROJECT NUMBER 2289	SHEET 1 OF 19

1-132-28

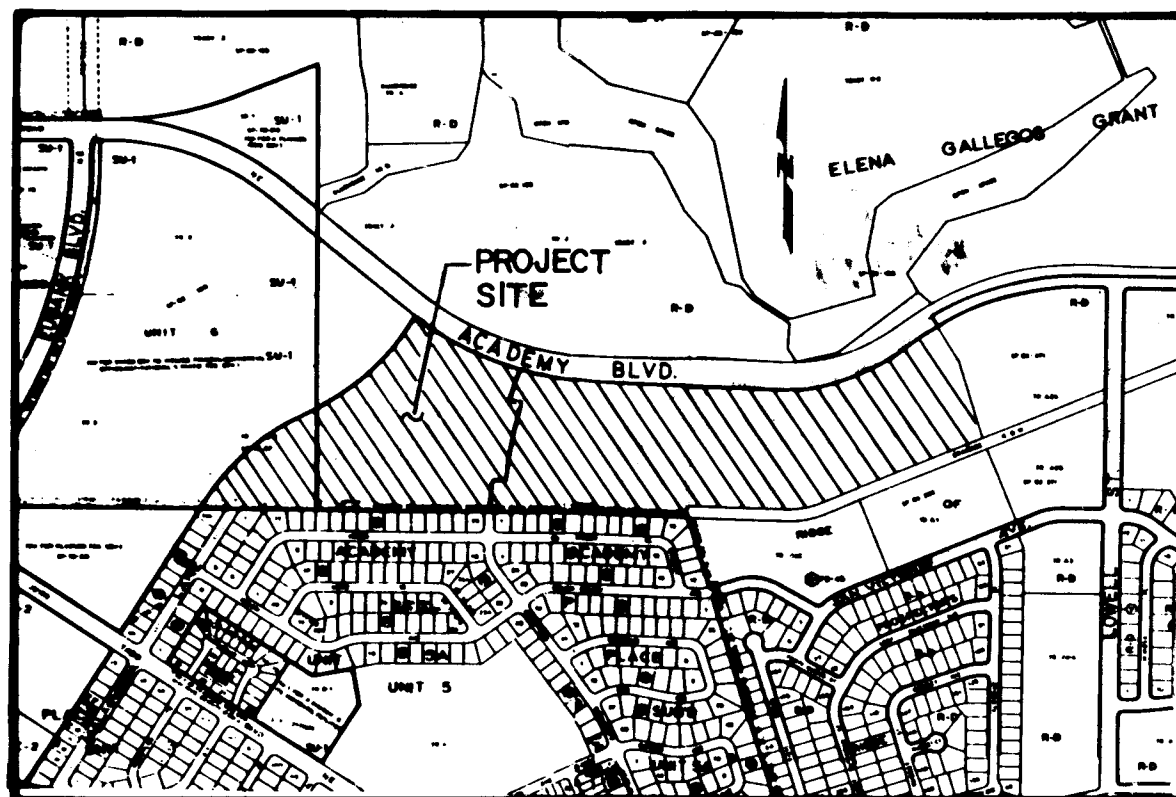

LOCATION MAP
Zone Atlas Map No. E-21-Z & E-22-Z

NOTES

1. Bearings are New Mexico State Plane Grid Bearings (Central Zone).
2. Distances are ground distances.
3. Record Bearings and distances are shown in parenthesis.

SUBDIVISION DATA

1. DBS Number **S-84-23, DRB-84-212, V-84-41**
2. Zone Atlas Index No. E-21 and E-22.
3. Gross Subdivision Acreage: 35.7791 Acres.
4. Total Number of Tracts Created: 128 Tracts.
5. Total Mileage of Full-Width Streets Created: 0.710 mile.
6. Plat was prepared from existing Plats of Record.

APPROVALS

PLAT NUMBER S-84-23	
Richard D. Weaver	10-16-85
PLANNING DIRECTOR	DATE
Frank J. Lopez	10-15-85
CITY ENGINEER	DATE
Frank J. Lopez	10-15-85
A.M.P.C.A.	DATE
Robert A. Thompson	6-3-85
TRAFFIC ENGINEER	DATE
Don Clark	05-30-85
CITY SURVEYOR	DATE
Roni Elwell	5-30-85
PROPERTY MANAGEMENT	DATE
Jon E. Fitzgerald	6-4-85
WATER RESOURCES DEPARTMENT	DATE
Marta Chelly	6-4-85
PARKS & RECREATION DEPARTMENT	DATE
Cl. Bernal	5-30-85
PUBLIC SERVICE COMPANY OF NEW MEXICO	DATE
Paula M. Geller	5-30-85
GAS COMPANY OF NEW MEXICO	DATE
Wayne Fleming	5-30-85
MOUNTAIN WELL	DATE

SUBDIVISION PLAT MAP FOR 85 36959

UNIT ONE
ACADEMY RIDGE EAST

WITHIN PROJECTED SECTIONS 27 and 28, T11N, R4E, N.M.P.M.

ALBUQUERQUE, NEW MEXICO
JANUARY 1985

DESCRIPTION

A certain tract of land situate within projected Sections 27 and 28, T11N, R4E, N.M.P.M., within the Elena Gallegos Grant, City of Albuquerque, Bernalillo County, New Mexico, comprising Tract B-1, LANDS OF ANHONY IV filed in the Office of the County Clerk of Bernalillo County, New Mexico on May 8, 1984 and being more particularly described by New Mexico State Plane Grid Bearings (Central Zone) and ground distances as follows:

BEGINNING at the southeast corner of the tract herein described, also being the southeast corner of said Tract B-1, whence the ACS Monument "HARRY", a brass tablet (having New Mexico State Plane Grid Coordinates, Central Zone: X = 423,375.12 and Y = 1,505,887.52) bears S30°57'31"E, 4223.92 feet and from said point of beginning running thence along the southerly boundary of said tract B-1, N88°53'35"W, 2464.96 feet to the southwest corner of said tract B-1; thence, N33°10'12"E, 300.00 feet to a point of curvature; thence, 379.26 feet along the arc of a curve to the right having a radius of 500.00 feet and a chord bearing N54°53'59"E, 370.23 feet to a point of reverse curvature; thence, 670.00 feet along the arc of a curve to the left having a radius of 1000.00 feet and a chord bearing N57°26'08"E, 657.54 feet to a point of non-tangency; thence, N38°17'17"E, 166.85 feet to the northwest corner of said tract B-1 also being a point on curve on the southerly right-of-way of Academy Road N.E.; thence continuing along said right-of-way and the northerly boundary of said tract B-1, 962.80 feet along the arc of a curve to the left having a radius of 1485.40 feet and a chord bearing S70°19'27"E, 946.04 feet to a point of tangency; thence, S88°53'35"E, 462.13 feet to the northeast corner of said Tract B-1; thence leaving said right-of-way and continuing along the easterly boundary of said Tract B-1, S01°06'25"W, 669.17 feet to the point and place of beginning.

Tract contains 35.7731 acres, more or less.

State of New Mexico) SS
County of Bernalillo)
I, the undersigned, County Clerk of Bernalillo County, New Mexico, do hereby certify that the foregoing is a true and correct copy of the original record of the above described subdivision plat map as recorded in Vol. C28 of the County Clerk's Office, Bernalillo County, New Mexico, on January 1, 1985.
County Clerk
Deputy Clerk

DEDICATION

The subdivision of the land hereon shown is with the free consent and in accordance with the desires of the undersigned owner(s) and/or proprietor(s) thereof and said owner(s) and/or proprietor(s) do grant all easements shown hereon. Electrical Power and Communication easements are reserved for buried distribution lines, conduits and pipes for underground utilities where shown or indicated, including the right of ingress and egress for construction and maintenance, and the right to trim interfering trees and shrubs. Future development of Tract A and Tract B will require additional PNM easements to serve future customers.

AMERIWEST CORPORATION

Allan L. Whitesel
Allan L. Whitesel
Vice President, AmeriWest Corporation

State of New Mexico)
County of Bernalillo)

The foregoing instrument was acknowledged before me this 30th day of May, 1985, by Allan L. Whitesel, Vice President, AmeriWest Corporation, a New Mexico Corporation on behalf of said Company.

My Commission Expires: 10-11-88
Lisa K. Connell
Notary Public

10-11-88

SURVEYOR'S CERTIFICATION

I, A. Dwain Weaver, under the laws of New Mexico, certify that I am a registered Land Surveyor, and that this plat was prepared by me or under my supervision, shows all easements of record, meets the minimum requirements for monumentation and surveys contained in the Albuquerque Subdivision Ordinance, and is true and accurate to the best of my knowledge and belief.


A. Dwain Weaver
A. Dwain Weaver
N.M.P.L.S. No. 6544

Bohannon-Huston Inc.
4125 Carlisle Blvd., N.E.
Albuquerque, NM 87107

State of New Mexico)
County of Bernalillo)

The foregoing instrument was acknowledged before me this 2nd day of February, 1985, by A. Dwain Weaver.

A. Dwain Weaver
Notary Public

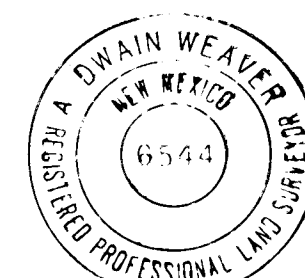

1 2 3 4 5 6 7 8 9 10 11 12
26 22890286

SHEET 1 OF 5

C28-132


PROJECT NUMBER
2289

C28-132-820

TANGENT TABLE		
NR.	DISTANCE	BEARING
T1	300.00'	N33°10'12"E
T2	166.85'	N38°17'17"E
T3	34.69'	S61°27'06"W
T4	34.72'	N26°27'41"W
T5	179.08'	N14°05'57"E
T6	69.70'	S17°31'15"W
T7	50.67'	S25°01'14"W
T8	76.15'	S17°31'15"W
T9	50.00'	N01°06'25"E
T10	105.00'	S01°06'25"W
T11	85.00'	N01°06'25"E
T12	76.15'	N17°31'15"E
T13	50.67'	N10°01'16"E
T14	70.04'	N17°31'15"E
T15	139.00'	N01°06'25"E
T16	103.00'	S88°53'35"E
T17	129.80'	N88°53'35"W
T18	49.27'	S36°50'01"W
T19	50.00'	N88°53'35"W
T20	964.36'	N88°53'35"W
T21	85.00'	N01°06'25"E
T22	195.58'	N86°32'39"E
T23	453.03'	S78°05'18"E
T24	223.65'	S87°24'20"E
T25	1413.02'	S88°53'35"E
T26	106.20'	N33°10'12"E
T27	500.02'	S88°53'35"E
T28	149.99'	N00°10'12"E
T29	105.39'	N85°27'52"E
T30	171.02'	S73°38'48"E
T31	320.04'	S88°00'26"E
T32	192.99'	S72°20'40"E
T33	235.05'	S87°41'01"E

CURVE TABLE				
NR.	RADIUS	ARC	CHORD	DELTA
C1	500.00'	379.26'	370.23'	43°27'34"
C2	1000.00'	670.00'	657.54'	38°23'17"
C3	1485.40'	962.80'	946.04'	37°08'16"
C4	1655.40'	87.25'	87.24'	03°01'12"
C5	822.36'	235.59'	234.78'	16°24'50"
C6	25.00'	39.27'	35.36'	90°00'00"
C7	772.36'	221.26'	220.51'	16°24'50"
C8	25.00'	40.14'	35.97'	91°59'40"
C9	25.00'	38.53'	34.83'	88°17'42"

NOTE: TABLES ARE FOR THIS SHEET ONLY.

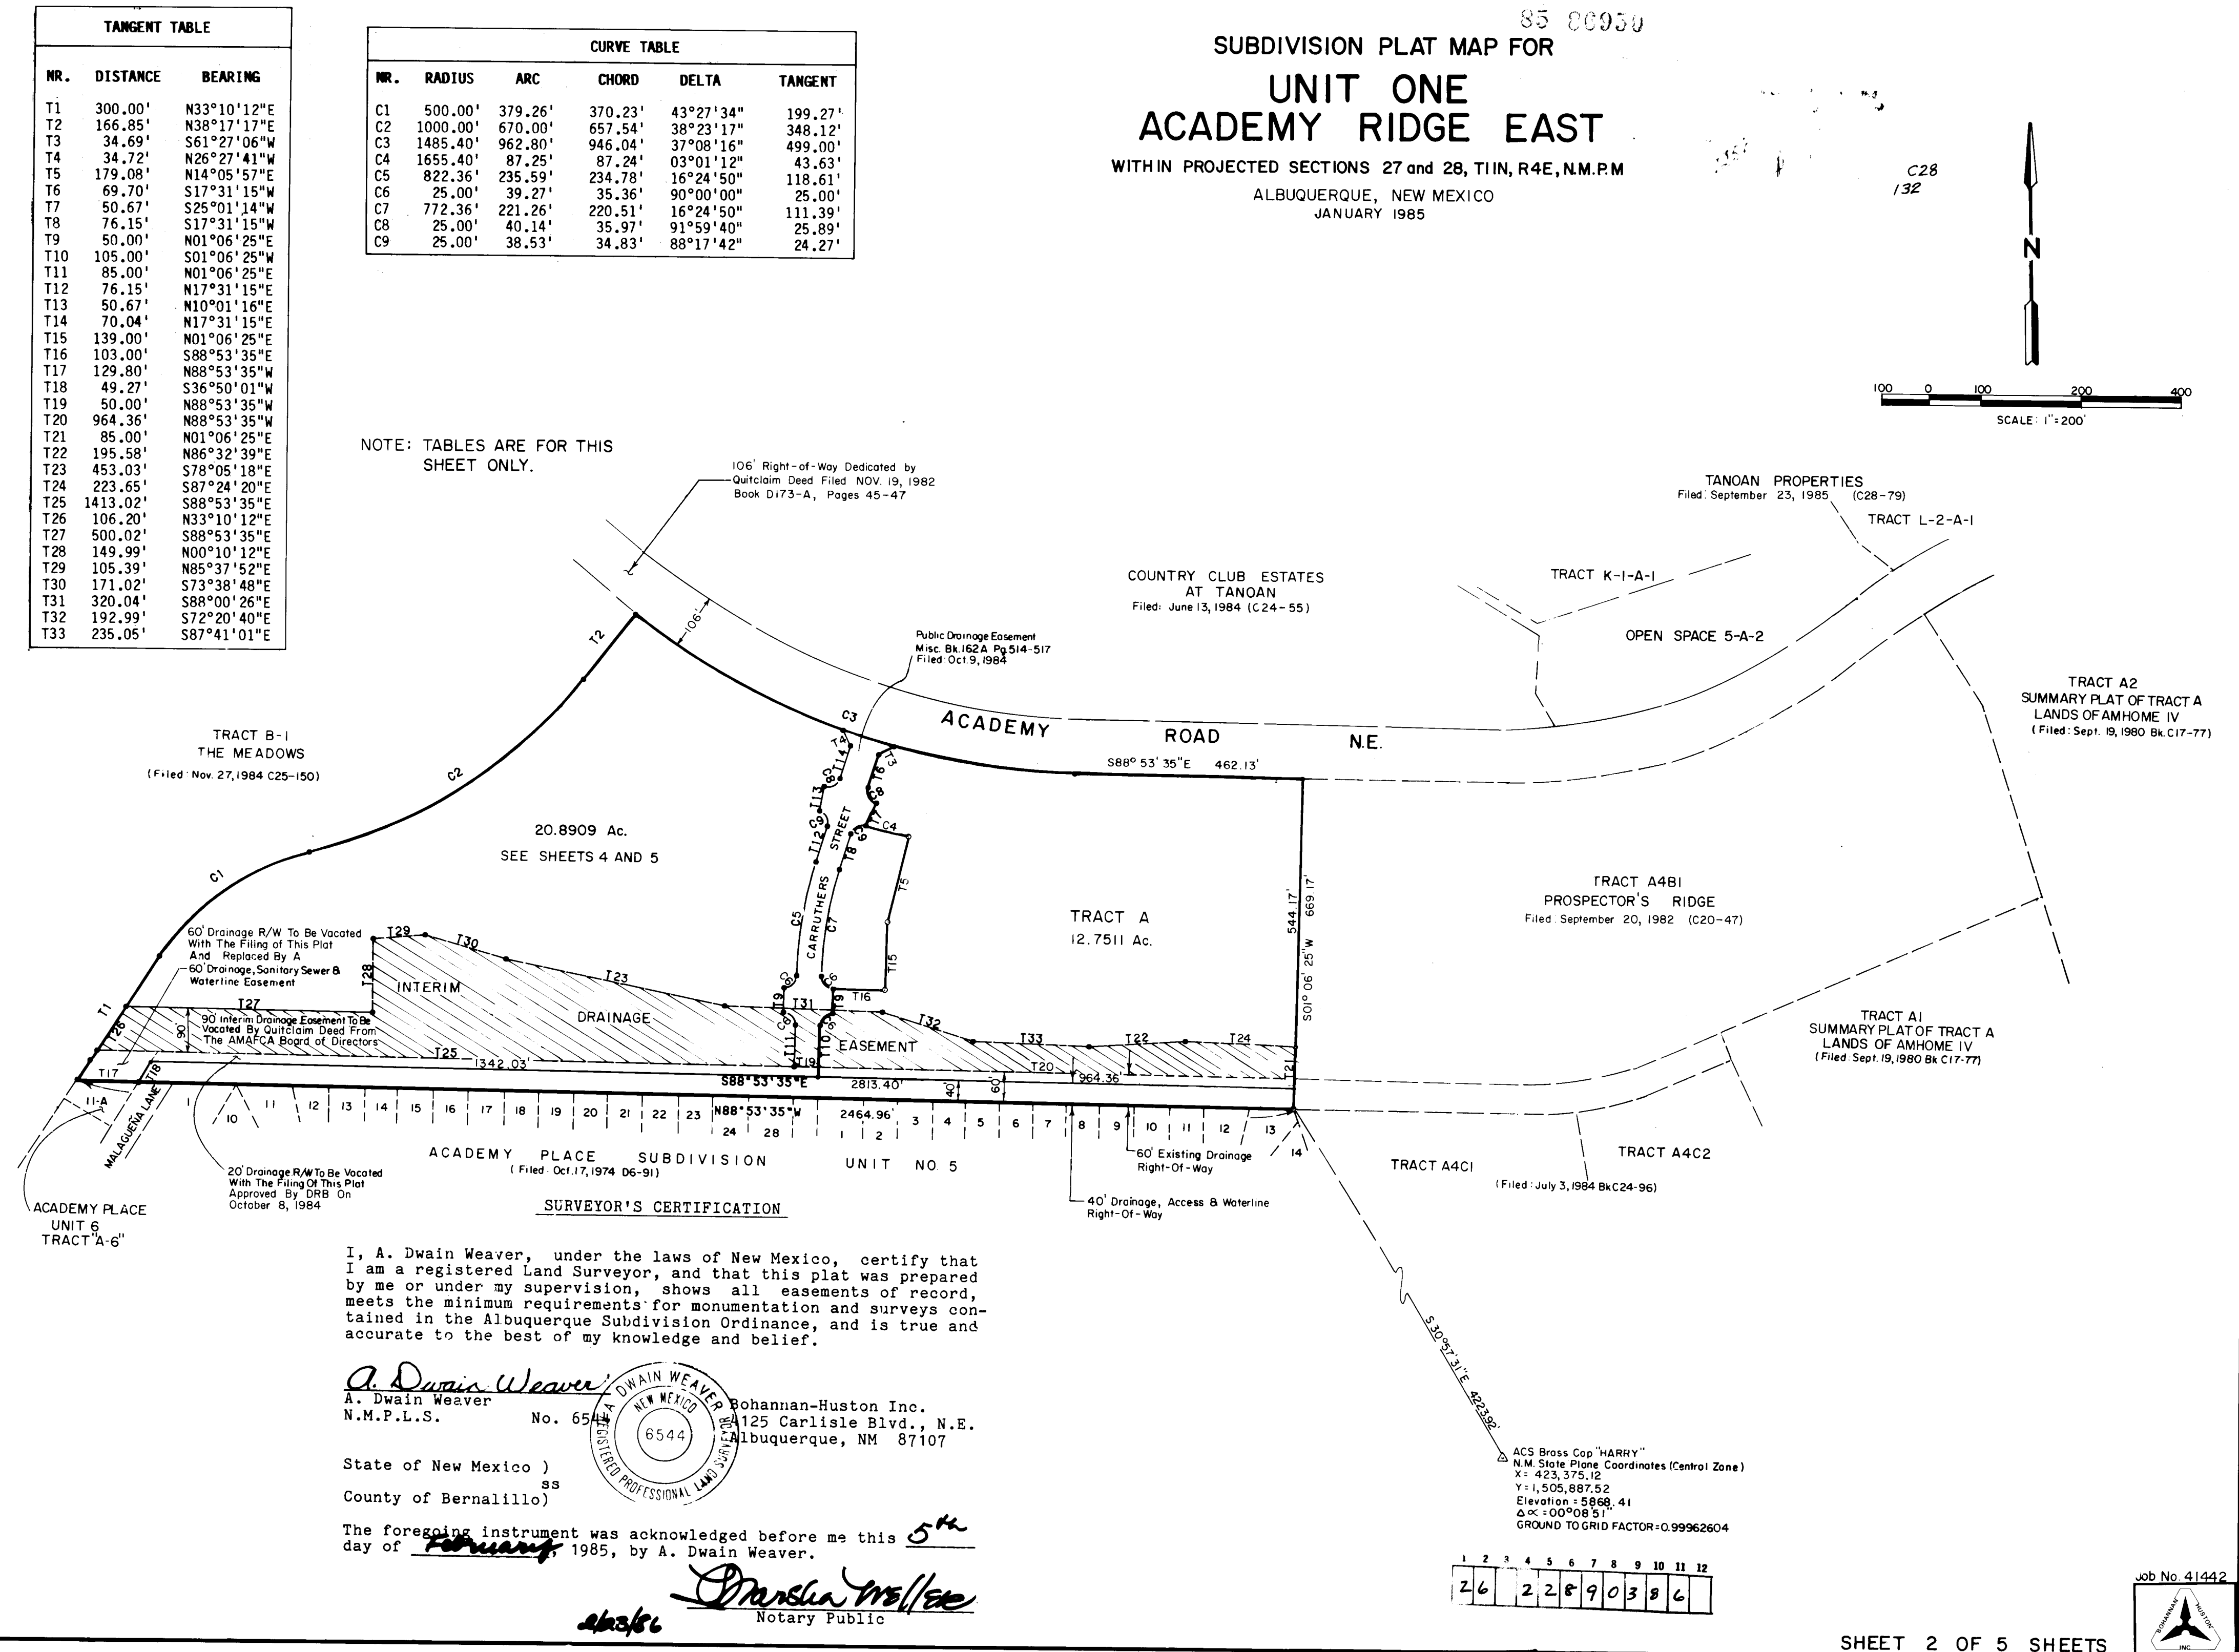

I, A. Dwain Weaver, under the laws of New Mexico, certify that I am a registered Land Surveyor, and that this plat was prepared by me or under my supervision, shows all easements of record, meets the minimum requirements for monumentation and surveys contained in the Albuquerque Subdivision Ordinance, and is true and accurate to the best of my knowledge and belief.

A. Dwain Weaver
A. Dwain Weaver
N.M.P.L.S. No. 6544
Bohannon-Huston Inc.
125 Carlisle Blvd., N.E.
Albuquerque, NM 87107

State of New Mexico)
County of Bernalillo)

The foregoing instrument was acknowledged before me this 5th day of February 1985, by A. Dwain Weaver.

Marsha M. McElroy
Notary Public

SHEET 2 OF 5 SHEETS

C28-132-2

PROJECT NUMBER

2289

SHEET

OF

3

19

C28-132-3

85 80030

SUBDIVISION PLAT MAP FOR
UNIT ONE
ACADEMY RIDGE EAST
WITHIN PROJECTED SECTIONS 27 AND 28, T11N, R4E, N.M.P.M.
ALBUQUERQUE, NEW MEXICO
JANUARY 1985

TABLES FOR SHEETS 4 AND 5 ONLY

CURVE TABLE					
NR.	RADIUS	ARC	CHORD	TANGENT	
C1	1000.00'	137.01'	156.85'	08°59'46"	78.67'
C2	1485.40'	592.71'	588.78'	22°51'44"	300.35'
C3	1132.05'	140.09'	140.00'	07°05'25"	70.13'
C4	100.00'	138.33'	127.56'	79°15'21"	82.81'
C5	1630.40'	367.02'	366.25'	12°53'52"	184.29'
C6	787.36'	228.42'	227.64'	16°24'50"	115.00'
C7	25.00'	38.34'	34.89'	87°51'43"	24.08'
C8	25.00'	40.14'	35.87'	91°59'40"	25.89'
C9	25.00'	38.53'	34.83'	86°17'42"	24.27'
C10	25.00'	38.27'	35.36'	90°00'00"	25.00'
C11	25.00'	24.39'	23.43'	55°53'41"	13.28'
C12	1485.40'	54.08'	54.08'	02°05'10"	27.04'
C13	1000.00'	40.00'	40.00'	02°17'51"	20.00'
C14	1107.05'	44.53'	44.53'	02°18'17"	22.27'
C15	1107.05'	44.53'	44.53'	02°18'18"	22.27'
C16	125.00'	13.88'	13.88'	08°18'32"	6.85'
C17	1107.05'	30.89'	30.89'	01°35'55"	15.44'
C18	1000.00'	37.00'	37.00'	02°07'12"	18.50'
C19	25.00'	21.46'	20.81'	49°10'38"	11.44'
C20	125.00'	24.43'	24.39'	11°11'57"	12.28'
C21	45.00'	39.23'	38.00'	49°57'00"	20.96'
C22	25.00'	2.93'	2.93'	06°43'03"	1.47'
C23	1485.40'	78.78'	78.78'	03°02'17"	39.39'
C24	45.00'	44.81'	42.88'	57°03'33"	24.46'
C25	1485.40'	89.61'	89.60'	03°27'24"	44.82'
C26	45.00'	43.70'	42.00'	53°38'11"	23.74'
C27	1485.40'	40.08'	40.08'	01°32'37"	20.01'
C28	1805.40'	4.61'	4.61'	00°09'53"	2.31'
C29	125.00'	14.25'	14.24'	06°31'51"	7.13'
C30	45.00'	3.45'	3.45'	04°23'41"	1.73'
C31	1805.40'	43.23'	43.23'	01°32'35"	21.82'
C32	1485.40'	36.01'	36.00'	01°23'20"	18.00'
C33	1805.40'	41.50'	41.50'	01°28'52"	20.75'
C34	1187.05'	40.00'	40.00'	01°58'51"	20.00'
C35	1187.05'	40.01'	40.00'	01°58'52"	20.01'
C36	1157.05'	58.56'	58.55'	02°58'58"	28.79'
C37	75.00'	13.64'	13.82'	10°38'45"	6.99'
C38	1187.05'	60.49'	60.43'	02°59'44"	30.25'
C39	75.00'	86.38'	81.68'	63°58'13"	48.69'
C40	75.00'	3.43'	3.43'	02°37'23"	1.72'
C41	1855.40'	67.32'	67.32'	02°19'48"	33.67'
C42	1855.40'	44.20'	44.20'	01°31'48"	22.10'
C43	1855.40'	42.96'	42.96'	01°29'13"	21.48'
C44	1855.40'	40.00'	40.00'	01°23'04"	20.00'
C45	1855.40'	88.90'	88.89'	03°04'37"	44.48'
C46	822.36'	7.00'	7.00'	00°29'16"	3.50'
C47	822.36'	48.01'	48.00'	03°20'41"	24.01'
C48	822.36'	36.58'	36.58'	02°32'50"	18.28'
C49	85.00'	1.45'	1.45'	03°19'55"	.73'
C50	25.00'	28.82'	28.09'	88°21'01"	16.97'
C51	45.00'	35.57'	34.86'	45°11'40"	18.78'
C52	45.00'	47.23'	45.08'	60°08'12"	26.05'
C53	45.00'	30.00'	29.45'	38°11'50"	15.58'
C54	45.00'	33.17'	32.43'	42°14'12"	17.38'
C55	45.00'	21.69'	21.48'	27°37'12"	11.06'
C56	1855.40'	87.25'	87.24'	03°01'12"	43.64'
C57	772.36'	54.34'	54.33'	04°01'51"	27.18'
C58	772.36'	54.01'	54.00'	04°00'54"	27.02'
C59	772.36'	54.59'	54.58'	04°03'00"	27.31'
C60	772.36'	47.88'	47.88'	03°53'08"	23.95'

CURVE TABLE					
NR.	RADIUS	ARC	CHORD	DELTA	TANGENT
C61	500.00'	379.28'	370.23'	43°27'34"	189.27'
C62	1000.00'	512.89'	507.58'	28°23'31"	282.27'
C63	839.87'	407.02'	403.05'	27°48'24"	207.59'
C64	839.87'	82.30'	82.27'	05°36'58"	41.18'
C65	839.87'	488.32'	482.43'	33°23'22"	251.83'
C66	1132.05'	381.70'	380.18'	18°18'23"	182.40'
C67	117.87'	94.58'	92.07'	45°56'17"	50.00'
C68	864.87'	16.82'	16.82'	01°06'53"	8.41'
C69	864.87'	42.00'	42.00'	02°47'00"	21.01'
C70	500.00'	38.03'	38.04'	04°21'37"	19.03'
C71	864.87'	40.00'	40.00'	02°38'03"	20.01'
C72	500.00'	46.85'	46.83'	05°22'06"	23.44'
C73	500.00'	46.84'	46.84'	05°22'04"	23.44'
C74	500.00'	46.84'	46.82'	05°22'03"	23.44'
C75	500.00'	46.86'	46.84'	05°22'06"	23.45'
C76	500.00'	13.28'	13.28'	01°31'20"	6.64'
C77	1000.00'	32.48'	32.47'	01°51'39"	16.24'
C78	864.87'	34.00'	34.00'	02°15'11"	17.00'
C79	1000.00'	40.31'	40.31'	02°18'34"	20.16'
C80	1000.00'	40.14'	40.14'	02°18'00"	20.07'
C81	1000.00'	40.04'	40.04'	02°17'38"	20.02'
C82	1000.00'	40.00'	40.00'	02°17'31"	20.00'
C83	1107.05'	14.89'	14.88'	00°45'37"	7.35'
C84	1107.05'	44.48'	44.48'	02°18'09"	22.25'
C85	1107.05'	44.48'	44.48'	02°18'10"	22.25'
C86	1107.05'	44.50'	44.50'	02°18'11"	22.25'
C87	1107.05'	44.51'	44.50'	02°18'12"	22.26'
C88	1107.05'	44.51'	44.51'	02°18'13"	22.26'
C89	1107.05'	44.52'	44.52'	02°18'14"	22.26'
C90	1107.05'	44.52'	44.52'	02°18'15"	22.26'
C91	1107.05'	44.53'	44.52'	02°18'16"	22.27'
C92	82.87'	73.85'	71.82'	45°30'41"	39.00'
C93	25.00'	47.38'	40.60'	108°33'08"	34.78'
C94	814.87'	13.20'	13.20'	00°55'43"	6.60'
C95	82.87'	.68'	.68'	00°25'36"	.35'
C96	1157.05'	32.80'	32.79'	01°37'26"	16.40'
C97	1157.05'	40.00'	40.00'	01°58'51"	20.00'
C98	814.87'	63.31'	63.28'	04°27'08"	31.67'
C99	814.87'	40.08'	40.08'	07°48'08"	20.04'
C100	814.87'	40.25'	40.25'	02°48'51"	20.13'
C101	814.87'	40.52'	40.52'	02°51'00"	20.27'
C102	814.87'	40.80'	40.80'	02°52'36"	20.46'
C103	814.87'	41.50'	41.49'	02°55'06"	20.75'
C104	25.00'	34.44'	31.78'	78°55'20"	20.58'
C105	142.87'	8.00'	8.00'	03°12'22"	4.00'
C106	142.87'	37.21'	37.10'	14°54'42"	18.71'
C107	142.87'	37.21'	37.11'	14°54'43"	18.71'
C108	142.87'	32.21'	32.14'	12°54'30"	16.17'
C109	100.00'	78.71'	76.70'	45°06'00"	41.52'
C110	100.00'	59.61'	58.74'	34°09'22"	30.72'
C111	25.00'	38.38'	34.72'	87°57'52"	24.13'
C112	1485.40'	40.02'	40.01'	01°32'37"	20.01'
C113	1485.40'	40.02'	40.01'	01°32'36"	20.01'
C114	1485.40'	54.12'	54.12'	02°05'16"	27.06'
C115	772.36'	10.44'	10.44'	00°46'20"	5.22'

TANGENT TABLE	
NR.	BEARING
T1	8.08' N38°17'17"E
T2	28.48' S15°23'17"W
T3	58.40' S15°23'17"W
T4	55.36' S15°23'17"W
T5	44.03' S48°59'03"W
T6	40.00' S48°59'03"W
T7	34.30' S48°59'03"W
T8	21.48' N67°06'28"W
T9	22.00' S48°59'03"W
T10	31.61' N67°06'28"W
T11	40.00' N67°06'28"W
T12	42.06' N67°06'28"W
T13	51.94' N67°06'28"W
T14	2.97' N12°21'18"E
T15	54.57' N12°27'23"E
T16	54.43' N12°18'34"E
T17	54.65' N12°18'34"E
T18	11.31' N12°18'34"E
T19	28.00' S88°53'35"E
T20	45.87' N12°18'34"E
T21	45.85' N12°13'03"E
T22	17.24' S12°27'23"W
T23	26.65' S12°27'23"W
T24	120.00' S87°06'28"E
T25	37.33' S12°27'23"W
T26	38.00' N48°59'03"E
T27	107.09' S87°06'28"E
T28	110.00' N48°59'03"E
T29	20.00' S01°08'25"W
T30	49.37' N15°23'17"E
T31	32.32' N48°59'03"E
T32	46.43' N15°23'17"E
T33	5.02' N83°50'52"E
T34	10.44' N17°06'01"E
T35	32.00' N33°10'12"E
T36	10.00' S88°53'35"E
T37	6.79' N33°10'12"E
T38	6.06' S88°53'35"E
T39	40.07' S63°11'39"W
T40	8.00' N86°13'34"E
T41	44.00' S63°11'39"W
T42	43.82' S63°11'39"W
T43	43.80' S61°57'51"W
T44	54.85' N83°50'52"E
T45	57.81' N83°50'52"E
T46	5.02' S83°50'52"E
T47	32.15' N83°50'52"E
T48	127.89' S63°11'39"W
T49	40.18' S83°50'52"E
T50	25.00' N61°57'51"E
T51	18.50' N61°57'51"E
T52	18.80' N61°57'51"E
T53	10.00' S41°43'40"W
T54	5.00' S88°53'35"E
T55	149.99' N00°10'12"E
T56	105.36' N85°37'52"E
T57	171.0' S73°38'48"E
T58	130.48' S78°05'18"E
T59	25.00' N03°44'15"W
T60	54.72' S26°27'41"E
T61	34.65' S61°27'06"W

SURVEYOR'S CERTIFICATION

I, A. Dwain Weaver, under the laws of New Mexico, certify that I am a registered Land Surveyor, and that this plat was prepared by me or under my supervision, shows all easements of record, meets the minimum requirements for monumentation and surveys contained in the Albuquerque Subdivision Ordinance, and is true and accurate to the best of my knowledge and belief.

A. Dwain Weaver
A. Dwain Weaver
N.M.P.L.S. No. 6544 Bohannon-Huston Inc.
4125 Carlisle Blvd., N.E.
Albuquerque, NM 87107

State of New Mexico)
ss
County of Bernalillo)

The foregoing instrument was acknowledged before me this 5th day of February, 1985, by A. Dwain Weaver.

Notary Public

2/23/86

1 2 3 4 5 6 7 8 9 10 11 12
Z G Z Z 8 9 0 4 8 6

Job No. 41442

SHEET 3 OF 5 SHEETS

C28-132-3


C28-132-4

SUBDIVISION PLAT MAP FOR 88 00950
UNIT ONE
ACADEMY RIDGE EAST
WITHIN PROJECTED SECTIONS 27 and 28, T11N, R4E, N.M.P.M.
ALBUQUERQUE, NEW MEXICO
JANUARY 1985 SCALE 1"=50'



SURVEYOR'S CERTIFICATION

I, A. Dwain Weaver, under the laws of New Mexico, certify that I am a registered Land Surveyor, and that this plat was prepared by me or under my supervision, shows all easements of record, meets the minimum requirements for monumentation and surveys contained in the Albuquerque Subdivision Ordinance, and is true and accurate to the best of my knowledge and belief.

A. Dwain Weaver
N.M.P.L.S. No. 6544
State of New Mexico)
County of Bernalillo)
The foregoing instrument was acknowledged before me this day of February, 1985, by A. Dwain Weaver.

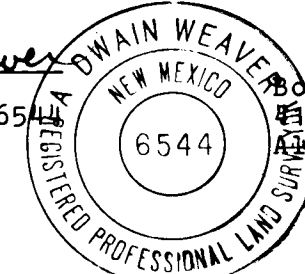

Notary Public
2/23/86

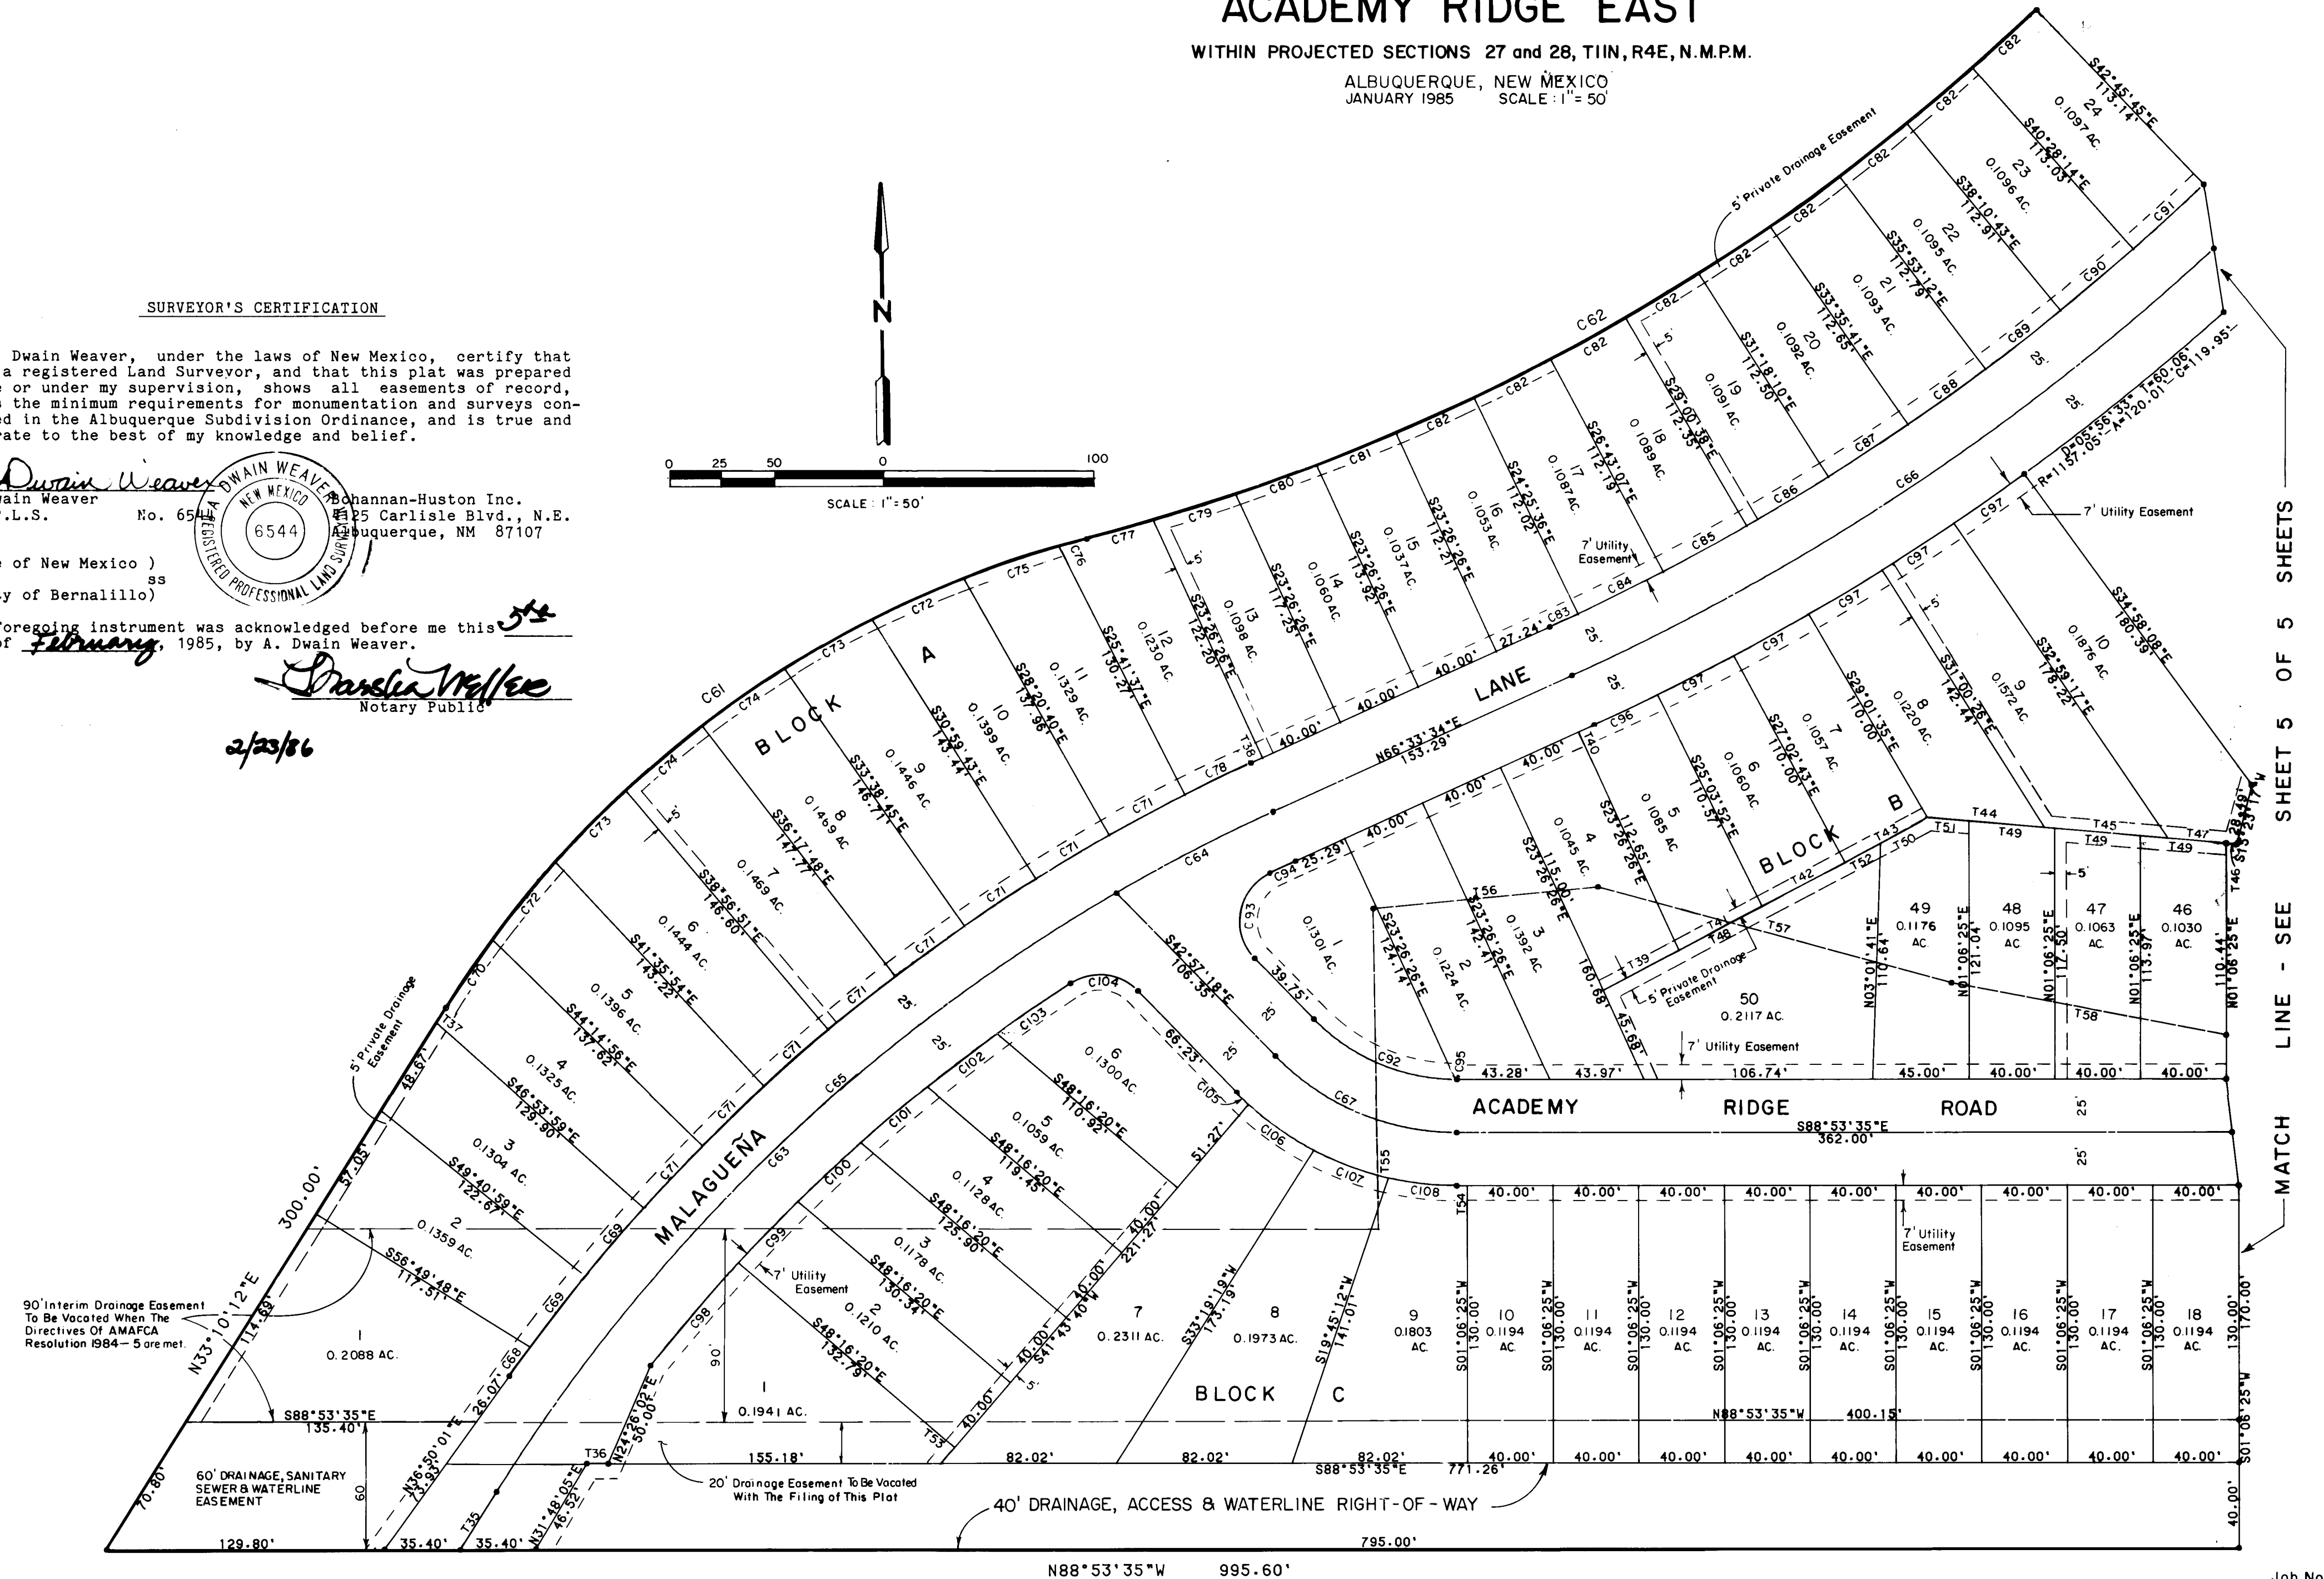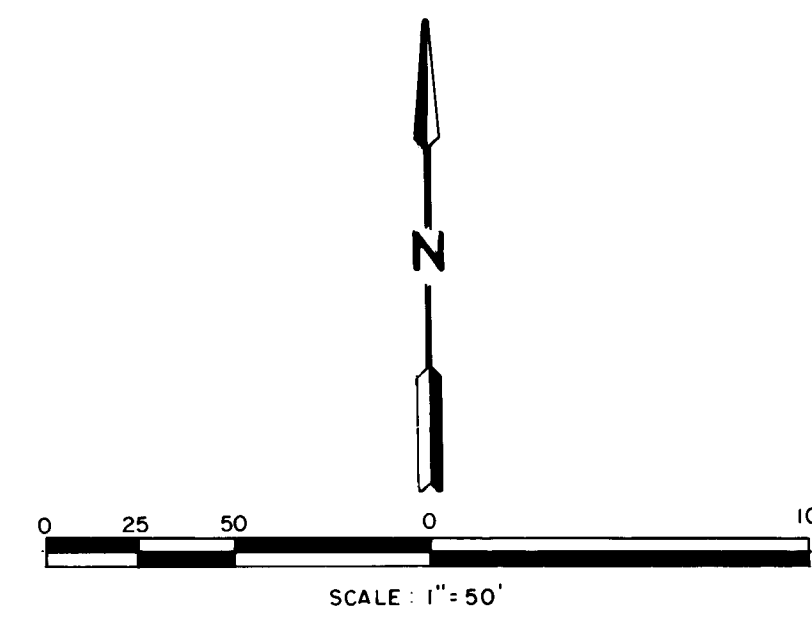

1 2 3 4 5 6 7 8 9 10 11 12
26 22 8 9 0 5 8 6


SHEET 4 OF 5 SHEETS

PROJECT NUMBER 2289 SHEET 5 OF 19

Job No. 41442



C28-132-5

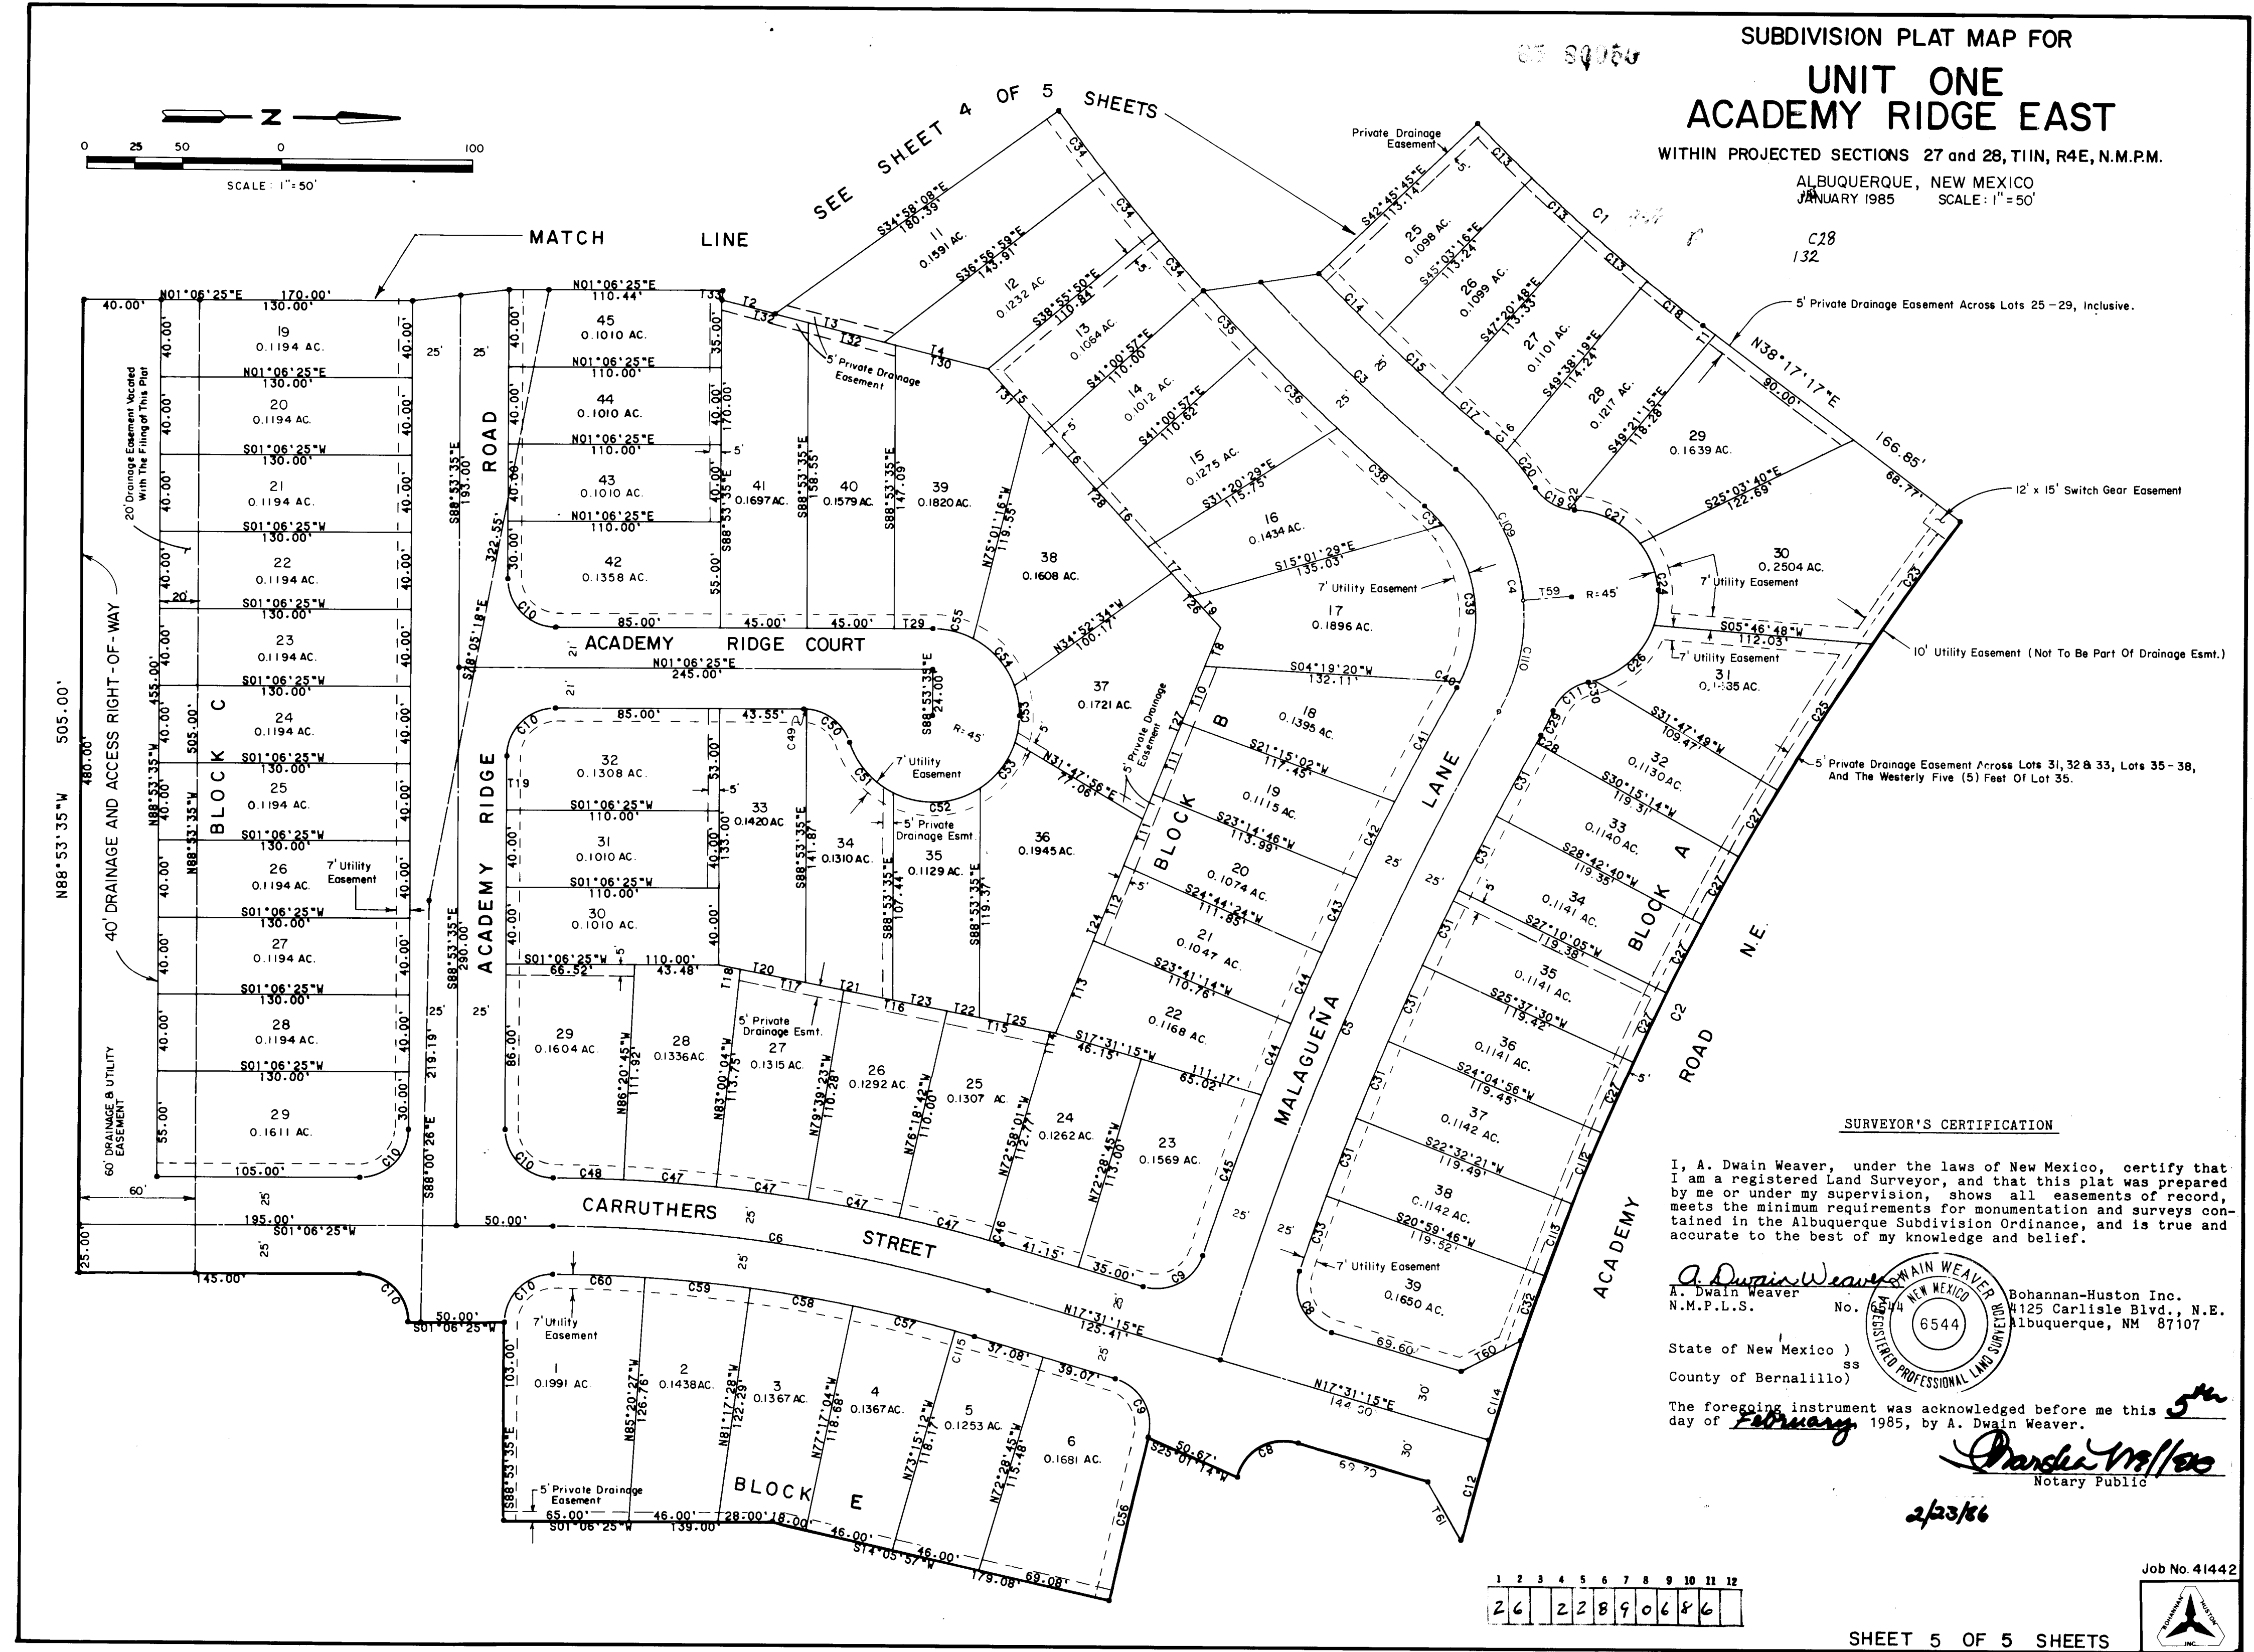

SUBDIVISION PLAT MAP FOR
**UNIT ONE
ACADEMY RIDGE EAST**
WITHIN PROJECTED SECTIONS 27 and 28, T11N, R4E, N.M.P.M.
ALBUQUERQUE, NEW MEXICO
JANUARY 1985 SCALE: 1"=50'

SURVEYOR'S CERTIFICATION

I, A. Dwain Weaver, under the laws of New Mexico, certify that I am a registered Land Surveyor, and that this plat was prepared by me or under my supervision, shows all easements of record, meets the minimum requirements for monumentation and surveys contained in the Albuquerque Subdivision Ordinance, and is true and accurate to the best of my knowledge and belief.

A. Dwain Weaver
A. Dwain Weaver
N.M.P.L.S. No. 6544
State of New Mexico)
County of Bernalillo) ss
The foregoing instrument was acknowledged before me this 24th day of February, 1985, by A. Dwain Weaver.

Charles M. [Signature]
Notary Public


2/23/86





1	2	3	4	5	6	7	8	9	10	11	12
2	6	2	2	8	9	0	6	8	6		

SHEET 5 OF 5 SHEETS

C28-132-5

PROJECT NUMBER 2289 SHEET 6 OF 19

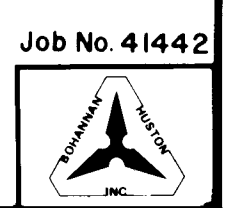


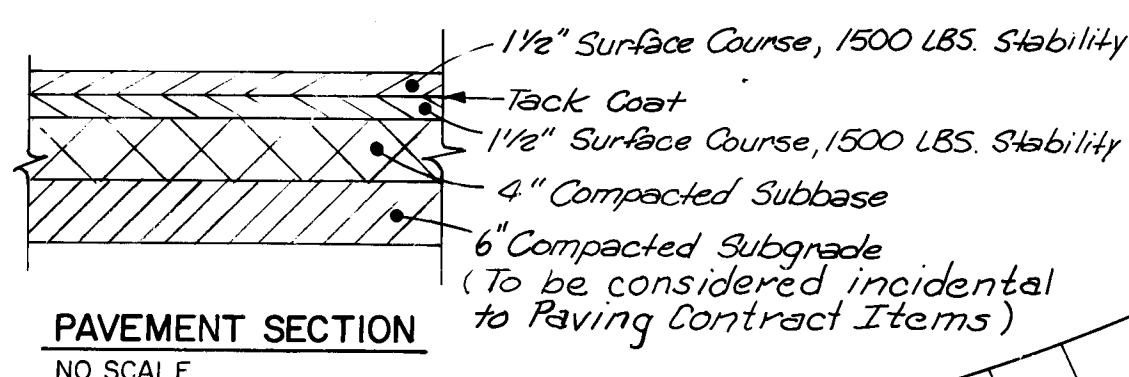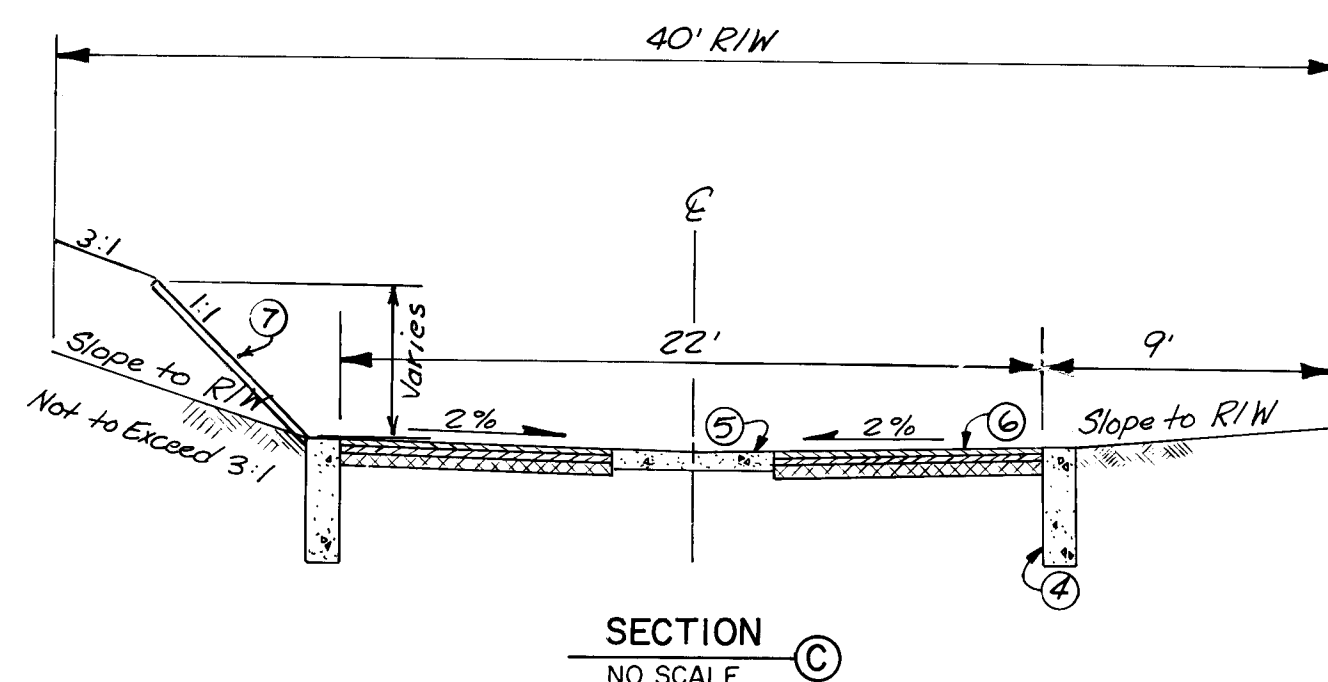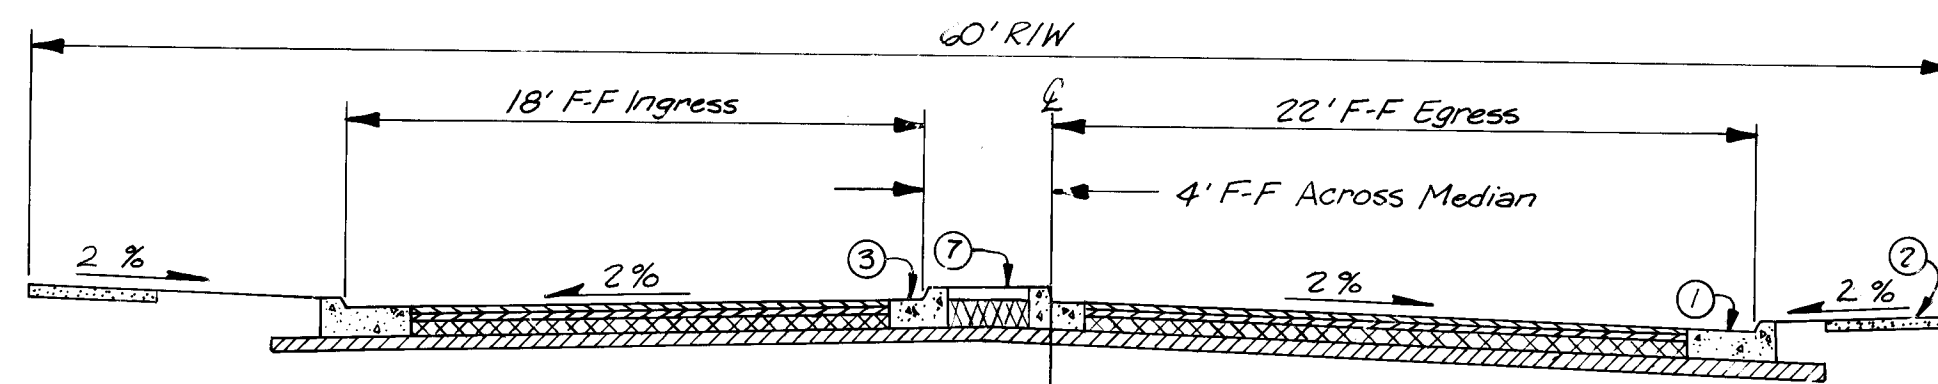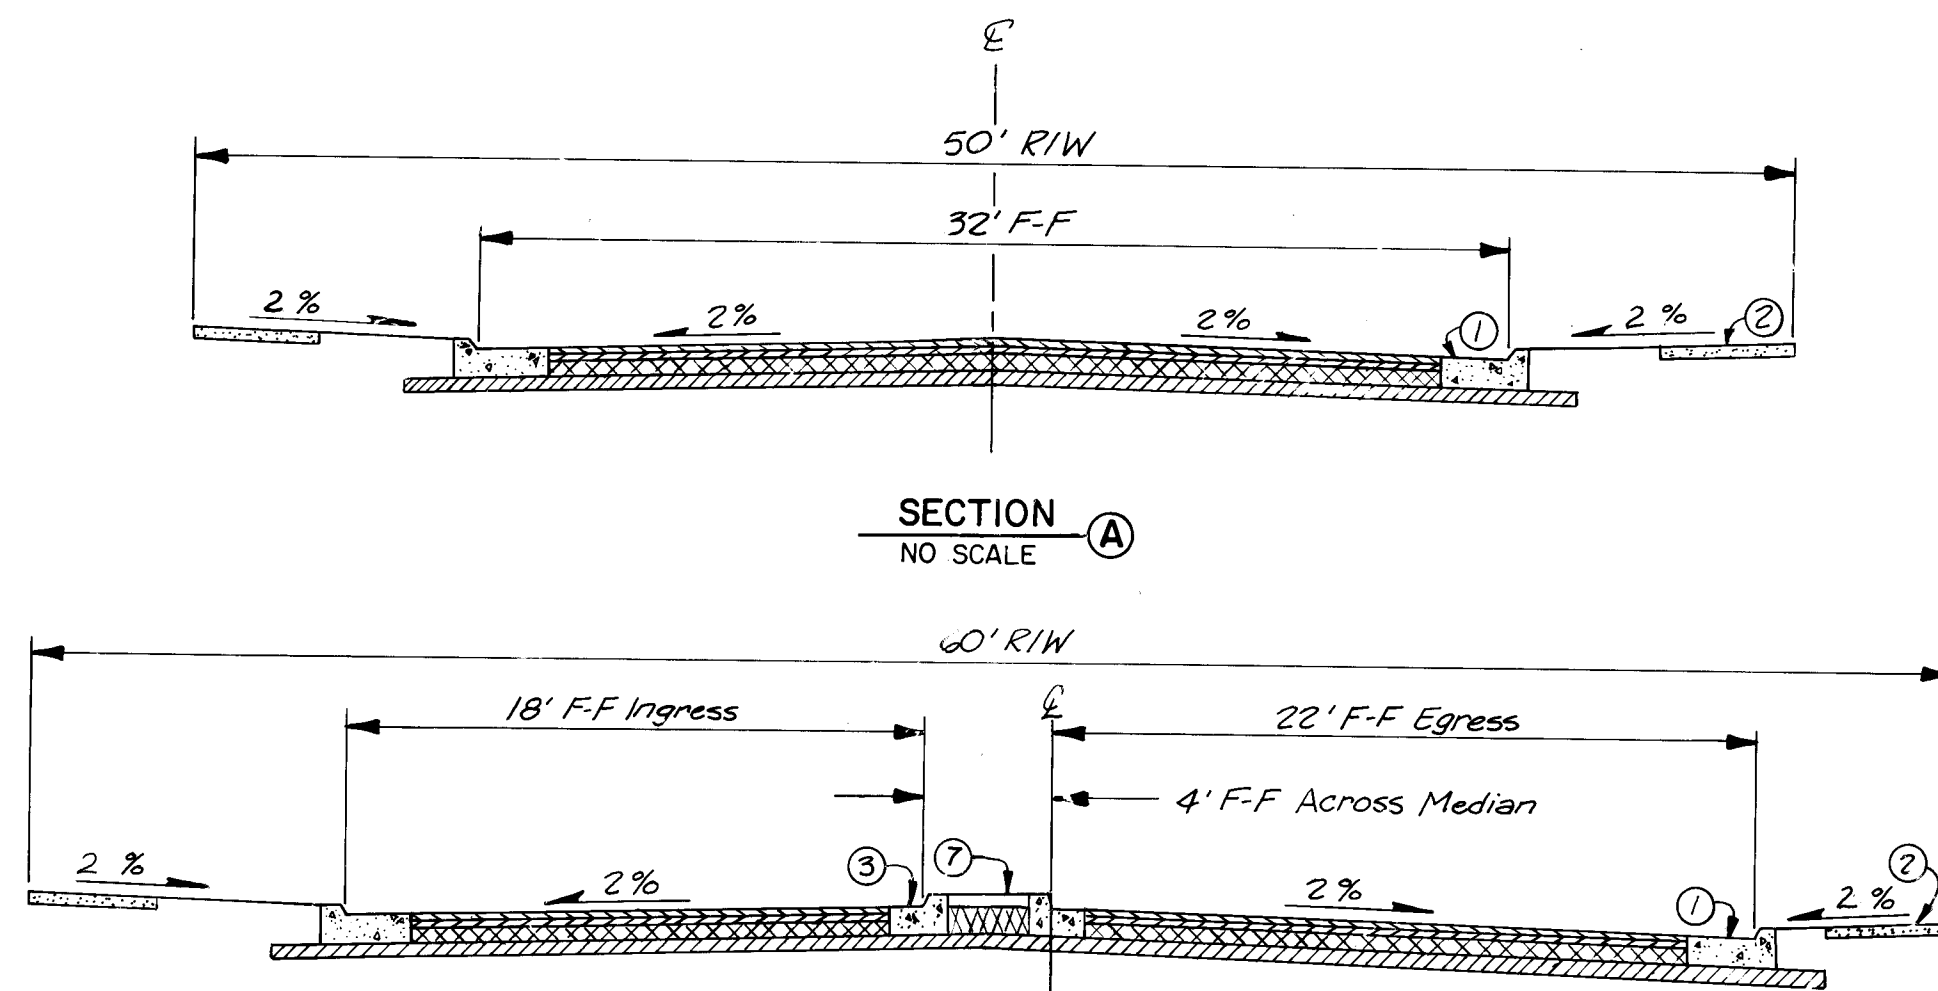

- NOTES:**
- ① Standard 8" Barrier Curb & Gutter
 - ② 4' Sidewalk, 4" Thick (Typ.)
 - ③ Standard 6" Median Curb & Gutter
 - ④ 6"x18" R.C.G. Header Curb
 - ⑤ Standard Alley Gutter
 - ⑥ All Streets & Alleys Use Standard Residential Pavement Section
 - ⑦ 4" thick Patterned Concrete, 4"x8" Running Bond Brick Baja Red Davis 160 or Engineer Approved Equal. See City of Albug. Public Works Contract, Section 346 for Specifications.

LEGEND



- PROPOSED MANHOLE
- PROPOSED WATER VALVE
- EXISTING MANHOLE
- EXISTING WATER VALVE
- ⊗ EXISTING STORM DRAIN MANHOLE
- ▨ SIDEWALK CULVERT AS PER COA STD. K-16-1

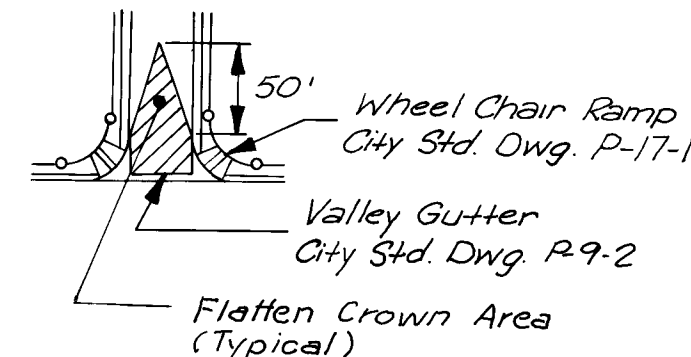

- ⊙ PROPOSED STORM DRAIN MANHOLE
- ▨ PROPOSED STORM DRAIN INLET

SCALE: 1"=100'



- NOTES:**
- 1.) All Curb Return Radii Shall Be 25' Unless Otherwise Specified.
 - 2.) Shaded Sidewalks and Only Wheel Chair Ramps to be Constructed Under Project 2289. Unshaded Sidewalks are not a Part of This Work Order.
 - 3.) All Phases of This Project are to be Coordinated with SAD-205.
 - 4.) The Contractor is to Field Verify All Existing Utility Locations and Notify the Engineer Immediately of any Discrepancies.

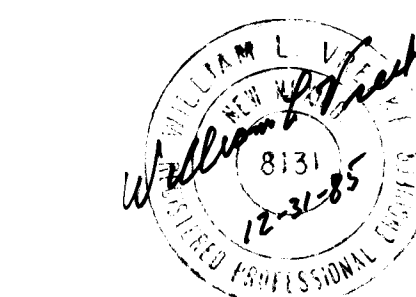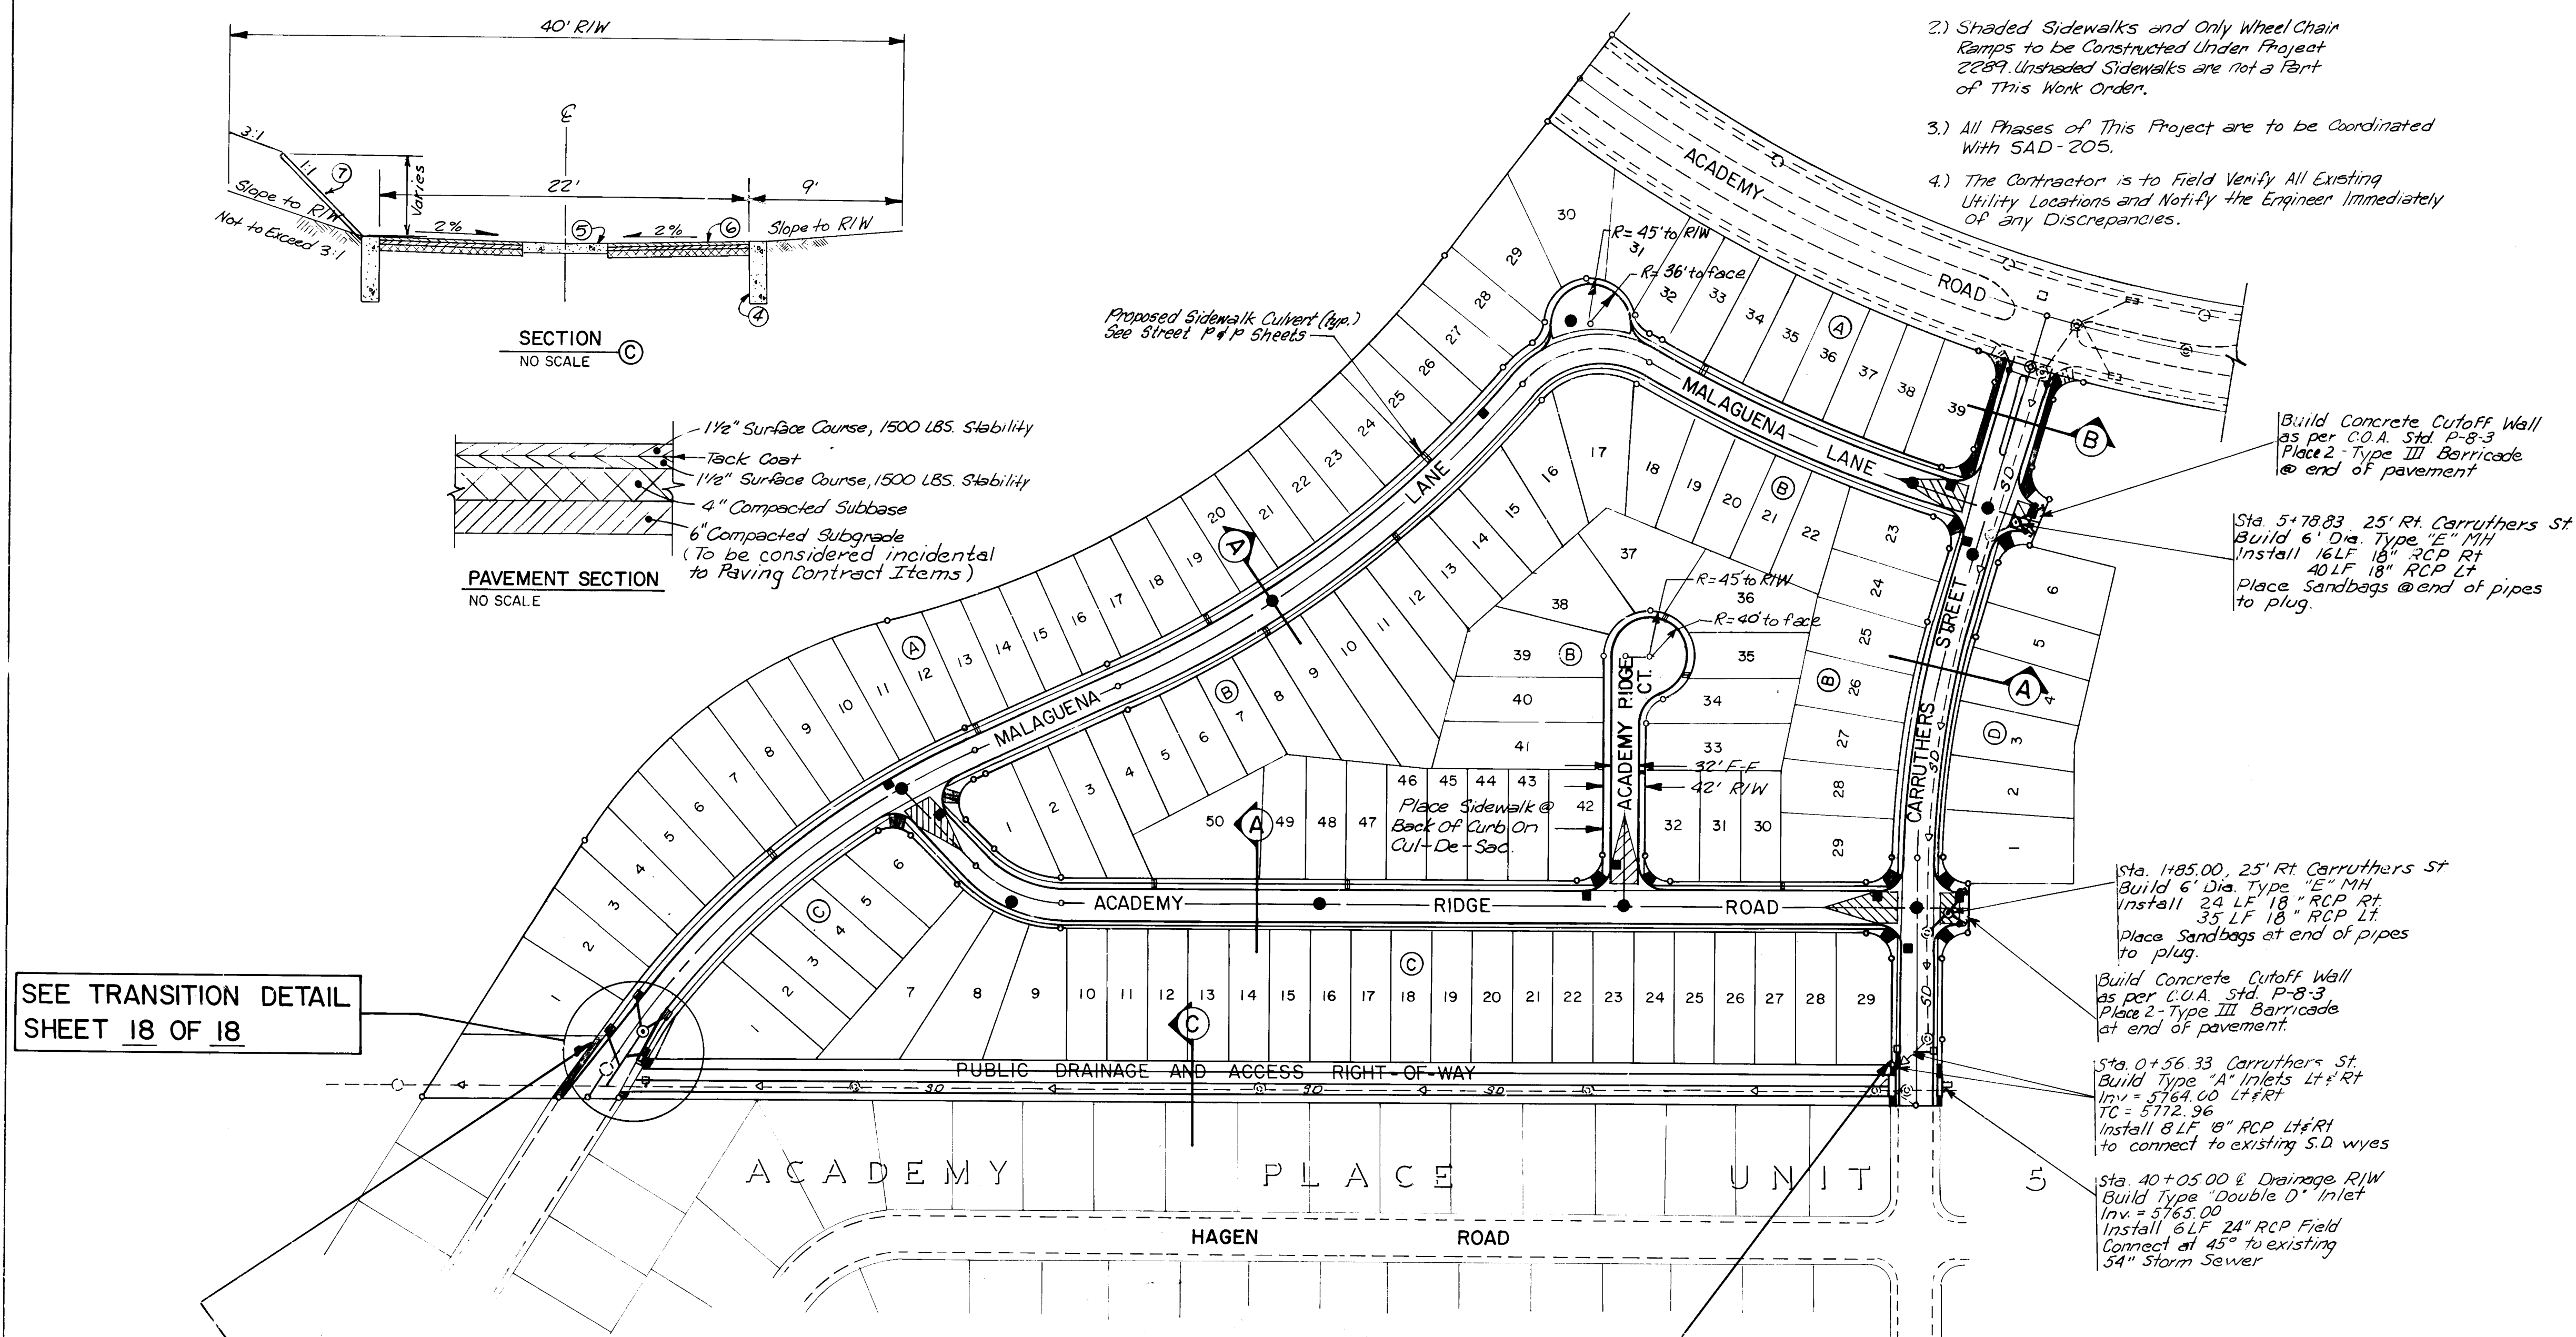

RECORD DRAWINGS
DATE 12/85

ENGINEER'S SEAL		SURVEY INFORMATION		BENCH MARKS		AS BUILT INFORMATION	
<							



CITY OF ALBUQUERQUE MUNICIPAL DEVELOPMENT DEPARTMENT ENGINEERING DIVISION					
TITLE: ACADEMY RIDGE EAST PHASE I STREET PAVING LAYOUT					
APPROVALS	ENGINEER	DATE	APPROVALS	ENGINEER	DATE
City Engineer	William G. Pugh	12/85	Liquid Waste	William G. Pugh	5/85
A.C.E. - Design	William G. Pugh	6/7/85	Traffic	William G. Pugh	5/85
Hydrology	William G. Pugh	5/85	Water	William G. Pugh	5/85
DRAWING NO	2289	MAP NO.	E-21	SHEET	7 OF 19

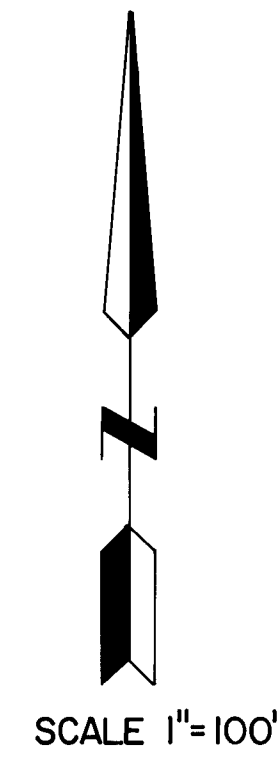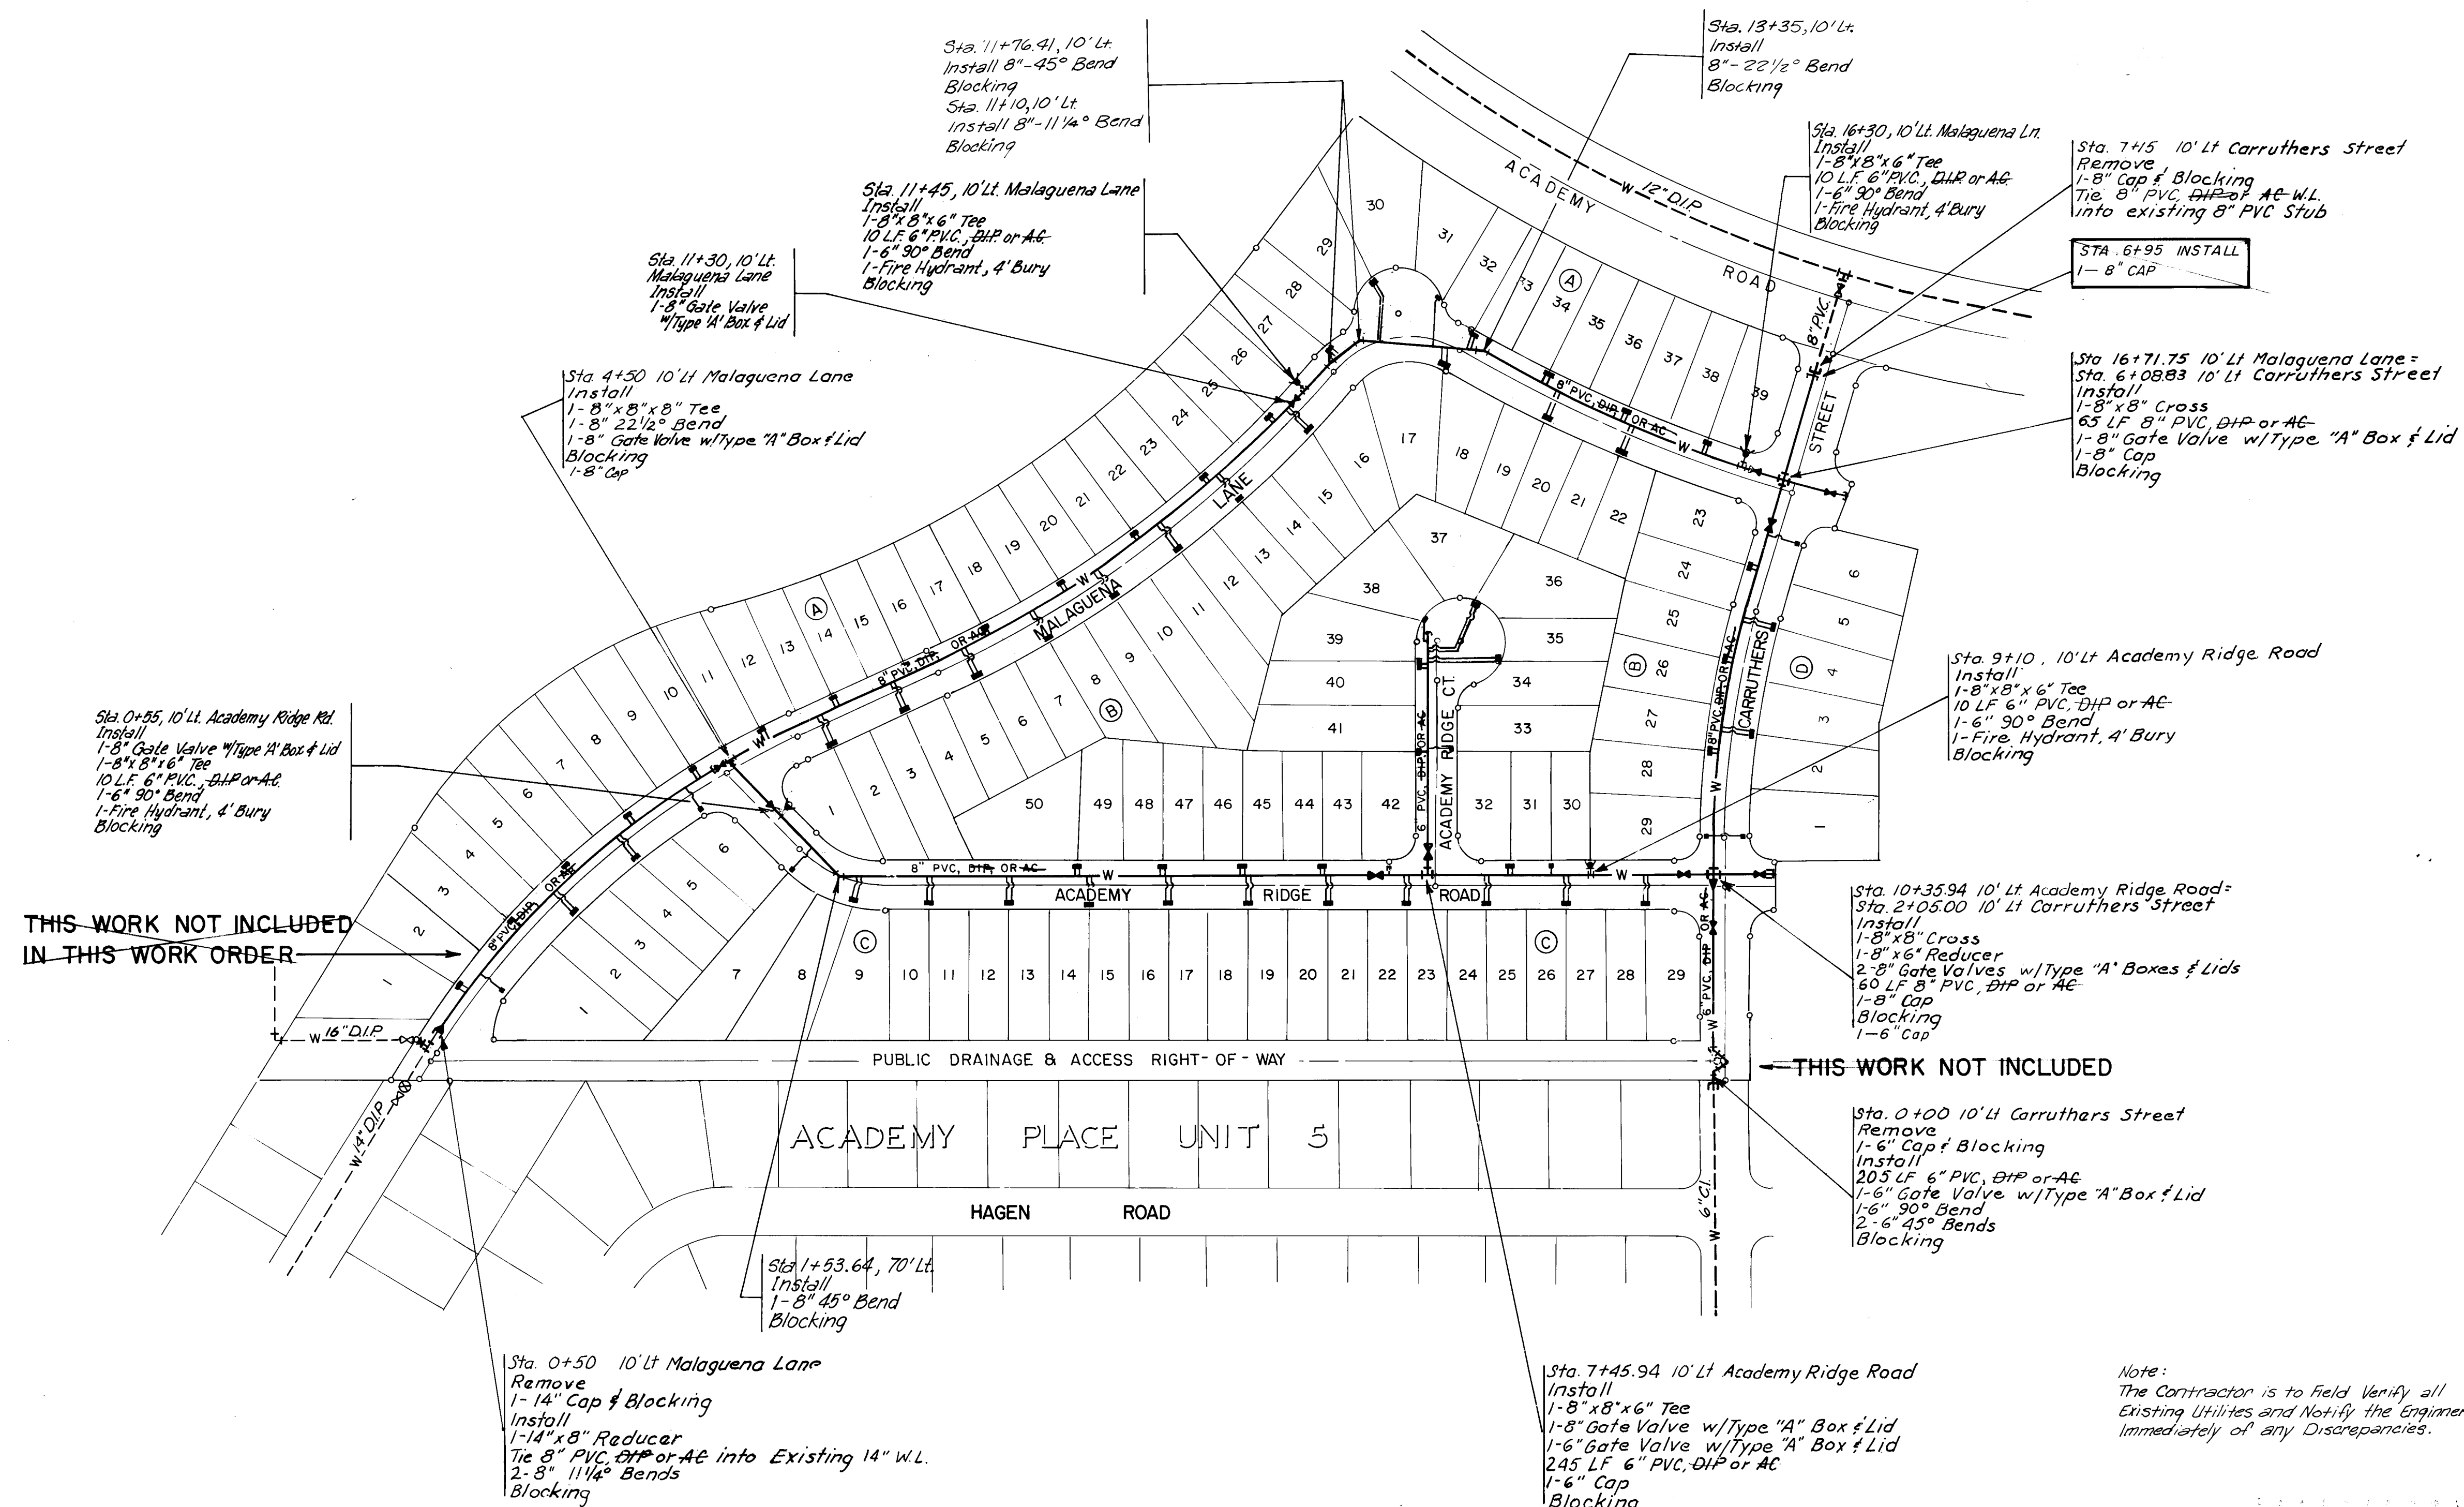[illegible]


TITLE: ACADEMY RIDGE EAST PHASE I
WATER DISTRIBUTION PLAN

APPROVALS	ENGINEER	DATE	APPROVALS	ENGINEER	DATE
City Engineer	<i>J. D. Wells</i>	6/24/85	Liquid Waste	<i>William G. Baker</i>	5/29/85
ACE - Design	<i>HL/ka</i>	6/17/85	Traffic	<i>N.A. Dowd</i>	5/28/85
ACE - Hydrology	<i>N.A. Baker</i>	5/29/85	Water	<i>William G. Baker</i>	5/29/85


DRAWING NO.	2289	MAP NO. E-21	SHEET 8 OF 19
----------------	------	-----------------	---------------

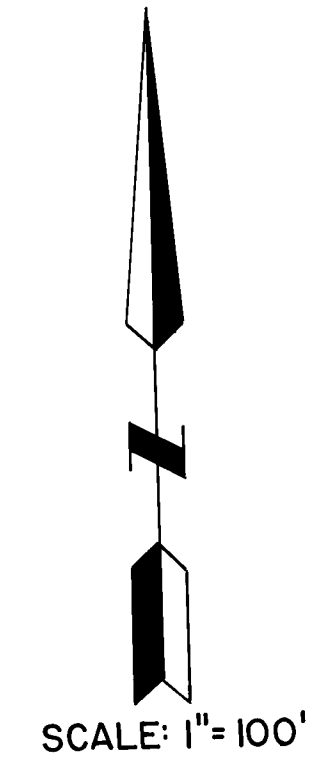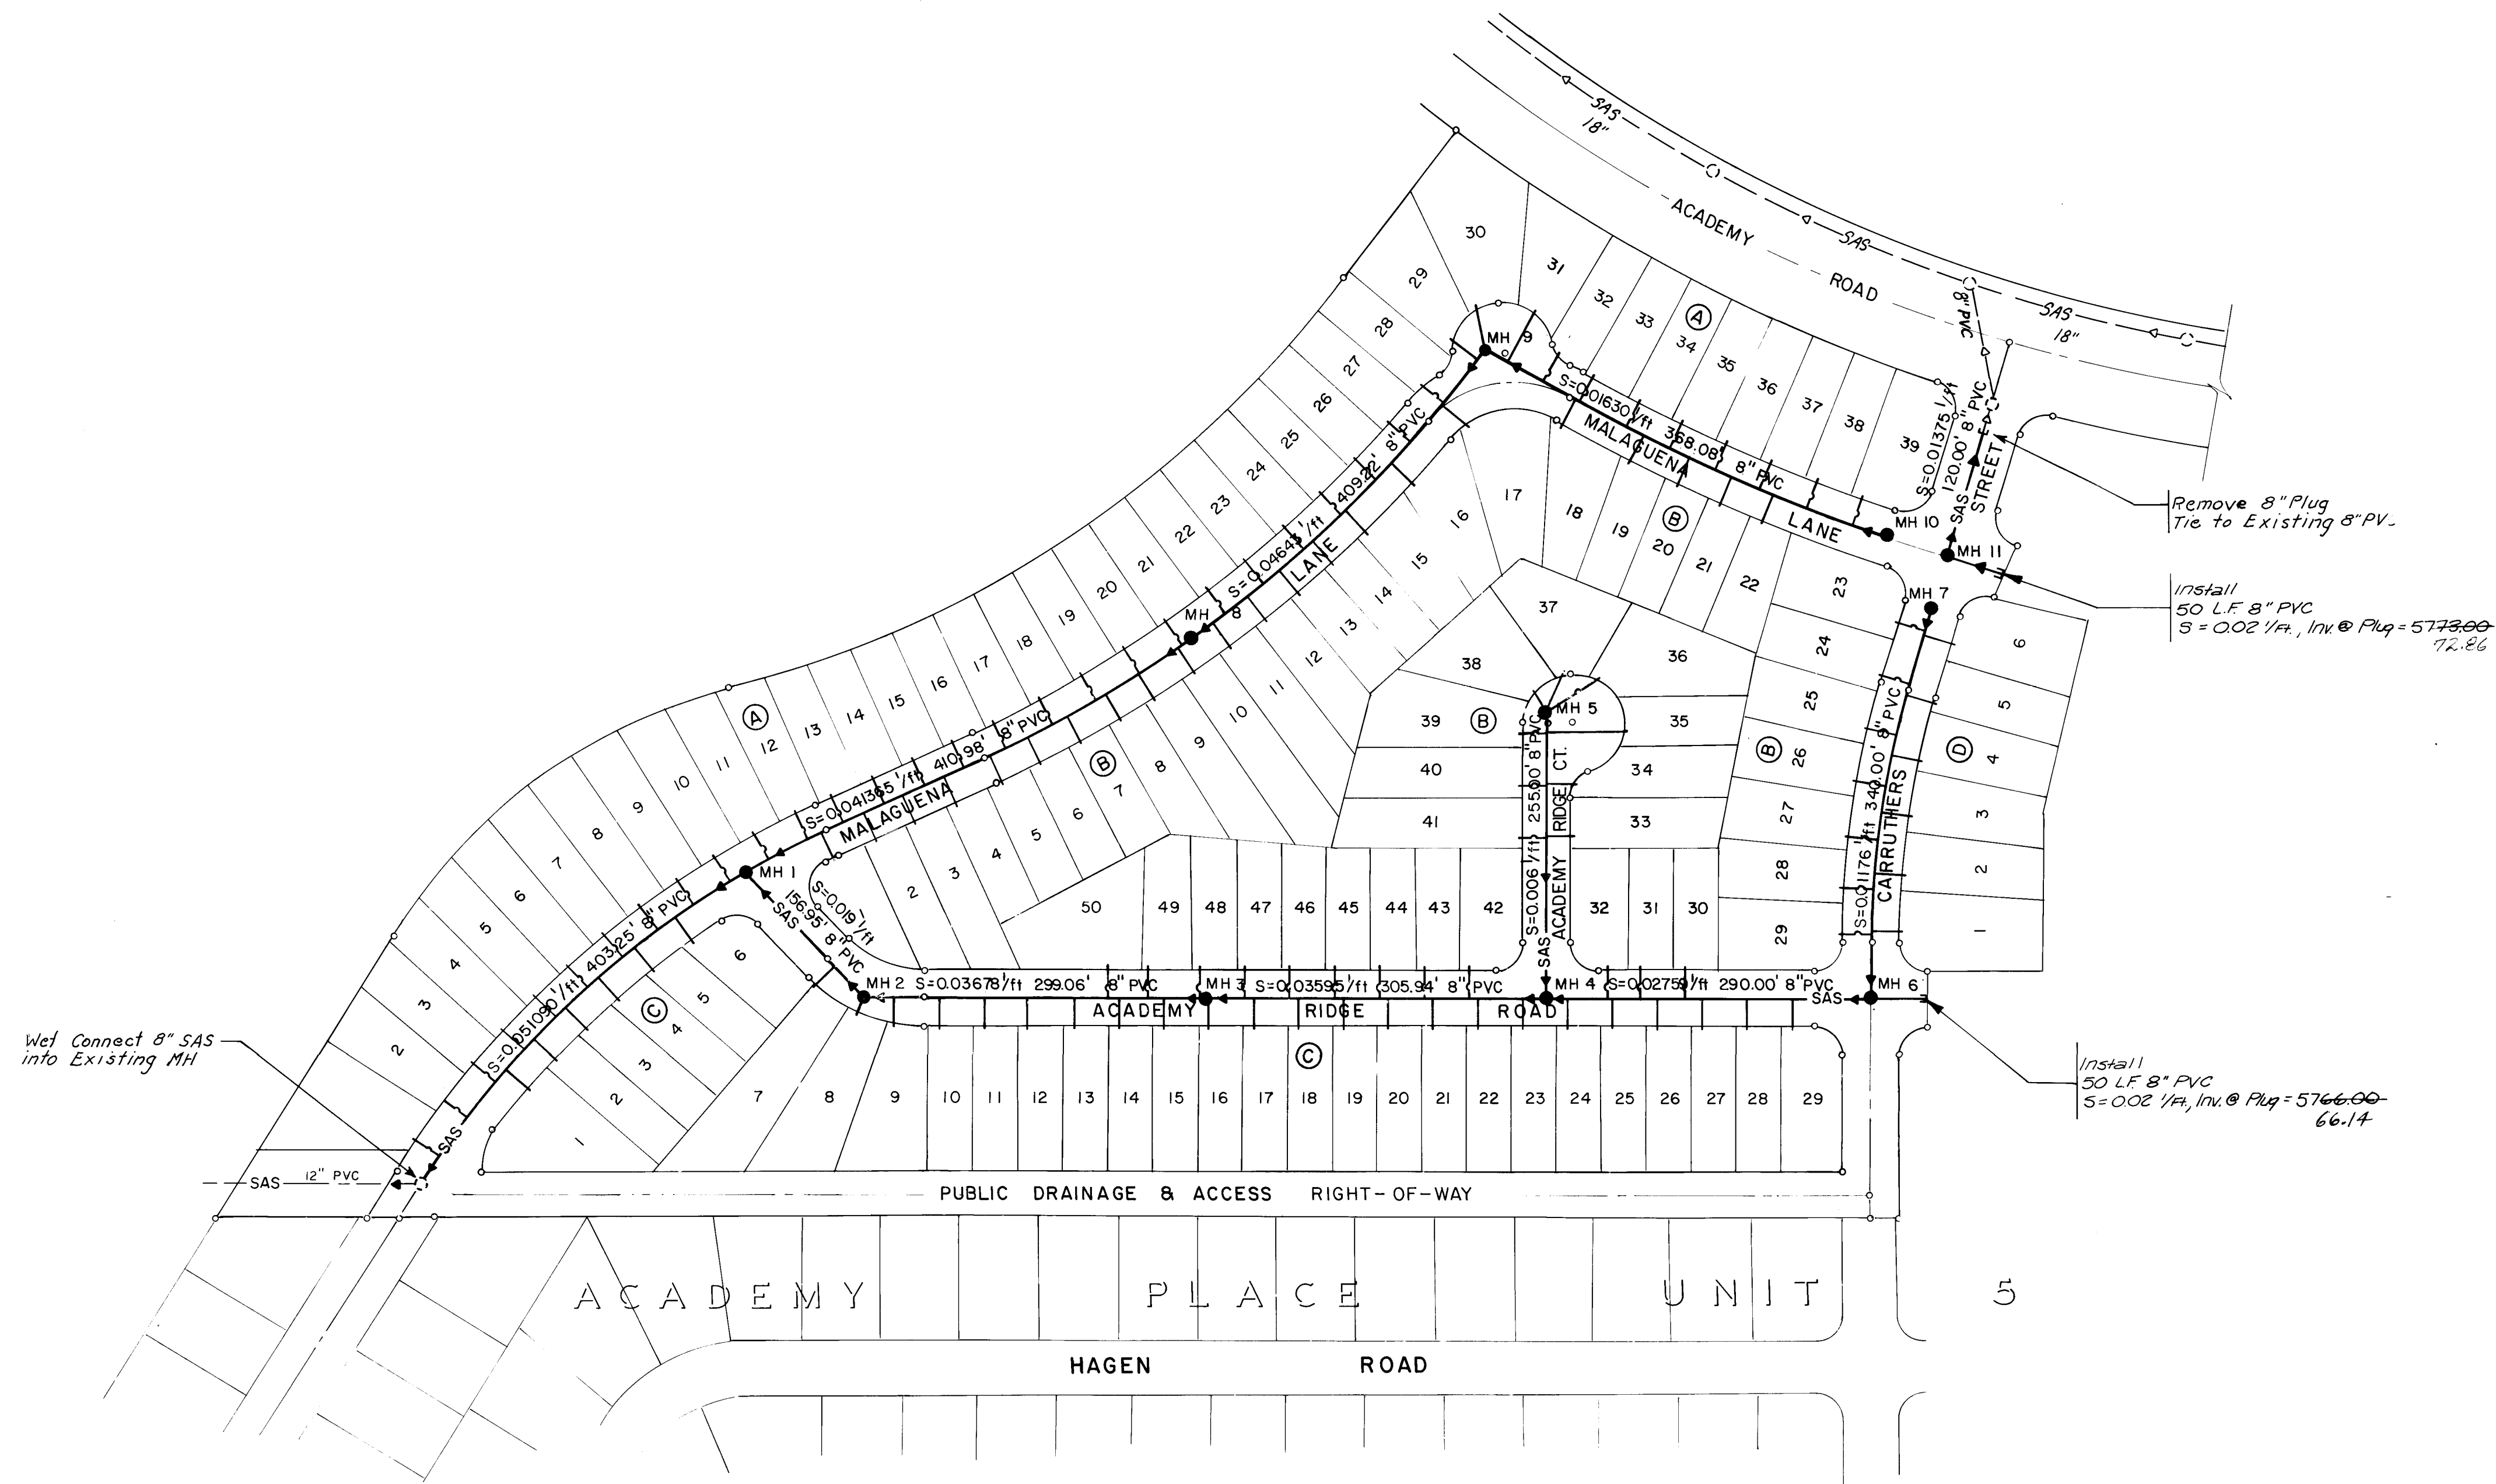


NOTE:
The Contractor is to Field Verify all Existing
Utility Locations and Notify the Engineer Immediately
of any Discrepancies.

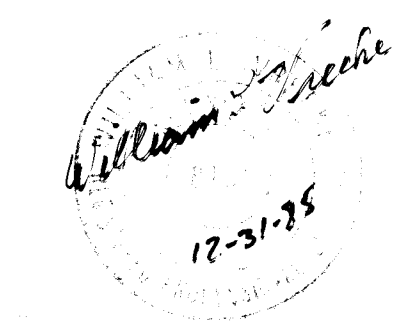

RECORD DRAWINGS
DATE 12/85

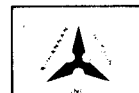 CITY OF ALBUQUERQUE MUNICIPAL DEVELOPMENT DEPARTMENT ENGINEERING DIVISION							
TITLE: ACADEMY RIDGE EAST PHASE I SANITARY SEWER PLAN							
APPROVALS	ENGINEER	DATE	APPROVALS	ENGINEER	DATE		
City Engineer	<i>(Signature)</i>	6/2/85	Liquid Waste	<i>William J. Steele</i>	5/29/85		
A.C.E. - Design	<i>NA</i>	6/17/85	Traffic	<i>NA</i>	5/29/85		
Hydrology	<i>NA</i>	6/29/85	Water	<i>William J. Steele</i>	5/29/85		
DRAWING NO.	2289		MAP NO.	E-21		SHEET	9 OF 19

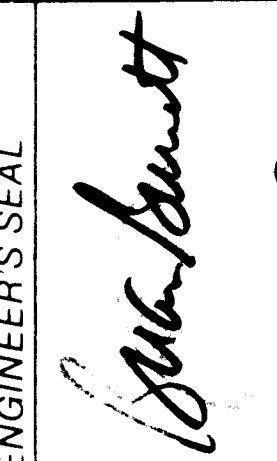ENGINEER'S SEAL		SURVEY INFORMATION		BENCH MARKS		AS BUILT INFORMATION						
 5-2385	KLD	BY	DATE	NO.	FIELD NOTES	CONTRACTOR	DATE					
		DESIGNED BY		KLD		DATE		MICRO-FILM INFORMATION				
		DRAWN BY		LAD		DATE		RECORDED BY				
		CHECKED BY		KLD		DATE		NO.				

EARTHWORK SPECIFICATIONS

Site Clearing: All rubbish and trash which may exist on the site shall be removed and wasted.

Site Grubbing: Existing vegetation shall be stripped from the entire area, and surface soils removed to a minimum depth of six (6) inches. Removed soils can be stockpiled for use in general site grading outside of building pads and pavement areas.

Prewetting: The entire development area should be prewetted to a minimum depth of five (5) feet. Several shallow depth (five feet minimum) test borings should be made periodically and under close observation and advisement by the Soils Engineer to determine that the deep prewetting of subsurface soils is accomplished. Special attention should be given to the areas in the vicinities of Test Holes 4, 5, 7 through 13, 18, 20, 21, 28 and 29 on Tract B and in the vicinities of Test Holes 2, 7, 10, 11 and 13 through 19 on Tract B-1.

Proof Rolling: Once prewetting has been accomplished the entire area should be proofrolled with a minimum 10 ton vibratory roller to help densify any loose subsurface soils. The roller should make a minimum of ten passes each in two directions perpendicular to one another, with a minimum 25% overlap of the roller width on each pass. Special attention should be given to the areas in the vicinities of Test Holes 4, 5, 7 through 13, 18, 20, 21, 28 and 29 on Tract B and in the vicinities of Test Holes 2, 7, 10, 11 and 13 through 19 on Tract B-1.

Building Pads: All building pads shall be composed either entirely of natural cut ground or entirely of compacted, engineered fill of uniform thickness. In the building areas where both fill and cut are encountered, the natural ground shall be overcut for a vertical depth of at least one (1) foot below finished pad grade. Both the fill and overcut natural ground section shall be compacted as follows:

Subgrade Preparation: The exposed cut ground or subgrade surface shall be scarified to a minimum depth of 8 inches, moistened thoroughly with excess optimum moisture (+2%), and compacted to a minimum of 90 percent of Modified Proctor Density (ASTM D-1557). Any slopes which are steeper than 5 horizontal to 1 vertical shall be stepped or benched prior to fill placement.

Approved Fill Soils: On-site granular soils having no stones larger than 4 inches in diameter and with a Plasticity Index not exceeding 10 may be submitted to the Soils Engineer for approval for use as engineered fill soils. For the most part, on-site soils are expected to be acceptable.

Fill Placement: Approved fill soils shall be thoroughly moistened with excess optimum moisture (+2%), then placed and spread in lifts not to exceed 8 inches in loose thickness, with each lift being compacted to a minimum of 95 percent of Modified Proctor Density in all areas.

Weather Constraints: During construction, low areas shall be protected from excessive surface water and ponding. The contractor shall have adequate equipment available to promptly remove or divert surface water which might accumulate.

If earthwork is interrupted by surface water intrusions, fill operations shall not be resumed until the Soils Engineer accepts the moisture content and density of the natural ground or previously placed fill soils.

No fill soils shall be placed, spread or rolled while the soils are frozen or thawing or during other unfavorable weather conditions.

Soils Engineer and Quality Control: The owner or contractor shall employ the services of a Professional Engineer (Geotechnical Engineer) to supervise all prewetting and controlled earthwork. Testing of compacted fill should include density and moisture content determinations by nuclear methods (ASTM D-2922).

A sufficient number of tests shall be made during each day's operations on each lift of fill, as necessary, to insure adherence to project specifications. In addition, tests of fill soils shall be made at the following minimum rates:



- One (1) field density test for each 1000 square yards of subgrade prior to fill placement.
- One (1) field density test for each 350 cubic yards of fill placed or each layer of fill in each work area.

When tests indicate that the density of any layer of fill or portion thereof is below the required density, the particular layer or portion thereof shall be removed and replaced with adjustments in soil moisture as necessary until the required density is obtained.


Notification by Contractor: The contractor shall notify the Geotechnical Engineer at least 2 days prior to beginning earthwork operations or prior to resuming operations after stoppage.

Daily Report: Daily reports of field density tests shall be submitted by the Soil Engineer to the contractor or developer's field engineer.

- LEGEND**
- Existing Masonry Wall
 - (#3) Masonry Garden Wall (By Others)
 - Masonry Retaining Wall (See Detail Sht. 12)
 - Concrete Private Drainage Rindown (See Detail Sht. 12)
 - Slump Block Wall (By Others)
 - Existing Contours
 - Swale or Flow Patterns

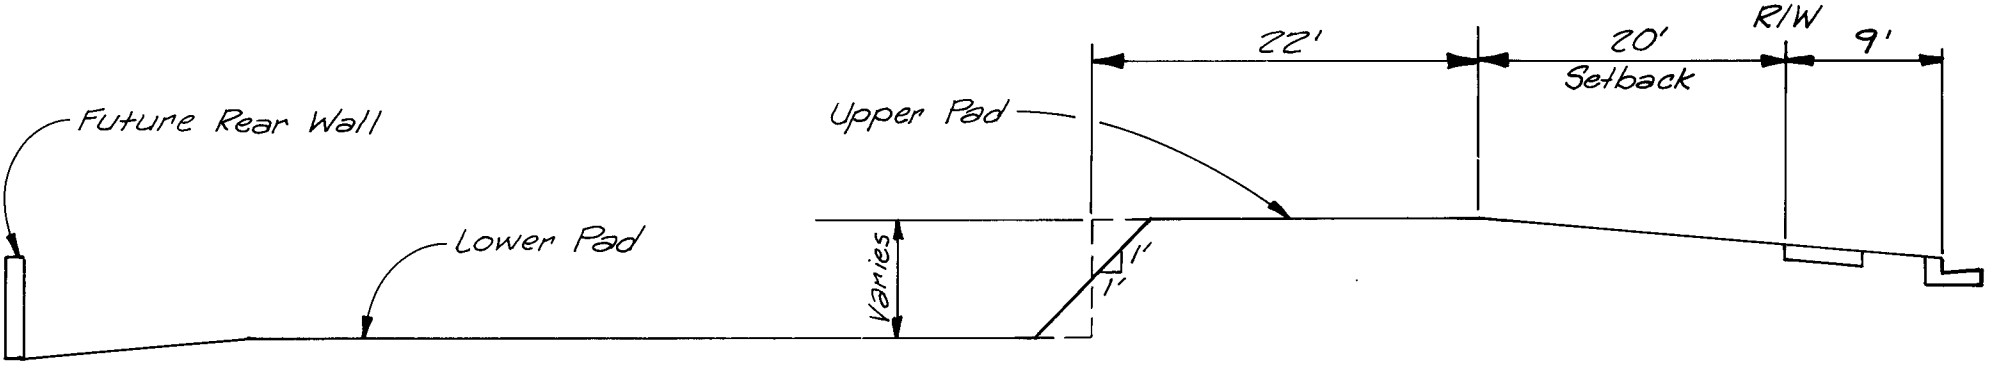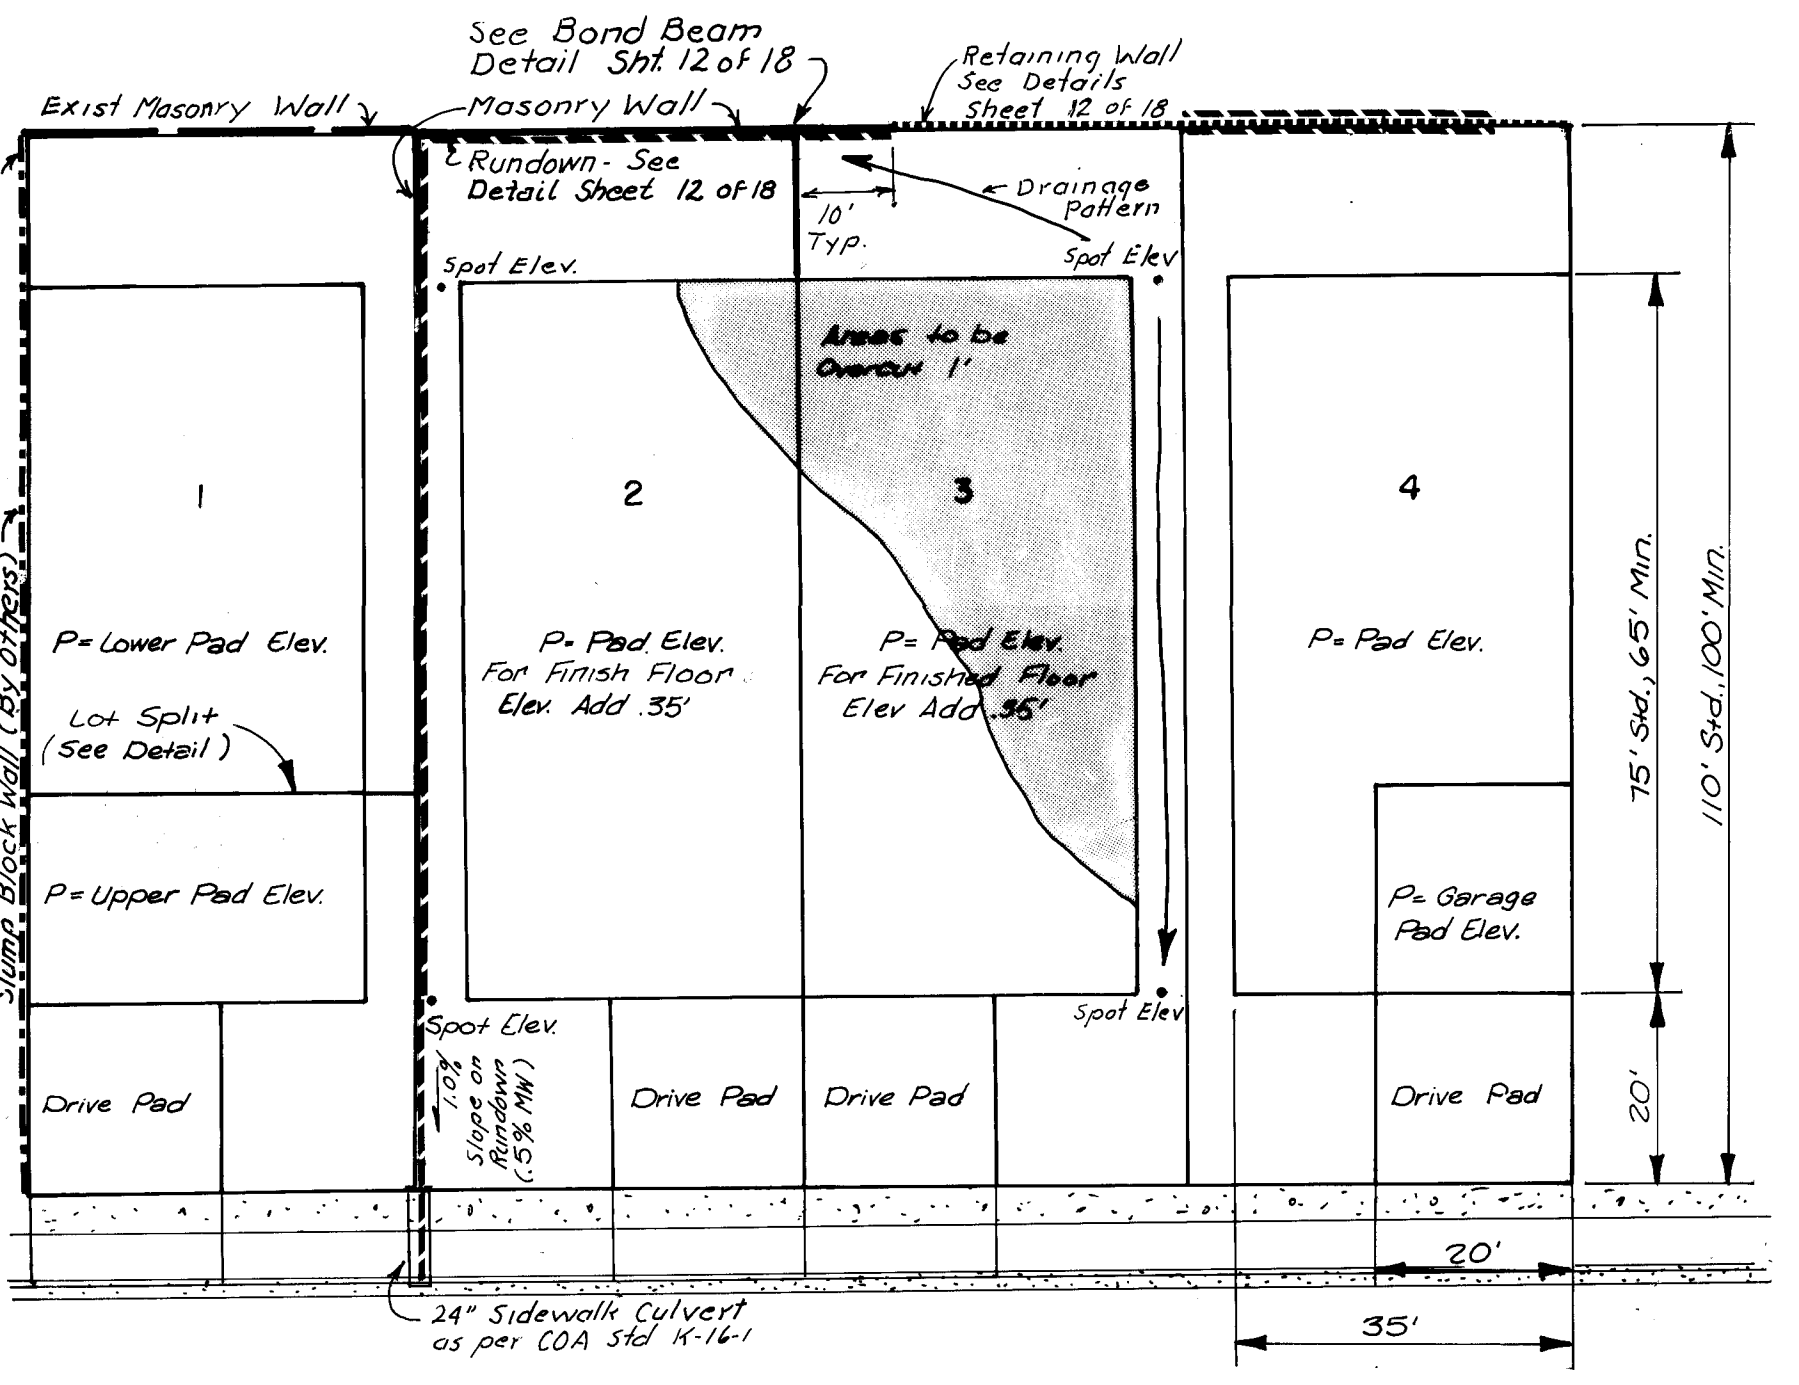


LOT SPLIT DETAIL
 NO SCALE

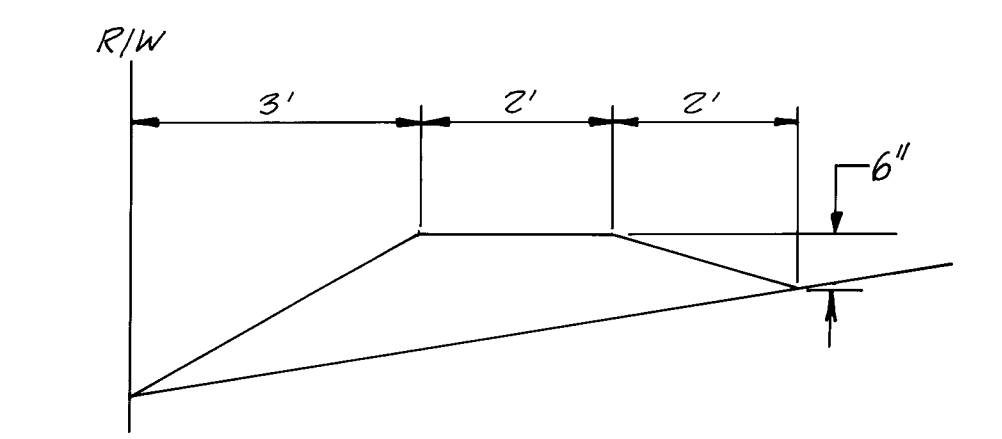

EROSION CONTROL BERM
 (TO BE PLACED ACROSS EACH LOT @ STREET SIDE)
 NO SCALE

SCALE 1"=50'

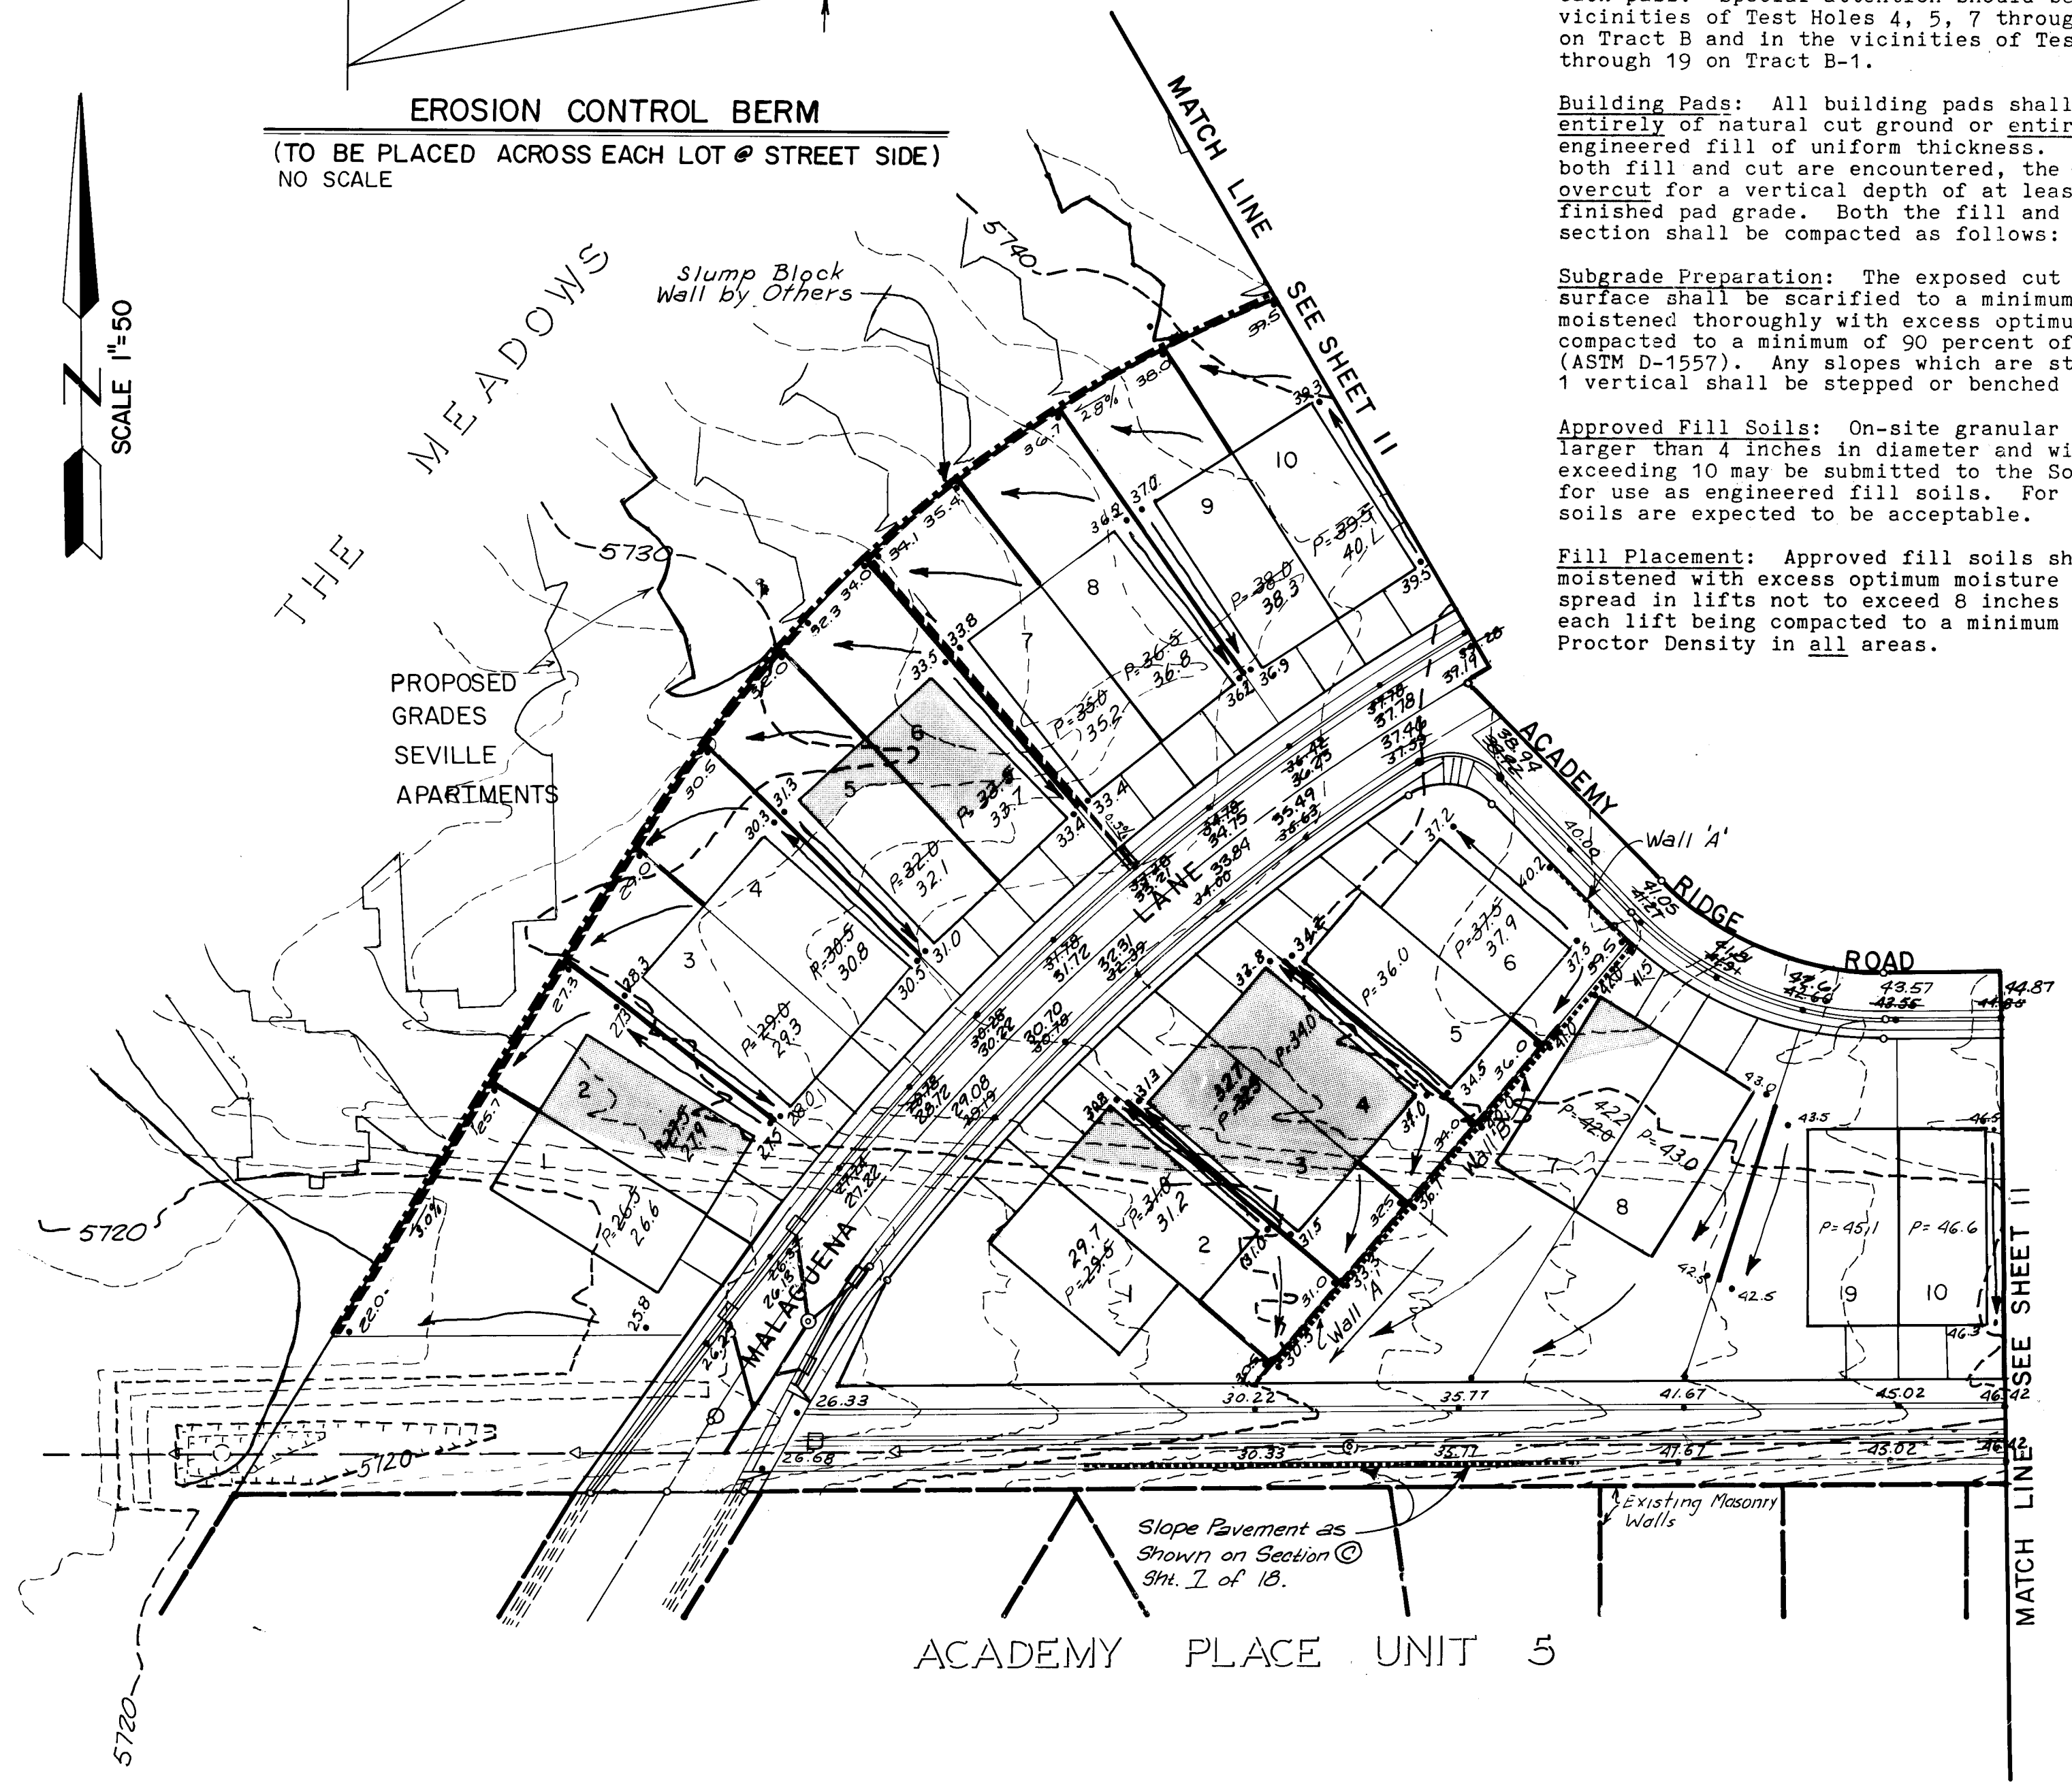

CITY OF ALBUQUERQUE
 MUNICIPAL DEVELOPMENT DEPARTMENT
 ENGINEERING DIVISION

TITLE: ACADEMY RIDGE EAST PHASE I GRADING PLAN

APPROVALS	ENGINEER	DATE	APPROVALS	ENGINEER	DATE
CITY Engineer	5/27/85	5/27/85	Liquid Waste	NA	5/30/85
A C E - Design	5/27/85	5/27/85	Traffic	NA	5/30/85
Hydrology	5/27/85	5/27/85	Water	NA	5/30/85

DRAWING NO. 2289 **MAP NO.** E-21 **SHEET** 10 **OF** 19



FHWA Region No.	NEW MEXICO	SHEET NO.	TOTAL SHEETS
6			

AS-BUILT INFORMATION		BENCH MARKS		SURVEY INFORMATION		ENGINEER'S SEAL		REVISIONS		DESIGN		APPROVALS		ENGINEER		DATE	
CONTRACTOR: <i>KLJ Inc.</i>		ACS Brass Cap "6-E22" Elev 5934.53		DATE: <i>11/15</i>		BY: <i>KLJ Inc.</i>		KLD: <i>KLJ</i>		KLD: <i>KLJ</i>		NO. DATE		NO. DATE		NO. DATE	
STAKED BY: <i>KLJ Inc.</i>		Location is 12 miles East of the intersection of Academy Road N.E. & Eubank Blvd. N.E.		DATE: <i>11/15</i>		BY: <i>KLJ Inc.</i>		KLD: <i>KLJ</i>		KLD: <i>KLJ</i>		NO. DATE		NO. DATE		NO. DATE	
FIELD CHECKED BY: <i>KLJ Inc.</i>		Station is then 375 South on the South Rim of the Bear Canyon Tributary		DATE: <i>11/15</i>		BY: <i>KLJ Inc.</i>		KLD: <i>KLJ</i>		KLD: <i>KLJ</i>		NO. DATE		NO. DATE		NO. DATE	
CORRECTED BY: <i>KLJ Inc.</i>				DATE: <i>11/15</i>		BY: <i>KLJ Inc.</i>		KLD: <i>KLJ</i>		KLD: <i>KLJ</i>		NO. DATE		NO. DATE		NO. DATE	
MICRO-FILM INFORMATION				DATE: <i>11/15</i>		BY: <i>KLJ Inc.</i>		KLD: <i>KLJ</i>		KLD: <i>KLJ</i>		NO. DATE		NO. DATE		NO. DATE	
RECORDED BY: <i>KLJ Inc.</i>				DATE: <i>11/15</i>		BY: <i>KLJ Inc.</i>		KLD: <i>KLJ</i>		KLD: <i>KLJ</i>		NO. DATE		NO. DATE		NO. DATE	

RECORD DRAWINGS
DATE *12/85*


12-31-85

CITY OF ALBUQUERQUE
MUNICIPAL DEVELOPMENT DEPARTMENT
ENGINEERING DIVISION


TITLE: ACADEMY RIDGE EAST PHASE I
GRADING PLAN

APPROVALS	ENGINEER	DATE	APPROVALS	ENGINEER	DATE
City Engineer	<i>[Signature]</i>	<i>12/85</i>	Liquid Waste	<i>NA</i>	<i>5/2/85</i>
A/C-E Design	<i>[Signature]</i>	<i>6/1/85</i>	Traffic	<i>NA</i>	<i>12/85</i>
- Hydrology	<i>[Signature]</i>	<i>5/2/85</i>	Water	<i>NA</i>	<i>5/2/85</i>

DRAWING NO. 2289 MAP NO. E-21 SHEET 11 OF 19

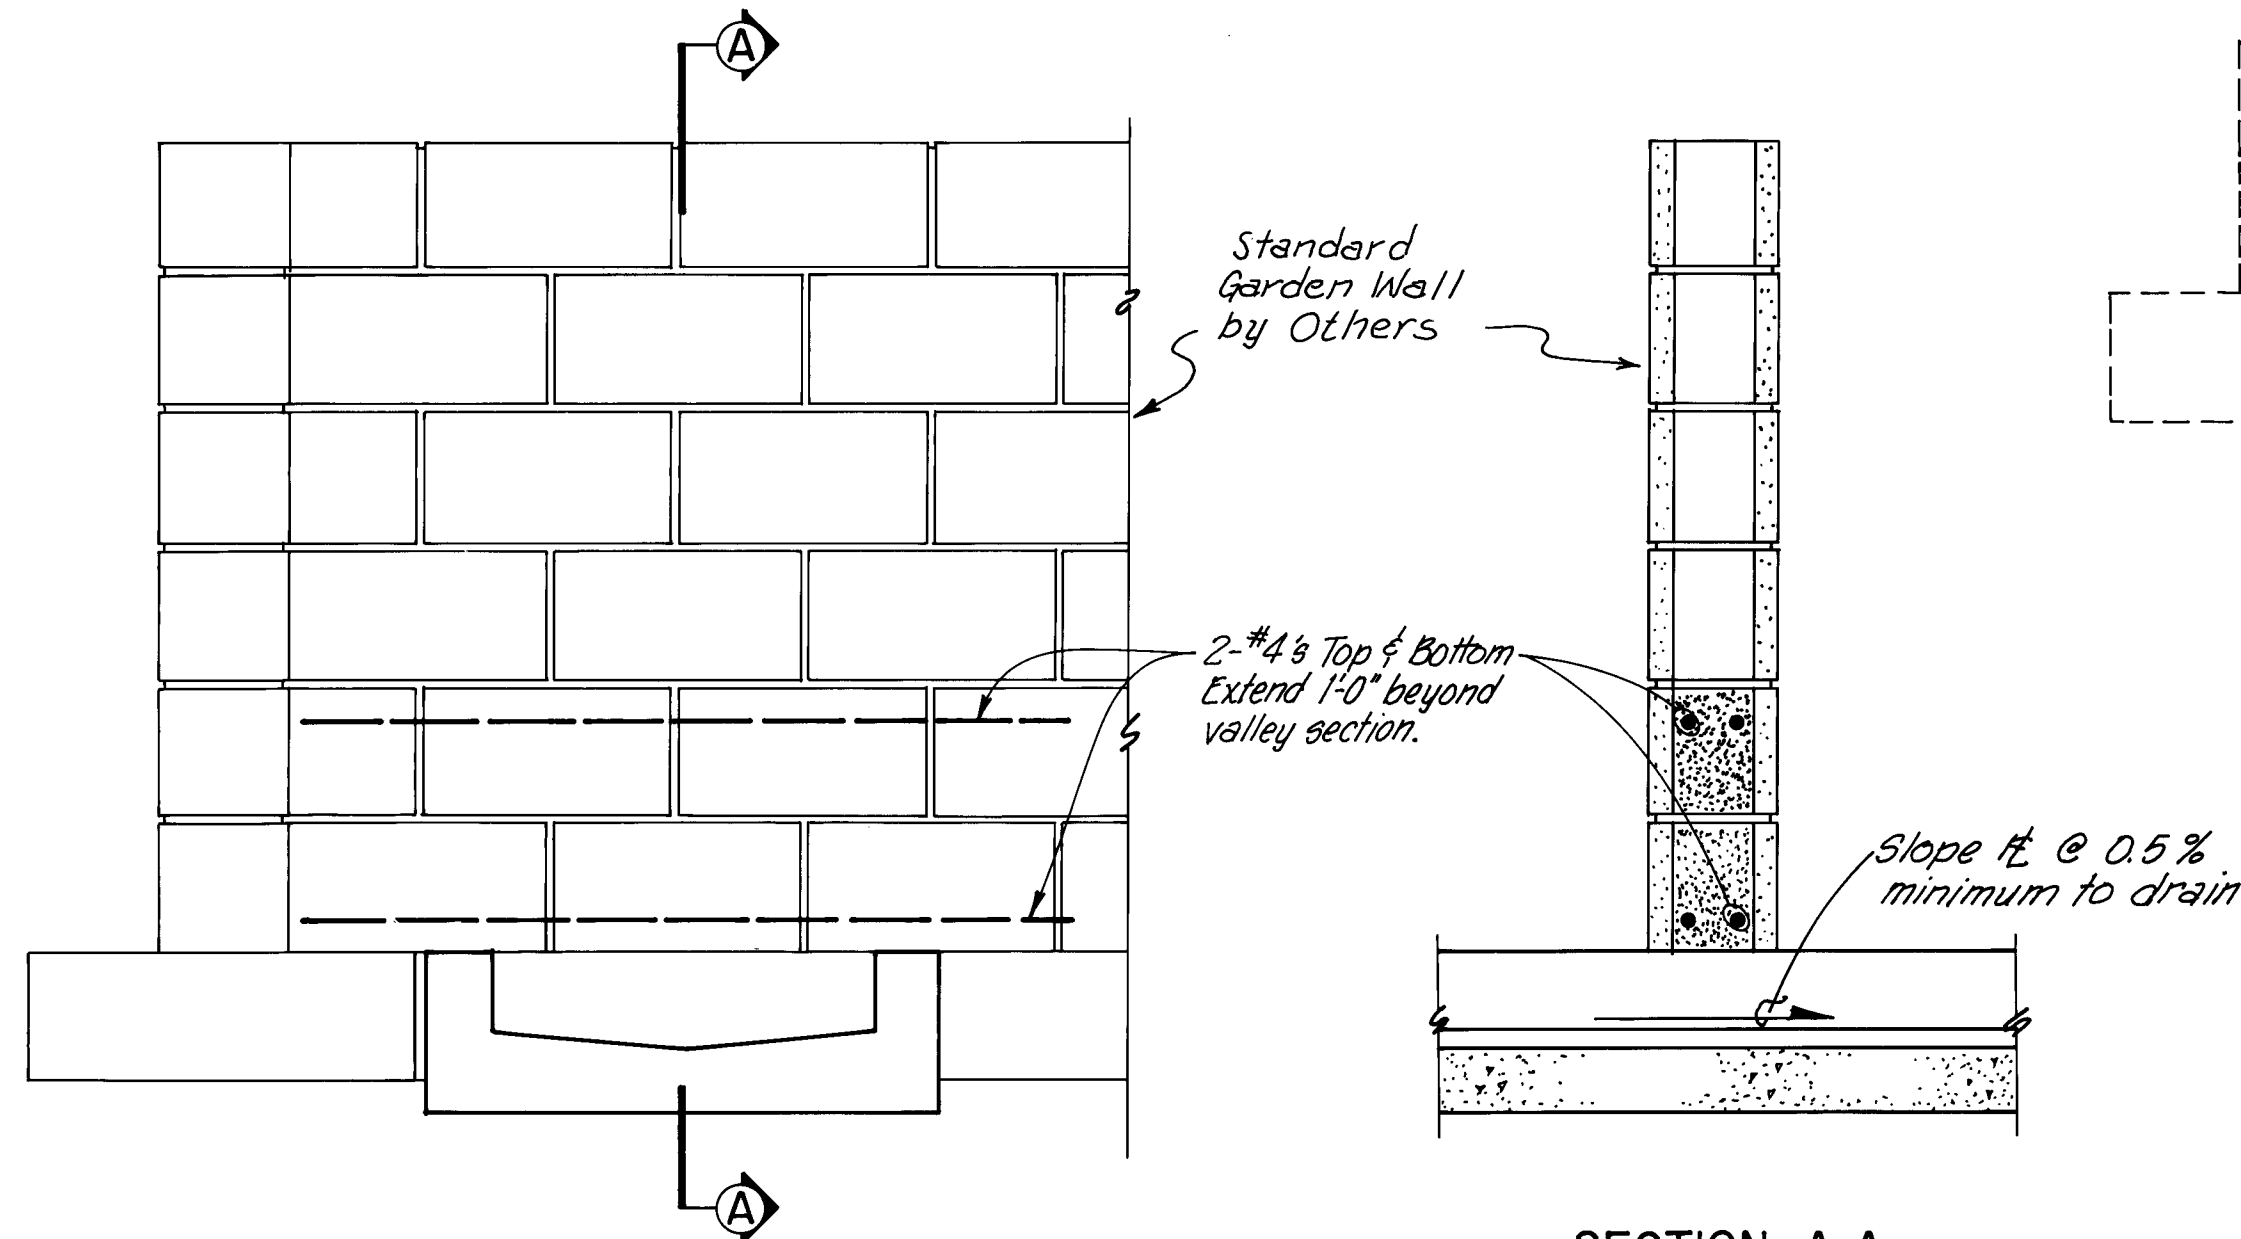


DRAINAGE RUNDOWN PLACEMENT

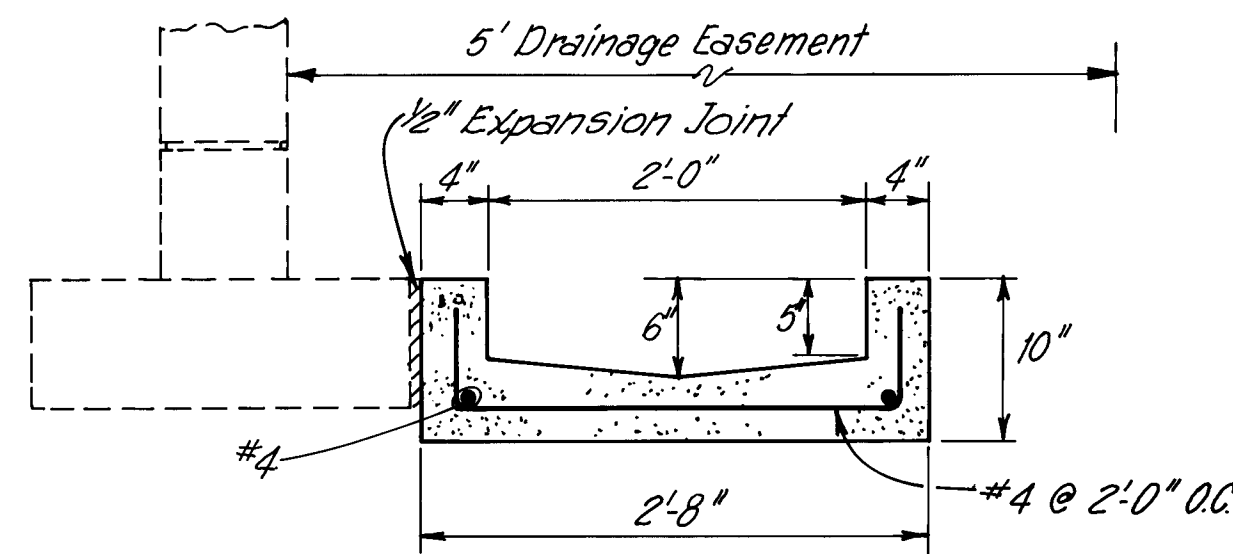


DRAINAGE RUNDOWN DETAIL


To Be Built by Others

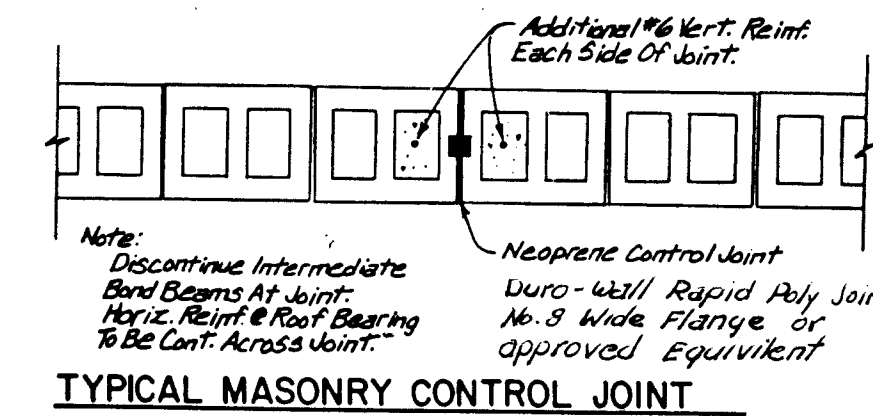


TYPICAL MASONRY CONTROL JOINT

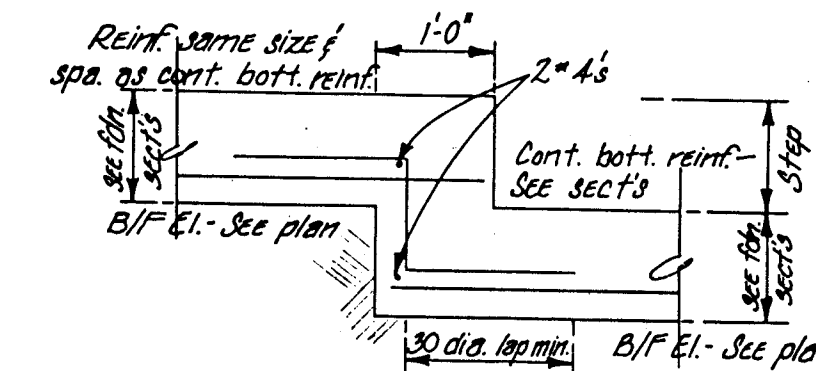


TYPICAL STEPPED FOOTING DETAIL

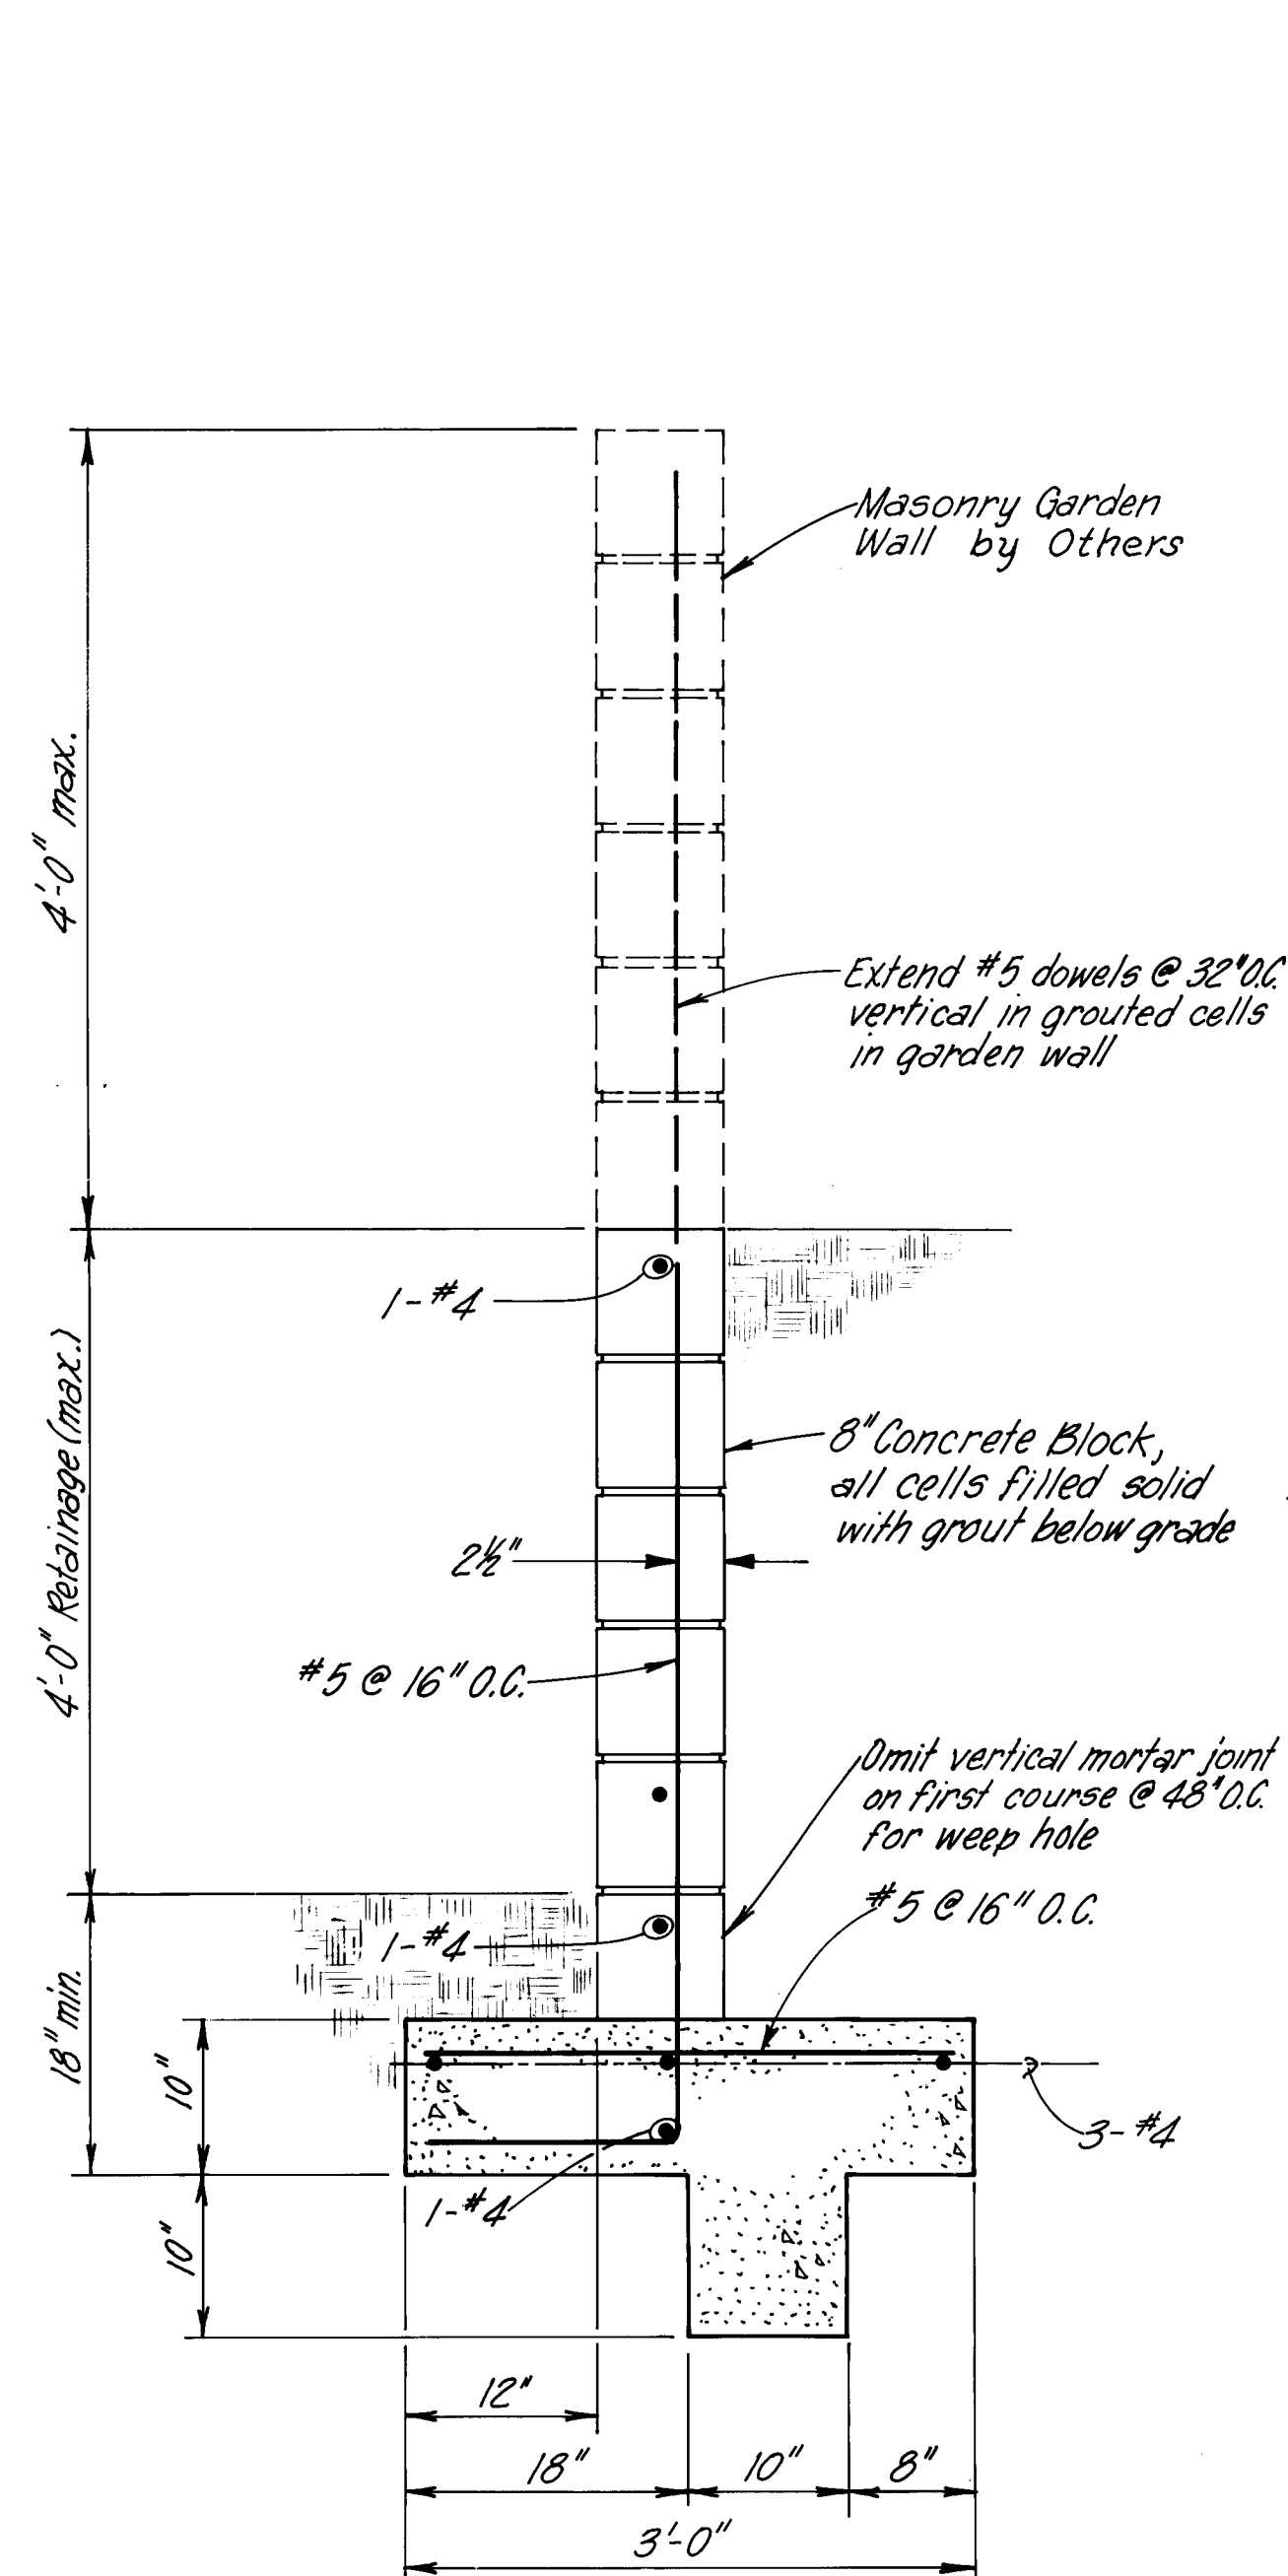

RETAINING WALL 'A'

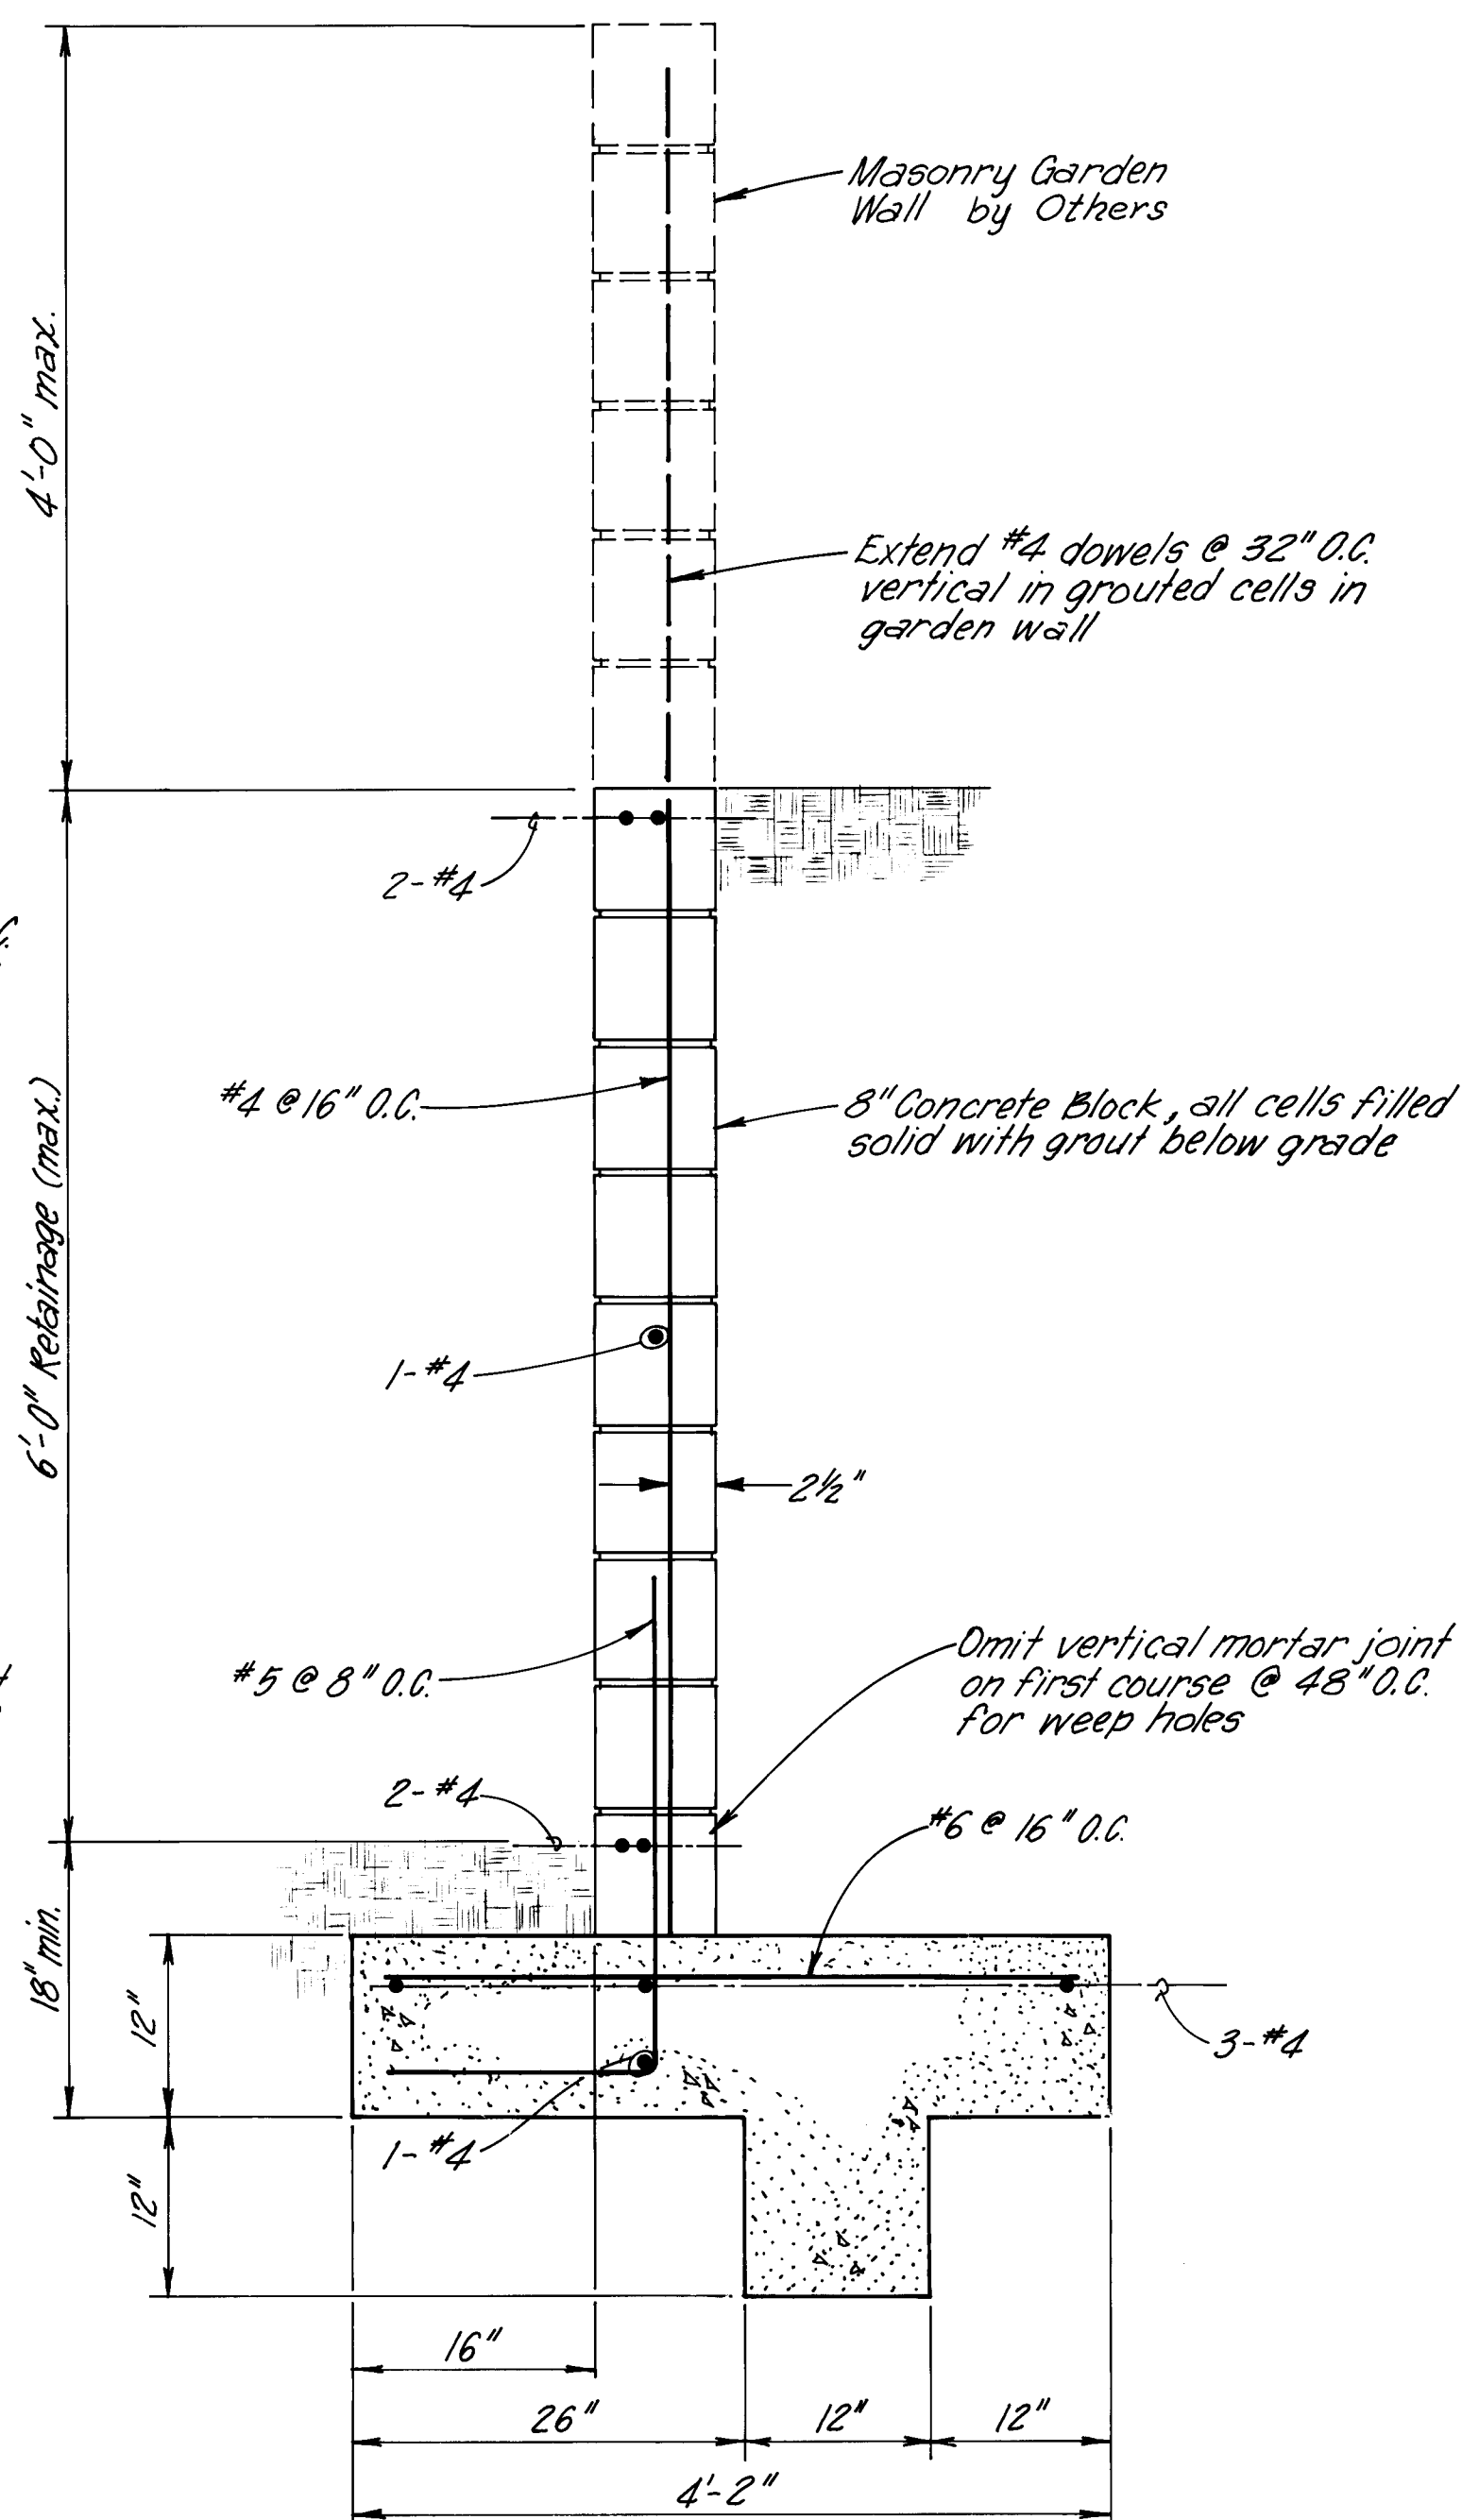


RETAINING WALL 'B'

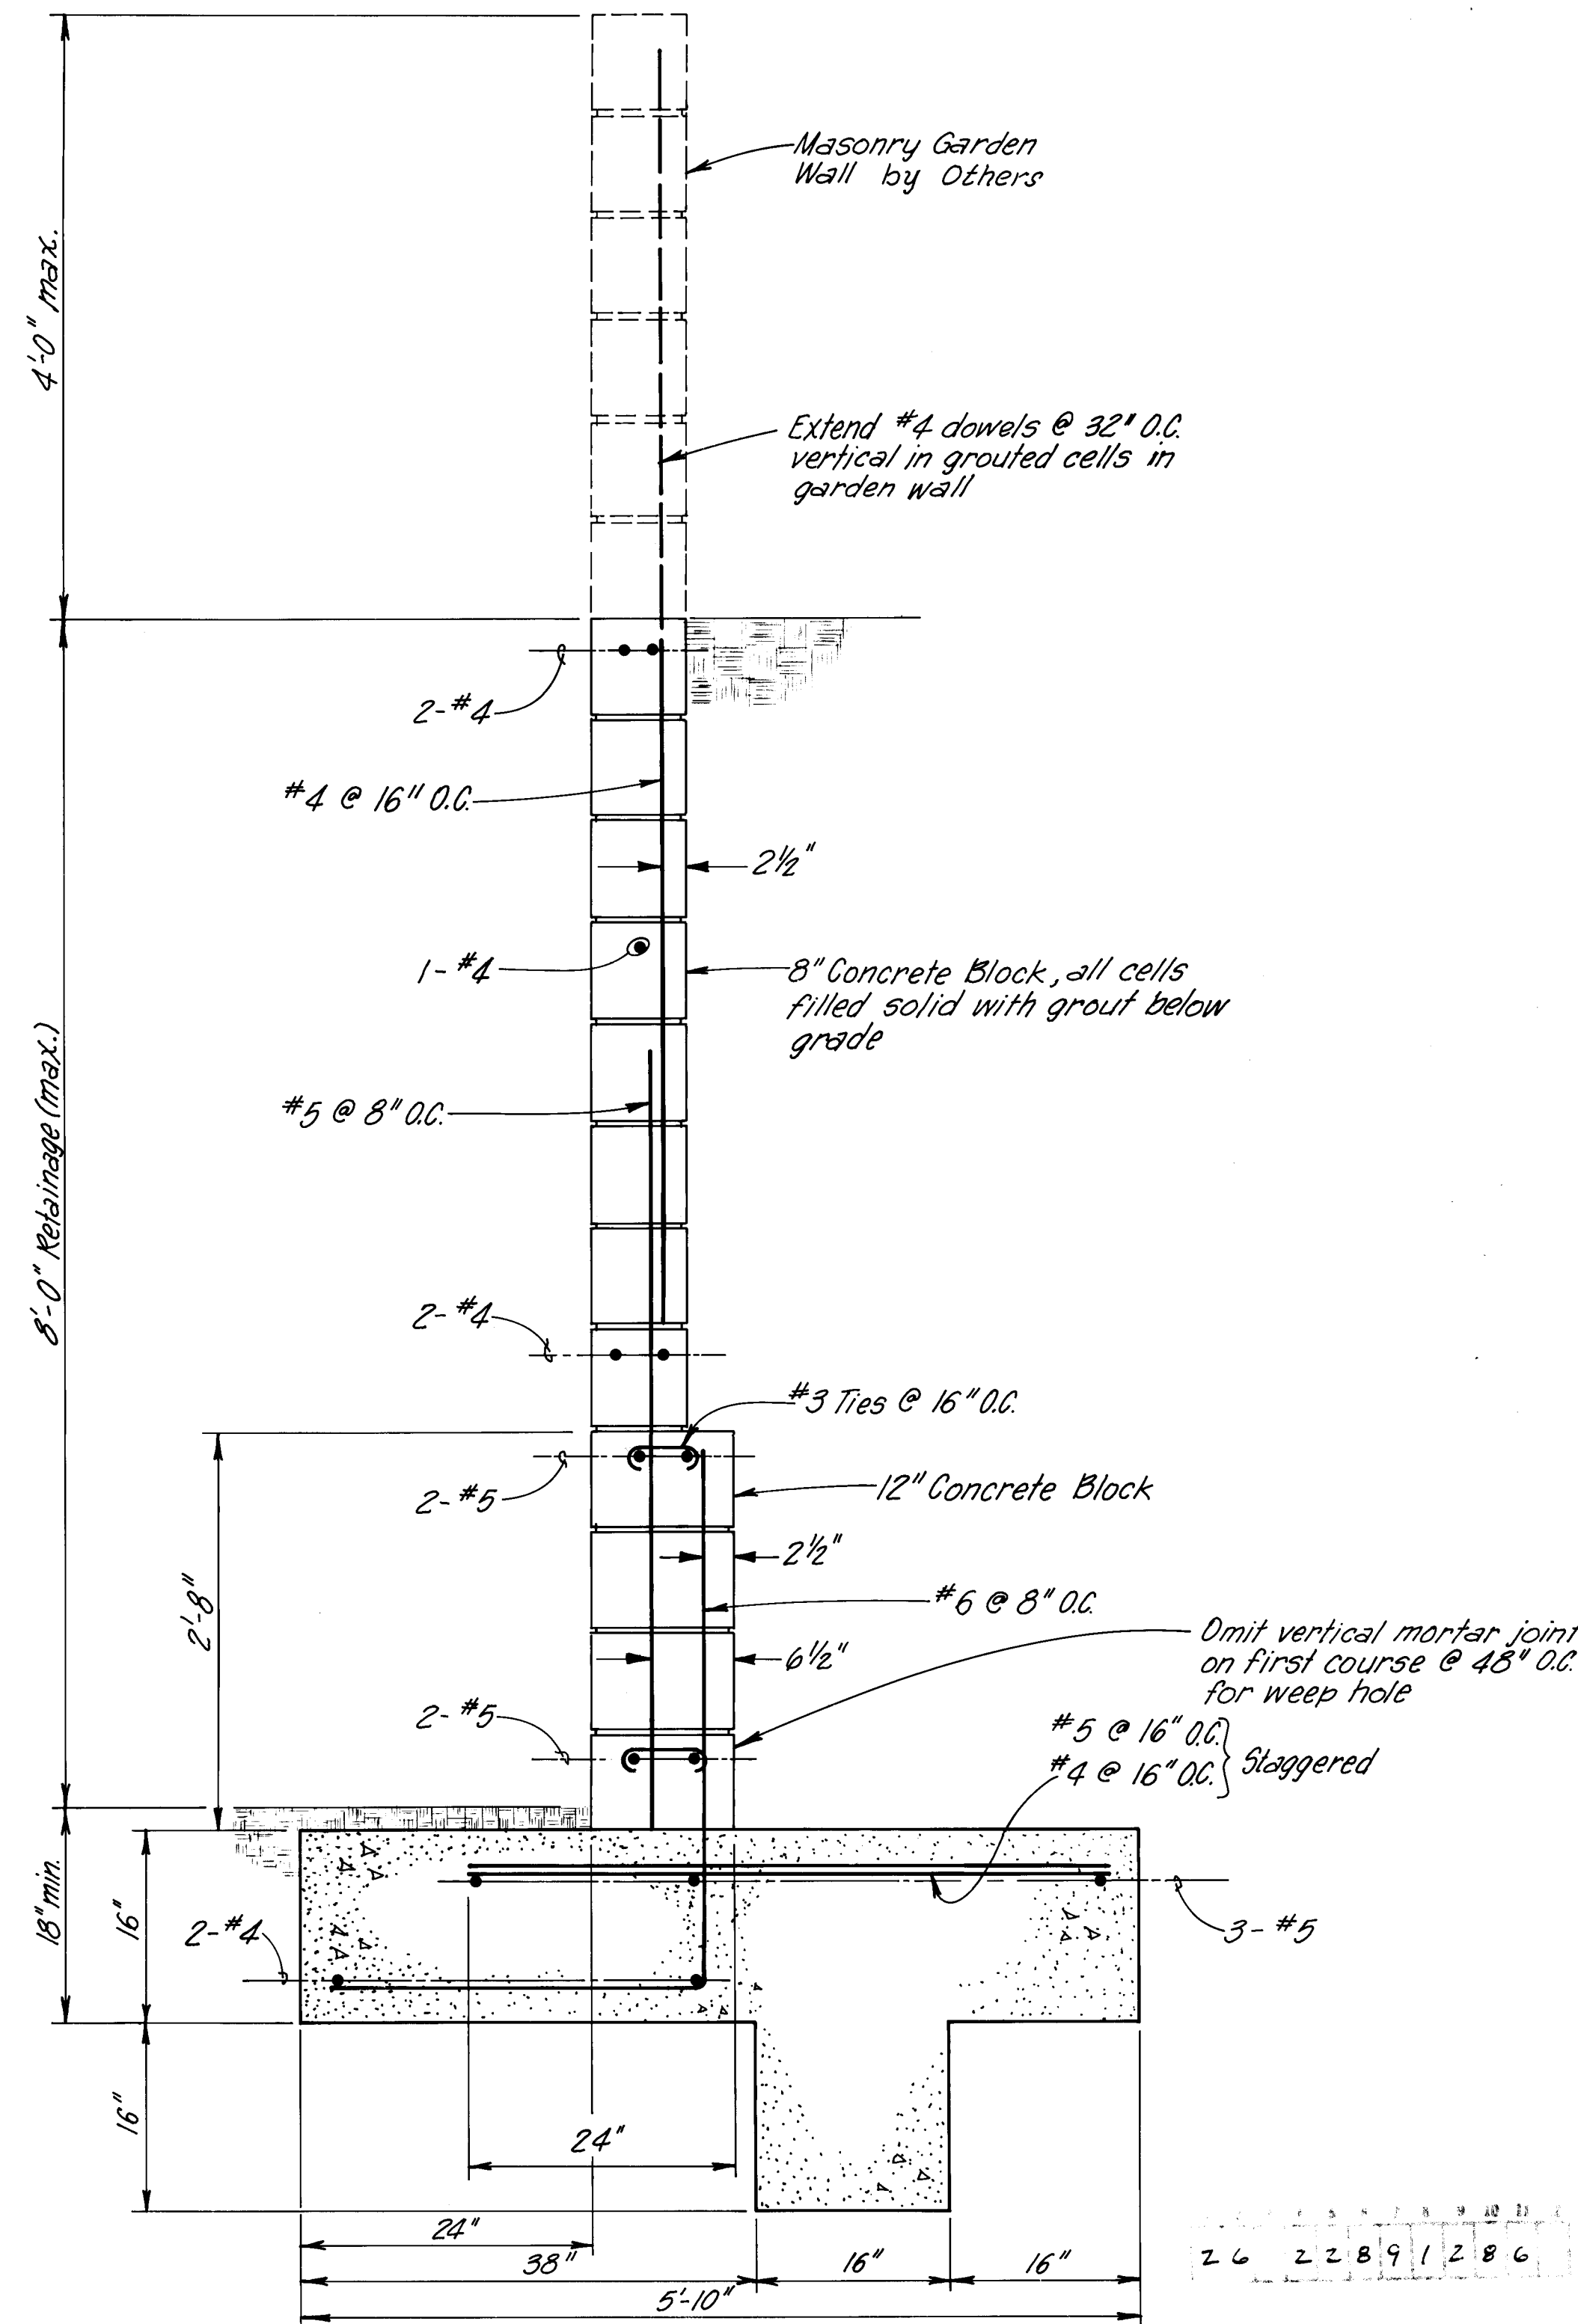

RETAINING WALL 'C'

- GENERAL NOTES**
- Retaining wall footings shall be placed on a minimum of 2'-0" of engineered fill extending a minimum of 2'-6" from the edge of the footing and compacted to a minimum of 95 percent optimum density (ASTM D-1557).
 - Backfill shall be free draining material and shall be placed in 8" loose lifts and compacted to 90 percent optimum density (ASTM D-1557) with light vibratory compacting equipment.
 - Retaining wall shall not be backfilled until at least 7 days after placing of final grout level.
 - Vertical control joints with PVC inserts shall be placed at intervals not to exceed 30'-0" on center.
 - Minimum lap splice on reinforcing bars shall be 30 bar diameters or 1'-6" minimum.
 - Construction of retaining walls shall conform to requirements of the Uniform Building Code Section 24, low lift grouting method.
 - All garden walls that retain over 6" of soil, erected not in conjunction with retaining walls, shall be reinforced with 1-#4 in grouted cells at 16" o.c. extending to within 2" of the bottom of garden wall footing.
 - DESIGN DATA
Block Weight 12"=130 pcf.
Block Weight 8"=85 pcf.
Soil Weight=130 pcf.
Equiv. Fluid Press.=43 pcf.
Soil Bearing Press.=1500 pcf.
(1/3 Increase for Wind/Seismic)
Coefficient of Friction=0.4
Passive Soil Pressure=390 pcf.
Concrete f'c(28 Days)=3000 psi.
Grout Strength=2000 psi.
CMU Grade N=1500 psi (Grouted)
Reinforcement=60 ksi ASTM A-615
 - Colored and patterned concrete.

After proper consolidation of concrete, level and screed to compact the surface and float to attain a smooth, level, regular surface of uniform texture. A pattern, as specified on the plans or by the ENGINEER, is then to be pressed into the surface, to a depth, not to exceed 3/16", by using embossing tools as manufactured by Bominite, Impresco, or approved equal. The Contractor shall provide a test slab of approximately 2' x 6' x 5' for the ENGINEER'S approval prior to proportion of the large areas.

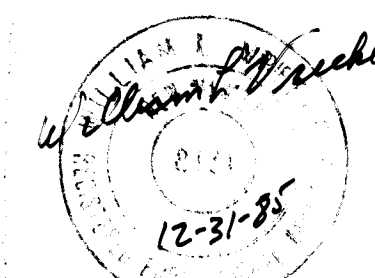

RECORD DRAWINGS
DATE 12/85

THIS SHEET FOR INFORMATION ONLY. A SEPERATE BUILDING PERMIT IS REQUIRED FOR RETAINING WALL CONSTRUCTION


CITY OF ALBUQUERQUE MUNICIPAL DEVELOPMENT DEPARTMENT ENGINEERING DIVISION					
TITLE: ACADEMY RIDGE EAST PHASE I RETAINING WALL & DRAINAGE DETAILS					
APPROVALS	ENGINEER	DATE	APPROVALS	ENGINEER	DATE
City Engineer	D. J. [Signature]	6/2/85	Liquid Waste	NA	5/29/85
A.C.E. Design	[Signature]	6/1/85	Traffic	NA	5/29/85
Hydrology	[Signature]	5/29/85	Water	NA	5/29/85
DRAWING NO. 2289			MAP NO. E-21		
SHEET 12 OF 19			REVISIONS		
DESIGNED BY KLD			DATE 1/85		
DRAWN BY JRJ			DATE 2/85		
CHECKED BY KLD			DATE 5/85		

PLAN	DATE	BY	DATE	BY
SURVEYED				
ALIGNED				
NOTED				
NO.				



PROFILE	DATE	BY	DATE	BY
SURVEYED				
ALIGNED				
NOTED				
NO.				

STA.	LENGTH	INV. @ PLUG
2+56 Lt	26'	6788.54
2+82 Rt	26'	6795.76
3+08 Rt	26'	6802.03
3+34 Rt	26'	6808.29
3+60 Rt	26'	6814.55
3+86 Rt	26'	6820.81
4+12 Rt	26'	6827.07
4+38 Rt	26'	6833.33
4+64 Rt	26'	6839.59
4+90 Rt	26'	6845.85
5+16 Rt	26'	6852.11
5+42 Rt	26'	6858.37

NOTE:
SEE SHT. 18 FOR STORM
DRAIN DETAILS.

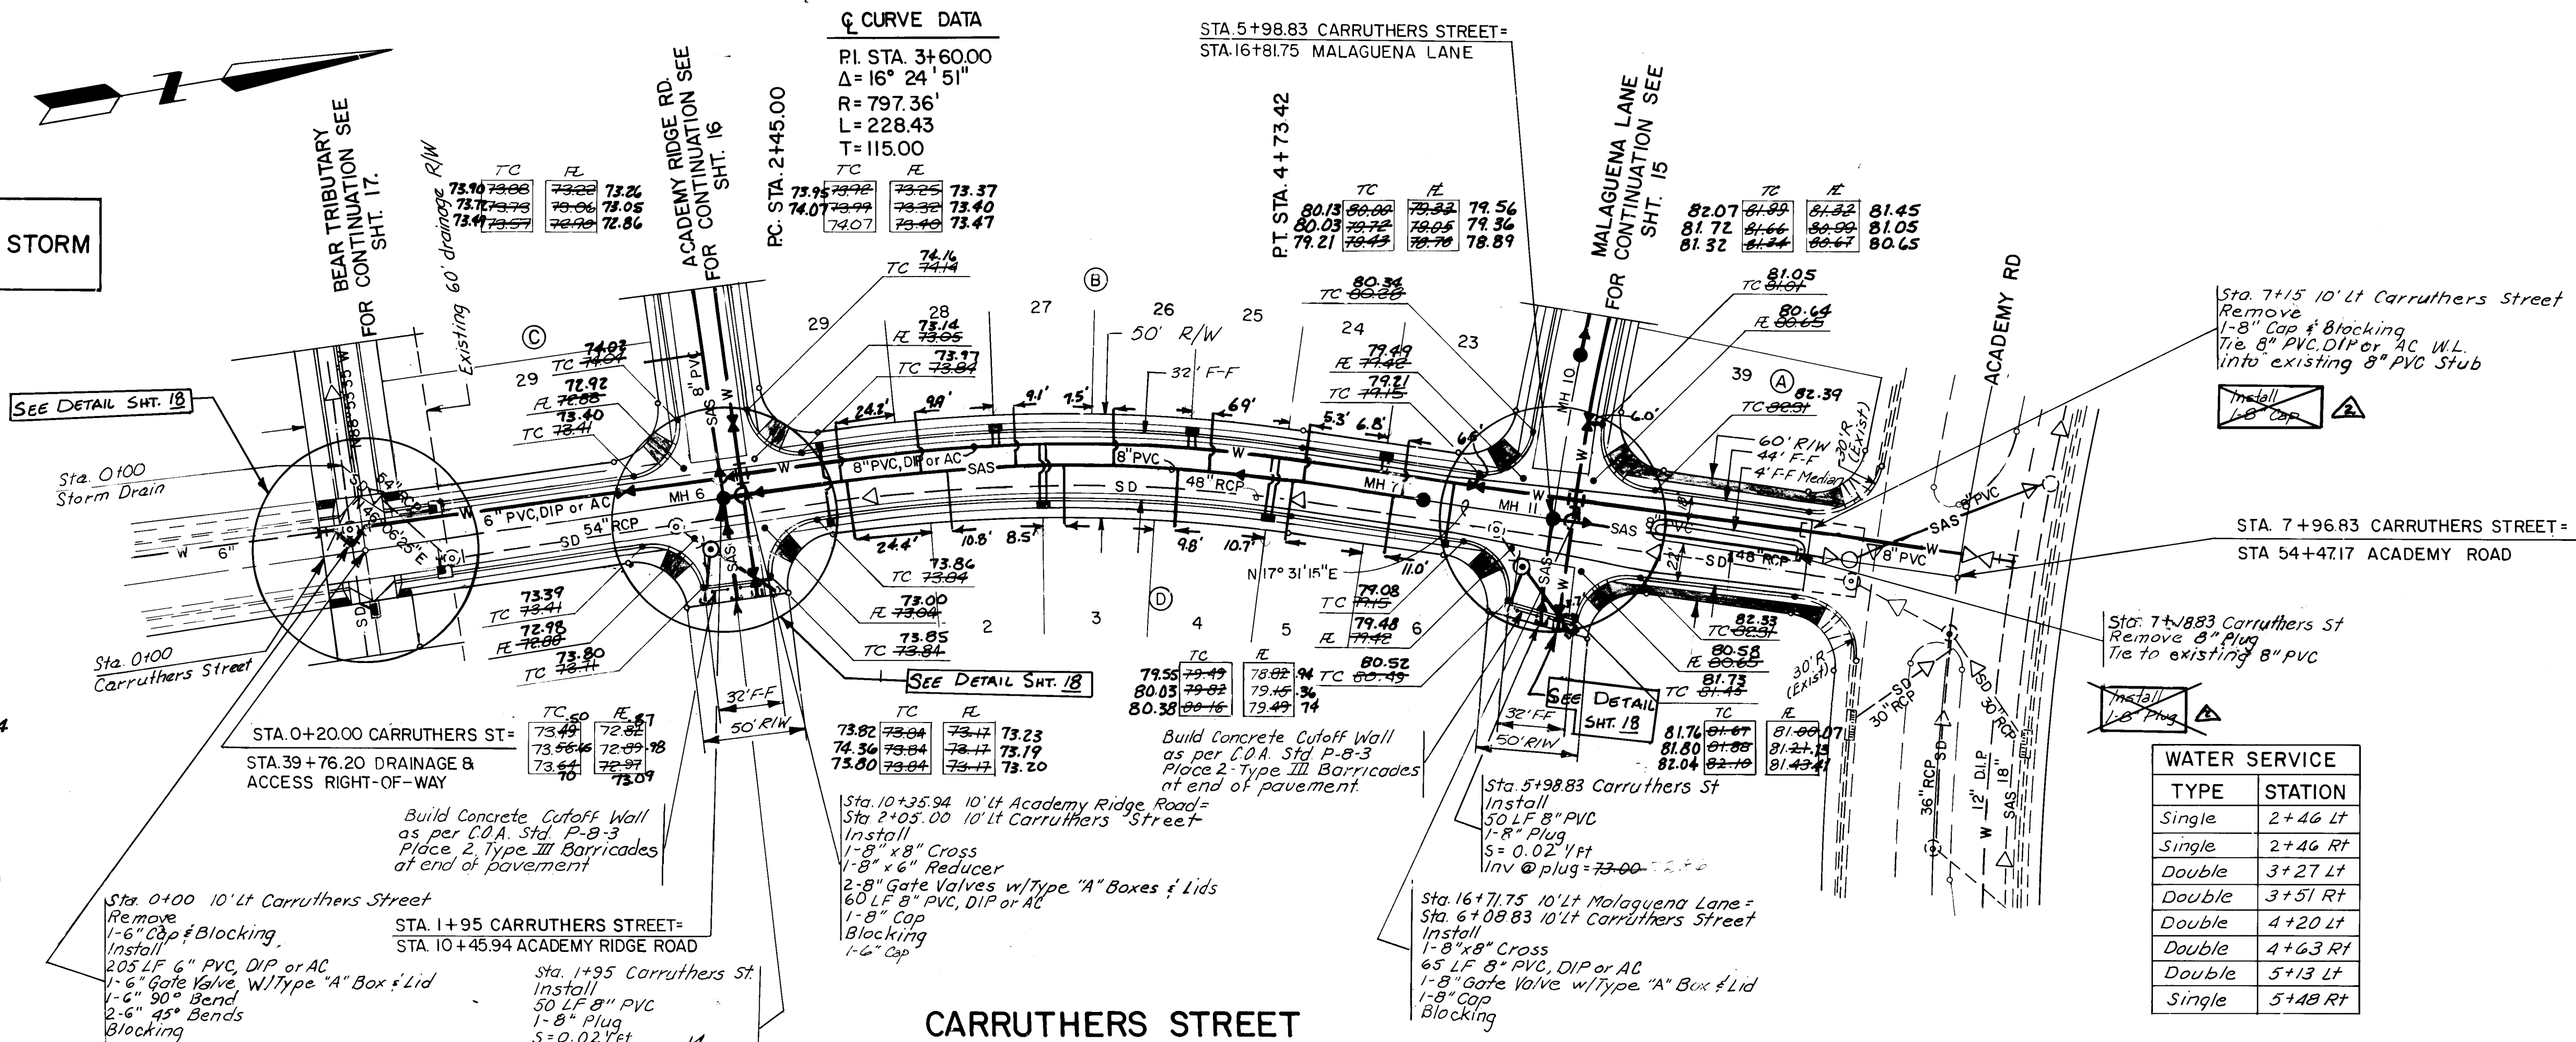

TYPE	STATION
Single	2+46 Lt
Single	2+46 Rt
Double	3+27 Lt
Double	3+51 Rt
Double	4+20 Lt
Double	4+63 Rt
Double	5+13 Lt
Single	5+48 Rt

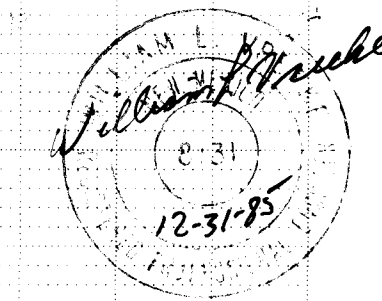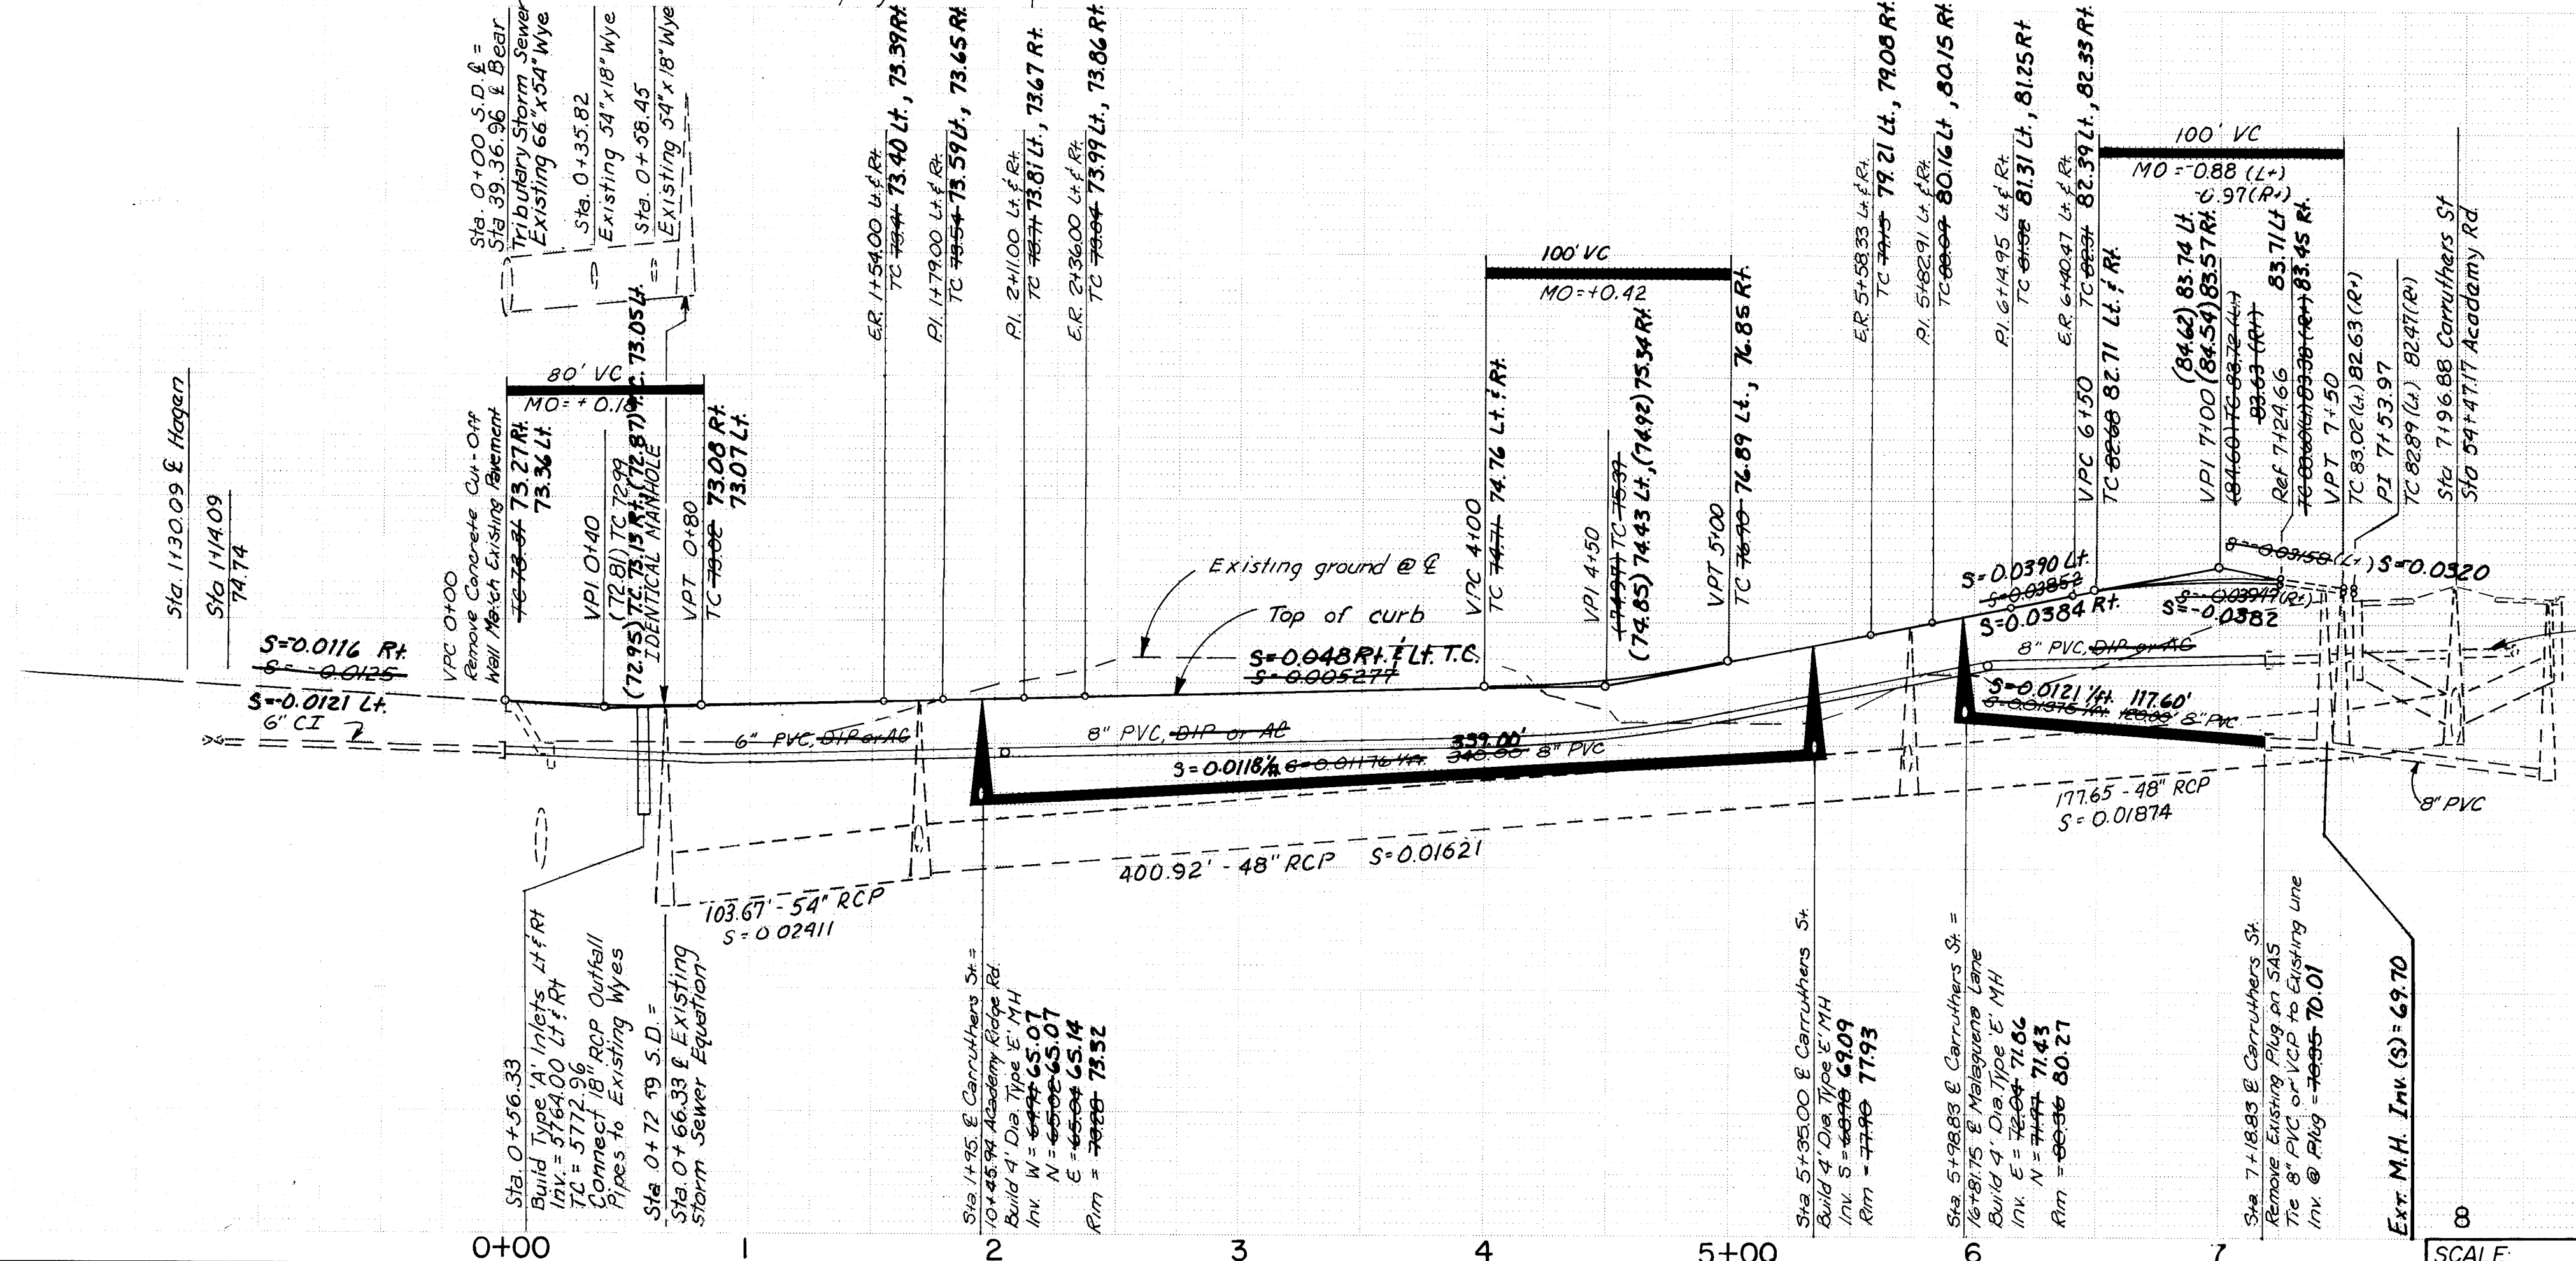


RECORD DRAWINGS
DATE 12/85

PREPARED UNDER THE DIRECTION OF <i>Brian Barnett</i> 5-23-85		CITY OF ALBUQUERQUE MUNICIPAL DEVELOPMENT DEPARTMENT ENGINEERING DIVISION	
TITLE: ACADEMY RIDGE EAST PHASE I CARRUTHERS STREET			
APPROVALS	ENGINEER	DATE	APPROVALS
City Engineer	<i>[Signature]</i>	6/2/85	Liquid Waste
ACE Design	<i>[Signature]</i>	6/2/85	Traffic
Hydrology	<i>[Signature]</i>	6/2/85	Water
PROJECT NUMBER 2289		SHEET 13 OF 19	

FWHA Region No.	NEW MEXICO	SHEET NO.	TOTAL SHEETS
6			

AS-BUILT INFORMATION	BENCH MARKS	SURVEY INFORMATION	REFERENCES
CONTRACTOR: <i>[Signature]</i> WORK: <i>[Signature]</i> STATIONED BY: <i>[Signature]</i> ACCEPTANCE BY: <i>[Signature]</i> DRAWING BY: <i>[Signature]</i> CHECKED BY: <i>[Signature]</i> RECORDED BY: <i>[Signature]</i>	ACS Brass Cap "6-E22" Location is 1.2 miles East of the Intersection of Academy Road NE & Eubank Blvd NE Station is then 375' South on the South Rim of the Bear Canyon Tributary	MAP NO. E-21 EST. NO. W.O. NO. NO. DATE BY	NO. E-21 EST. NO. W.O. NO. NO. DATE BY

PLATE 1 SINGLE PLAN - PROFILE - DOTTED
CHARLES BRUNING COMPANY
MADE IN U.S.A.

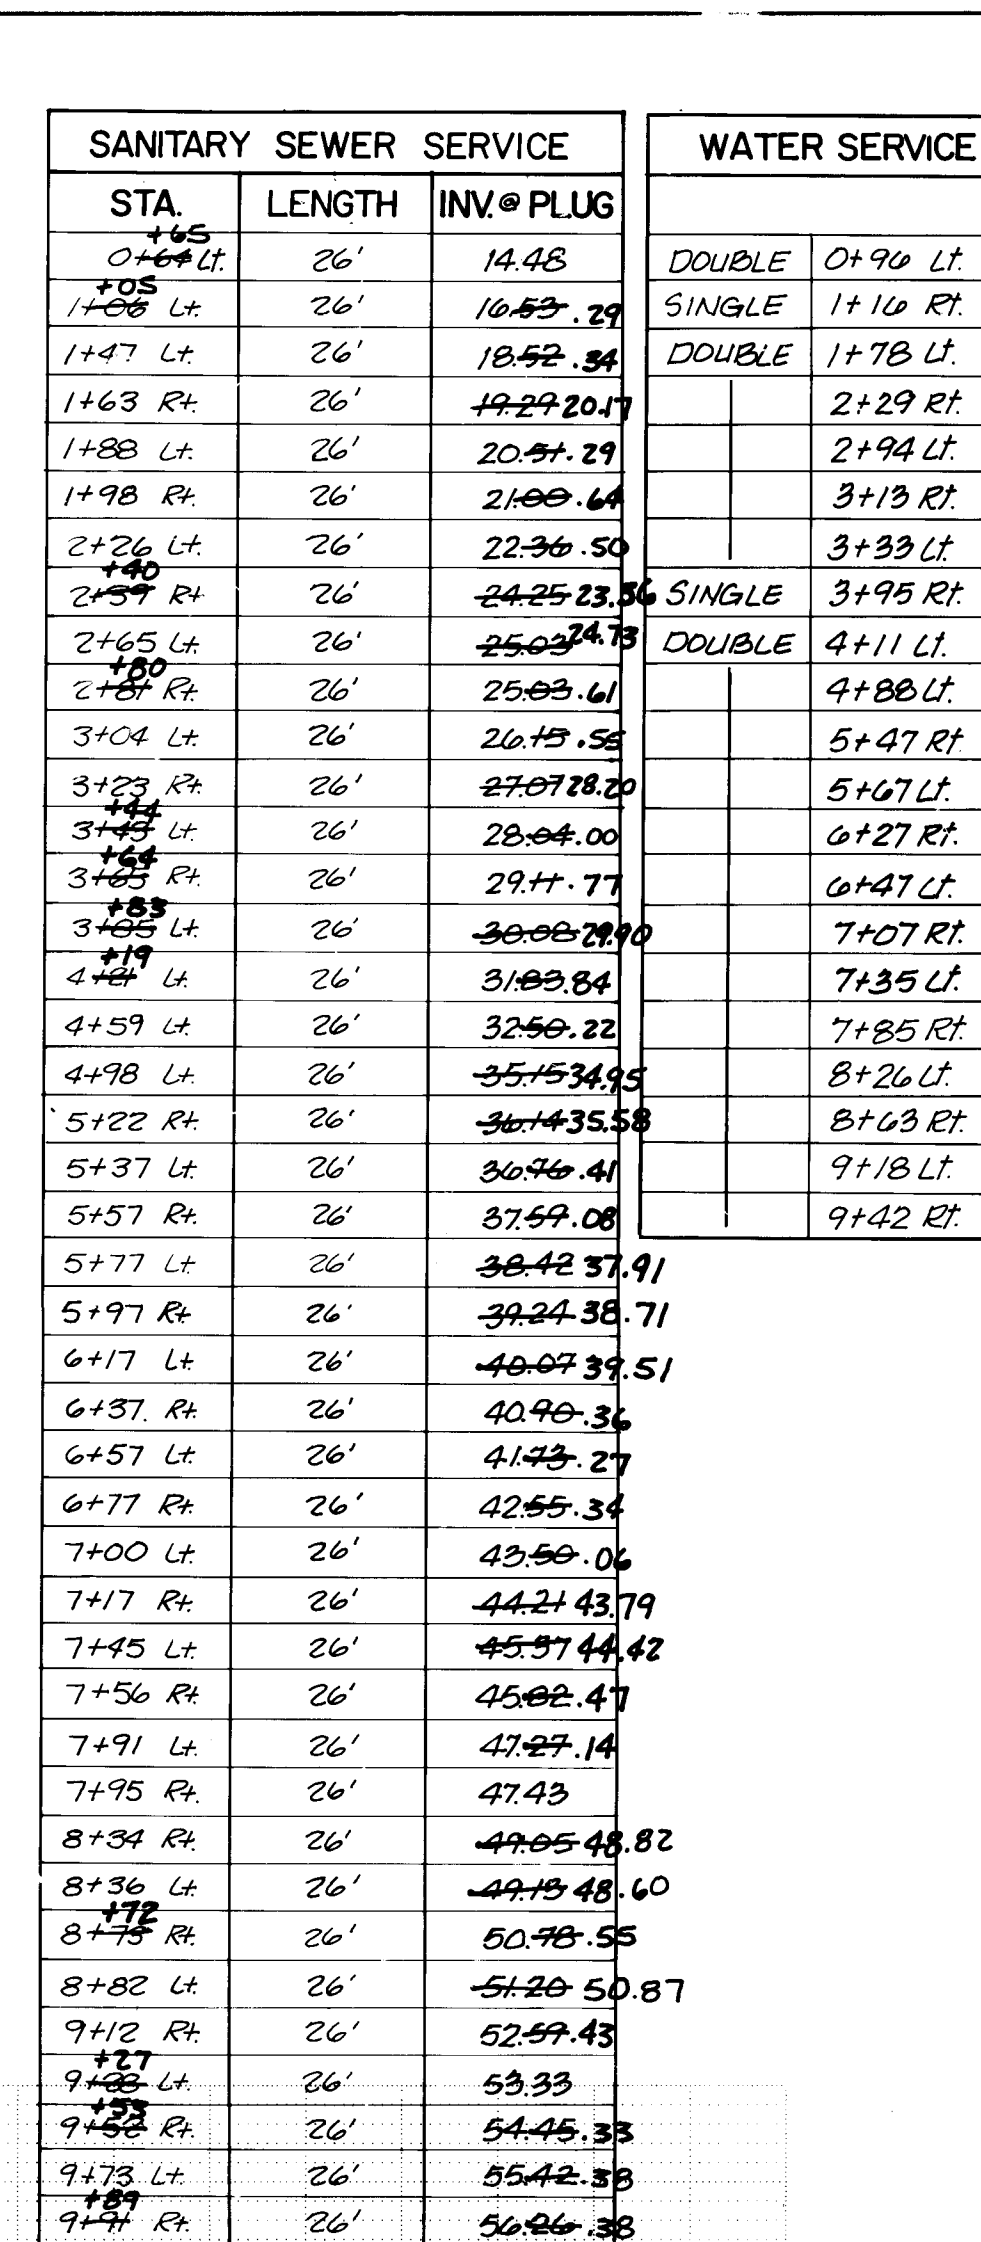

QUERQUE MENT DEPARTMENT DIVISION																			
AST PHASE I LANE																			
APPROVALS					ENGINEER					DATE									
Chief Engineer					William J. Ridd					5/15/85									
District Engineer					David L. Brown					5/15/85									
Inspector					William J. Ridd					5/15/85									
										SHEET 14 OF 19									

PLAN	DATE	BY
NO. 1		
NO. 2		
NO. 3		
NO. 100		

PROFILE	DATE	BY
NO. 1		
NO. 2		
NO. 3		
NO. 100		

WATER SERVICE	STATION
Double	10+08 Lt
Double	10+20 Rt
Double	10+99 Lt
Double	11+17 Rt
Double	11+87 Lt
Double	12+35 Lt
Single	12+65 Lt
Double	13+10 Rt
Double	13+19 Lt
Double	14+07 Lt
Double	14+26 Rt
Double	14+95 Lt
Double	15+06 Rt
Double	15+83 Lt

C CURVE DATA
 PI STA. 9+29.71
 $\Delta = 25^\circ 23' 48''$
 $R = 132.05'$
 $L = 501.79'$
 $T = 255.09'$

PRC STA. 11+76.41

C CURVE DATA
 PI STA. 12+59.21
 $\Delta = 79^\circ 15' 05''$
 $R = 100.00'$
 $L = 138.32'$
 $T = 82.80'$

PRC STA. 13+14.73

C CURVE DATA
 PI STA. 14+99.02
 $\Delta = 12^\circ 53' 52''$
 $R = 1630.40'$
 $L = 367.02'$
 $T = 184.29'$

NOTE:
 SEE SHEET 18 FOR
 STORM DRAIN DETAILS


16+29.65 10' Lt
 Install
 10 LF 6" PVC, DIP or AC
 1-6" 90° Bend
 1-Fire Hydrant, 4' Bury, Flange Elev. = 5781.60
 Blocking

Sta. 16+71.75, 10' Lt Malaguena Lane =
 Sta. 6+08.83, 10' Lt Carruthers Street
 Install
 1-8" x 8" Cross
 65 LF 8" PVC, DIP or AC
 1-8" Gate Valve w/Type "A" Box & Lid
 1-8" Cop
 Blocking


Sta. 7+45.94 10' Lt Academy Ridge Road
 Install
 1-8" x 8" Tee
 1-8" Gate Valve w/Type "A" Box & Lid
 1-6" Gate Valve w/Type "A" Box & Lid
 245 LF 6" PVC, DIP or AC
 1-6" Cop
 Blocking

WATER SERVICE	STATION
Double	1+80 Lt
Double	1+82 Rt
Double	2+25 Rt
Single	2+47 Rt
Double	2+49 Lt



FWHA	Region No.	NEW	MEXICO	SHEET	TOTAL
6					

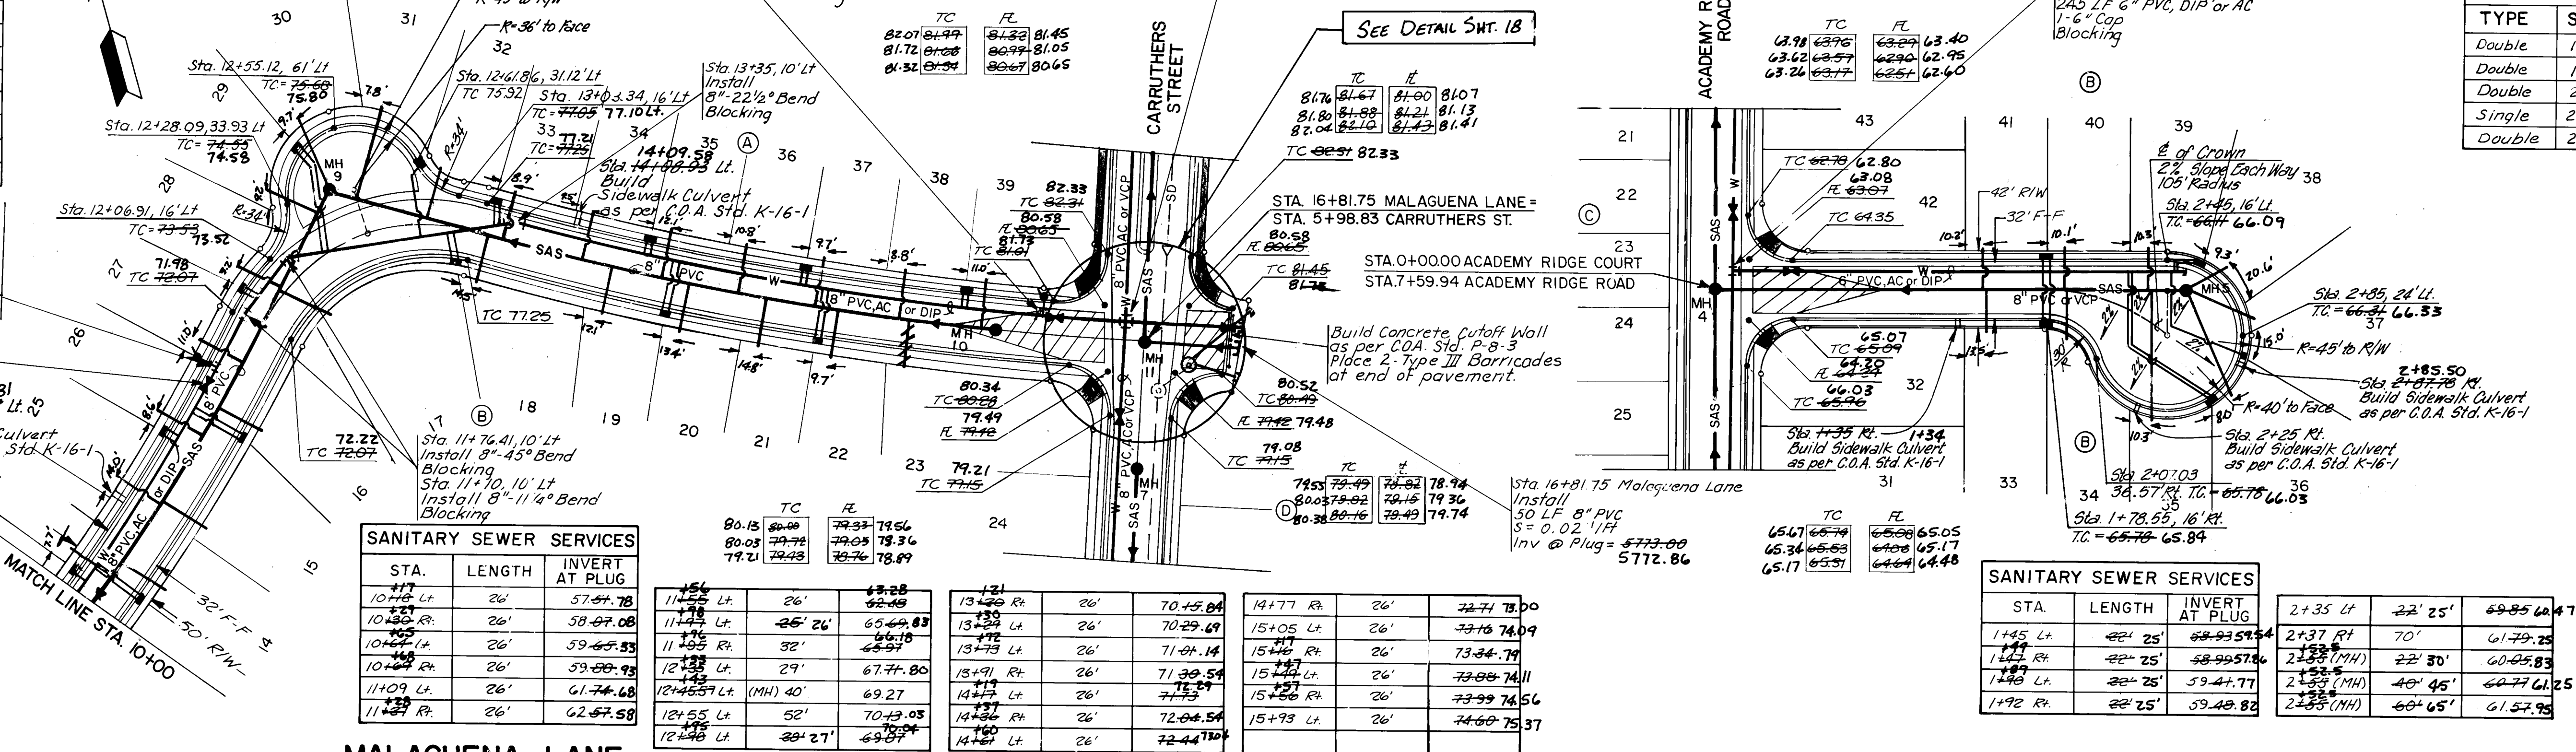

MALAGUENA LANE

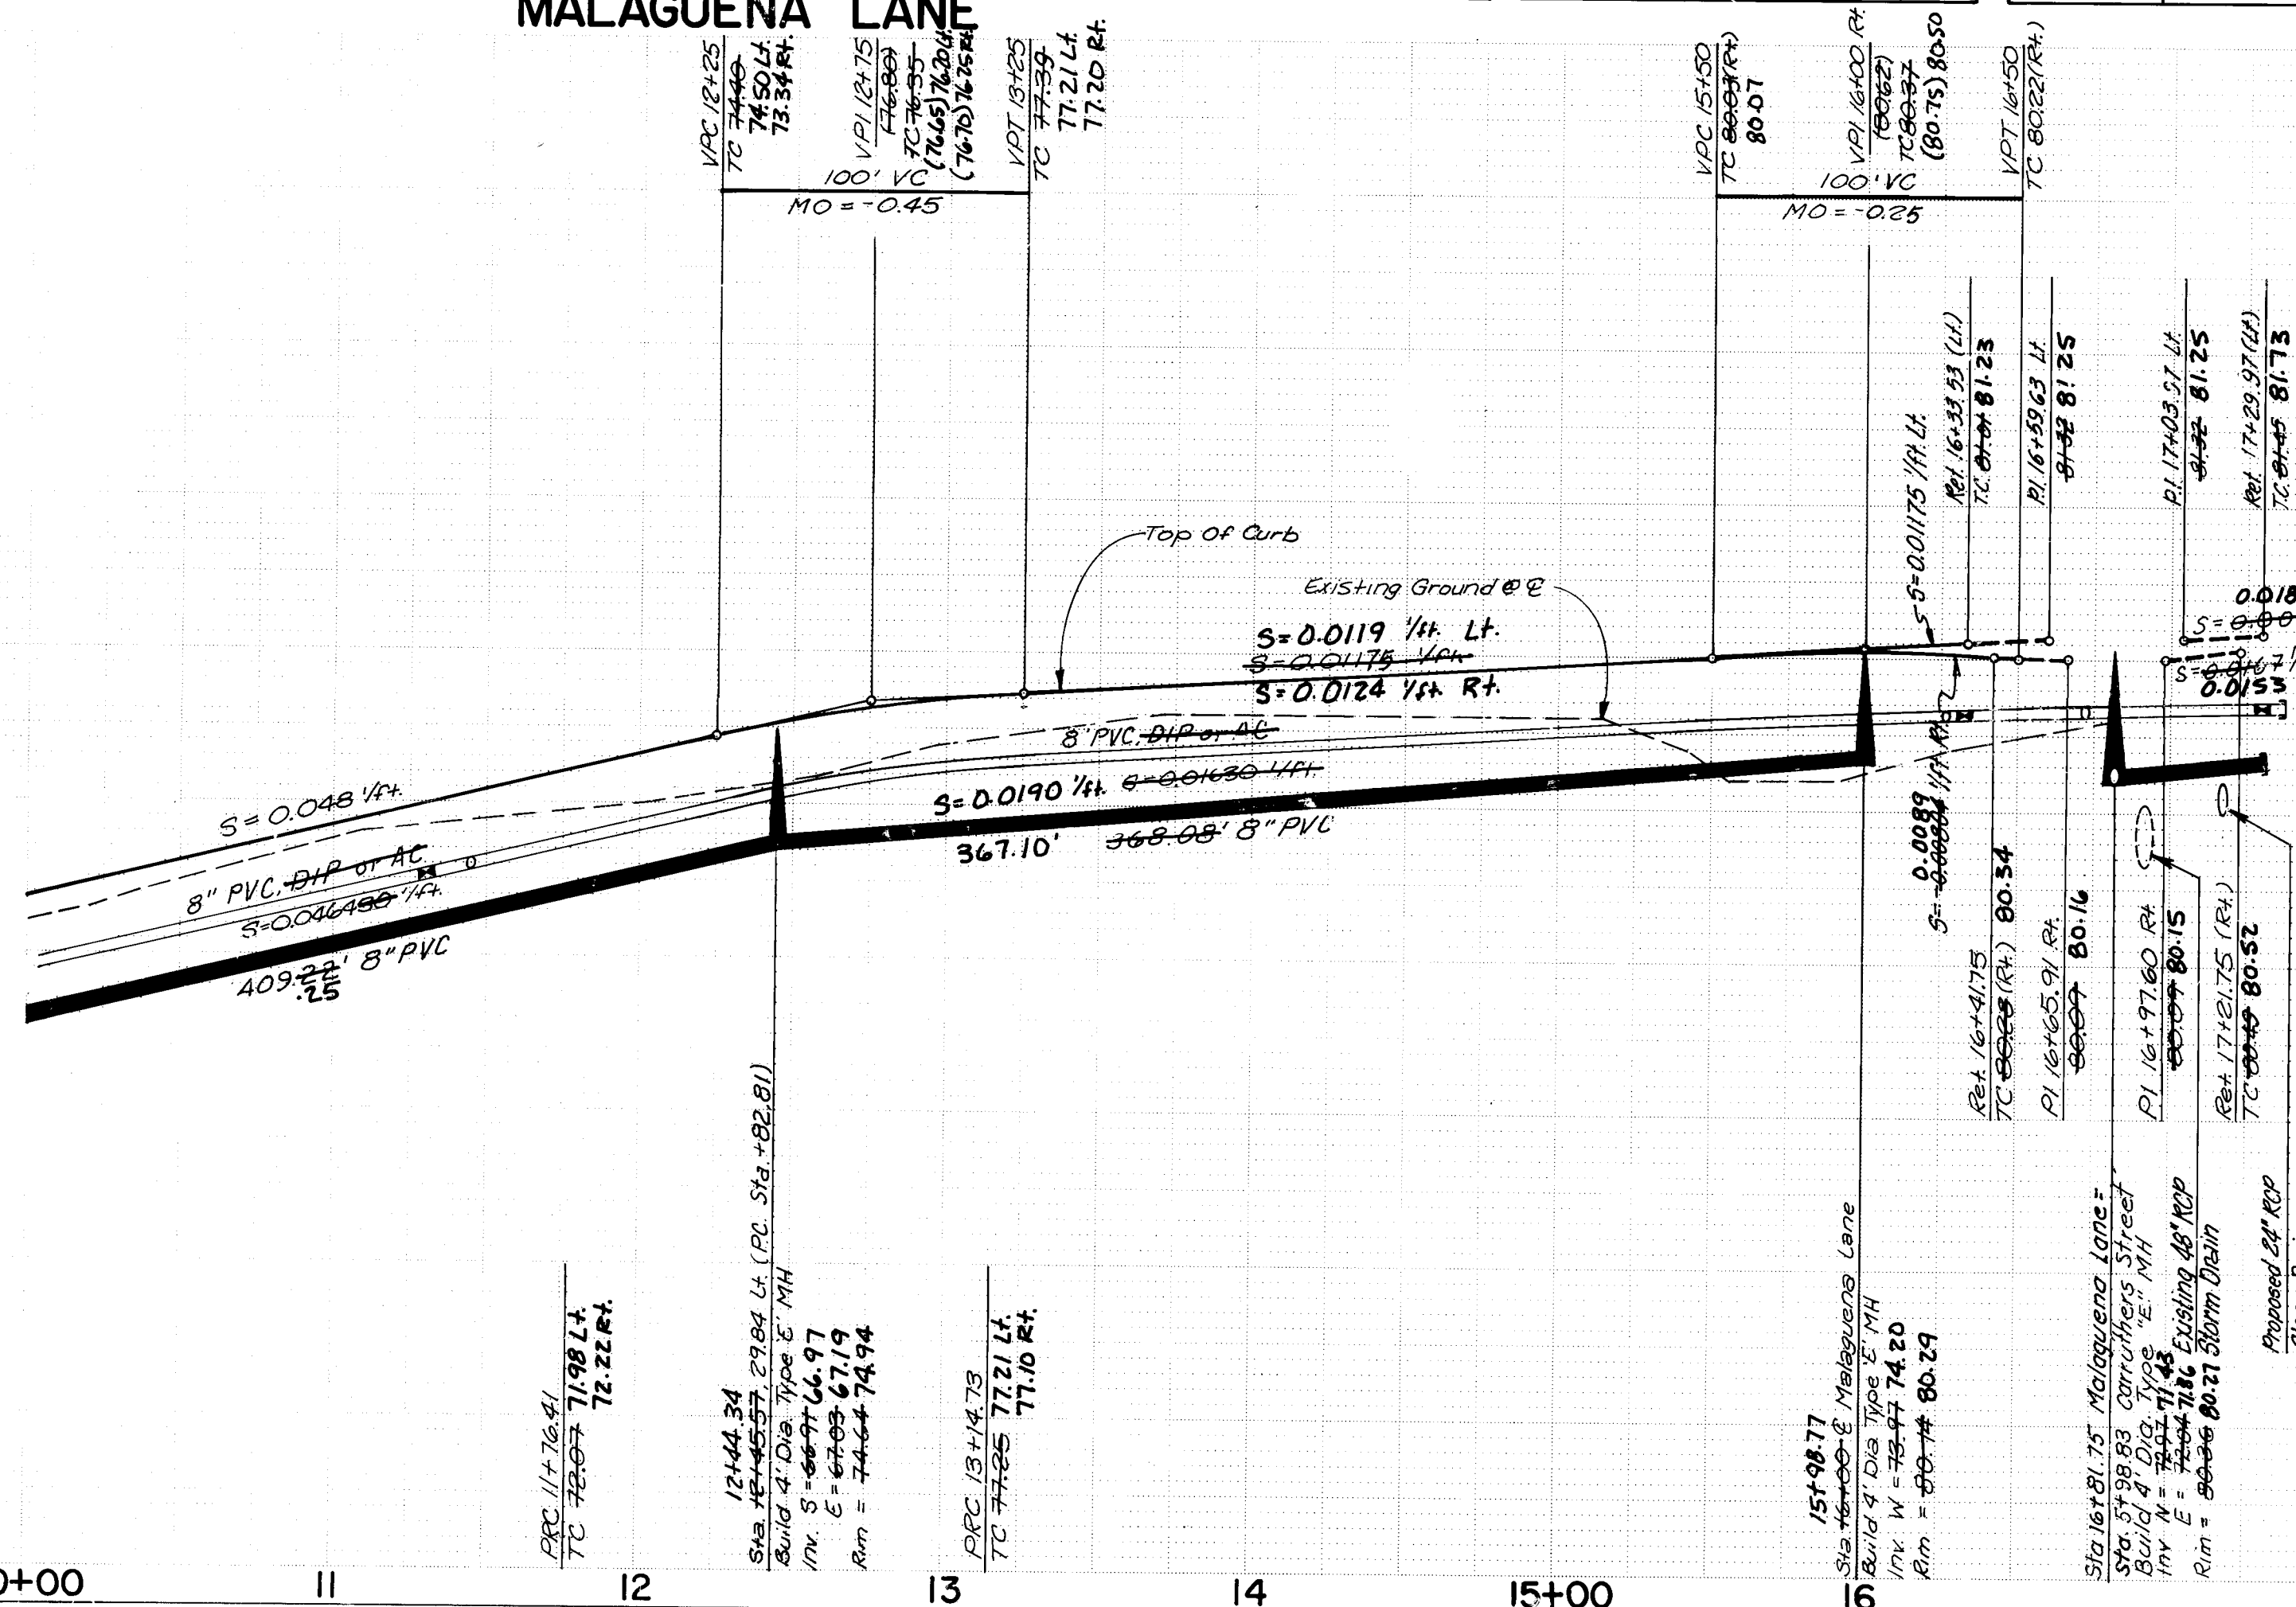

ACADEMY RIDGE COURT

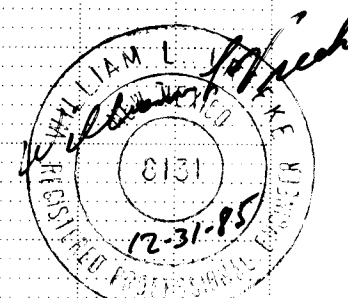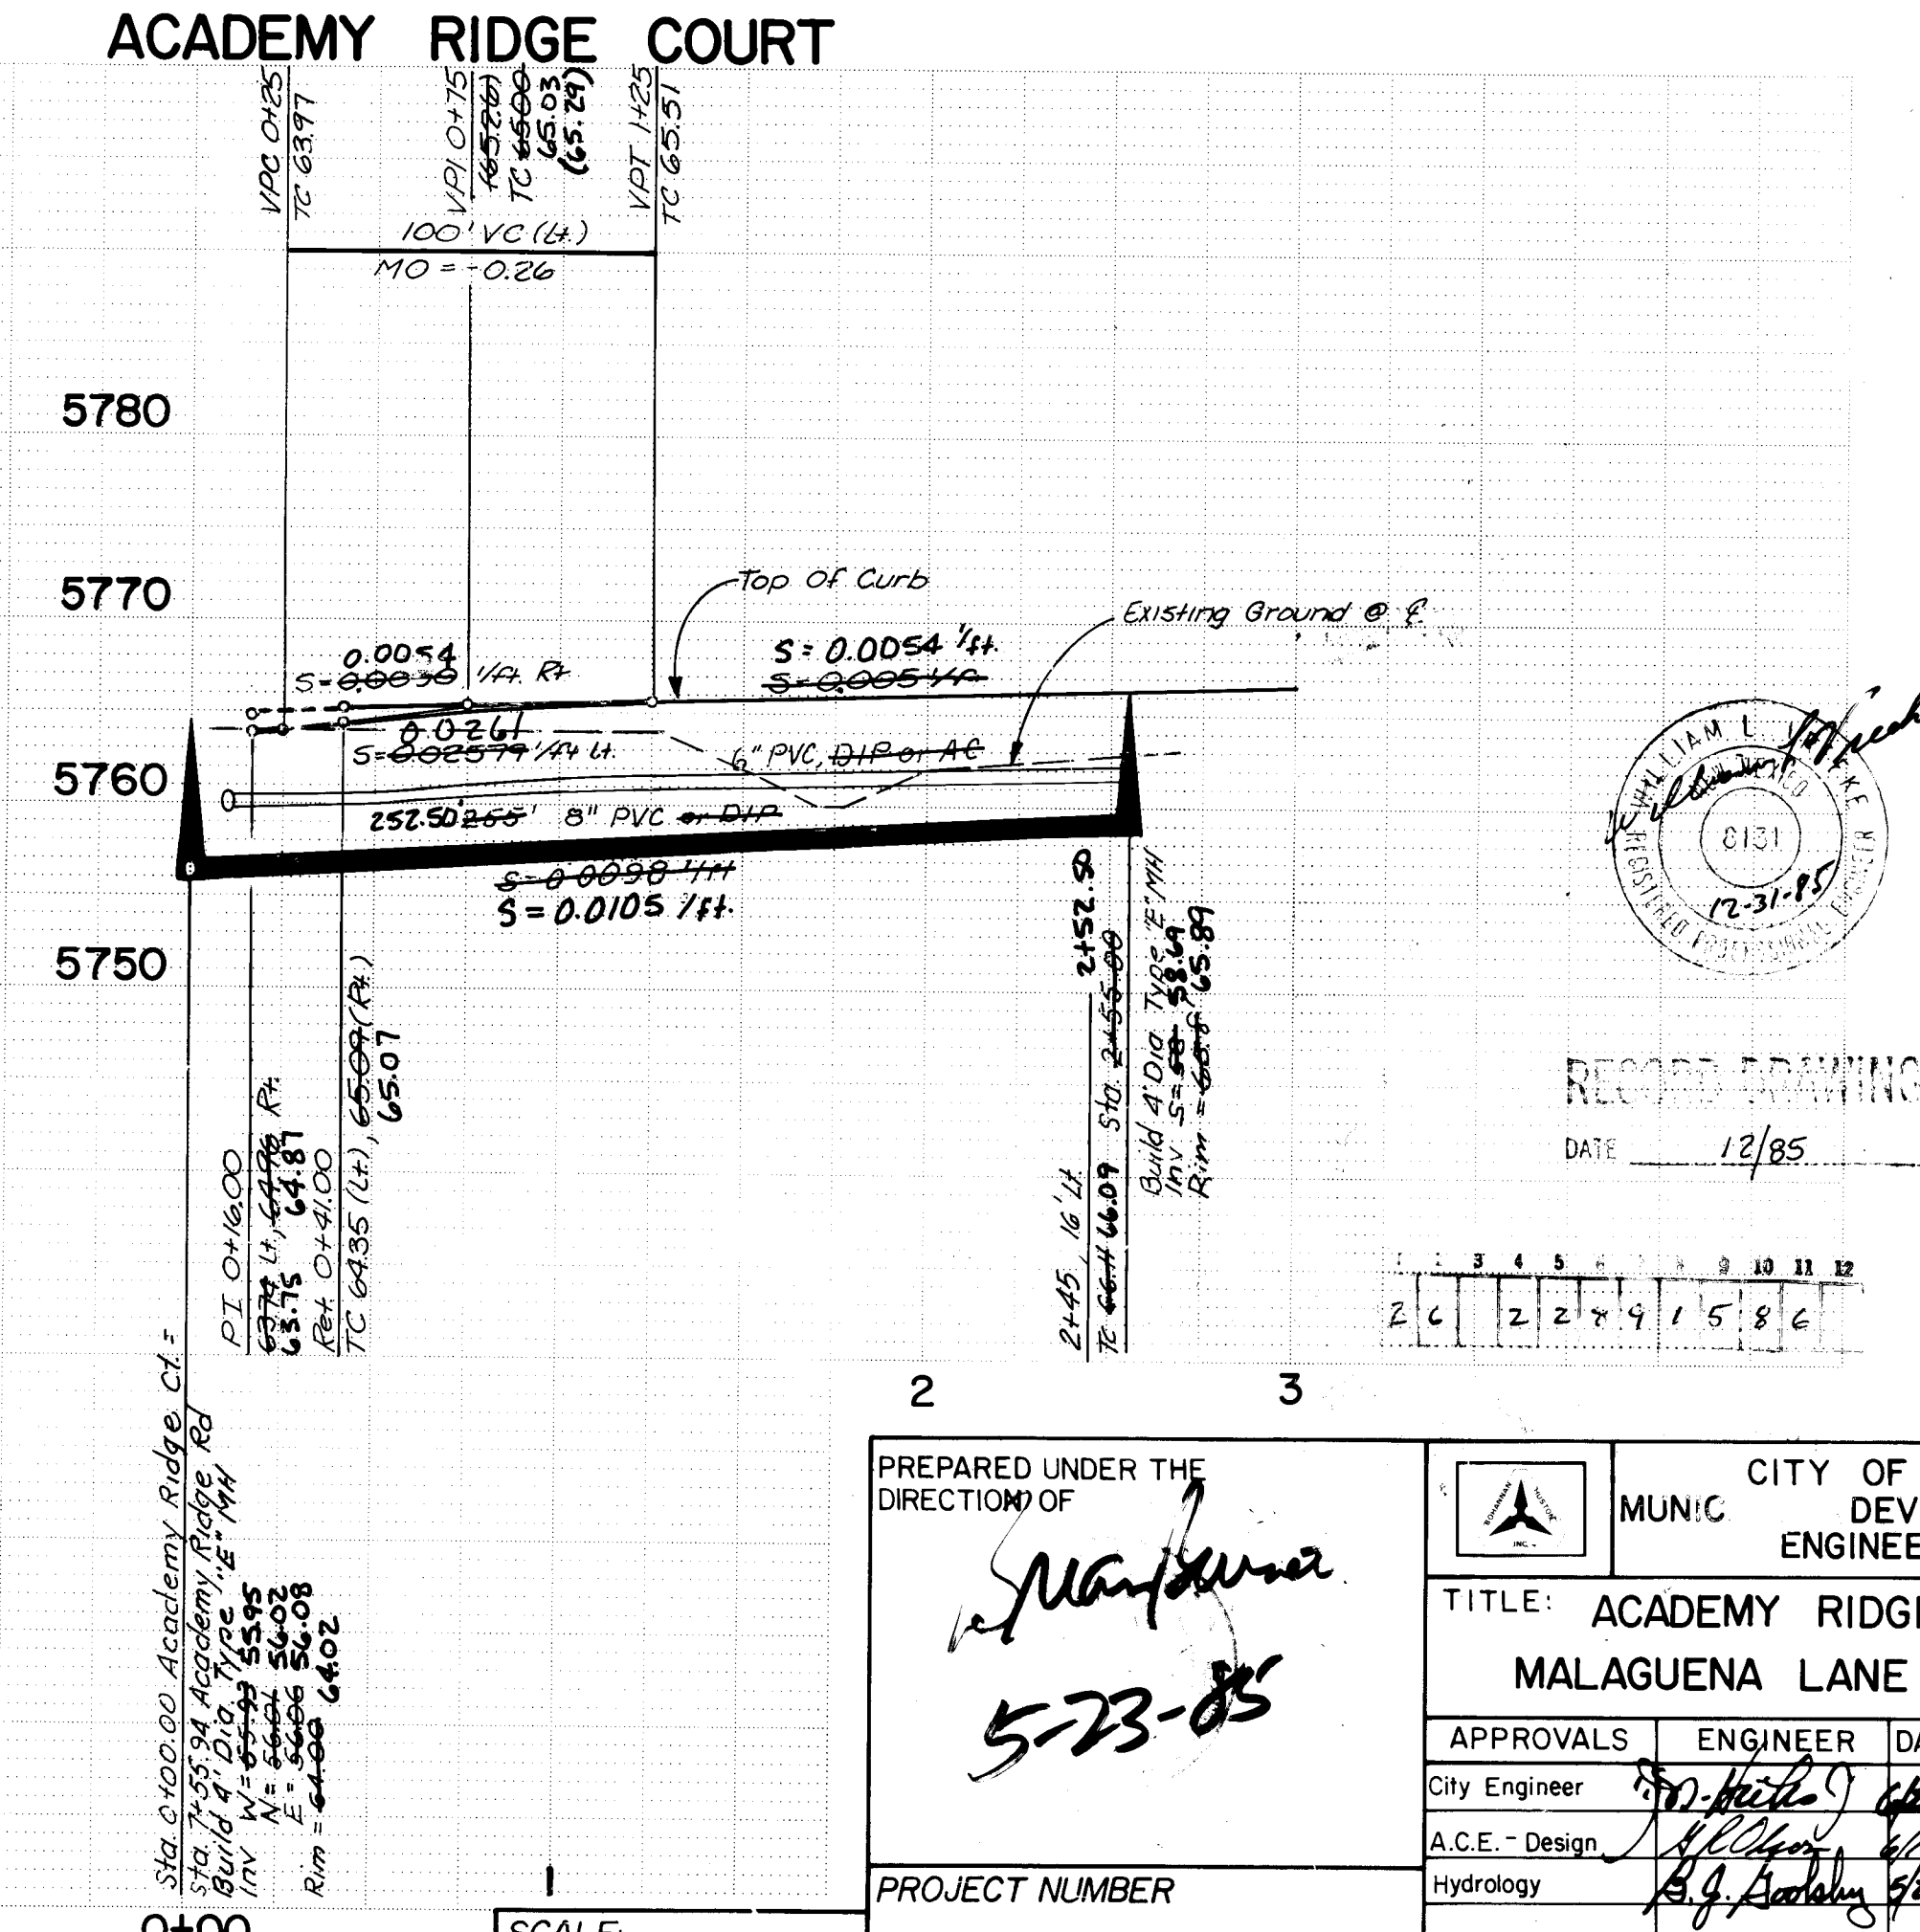

RECORD DRAWING
 DATE 12/85

PREPARED UNDER THE DIRECTION OF <i>Manzana</i> 5-23-85		CITY OF ALBUQUERQUE MUNICIPAL ENGINEERING DIVISION	
TITLE: ACADEMY RIDGE EAST PHASE I MALAGUENA LANE & ACADEMY RIDGE CT.			
APPROVALS	ENGINEER	DATE	APPROVALS
City Engineer	<i>Manzana</i>	1/85	City Engineer
A.C.E. - Design	<i>Manzana</i>	1/85	A.C.E. - Design
Hydrology	<i>Manzana</i>	1/85	Hydrology
PROJECT NUMBER		2289	
DRAWING NO.		SHEET 15 OF 19	

PLATE 1 SINGLE PLAN - PROFILE - DOTTED
 CHARLES BRUNING COMPANY
 MADE IN U.S.A.

F.H.W.A. Region No.			SHEET NO.	TOTAL SHEETS
6	NEW MEXICO			

WATER SERVICE	
TYPE	STATION
Single	1 14 RT
Double	1 69 RT
Double	2 46 RT
Double	3 26 RT
Single	3 95 LT
Double	4 06 RT
	4 40 LT
	4 86 RT
	5 22 LT
	5 66 RT
	6 02 LT
	6 46 RT
	6 82 LT
	7 26 RT
	8 06 RT
	8 30 LT
Single	8 70 LT
Double	8 86 RT
Double	9 66 RT

SANITARY	SEWER	SERVICE
STA	LENGTH	INV. @ PLUG
1+25 1+25 RT.	25' 26'	34.40
1+26 1+26 RT.	26' 20'	35.31.54
1+27 1+27 RT.	25' 26'	36.00.81
2+19 Rt.	26'	38.00.03
2+56 Rt.	26'	39.47.72
2+96 Rt.	26'	40.95.41.16
2+10 Lt.	26'	41.02.61
3+36 Rt.	26'	42.02.44

3+76 Rt	26'	43 88.86
4+92 Lt	26'	44 94.55
4+117 Rt	26'	45 96.70
4+50 LI (MH)	26'	46 98.44
4+80 Rt	26'	46 92.47
4+92 Lt	26'	48 92.40
4+117 Rt	26'	48 96.65

5+33 Lt.	26'	50.12
5+32 Lt.	26'	49.66
5+31 Lt.	26'	49.96
5+30 Lt.	26'	51.09
5+29 Lt.	26'	51.24
5+28 Lt.	26'	52.15
5+27 Lt.	26'	52.68
5+26 Lt.	26'	53.97

6+56 Rt.	26'	54.44.
6+92 Lt.	26'	55.44
6+96 Rt.	26'	55.58
7+32 Rt.	26'	56.99
7+10 Rt.	26'	58.33
8+05 Lt.	26'	59.23
8+16 Rt.	26'	59.5

40	8+40 Lt	26'	60
50	8+50 Rt	26'	60
57	8+70 Lt	26'	61
7.72	8+70 Rt	26'	62
9.11	9+80 Lt	26'	62
10.52	9+80 Rt	26'	63
	9+77 Lt	26'	64
	9+77 Rt	26'	65

NOTE:
SEE SHEET 18
STORM DRAIN DET

Sta 7+45.94 10' Lt A
Install
1-8" x 8" x 6" Tee
1-8" Gate Valve w/typ
1-6" Gate Valve w/typ
245 LF 6" PVC, DiPa
1-6" Cap
Blocking

Academy Ridge Road

Sta. 10+35.94
Sta 2+05.00
Install
1'-8" x 8" Cross
1'-8" x 6" Redd
2'-8" Gate Val
60 L F 8" PVC

10' Lt Academy Ridge Road =
10' Lt Carruthers Street

[illegible][illegible][illegible]

MAP NO.	EST. NO.	WORK	KLD	BY	
		R	KLD		
					1/85
					1/85
					1/85

	REMARKS	DATE
	REVISIONS	DATE
	DESIGN	DATE

			2	9/9/85	AD
			1	7/23/85	
			NO.	DATE	


DESIGNED BY
DRAWN BY
CHECKED BY

RQUE
 DEPARTMENT
 ON

PHASE I		
LOAD		
VALS	ENGINEER	DATE
Poste	W. J. (Penny) Pabst	5/27/85
	Daniel W. Hanna	5/27/85


William S. Bell, E. 29, 1935

SHEET	16	OF 19

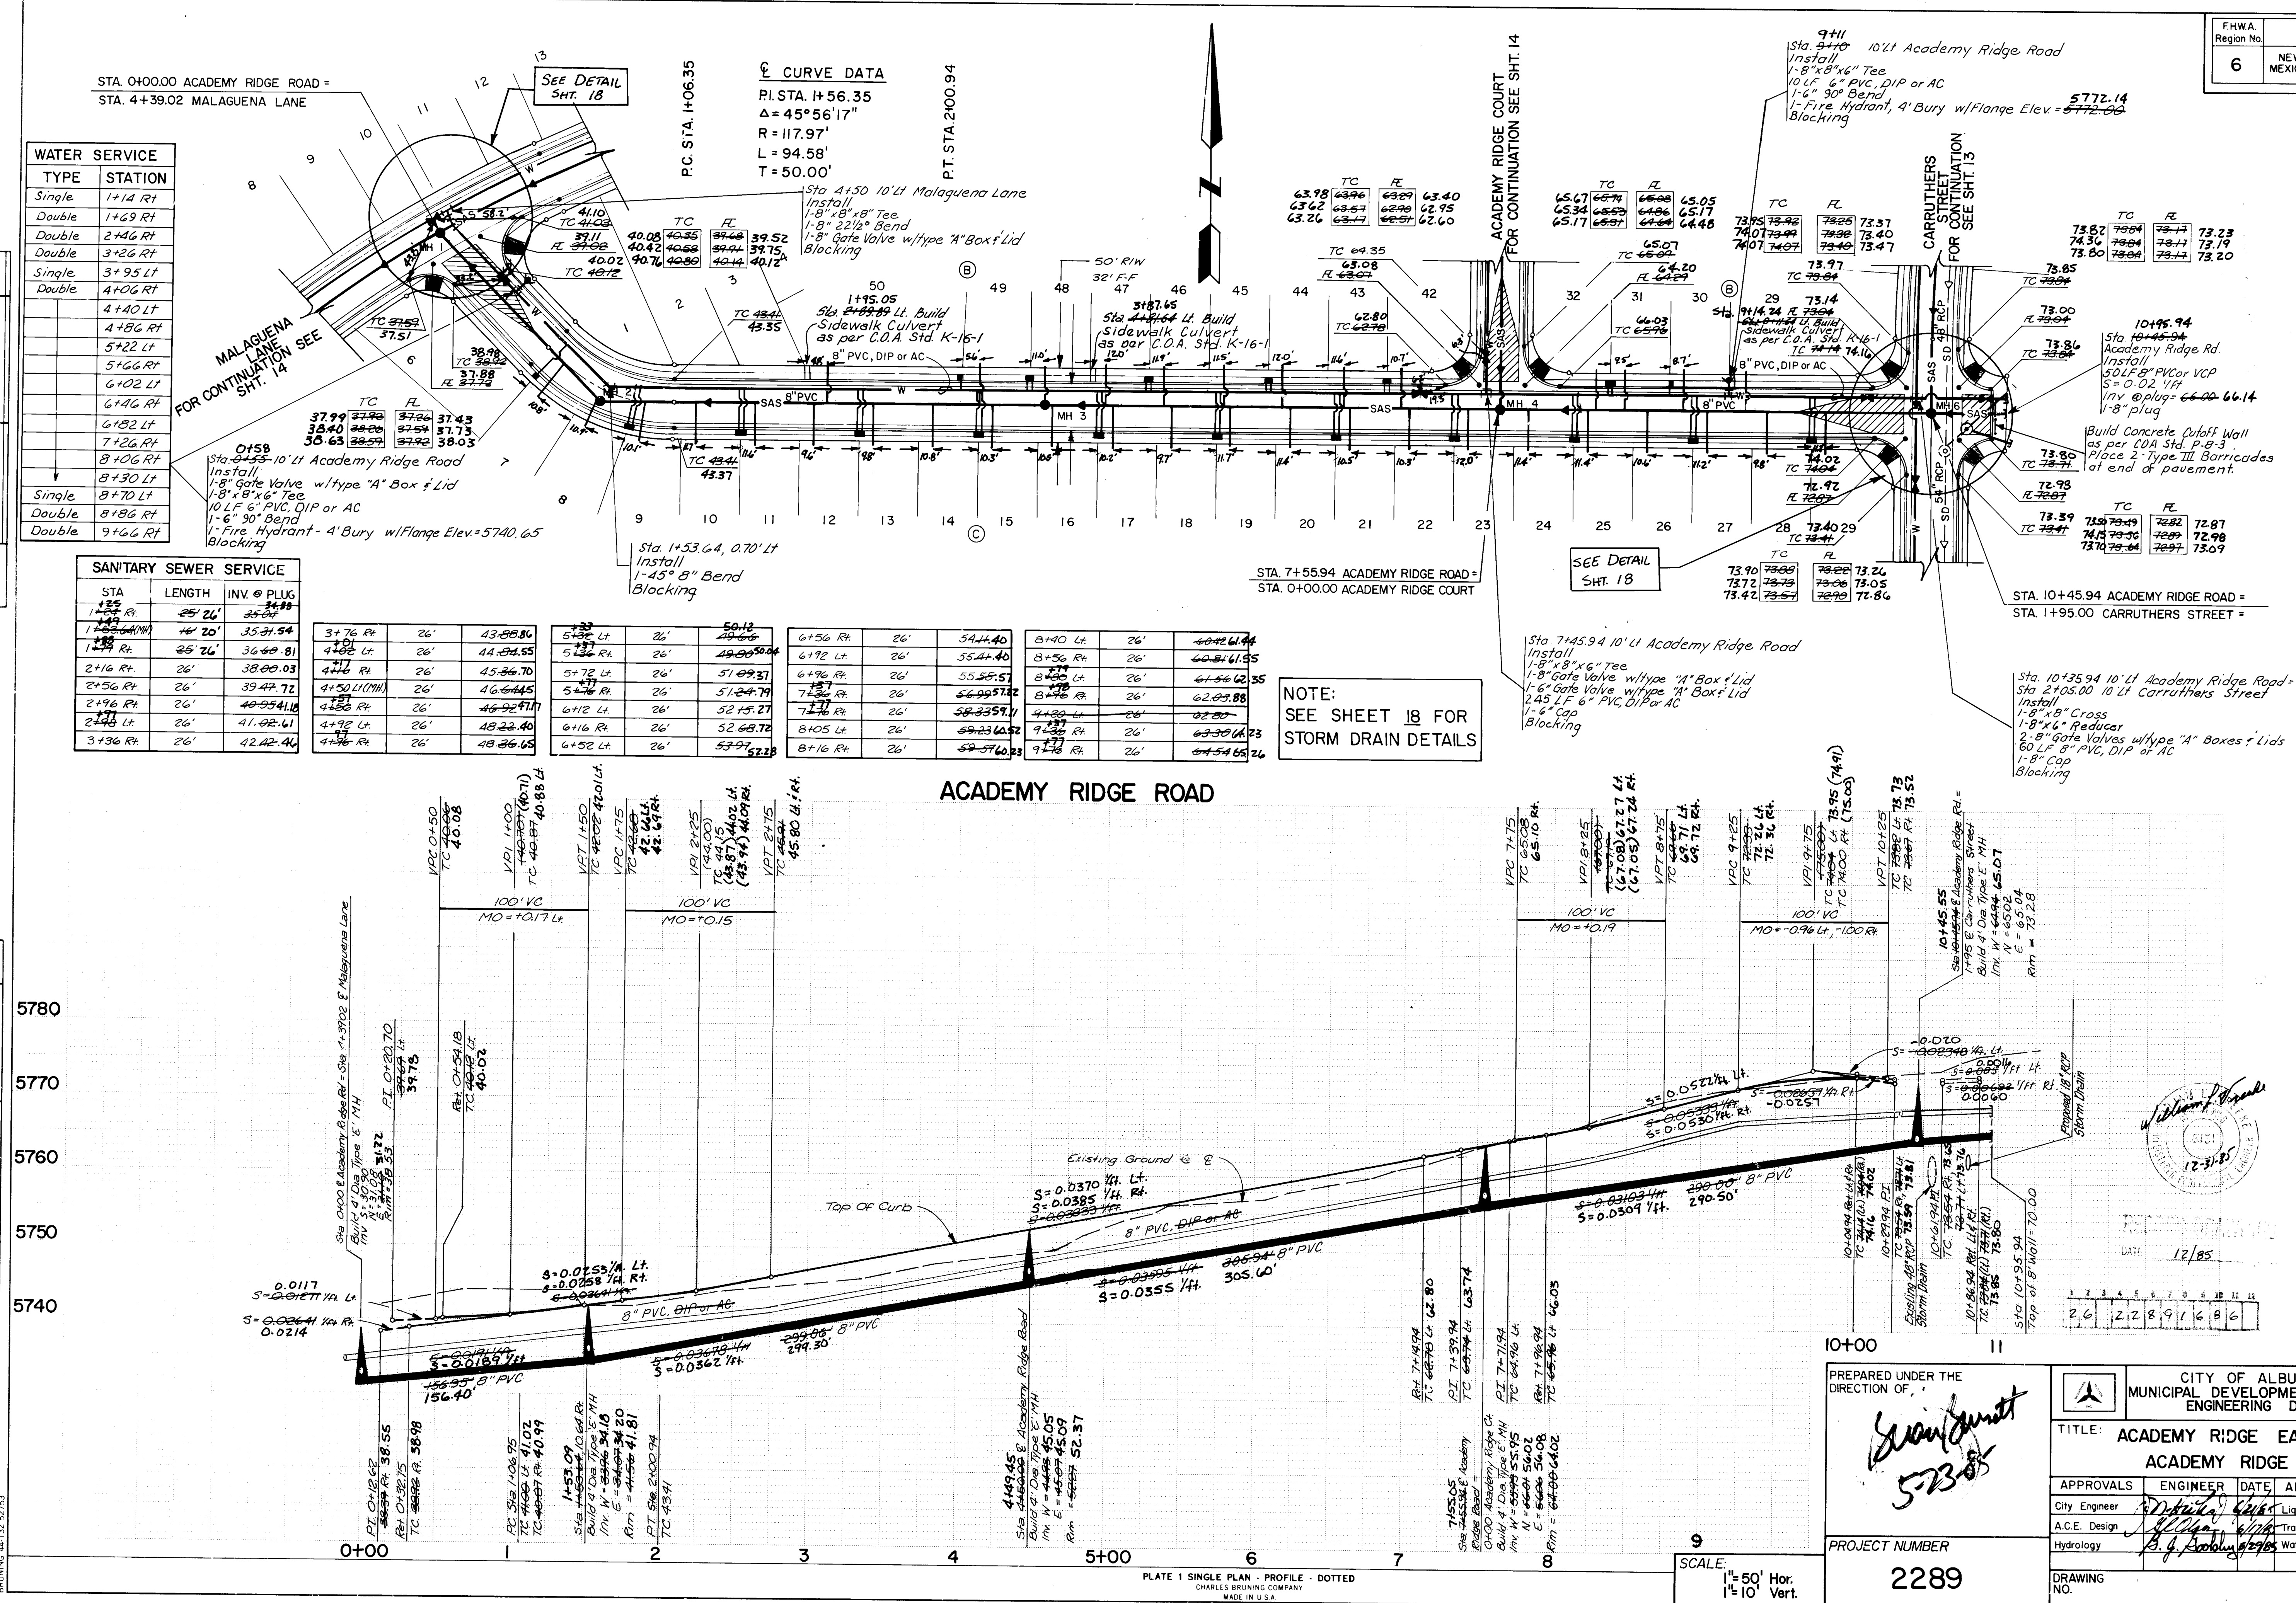

PLAN	DATE	BY	DATE
SURVEYED			
NOTED			
PLANNED			
DESIGNED			
CHECKED			
APPROVED			





PROFILE	DATE	BY	DATE
SURVEYED			
NOTED			
PLANNED			
DESIGNED			
CHECKED			
APPROVED			

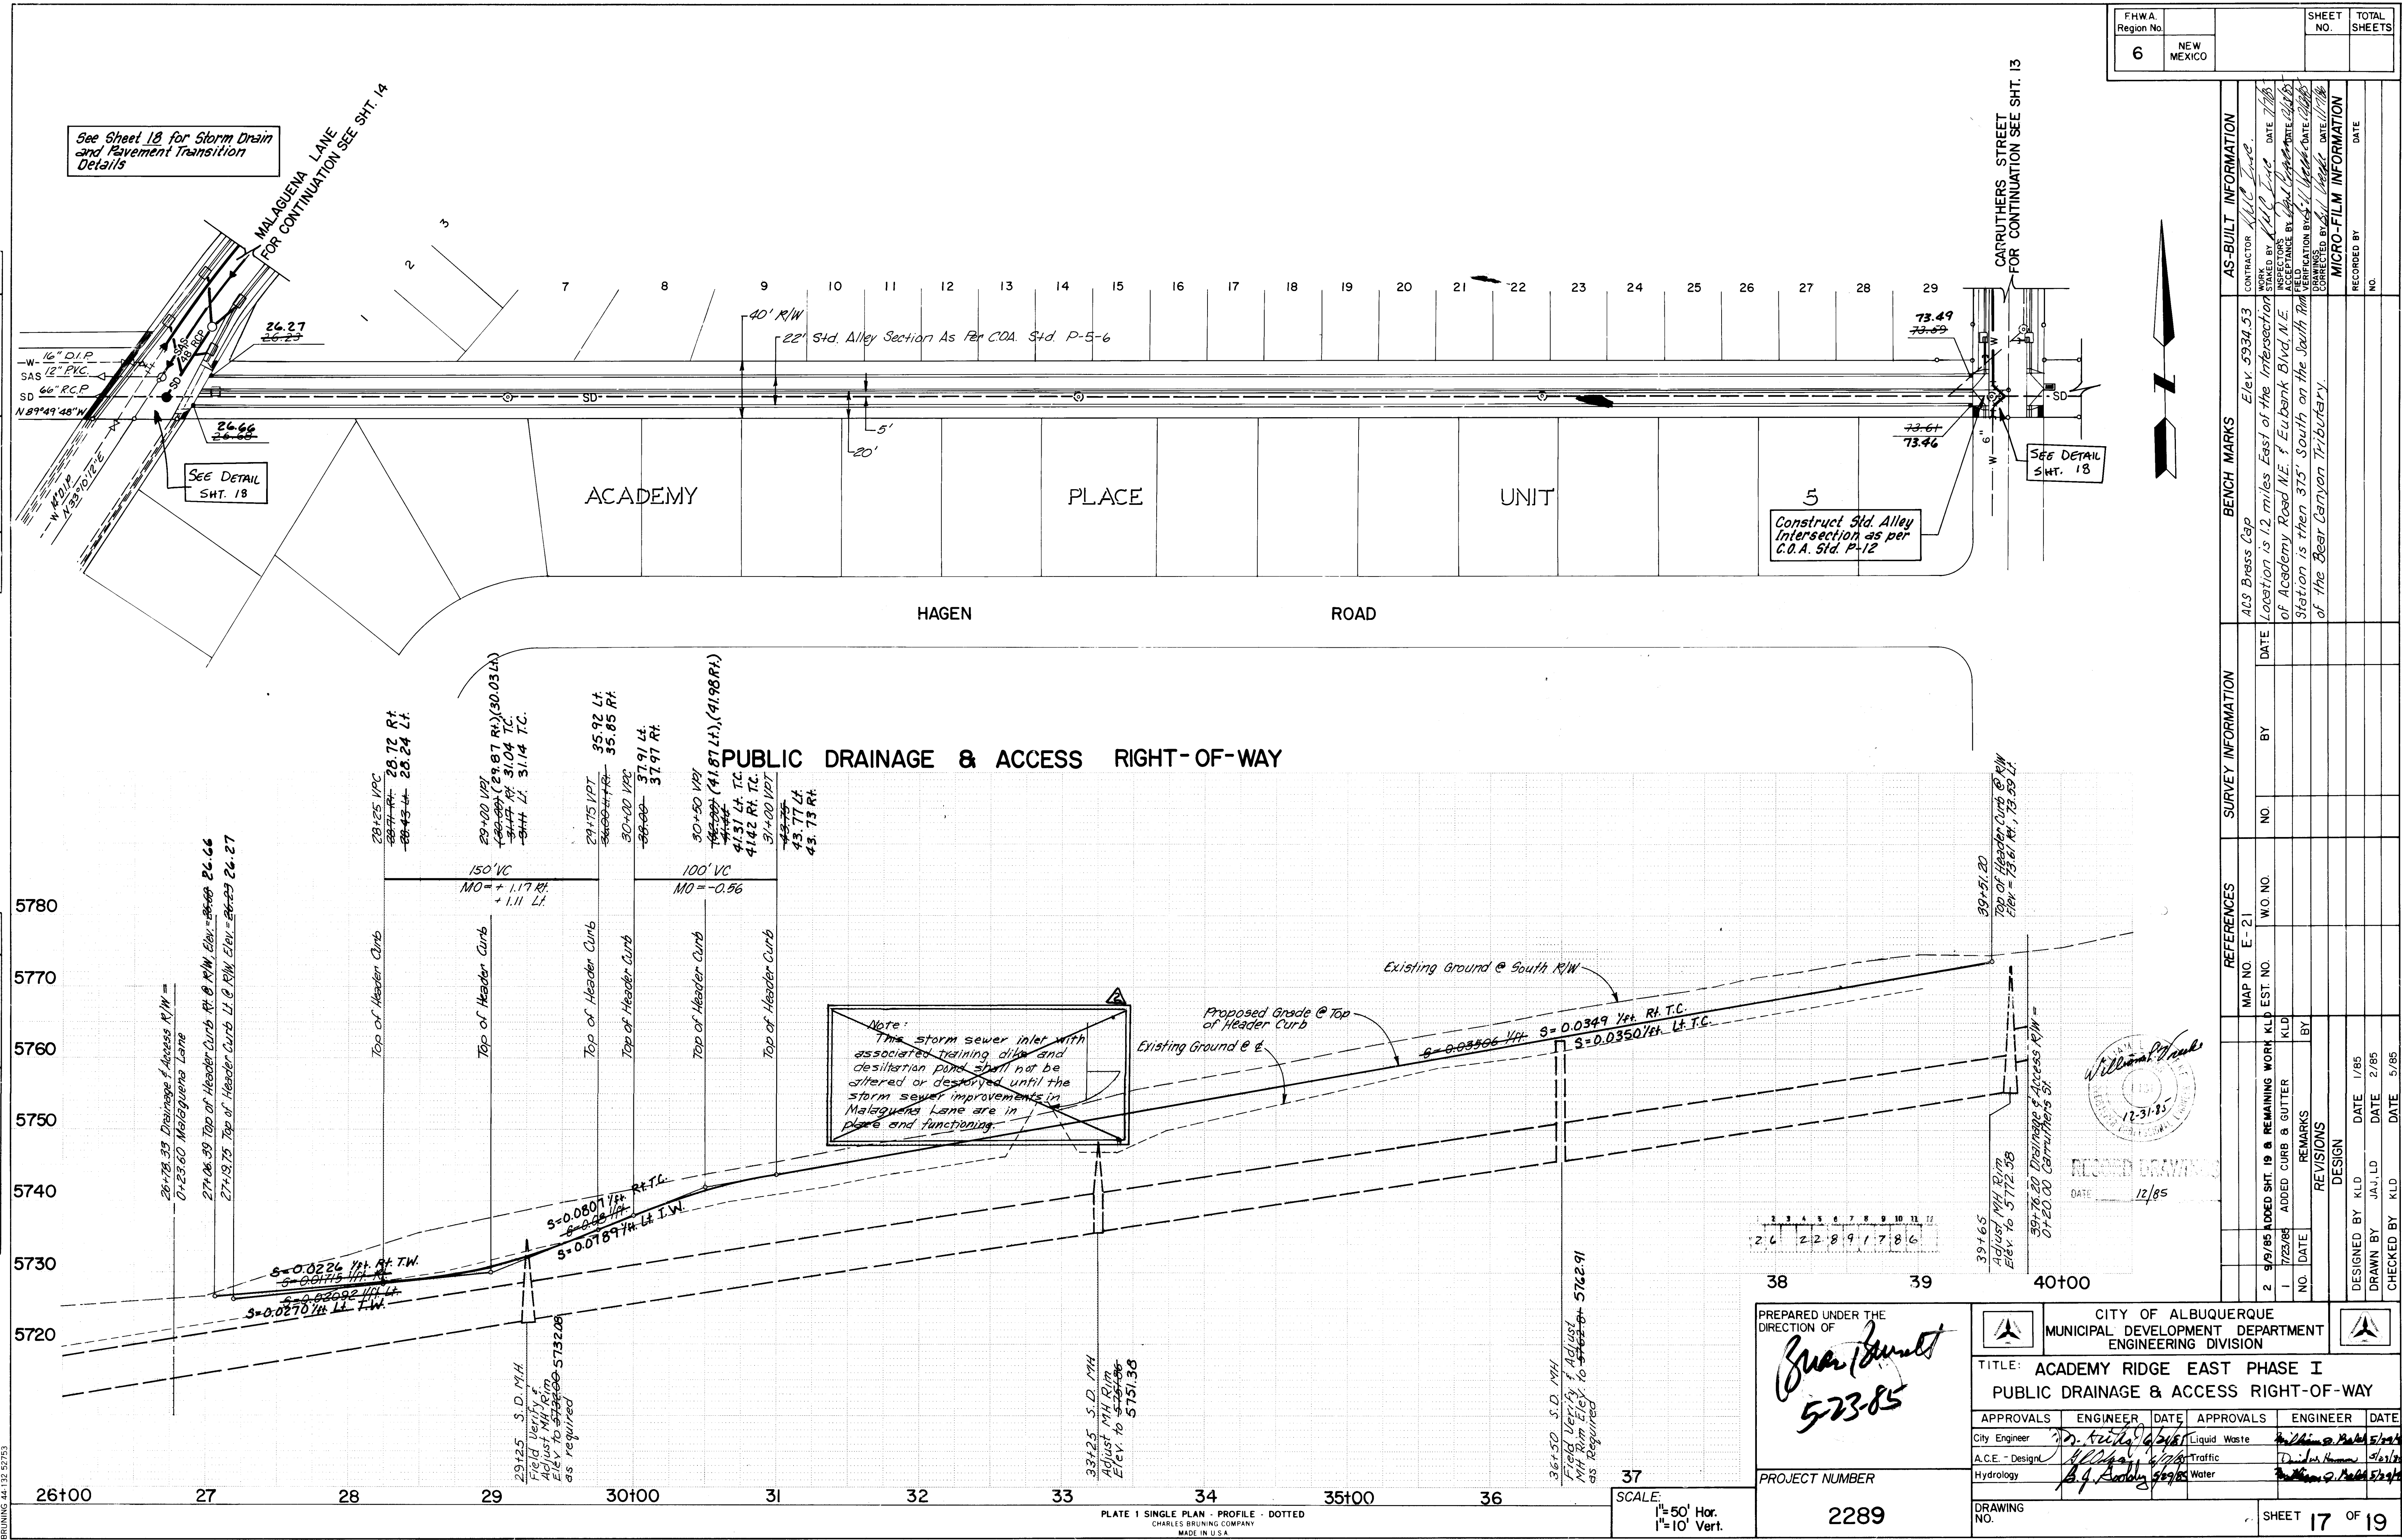

FHWA Region No.	NEW MEXICO	SHEET NO.	TOTAL SHEETS
6			

AS-BUILT INFORMATION	BENCH MARKS	SURVEY INFORMATION	REFERENCES	REVISIONS	DESIGN
CONTRACTOR: <i>K&C Inc.</i> WORKED BY: <i>K&C Inc.</i> DATE: <i>12/85</i> ACCEPTANCE BY: <i>John P. [Signature]</i> DATE: <i>12/85</i> DRAWINGS BY: <i>John P. [Signature]</i> CHECKED BY: <i>John P. [Signature]</i> DATE: <i>12/85</i>	ACS Brass Cap Elev. 5334.53 Location is 1.2 miles East of the Intersection of Academy Road NE. of Eubank Blvd. N.E. Station is then 375' South on the South Side of the Bear Canyon Tributary.	DATE: <i>12/85</i> BY: <i>John P. [Signature]</i> NO. <i>1</i>	MAP NO. E-21 W.O. NO. <i>1</i> KLD. <i>1</i> BY: <i>John P. [Signature]</i> DATE: <i>12/85</i>	REMARKS: <i>1</i> DATE: <i>12/85</i>	DESIGNED BY: <i>John P. [Signature]</i> DATE: <i>1/85</i> DRAWN BY: <i>John P. [Signature]</i> DATE: <i>2/85</i> CHECKED BY: <i>John P. [Signature]</i> DATE: <i>5/85</i>

PREPARED UNDER THE DIRECTION OF <i>John P. [Signature]</i> <i>5/23/85</i>	CITY OF ALBUQUERQUE MUNICIPAL DEVELOPMENT DEPARTMENT ENGINEERING DIVISION	TITLE: ACADEMY RIDGE EAST PHASE I PUBLIC DRAINAGE & ACCESS RIGHT-OF-WAY
APPROVALS City Engineer: <i>John P. [Signature]</i> A.C.E. - Design: <i>John P. [Signature]</i> Hydrology: <i>John P. [Signature]</i>	ENGINEER DATE: <i>12/85</i> APPROVALS ENGINEER DATE: <i>12/85</i>	PROJECT NUMBER 2289
DRAWING NO. <i>1</i>	SHEET 17 OF 19	

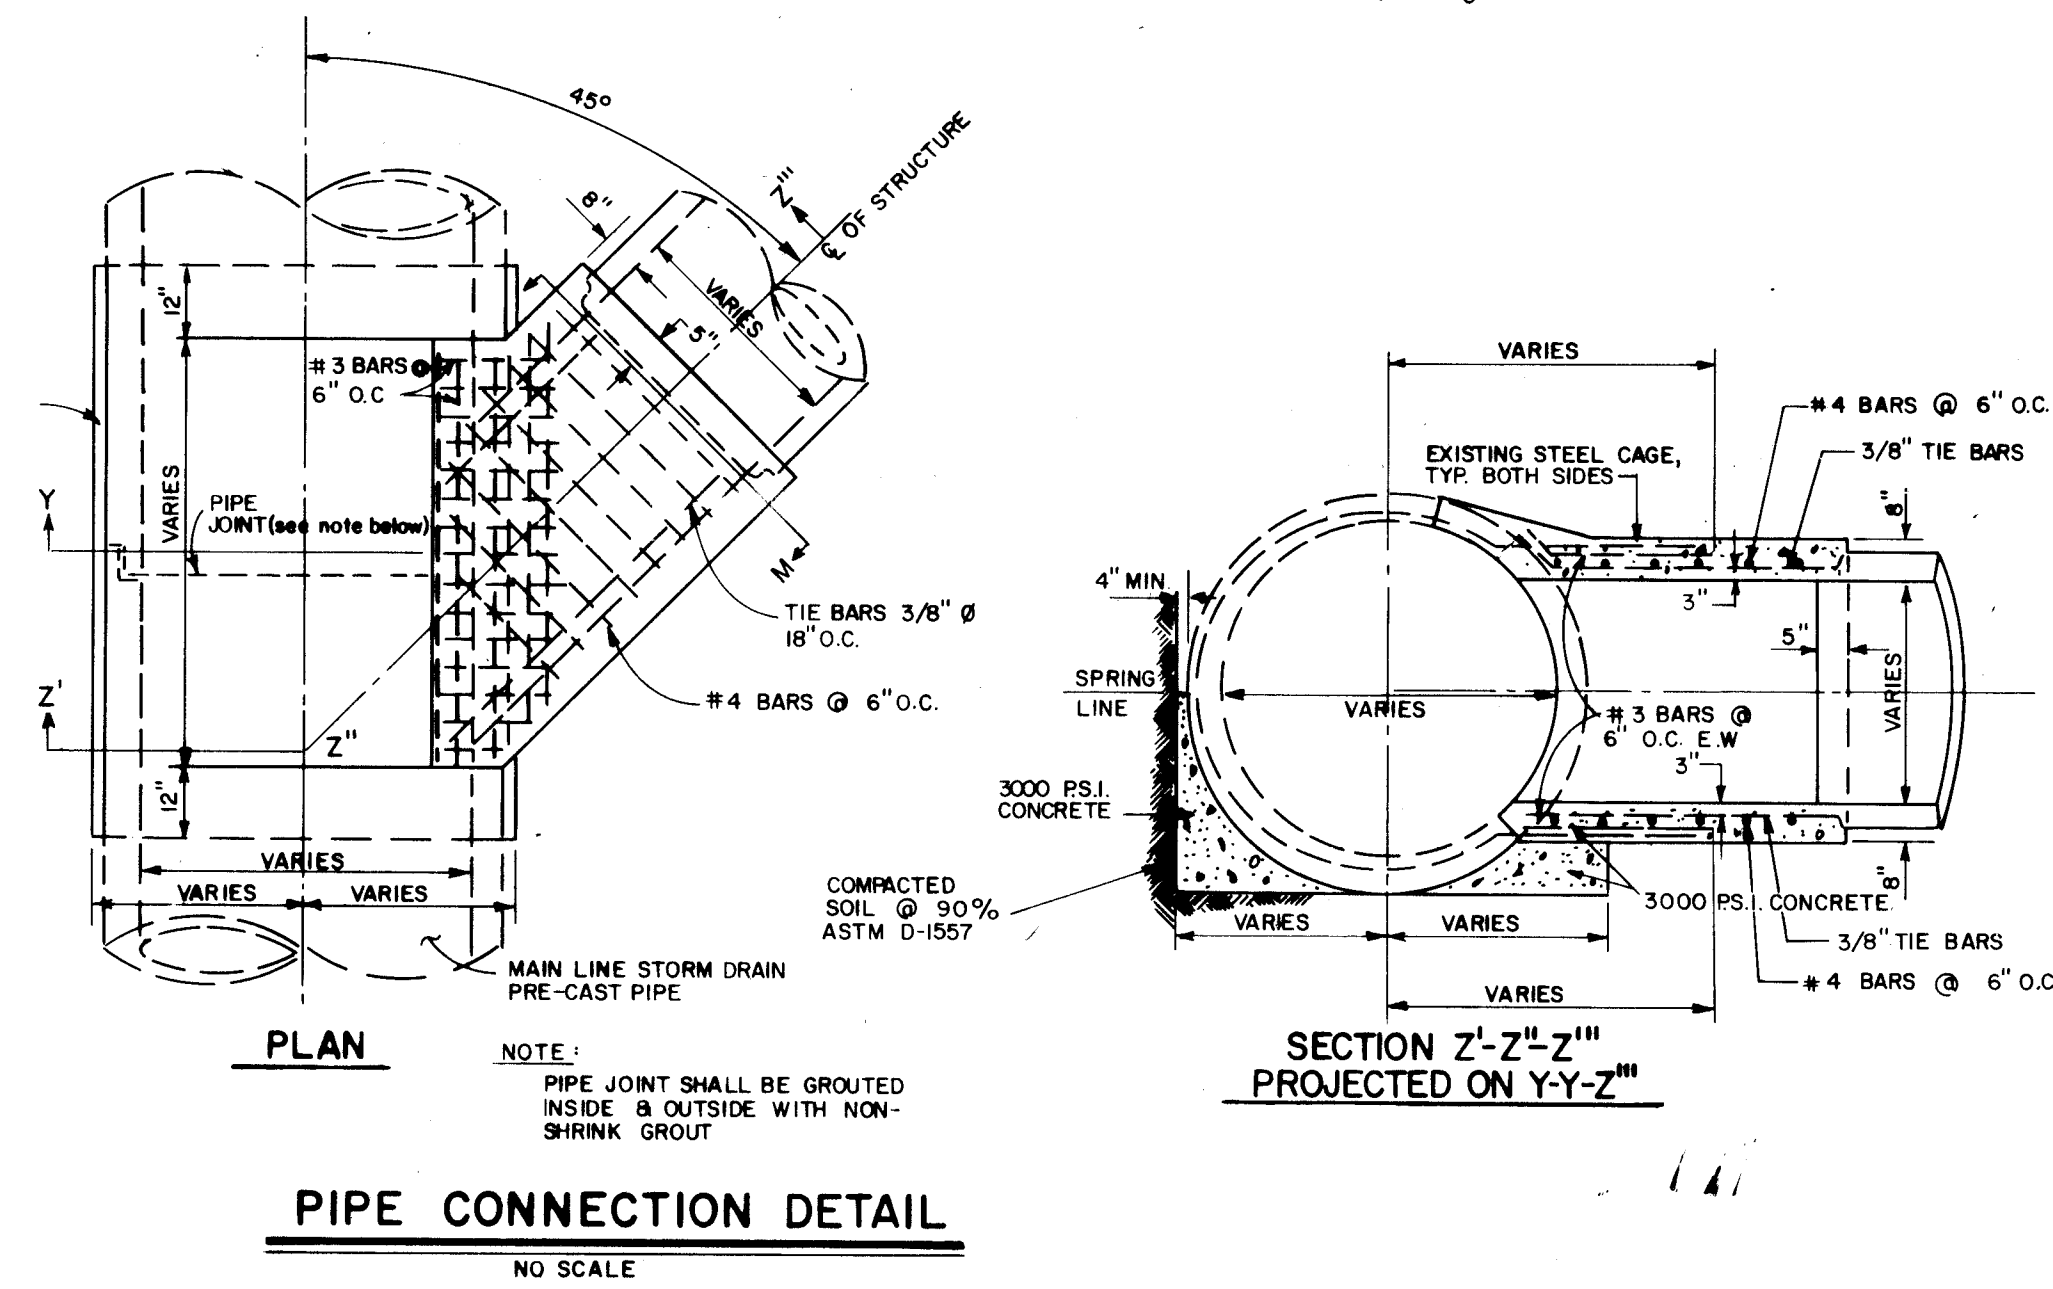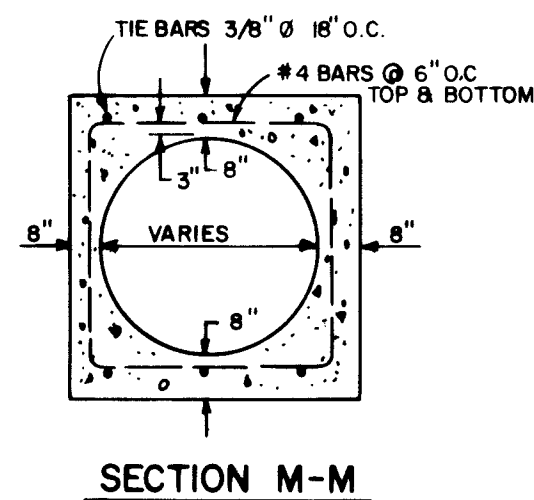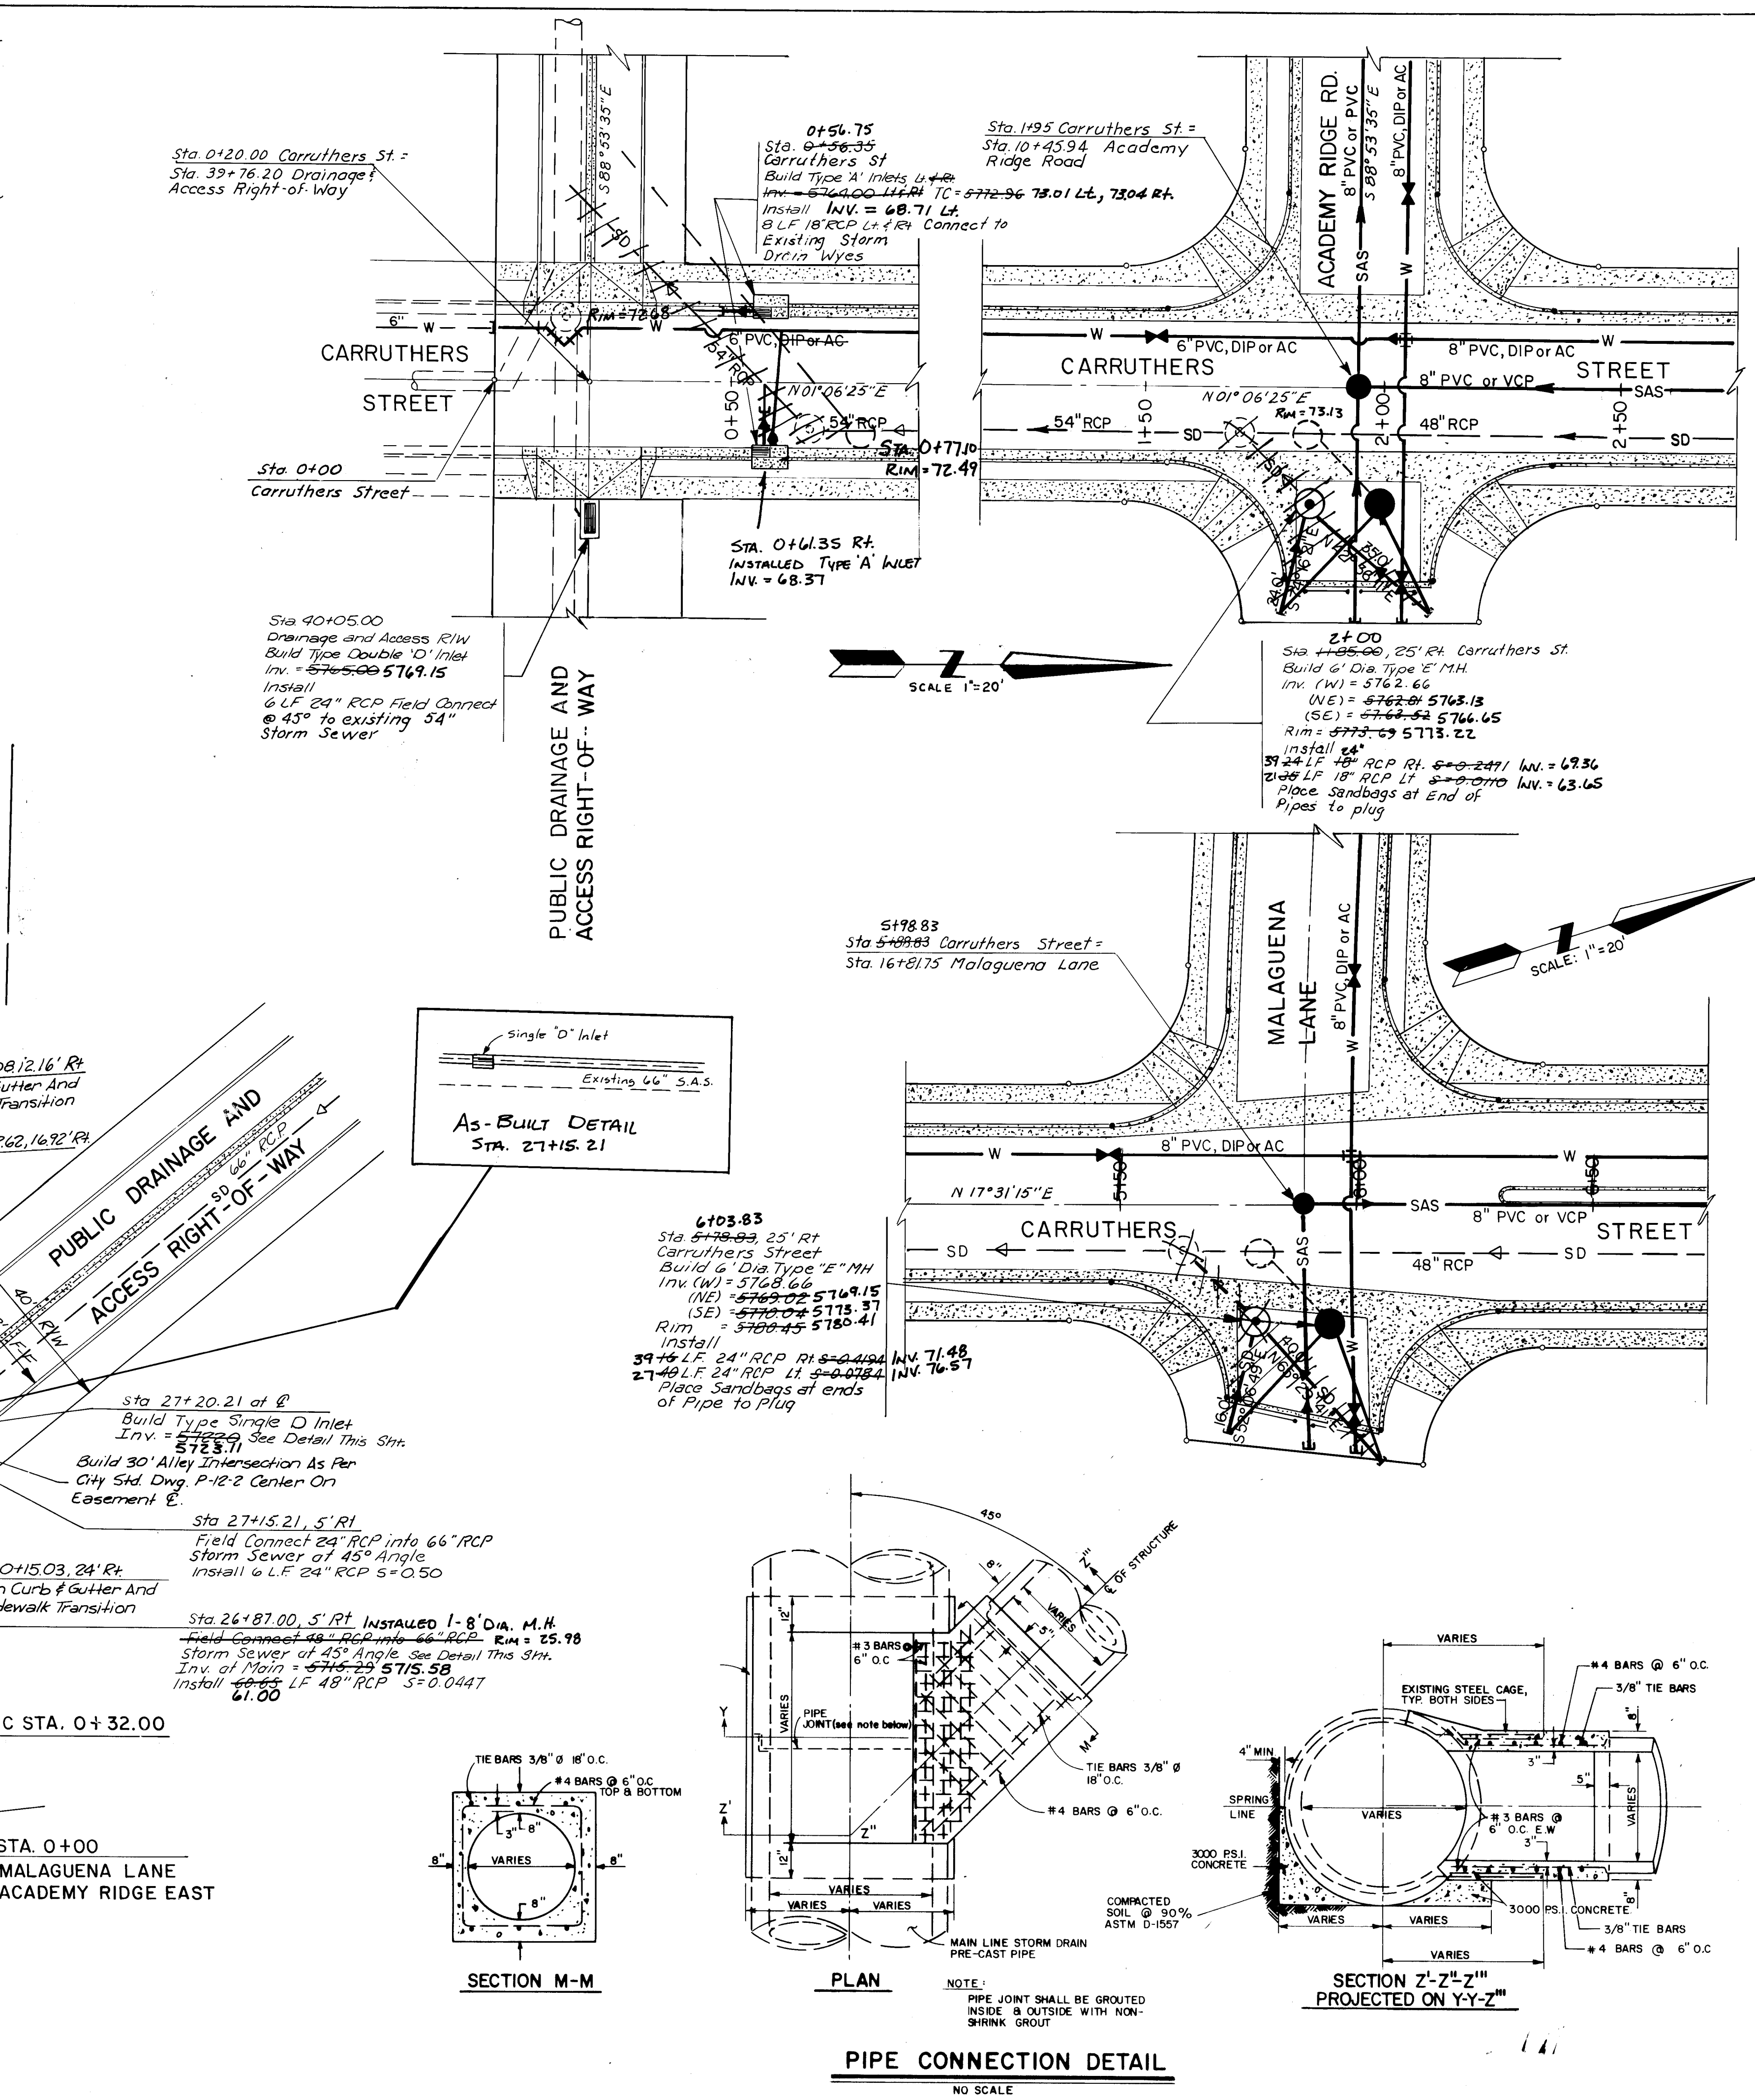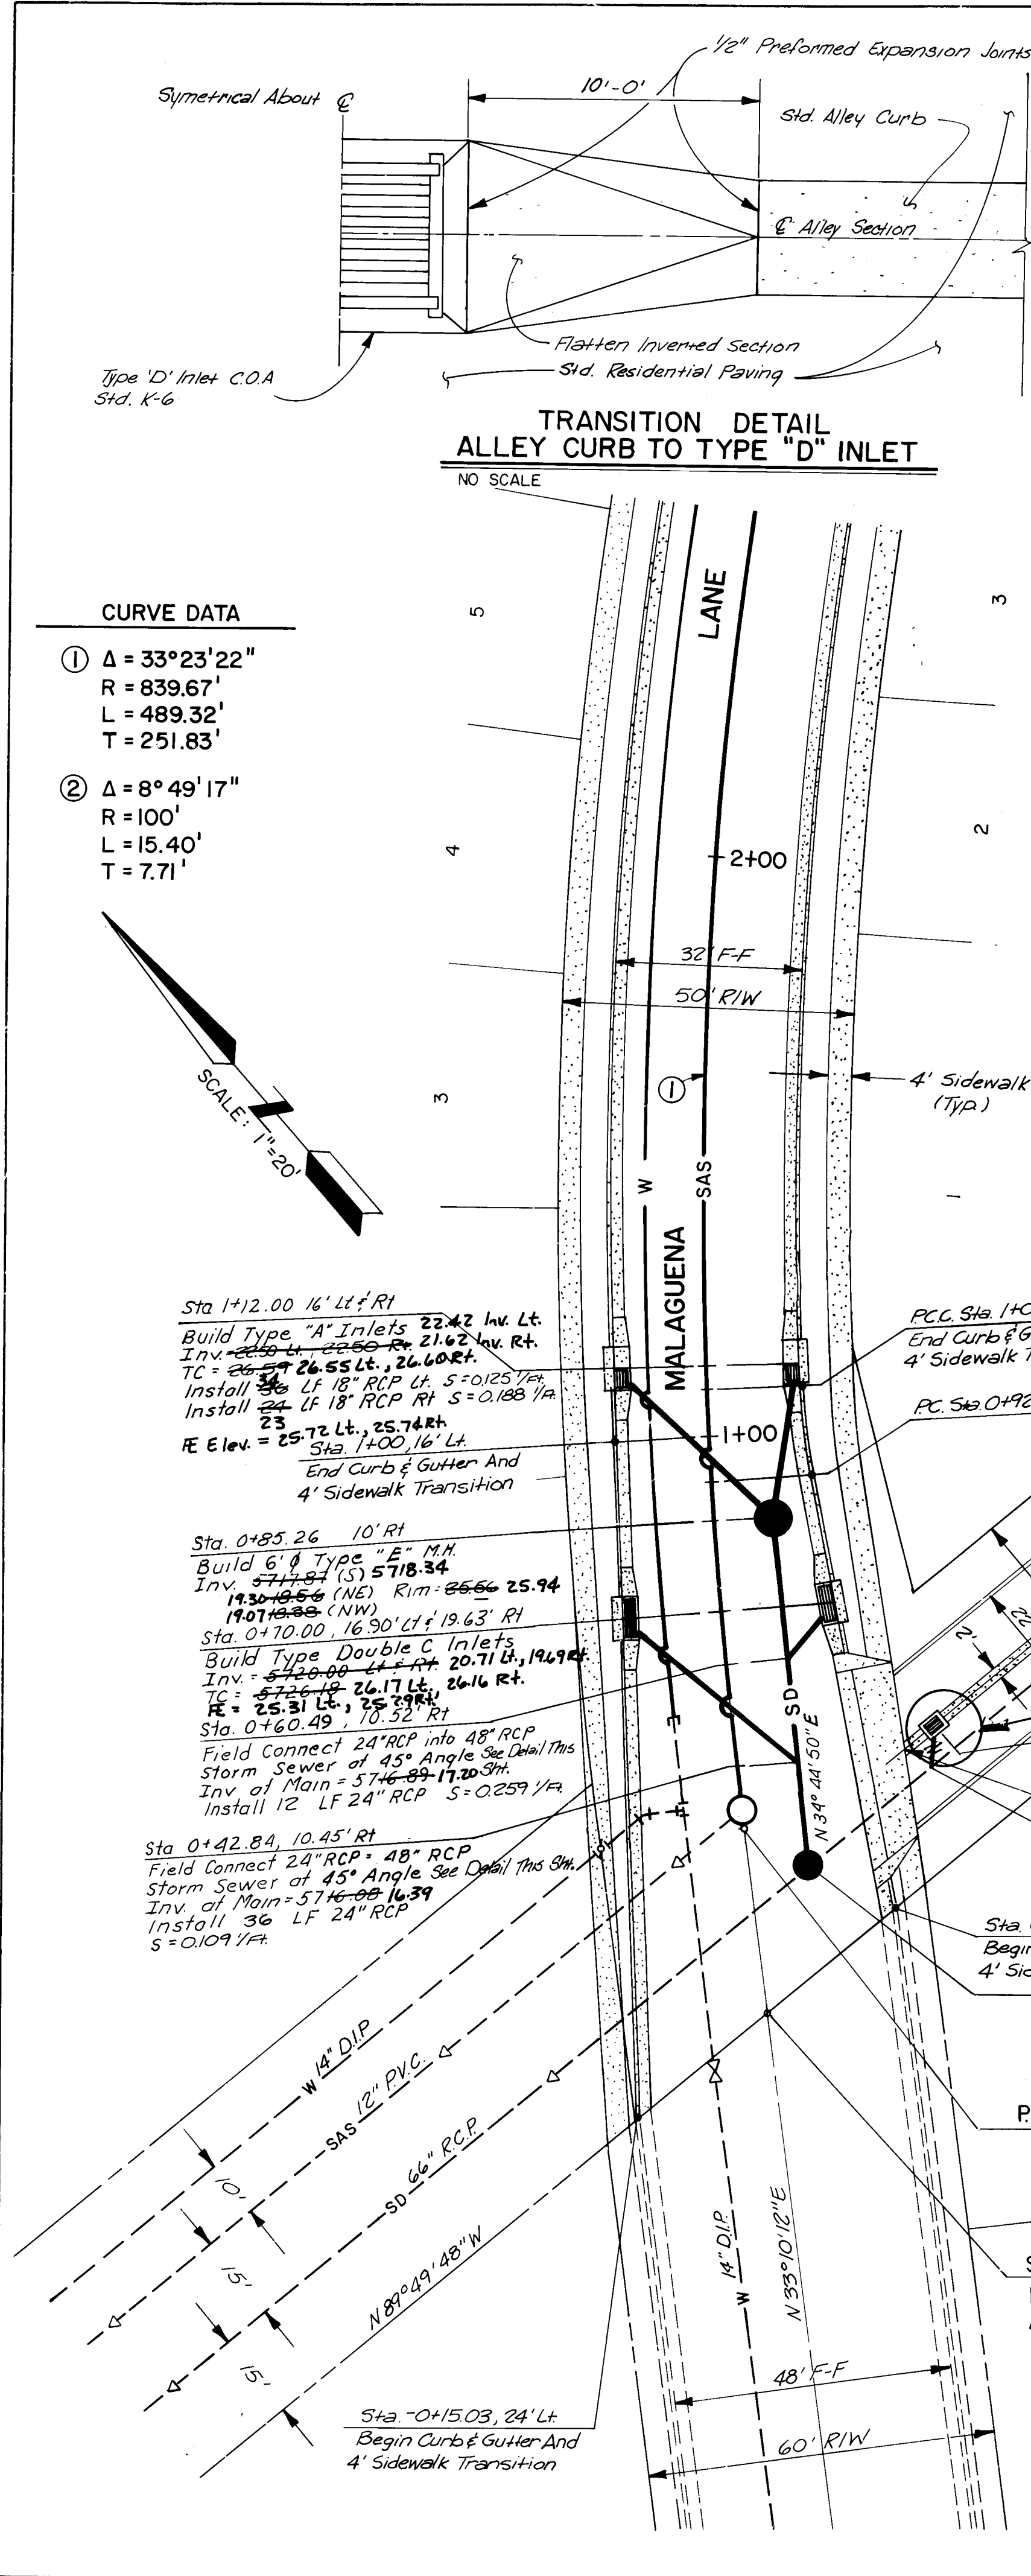




FHWA Region No.		NEW MEXICO		SHEET NO.		TOTAL SHEETS	
6							

AS-BUILT INFORMATION		BENCH MARKS		SURVEY INFORMATION		ENGINEER'S SEAL	
CONTRACTOR	DATE	FIELD NOTES	BY	NO.	DATE	KLD	BY
STATED BY	DATE						
INSPECTOR'S	DATE						
FIELD CHECK	DATE						
VERIFICATION	DATE						
CORRECTION	DATE						

REVISIONS		DESIGN	
NO.	DATE	DESIGNED BY	DATE
1	12/85	DRAWN BY	DATE
2	12/85	CHECKED BY	DATE


CITY OF ALBUQUERQUE MUNICIPAL DEVELOPMENT DEPARTMENT ENGINEERING DIVISION			
TITLE: ACADEMY RIDGE EAST PHASE I MISCELLANEOUS DETAILS			
APPROVALS	ENGINEER	DATE	APPROVALS
City Engineer	5/21/85	5/21/85	Liquid Waste
A.C.E. Design	5/21/85	5/21/85	Traffic
A.C.E. Hydrology	5/21/85	5/21/85	Water

DRAWING NO.	2289	MAP NO. E-21	SHEET 18	OF 19
----------------	------	-----------------	-------------	----------

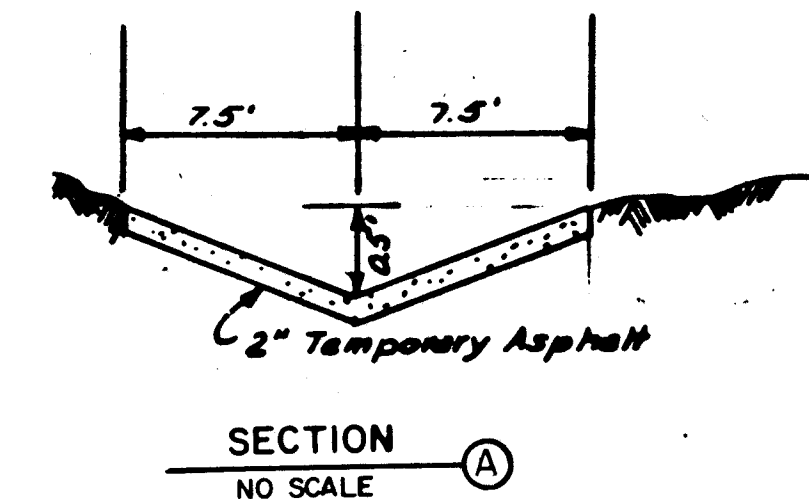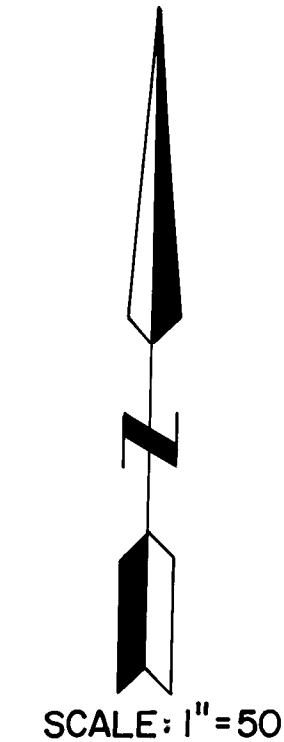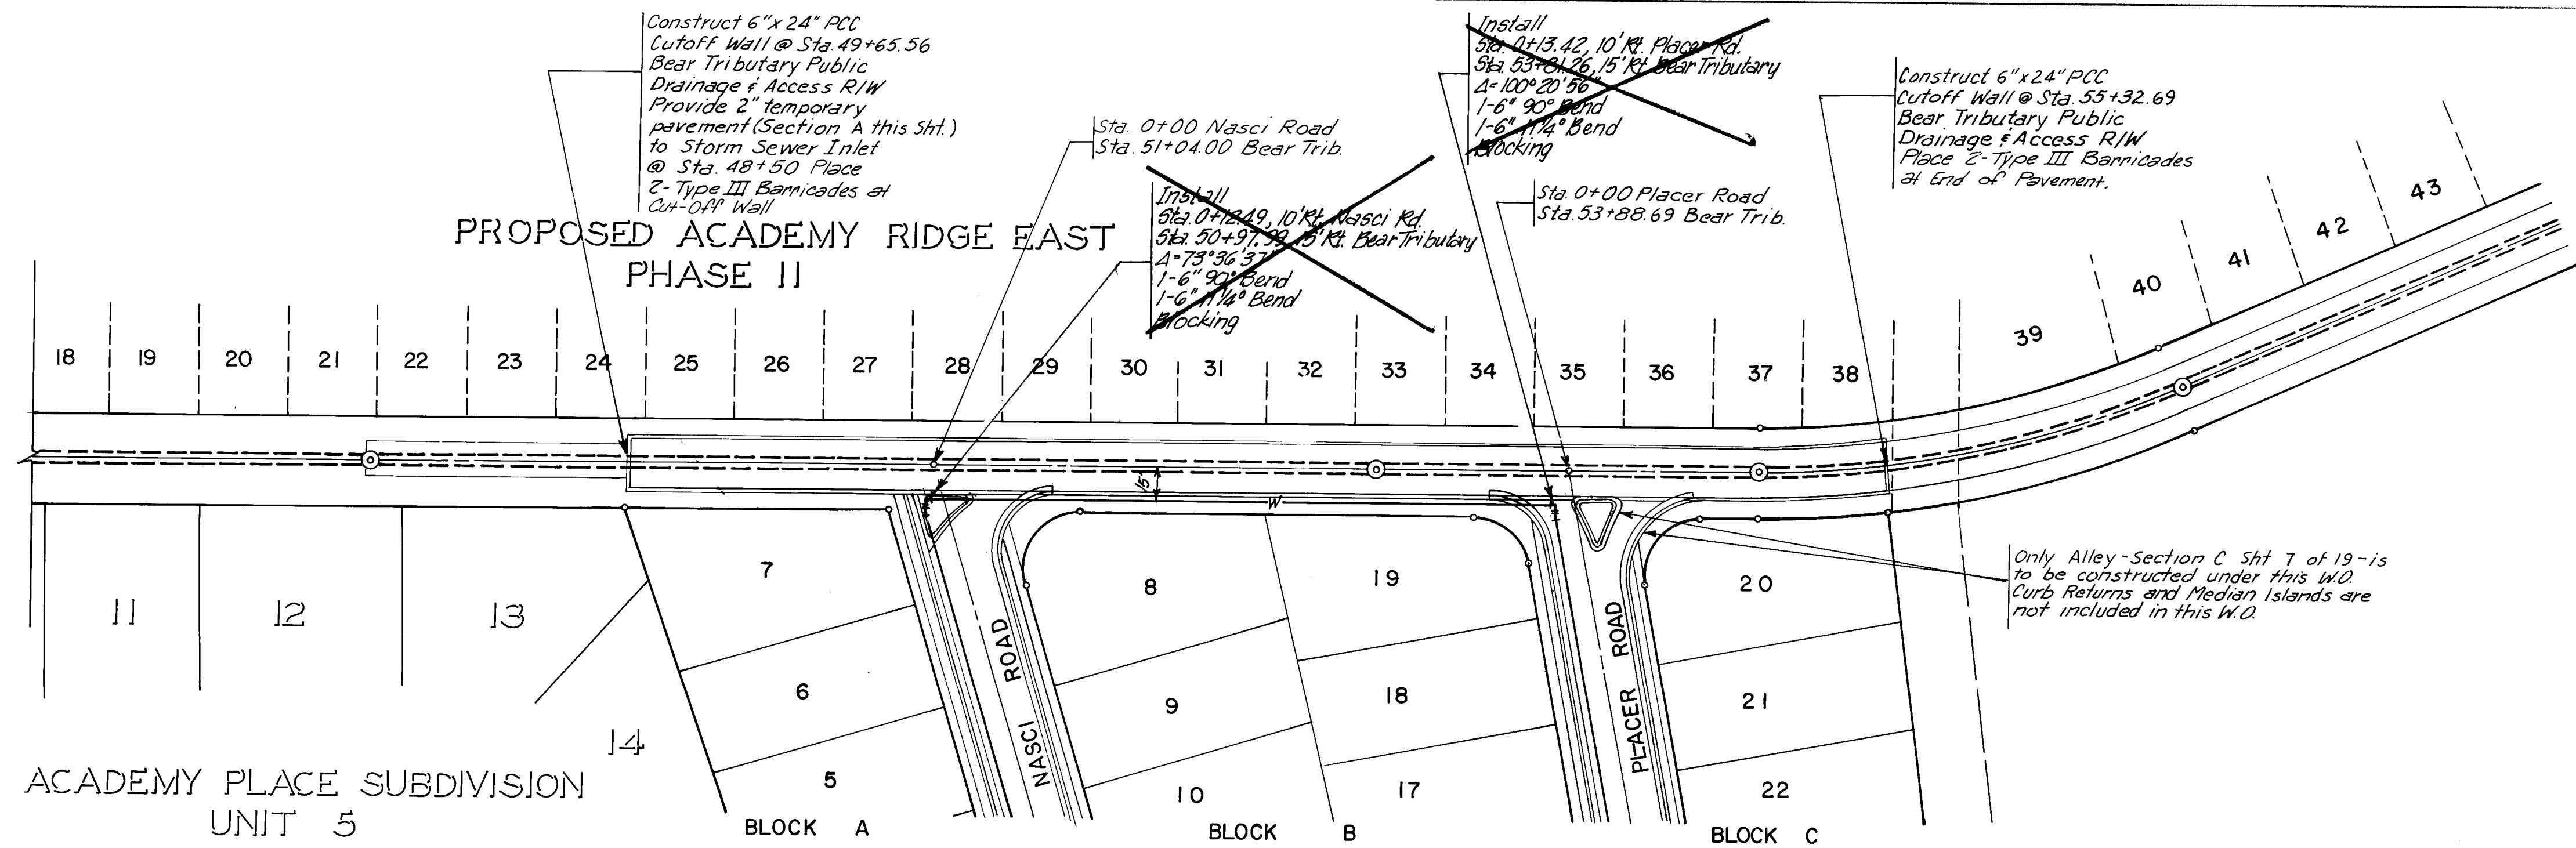

THIS SHEET IS FOR PAVING IMPROVMENTS FOR THE BEAR TRIBUTARY ONLY. PAVING FOR NASCI RD. & PLACER RD. & ALL WATER FACILITIES ARE NOT INCLUDED IN W.O. 2289. THIS WORK SHALL BE INCLUDED UNDER W.O. 2435.

PUBLIC DRAINAGE & ACCESS RIGHT-OF-WAY

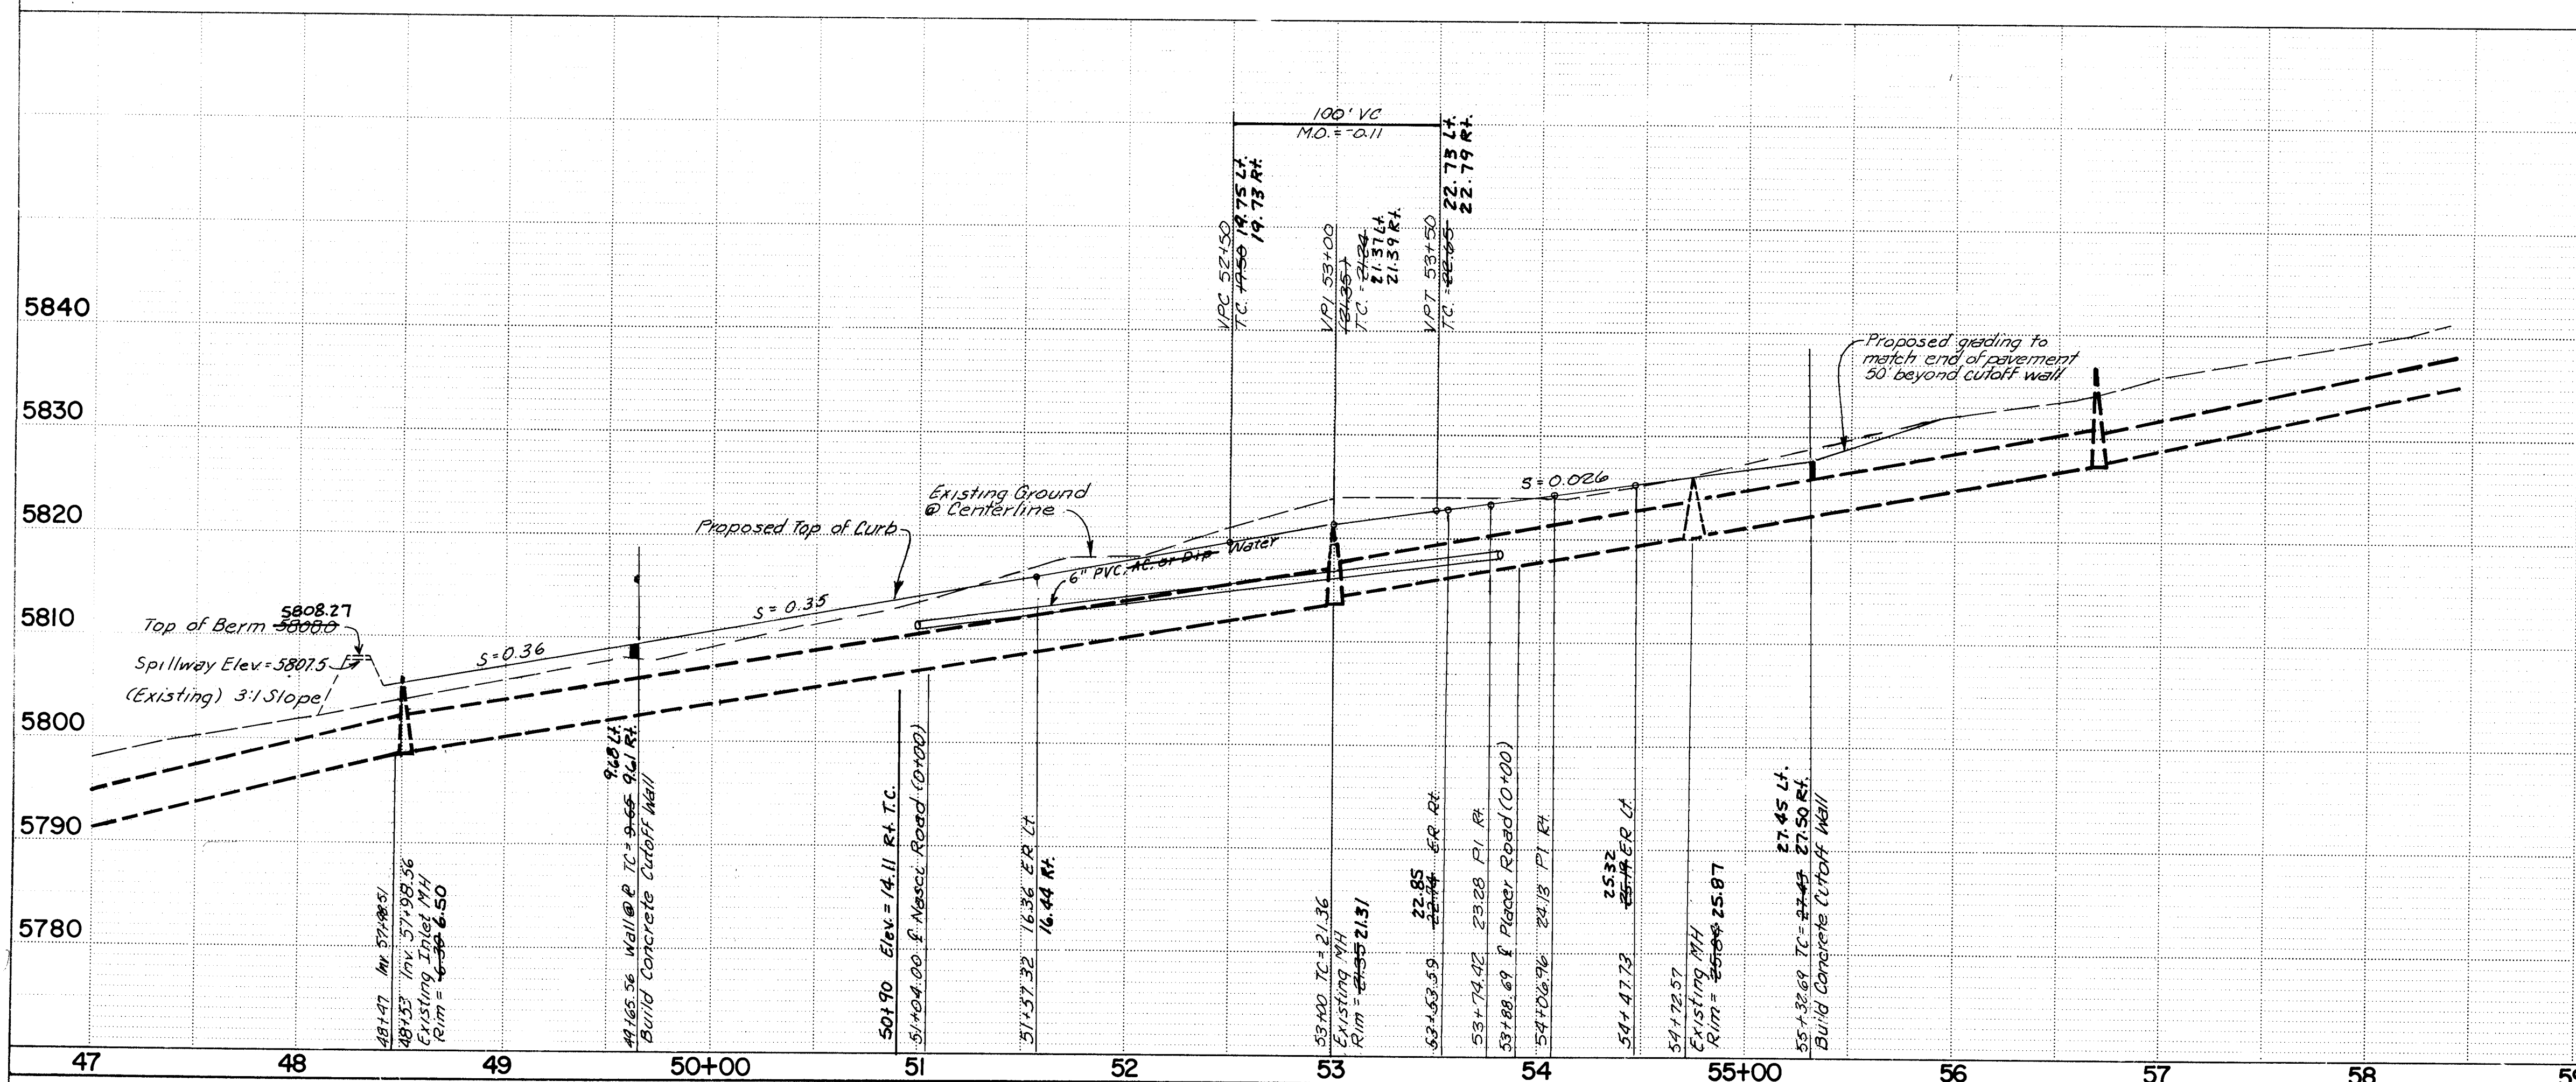

PAVING IMPROVMENTS FOR 2435 WILL NOT BE ACCEPTED UNTIL THE PAVING & DRAINAGE IMPROVMENTS FOR THE ALLEY ARE IN PLACE & ACCEPTED.

26 2289 1986

CITY OF ALBUQUERQUE MUNICIPAL DEVELOPMENT DEPARTMENT ENGINEERING DIVISION					
TITLE: PROSPECTOR'S POINT SUBDIVISION PUBLIC DRAINAGE & ACCESS R/W					
APPROVALS	ENGINEER	DATE	APPROVALS	ENGINEER	DATE
City Engineer	<i>[Signature]</i>	5/29/85	Liquid Waste	<i>[Signature]</i>	5/29/85
A.C.E. Design	<i>[Signature]</i>	5/29/85	Traffic	<i>[Signature]</i>	5/29/85
Hydrology	<i>[Signature]</i>	5/29/85	Water	<i>[Signature]</i>	5/29/85
DRAWING NO. 2289			MAP NO. E-22		
SHEET 19 OF 19			SHEET 19 OF 19		