



CITY OF ALBUQUERQUE

CONSTRUCTION PLANS

FOR

EMBUDITO ARROYO IMPROVEMENTS


COMANCHE ROAD TO TRACY STREET

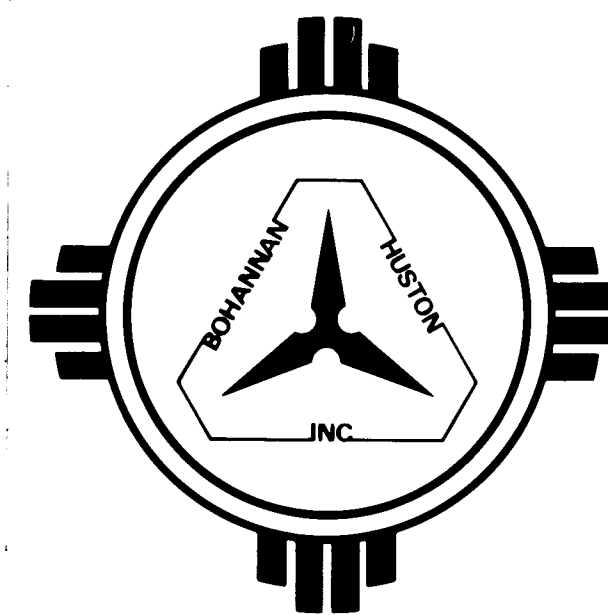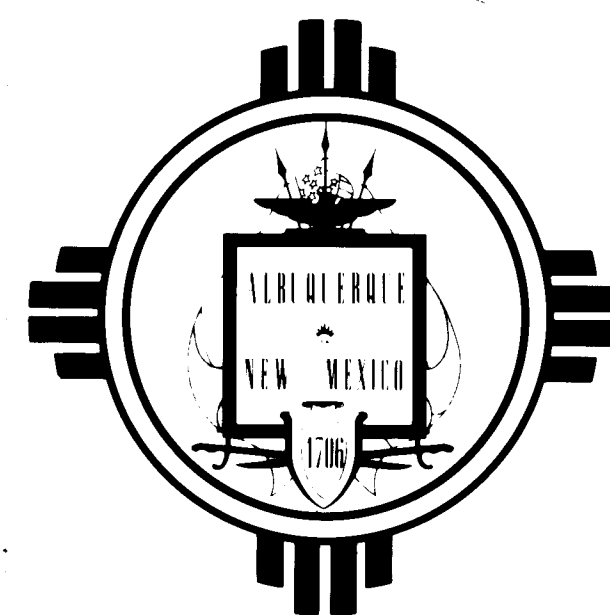

**SHEET
NO.**

DESCRIPTION

1. TITLE PAGE
2. PLAN & PROFILE-STA. 88+80.12 TO STA. 96+00.00
3. PLAN & PROFILE-STA. 96+00.00 TO STA. 108+00.00
4. PLAN & PROFILE- STA. 108+00.00 TO STA. 117+49.00
5. COMANCHE TRANSITION-SECTIONS & DETAILS
6. JUAN TABO TRANSITION-SECTIONS & DETAILS
7. CHANNEL INLET DETAILS
8. MISCELLANEOUS CONSTRUCTION DETAILS
9. TYPICAL CHANNEL SECTIONS & DETAILS
10. MAINTENANCE VEHICLE RAMP DETAILS
- 11.-16. CROSS-SECTIONS

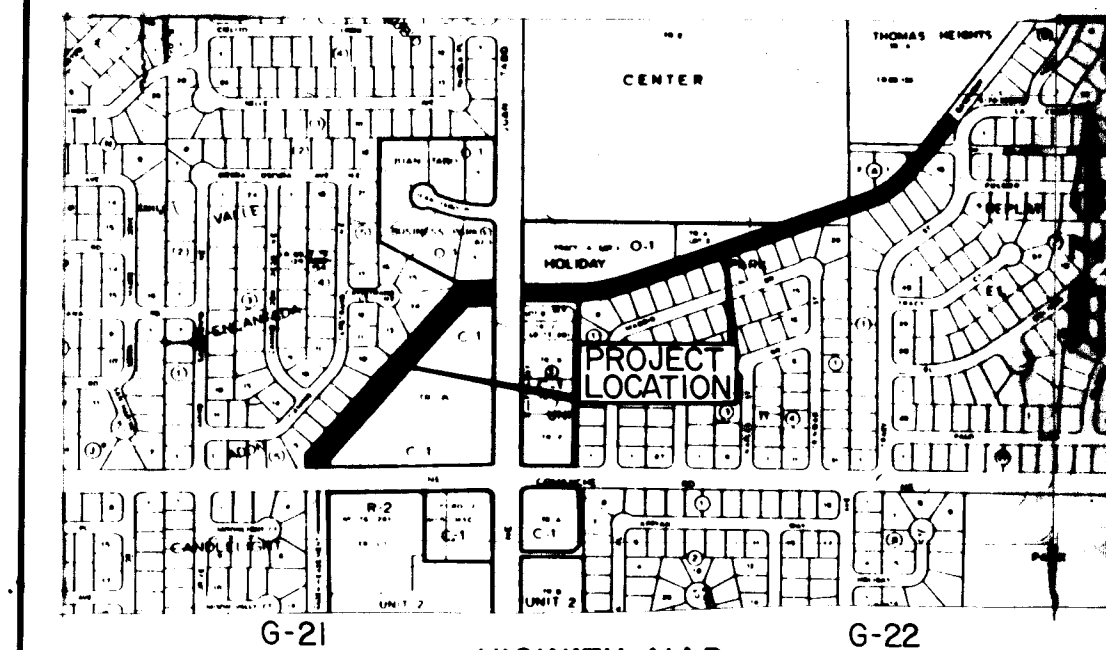

GENERAL NOTES

NOTICE TO CONTRACTORS

1. NEW MEXICO STANDARD SPECIFICATIONS FOR PUBLIC WORKS CONSTRUCTION-1979 EDITION WILL BE REFERRED TO HEREON AS THE "STANDARD SPECIFICATION."
2. STOCKPILING OF EXISTING CONCRETE, RIPRAP, ETC., AS SHOWN ON THE PLANS, SHALL BE PAID FOR UNDER BID ITEM "REMOVAL OF STRUCTURES AND OBSTRUCTIONS."
3. TWO WORKING DAYS PRIOR TO ANY EXCAVATION, CONTRACTOR MUST CONTACT LINE LOCATING SERVICE, 765-1234, FOR LOCATION OF EXISTING UTILITIES.
4. PRIOR TO CONSTRUCTION, THE CONTRACTOR SHALL EXCAVATE AND VERIFY THE HORIZONTAL AND VERTICAL LOCATIONS OF ALL OBSTRUCTIONS. SHOULD A CONFLICT EXIST, THE CONTRACTOR SHALL NOTIFY THE ENGINEER OR SURVEYOR SO THAT THE CONFLICT CAN BE RESOLVED WITH A MINIMUM AMOUNT OF DELAY.
5. NO CONSTRUCTION WILL BE ALLOWED IN THE EMBUDITO ARROYO DURING THE MONTHS OF JULY, AUGUST OR SEPTEMBER, UNLESS THE CONTRACTOR PROVIDES AND OBTAINS APPROVAL OF AN EROSION CONTROL PLAN AND A PLAN FOR THE SAFE PASSAGE OF THE 10 YEAR DESIGN STORM.

THE FOLLOWING NOTES ALSO APPLY WHEN CHECKED

- ☐ ALL UTILITIES AND UTILITY SERVICE LINES SHALL BE INSTALLED PRIOR TO PAVING.
- ☐ BACKFILL COMPACTION SHALL BE ACCORDING TO SPECIFIED STREET USE.
- ☐ TACK COAT REQUIREMENTS SHALL BE DETERMINED BY THE CITY ENGINEER.
- ☐ SIDEWALKS AND WHEELCHAIR RAMPS WITHIN THE CURB RETURNS SHALL BE CONSTRUCTED WHEREVER A NEW CURB RETURN IS CONSTRUCTED.
- ☐ IF CURB IS DEPRESSED FOR A DRIVEPAD, THE DRIVEPAD SHALL BE CONSTRUCTED PRIOR TO ACCEPTANCE OF CURB AND GUTTER.
- ☐ ALL STORM DRAINAGE FACILITIES SHALL BE COMPLETED PRIOR TO FINAL ACCEPTANCE.
- ☒ THE REQUESTOR OR DEVELOPER SHALL BE RESPONSIBLE FOR REPAIR OR REPLACEMENT OF ALL CURB AND GUTTER OR SIDEWALK DAMAGED AFTER APPROVAL BY THE CITY ENGINEER OF WORK COMPLETED BY THE CONTRACTOR.

1 2 3 4 5 6 7 8 9 10 11 12
2 6 2 2 9 6 0 1 8 5

L. F. McManis
DATE 12-23-85



REV	DATE	DESCRIPTION	BY	CITY ENGINEER	DATE	USER	DEPT.	DATE	USER	DEPT.	DATE
1	11-26-85	As Built									
2	7-31-85	Change Curve Data									

APPROVAL OF REVISIONS

		APPROVED FOR CONSTRUCTION
		<i>C. H. Haggard</i> 2/24/85 CE
PROJECT NUMBER 2296		SHEET 1 OF 16

RECORD DRAWINGS

DATE 12/5/85

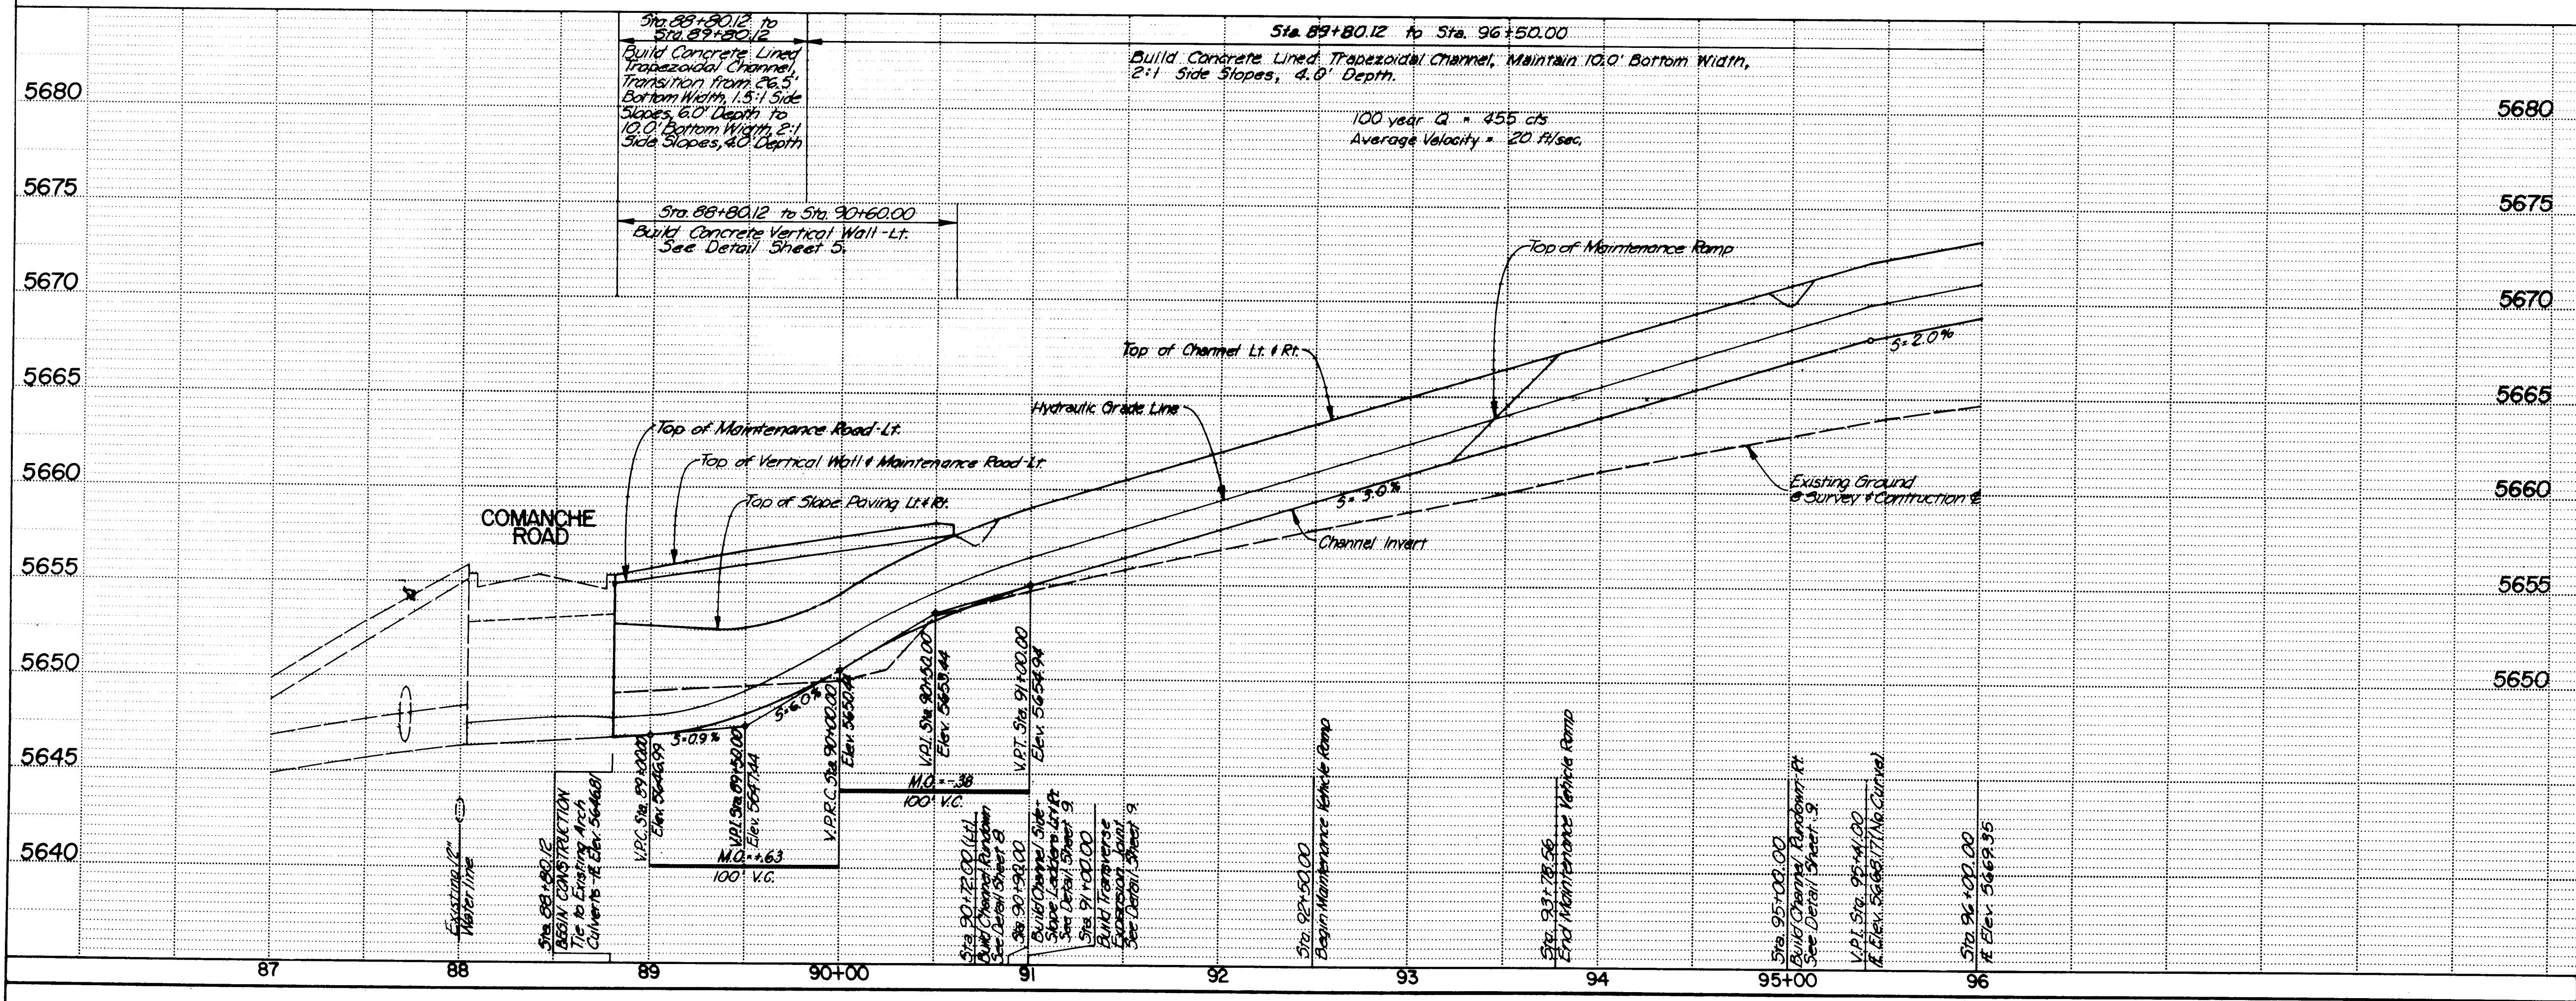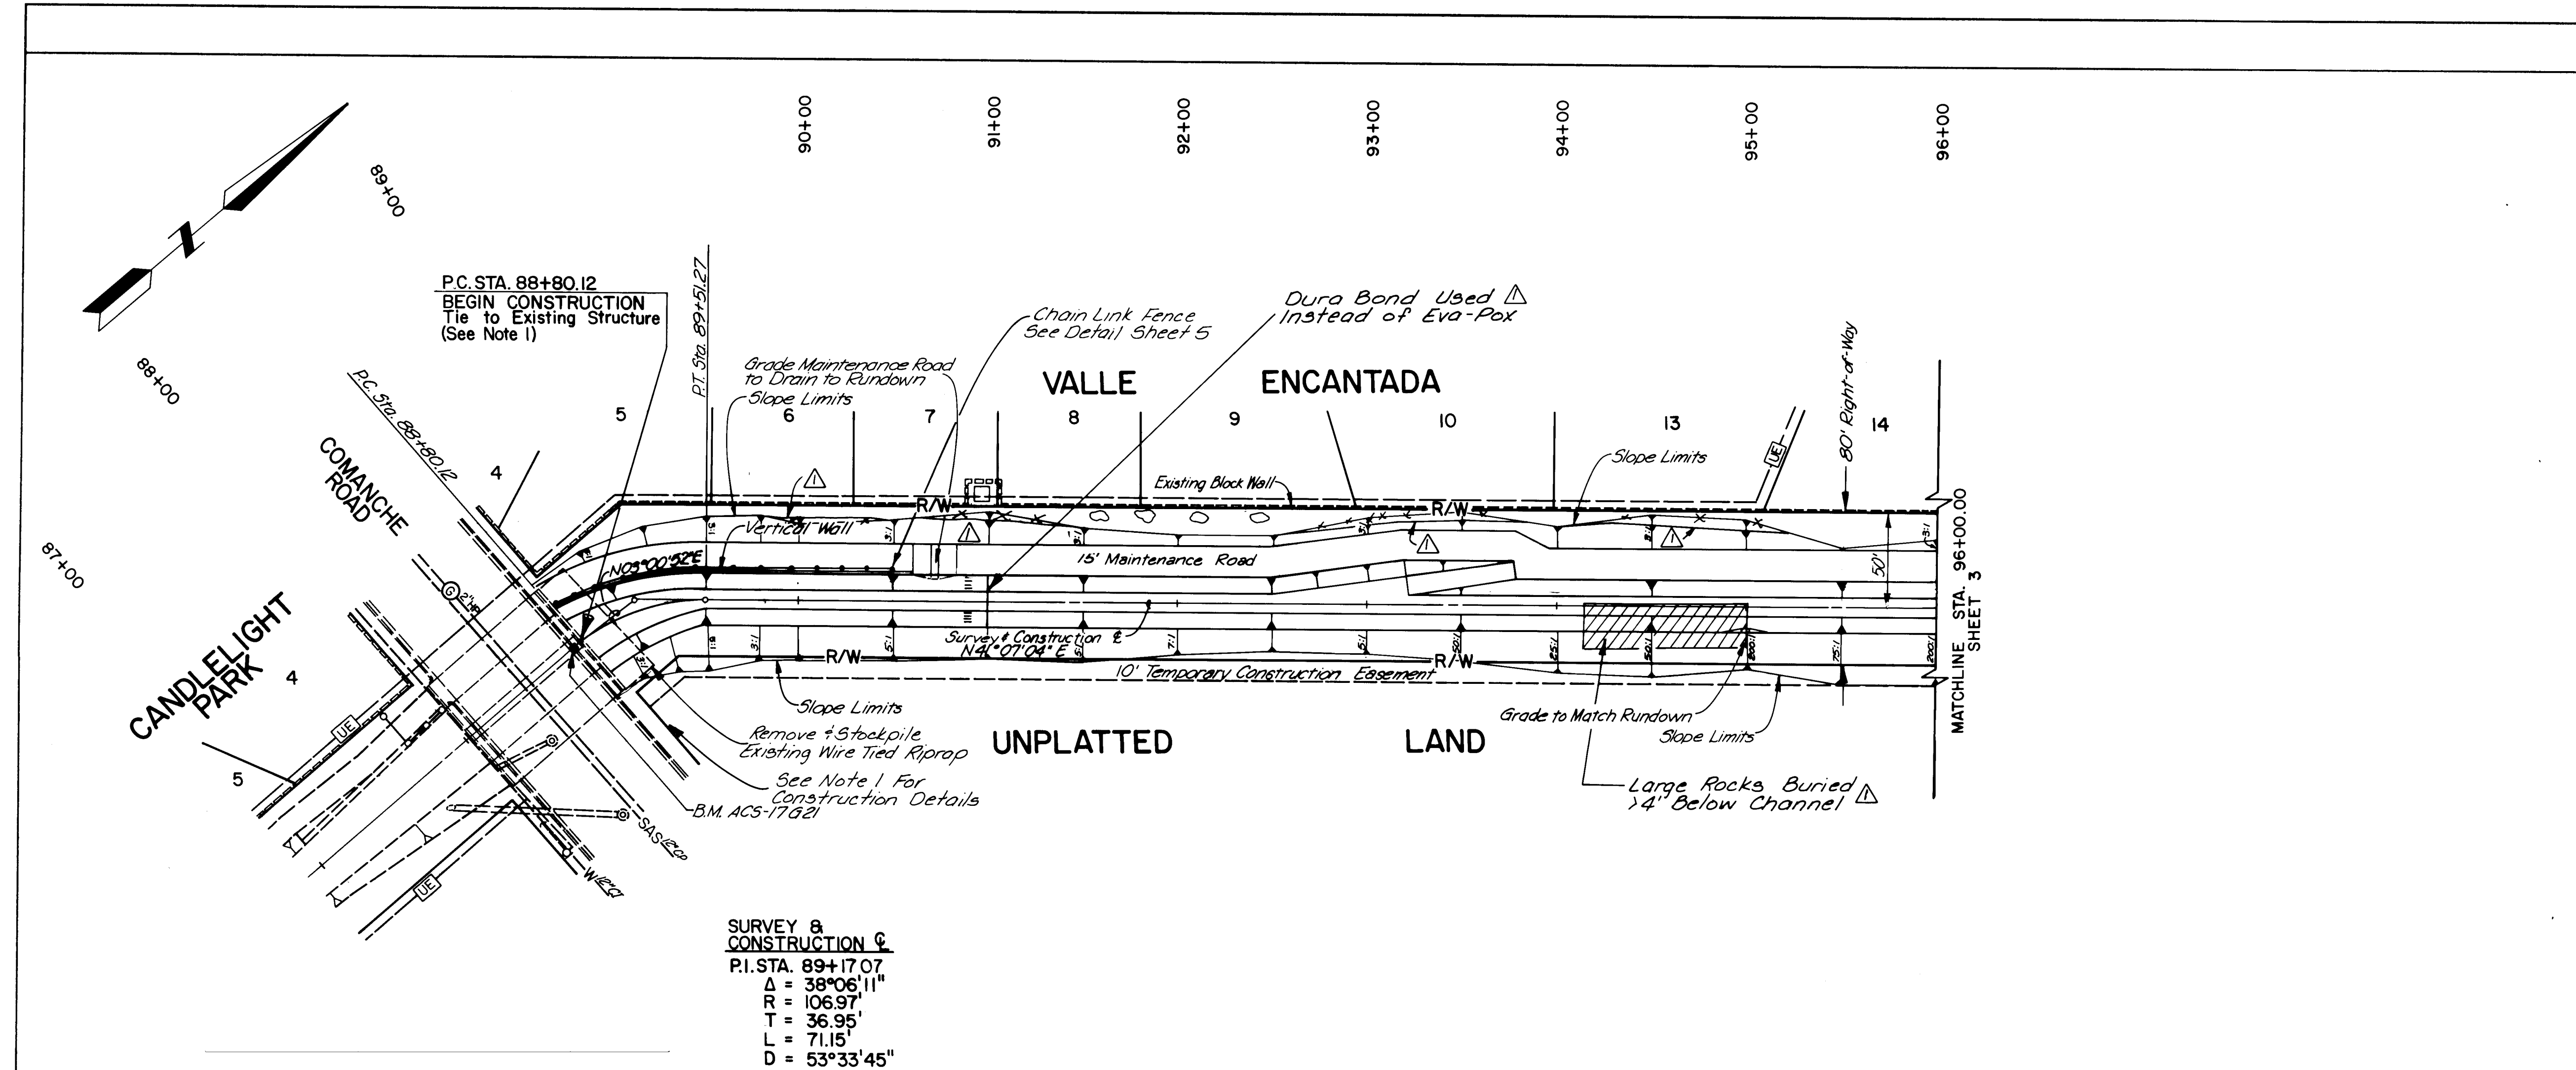

- NOTES:**
- For Survey & Construction & Location at Comanche Structure and Additional Details, See Sheet 5.
 - For Maintenance Vehicle Ramp Details, See Sheet 10.
 - For Typical Channel Details, See Sheet 9.
 - For Channel Run-down Details, See Sheet 9.

AS BUILT INFORMATION	
CONTRACTOR	
STATIONED BY	
DATE	
ACCEPTANCE BY	
DATE	
REVISION BY	
DATE	
REVISION BY	
DATE	
REVISION BY	
DATE	

BENCH MARKS	
B.M. - ACS 17-G21	Elev. 5655.34
ACS Brass cap stamped "17-G21 1978"	set in top of a concrete post flush with ground, 34' ± north of Comanche Rd. centerline and 725' ± west of Juan Tabo Blvd. centerline.

FIELD NOTES	
NO.	
DATE	
BY	

REVISIONS	
NO.	DATE
1	11/28/85
2	12/15/85
3	12/15/85
4	12/15/85
5	12/15/85
6	12/15/85
7	12/15/85
8	12/15/85
9	12/15/85
10	12/15/85
11	12/15/85
12	12/15/85



DESIGN REVISIONS	
NO.	DATE
1	11/28/85
2	12/15/85
3	12/15/85
4	12/15/85
5	12/15/85
6	12/15/85
7	12/15/85
8	12/15/85
9	12/15/85
10	12/15/85
11	12/15/85
12	12/15/85

APPROVALS	
CITY ENGINEER	DATE
A.C.E. - Design	DATE
A.C.E. - Hydrology	DATE

DRAWING NO.	
2296	MAP NO. G-21 & G-22
2	SHEET 2 OF 16

ENGINEER'S SEAL		REMARKS		DATE	
BY		DATE		DATE	
DESIGNED BY T.L.H., K.R.J.		DATE 2-85		DATE 2-85	
DRAWN BY N.A.W.		DATE 2-85		DATE 2-85	
CHECKED BY H.C.S.		DATE 2-85		DATE 2-85	

RECORD DRAWINGS

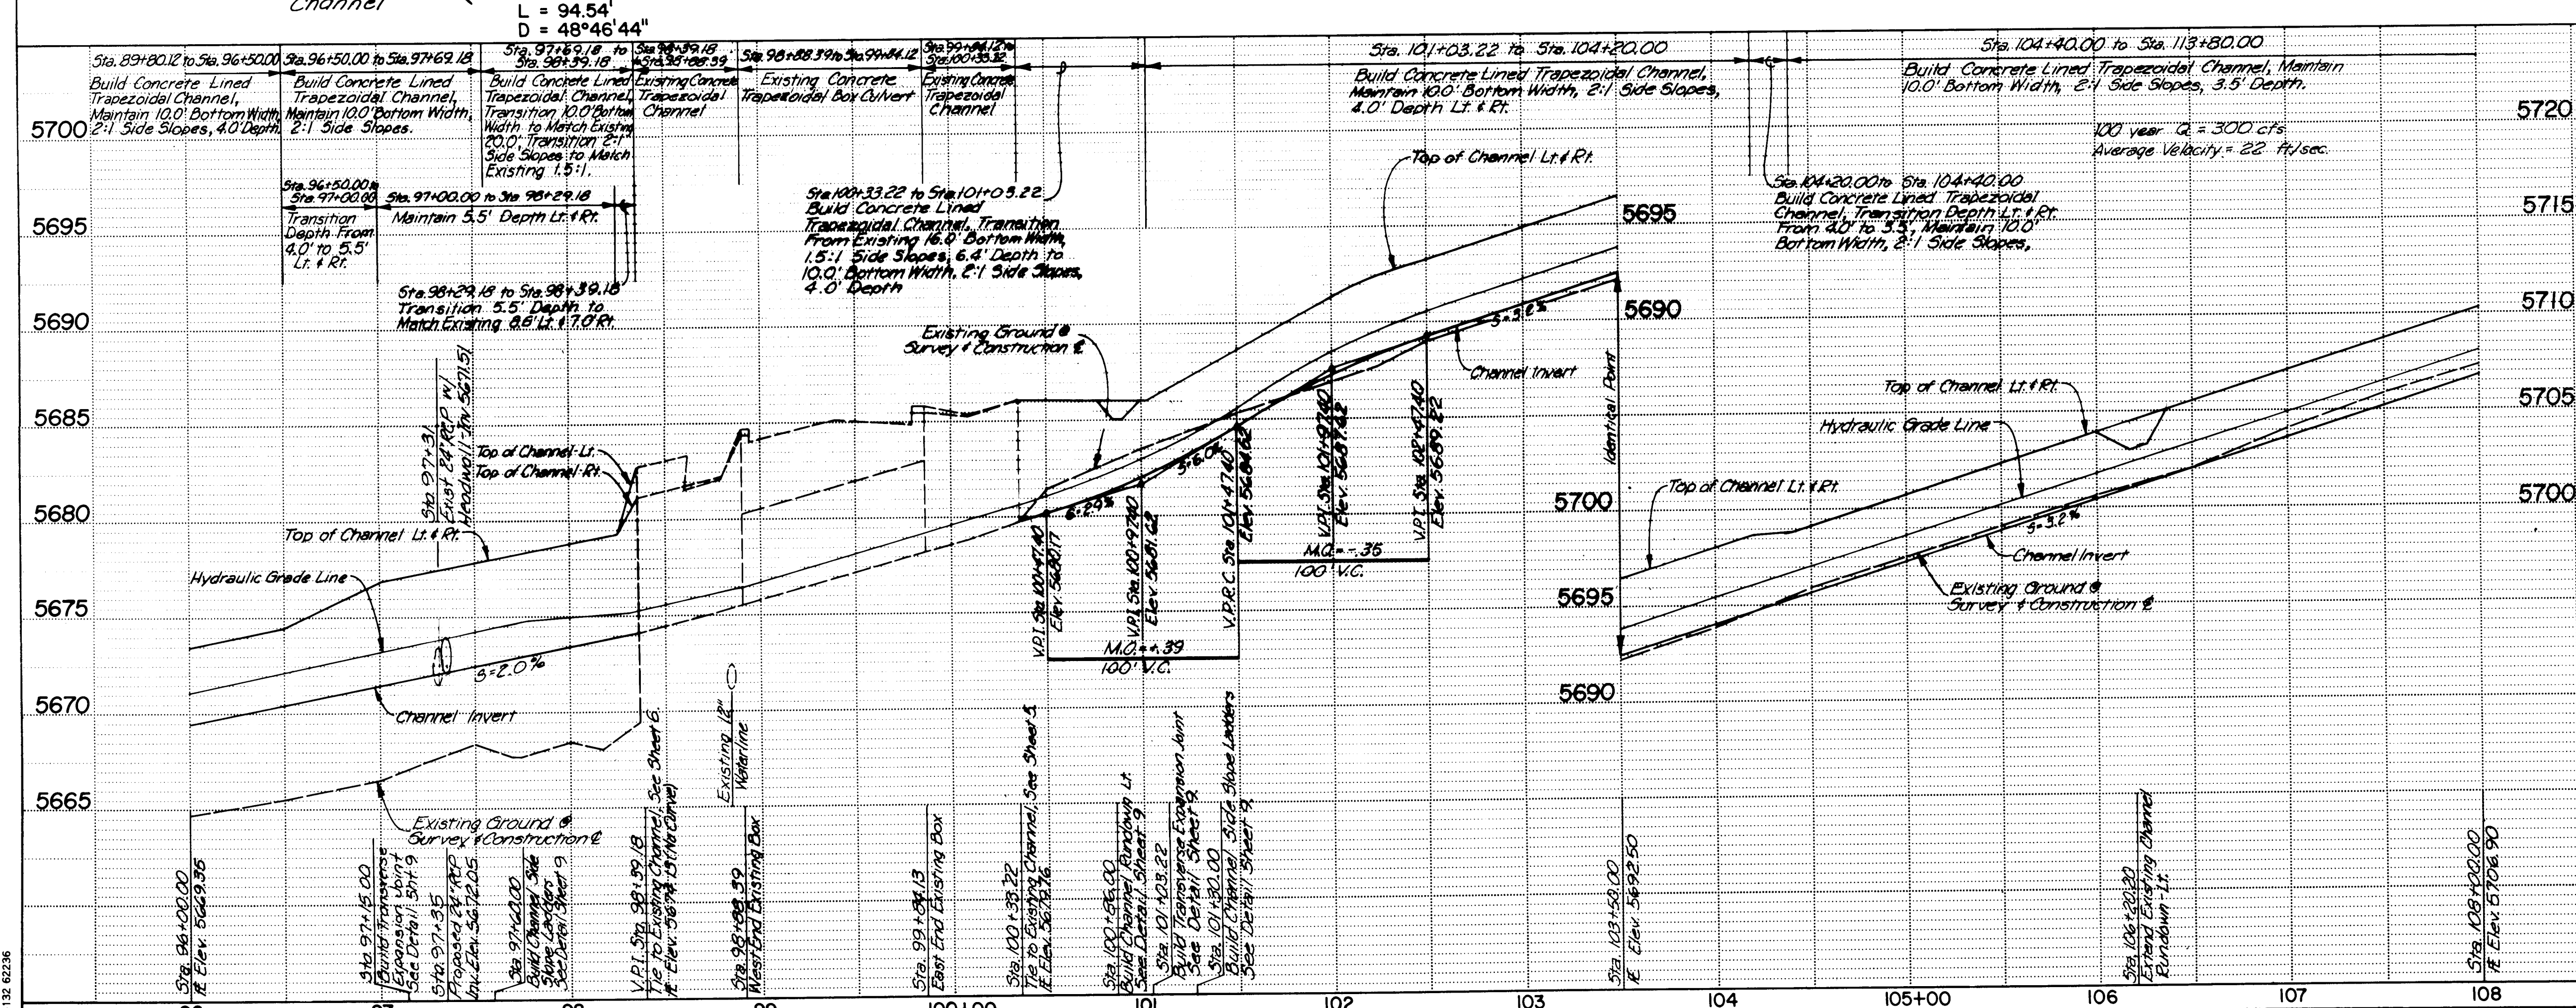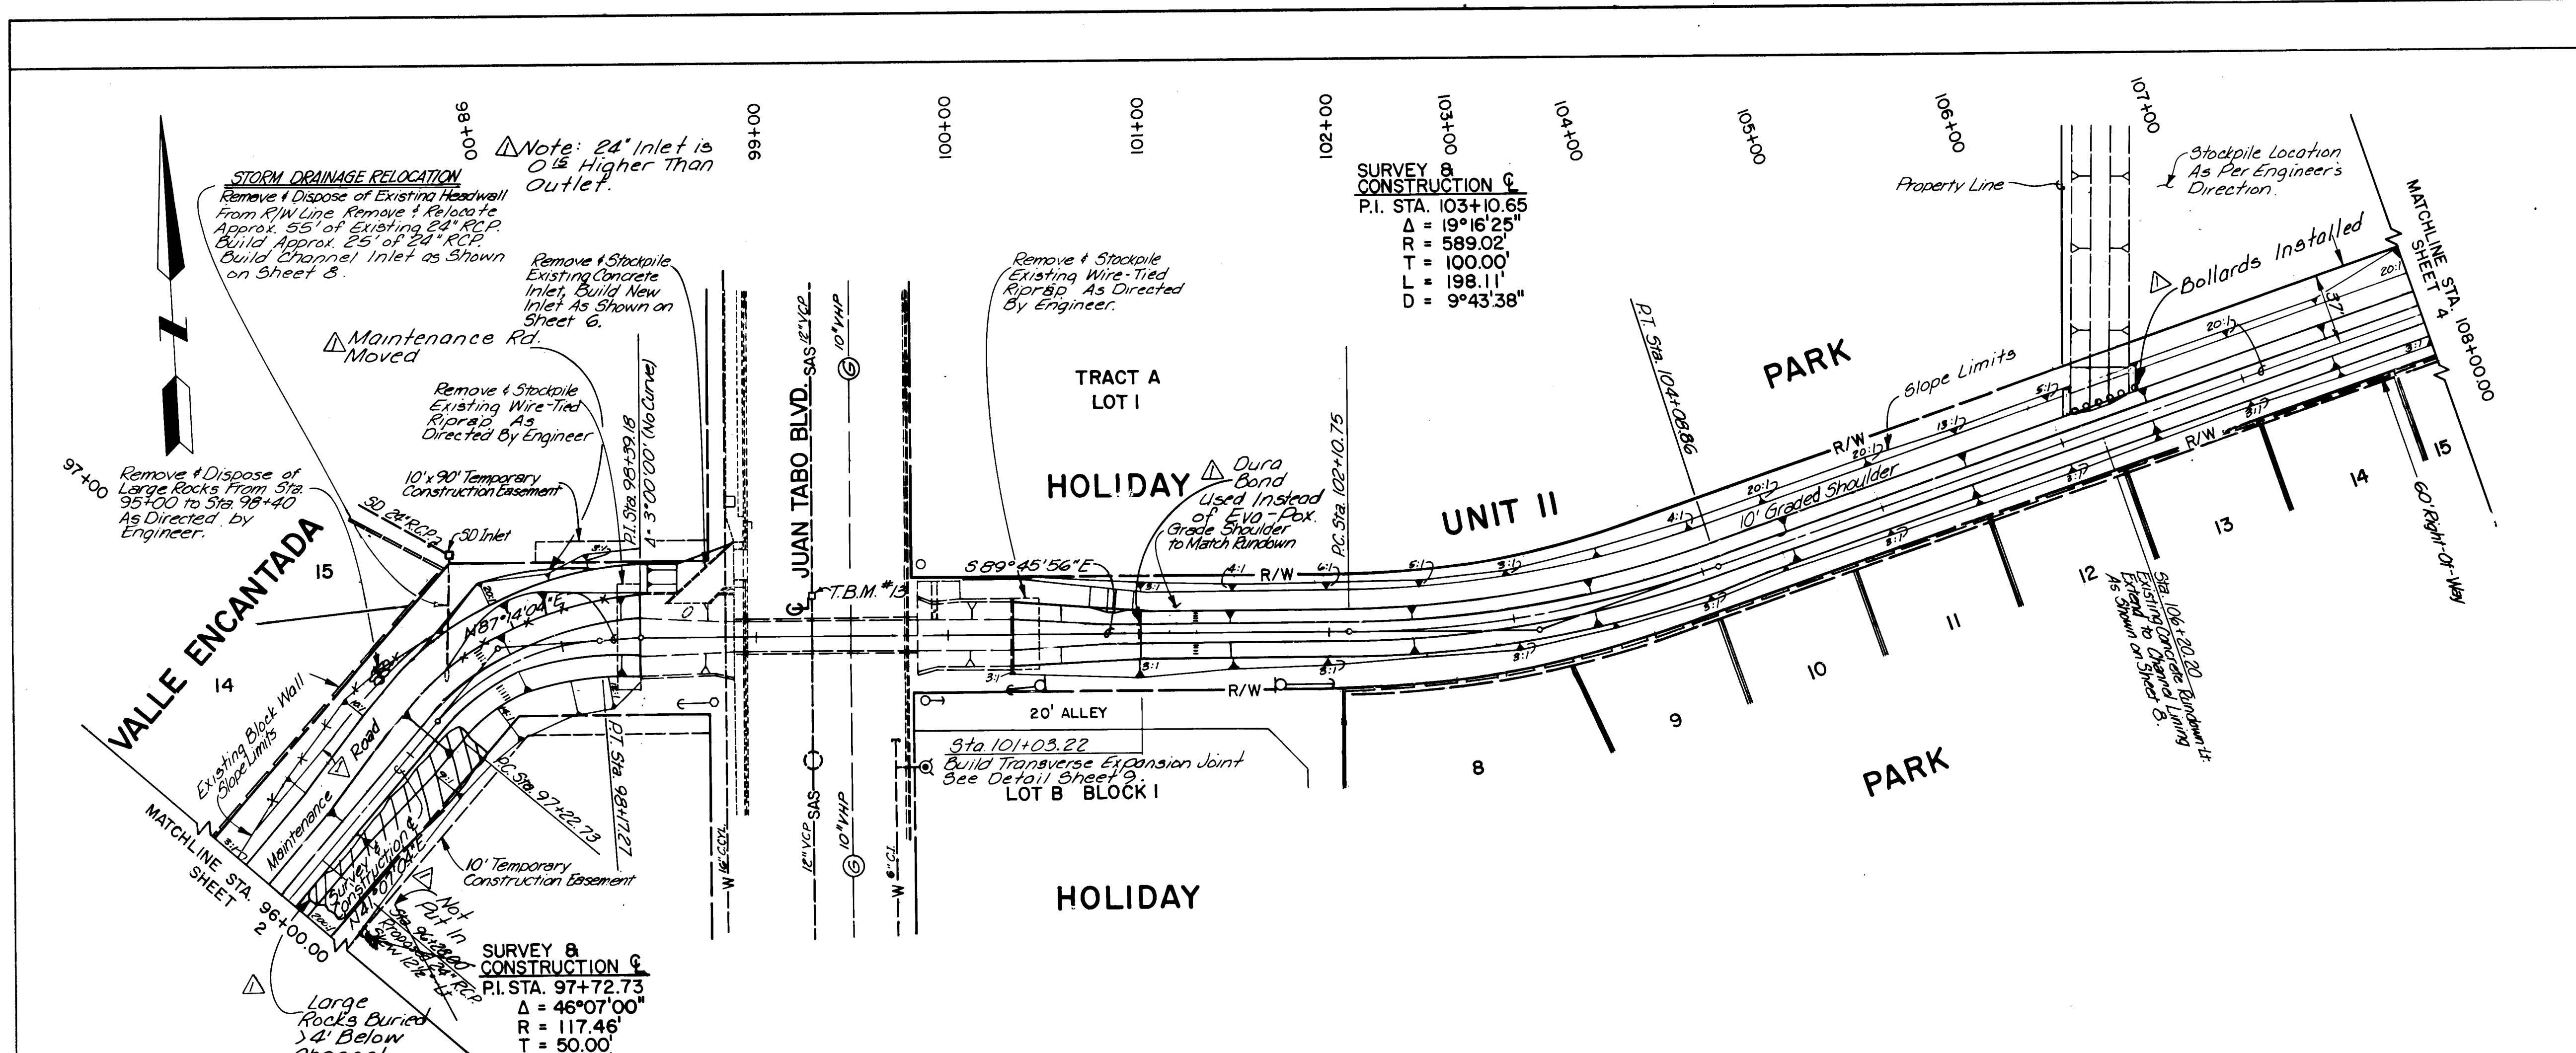

NOTES:

- For Juan Tabo Structure Details, See Sheet 6.
- For Channel Run-down Details, See Sheet 9.
- For Typical Channel Section & Details, See Sheet 9.

CONSTRUCTION & SURVEY DATA

P.I. STA. 103+10.65
 $\Delta = 19^\circ 16' 25''$
 $R = 589.02'$
 $T = 100.00'$
 $L = 198.11'$
 $D = 9^\circ 43' 38''$

P.I. STA. 97+72.73
 $\Delta = 46^\circ 07' 00''$
 $R = 117.46'$
 $T = 50.00'$
 $L = 94.54'$
 $D = 48^\circ 46' 44''$

SCALE:
1" = 5' VERT.
1" = 50' HORIZ.

CITY OF ALBUQUERQUE
MUNICIPAL DEVELOPMENT DEPARTMENT
ENGINEERING DIVISION

TITLE: STA. 96+00.00 TO STA. 108+00.00
EMBUDITO ARROYO IMPROVEMENTS
COMANCHE ROAD TO TRACY STREET

APPROVALS	ENGINEER	DATE	APPROVALS	ENGINEER	DATE
City Engineer	<i>[Signature]</i>	3/13/85	Liquid Waste	<i>[Signature]</i>	3/13/85
A.C.E. - Design	<i>[Signature]</i>	3/13/85	Traffic	<i>[Signature]</i>	3/13/85
A.C.E. - Hydrology	<i>[Signature]</i>	3/13/85	Water	<i>[Signature]</i>	3/13/85










DRAWING NO. 2296 **MAP NO. G-21 & G-22** **SHEET 3 OF 16**

JOB NO. 43080






DATE: 12/5/85

VERTICAL WALL HEIGHTS-TABLE 1

STATION	H	COMMENTS	W
88+80.12-Lt.	3'-0"	Begin Vertical Wall @ Comanche Structure	2'-3"
89+50.00-Lt.	4'-0"		3'-0"
90+50.00-Lt.	1'-0"		0'-9"
90+60.00-Lt.	0'-6"	End Vertical Wall	0'-6"

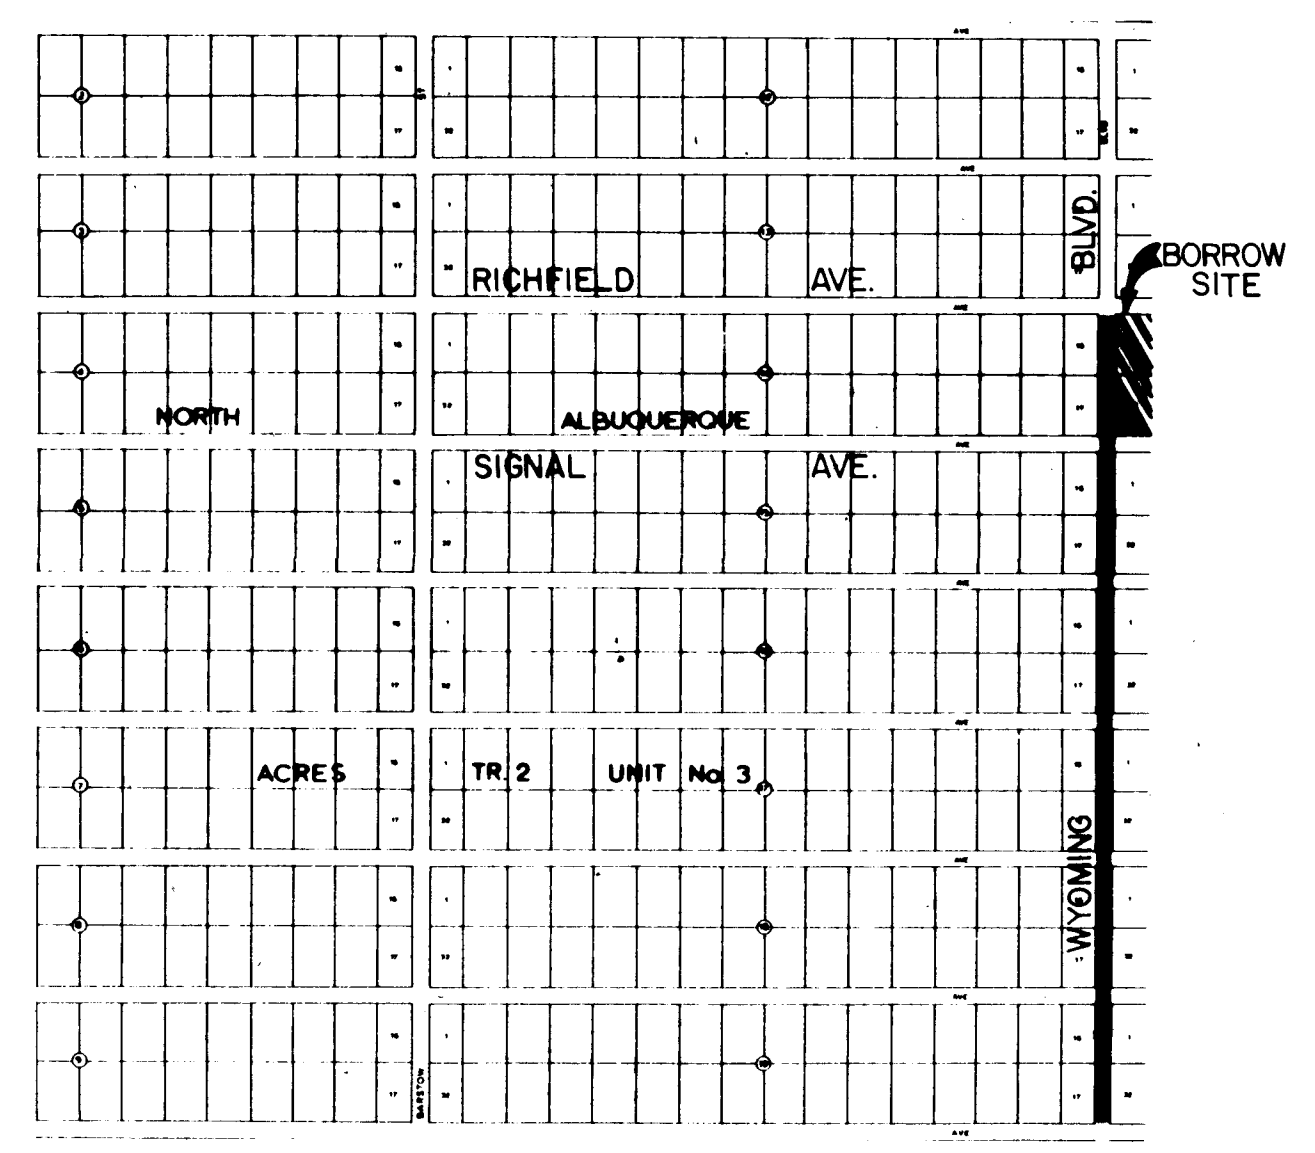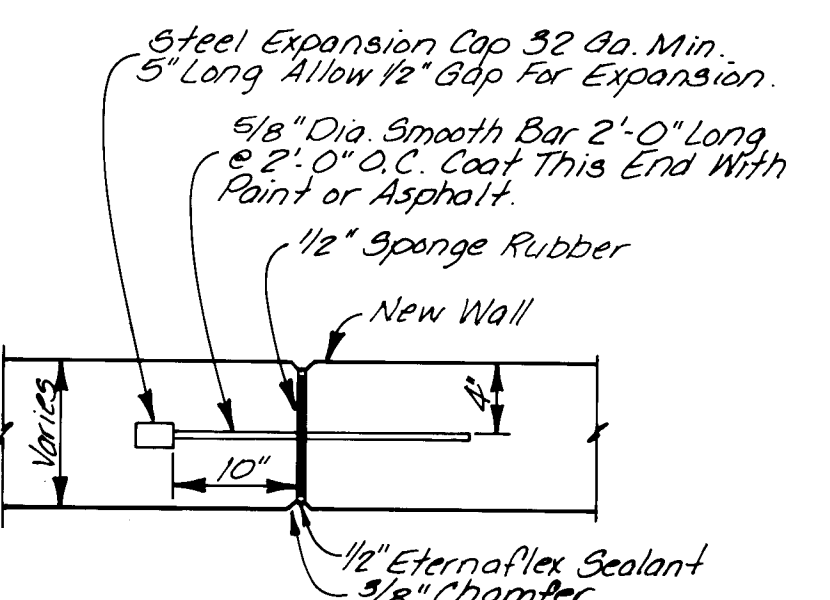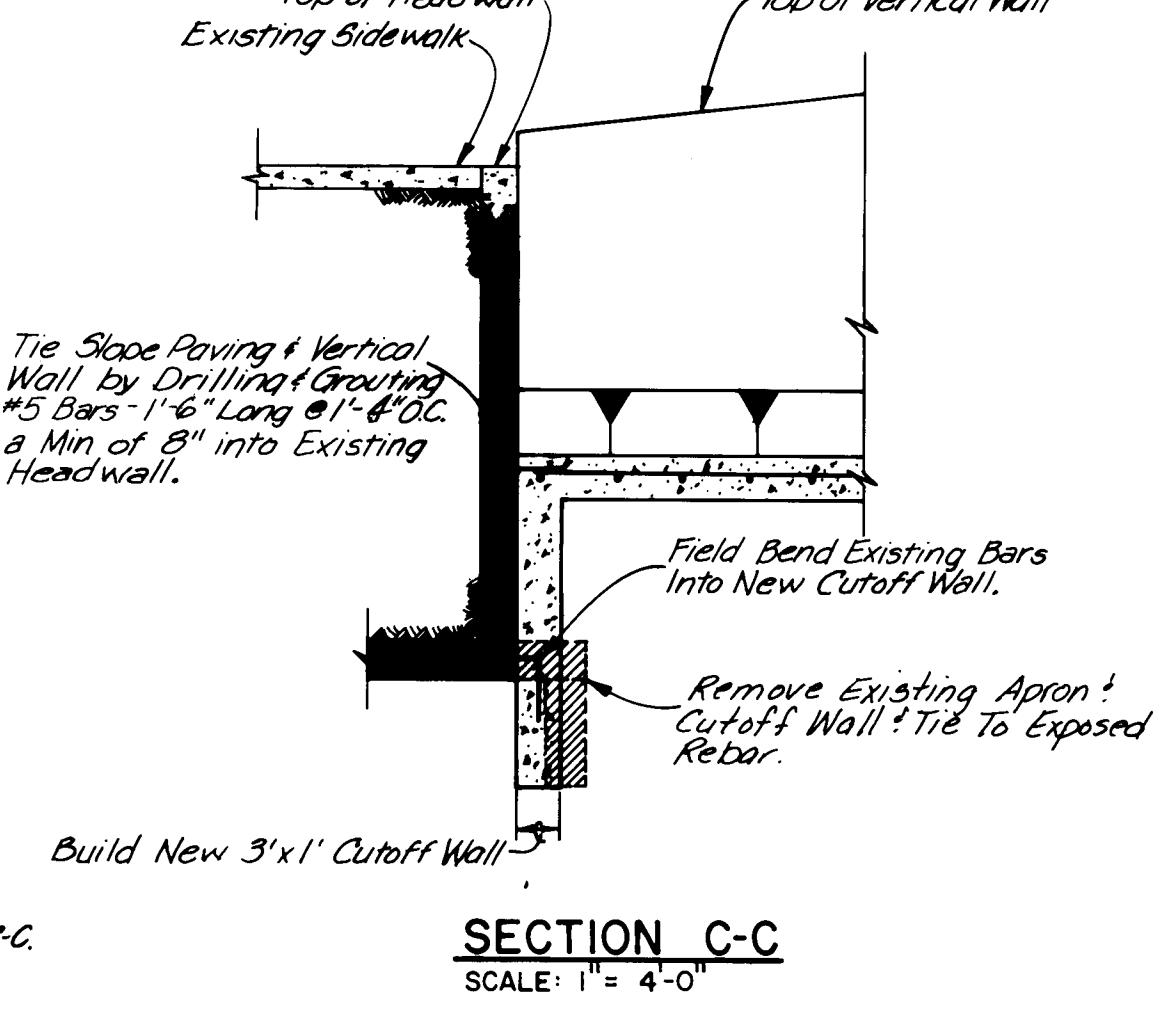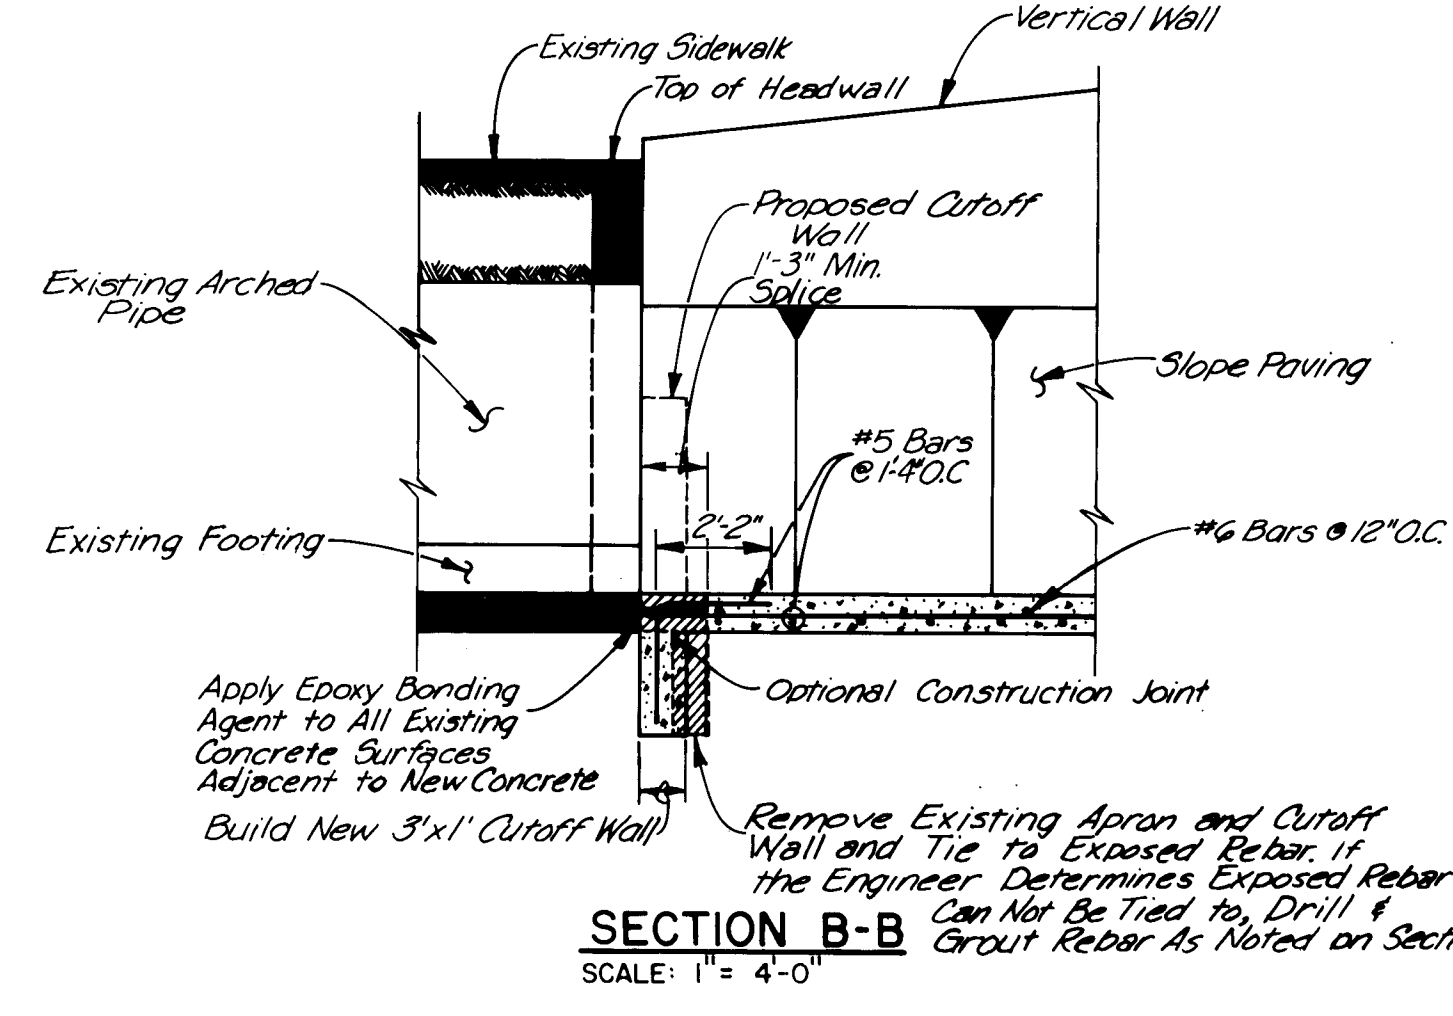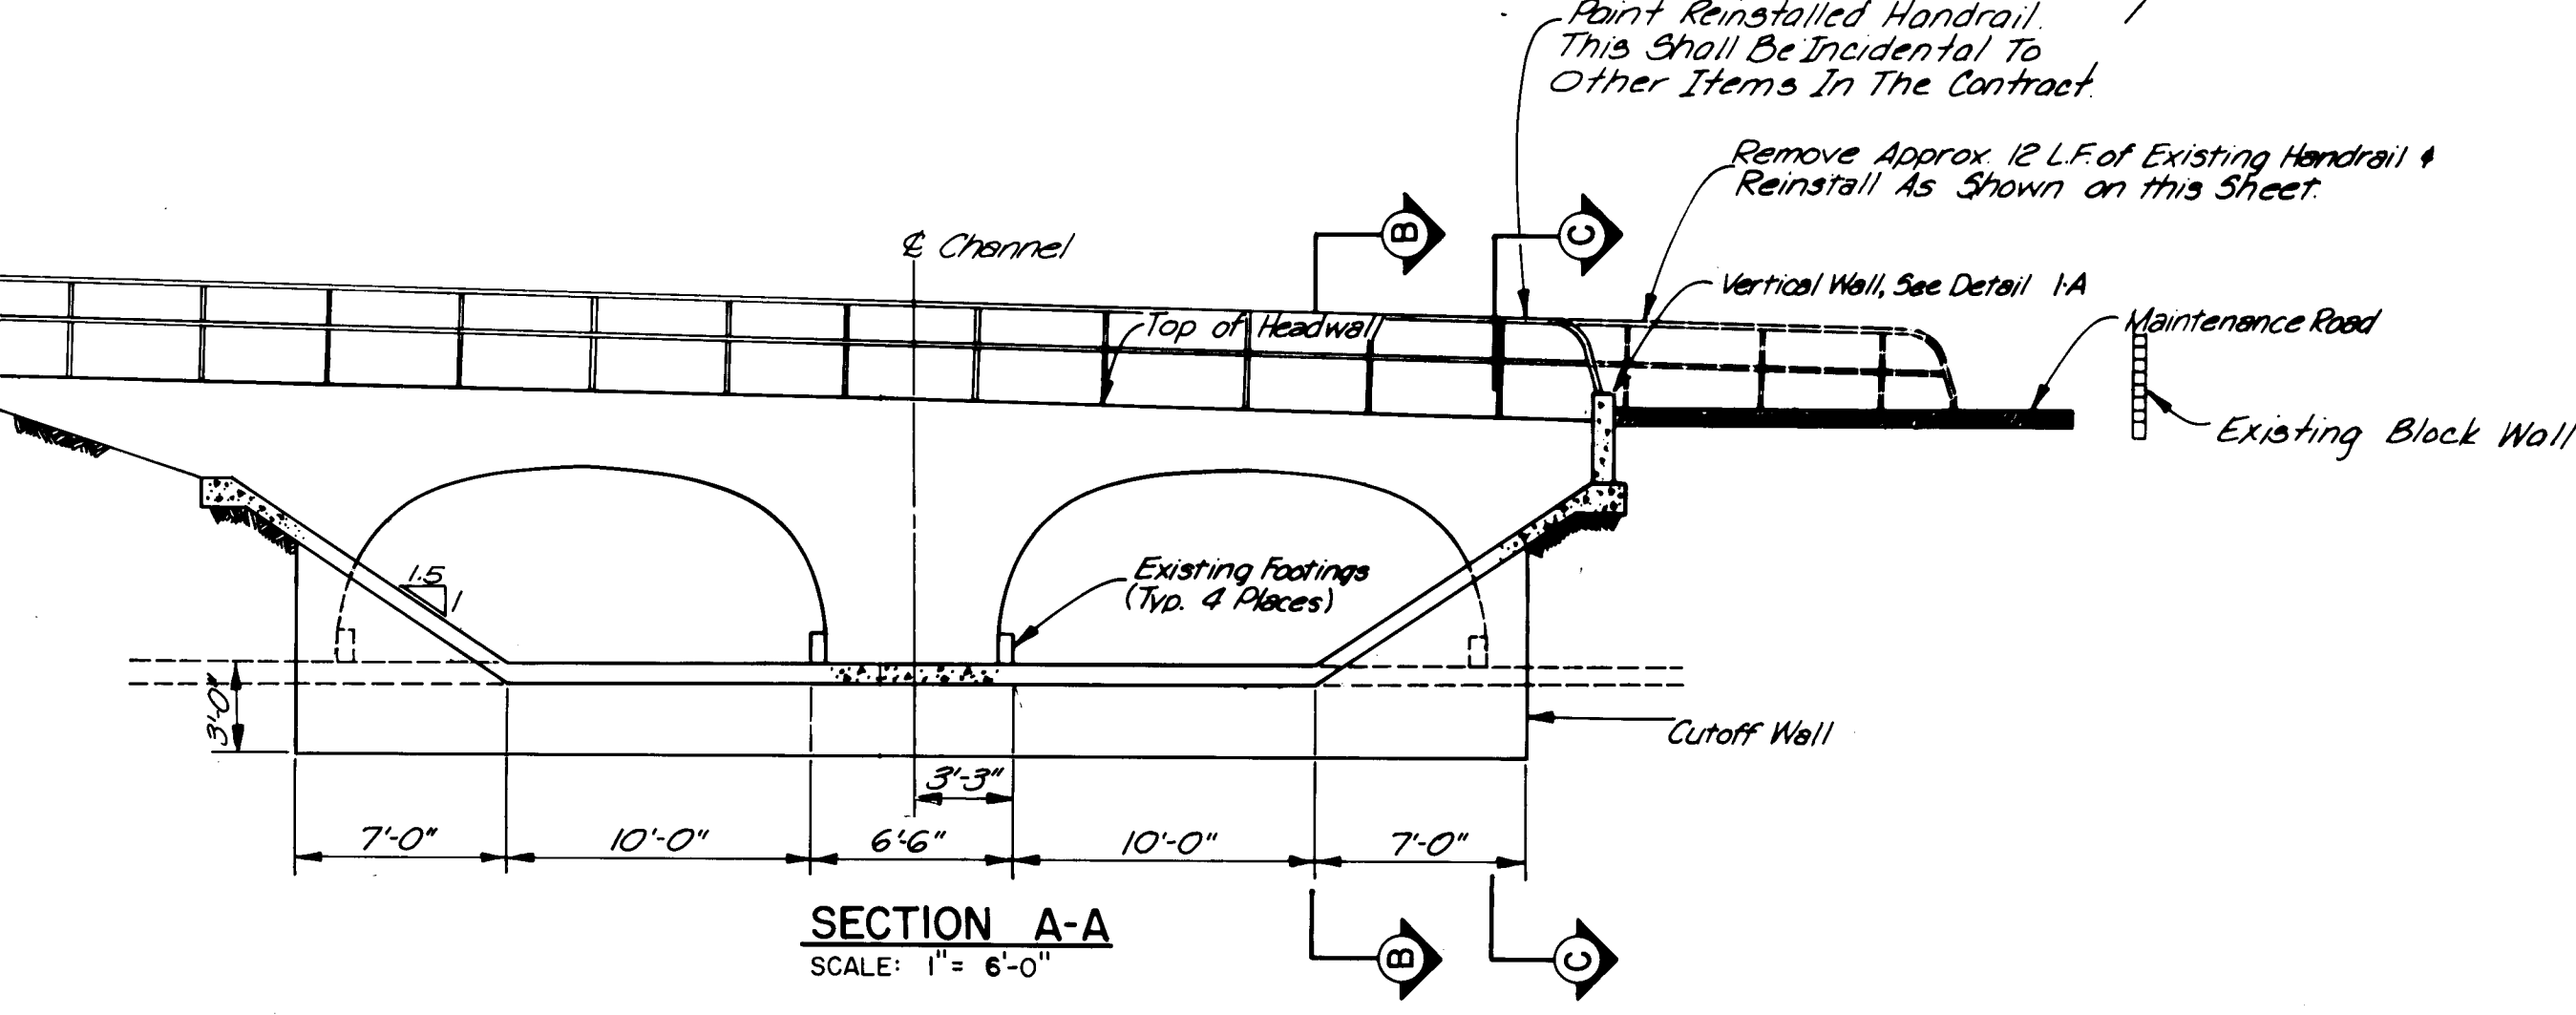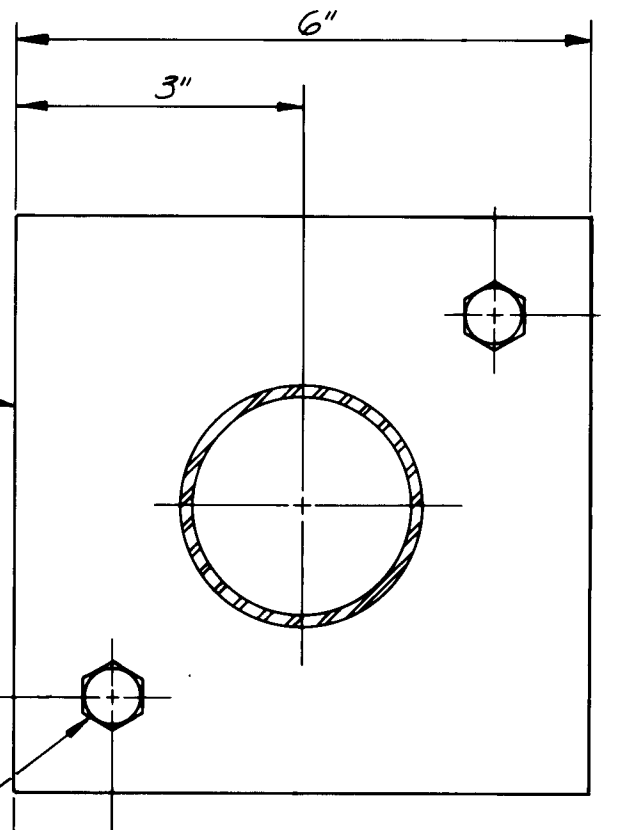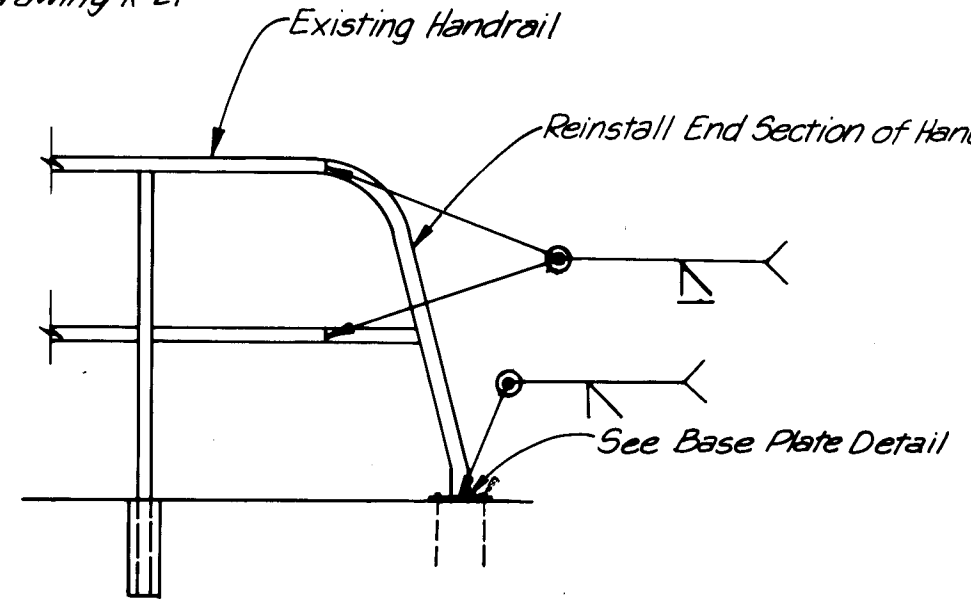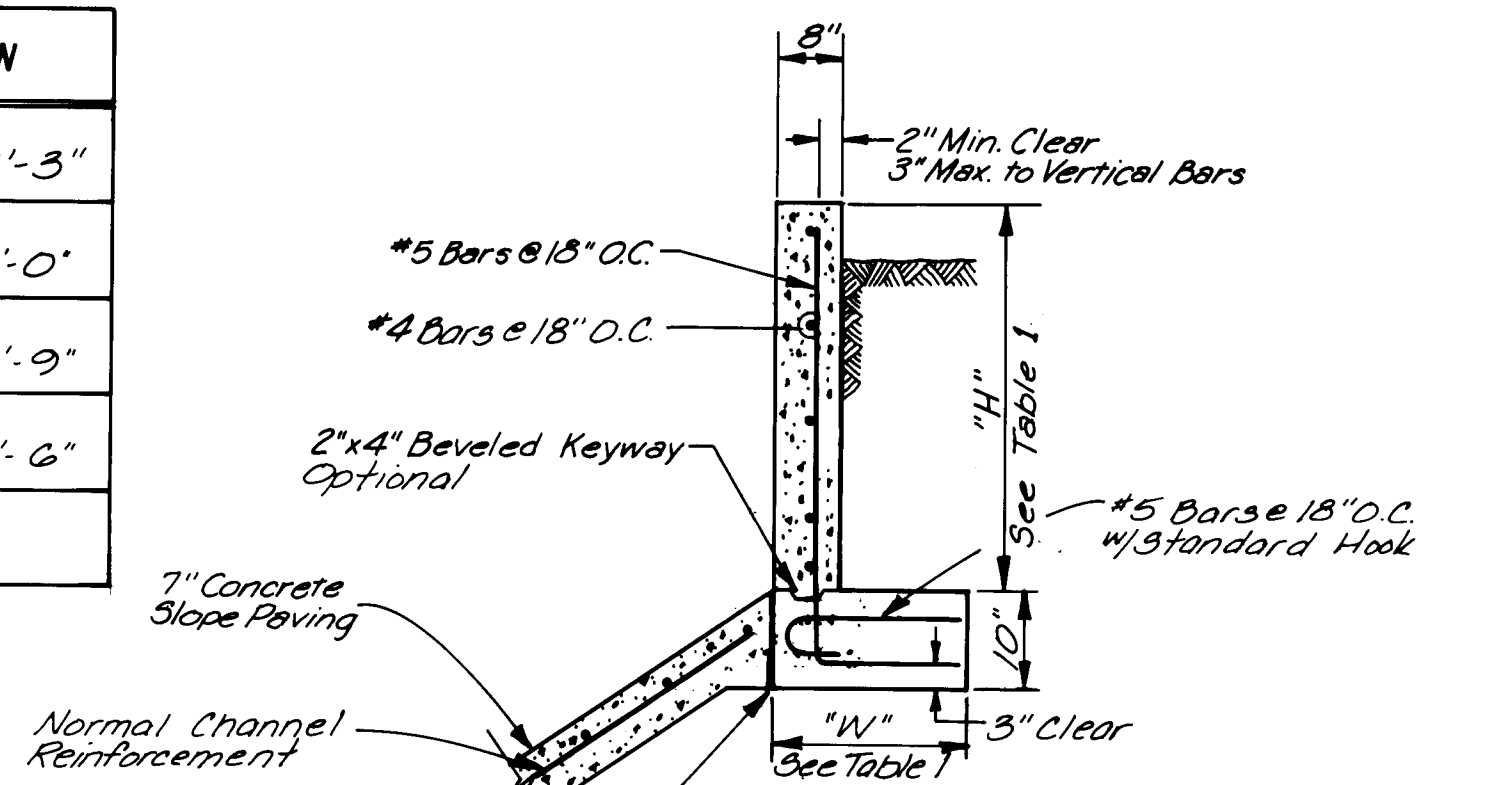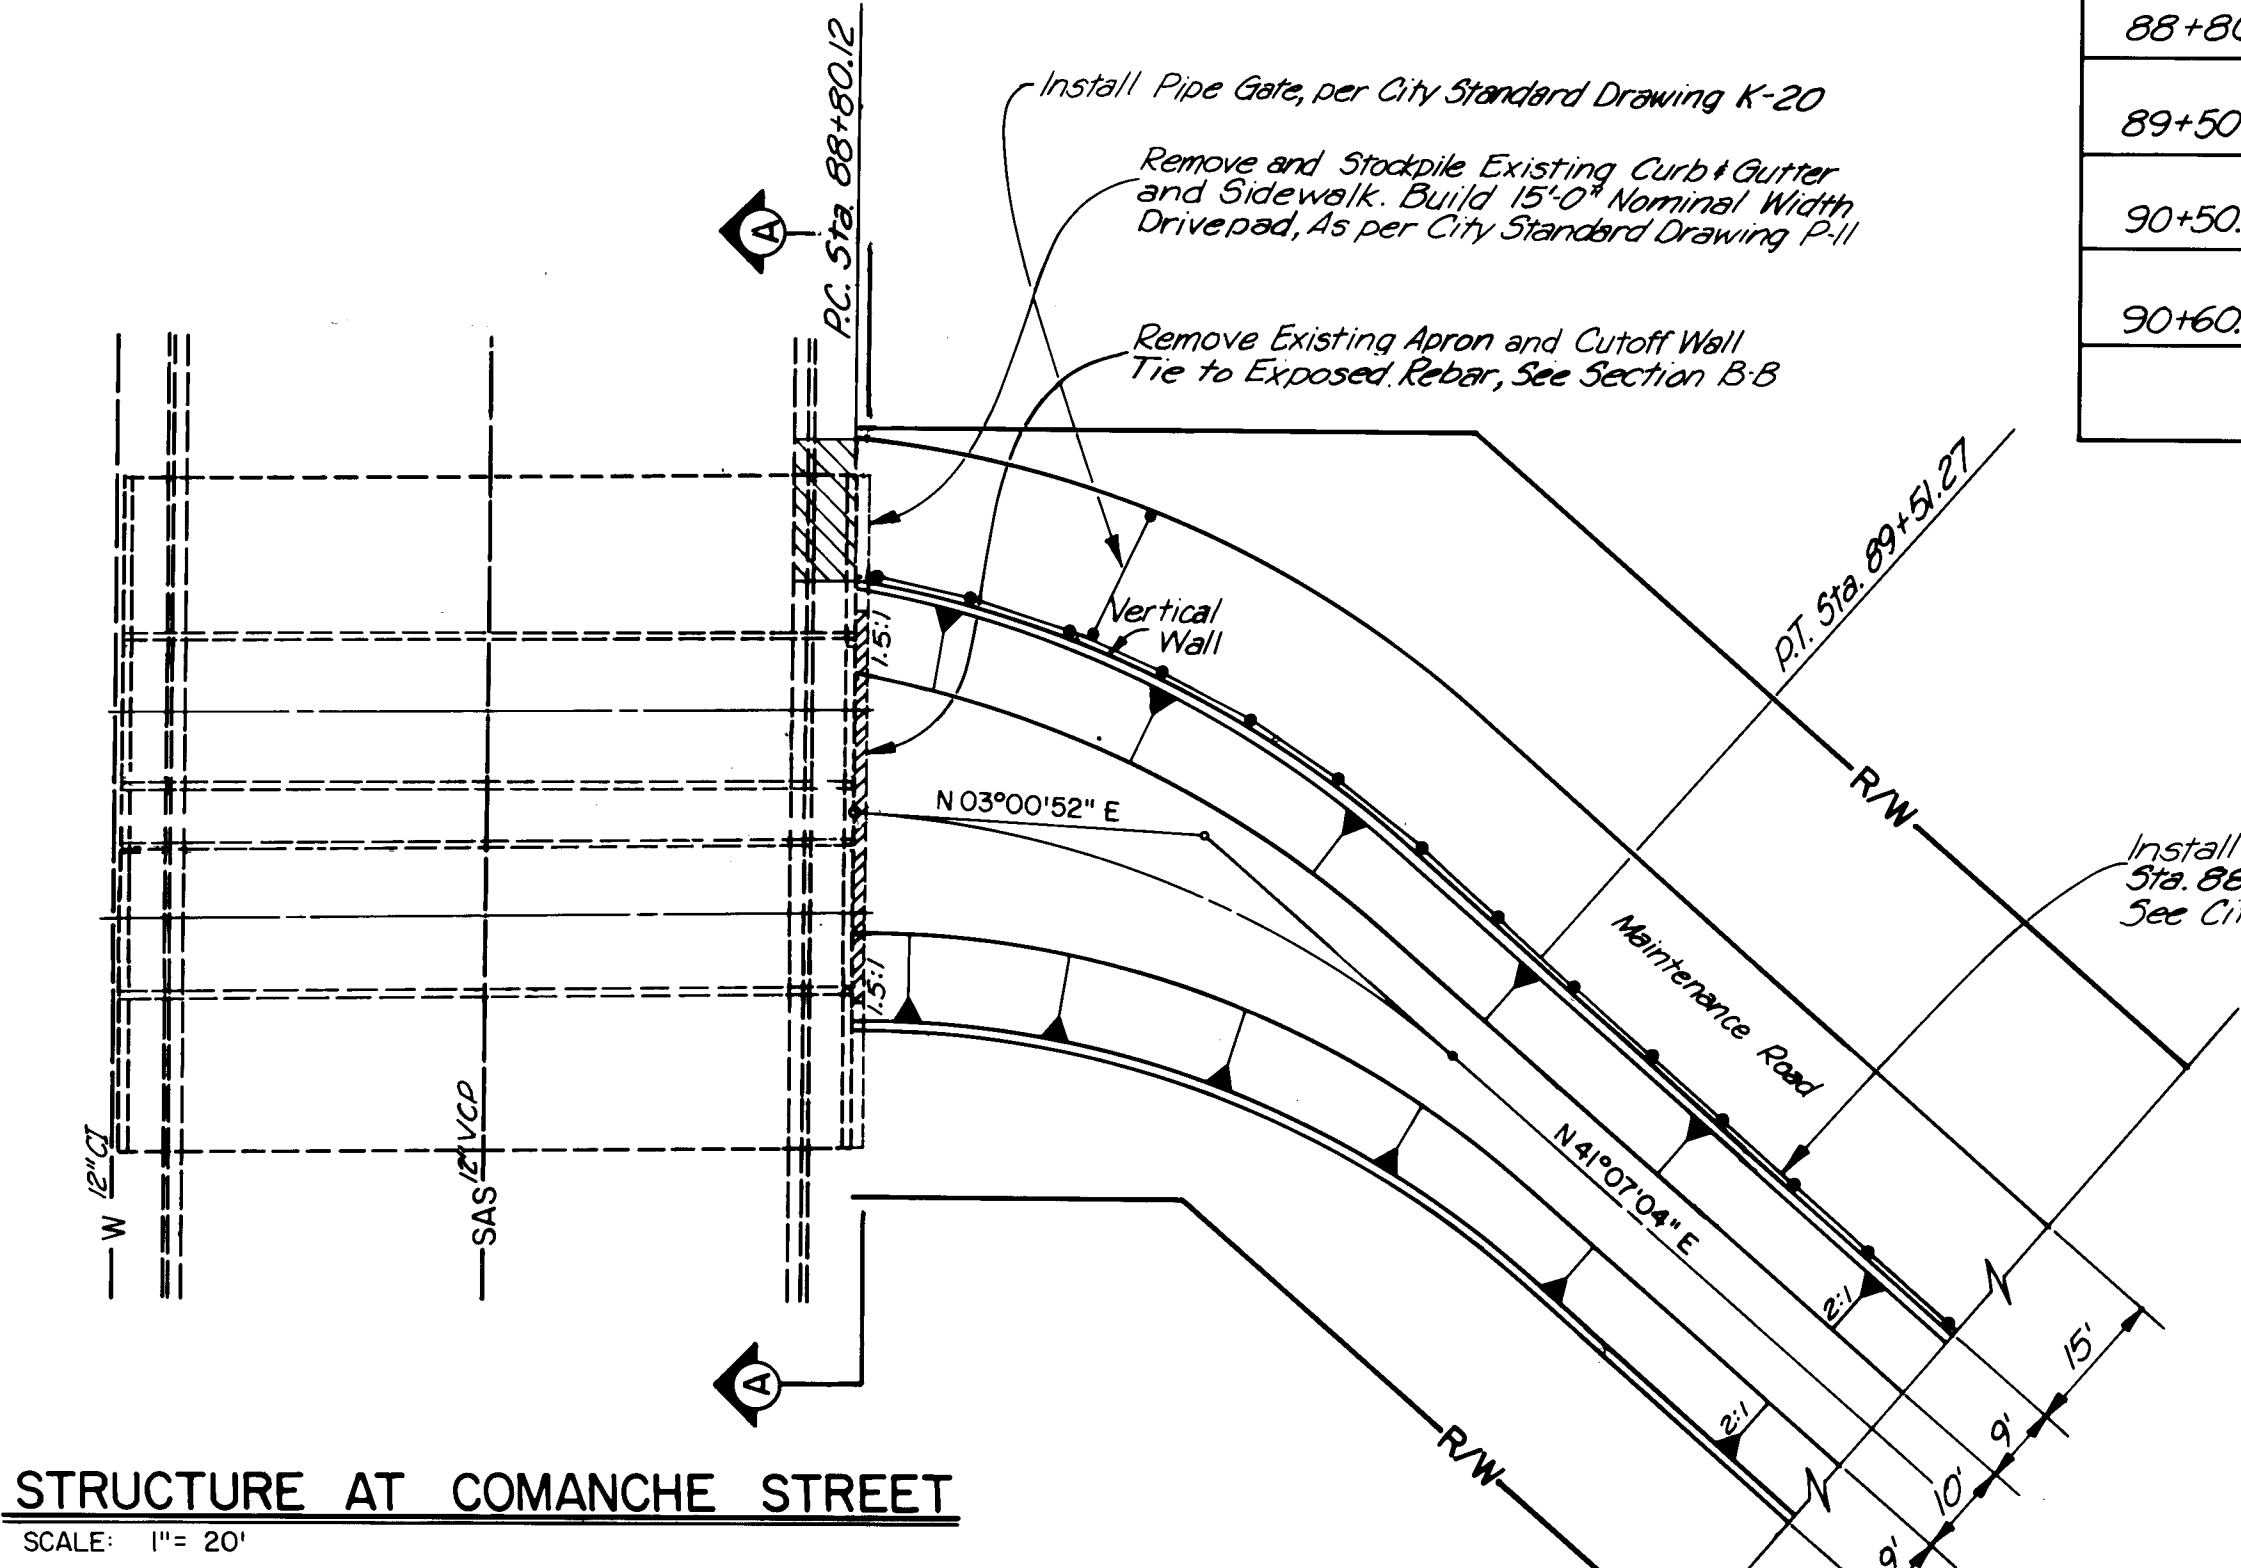


AS BUILT INFORMATION				BENCH MARKS				SURVEY INFORMATION				ENGINEER'S SEAL			
CONTRACTOR	DATE	INSPECTOR'S	DATE	NO.	DATE	BY	DATE	NO.	DATE	BY	DATE	NO.	DATE	BY	DATE
REVISIONS															
DESIGN															
CHECKED BY H.C.S. DATE 2-85															
DRAWN BY N.A.W. DATE 2-85															
DESIGNED BY T.L.H., K.R.J. DATE 2-85															
REMARKS															
4-9-85 Change Location of Borrow Site															
MCS BY															
CITY OF ALBUQUERQUE MUNICIPAL DEVELOPMENT DEPARTMENT ENGINEERING DIVISION															
TITLE: COMANCHE TRANSITION-SECTIONS & DETAILS EMBUDITO ARROYO IMPROVEMENTS COMANCHE ROAD TO TRACY STREET															
APPROVALS	ENGINEER	DATE	APPROVALS	ENGINEER	DATE										
City Engineer	P.B. Vedammit	3/15/85	Liquid Waste	P.B. Vedammit	3/15/85										
A-C-E - Design	N.A.W.	3/15/85	Traffic	P.B. Vedammit	3/15/85										
A-C-E - Hydrology	N.A.W.	3/15/85	Water	P.B. Vedammit	3/15/85										
DRAWING NO.	2296	MAP NO.	SHEET	5	OF	16									

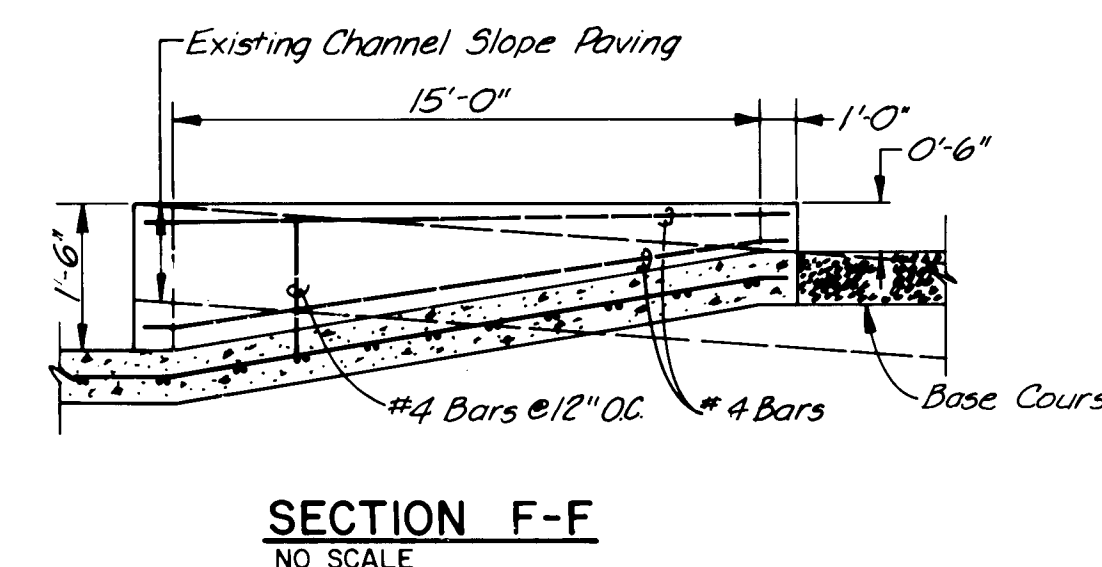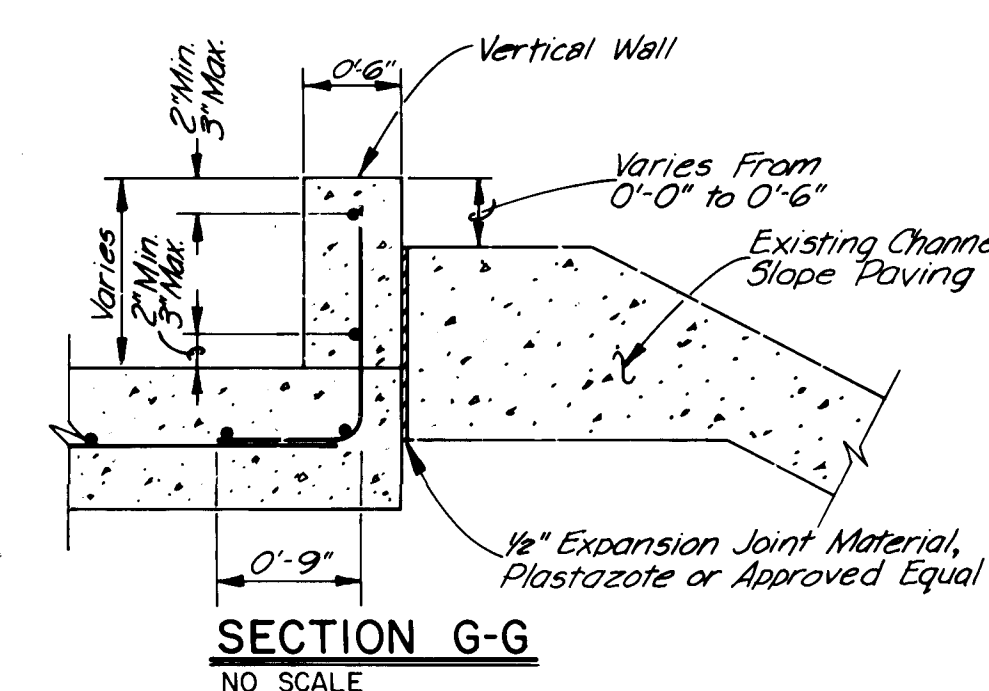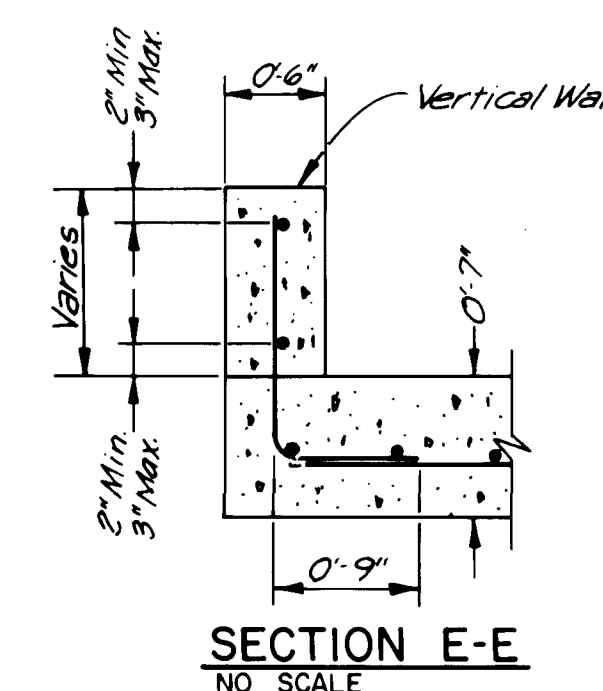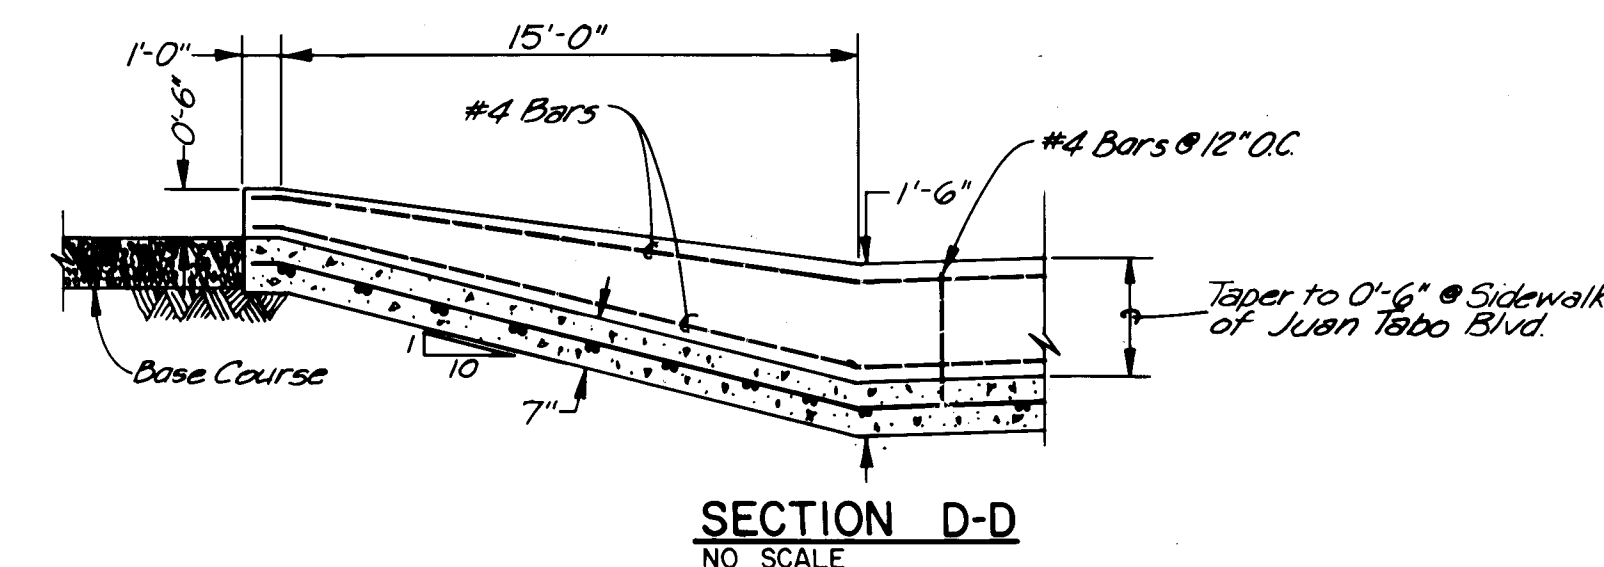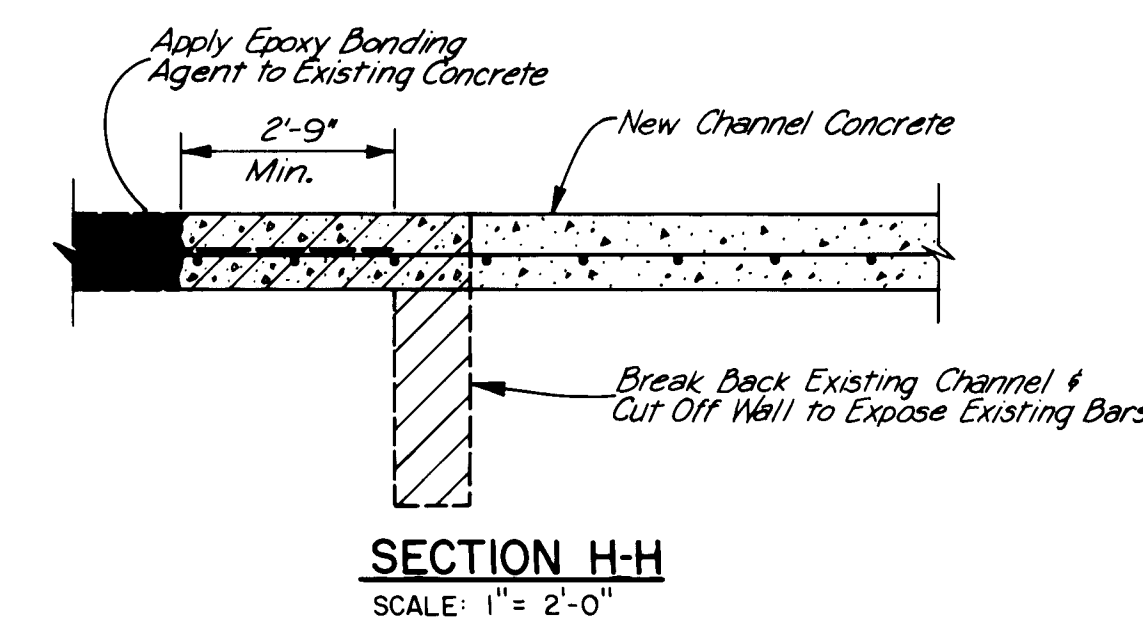

NOTES:

1. Reconstruction of Existing Rundown Will Be Payed For Under Bid Items "Portland Cement Fly Ash-Concrete Channel Lining (7" Thick With Thickened Edges)," And "Structural Concrete For Vertical Walls (3000 psi) Including Reinforcing Steel."

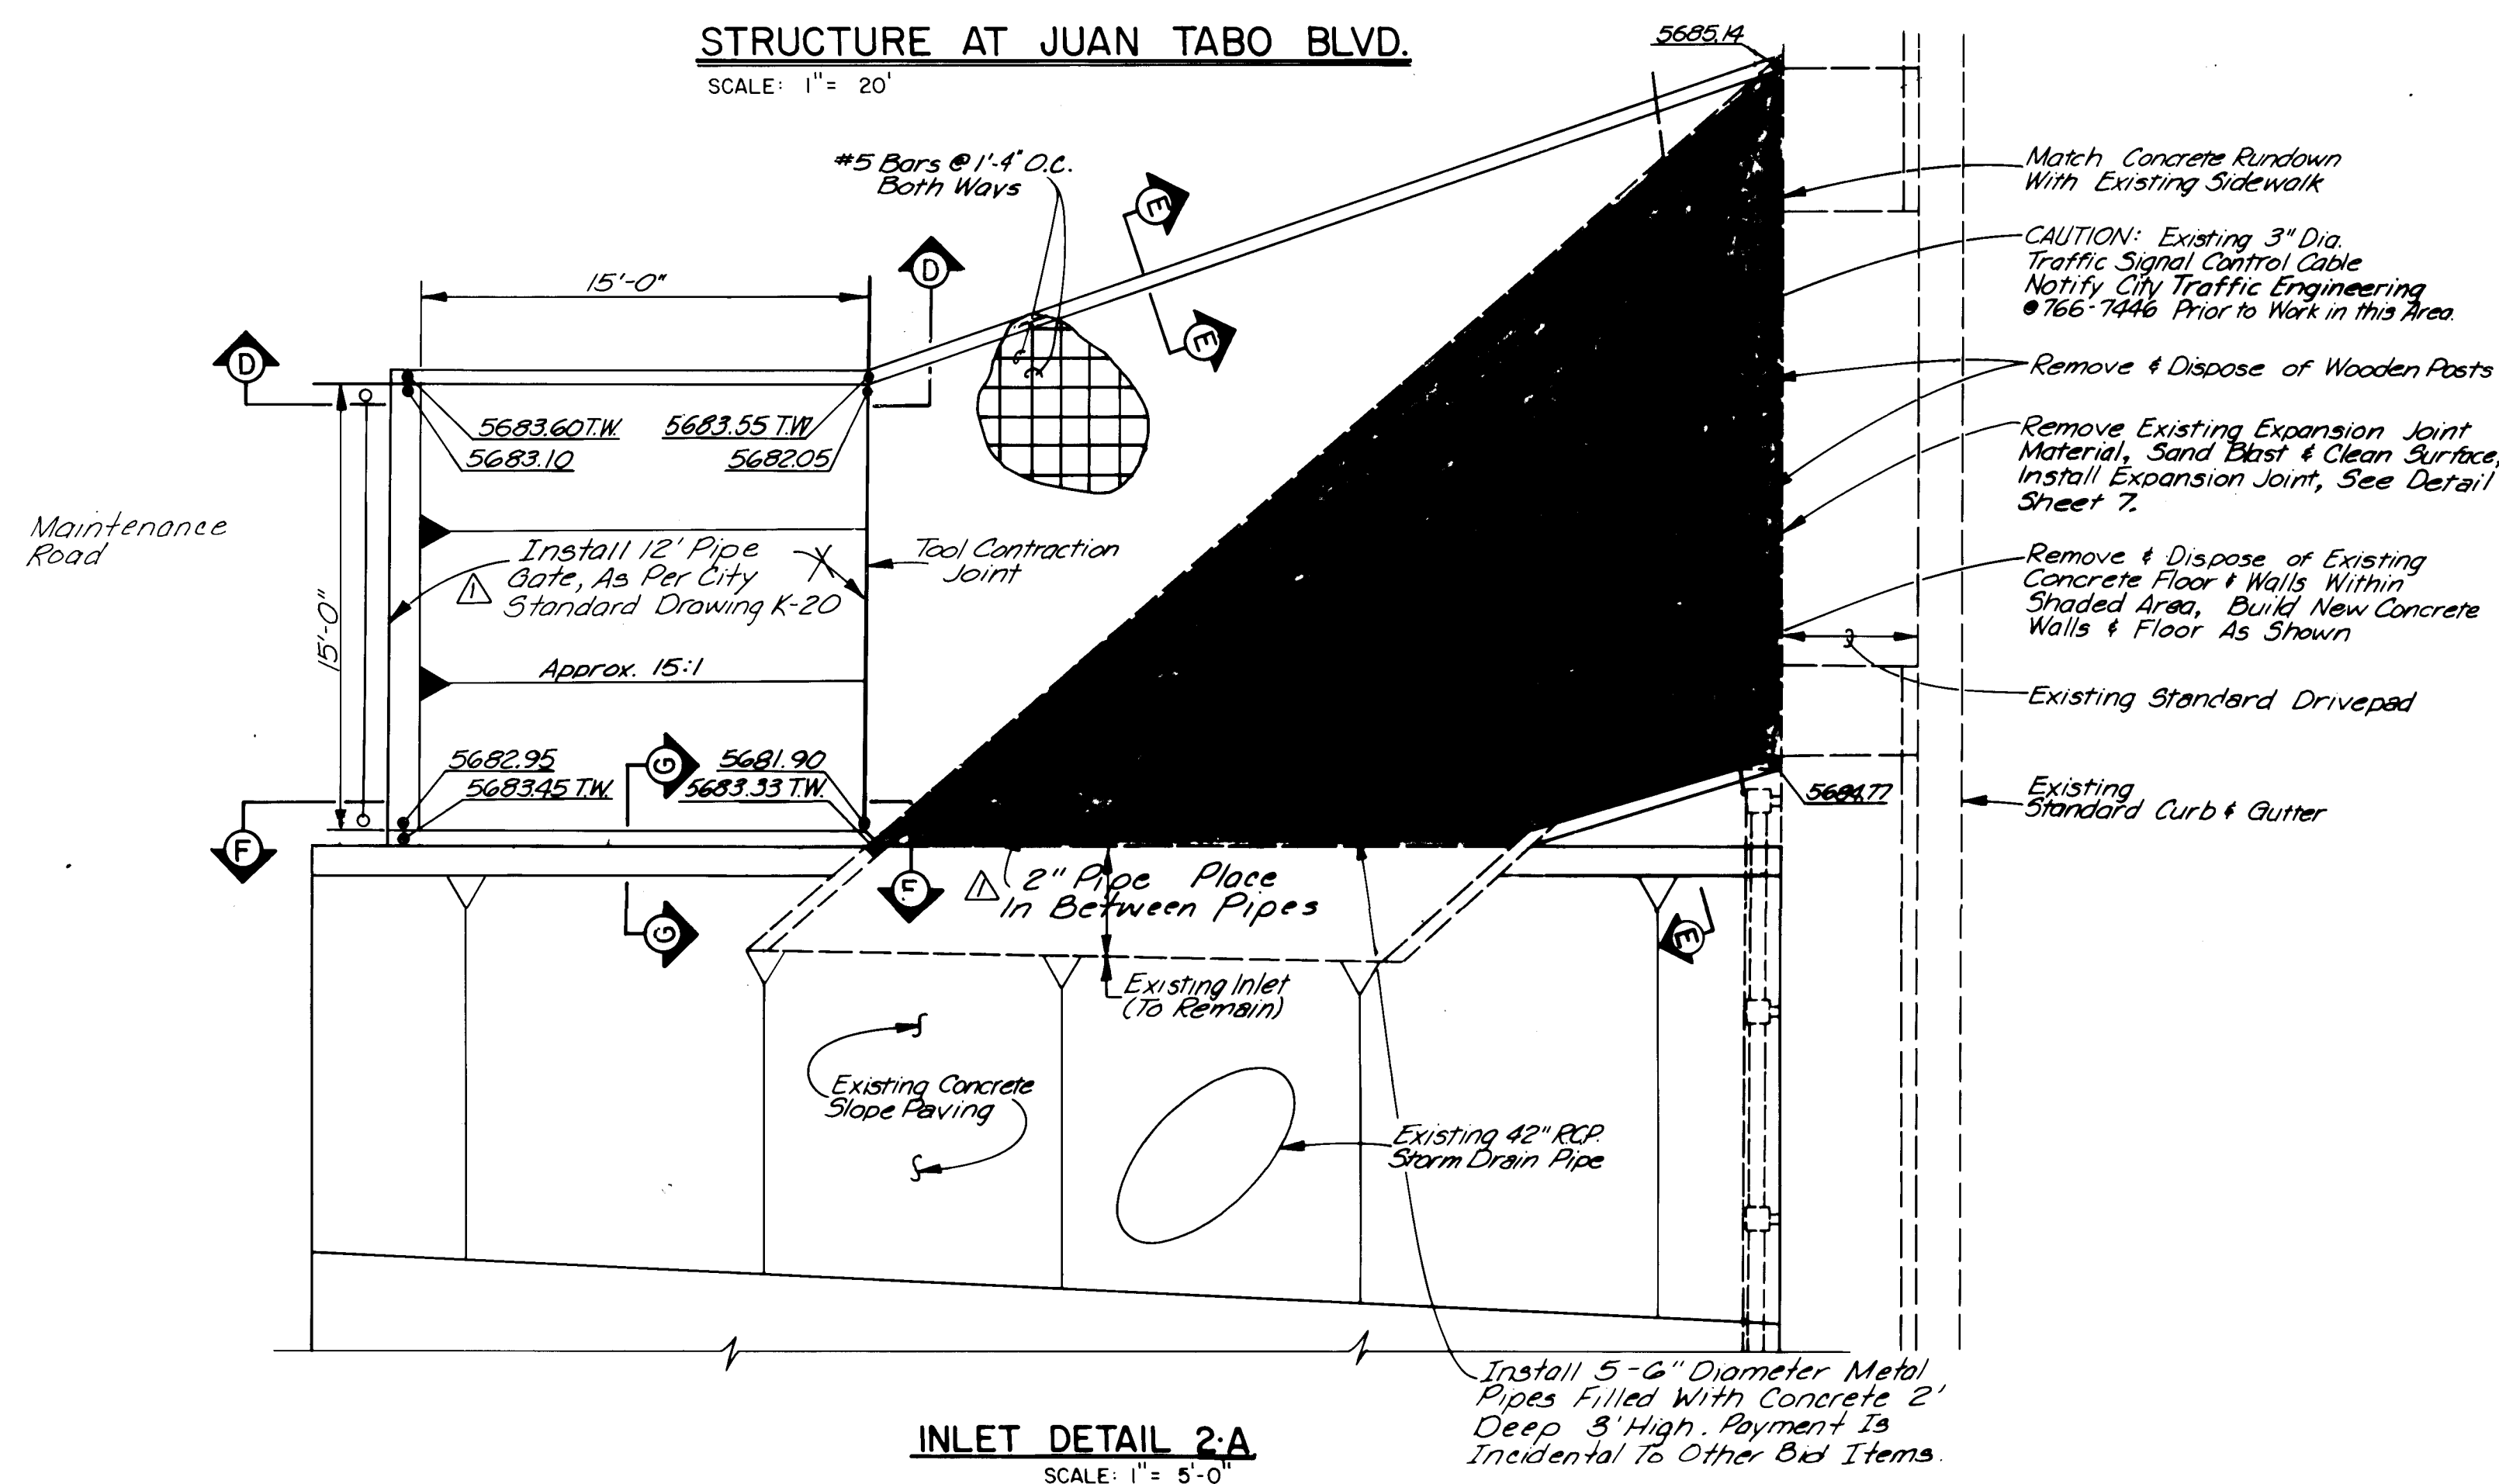

ENGINEER'S SEAL		SURVEY INFORMATION		BENCH MARKS		AS BUILT INFORMATION	
		FIELD NOTES					
		NO.	BY	DATE			
						CONTRACTOR	
						DRAWN BY	
						INSPECTOR'S	
						ACCEPTANCE BY	
						DATE	
						DATE	
						DRAWINGS	
						VERIFICATION BY	
						DATE	
						DRAWINGS	
						VERIFIED BY	
						DATE	
						MICRO-FILM INFORMATION	
						RECORDED BY	
						DATE	
						NO.	

REVISIONS		DESIGN	
DESIGNED BY	T.L.H., K.R.J.	DATE	2-85
DRAWN BY	N.A.W.	DATE	2-85
CHECKED BY	H.C.S.	DATE	2-85

SCALE: AS SHOWN



CITY OF ALBUQUERQUE

MUNICIPAL DEVELOPMENT DEPARTMENT

ENGINEERING DIVISION

TITLE: JUAN TABO TRANSITION-SECTIONS & DETAILS
EMBUDITO ARROYO IMPROVEMENTS
COMANCHE ROAD TO TRACY STREET




APPROVALS	ENGINEER	DATE	APPROVALS	ENGINEER	DATE
City Engineer	<i>C.H. Haggard</i>	3/10/85	Liquid Waste	<i>P.B. Vedamathu</i>	3/12/85
A C E - Design	<i>H. Q. Q.</i>	3/13/85	Traffic	<i>NA DWH</i>	3/13/85
A C E - Hydrology	<i>Don Han</i>	3/13/85	Water	<i>P.B. Vedamathu</i>	3/13/85






DRAWING NO.	2296	MAP NO.	SHEET 6 OF 16
-------------	------	---------	---------------

JOB NO. 43080


RECORD DRAWINGS

DATE: 12/5/95

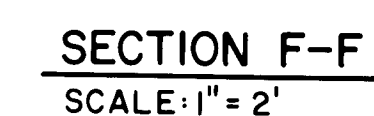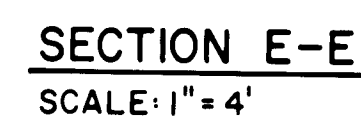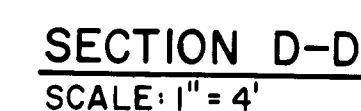[illegible]

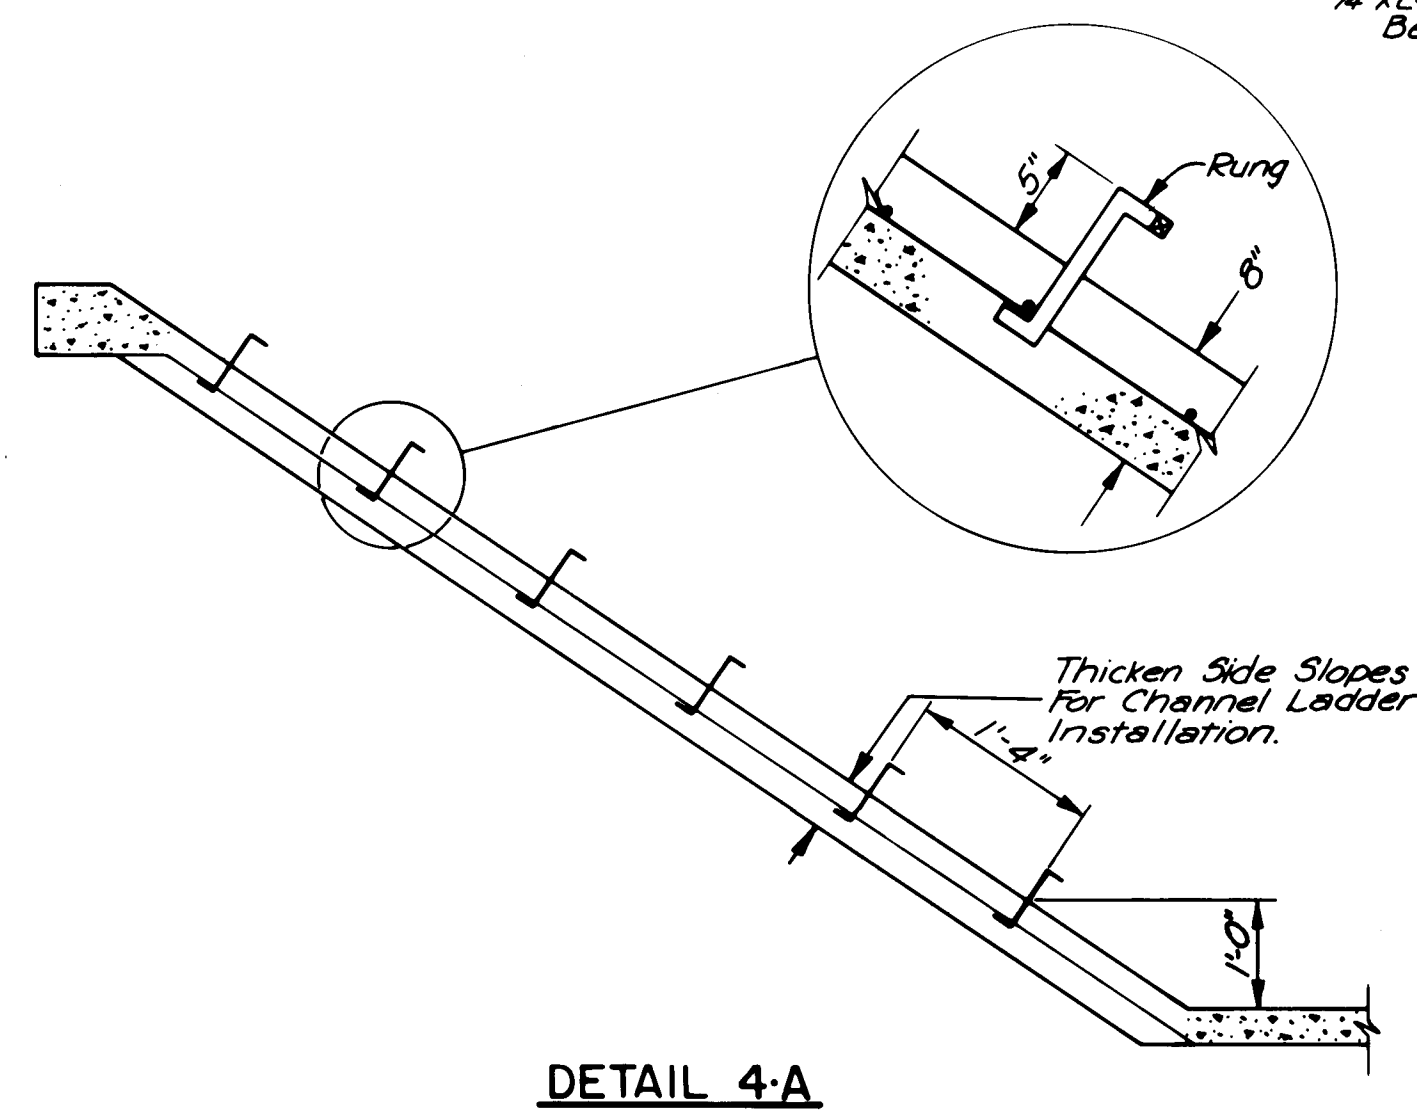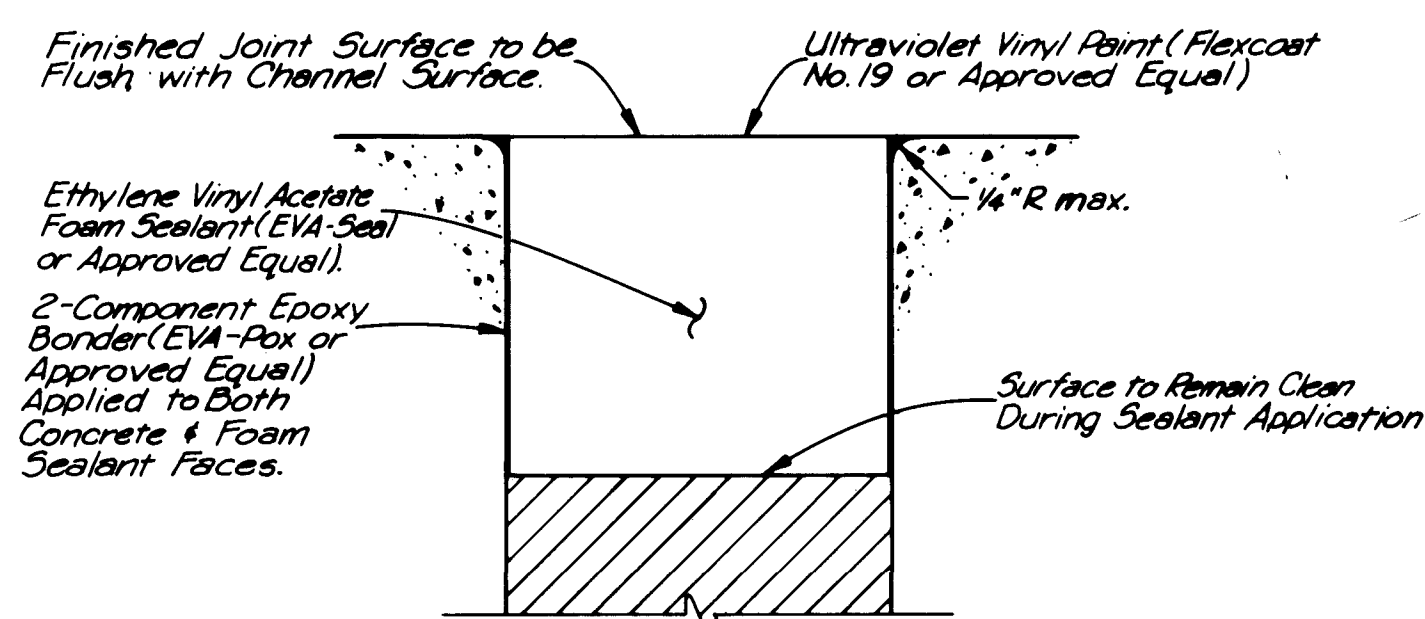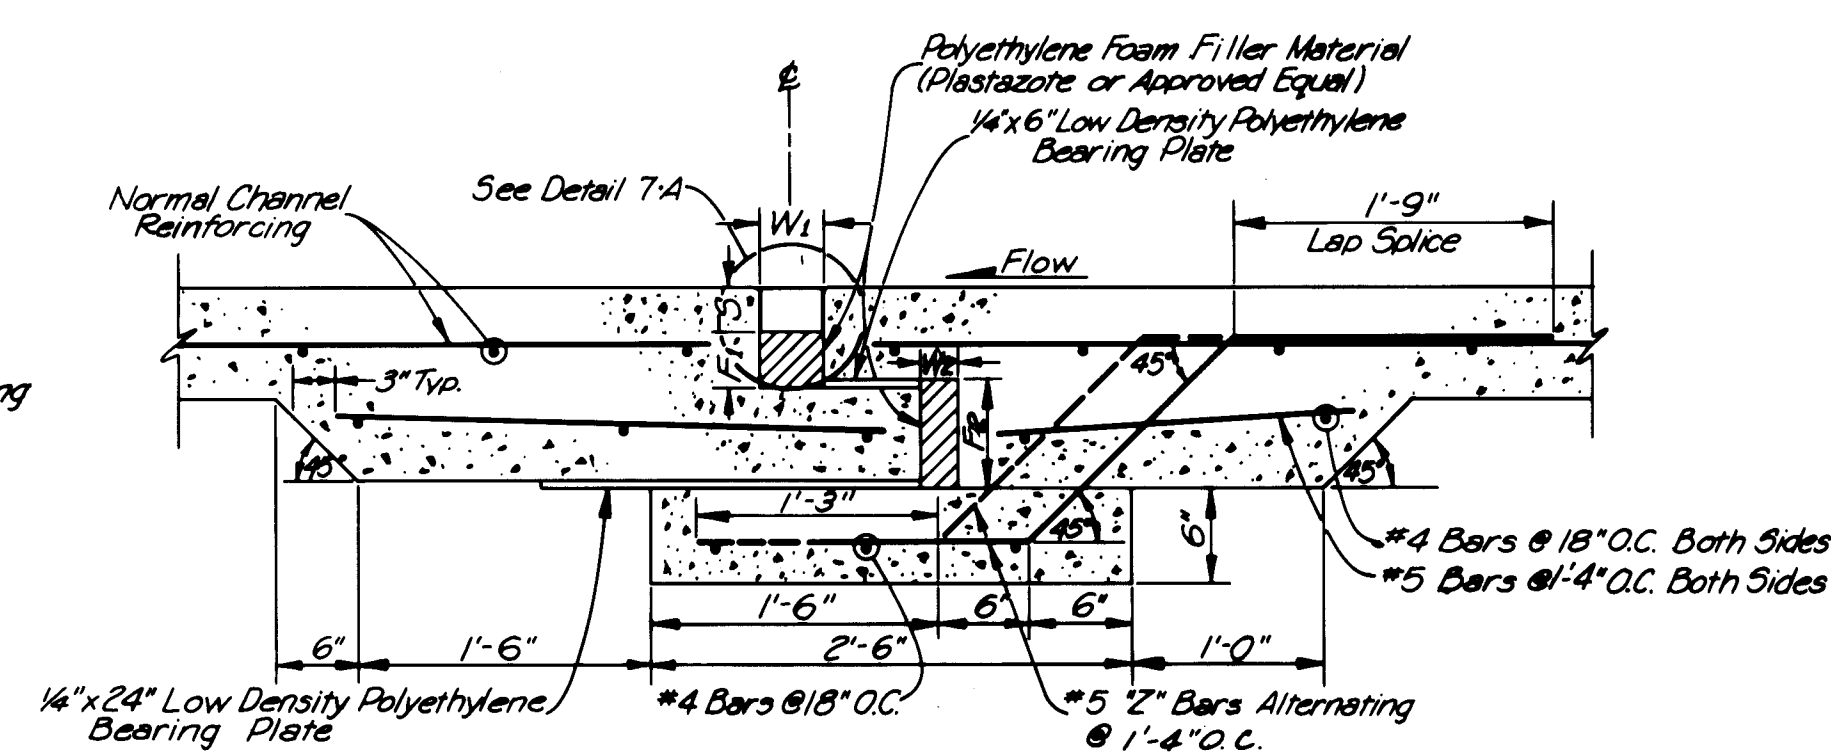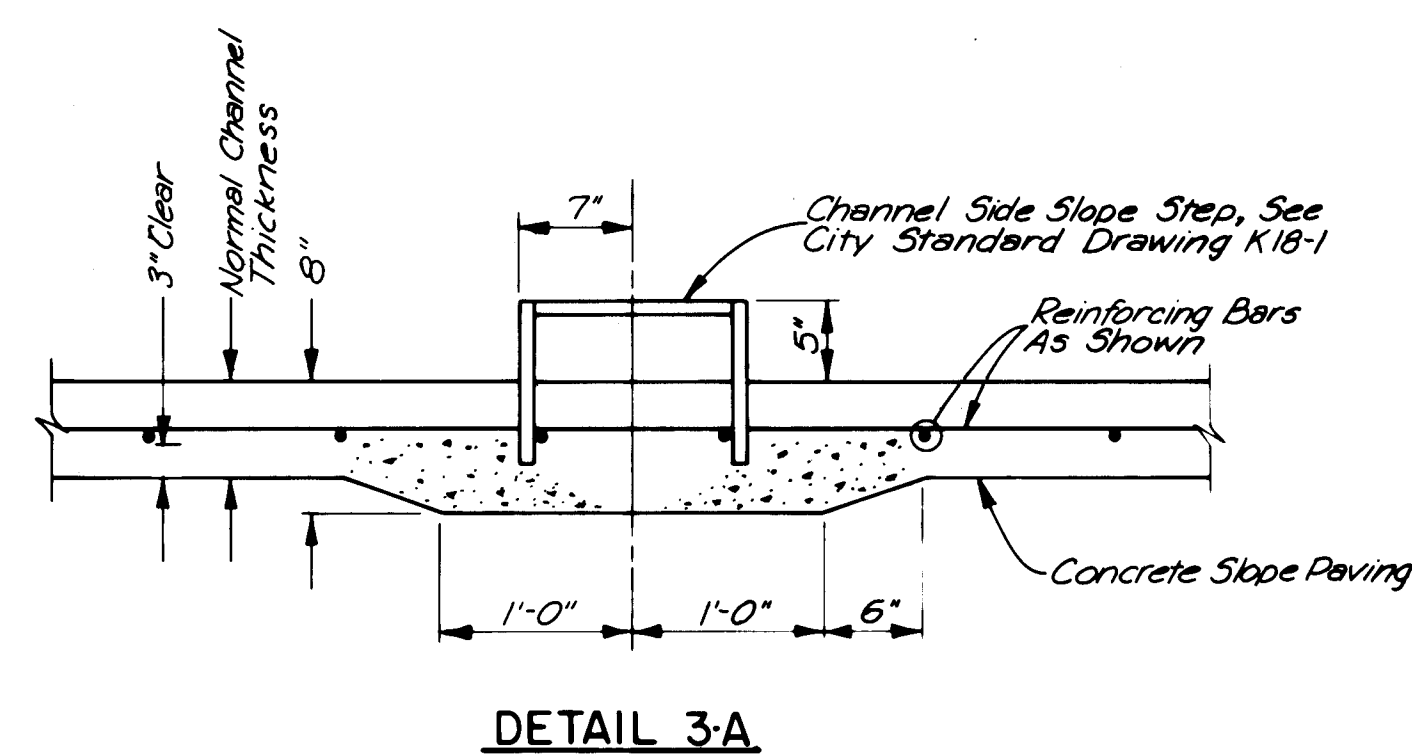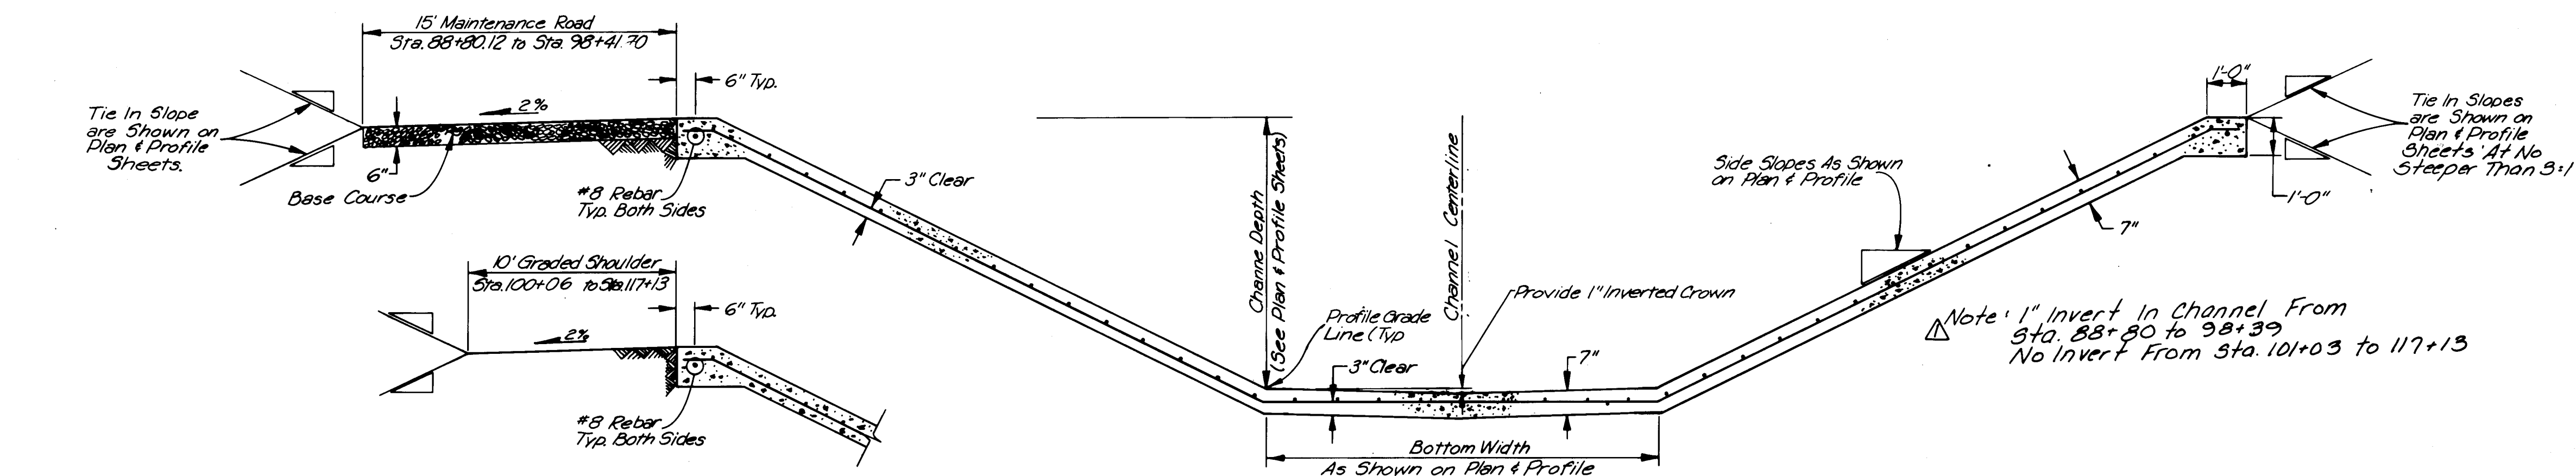

CHANNEL SIDESLOPE LADDER DETAILS

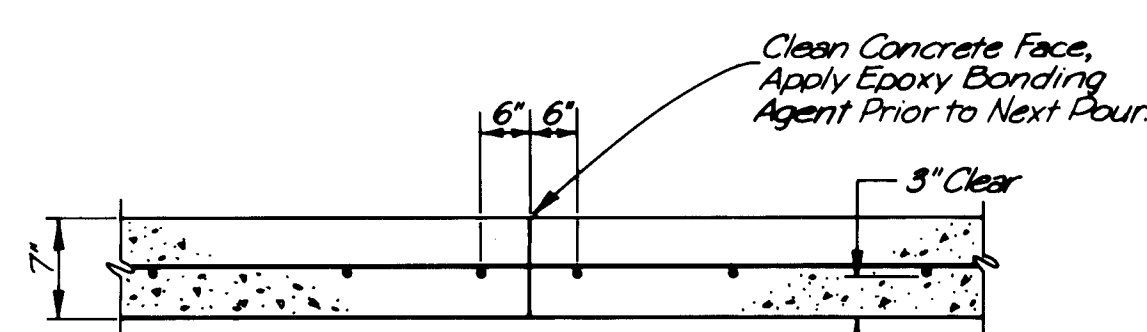


CONSTRUCTION JOINT DETAIL
AS REQUIRED BY CHANNEL CONSTRUCTION



EXPANSION JOINT FILLERS & SEALANT DIMENSIONS(in inches)

W1	W2	S	F1	F2
2	1	2	4½	6
3	2	2½	3¾	6
5	4	4	2¼	6
6	5	4	2¼	6
7	6	4	2¼	6

NOTE: Order Width For Foam Filter Sealant Δ
Material Shall Be 25% Greater
Than Dimensions of W1 & W2.

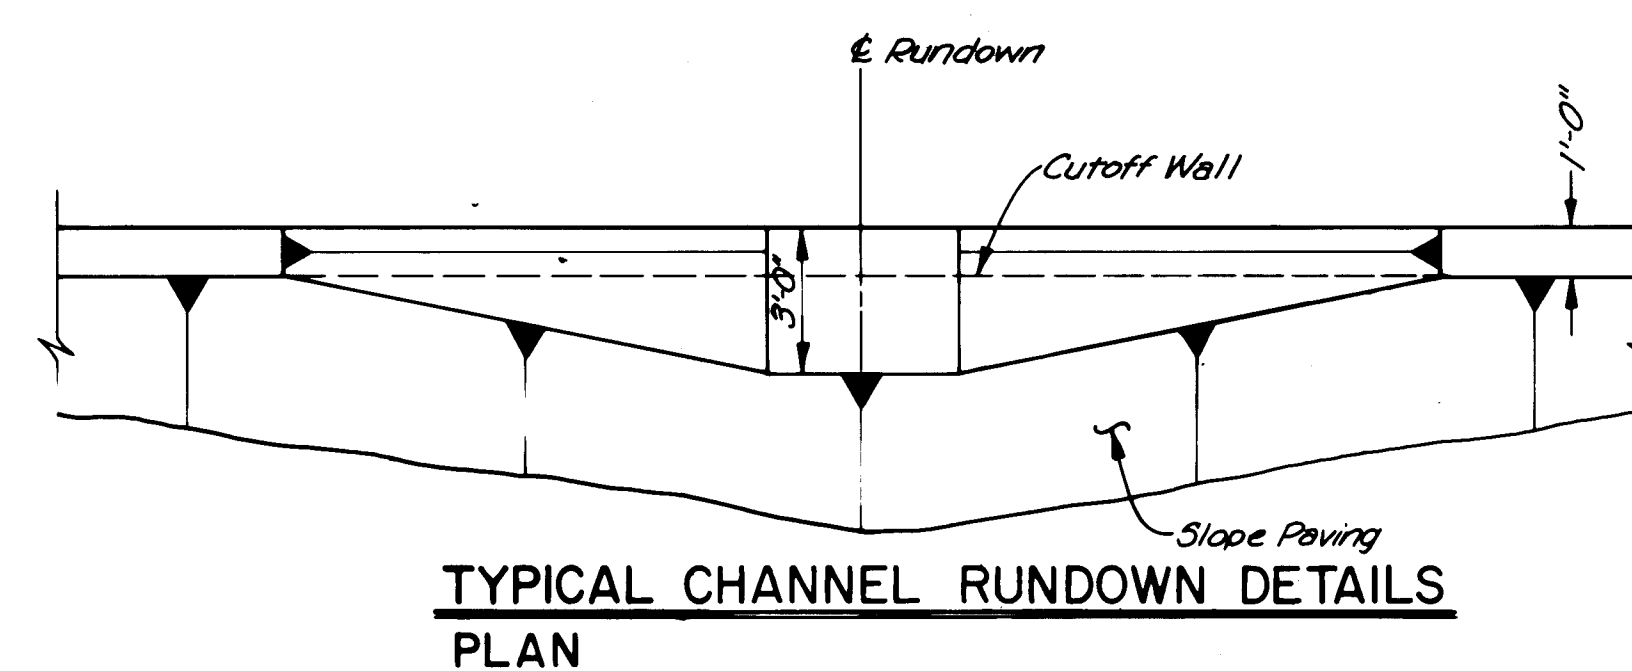

TYPICAL CHANNEL RUNDOWN DETAILS
PLAN

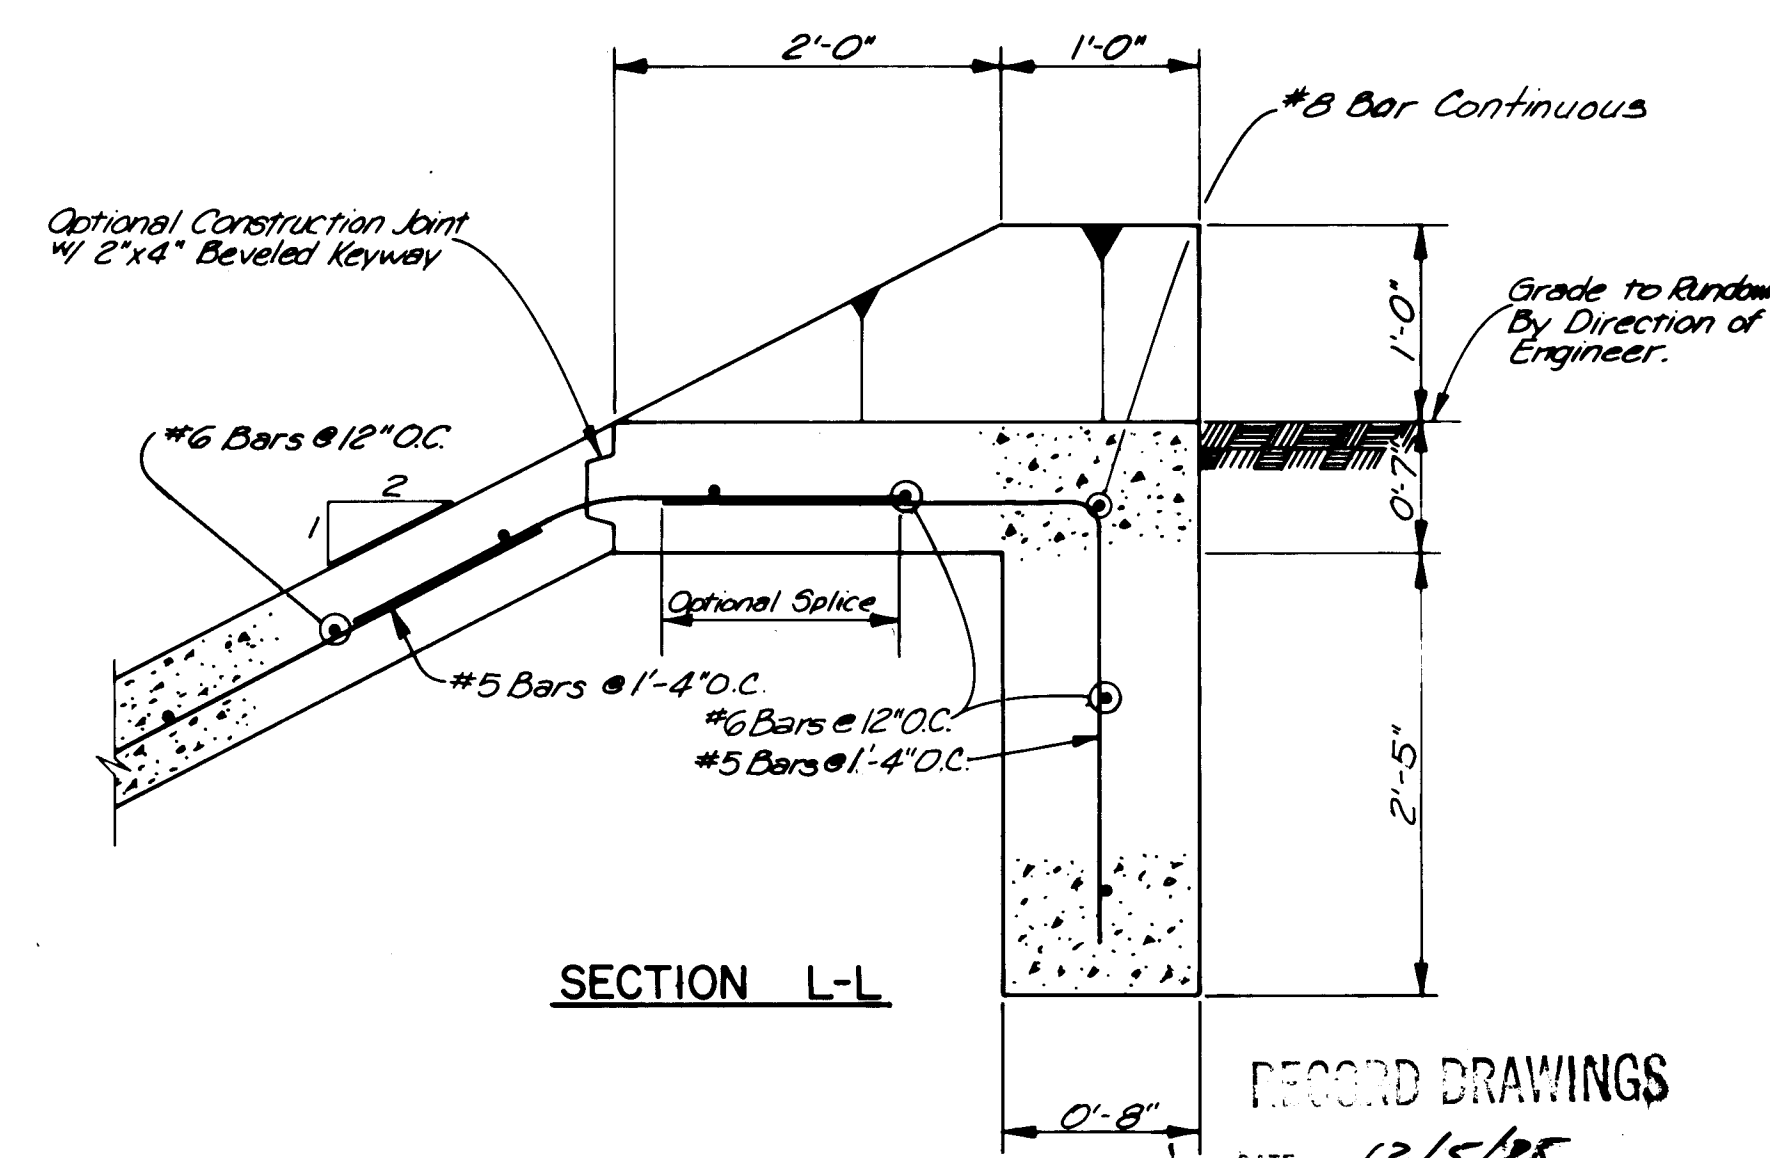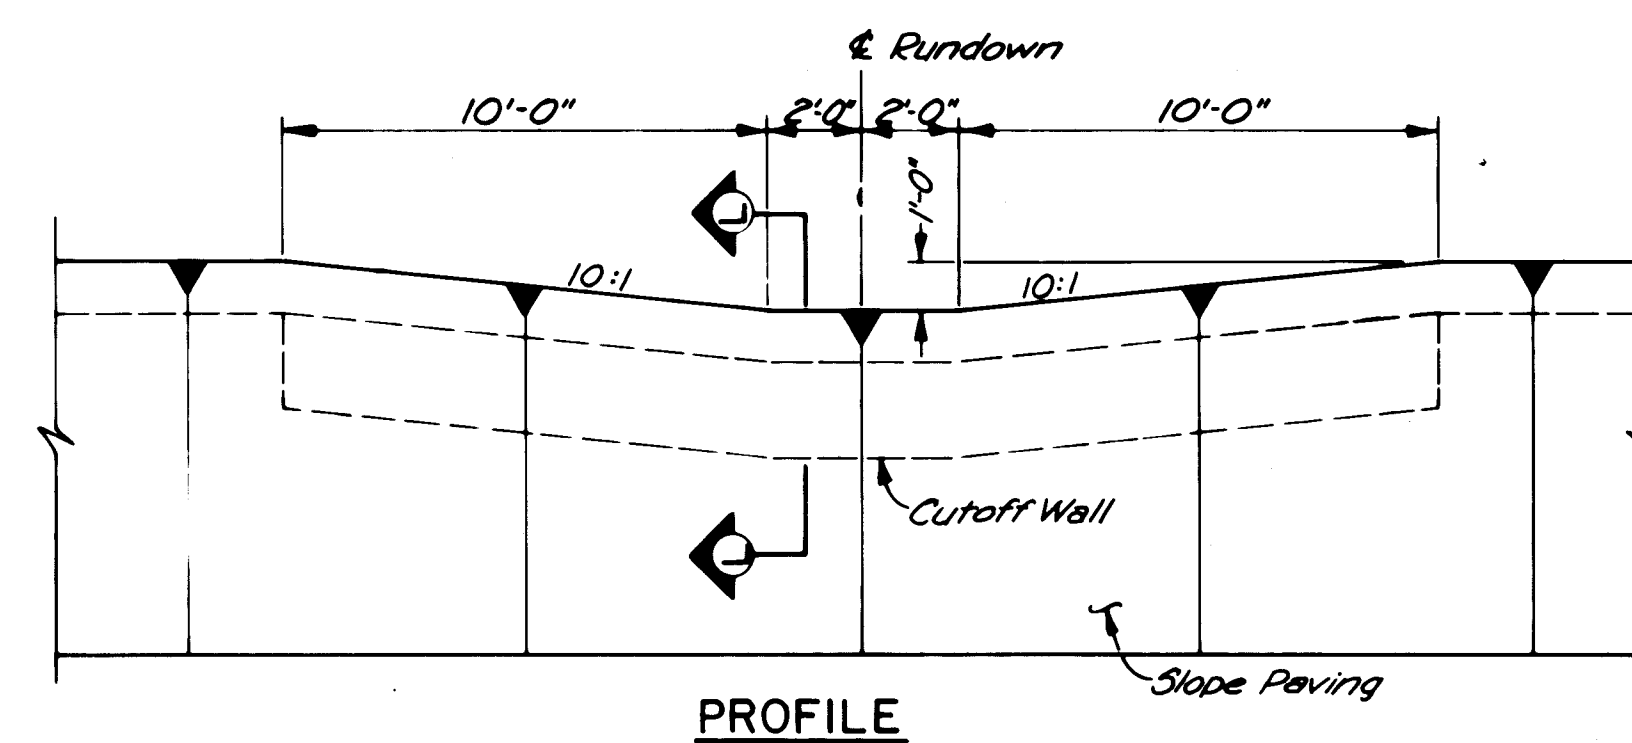

1	2	3	4	5	6	7	8	9	10	11	12
2	6		2	2	9	6	0	9	8	5	

JOB NO. 43080

NOTE:

1. Concrete Shall be 3000 P.S.I. 28 Day Strength with maximum Aggregate Size as Stated in the Specifications.
2. All Reinforcing Steel Shall be Grade 60 Deformed Bars, Unless Otherwise Shown.
3. Splices in Rebar in Typical Channel Section Shall be 1'-0" or Greater for No 3 and No 4 Bars, 1'-3" for No 5 Bars, 2'-0" for No 6 Bars and 4'-0" for No 8 Bars, Unless Otherwise Shown.
4. All Steel Spacing are given to the Centerline of the Bar, U.O.S.
5. All Exposed Edges Shall have a 3/4" Chamfer, Unless Noted Otherwise.
6. Channel Rebar Shall be Supported on 5/8" Sand Chairs at a Maximum Spacing of 5' Perpendicular to the Channel Centerline.
7. Place Ladder Steps as Shown on Plan and Profile Sheets on Both Sides of Channel.
8. Maintenance Road Shall be Surfaced with 6" Class I Crushed Gravel Base as Stated in the Specifications.
9. Minimum Subgrade Compaction Shall be 90 % per ASTM D 1557.
10. Bar Inside Diameter Bend is 6 Times the Bar Diameter.

EXPANSION JOINT CONSTRUCTION NOTES

1. Compact sleeper subgrade to 90% per ASTM D 1557.
2. Pour sleeper with Z-bar reinforcement extending above slab. Steel trowel bearing plate surface only.
3. Compact subgrade and form downstream portion of joint. Construction joints may be installed a min. of 5 feet upstream and downstream of joint centerline. Place lower bearing plate and downstream reinforcing and make downstream pour. Steel trowel upper bearing plate surface.
4. Compact subgrade and form upstream portion of joint. Place reinforcing steel, upper bearing plate, and upper and lower foam filler material. Upper bearing plate must be parallel to lower bearing plate. Do not anchor foam filler material with nails or bonding agent, but flush with pour downstream section. Block out foam sealant notch, clean exposed sleeper surface and make upstream pour.
5. When upstream and downstream concrete has reached a min. of 80% design strength or after a minimum of seven days has elapsed since concrete was poured, remove sealant notch form, sand blast vertical surfaces and blow all debris from notch. Apply Epoxy bondor to both vertical concrete faces and to both sides of foam sealant material. Immediately compress foam sealant into notch. Remove bondor from top surface of sealant material, but do not clean bondor bead along edges.
6. If sealant material extends from 0" to 1/8" above channel flowline, apply ultra-violet paint as specified. If sealant material extends from 1/8" to 1/2" above channel flowline, remove sealant flush with channel flowline under the direction of the Engineer prior to application of ultra violet paint.

NOT TO SCALE


CITY OF ALBUQUERQUE
MUNICIPAL DEVELOPMENT DEPARTMENT
ENGINEERING DIVISION

TITLE: TYPICAL CHANNEL SECTIONS AND DETAILS
EMBUDITO ARROYO IMPROVEMENTS
COMANCHE ROAD TO TRACY STREET

APPROVALS	ENGINEER	DATE	APPROVALS	ENGINEER	DATE
City Engineer	<i>C.B. Hedman</i>	<i>4/20/85</i>	Liquid Waste	<i>P.B. Vedamanti</i>	<i>3/13/85</i>
ACE - Design	<i>ALC</i>	<i>3/13/85</i>	Traffic	<i>D.A. DWH</i>	<i>3/13/85</i>
ACE - Hydrology	<i>ALC</i>	<i>3/13/85</i>	Water	<i>P.B. Vedamanti</i>	<i>3/13/85</i>


DRAWING NO	2296	MAP NO.	SHEET 9 OF 16
------------	------	---------	---------------

MAP NO.	SHEET	9	OF	16
---------	-------	---	----	----

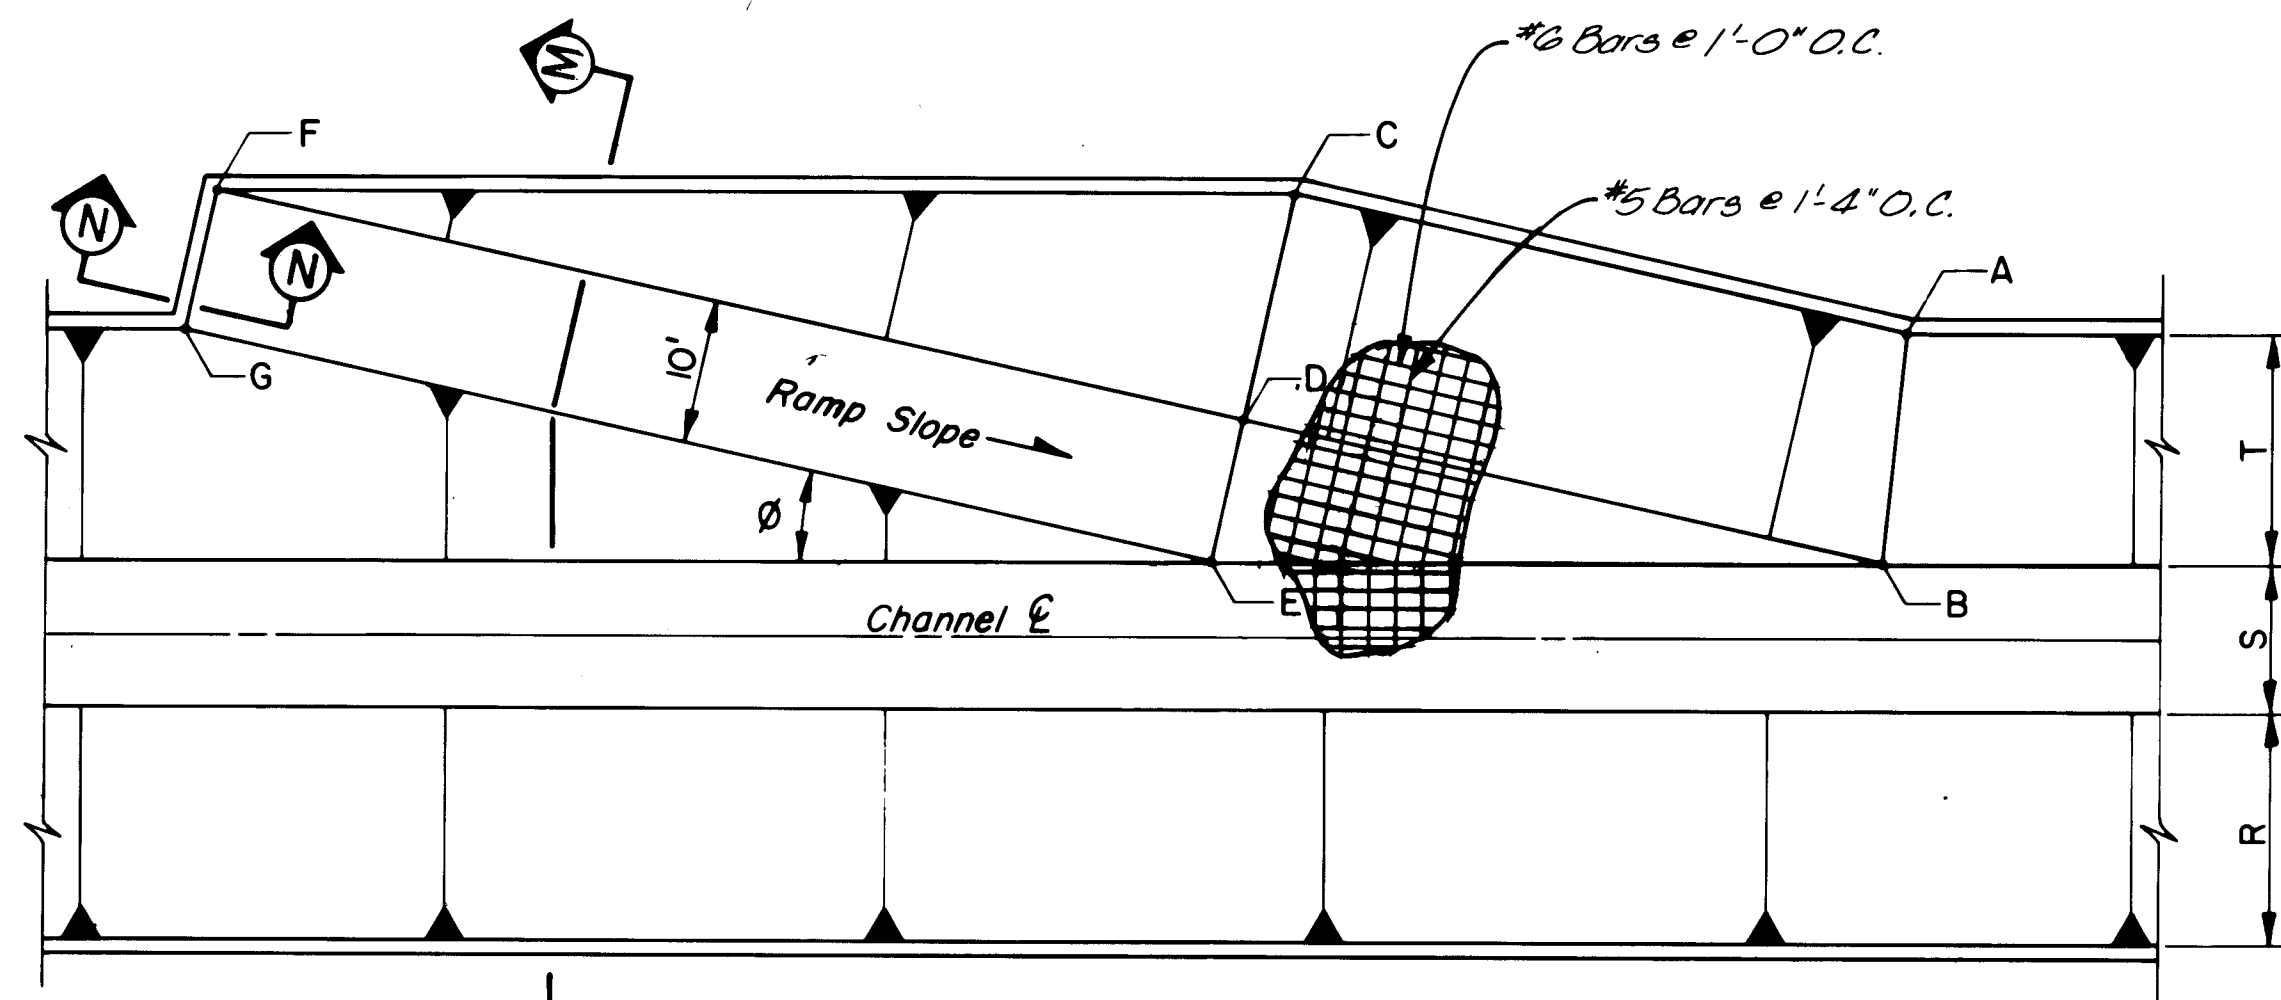


MAINTENANCE VEHICLE RAMP
PLAN VIEW


SITE DESCRIPTION	CHANNEL SIDE SLOPE	SLOPE (%)		Ø	DIMENSIONS			POINT							
		CHANNEL	RAMP		R	S	T	DESCRIPTION	A	B	C	D	E	F	G
Embudo Arroyo Sta. 92+50.00 to Sta. 93+78.56	2:1	3.00%	10.0%	8"Ø2'54"	8'	10'	8	STATION	92+50.00	92+50.56	93+20.01	93+20.58	93+21.98	93+77.16	93+78.56
								ELEVATION	5663.44	5659.46	5665.54	5661.56	5661.60	5667.25	5667.29
								OFFSET FROM CHANNEL C	13.00'	5.00'	22.90	14.90'	5.00'	22.90	13.00'
								STATION							
								ELEVATION							
								OFFSET FROM CHANNEL C							
								STATION							
								ELEVATION							
								OFFSET FROM CHANNEL C							
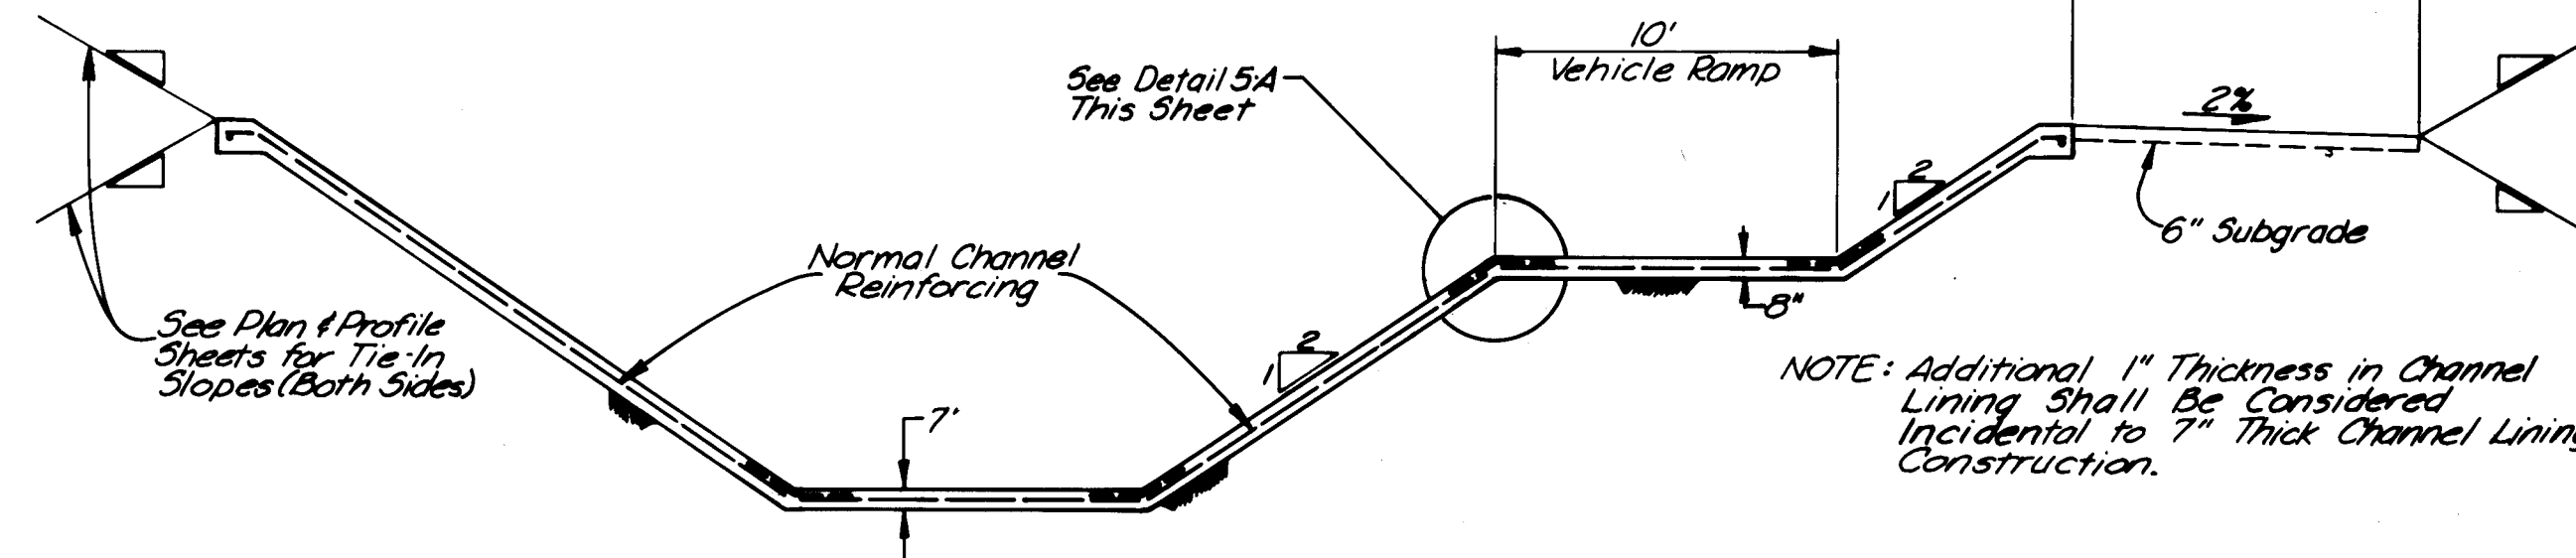


SECTION M-M

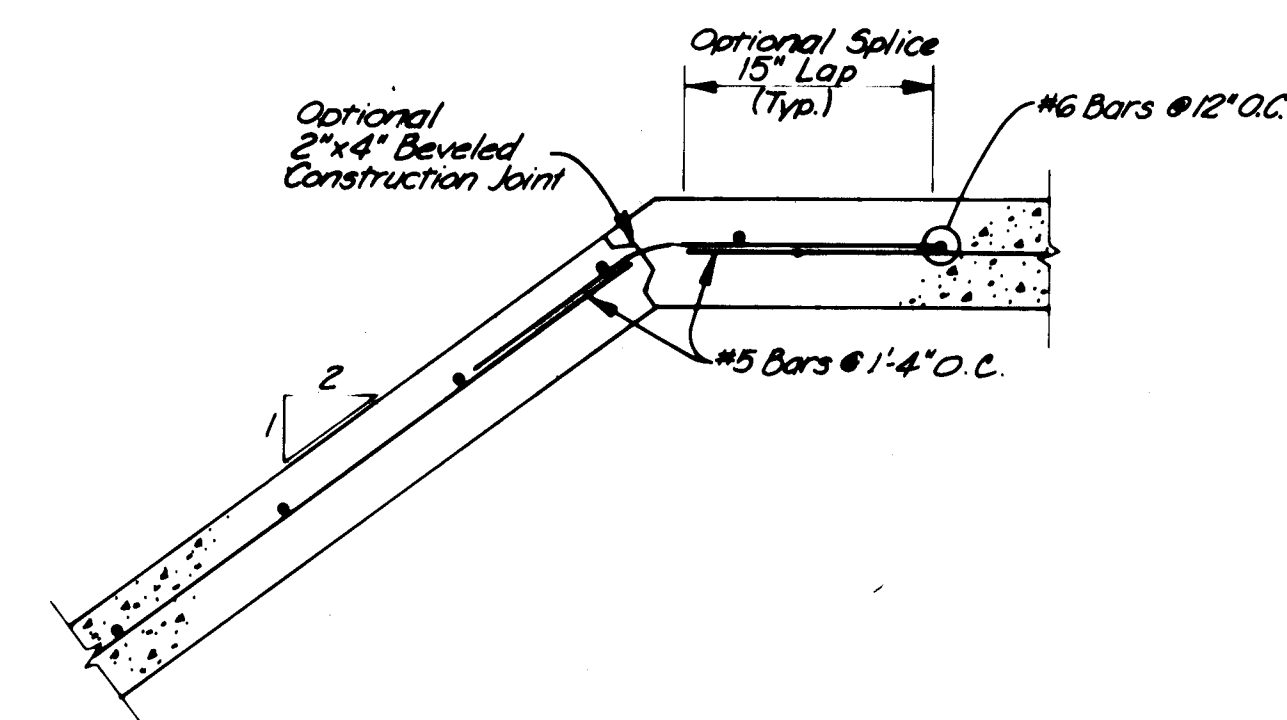

DETAIL 5-A

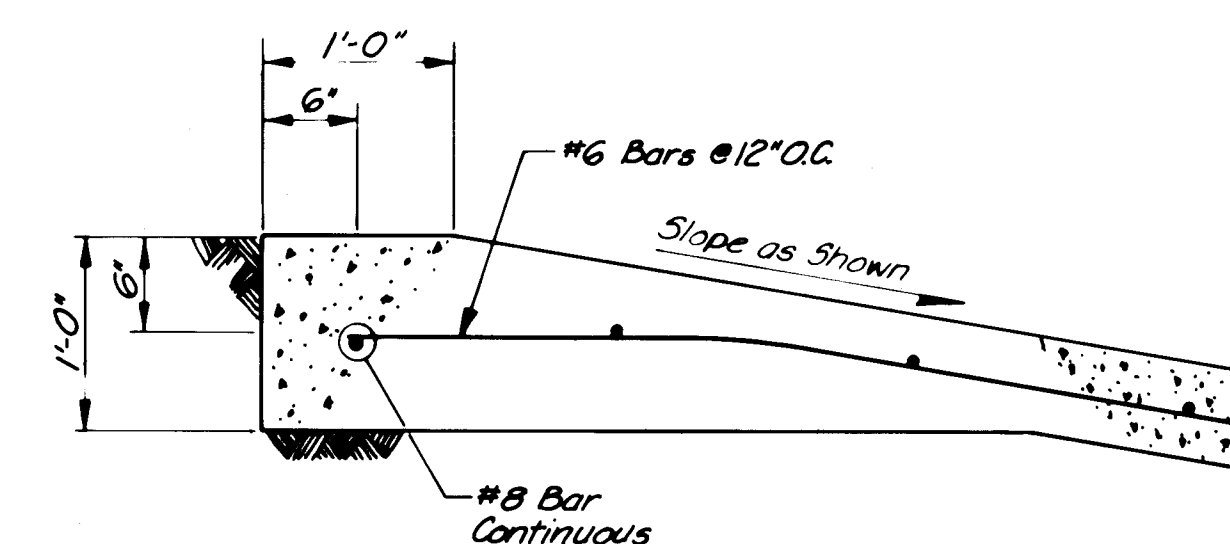

SECTION N-N

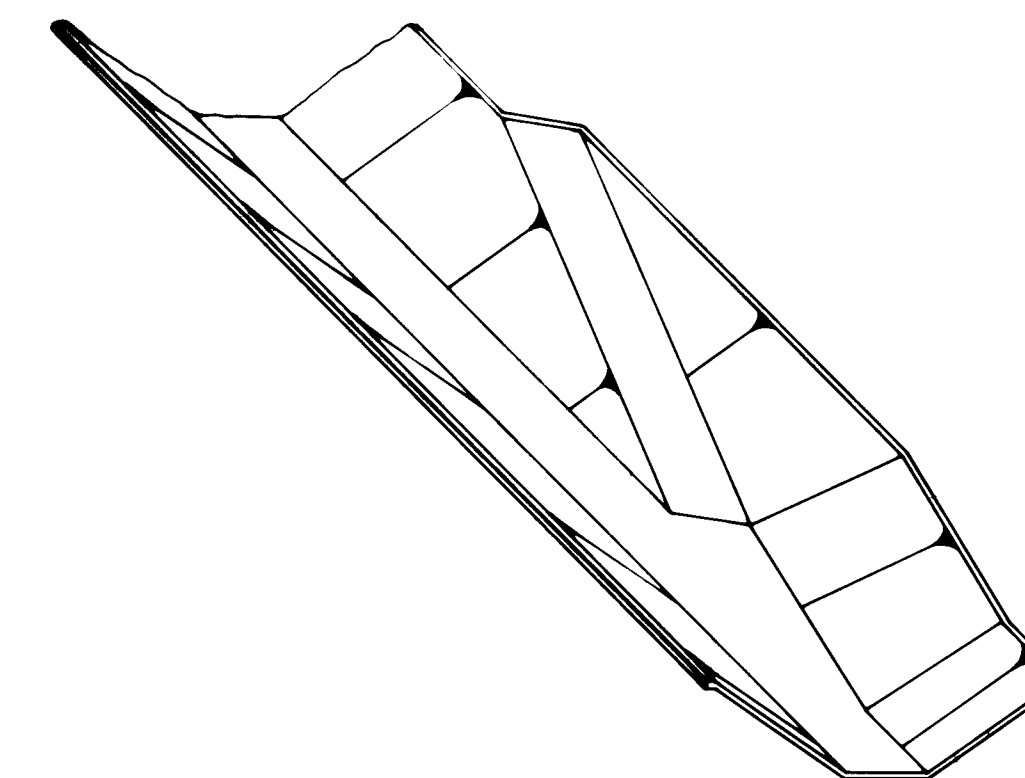


ISOMETRIC VIEW

GENERAL NOTES:
1. Maintenance Ramp may be located on side other than that illustrated in Plan View Diagram. See Plan & Profile Sheets for Actual location.
2. For Typical Channel Sections, See Sheet 9.

CONTRACT	DATE
WORK BY	DATE
INSPECTED BY	DATE
FIELD LAYOUT BY	DATE
DRAWINGS	DATE
CHECKED BY	DATE
RECORDED BY	DATE
NO.	

AS BUILT	MARKS
CONTRACT	DATE
WORK BY	DATE
INSPECTED BY	DATE
FIELD LAYOUT BY	DATE
DRAWINGS	DATE
CHECKED BY	DATE
RECORDED BY	DATE
NO.	

SURVEY	INFORMATION
FIELD NOTES	DATE
NO.	

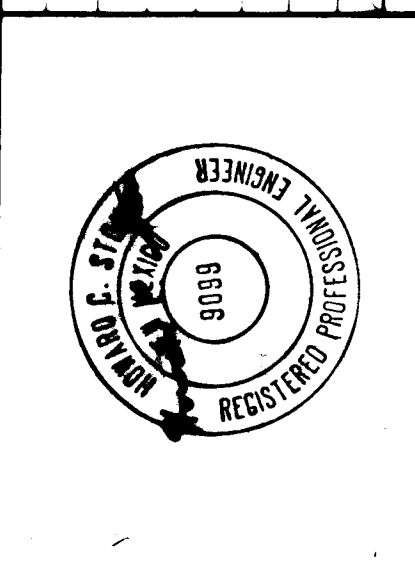

REVISIONS	BY	DATE
DESIGN	T.L.H., K.R.J.	DATE 2-85
TRAFFIC	N.A.D.W.H.	DATE 2-85
WATER	H.C.S.	DATE 2-85

NOT TO SCALE

CITY OF ALBUQUERQUE
MUNICIPAL DEVELOPMENT DEPARTMENT
ENGINEERING DIVISION

TITLE: MAINTENANCE VEHICLE RAMP DETAILS
EMBUDITO ARROYO IMPROVEMENTS
COMANCHE ROAD TO TRACY STREET

APPROVALS	ENGINEER	DATE	APPROVALS	ENGINEER	DATE
City Engineer	C.H. Adams	3/13/85	Liquid Waste	P.B. Redman	3/13/85
A.C.E. - Design	M.P. Adams	3/13/85	Traffic	N.A.D.W.H.	3/13/85
A.C.E. - Hydrology	N.A. Adams	3/13/85	Water	P.B. Redman	3/13/85

DRAWING NO.	MAP NO.	SHEET	OF
2296		10	16

JOB NO: 43080

RECORD DRAWINGS
12/5/85

FINAL SURVEY	DATE	
	BY	
	SURVEYED	
	PLOTTED	
NO. BOOK	TEMPLATE	
NO.	AREAS CHECKED	

ORIGINAL SURVEY	DATE	
	BY	
	SURVEYED	
	PLOTTED	
NO. BOOK	TEMPLATE	
NO.	AREAS CHECKED	


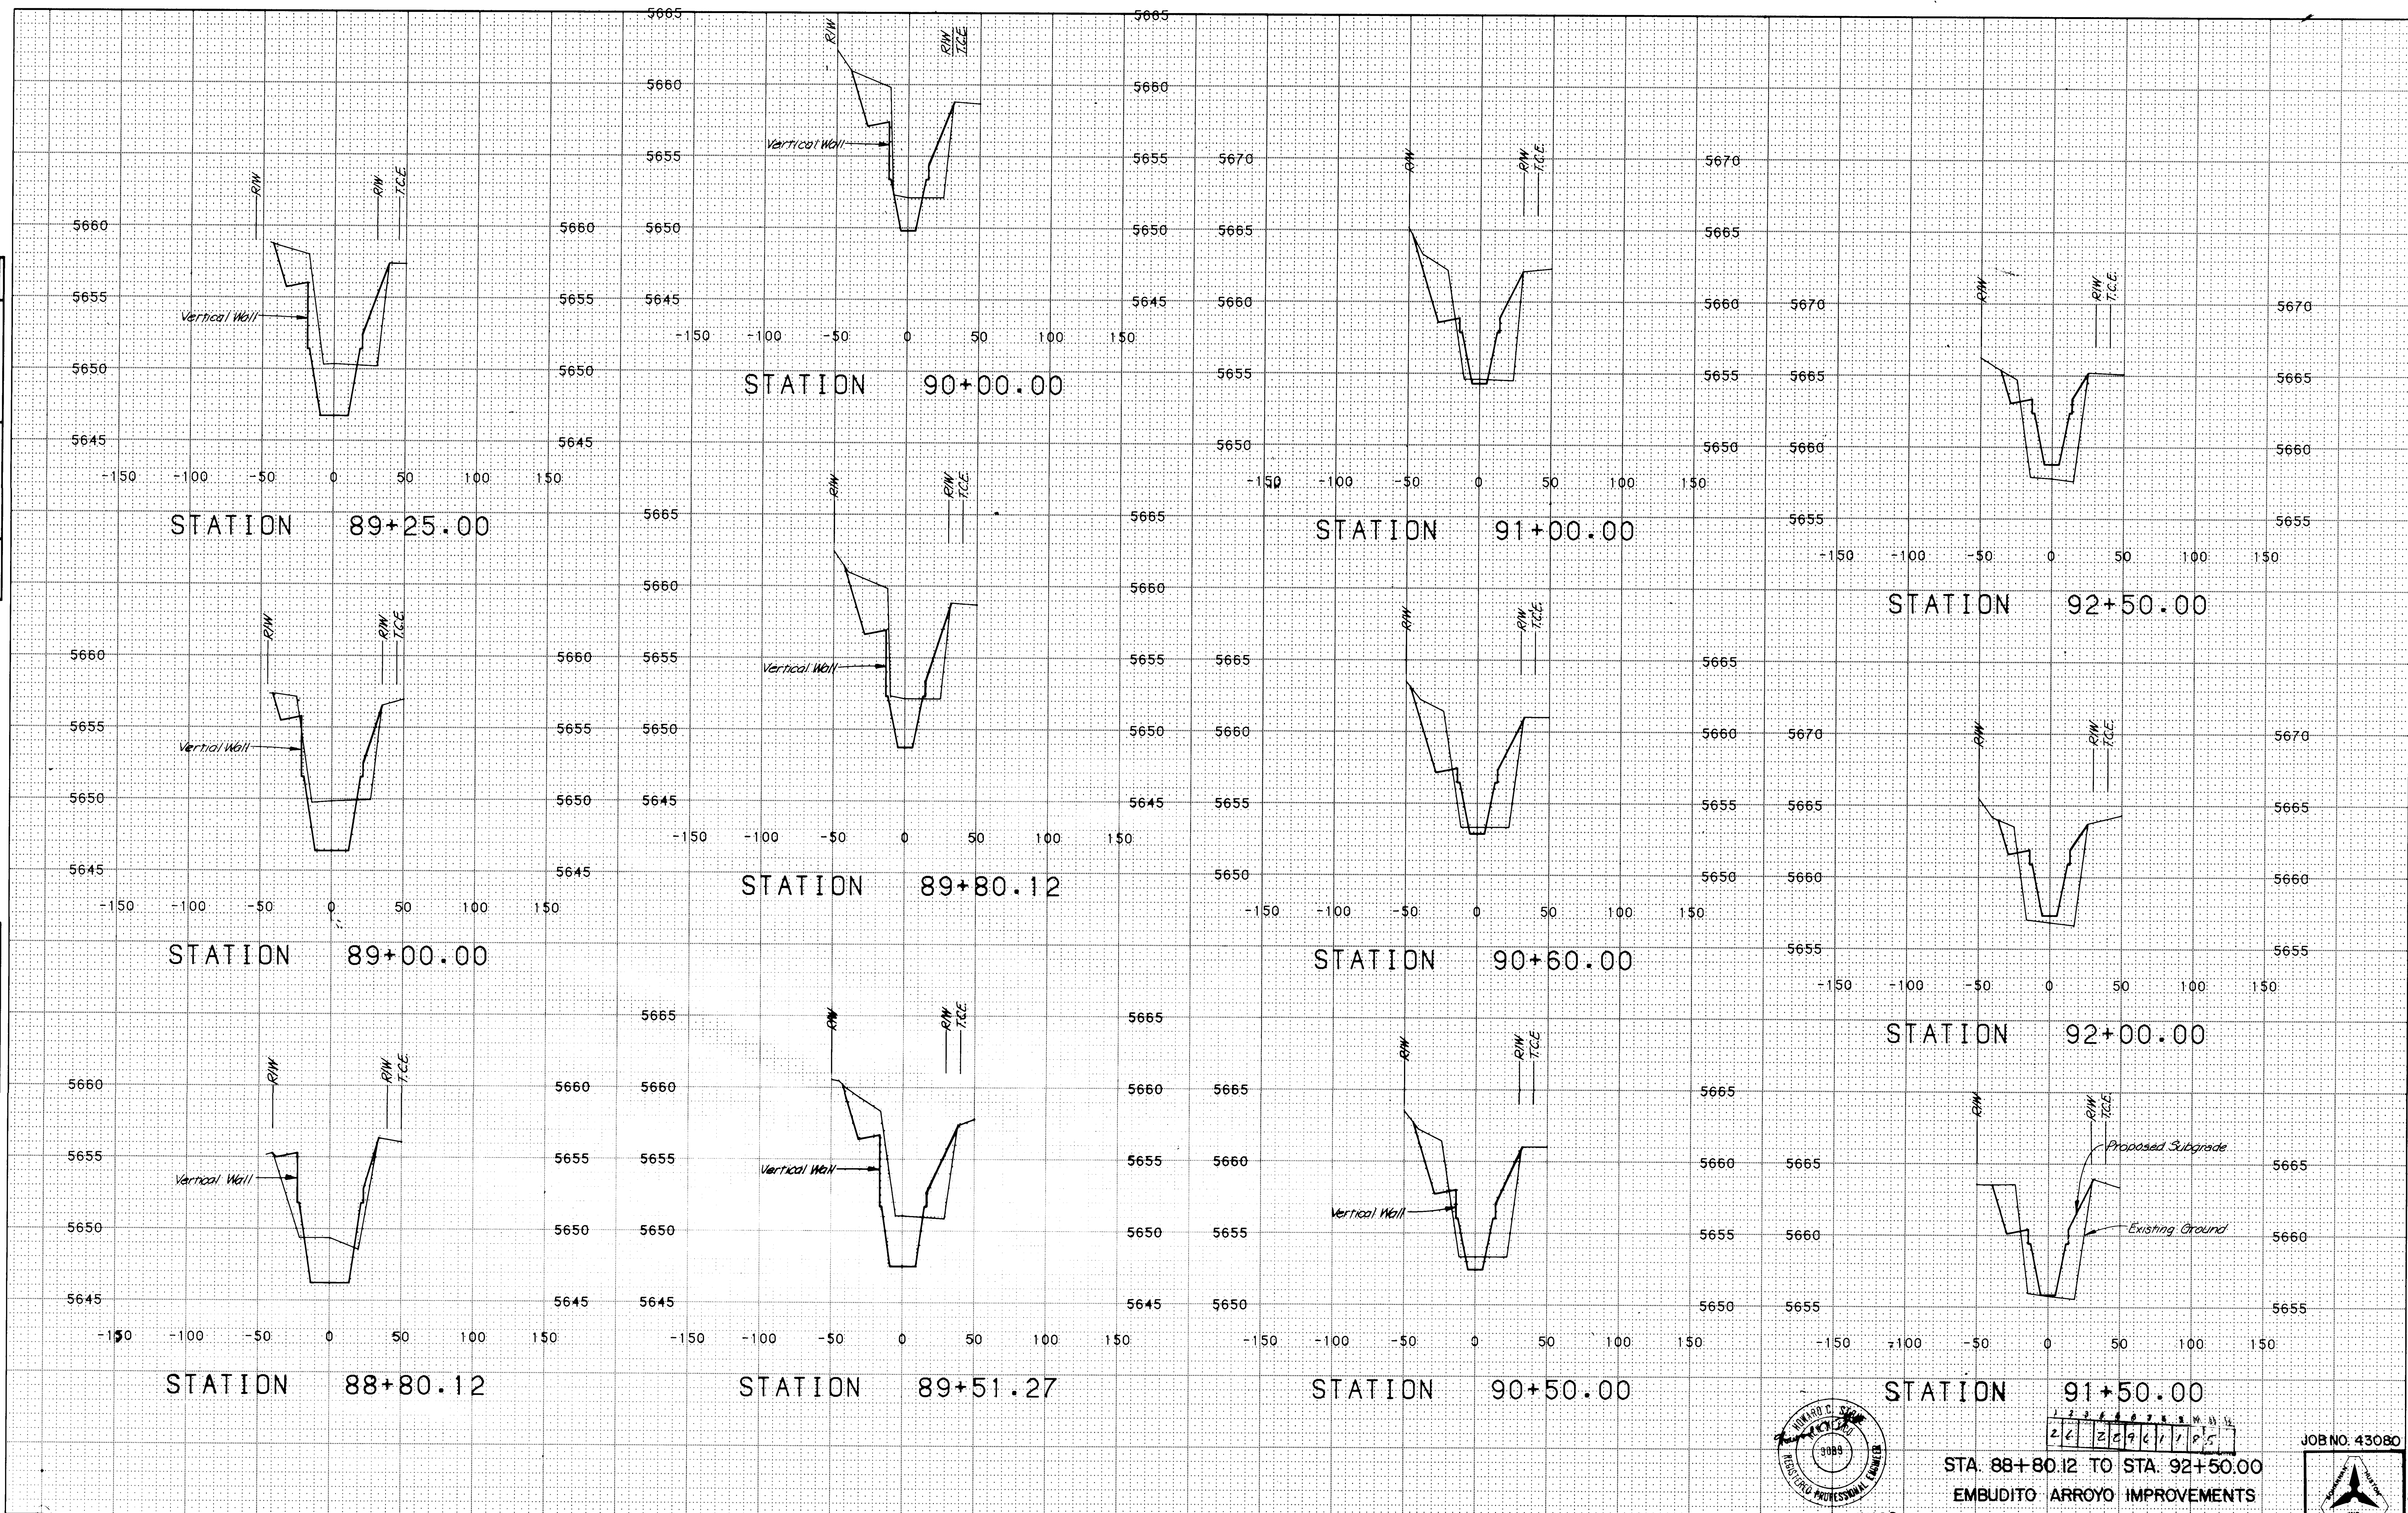


PLATE 3 CROSS SECTION - DOTTED
CHARLES BRUNING COMPANY
MADE IN U.S.A.

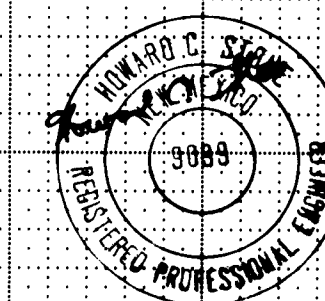


RECORD DRAWINGS

DATE 12/5/85

STA. 88+80.12 TO STA. 92+50.00
EMBUDITO ARROYO IMPROVEMENTS

JOB NO. 43080

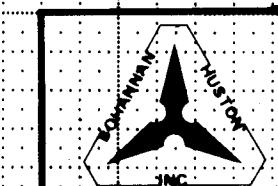

FINAL SURVEY NOTE BOOK NO.	SURVEYED PLOTTED CHECKED AREAS CHECKED	DATE
		BY

ORIGINAL SURVEY NOTE BOOK NO.	SURVEYED PLOTTED CHECKED AREAS CHECKED	DATE
		BY


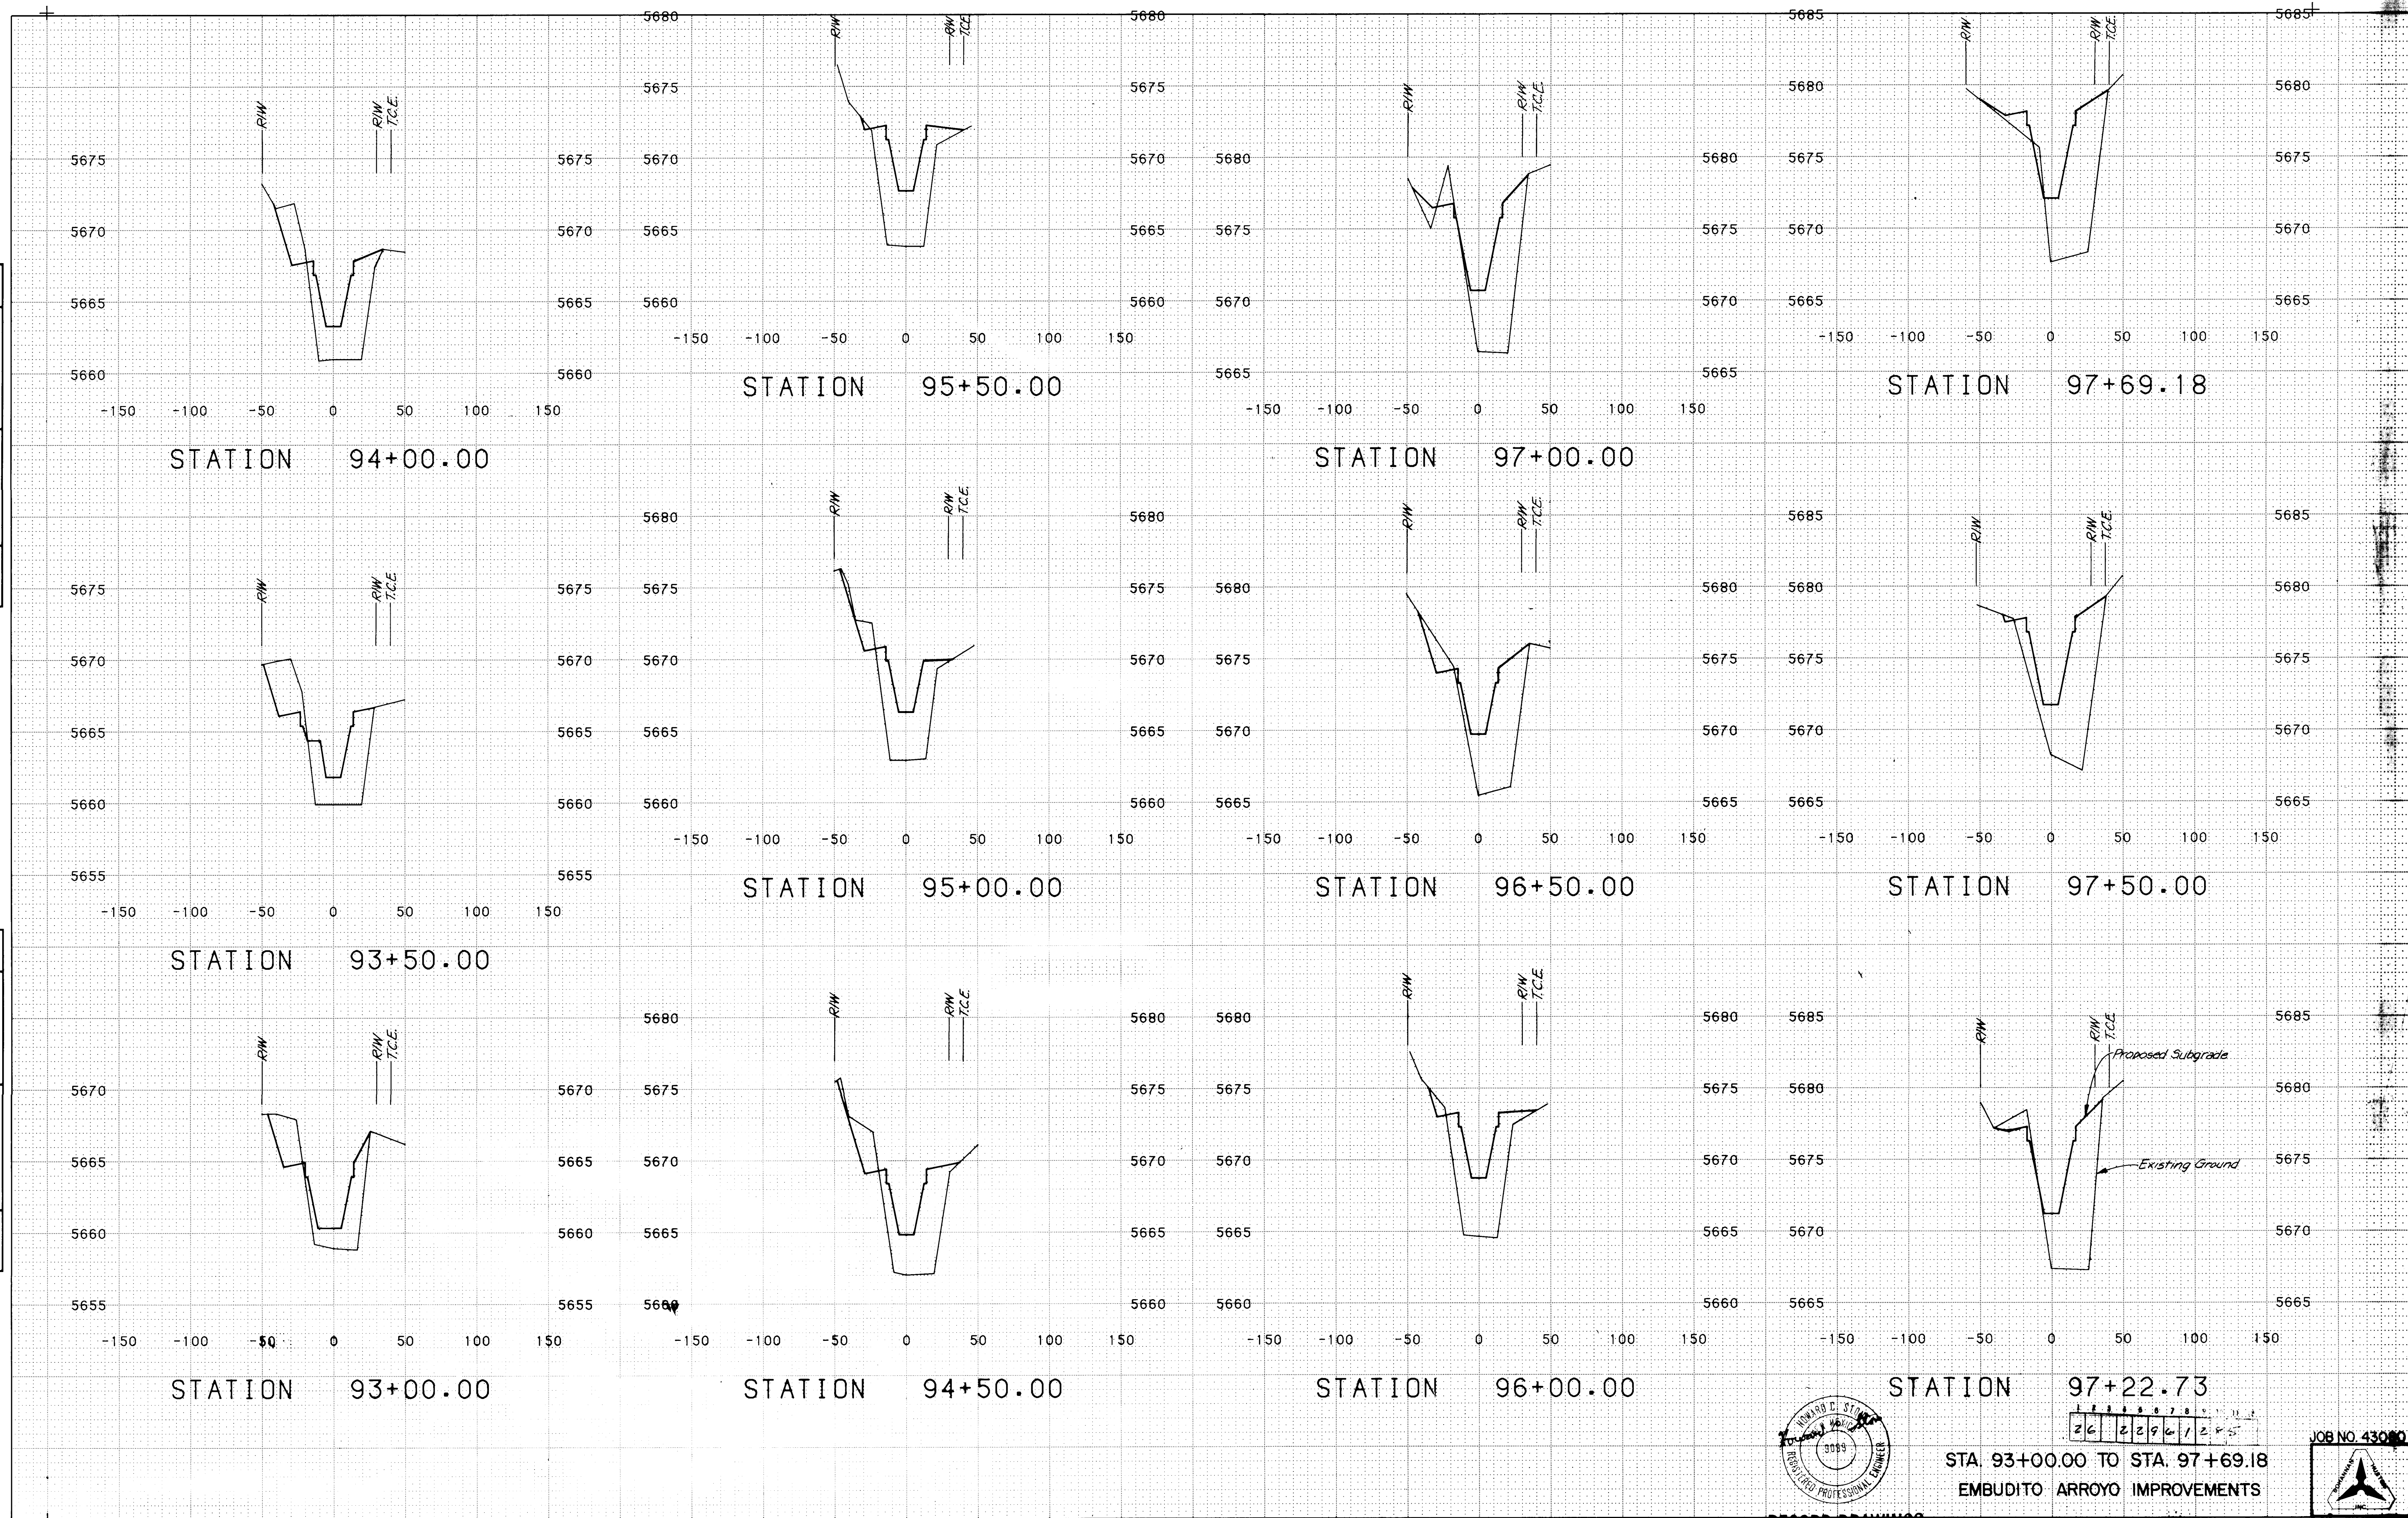


PLATE 3 CROSS SECTION - DOTTED
CHARLES BRUNING COMPANY
MADE IN U.S.A.

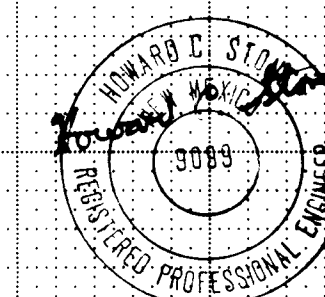


RECORD DRAWINGS

DATE 12/5/85

STA. 93+00.00 TO STA. 97+69.18
EMBUDITO ARROYO IMPROVEMENTS

JOB NO. 43000

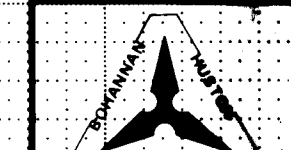

Sheet 12 of 16

DATE	
BY	
FINAL SURVEY	
NO.	
SURVEYED	
PLOTTED	
NOTED	
AREAS CHECKED	

DATE	
BY	
ORIGINAL SURVEY	
NO.	
SURVEYED	
PLOTTED	
NOTED	
AREAS CHECKED	

STATION 98+17.27

STATION 100+33.22

STATION 103+50.00

STATION 98+00.00

STATION 98+39.18

STATION 103+00.00

STATION 97+75.00


STATION 98+25.25

STATION 101+03.22

STATION 102+50.00


STATION 100+50.00

STATION 102+00.00

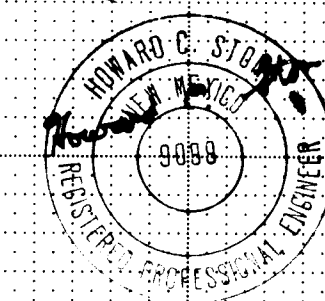

STA. 97+75.00 TO STA. 103+50.00
EMBUDITO ARROYO IMPROVEMENTS

JOB NO. 43080

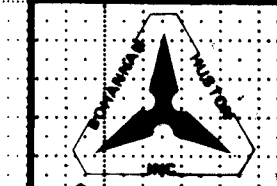

RECORD DRAWINGS

Sheet 13 of 16

12/5/85

PLATE 3 CROSS SECTION - DOTTED
CHARLES BRUNING COMPANY
MADE IN U.S.A.

ORIGINAL	SURVEYED _____ BY _____ DATE _____
SURVEY	PLOTTED _____
NOTE BOOK	TEMPLATE _____
NO.	AREAS _____
	AREAS CHECKED _____

STATION 104+20.00

STATION 105+50.00

STATION 107+00.00

STATION 108+50.00

STATION 104+00.00

STATION 105+00.00

STATION 106+50.00

STATION 108+00.00

STATION 103+50.00

STATION 104+40.00


STATION 106+00.00

STATION 107+50.00



STA. 103+50.00 TO STA. 108+50.00
EMBUDITO ARROYO IMPROVEMENTS

JOB NO. 430

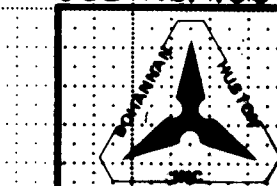

Sheet 14 of 16


RECORD DRAWINGS

DATE 12/5/85


PLATE 3 CROSS SECTION - DOTTED
CHARLES BRUNING COMPANY
MADE IN U.S.A.

FINAL	DATE
SURVEY	BY
NO. _____	
PLOTTED	
TEMPLATE	
AREAS CHECKED	


ORIGINAL	DATE
SURVEY	BY
NO. _____	
PLOTTED	
TEMPLATE	
AREAS CHECKED	

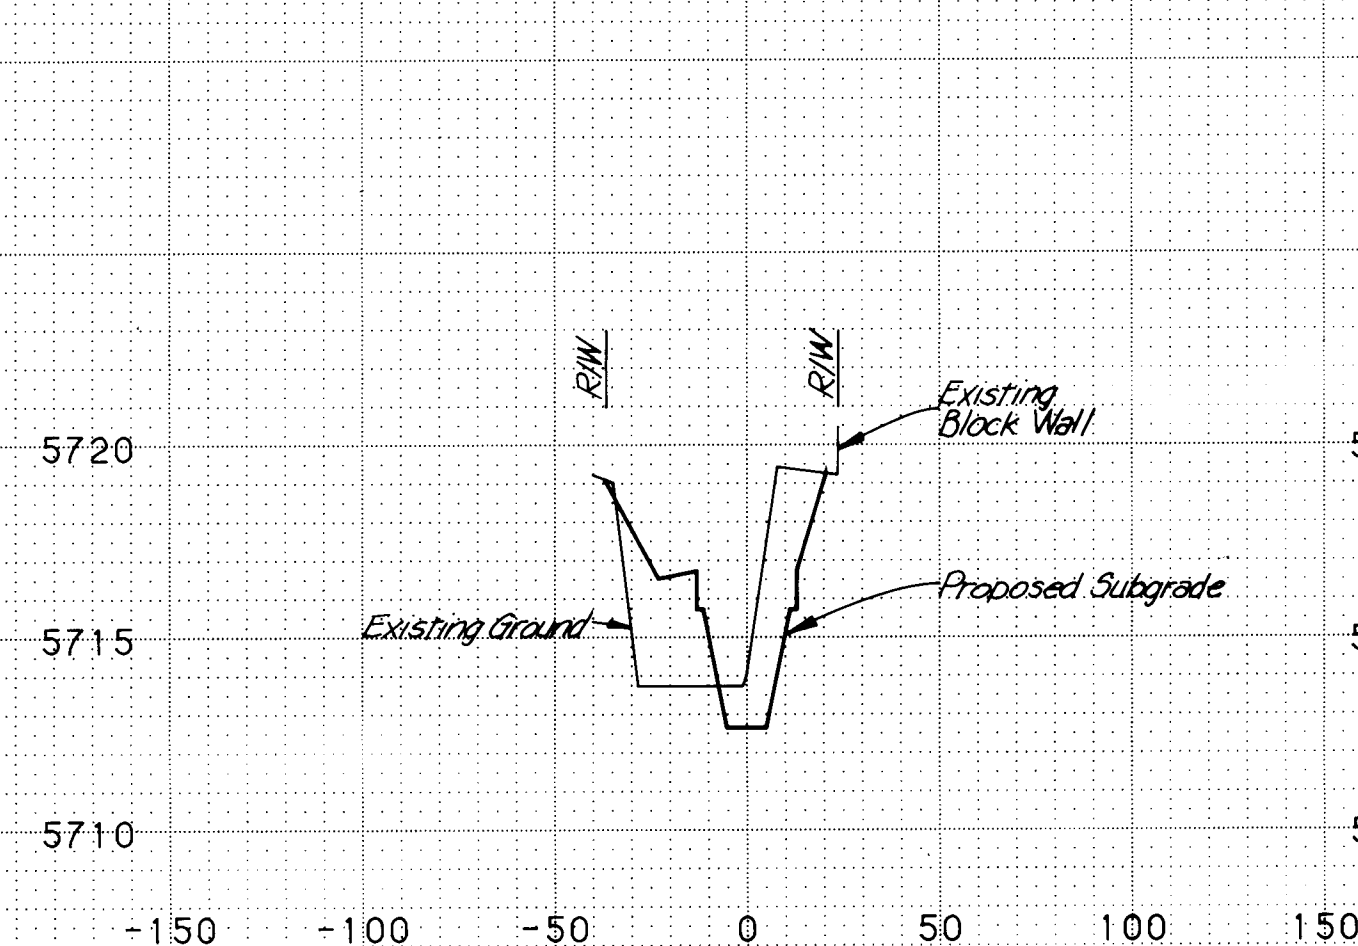


STATION 110+00.00

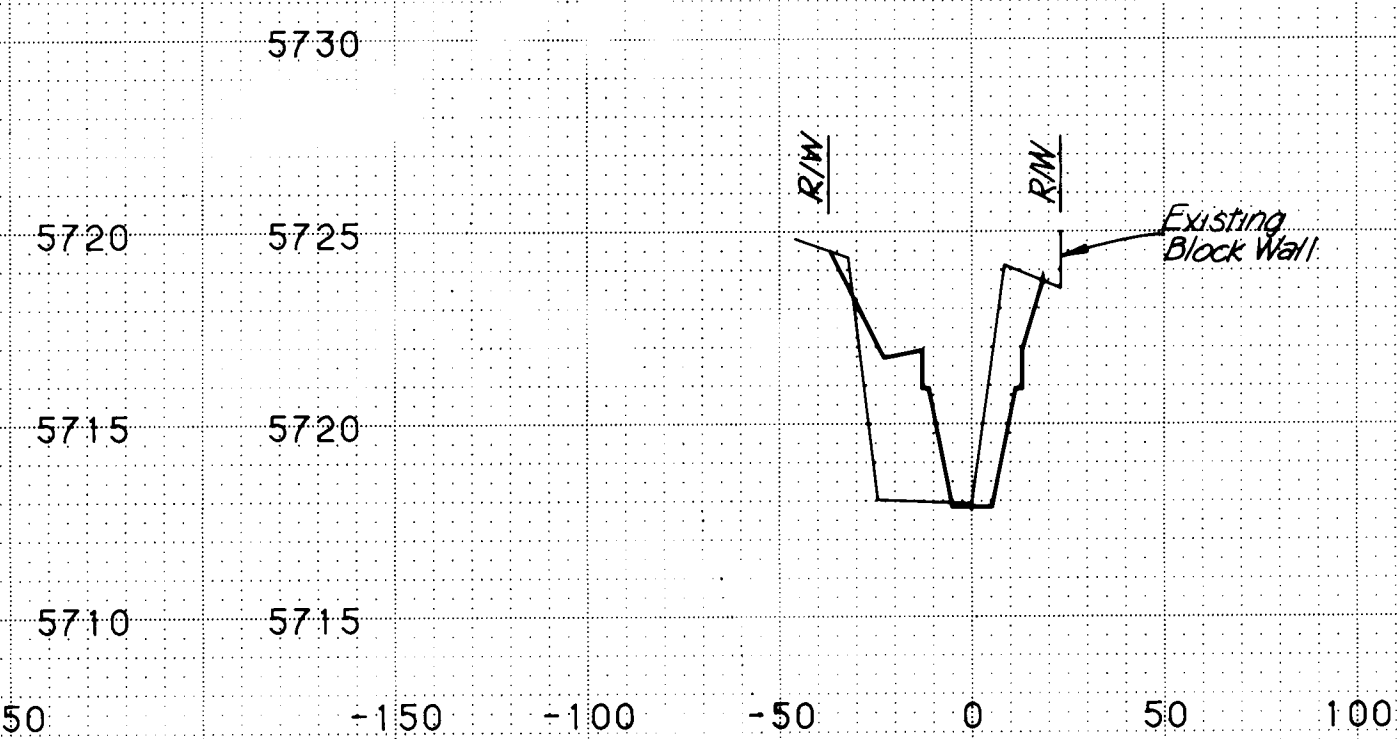


STATION 111+50.00

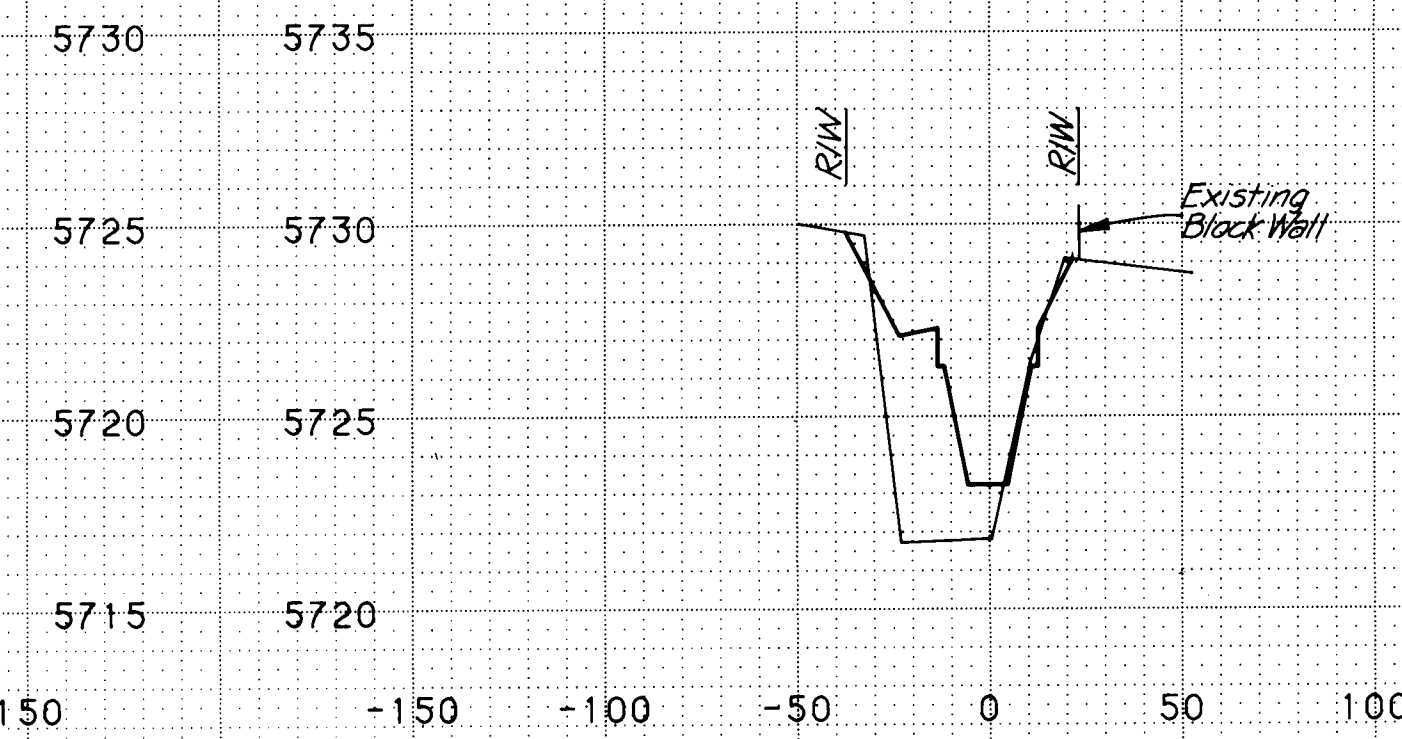

STATION 113+00.00

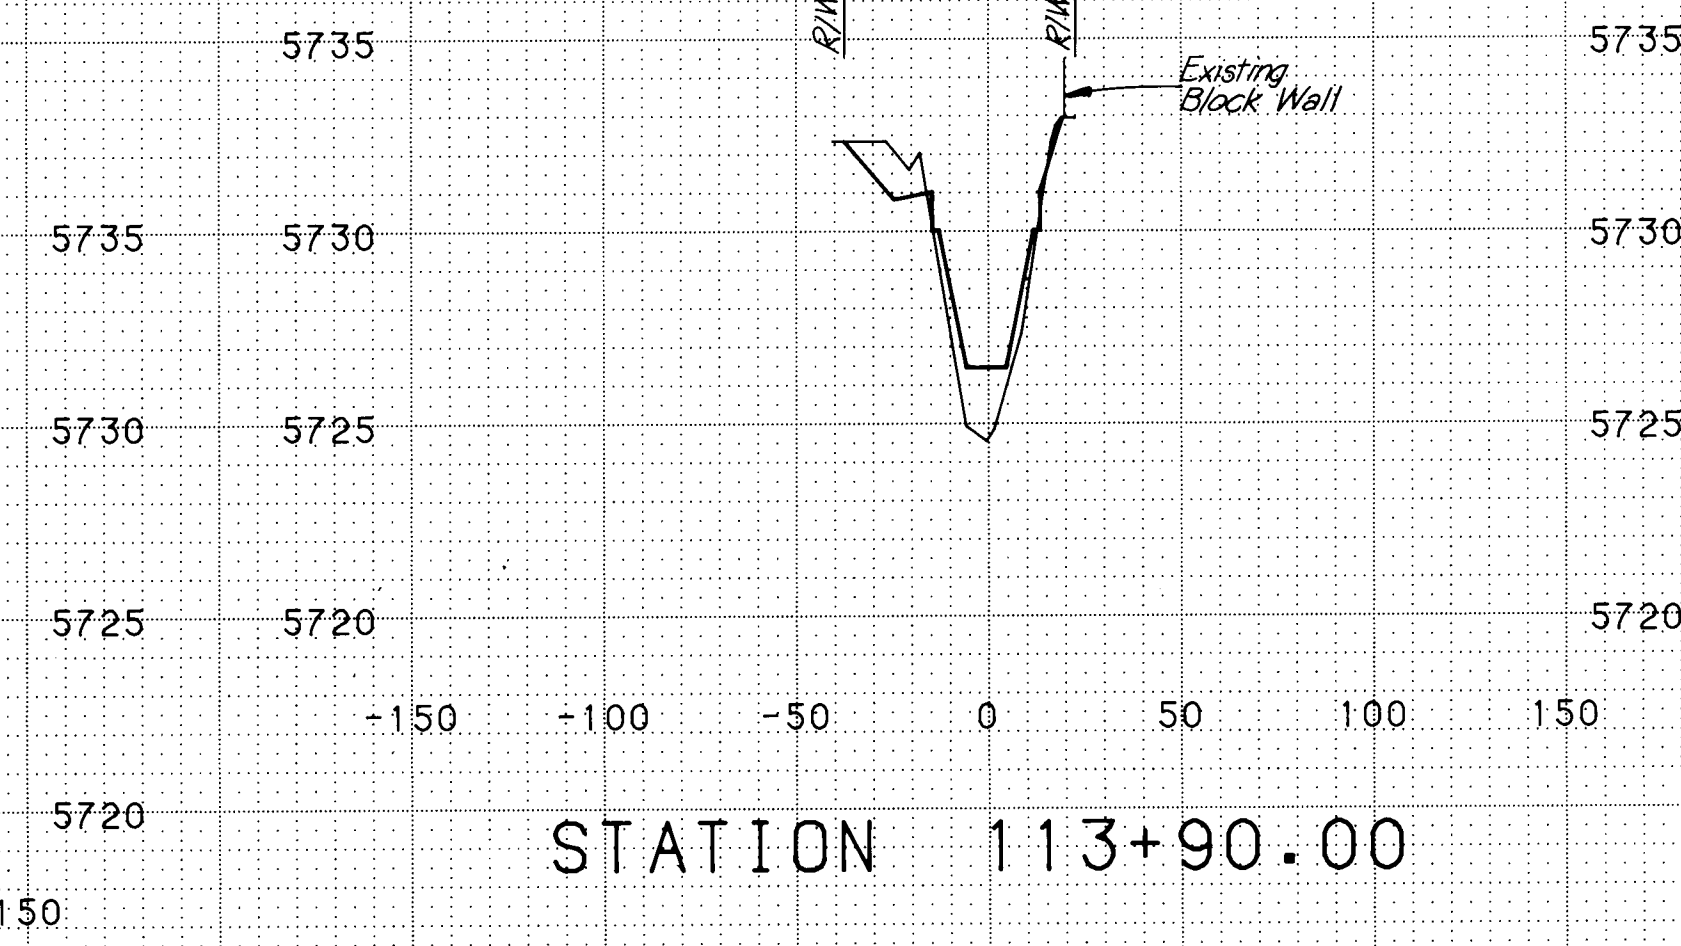

STATION 113+90.00

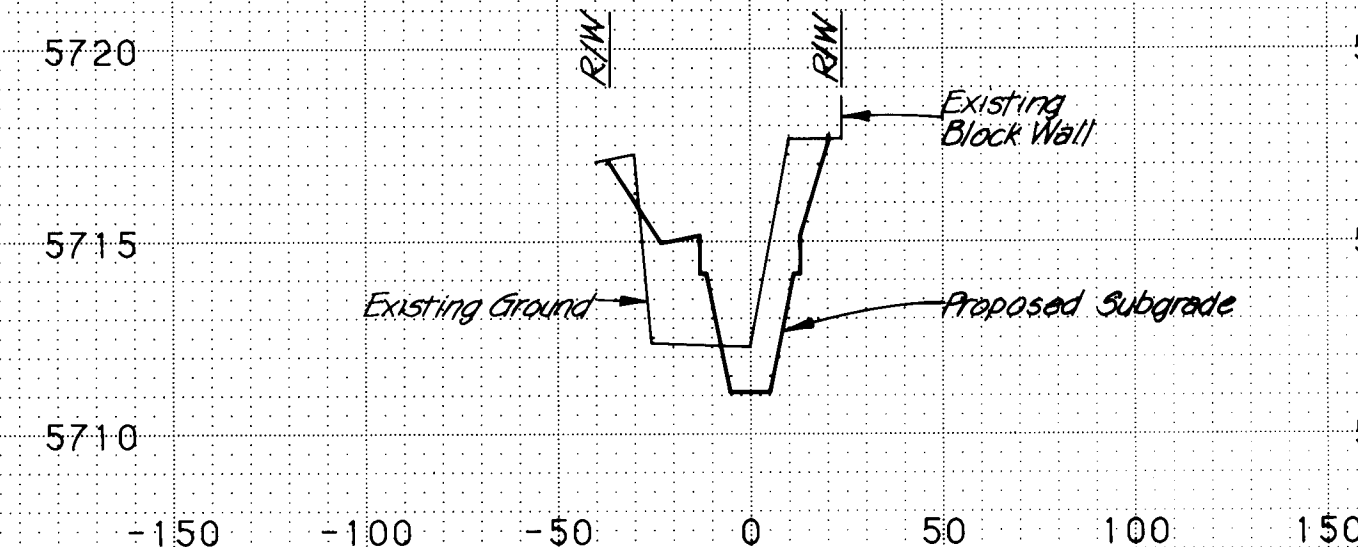

STATION 109+50.00




STATION 111+00.00




STATION 112+50.00




STATION 113+70.00

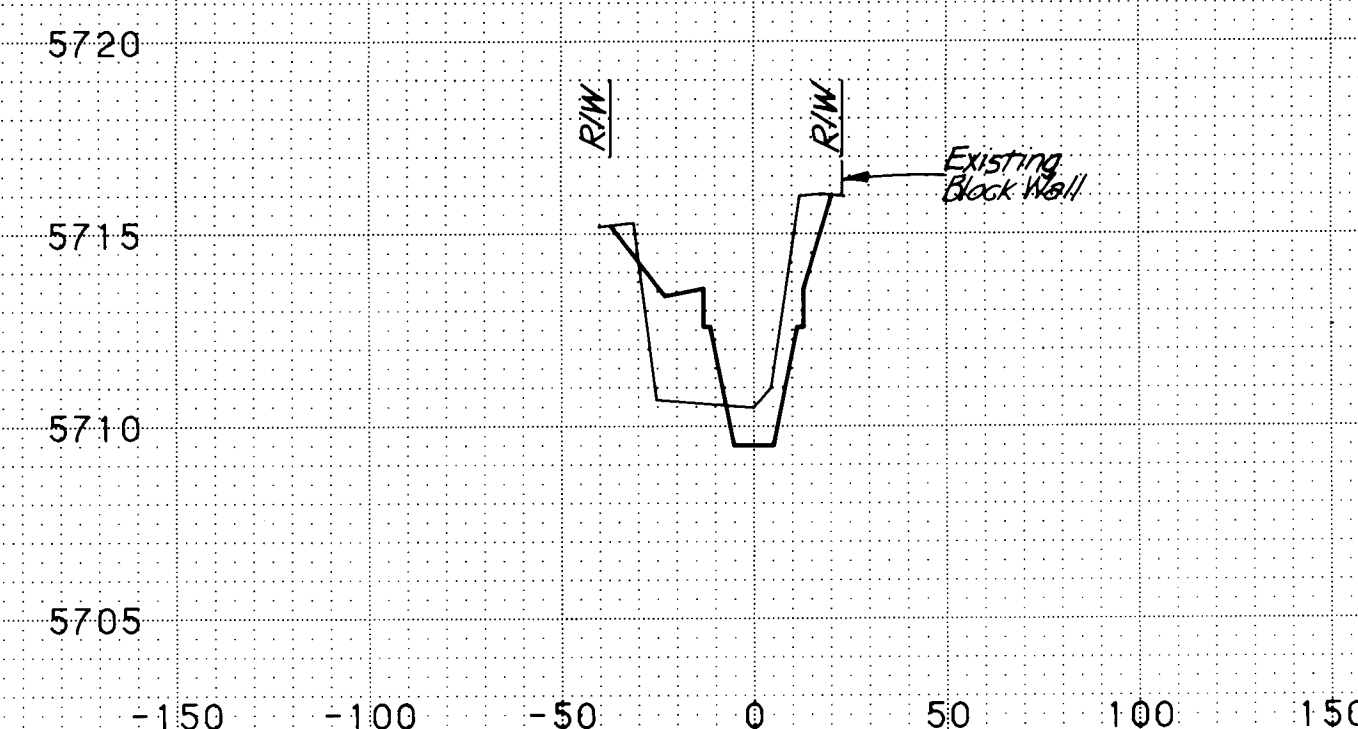


STATION 109+00.00

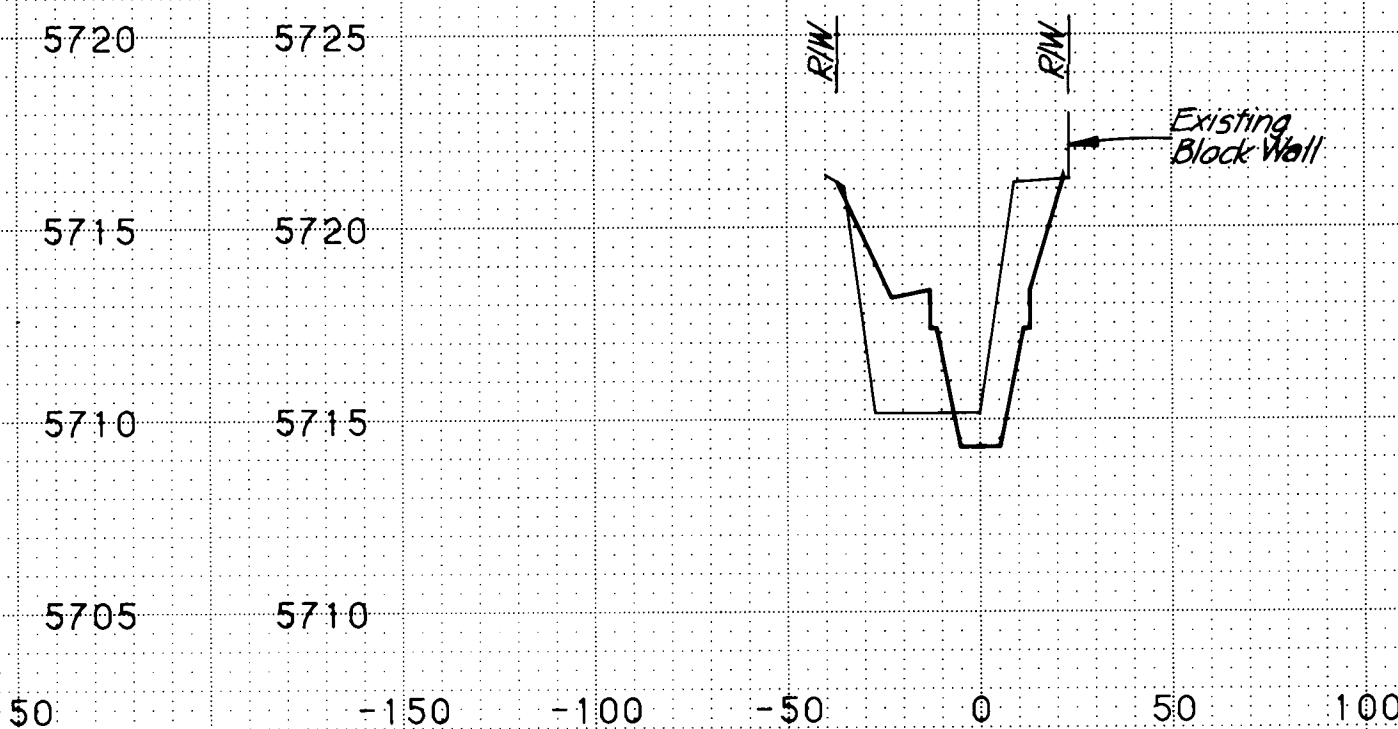


STATION 110+50.00

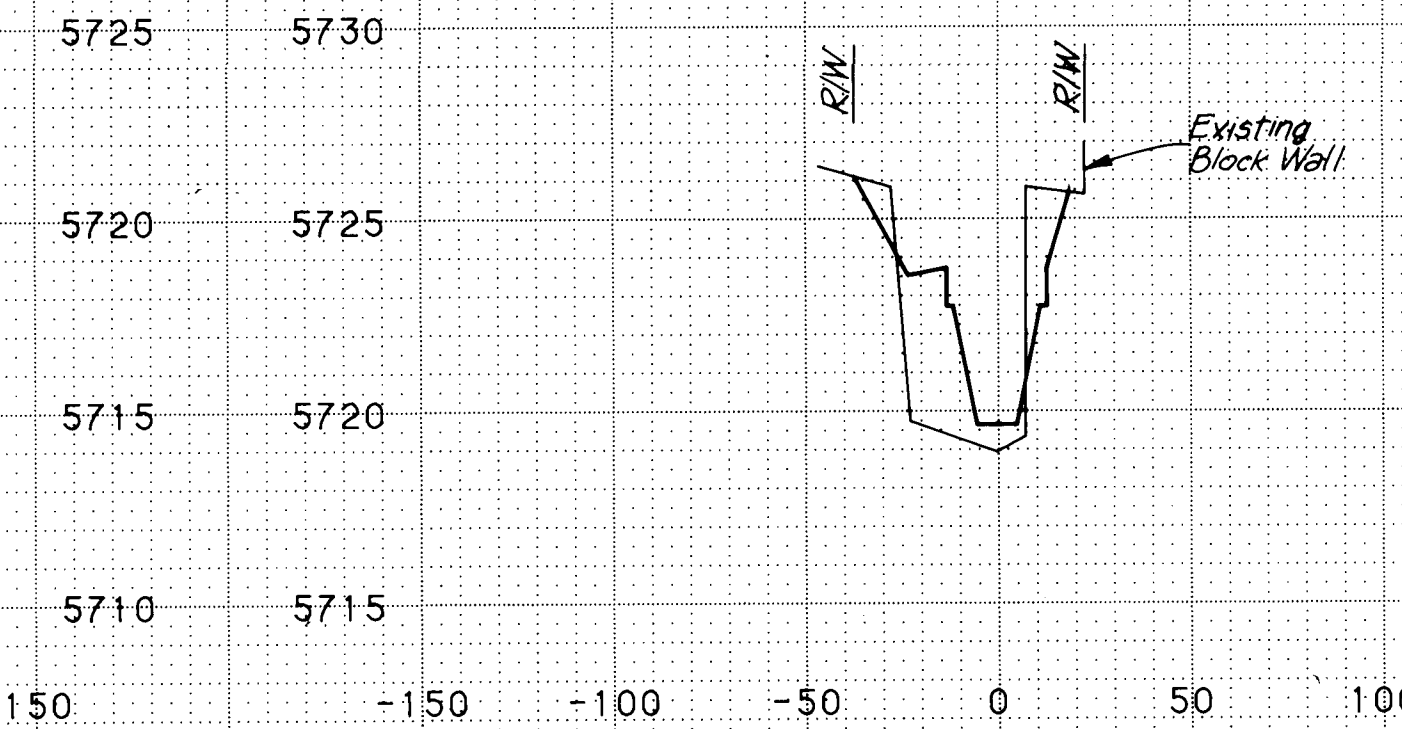

STATION 112+00.00

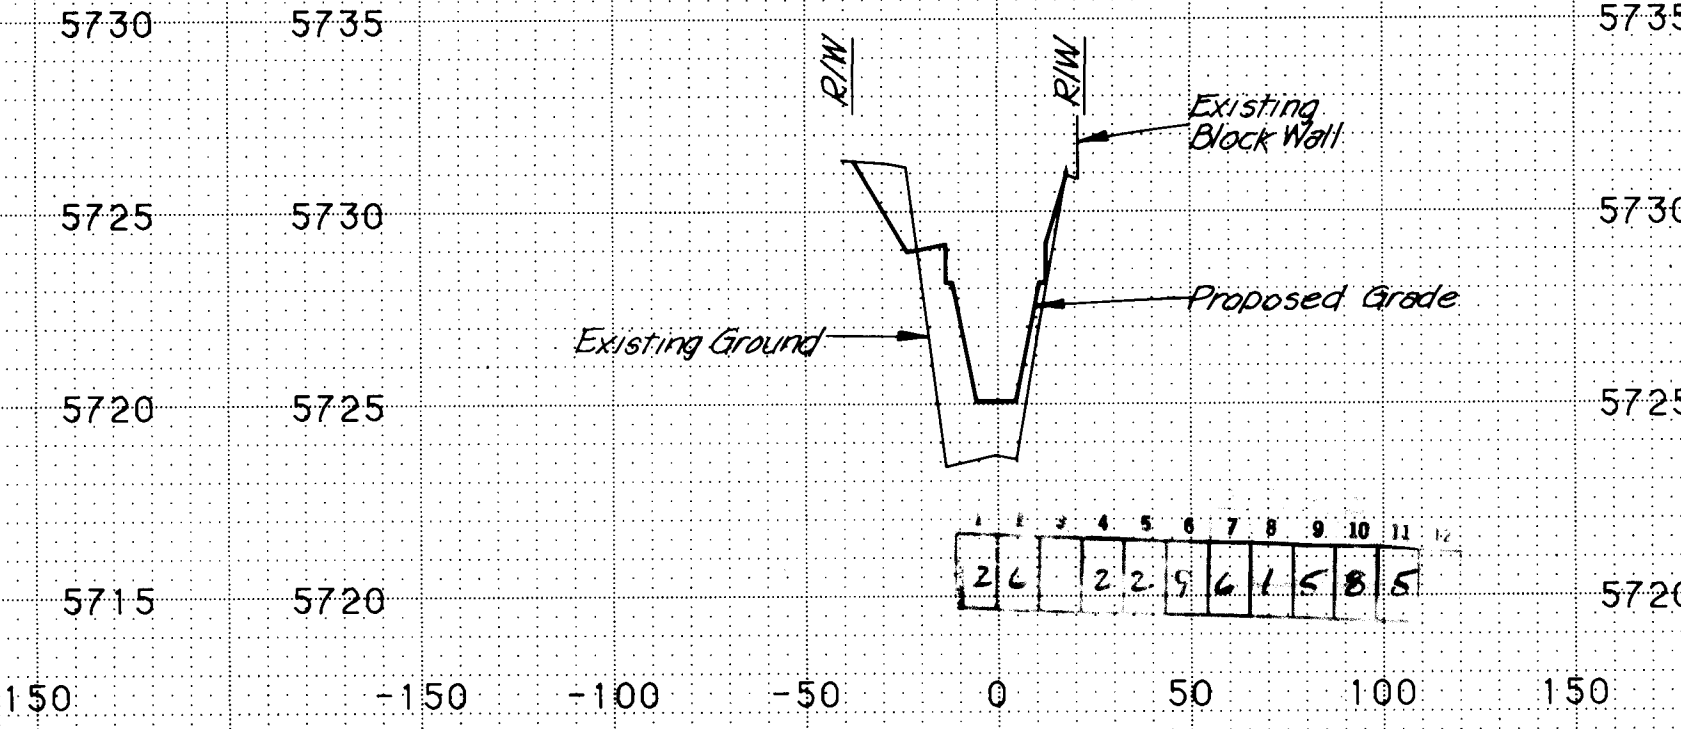


STATION 113+50.00

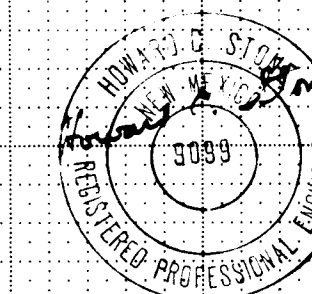

STA. 109+00.00 TO STA. 113+90.00
EMBUDITO ARROYO IMPROVEMENTS









JOB NO. 43080

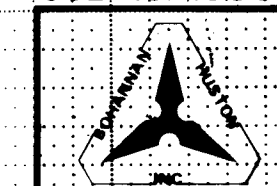

RECORD DRAWINGS
12/5/95


FINAL	DATE
SURVEY	BY
NO. BOOK	
PLOTTED	
REVISIONS	
AREAS CHECKED	

ORIGINAL	DATE
SURVEY	BY
NO. BOOK	
PLOTTED	
REVISIONS	
AREAS CHECKED	

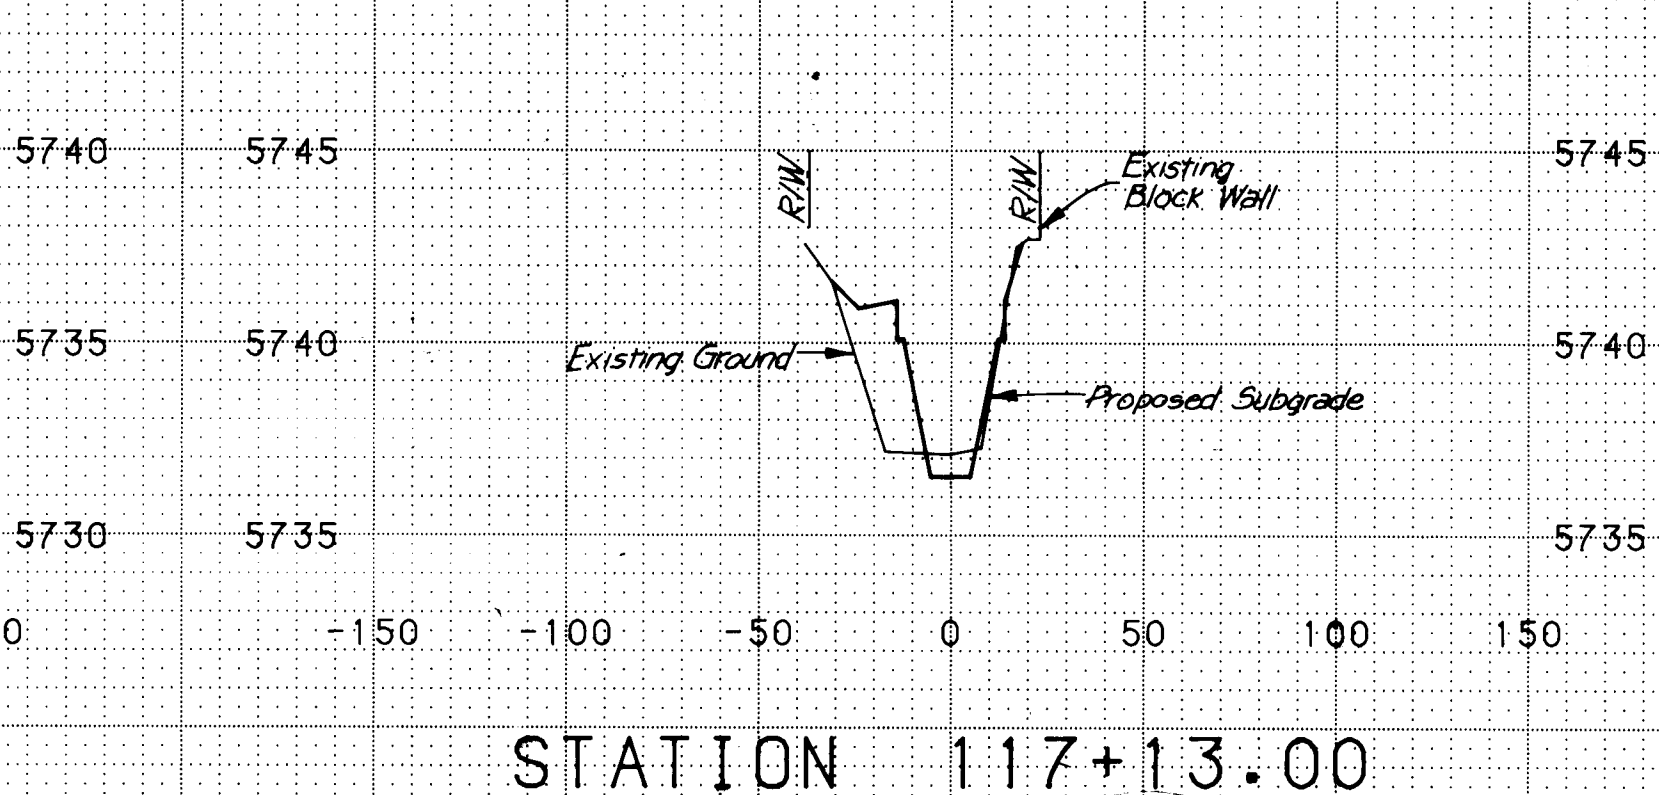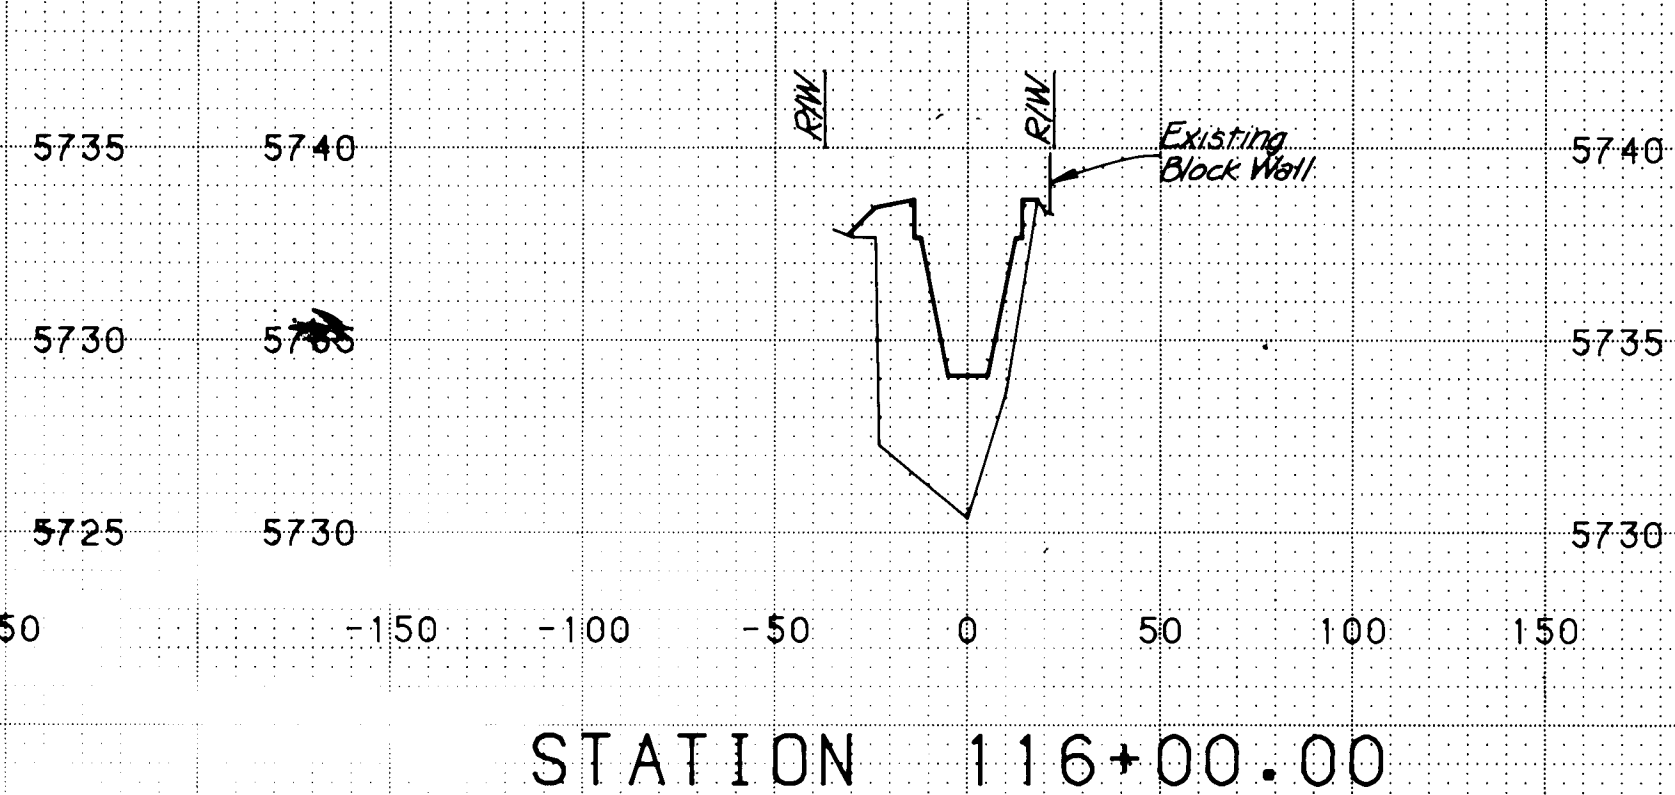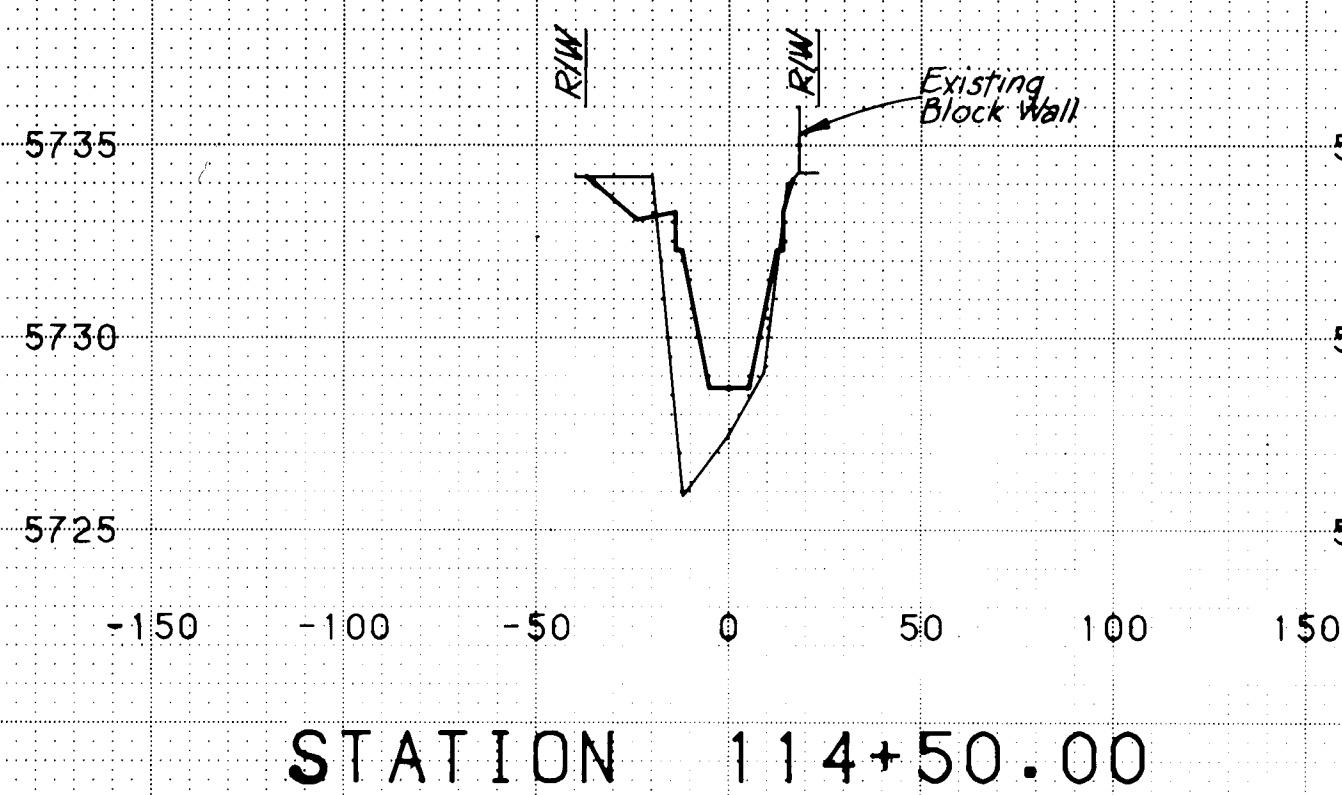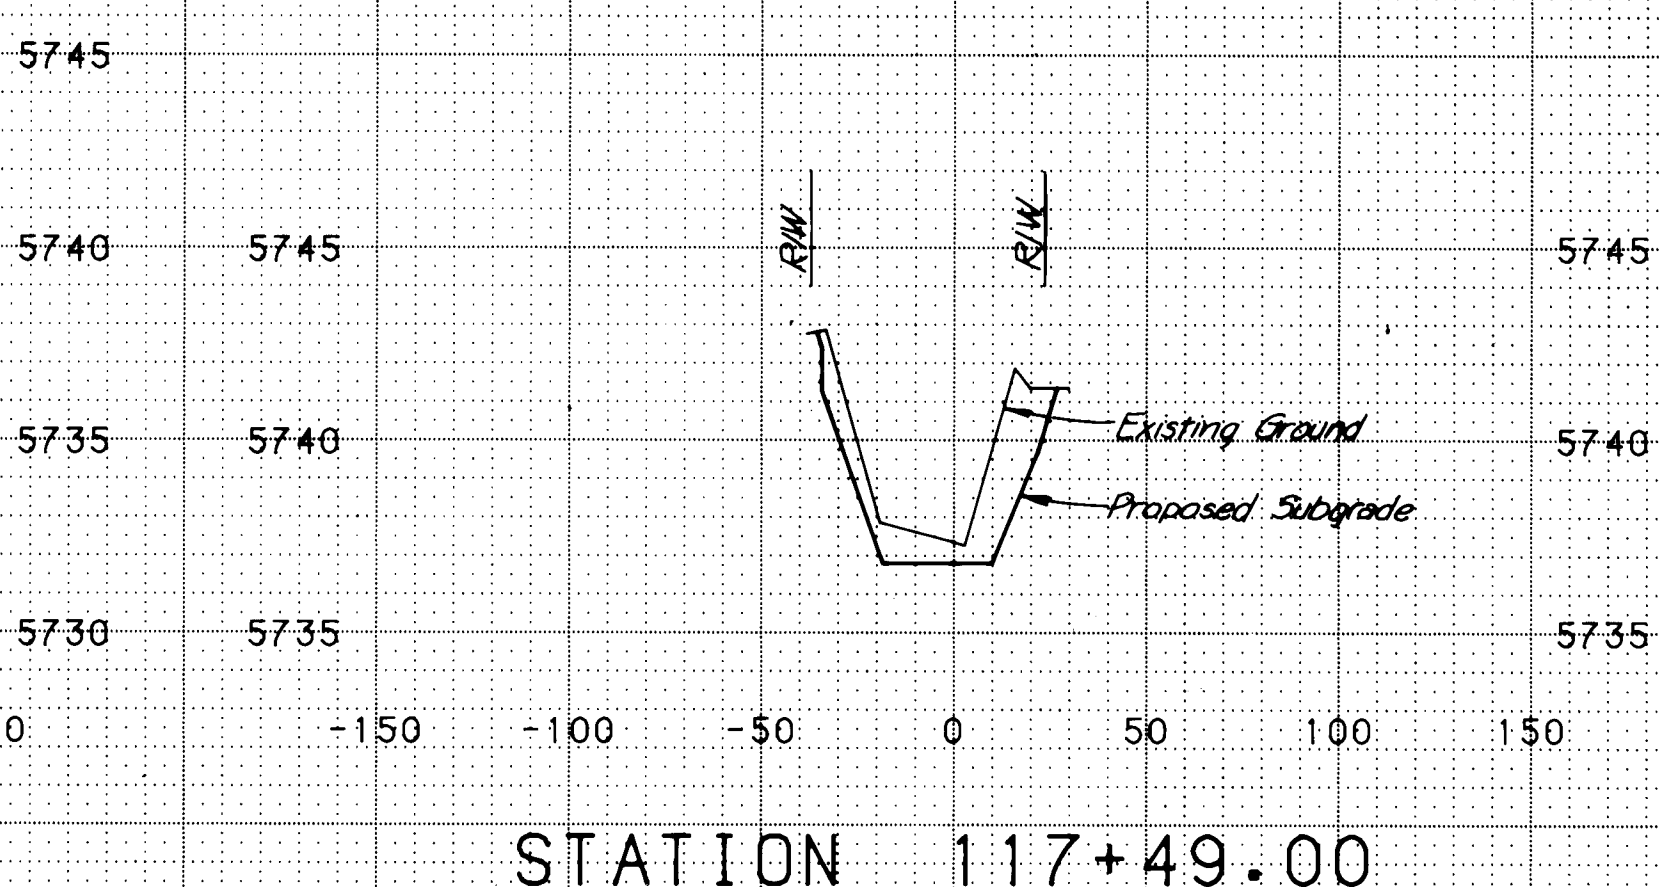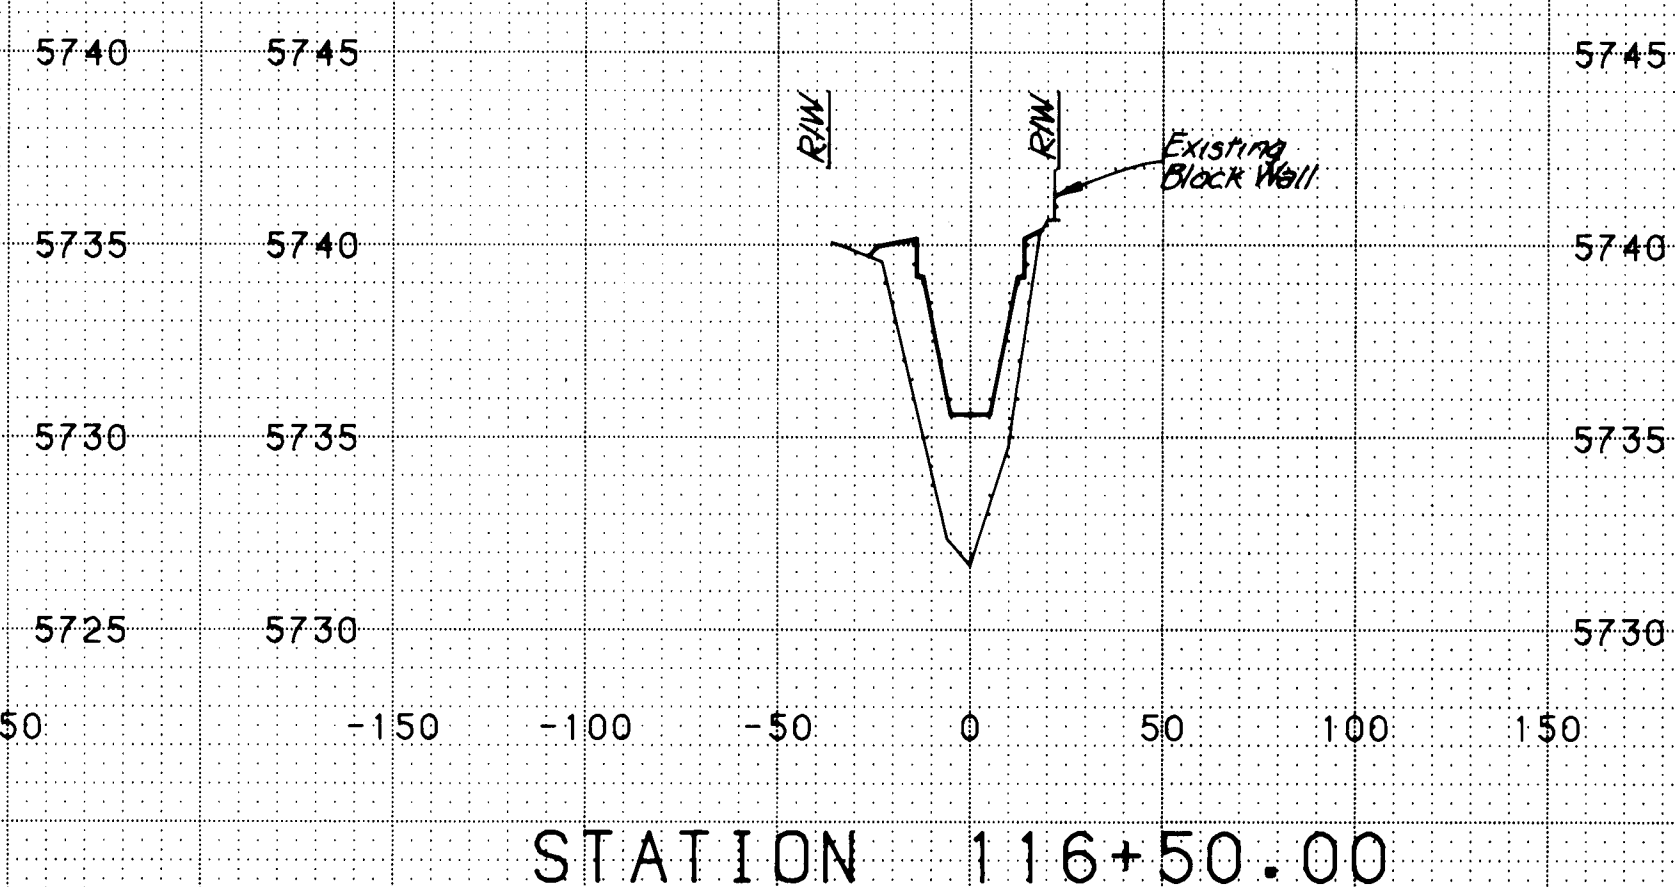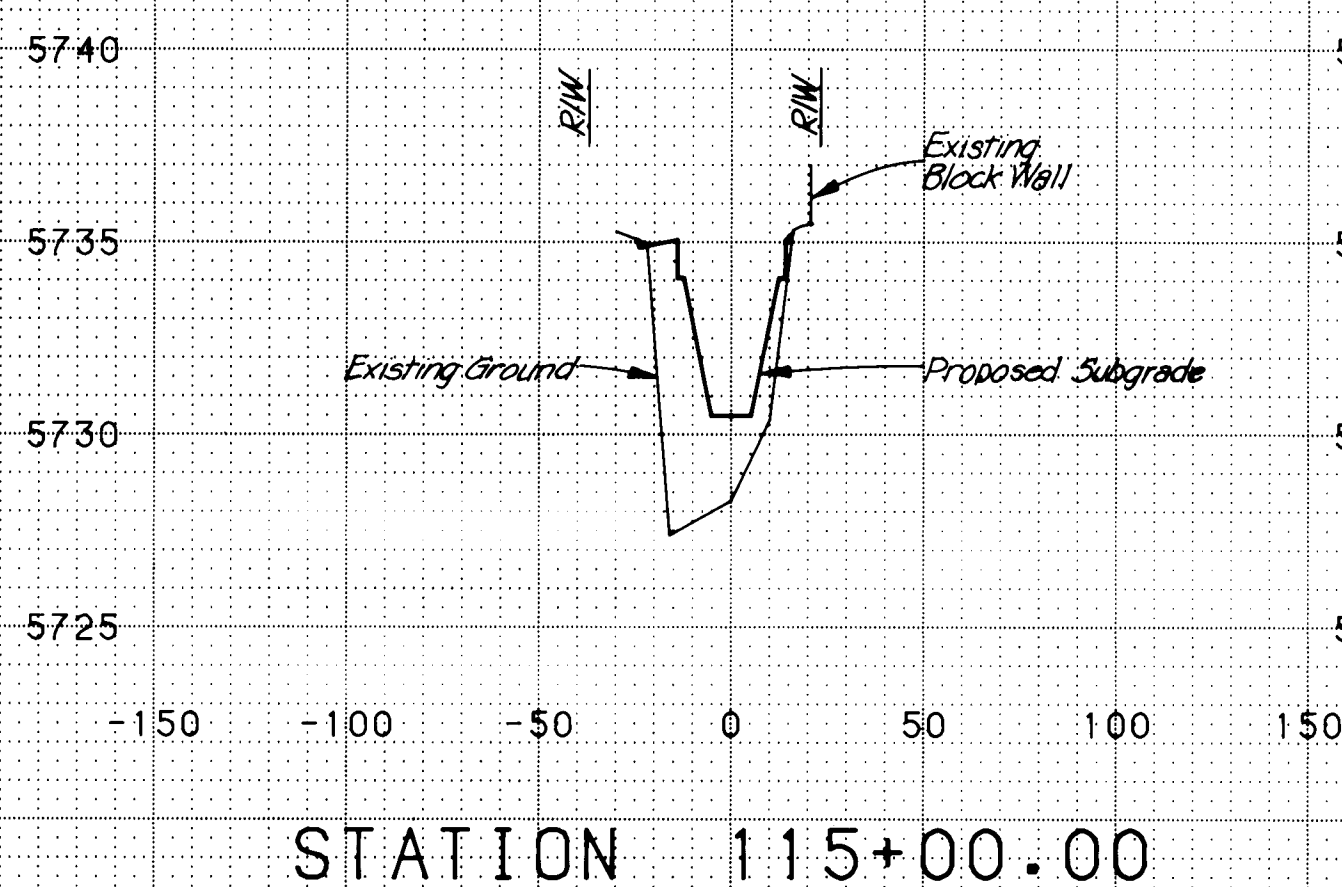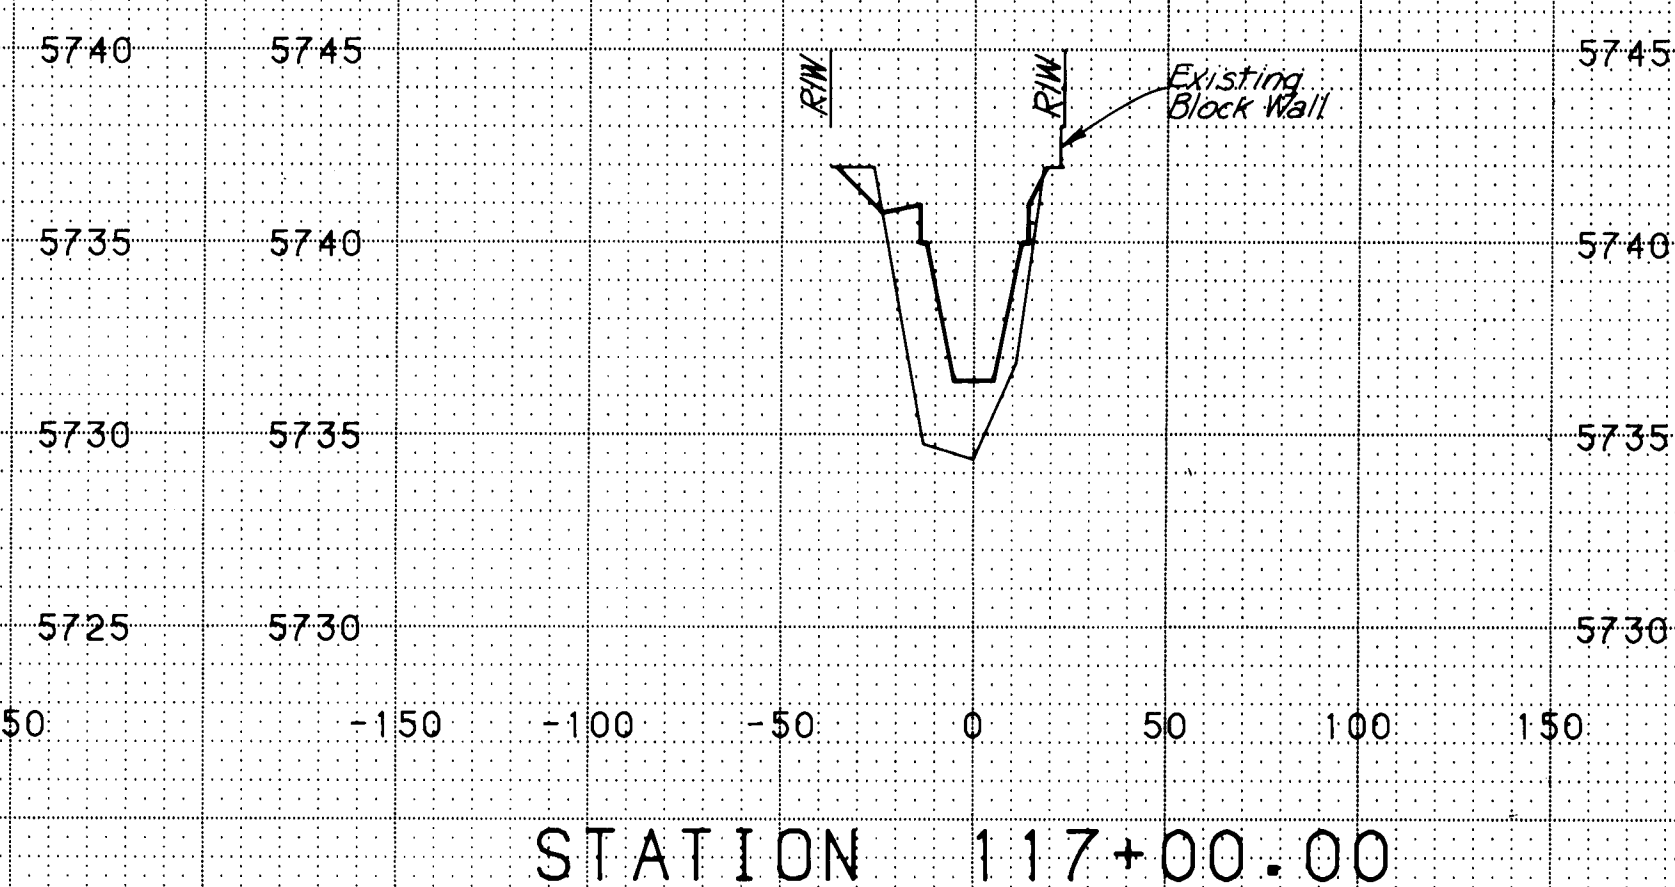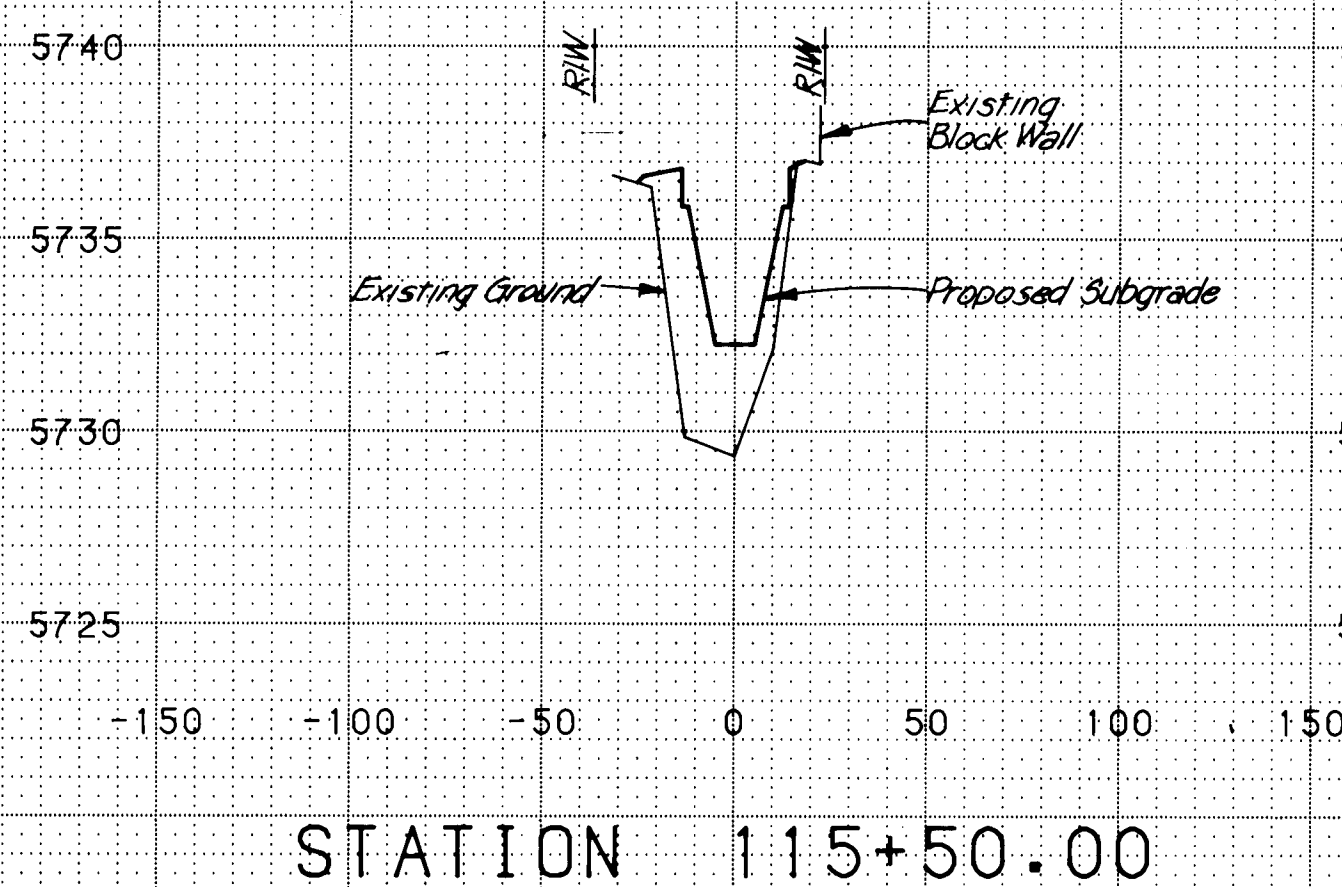

1	2	3	4	5	6	7	8	9	10	11	12
2	6	2	2	5	1	1	6	5			

RECORD DRAWINGS
DATE 12/5/15

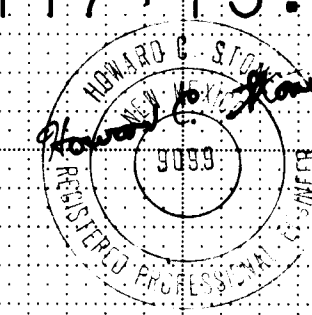

STA. 114+50.00 TO STA. 117+49.00
EMBUDITO ARROYO IMPROVEMENTS

