

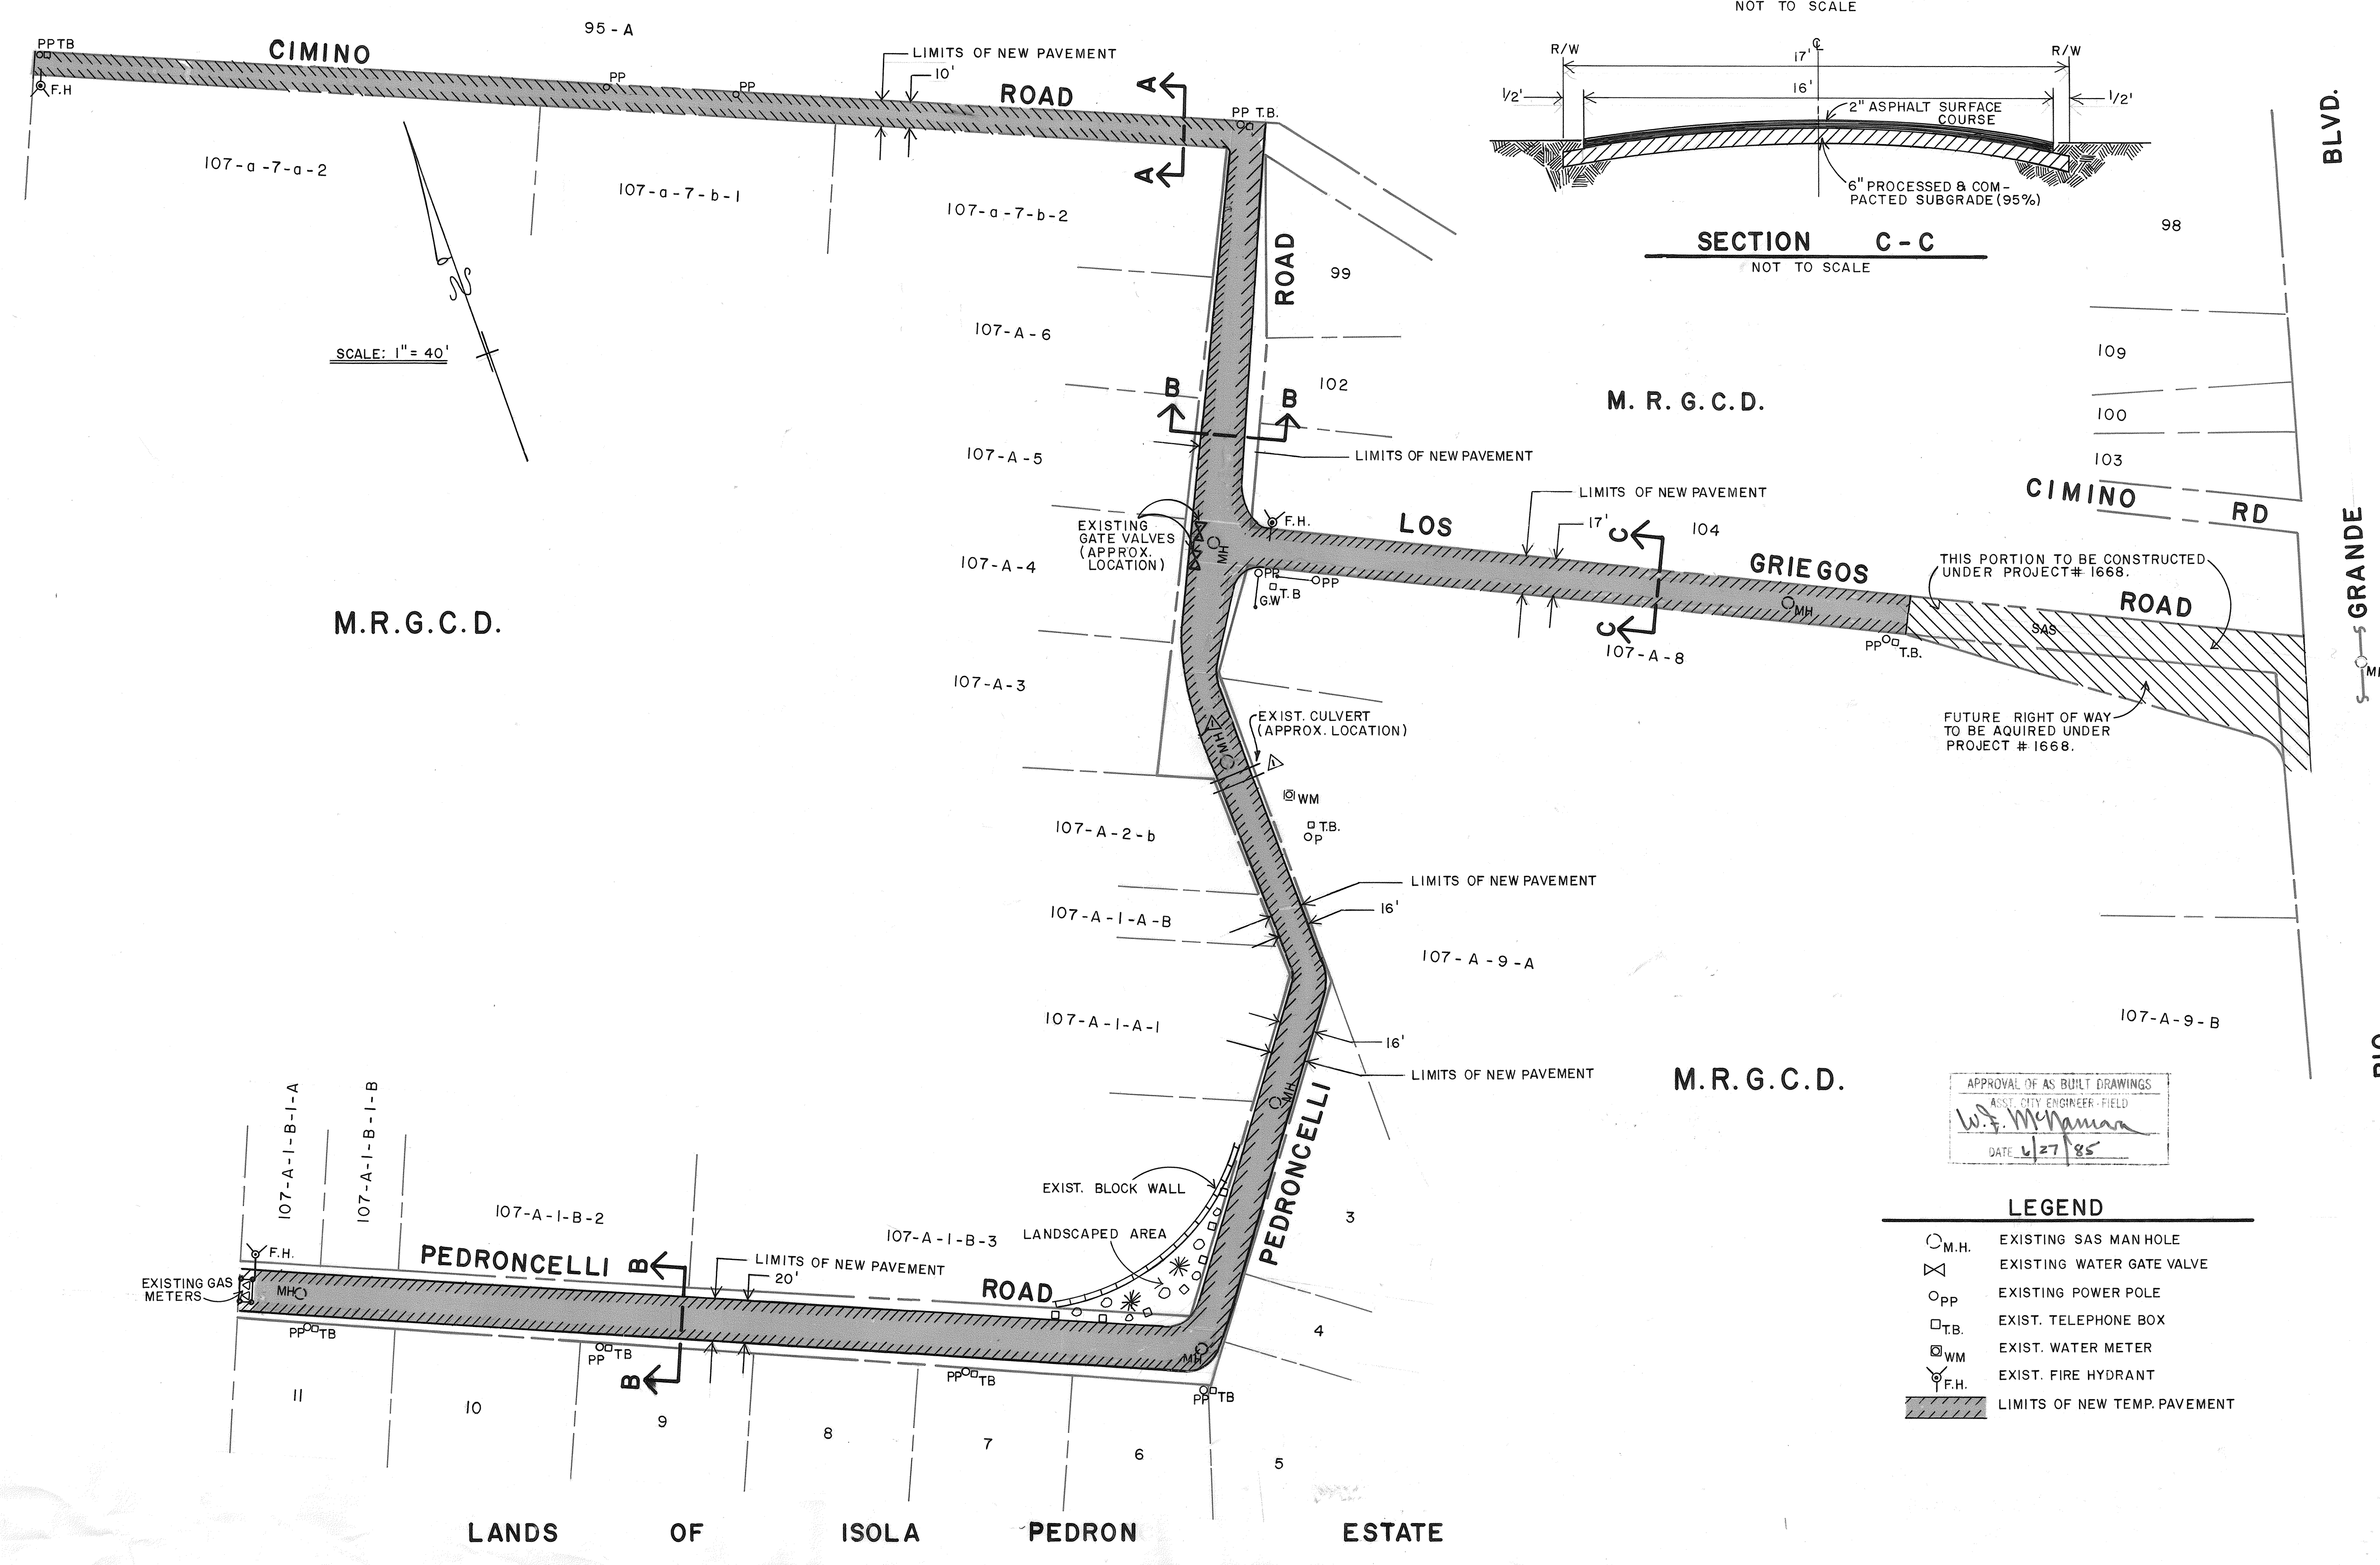
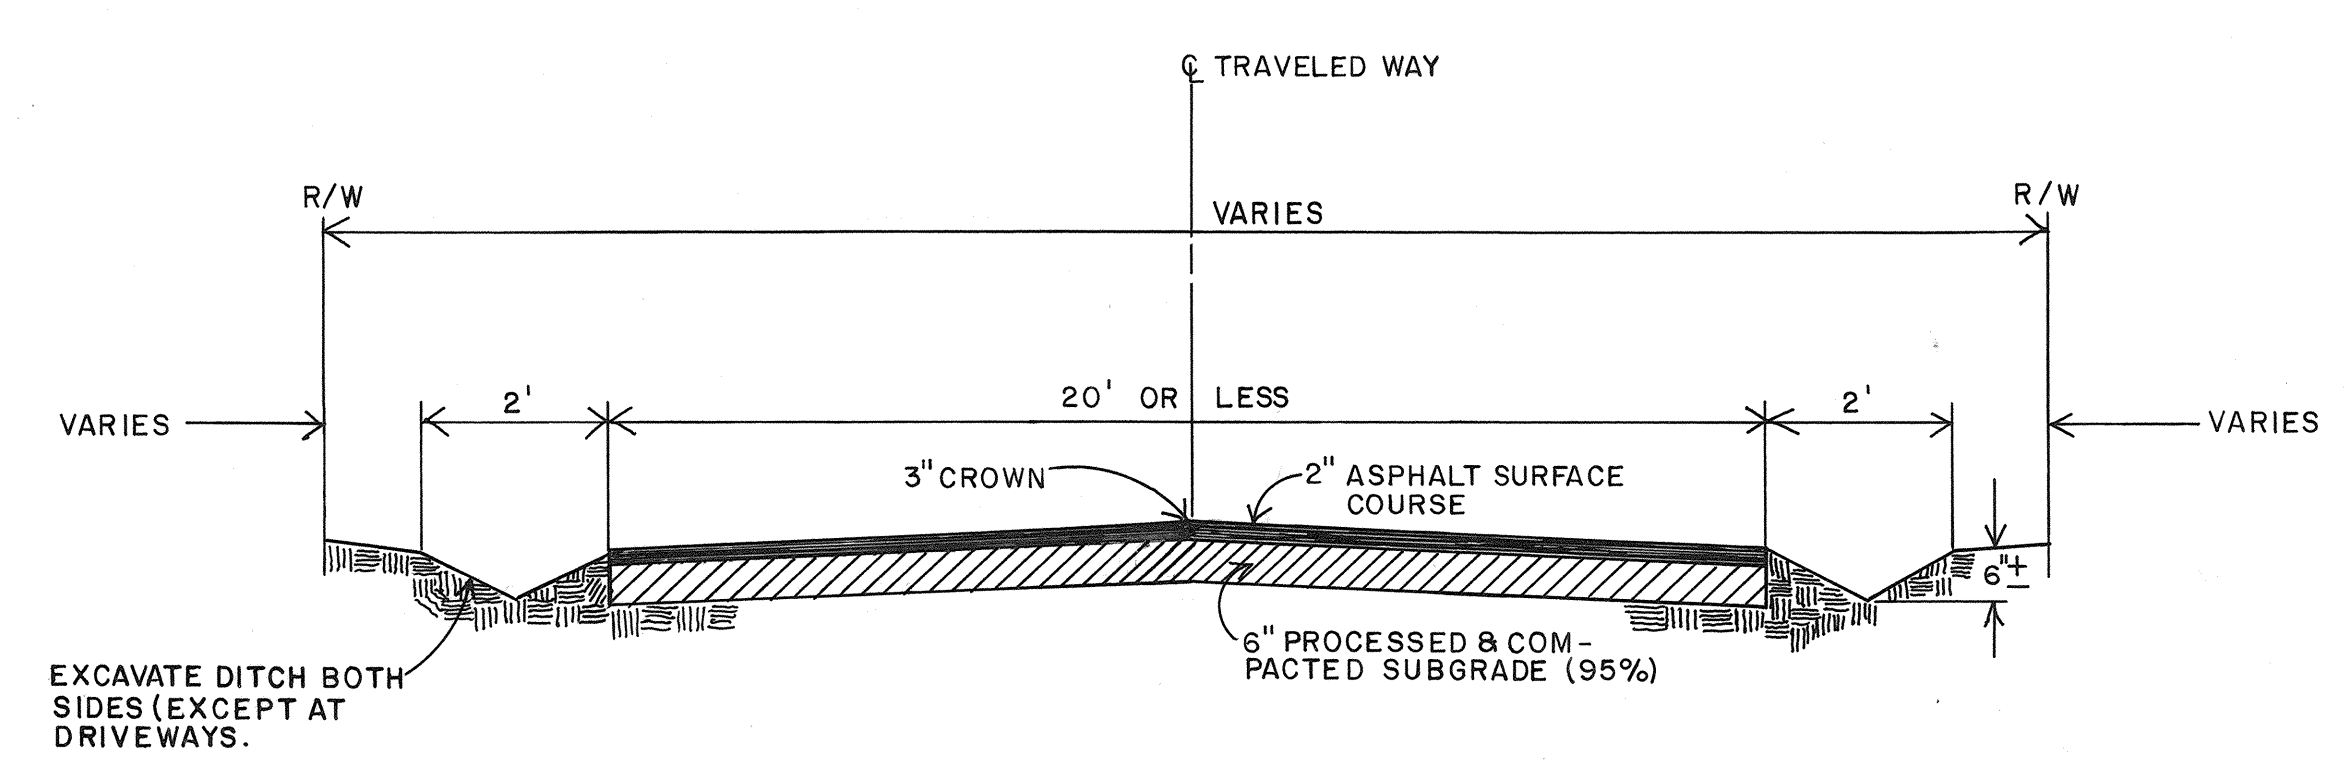


SCANNED BY LKSON

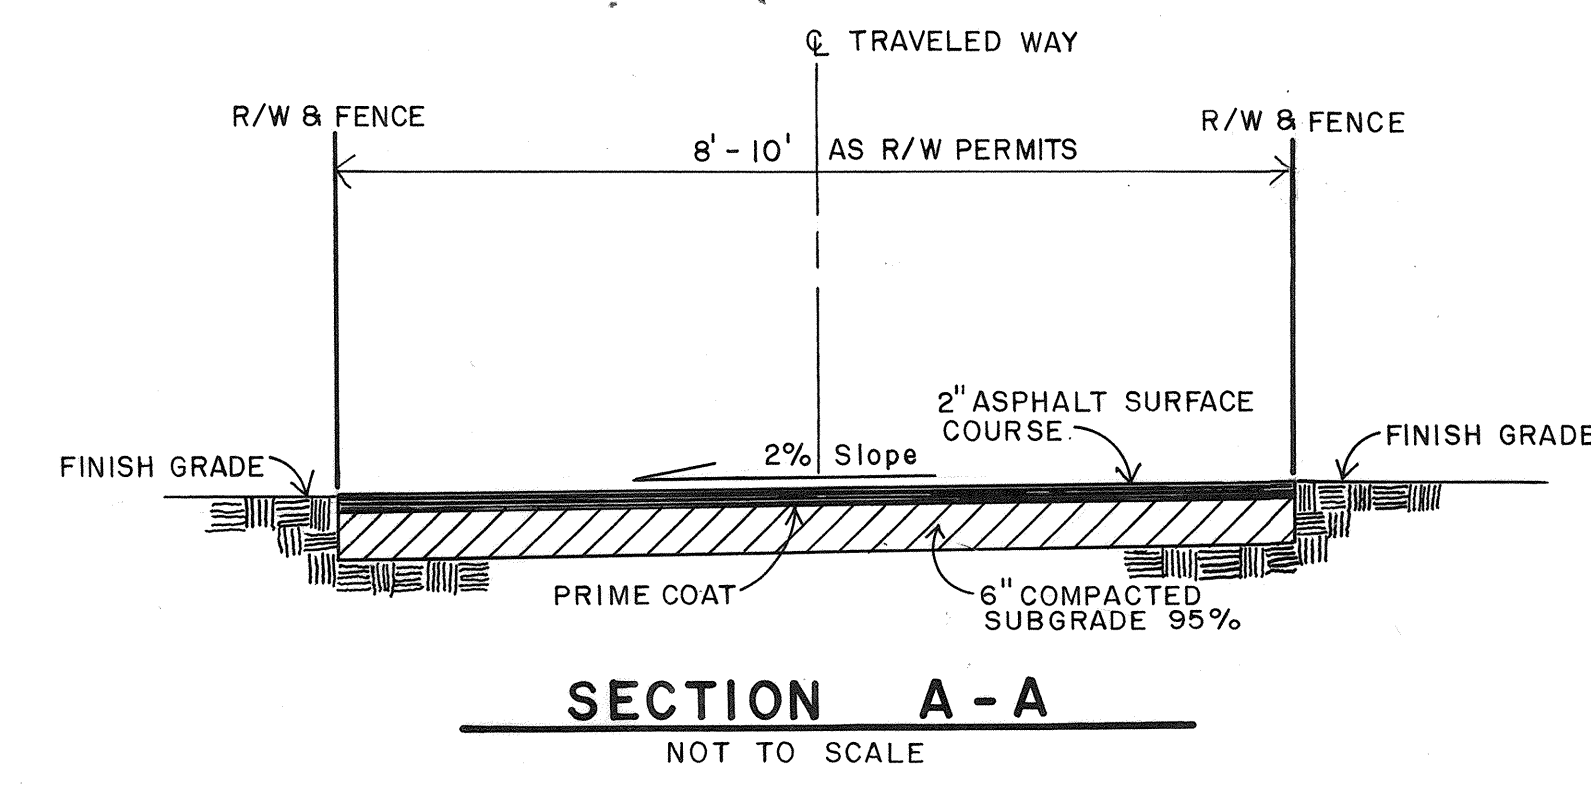

APPROVAL OF AS-BUILT DRAWINGS
W.F. McManis
DATE 4/27/85

- LEGEND**
- M.H. EXISTING SAS MAN HOLE
 - W.G.V. EXISTING WATER GATE VALVE
 - PP EXISTING POWER POLE
 - T.B. EXIST. TELEPHONE BOX
 - WM EXIST. WATER METER
 - F.H. EXIST. FIRE HYDRANT
 - [Hatched Area] LIMITS OF NEW TEMP. PAVEMENT

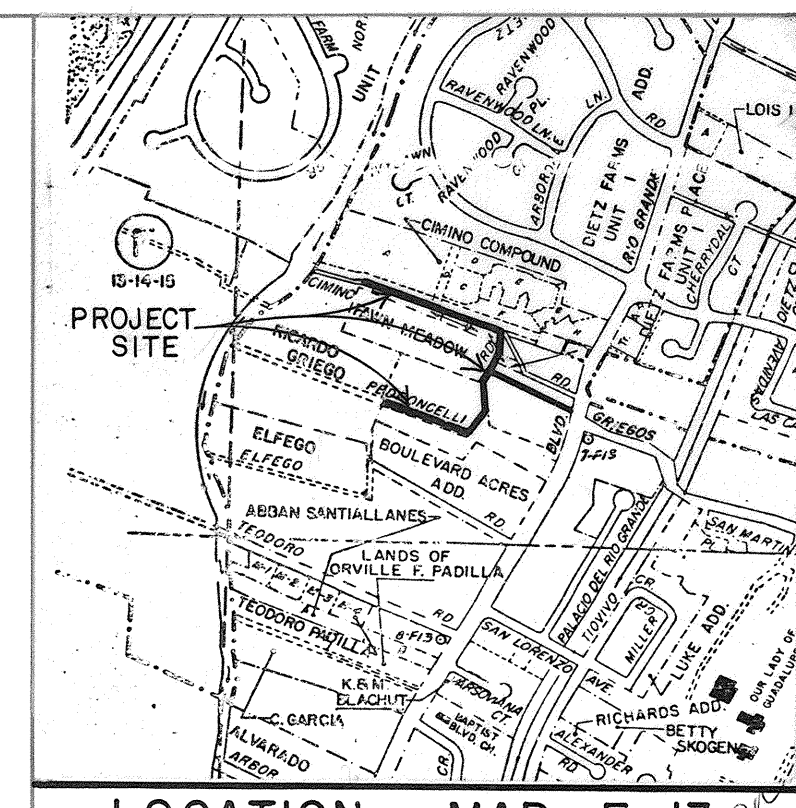

NOTICE TO CONTRACTORS

1. All work detailed on these plans to be performed under contract shall, except as otherwise stated or provided for herein, be constructed in accordance with the New Mexico Standard Specifications for Public Works Construction-1979 Edition (referred to herein as the Standard Specifications) and the Contract Documents for Public Works Contract 85-1.

2. Two (2) working days prior to any excavation, the contractor must contact Line Locating Service, 765-1234, for location of existing utilities.

3. Prior to construction, the contractor shall excavate and verify the horizontal and vertical locations of all obstructions. Should a conflict exist, the contractor shall notify the engineer or surveyor so that the conflict can be resolved with minimum amount of delay.

THE FOLLOWING NOTES ALSO APPLY WHEN CHECKED

- ☐ All utilities and utility service lines shall be installed prior to paving.
- ☒ Backfill compaction shall be according to specified street use.
- ☒ Tack coat requirements shall be determined by the City Engineer.
- ☐ Sidewalks and wheelchair ramps within the curb returns shall be constructed wherever a new curb return is constructed.
- ☐ If curb is depressed for a driveway or a handicap ramp, the driveway or ramp shall be constructed prior to acceptance of the curb and gutter.
- ☐ All storm drainage facilities shall be completed prior to final acceptance.

CONSTRUCTION NOTES

(A) LOCATION OF MH's AND GV's ON PLAN ARE APPROXIMATE. CONTRACTOR SHALL LOCATE AND ADJUST MH's & VALVE BOXES PRIOR TO PLACEMENT OF ASPHALT.

(B) THE CITY OF ALBUQUERQUE SURVEY CREW WILL ESTABLISH LINE AND GRADES FOR STREET CONSTRUCTION.

(C) EXISTING SUBGRADE MATERIAL IS TO BE COMPACTED AND USED UNDER NEW PAVEMENT, TO 95% OF LAB DENSITY AS PER ASTM D-1557.

REVISIONS			
NO.	DATE	REMARKS	BY
1	6-21-85	AS-BUILT	W.F. McManis

CITY OF ALBUQUERQUE MUNICIPAL DEVELOPMENT DEPARTMENT ENGINEERING DIVISION			
TITLE: TEMPORARY PAVING FOR PEDRONCELLI RD., CIMINO RD. AND LOS GRIEGOS RD.			
APPROVALS	ENGINEER	DATE	APPROVALS
City Engineer	William B. Bales	1/31/85	Liquid Waste
A.C.E. - Design	William B. Bales	1/30/85	Traffic
Hydrology	William B. Bales	1/31/85	Water
DRAWING NO. 2301		MAP NO. F-13&14	SHEET 1 OF 1