


SCANNED BY LSCU

DRAINAGE IMPROVEMENTS ON WOODWARD RD. S.E., AT GE PLANT

INDEX

SHEET NO.	DESCRIPTION
1 OF 3	TITLE SHEET
2 OF 3	PLAN & PROFILE
3 OF 3	DETAILS

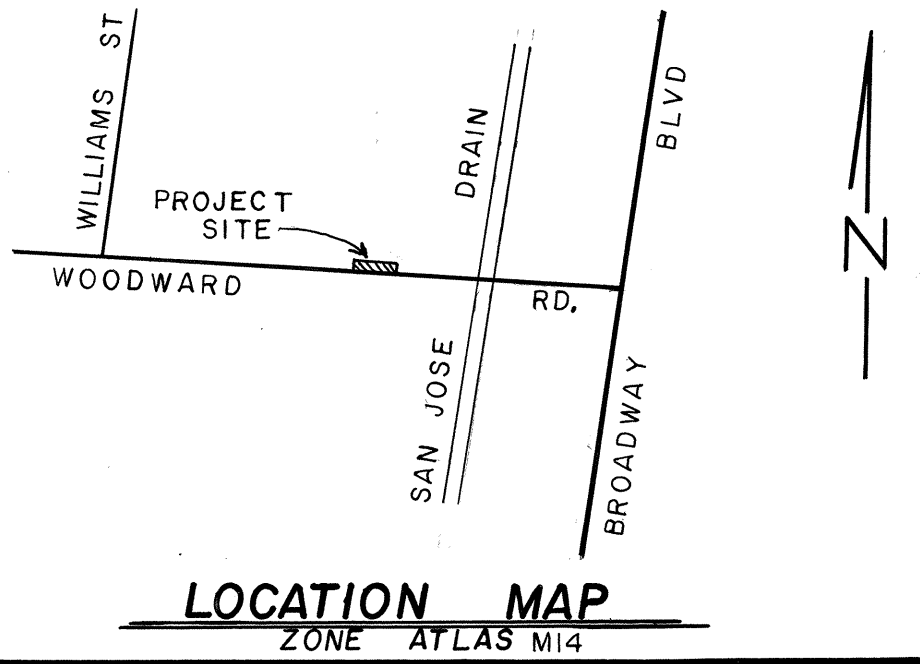

NOTICE TO CONTRACTORS

- All work detailed on these plans to be performed under contract shall, except as otherwise stated or provided for hereon, be constructed in accordance with the New Mexico Standard Specifications for Public Works Construction 1979-Edition (referred to herein as the Standard Specifications) and the Contract Documents for Public Works Contract 84-.
- Two(2) working days prior to any excavation, the contractor must contact Line Locating Service, 765-1234 for location of existing utilities.
- Prior to construction, the contractor shall excavate and verify the horizontal and vertical locations of all obstructions. Should a conflict exist, the contractor shall notify the engineer or surveyor so that the conflict can be resolved with minimum amount of delay.

THE FOLLOWING NOTES ALSO APPLY
WHEN CHECKED

- ☐ All utilities and utility service lines shall be installed prior to paving.
- ☒ Backfill compaction shall be according to specified street use. (ARTERIAL)
- ☒ Tack coat requirements shall be determined by the City Engineer.
- ☐ Sidewalks and wheelchair ramps within the curb returns shall be constructed wherever a new curb return is constructed.
- ☐ If curb is depressed for a driveway or a handicap ramp, the driveway or ramp shall be constructed prior to acceptance of the curb and gutter.
- ☒ All storm drainage facilities shall be completed prior to final acceptance.

1	2	3	4	5	6	7	8	9	10	11	12
2	6	2	3	0	2	0	1	8	5		

APPROVAL OF AS BUILT DRAWINGS
ASST. CITY ENGINEER - FIELD
W. F. McManis
DATE 10-10-85



CITY OF ALBUQUERQUE	APPROVED FOR CONSTRUCTION <i>E. J. Delaney</i> CITY ENGINEER
	SHEET 1 OF 3
DRAWING NO. 2302	

2302

POSITION EDGE OF PRINT ON THIS LINE

POSITION EDGE OF PRINT ON THIS LINE

POSITION EDGE OF PRINT ON THIS LINE

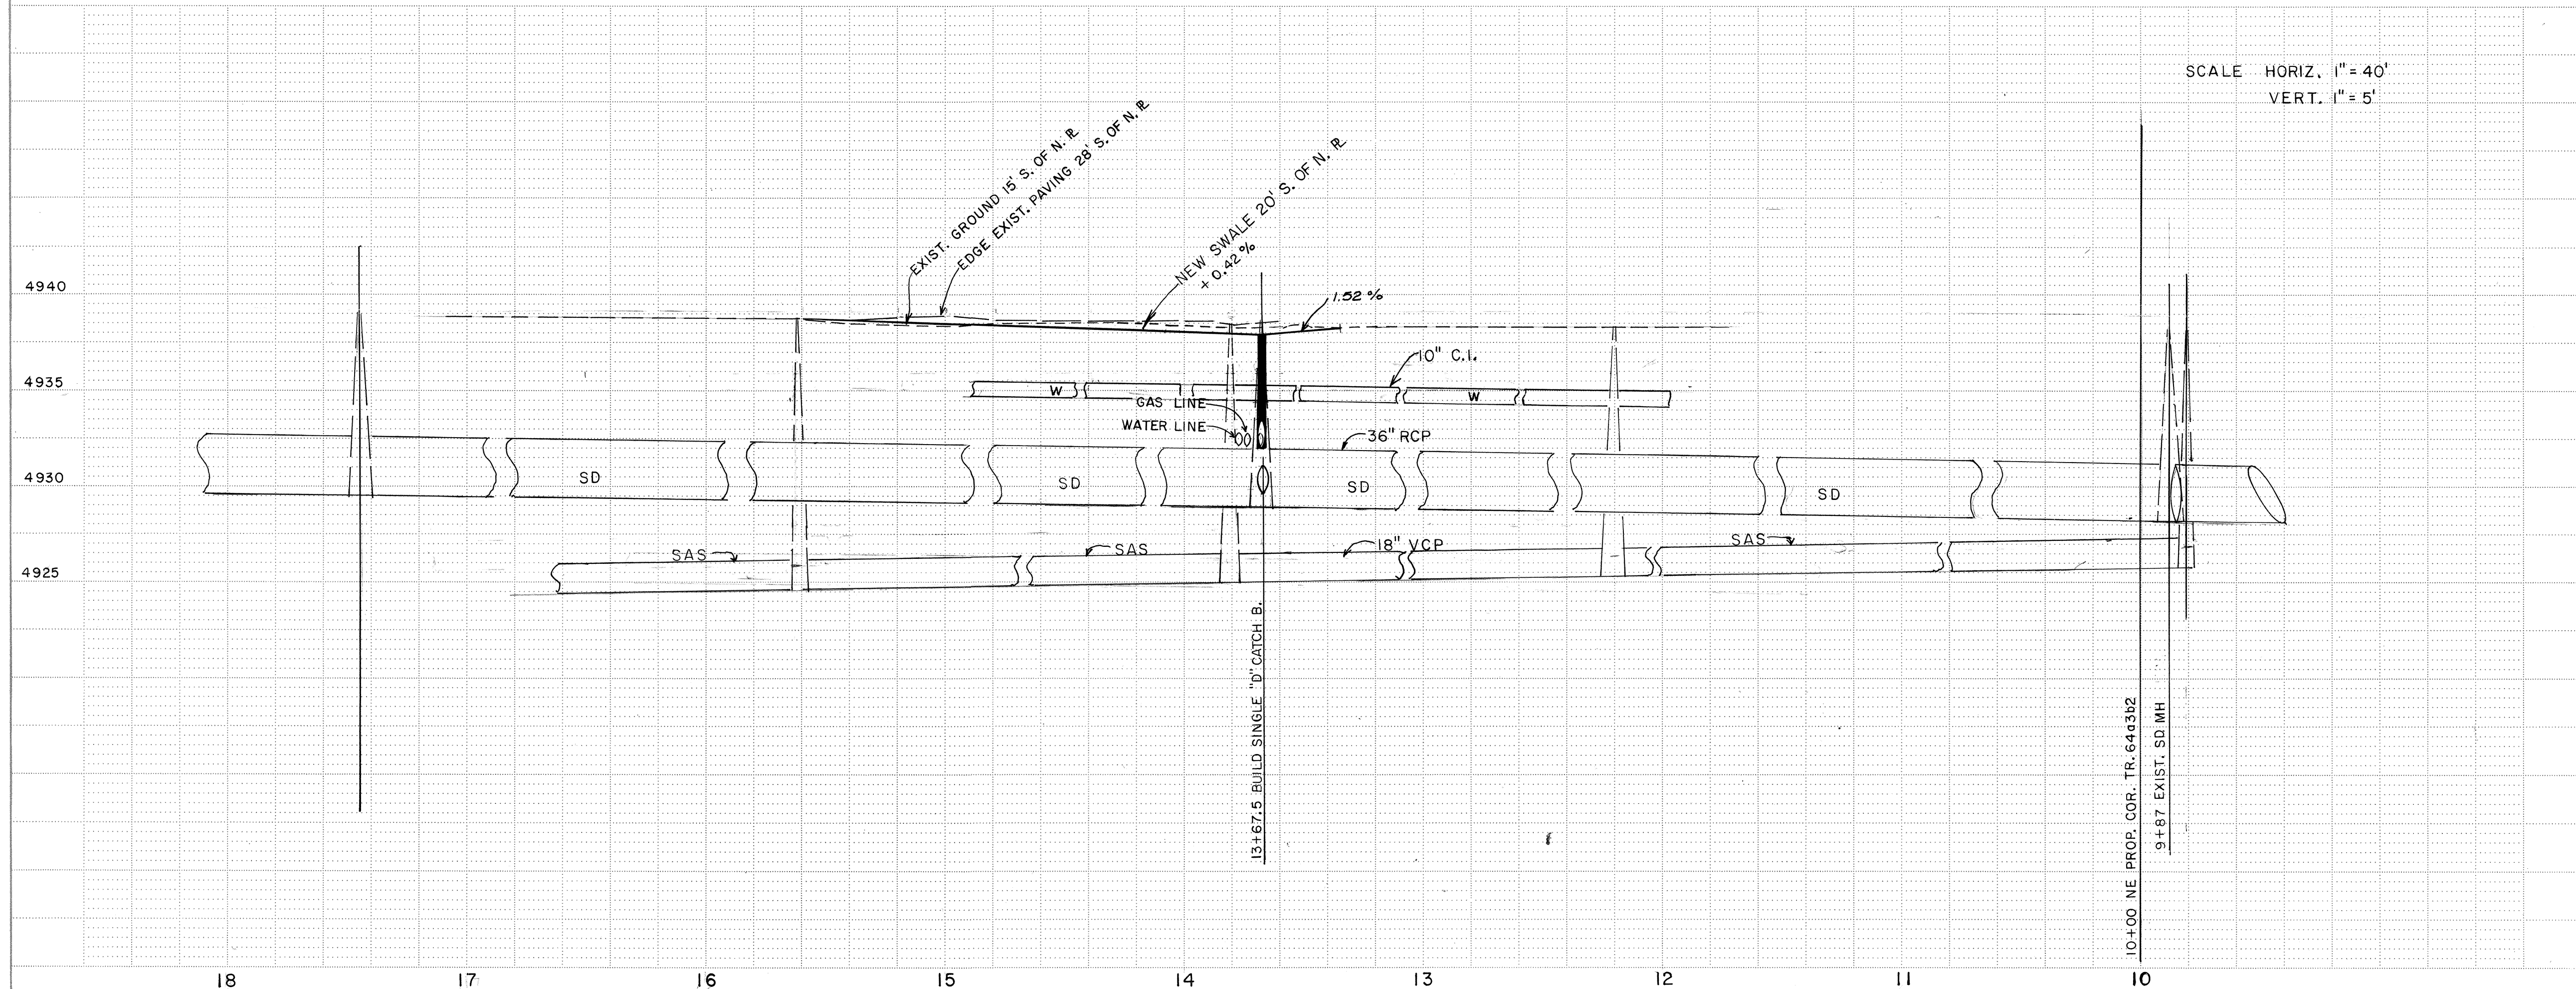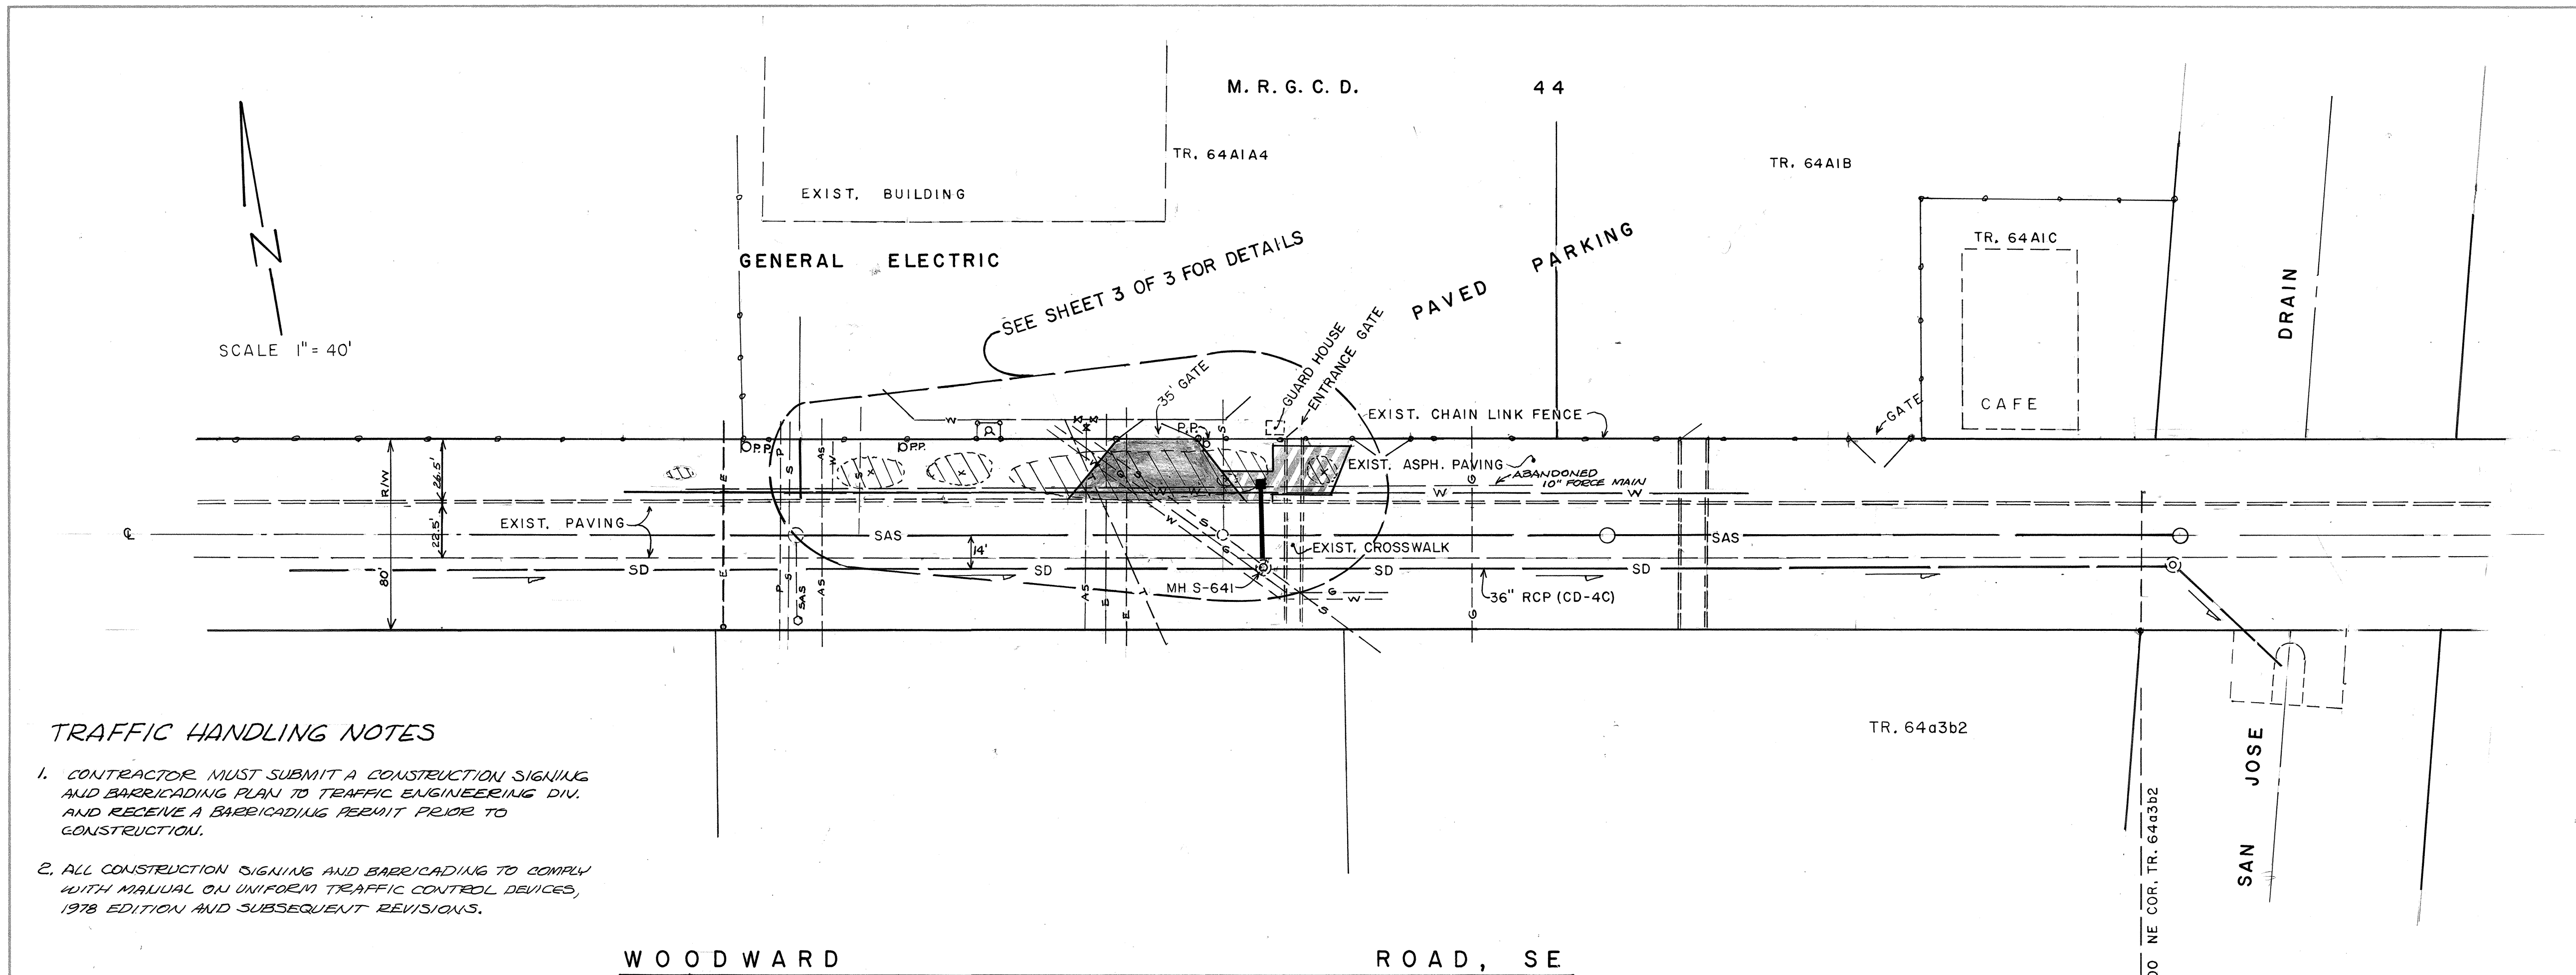

LEGEND

- NEW ARTERIAL PAVING
- NEW RESIDENTIAL PAVING
- NEW CATCH BASIN
- NEW STORM DRAIN LINE
- SD — EXISTING STORM DRAIN LINE
- SAS — EXISTING SANITARY SEWER LINE
- S — EXIST. SAN. SEWER SERVICE
- G — EXISTING GAS LINE
- W — EXISTING WATER LINE
- P — EXISTING POWER LINE
- T — EXISTING TELEPHONE

1	2	3	4	5	6	7	8	9	10	11	12
2	6	2	3	0	2	0	2	8	5		

CITY OF ALBUQUERQUE
MUNICIPAL DEVELOPMENT DEPARTMENT
ENGINEERING DIVISION

TITLE: DRAINAGE IMPROVEMENTS ON WOODWARD RD. AT GE PLANT

APPROVALS	ENGINEER	DATE	APPROVALS	ENGINEER	DATE
City Engineer	<i>[Signature]</i>	1/19/85	Liquid Waste	<i>[Signature]</i>	1/19/85
A.C.E. - Design	<i>[Signature]</i>	1/21/85	Traffic	<i>[Signature]</i>	1/19/85
A.C.E. - Hydrology	<i>[Signature]</i>	1/23/85	Water	<i>[Signature]</i>	1/19/85

DESIGNED BY B. EMMETT
DRAWN BY B. EMMETT
CHECKED BY *[Signature]*

NO. DATE REMARKS
26 2302020285

DRAWING NO. 2302 MAP NO. M14 SHEET 2 OF 3

SURVEY INFORMATION		FIELD NOTES		BENCH MARKS		AS BUILT INFORMATION	
NO.	BY	DATE				CONTRACTOR	KNC
DS44	D. KRAEMER	11-2-84				INSPECTOR'S	
						STAMPED BY	
						DATE	
						FIELD	
						DATE	
						VERIFICATION BY	
						DATE	
						CORRECTED BY	
						DATE	
						MICRO-FILM	
						INFORMATION	
						RECORDED BY	
						NO.	
						DATE	


2302

2302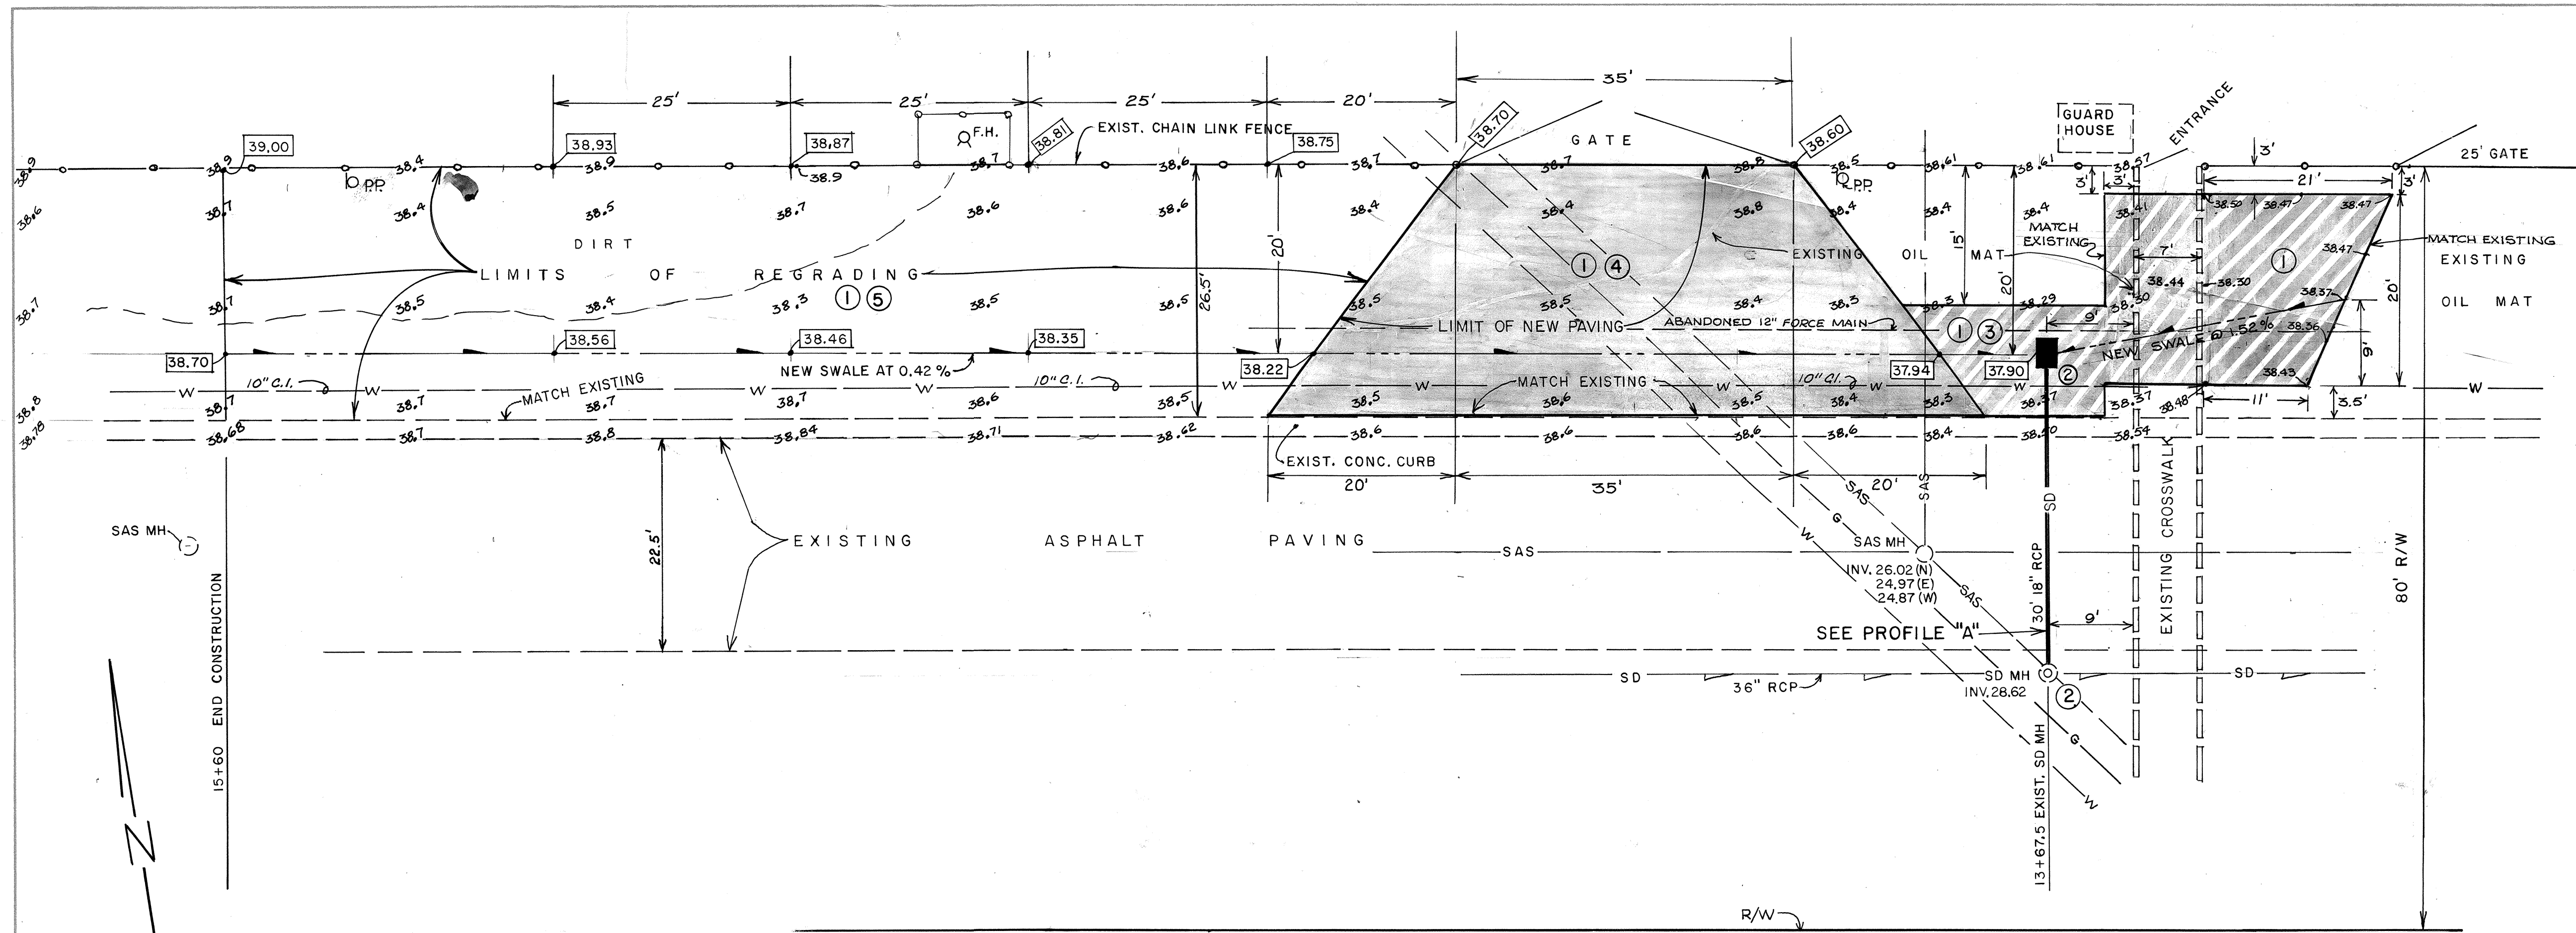

SCALE 1" = 10'

WOODWARD

ROAD, SE

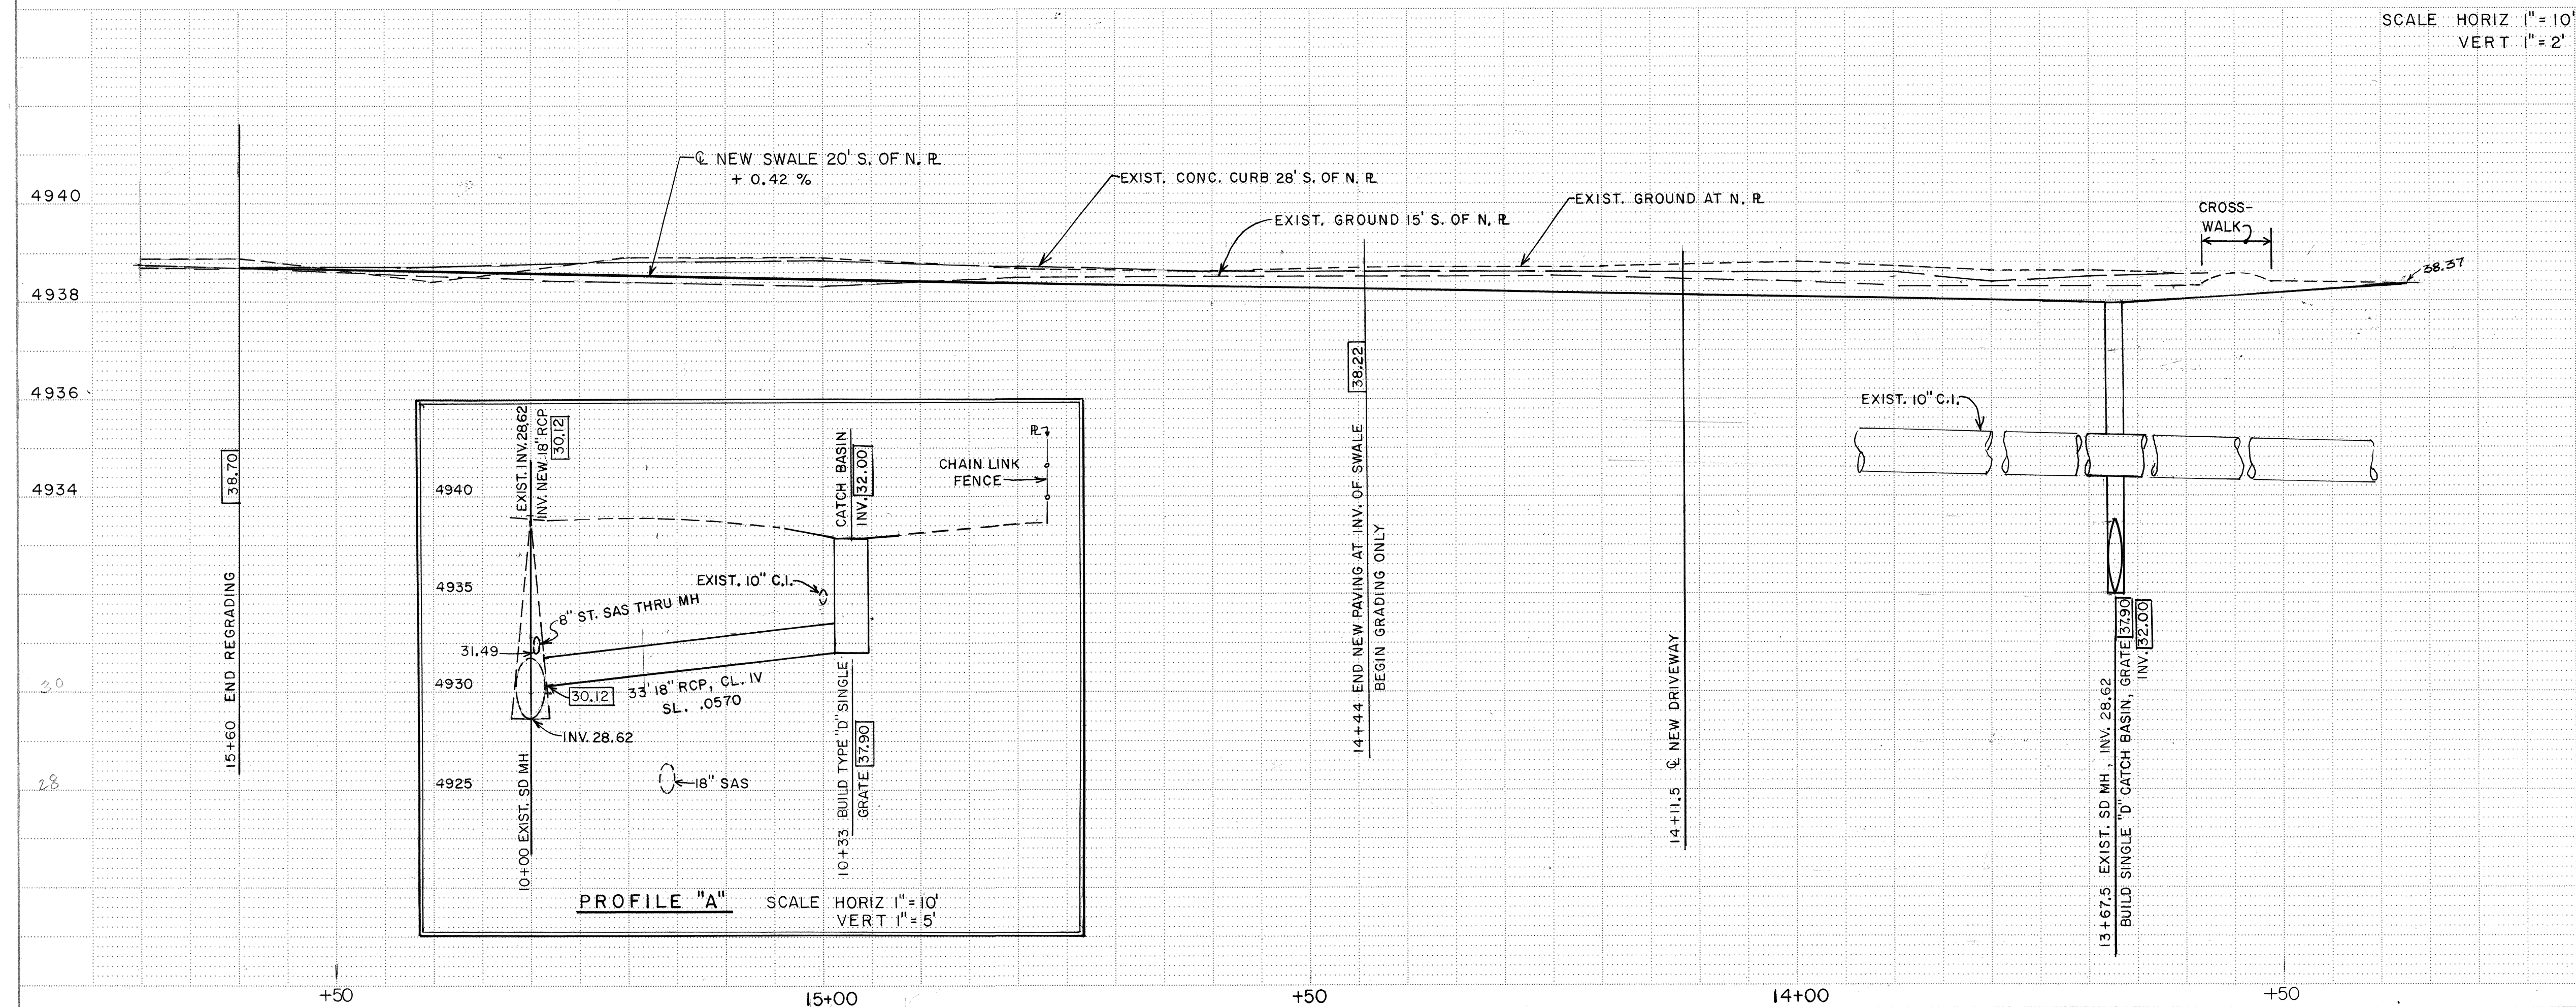

SCALE HORIZ 1" = 10'
VERT 1" = 2'

NOTES

- 1 REMOVE EXISTING OIL MAT WITHIN LIMITS OF CONSTRUCTION SHOWN ON PLAN.
- 2 BUILD TYPE "D" SINGLE CATCH BASIN PER ALB. STD. K-6-3 WITH 18" CONNECTOR LINE TO EXISTING SD MH 33' SOUTH. BREAK INTO MH AT INVERT SHOWN ON PROFILE "A". REMOVE AND REPLACE CURB AND ARTERIAL PAVING ON WOODWARD PER ALB. STD. P-7-2.
- 3 BUILD RES. PAVING PER ALB. STD. P-7-2 TO NEW GRADES SHOWN.
- 4 BUILD ARTERIAL TYPE PAVING AT ENTRANCE OF 35' GATE TO LIMITS SHOWN ON PLAN PER ALB. STD. P-7-2.
- 5 REGRADE AND COMPACT EXISTING GROUND TO 95% OF MAXIMUM BETWEEN NEW PAVING AND STA. 15+60 TO NEW GRADES SHOWN.

LEGEND

- NEW RESIDENTIAL PAVING
- NEW ARTERIAL PAVING
- NEW CATCH BASIN
- SD NEW STORM DRAIN LINE
- SD EXISTING STORM DRAIN LINE
- SAS EXISTING SANITARY SEWER LINE
- EXISTING CHAIN LINK FENCE
- PP EXISTING POWER POLE
- 37.23 NEW ELEVATION
- 38.10 EXISTING ELEVATION

1 2 3 4 5 6 7 8 9 10 11 12
2 6 2 3 0 2 0 3 8 5

CITY OF ALBUQUERQUE
MUNICIPAL DEVELOPMENT DEPARTMENT
ENGINEERING DIVISION

TITLE: DRAINAGE IMPROVEMENTS ON WOODWARD
ROAD, SE, AT GE PLANT

APPROVALS	ENGINEER	DATE	APPROVALS	ENGINEER	DATE
City Engineer	R. P. Diaz	1/9/85	Liquid Waste	R. P. Diaz	1/9/85
A.C.E. - Design	N. P. Diaz	1/9/85	Traffic	N. P. Diaz	1/9/85
Hydrology	R. P. Diaz	1/9/85	Water	R. P. Diaz	1/9/85

DRAWING NO.	2302	MAP NO.	M14	SHEET	3	OF	3
-------------	------	---------	-----	-------	---	----	---

AS BUILT INFORMATION		BENCH MARKS		SURVEY INFORMATION		ENGINEER'S SEAL	
CONTRACTOR	K.N.C.	NO.	5-M14	DATE	11-2-84	NO.	DATE
WORK	5-M14	BY	D. KRAEMER	DATE	11-2-84	NO.	DATE
INSPECTOR'S	5-M14	DATE	11-2-84	DATE	11-2-84	NO.	DATE
FIELD	5-M14	DATE	11-2-84	DATE	11-2-84	NO.	DATE
VERIFICATION	5-M14	DATE	11-2-84	DATE	11-2-84	NO.	DATE
CORRECTED	5-M14	DATE	11-2-84	DATE	11-2-84	NO.	DATE
RECORDED	5-M14	DATE	11-2-84	DATE	11-2-84	NO.	DATE