

5303

SCANNED BY LSC




BROWNEWELL

FIRST PRESBYTERIAN CHURCH

AND

LAIS

HIGHLAND

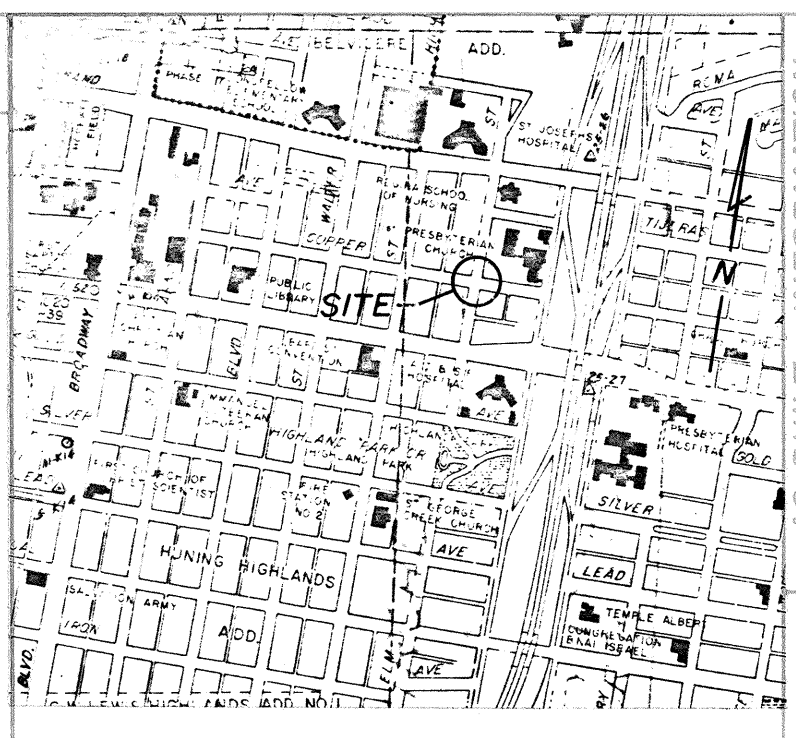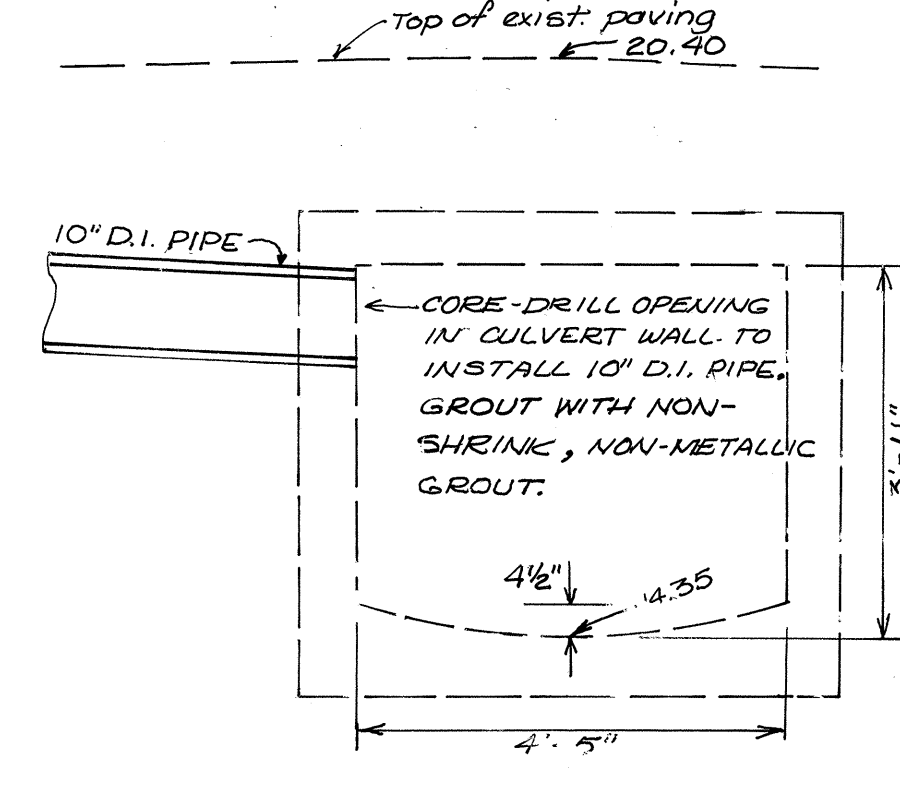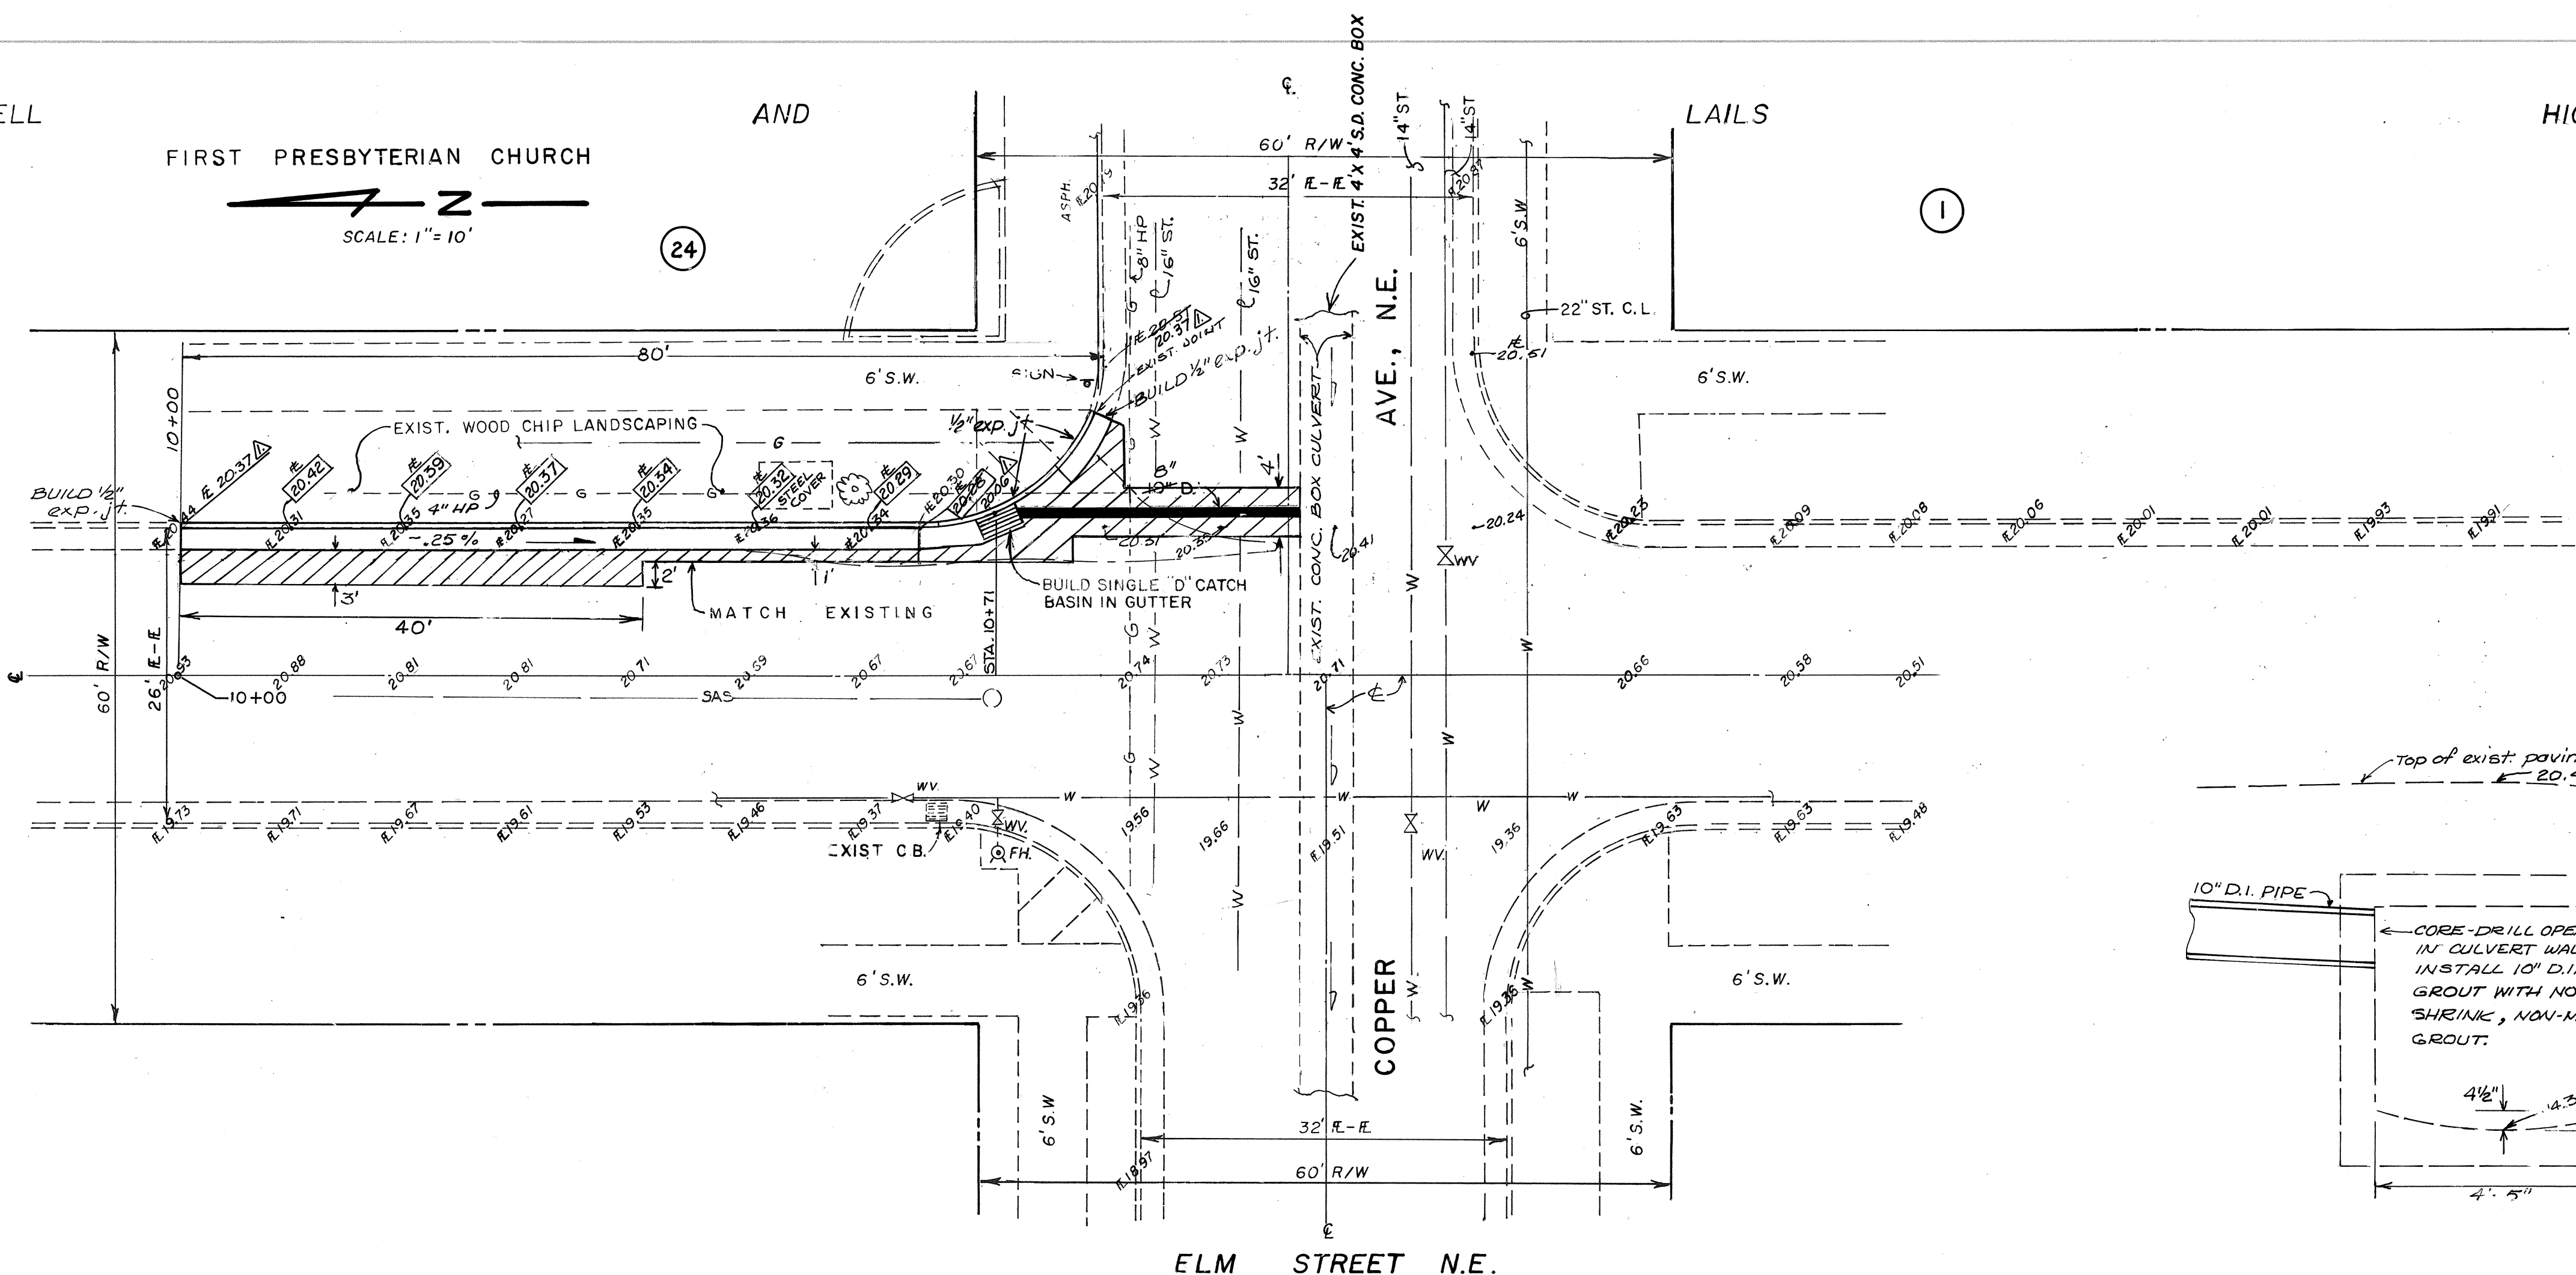

NOTICE TO CONTRACTORS

1. All work detailed on these plans to be performed under contract shall, except as otherwise stated or provided for herein, be constructed in accordance with the City of Albuquerque Interim Std. Specifications Public Works Construction- 1985 (referred to herein as the Standard Specifications) and the Contract Documents for Public Works Contract 85-4.
2. Two (2) working days prior to any excavation, the contractor must contact Line Locating Service, 765-1234, for location of existing utilities.
3. Prior to construction, the contractor shall excavate and verify the horizontal and vertical locations of all obstructions. Should a conflict exist, the contractor shall notify the engineer or surveyor so that the conflict can be resolved with minimum amount of delay.

THE FOLLOWING NOTES ALSO APPLY WHEN CHECKED

- ☐ All utilities and utility service lines shall be installed prior to paving.
- ☒ Backfill compaction shall be according to specified street use. (Residential)
- ☒ Tack coat requirements shall be determined by the City Engineer.
- ☐ Sidewalks and wheelchair ramps within the curb returns shall be constructed wherever a new curb return is constructed.
- ☐ If curb is depressed for a driveway or a handicap ramp, the driveway or ramp shall be constructed prior to acceptance of the curb and gutter.
- ☒ All storm drainage facilities shall be completed prior to final acceptance.

LEGEND

- EXISTING STORM DRAIN CONC BOX
- EXISTING WATER LINE
- EXISTING GAS LINE
- EXISTING CATCH BASIN
- EXISTING PIPE HYDRANT
- EXISTING WATER VALVE
- EXISTING SANITARY SEWER LINE
- REMOVE & REPLACE EXISTING PAVING TO NEW GRADES
- REMOVE & REPLACE EXISTING CURB AND GUTTER
- NEW STORM DRAIN DRAIN LINE

APPROVAL OF AS BUILT DRAWINGS
ASST. CITY ENGINEER-FIELD
W.F. McManus
DATE 5-14-86

SCALE 1"=10' HORIZ
1"=2' VERT

1	2	3	4	5	6	7	8	9	10	11	12
26	23	03	01	86							

APPROVED FOR CONSTRUCTION
CITY ENGINEER
J. Fink
7/1/85

CITY OF ALBUQUERQUE MUNICIPAL DEVELOPMENT DEPARTMENT ENGINEERING DIVISION					
TITLE: STORM DRAINAGE IMPROVEMENTS ELM ST & COPPER AVE					
APPROVALS	ENGINEER	DATE	APPROVALS	ENGINEER	DATE
City Engineer	C.W. Shuman	6/18/85	Liquid Waste	Rosa	7/1/85
C.E.-Design	A.L. Chua	4/16/85	Traffic	A.P. T...	2/1/85
A.C.E.-Hydrology	J.W. ...	7/1/85	Water	Rosa	2/1/85
Street Maintenance	R.E. Paul	7/1/85			
DRAWING NO.	2303	MAP NO.	K-15	SHEET	1 OF 1