


JOHN MARSHALL MULTI-SERVICE PARKING LOT

INDEX OF DRAWINGS

SHEET NO.	DESCRIPTION
1	TITLE, INDEX, GENERAL NOTES & LOCATION MAP
2	PLAN
3	PLAN & PROFILE—DETAILS

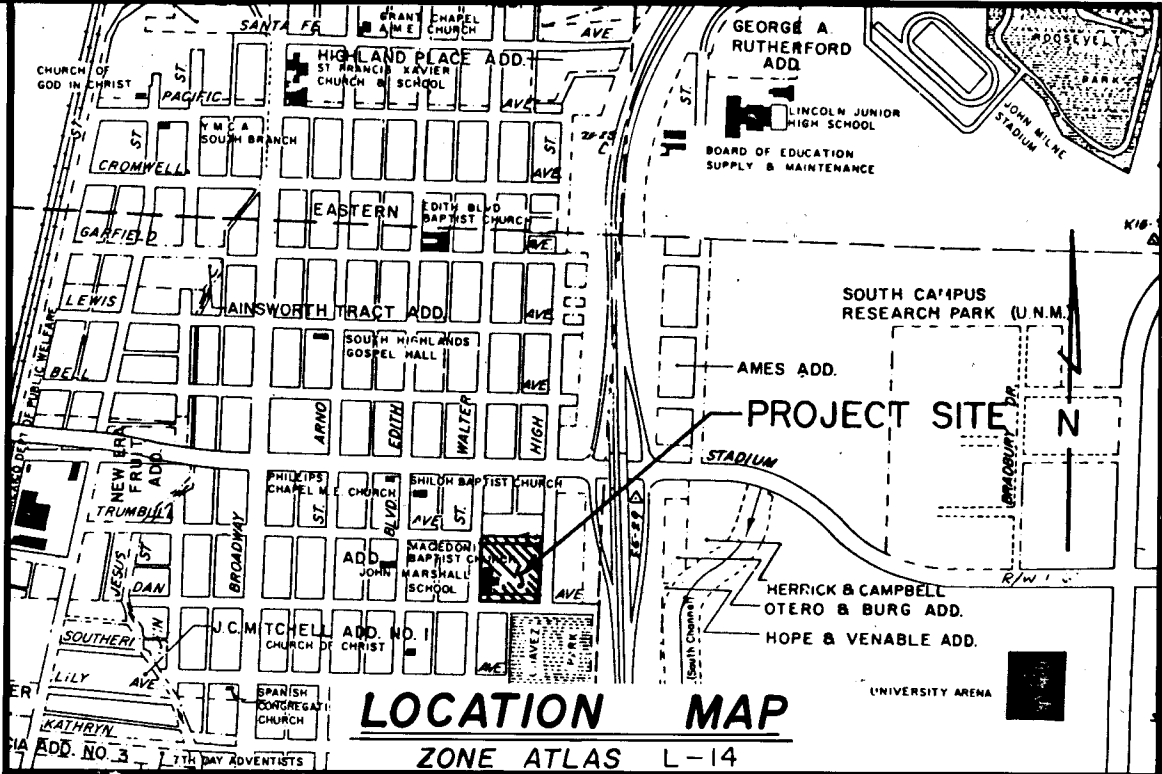


NOTICE TO CONTRACTORS

- All work detailed on these plans to be performed under contract shall, except as otherwise stated or provided for hereon, be constructed in accordance with the New Mexico Standard Specifications for Public Works Construction - 1979 Edition (referred to herein as the Standard Specifications) and the Contract Documents for Public Works Contract 84.
- Two (2) working days prior to any excavation, the contractor must contact Line Locating Service, 765-1234 for location of existing utilities.
- Prior to construction, the contractor shall excavate and verify the horizontal and vertical locations of all obstructions. Should a conflict exist, the contractor shall notify the engineer or surveyor so that the conflict can be resolved with minimum amount of delay.





THE FOLLOWING NOTES ALSO APPLY WHEN CHECKED

- ☐ All utilities and utility service lines shall be installed prior to paving.
- ☐ Backfill compaction shall be according to specified street use.
- ☐ Tack coat requirements shall be determined by the City Engineer.
- ☐ Sidewalks and wheelchair ramps within the curb returns shall be constructed wherever a new curb return is constructed.
- ☐ If curb is depressed for a driveway or a handicap ramp, the driveway or ramp shall be constructed prior to acceptance of the curb and gutter.
- ☒ All storm drainage facilities shall be completed prior to final acceptance.

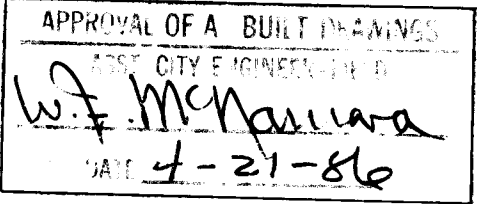

26 2314 0186

DRAWING NO.	2314	APPROVED FOR CONSTRUCTION
		 CITY ENGINEER 12/1/86 SHEET OF 1 3

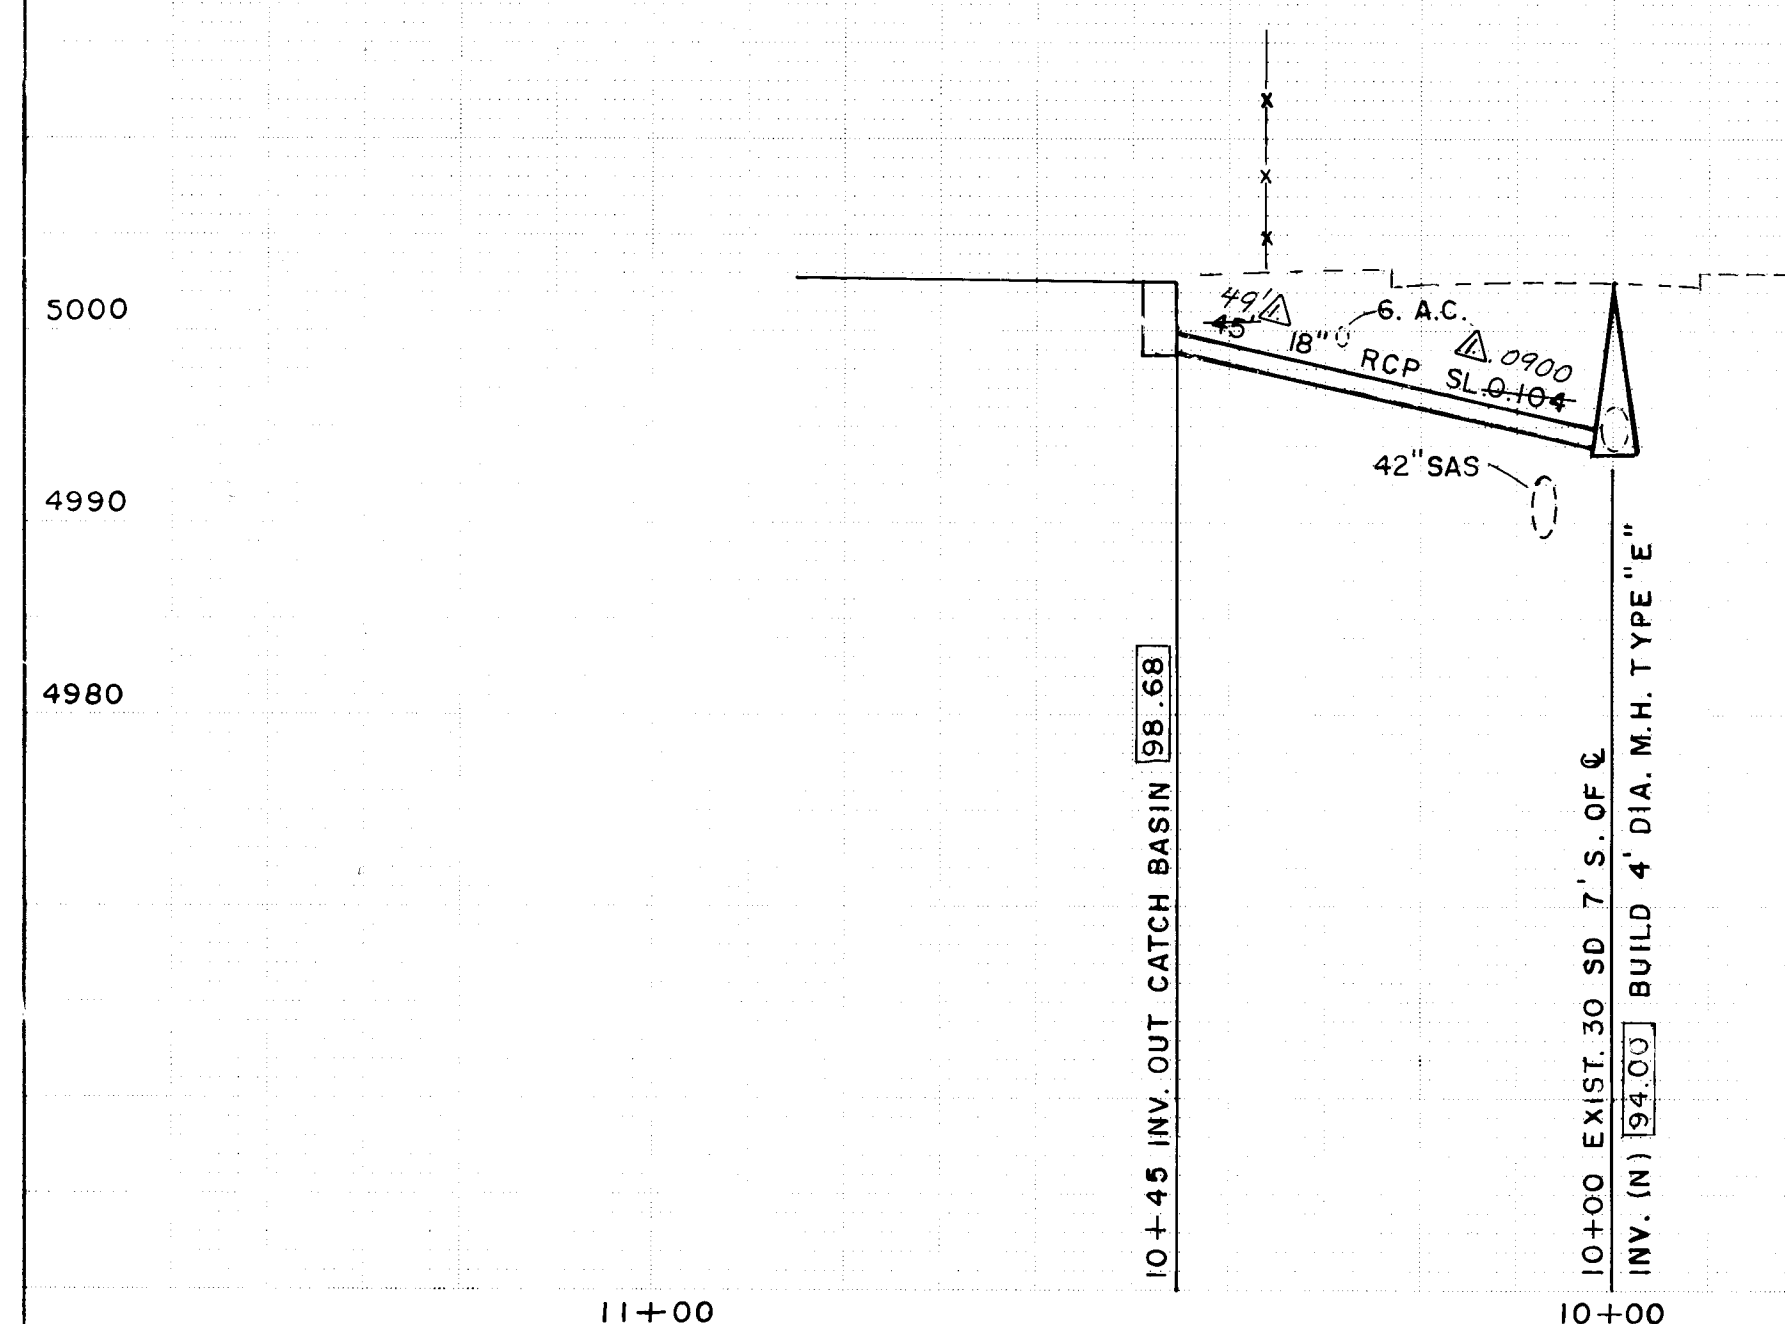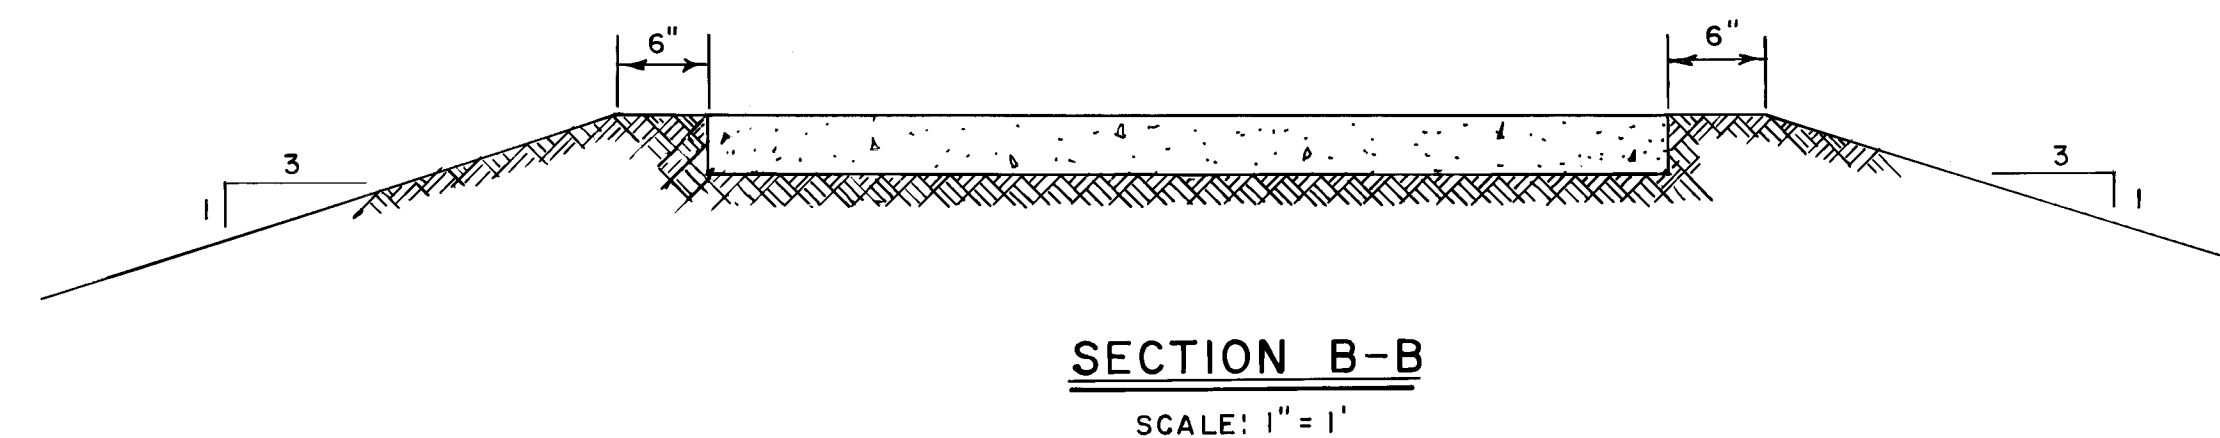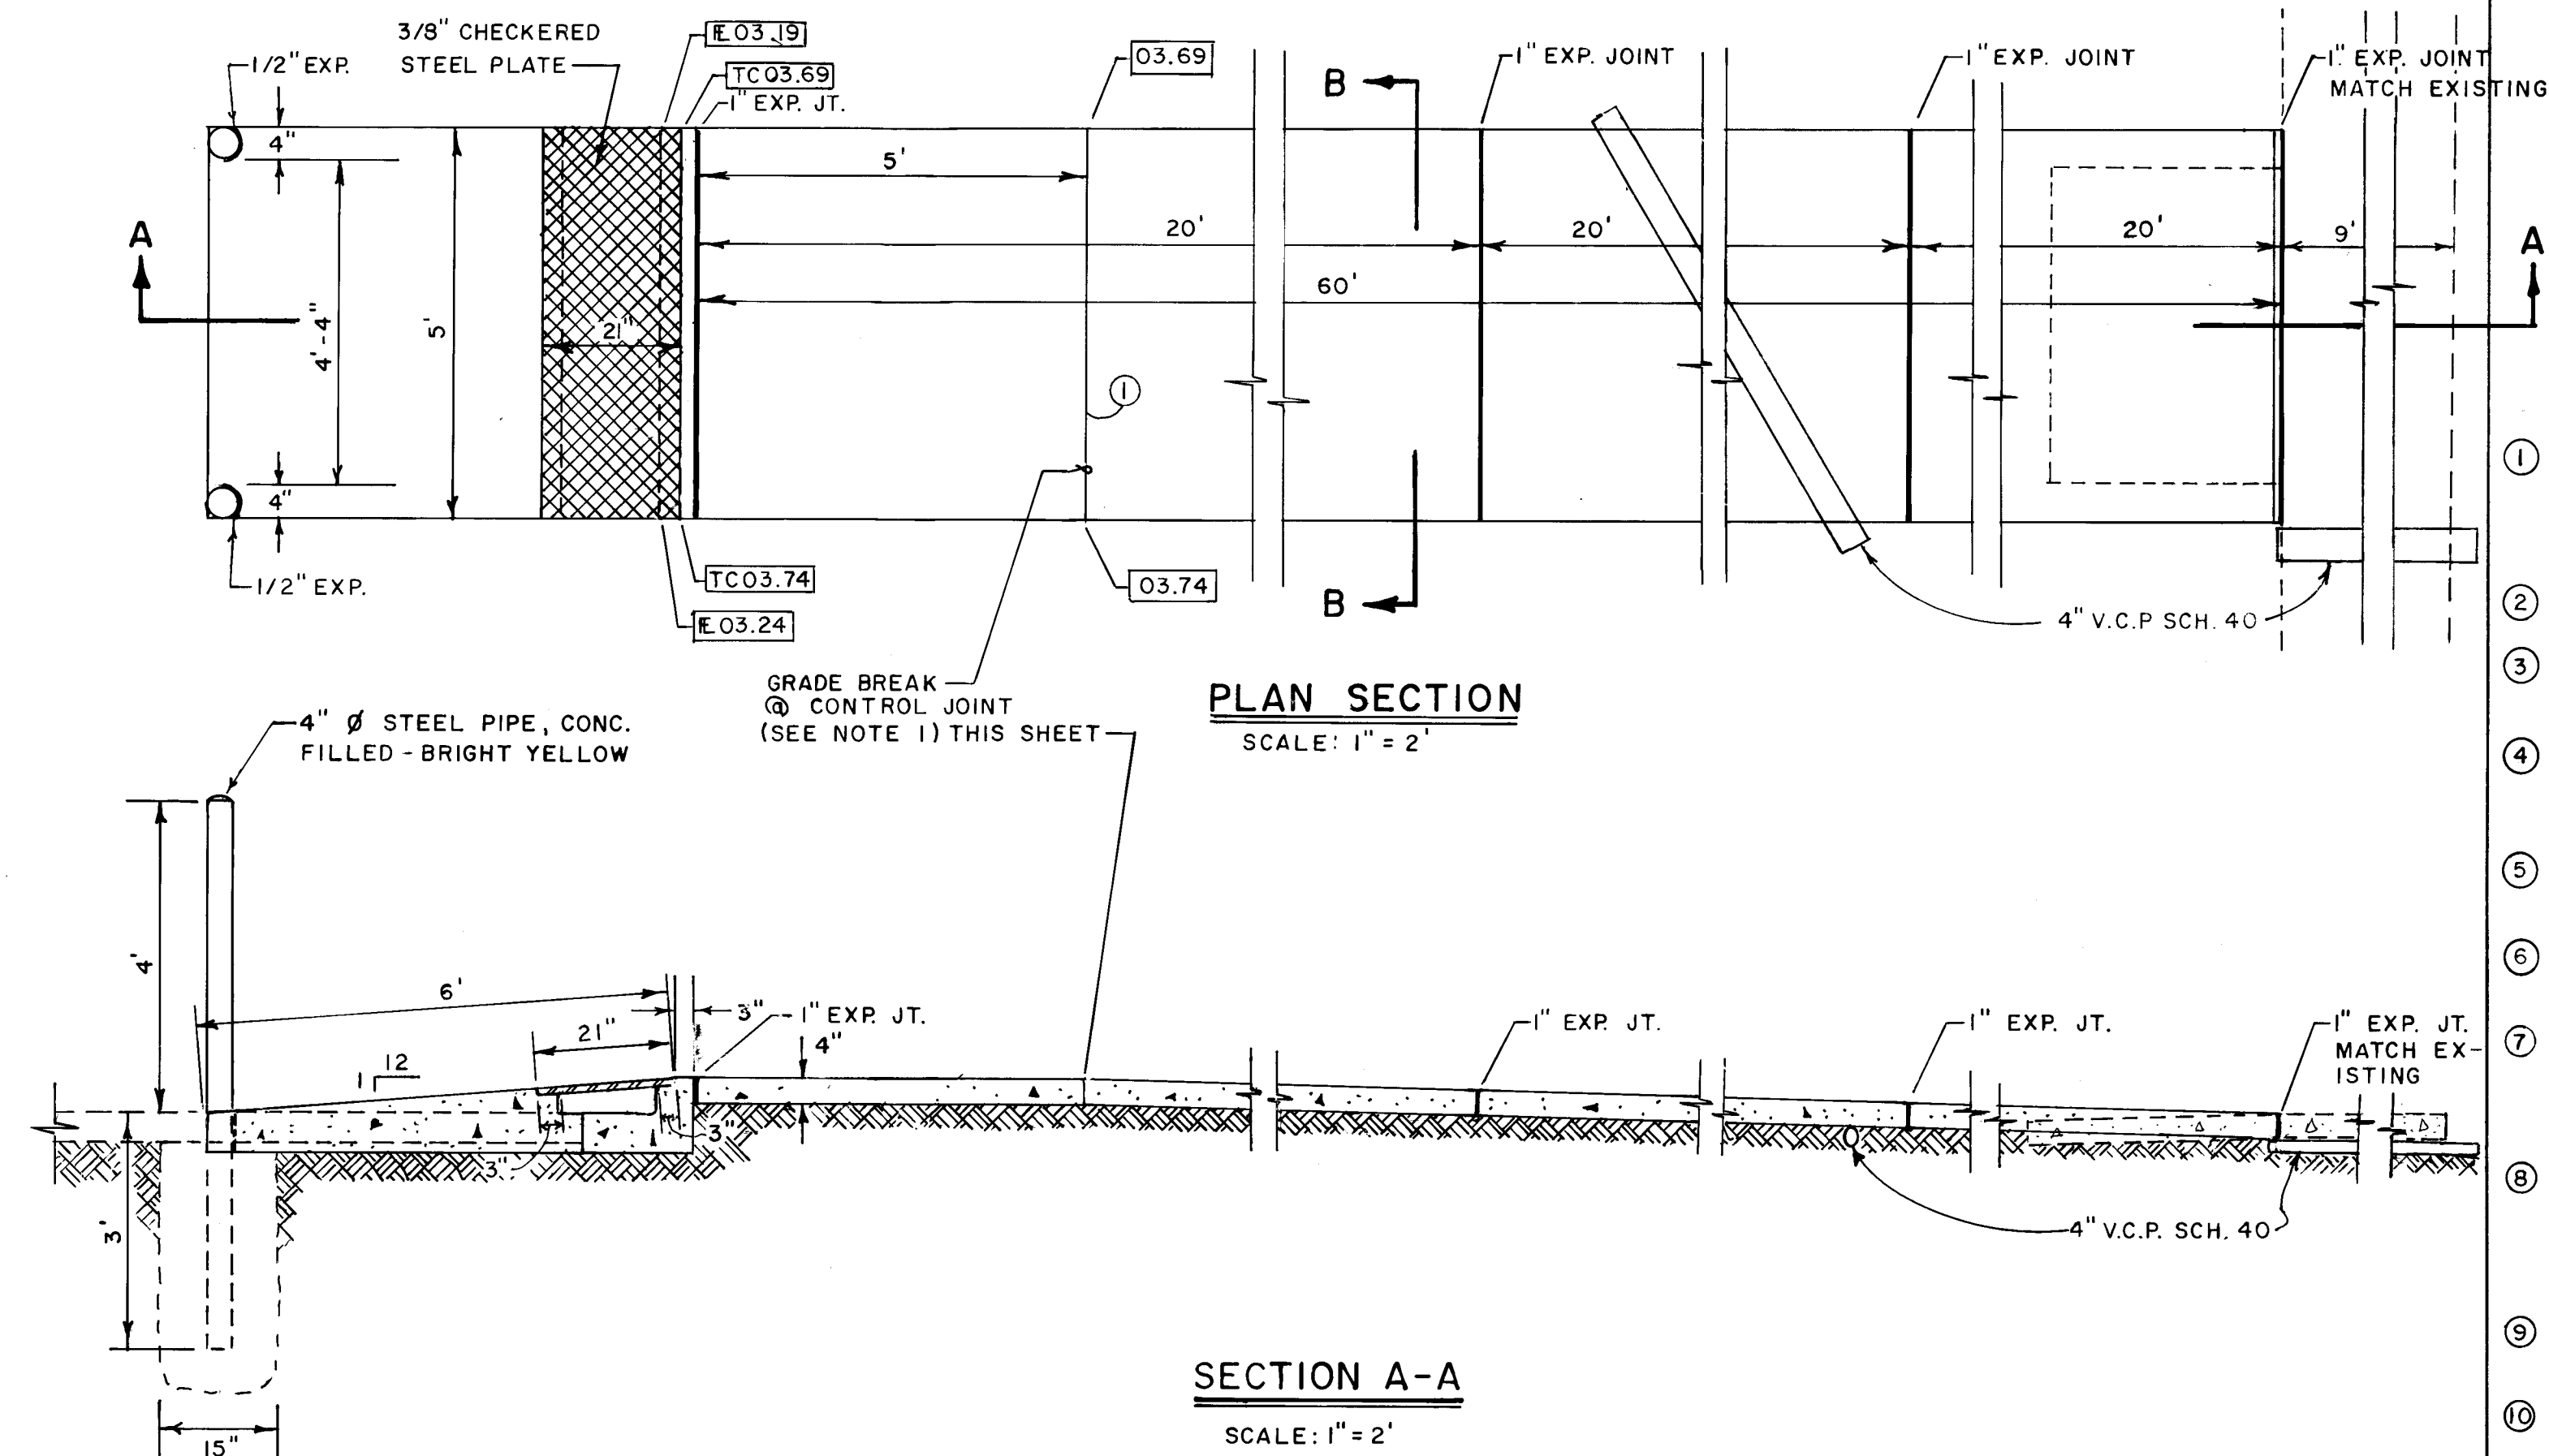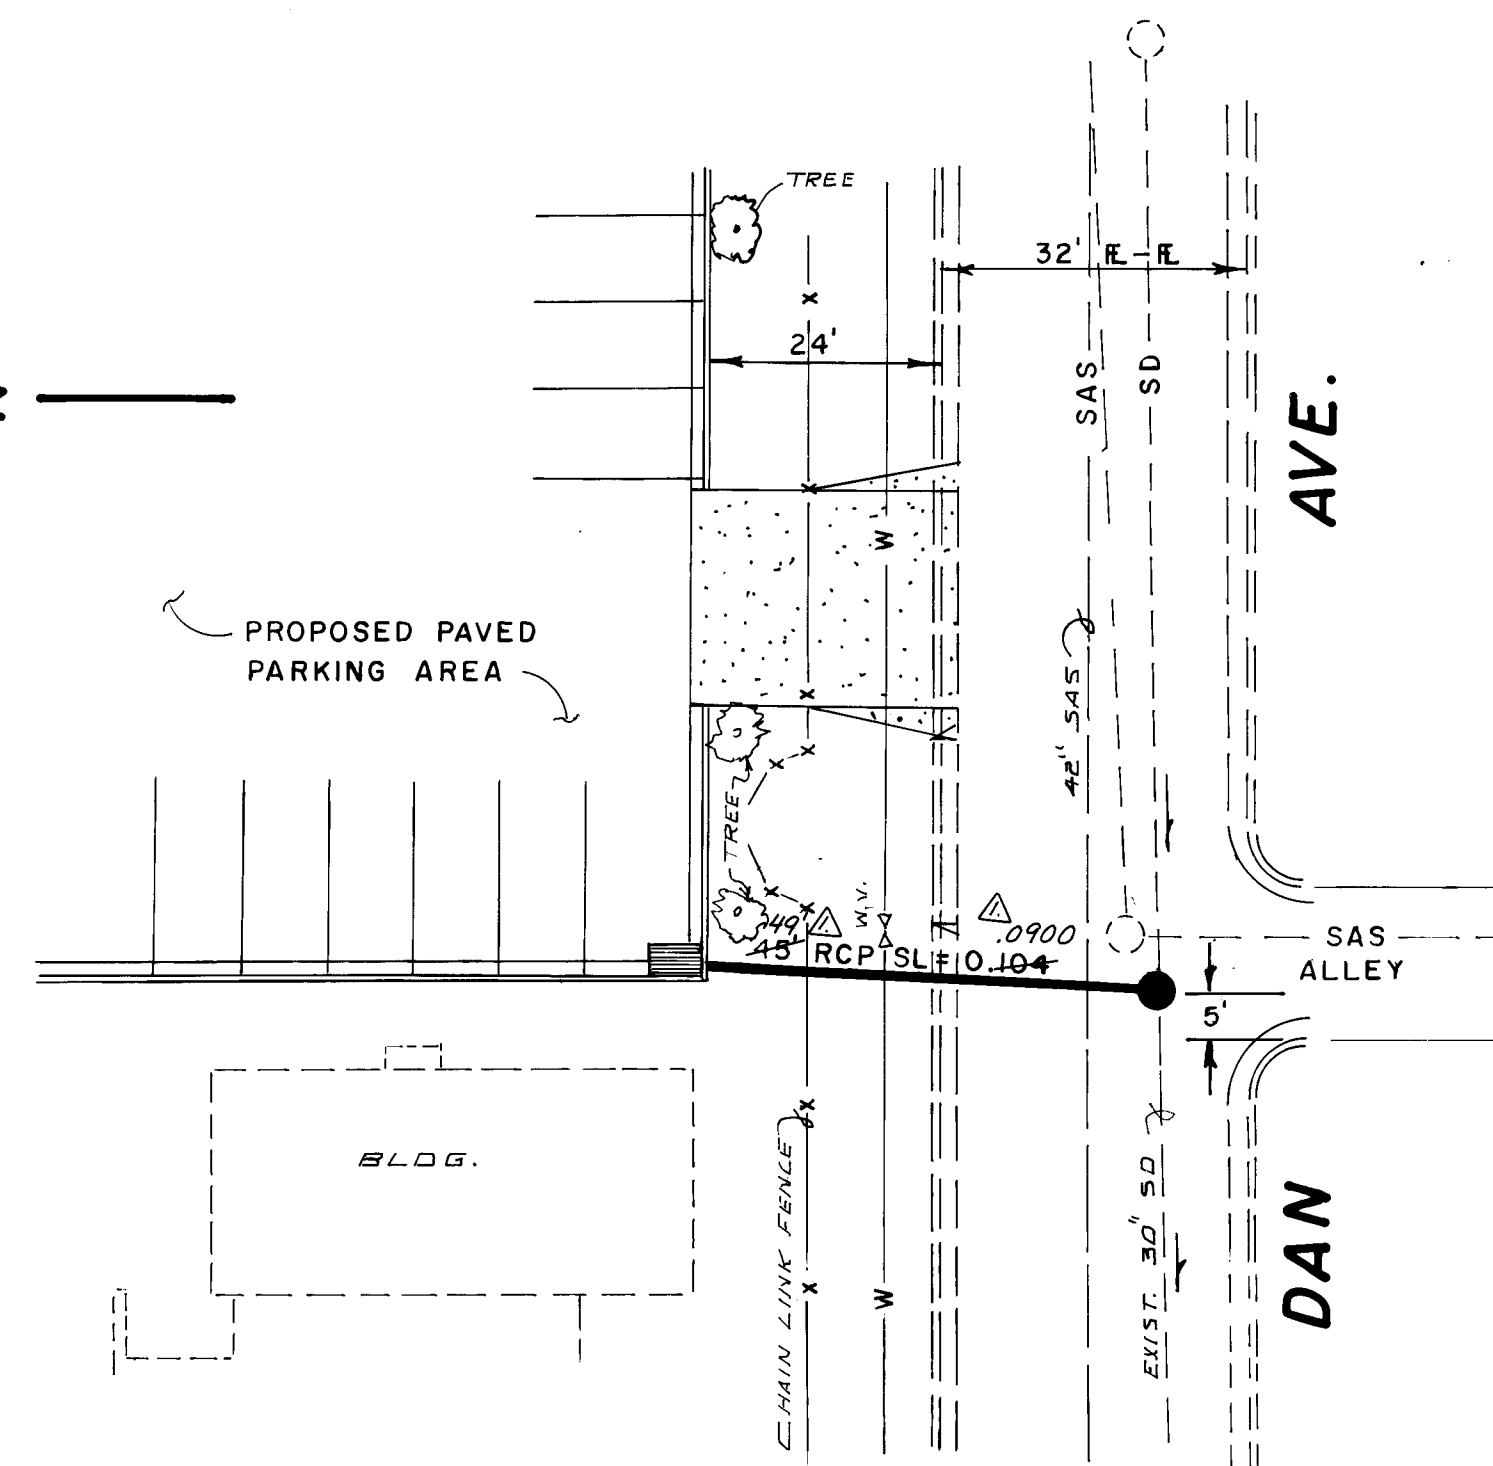

- KEYED NOTES**
- ① STARTING @ GRADE BREAK, PLACE 1 CONTROL JOINT EVERY 5' WITH THE EXCEPTION OF PLACES WHERE EXPANSION JOINTS ARE BUILT.
 - ② BUILD 24" GATE ON EXISTING FENCE.
 - ③ BUILD FENCE TO MATCH EXISTING, WHERE EXISTING GATE IS.
 - ④ BUILD SINGLE "0" CATCH BASIN AS PER CITY OF ALBUQUERQUE STD. DWG. K-6
 - ⑤ REFUSE ENCLOSURE FOR LIFT BIN CONTAINER TO BE BUILT BY OTHERS
 - ⑥ BUILD DRIVEPAD AS PER C.O.A. STD. DWG. P-II.
 - ⑦ INSTALL 1-4"Ø SCH. 40 PVC DRAIN 12' LONG UNDER CONC. WALK
S. INV. 01.15
N. INV. 00.91
 - ⑧ INSTALL 1-4"Ø SCH. 40 PVC DRAIN 12' LONG - REMOVE & REPL. 1' WIDE STRIP AT S. WALK
E. INV. 00.86
W. INV. 00.74
 - ⑨ HAND GRADE A 30' LONG 12" WIDE SWALE TO DAYLIGHT @ 1% SLOPE MIN.
 - ⑩ EXISTING 3' x 4' CONC. PAD TO BE REMOVED
 - ⑪ EXISTING CONCRETE WALK
 - ⑫ AREA TO BE REMOVED FROM EXIST. CONCRETE SLABS.
 - ⑬ NEW VALLEY GUTTER
 - ⑭ TRANSITION HEADER CURB RETURN TO GROUND ELEVATION IN 12".

				ENGINEER'S SEAL		SURVEY INFORMATION		BENCH MARKS		AS BUILT INFORMATION	
						FIELD NOTES				CONTRACTOR K.N.C.	
						BY				DATE	
						NO.				INSPECTED BY	
						FRANK				FIELD	
						TABLE				INANCE BY	
						G. AREHUNDE				DATE	
						P. AGUIAR				DATE	
						10-38				DATE	
						K.S.H. L-14-265				DATE	
						N. RIA M.H. ALLEY BETWEEN				DATE	
						EDITH & WALTER				DATE	
						ELEV. 4384.35				DATE	
										RECORDED BY	
										DATE	
										NO	

CITY OF ALBUQUERQUE	
MUNICIPAL DEVELOPMENT DEPARTMENT	
ENGINEERING DIVISION	
TITLE:	JOHN MARSHALL MULTI-SERVICE PARKING LOT

APPROVALS	ENGINEER	DATE	APPROVALS	ENGINEER	DATE
City Engineer	<i>J. C. Lee</i>	<i>12/6/85</i>	Liquid Waste	<i>R. P. Lee</i>	<i>8/21/85</i>
A C E - Design	<i>J. C. Lee</i>	<i>12/6/85</i>	Traffic	<i>David W. Hume</i>	<i>8/21/85</i>
A C E - Hydrology	<i>Don Lee</i>	<i>8/21/85</i>	Water	<i>R. P. Lee</i>	<i>8/21/85</i>

DRAWING NO.	2314	MAP NO.	L-14	SHEET	3	OF	3
-------------	------	---------	------	-------	---	----	---