


CITY OF ALBUQUERQUE
NEW MEXICO
WATER RESOURCES DEPARTMENT

MISSION SQUARE
WATERLINE EXTENSIONS
AND SAS MANHOLE

ANDREWS, ASBURY & ROBERT, INC.
CONSULTING ENGINEERS
ALBUQUERQUE NEW MEXICO

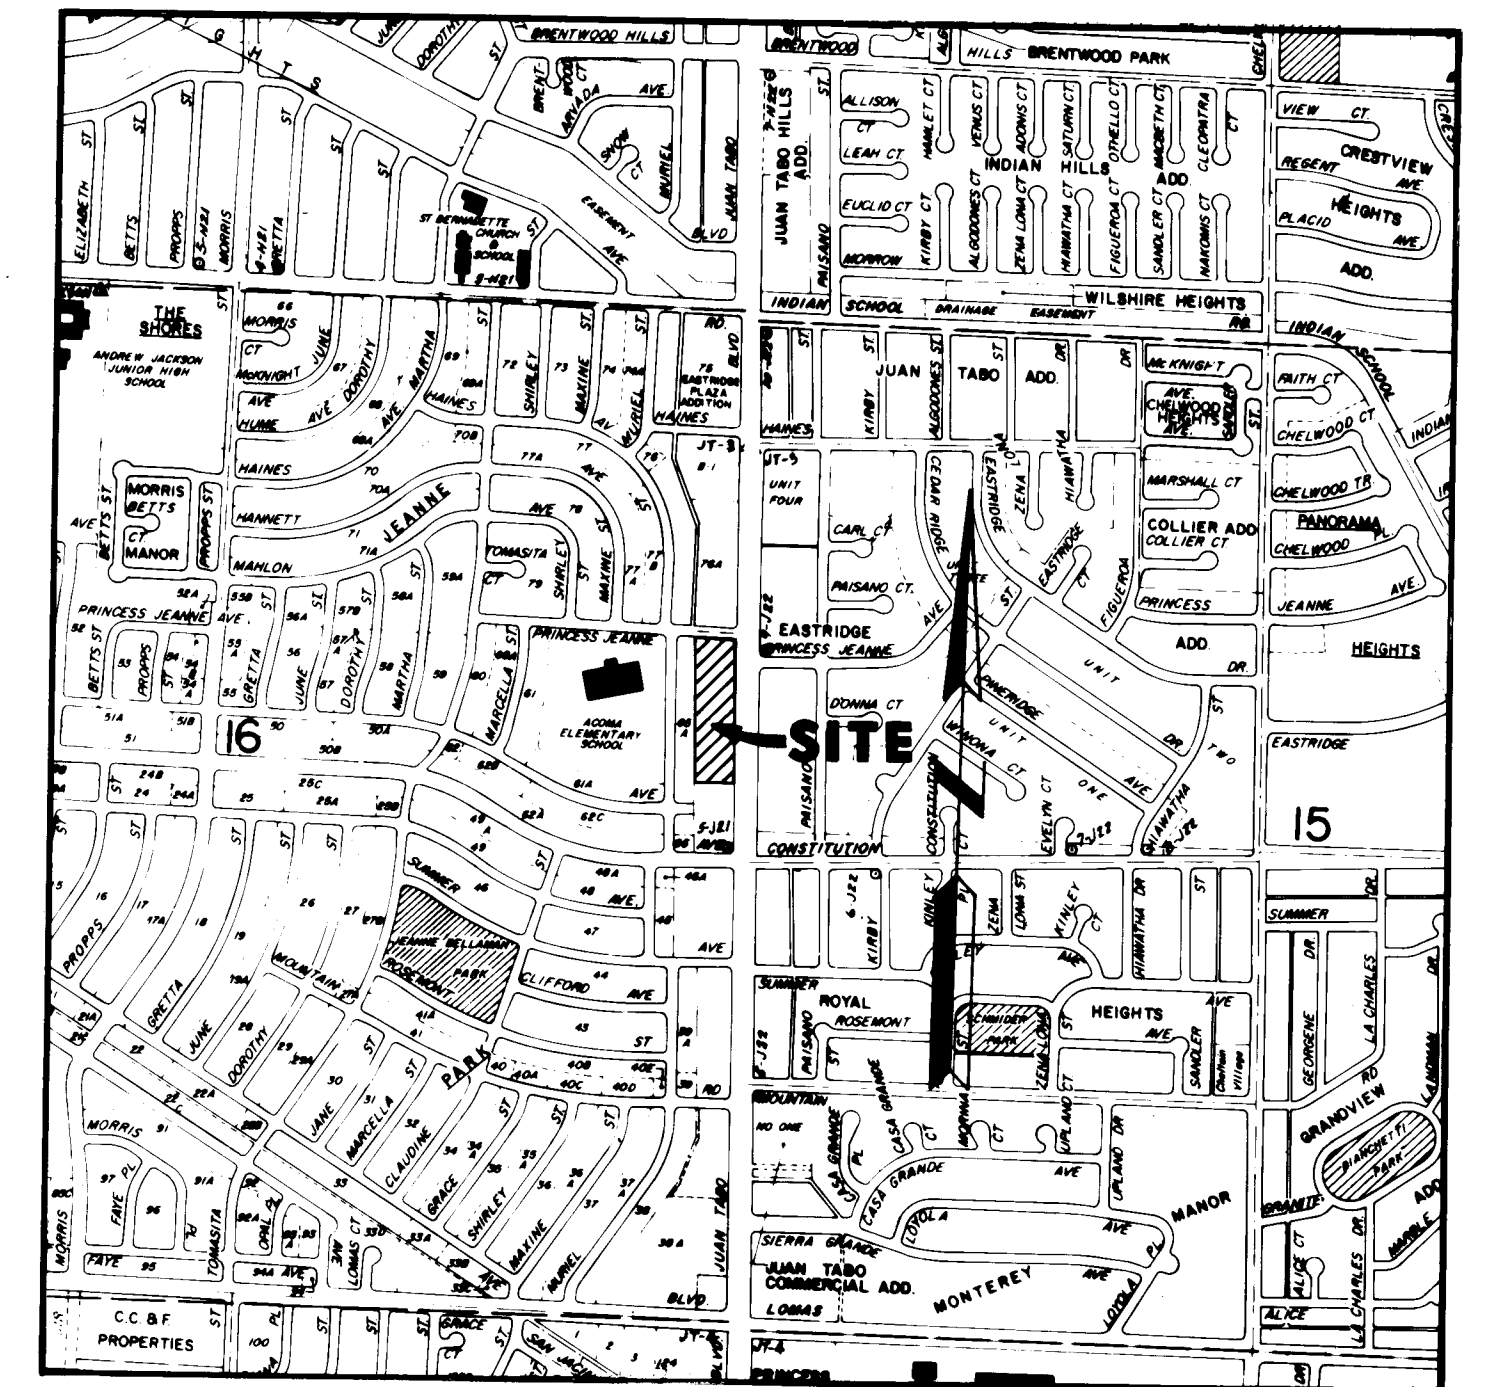

ZONE ATLAS MAP NO. J-21

INDEX

DESCRIPTION	SHEET No.
TITLE SHEET	1
SUBDIVISION PLAT & GENERAL NOTES	2
SUBDIVISION PLAT	3
WATERLINE "A" STA. 0+00 TO STA. 6+50 PLAN & PROFILE	4
WATERLINE "A" STA. 6+50 TO STA. 11+04.83 & WATERLINE "B" PLAN & PROFILE	5

W.F. McManus
6/28/85

RECORD DRAWING

26 23360185

APPROVED FOR
CONSTRUCTION

C. H. Thompson *4/28/85*
CITY ENGINEER DATE

REV.	SHTS.	CITY ENGINEER	DATE	USER	DEPT.	DATE	No.	DATE	REMARKS	BY
Δ	5	<i>C. H. Thompson</i>	<i>4/28/85</i>	<i>B. P. Asbury</i>		<i>3/13/85</i>		<i>3/17/85</i>	Added Storm Drain MH-Sheet 5 of 5	A.A.R.
APPROVAL OF REVISIONS										

DRAWING NO.	2336	MAP NO.	J-21	SHEET	2	OF	5
-------------	------	---------	------	-------	---	----	---

83 60552

SUBDIVISION OF
LOT 2-B, BLOCK 65-B
OF
DALE J. BELLAMAH'S
PRINCESS JEANNE PARK
ALBUQUERQUE, NEW MEXICO

NOW COMPRISING
LOTS 2-B1 & 2-B2, BLOCK 65-B
AUGUST 1983

State of New Mexico } SS
County of Bernalillo
This instrument was filed for record
on 06 SEP 6 1983
at 11:00 o'clock P.M. Recorded to Vol. 117
of records of said County Falls ...
... Clerk & Recorder
... Deputy Clerk

PRINCESS JEANNE AVE., N.E.

LOT 2-A BLK. 65-B
FILED 6-22-78
VOLUME C13, PAGE 131

N 89°43'00" W 207.79' (Plot)

LOT 2-B1
1.58628 Acres

LOT 2-B2
0.48782 Acres

LOT 1-BLK. 65-B
FILED 1-7-77
VOLUME C11, PAGE 159

CONSTITUTION AVE., N.E.

PRINCESS JEANNE PARK

TRACT 85-A
FILED 11-13-56 VOLUME C4, PAGE 49

N 00°26'00" E 436.81' (Plot)

332.27'

104.54'

106' R/W

332.82'

432.82' (Plot)

S 00°26'00" W

100.00'

DESCRIPTION

Lot 2-B, Block 65-B, of Dale J. Bellamah's PRINCESS JEANNE PARK, as the same is shown and designated on the replat of said Addition, filed in the Office of the County Clerk of Bernalillo County, New Mexico, on the 22nd day of June, 1978, Volume C13, Page 131.

APPROVED AND ACCEPTED BY:

<i>Frank J. ...</i>	<u>8/30/83</u>
A.M.A.E.C.A.	(Date)
<i>...</i>	<u>8/29/83</u>
City Surveyor	(Date)
<i>...</i>	<u>8/30/83</u>
Park & Recreation Department	(Date)
<i>...</i>	<u>8/30/83</u>
Property Management	(Date)
<i>...</i>	<u>8/30/83</u>
Traffic Engineer	(Date)
<i>...</i>	<u>8/30/83</u>
City Engineer	(Date)
<i>...</i>	<u>9-1-83</u>
Planning Department	(Date)
<i>...</i>	<u>8/30/83</u>
Water Resources Department	(Date)

SURVEYOR'S CERTIFICATION

This is to certify that this Subdivision Plat was prepared under my direct supervision, shows all easements of record, meets the minimum requirements for monumentation and surveys of the Albuquerque Subdivision Ordinance, and is true and accurate to the best of my knowledge and belief.

8/29/83 Date *Louis W. Gross* Louis W. Gross, N.M.P.E. & L.S. No. 4170

61-222

83 00554 SUBDIVISION OF
LOT 2-B, BLOCK 65-B
OF
DALE J. BELLAMAH'S
PRINCESS JEANNE PARK
ALBUQUERQUE, NEW MEXICO
NOW COMPRISING
LOTS 2-B1 & 2-B2, BLOCK 65-B
AUGUST 1983

DESCRIPTION

Lot 2-B, Block 65-B, of Dale J. Bellamah's PRINCESS JEANNE PARK, as the same is shown and designated on the replat of said Addition, filed in the Office of the County Clerk of Bernalillo County, New Mexico, on the 22nd day of June, 1978, Volume C13, Page 131.

APPROVED AND ACCEPTED BY:

Frank Hogen	2/30/83
A.M.A. F.C.A.	(Date)
City Surveyor	2/29/83
	(Date)
James W. Haines	8/20/83
Park & Recreation Department	(Date)
James E. Haines	8/20/83
Property Management	(Date)
Robert A. Haines	8/30/83
Traffic Engineer	(Date)
Frank Hogen	2/30/83
City Engineer	(Date)
G. Haines by B. Haines	9-1-83
Planning Department	(Date)
R. H. Haines	8/30/83
Water Resources Department	(Date)

SURVEYOR'S CERTIFICATION

This is to certify that this Subdivision Plat was prepared under my direct supervision, shows all easements of record, meets the minimum requirements for monumentation and surveys of the Albuquerque Subdivision Ordinance, and is true and accurate to the best of my knowledge and belief.

8/29/83
Date

DGA **DENNEY-GROSS & ASSOC., INC.**
ENGINEERS SURVEYORS PLANNERS
2400 COMANCHE RD. NE, ALBUQ., N.M. 87107
(505) 884-0696

D. G A Job # 677.12


RECORD DRAWING

CITY OF ALBUQUERQUE
MUNICIPAL DEVELOPMENT DEPARTMENT
ENGINEERING DIVISION

MISSION SQUARE WATERLINE EXTENSIONS
SUBDIVISION PLAT


APPROVALS	ENGINEER	DATE	APPROVALS	ENGINEER	DATE
City Engineer	<i>C.D. Lloyd</i>	<i>3/9/85</i>	Liquid Waste	<i>NA 200B</i>	<i>1/23/85</i>
A.C.E. - Design	<i>A.C. Lloyd</i>	<i>2/18/85</i>	Traffic	<i>NA 200H</i>	<i>1/23/85</i>
NA - Hydrology	<i>N.A. 200B</i>	<i>1/23/85</i>	Water	<i>NA 200B</i>	<i>1/23/85</i>

DRAWING NO.	2336	MAP NO.	J-21	SHEET	3	OF	5
-------------	------	---------	------	-------	---	----	---

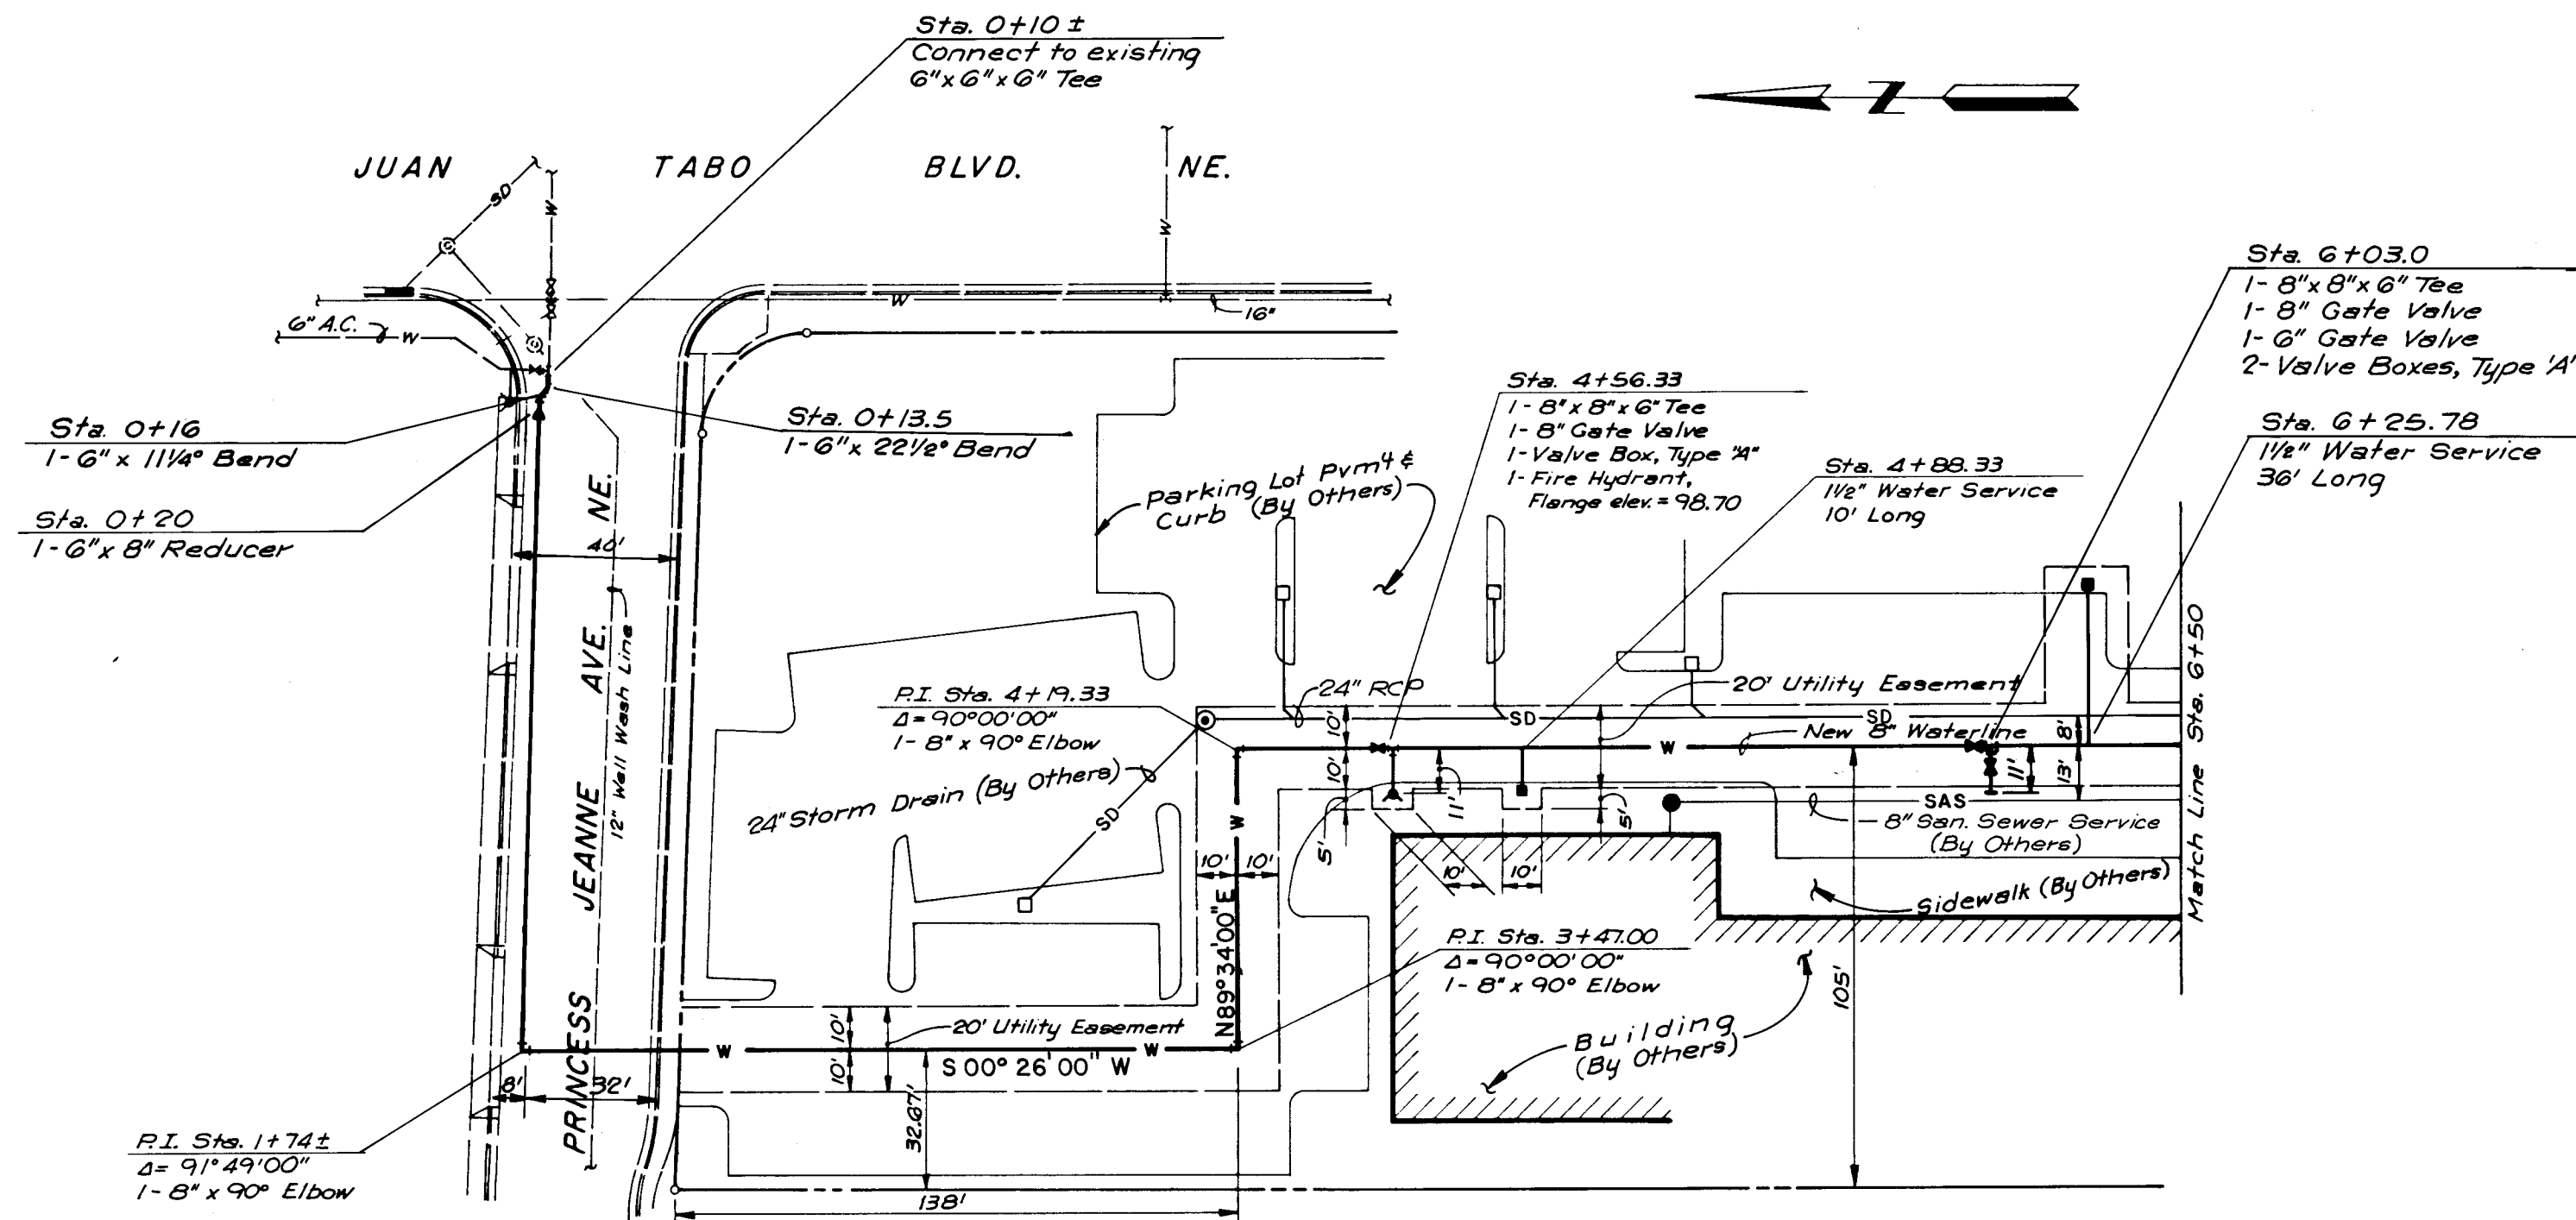

PLAN
SCALE: 1" = 40'

WATERLINE "A" STA. 0+00 TO STA. 6+50

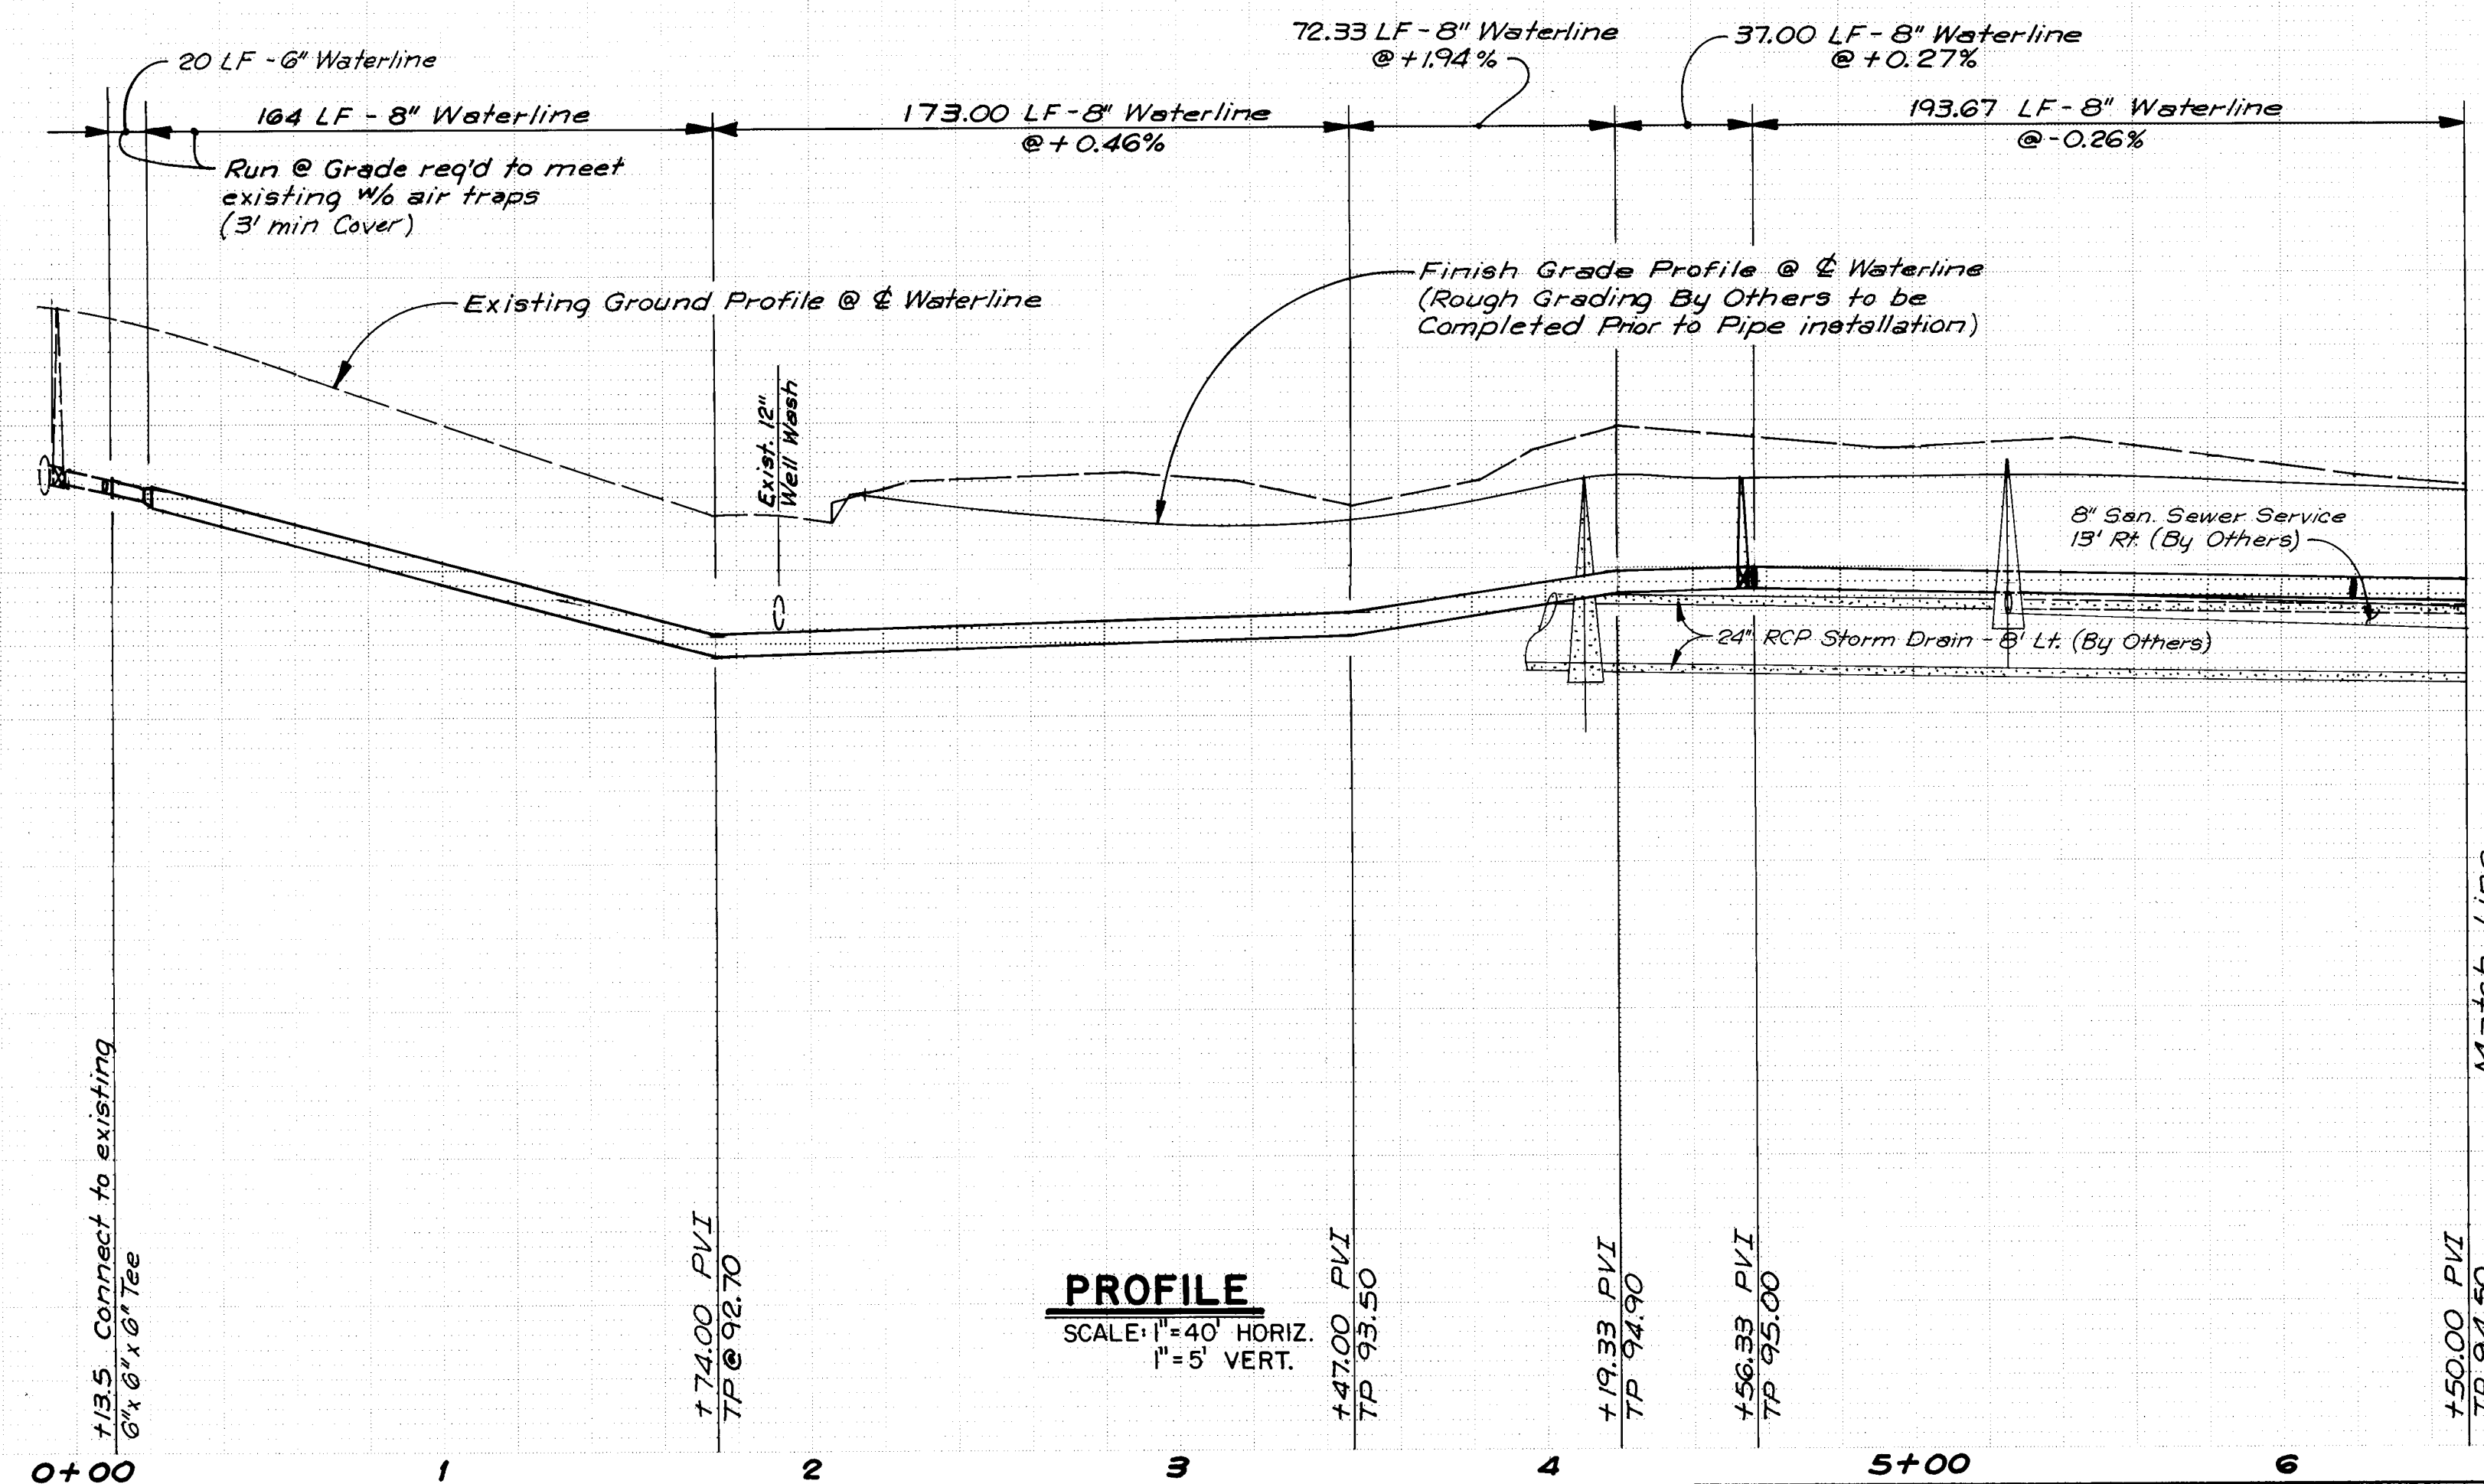

PROFILE
SCALE: 1" = 40' HORIZ.
1" = 5' VERT.


RECORD DRAWING

CITY OF ALBUQUERQUE MUNICIPAL DEVELOPMENT DEPARTMENT ENGINEERING DIVISION					
MISSION SQUARE WATERLINE EXTENSIONS WATERLINE "A" STA. 0+00 TO STA. 6+50 PLAN & PROFILE					
APPROVALS	ENGINEER	DATE	APPROVALS	ENGINEER	DATE
City Engineer	<i>[Signature]</i>	1/19/85	Liquid Waste	<i>[Signature]</i>	1/23/85
A.C.E. - Design	<i>[Signature]</i>	2/18/85	Traffic	<i>[Signature]</i>	1/23/85
Hydrology	<i>[Signature]</i>	1/23/85	Water	<i>[Signature]</i>	1/23/85



AS BUILT INFORMATION		BENCH MARKS		SURVEY INFORMATION		ENGINEER'S SEAL	
CONTRACTOR	DATE	STAKE	DATE	NO.	BY	NO.	BY
New Concepts, Inc.	4/1/85	ACS Sta. 5-121A, Elevation 5594.296	4/1/85				
INSPECTOR	DATE	STAKE	DATE				
FIELD	DATE	STAKE	DATE				
VERIFICATION BY	DATE	STAKE	DATE				
CORRECTED BY	DATE	STAKE	DATE				
MICRO-FILM INFORMATION	DATE	STAKE	DATE				
RECORDED BY	DATE	STAKE	DATE				
NO.	DATE	STAKE	DATE				

JOHN A. ANDREWS
 REGISTERED PROFESSIONAL ENGINEER
 STATE OF NEW MEXICO
 NO. 84-385
 ANDREWS, ASSURRY & ROBERT, INC.
 ALBUQUERQUE, NEW MEXICO

NO.	DATE	REVISIONS	BY
		DESIGN	
		JM	
		JV	
		JA	
		DATE Nov, 1984	
		DATE Nov, 1984	
		DATE Nov, 1984	

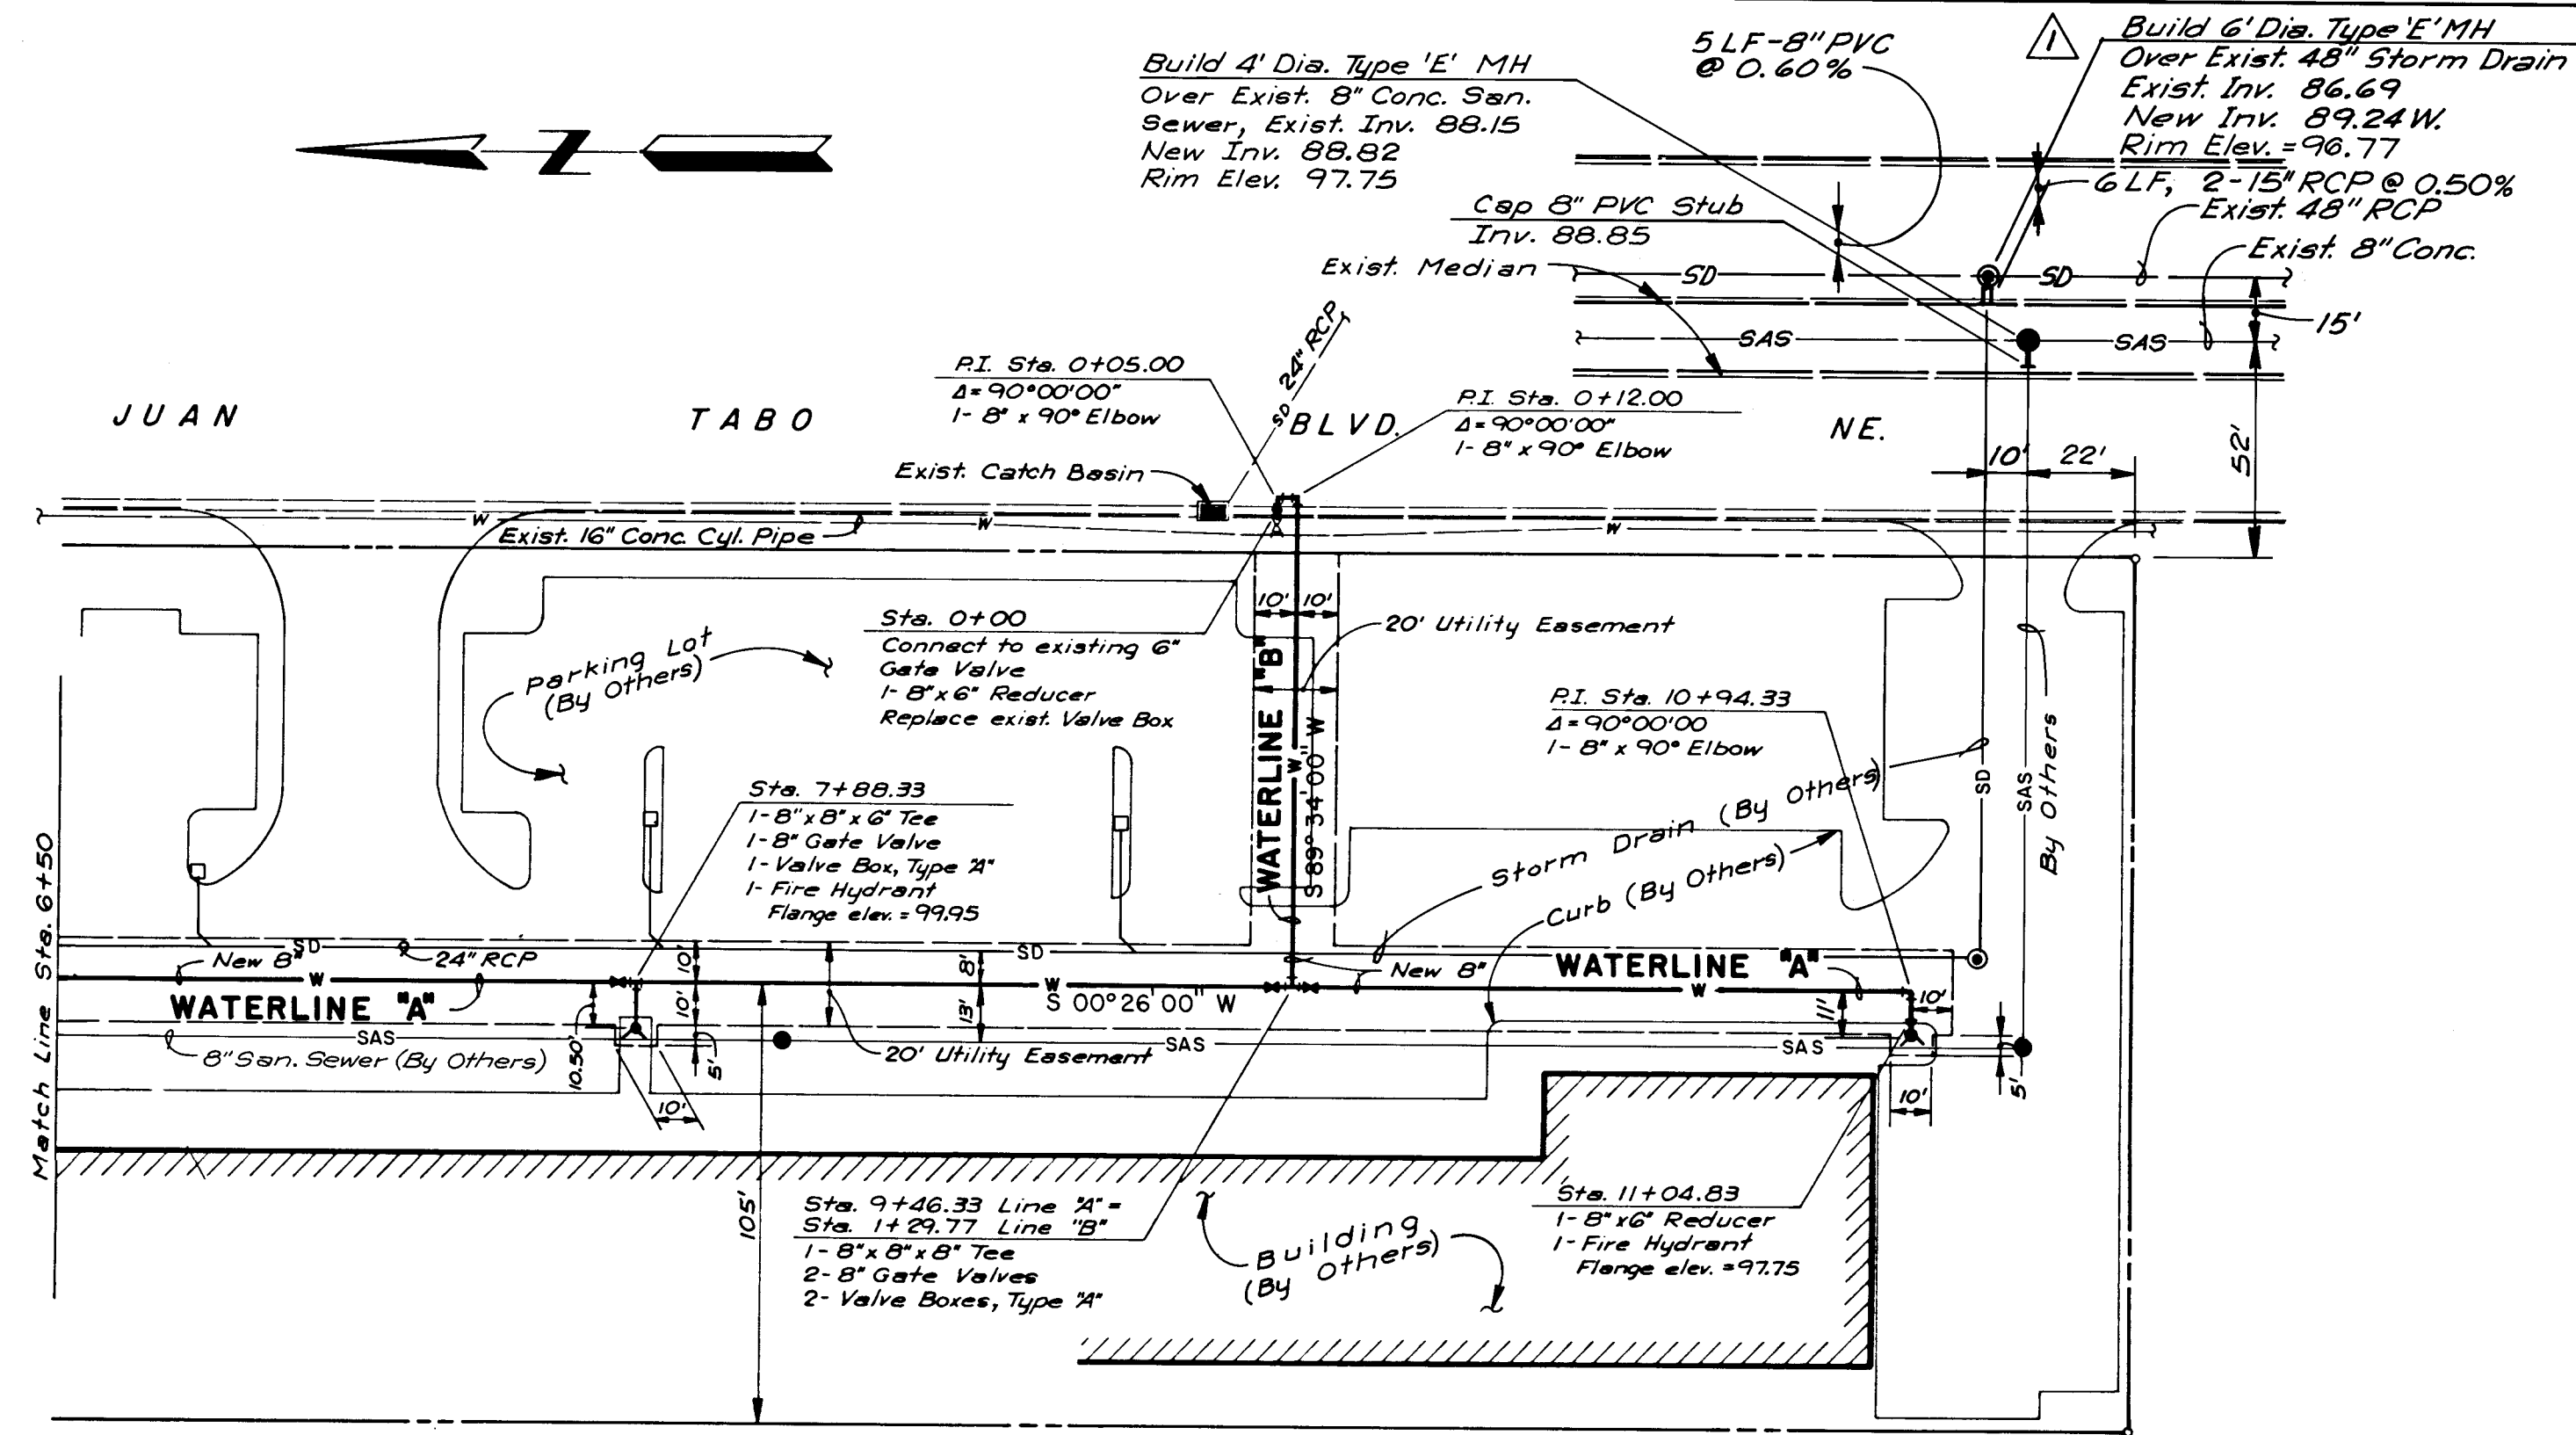


PLAN
SCALE: 1" = 40'

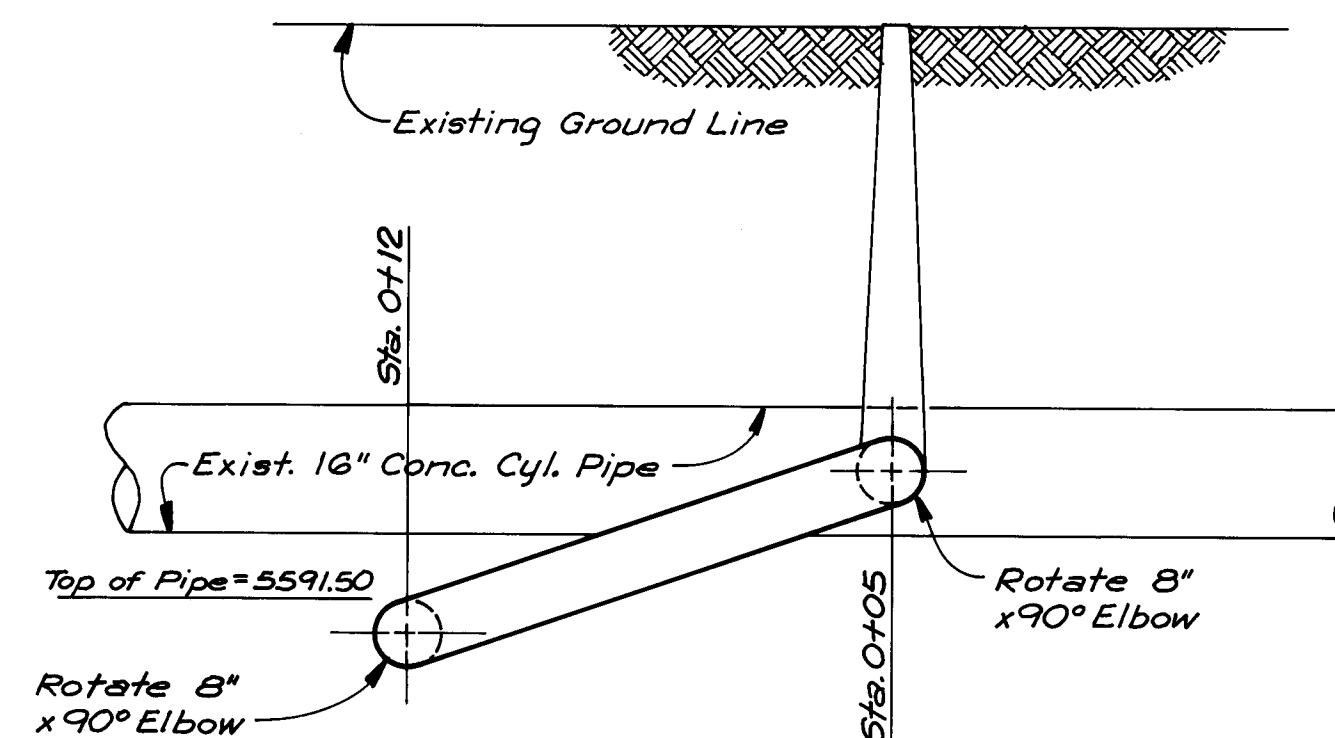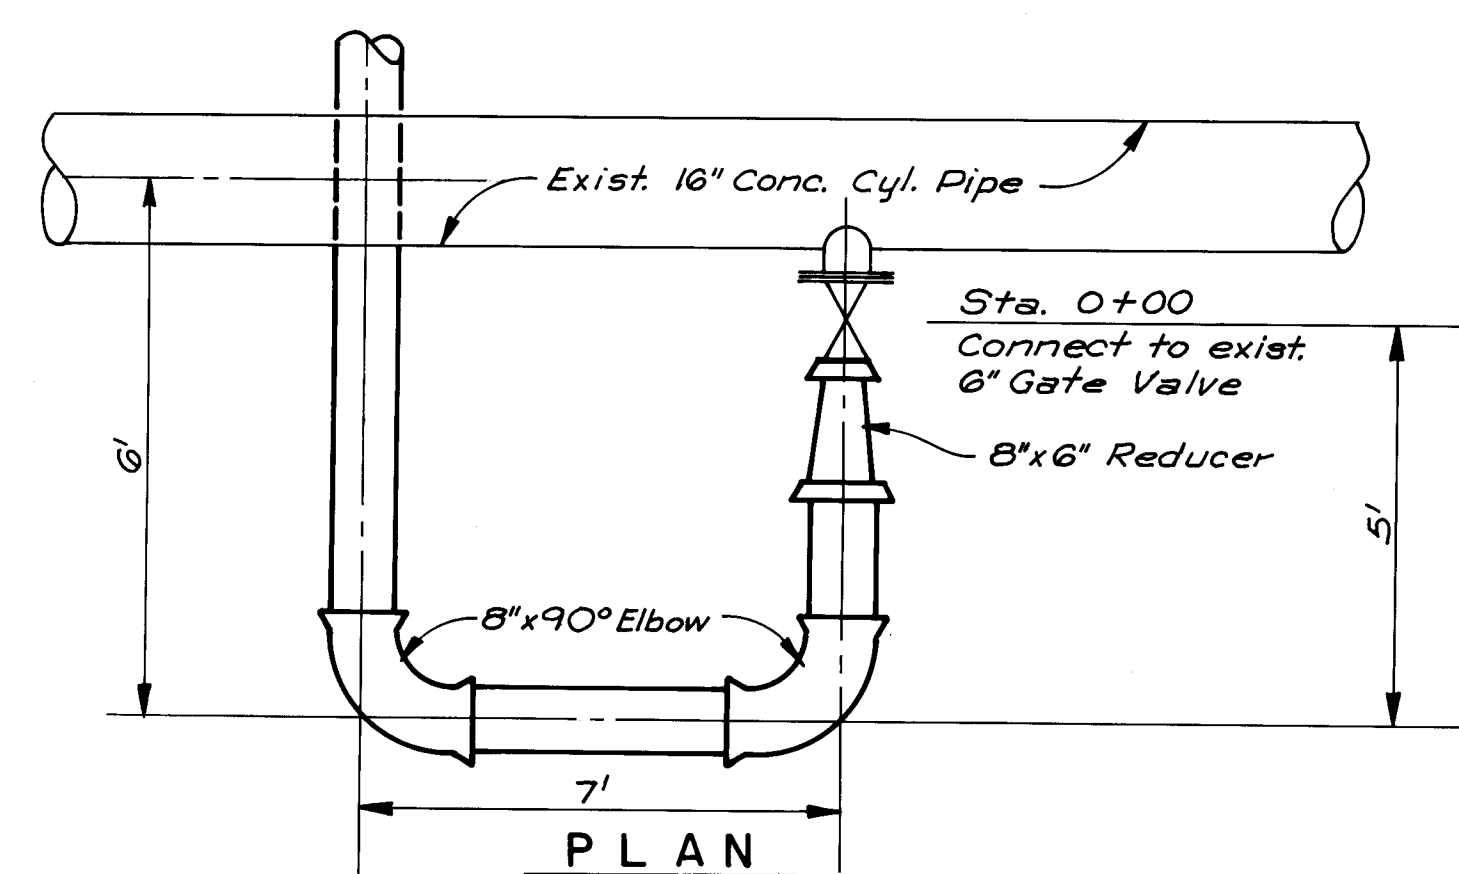


SECTION
CONNECTION DETAIL - WATERLINE 'B'
SCALE: 1/2" = 1'-0"

WATERLINE "A" STA. 6+50 TO STA. 11+04.83

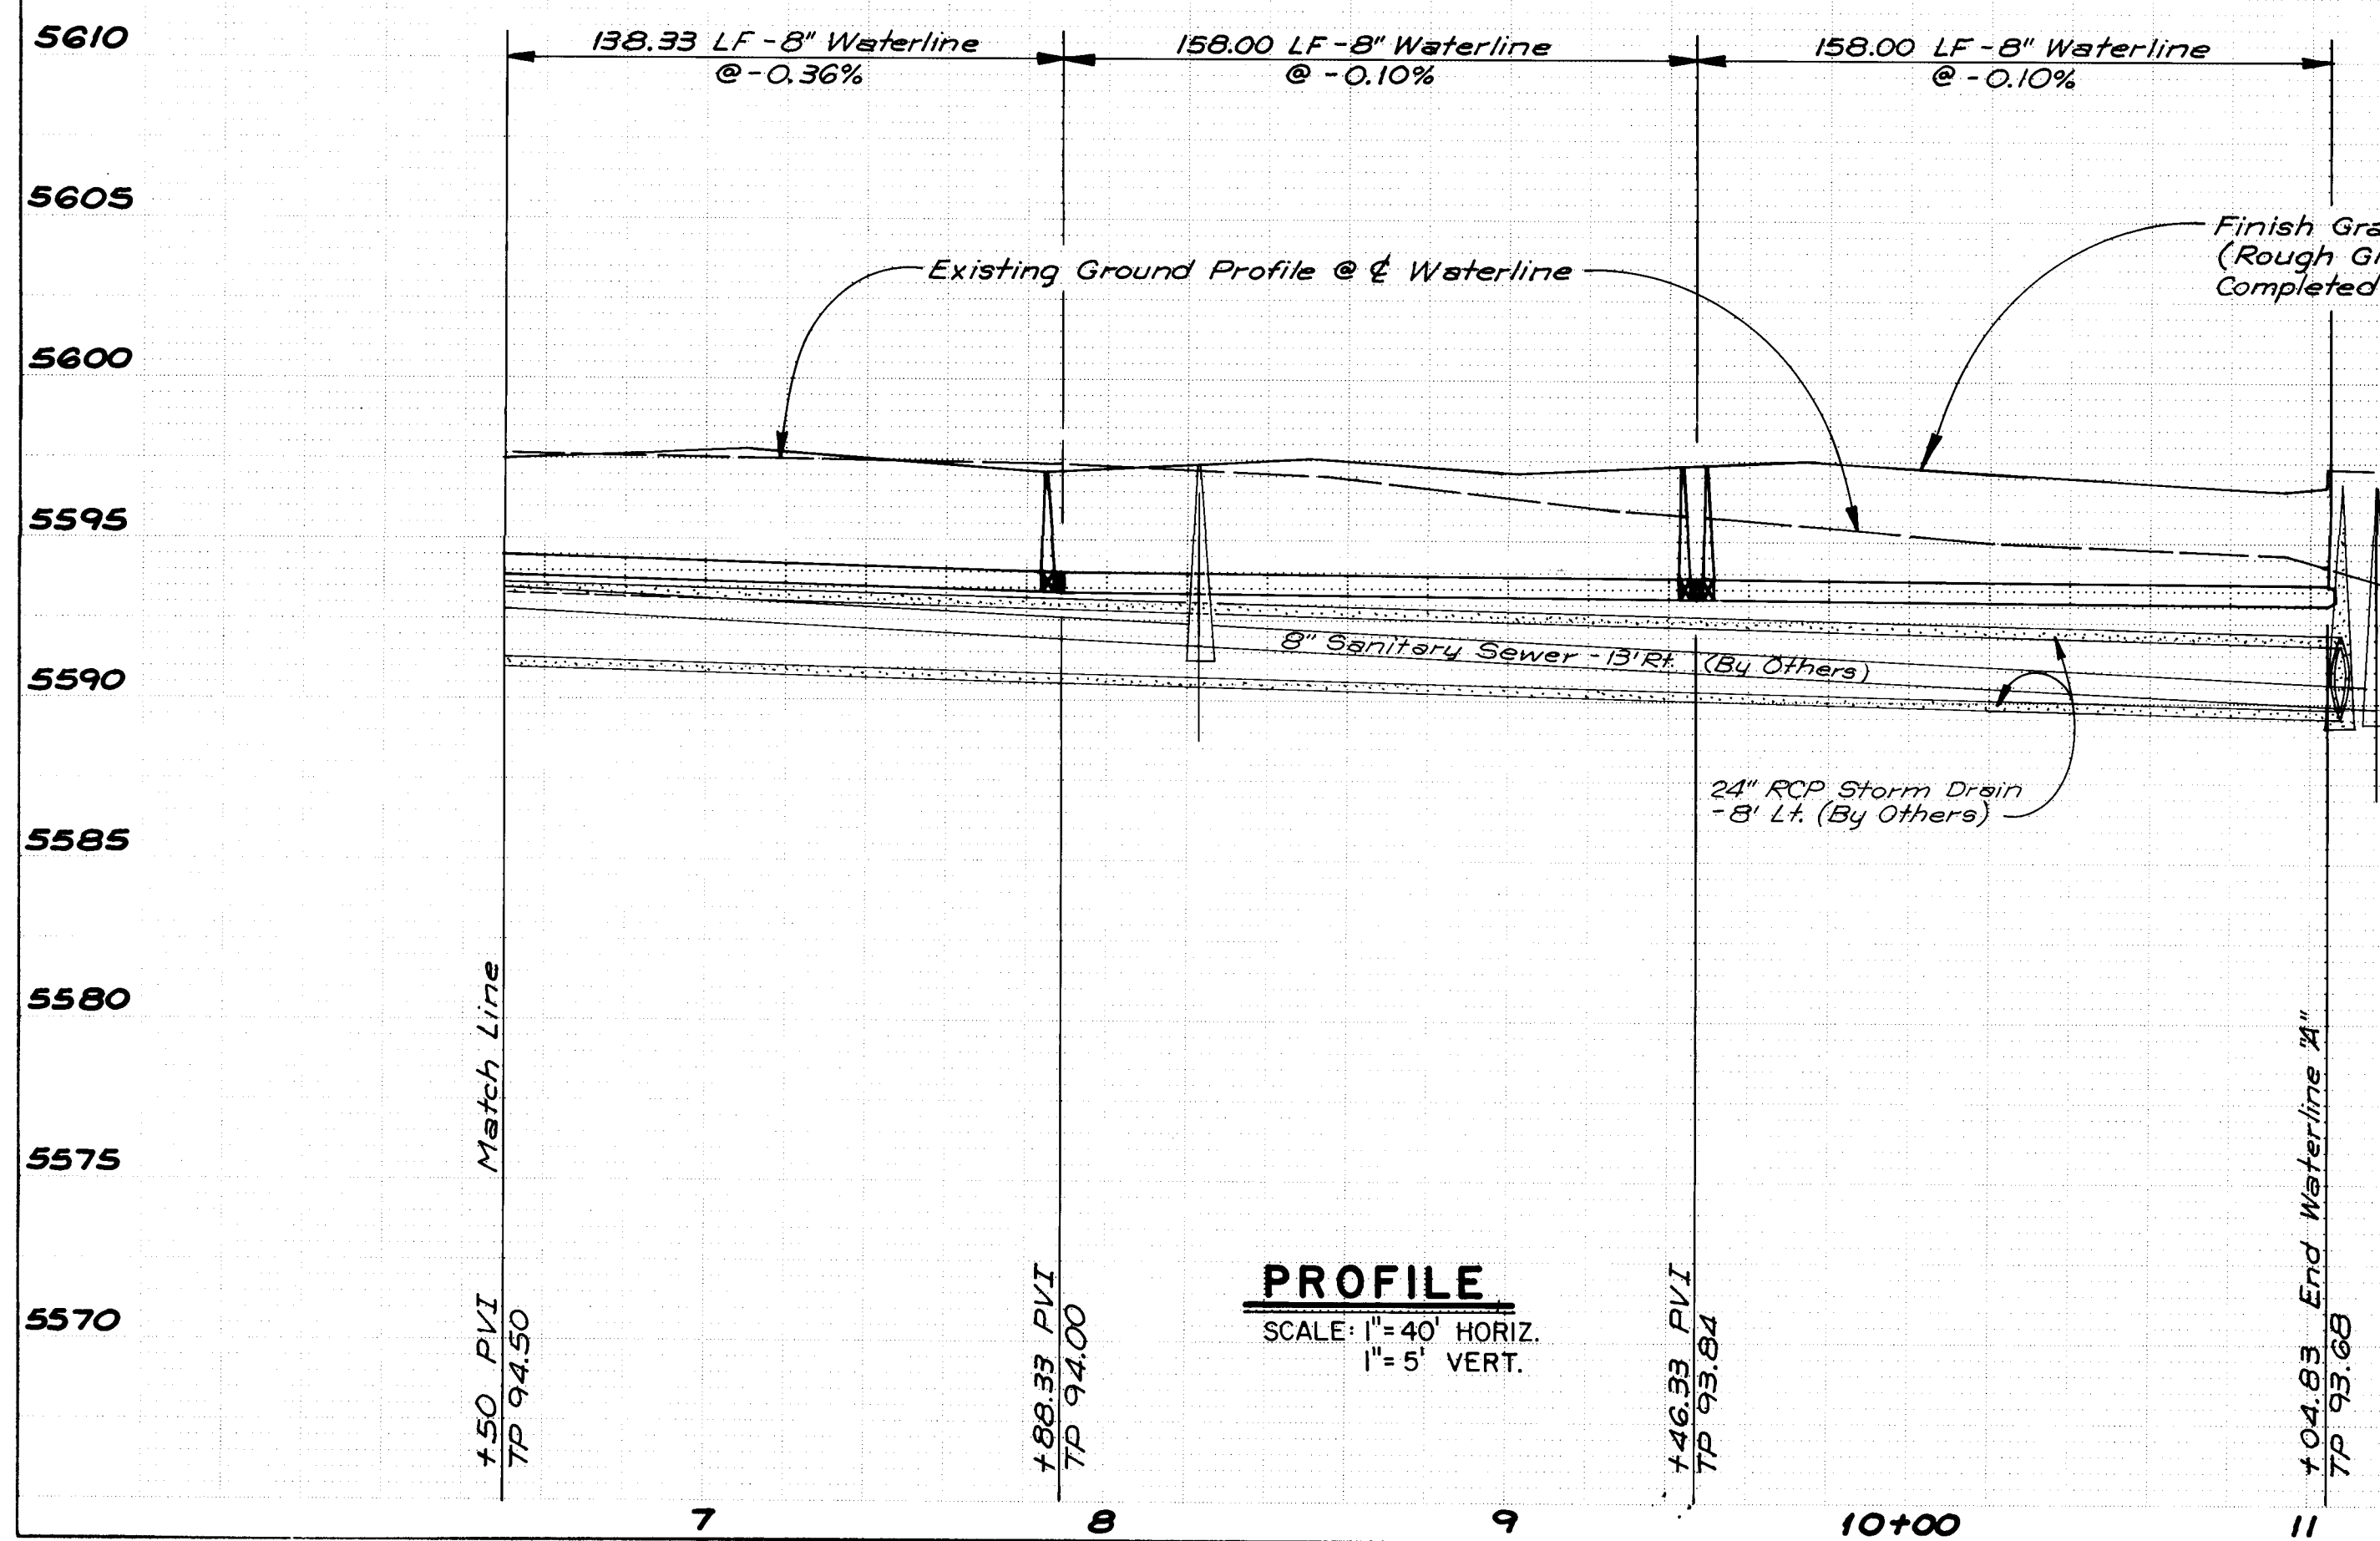

PROFILE
SCALE: 1" = 40' HORIZ.
1" = 5' VERT.

WATERLINE "B"

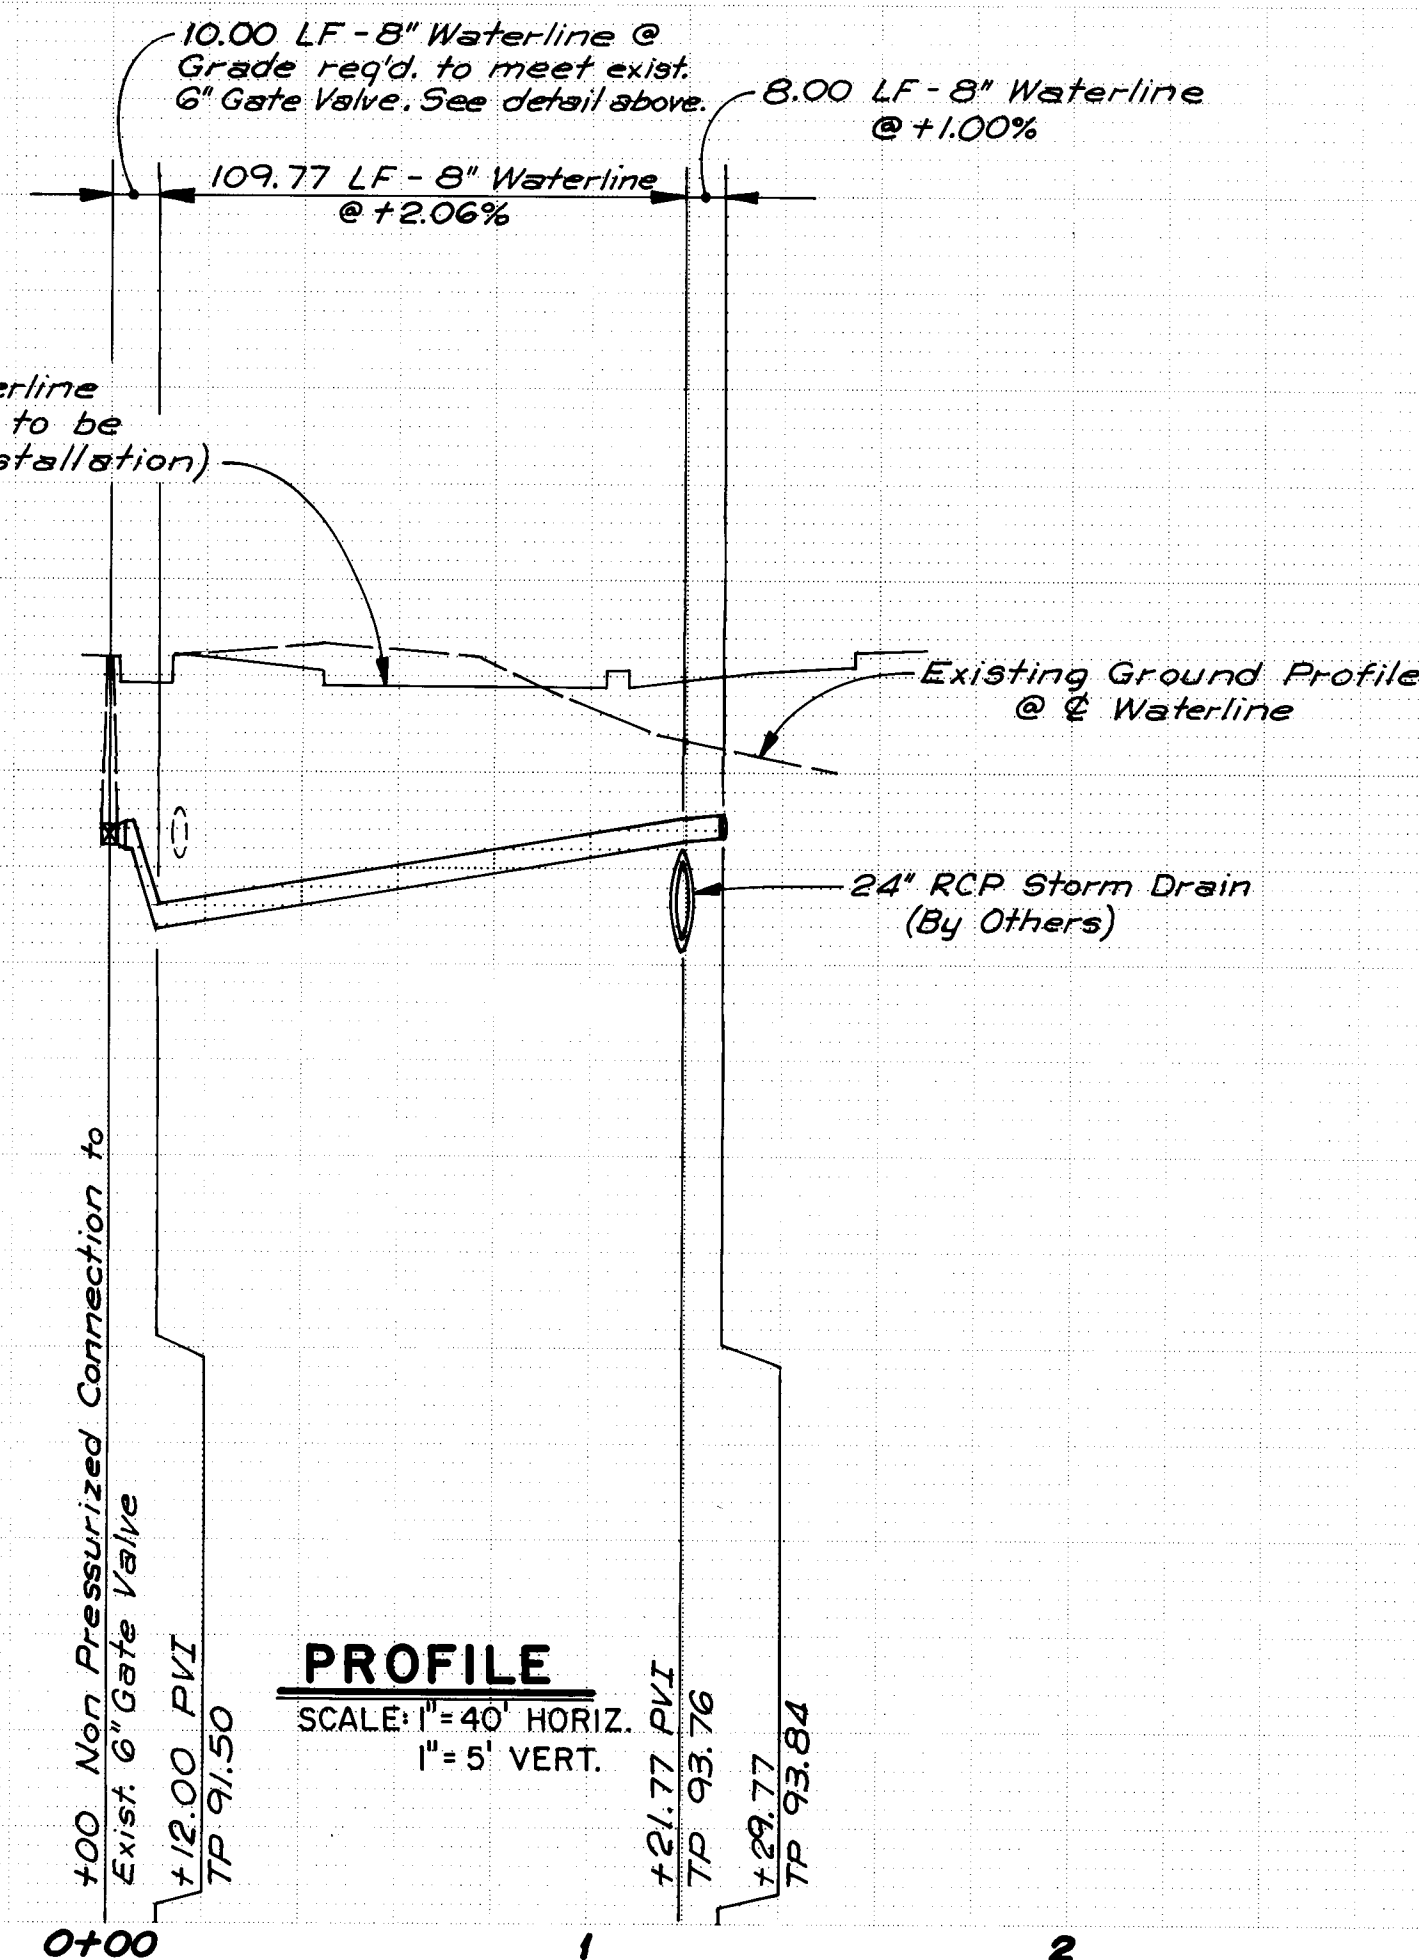

PROFILE
SCALE: 1" = 40' HORIZ.
1" = 5' VERT.

NOTE:
The Contractor must submit a Traffic Control Plan and receive a Barricading Permit prior to construction in Juan Tabo Blvd.

AS BUILT INFORMATION		BENCH MARKS		SURVEY INFORMATION		ENGINEER'S SEAL	
CONTRACTOR	DATE	NO.	BY	NO.	BY	NO.	BY
CONTRACTOR: New Concepts, Inc.	DATE: 4/85	NO.:	BY:	NO.:	BY:	NO.:	BY:
WORK BY: A.A.R.	DATE: 4/85	NO.:	BY:	NO.:	BY:	NO.:	BY:
INSPECTOR'S: A.A.R.	DATE: 4/85	NO.:	BY:	NO.:	BY:	NO.:	BY:
FIELD NOTES: A.A.R.	DATE: 4/85	NO.:	BY:	NO.:	BY:	NO.:	BY:
DRAWINGS: A.A.R.	DATE: 4/85	NO.:	BY:	NO.:	BY:	NO.:	BY:
CONTRACT: A.A.R.	DATE: 4/85	NO.:	BY:	NO.:	BY:	NO.:	BY:
RECORD BY: A.A.R.	DATE: 4/85	NO.:	BY:	NO.:	BY:	NO.:	BY:

CITY OF ALBUQUERQUE MUNICIPAL DEVELOPMENT DEPARTMENT ENGINEERING DIVISION			
MISSION SQUARE WATERLINE EXTENSIONS WATERLINE "A" STA. 6+50 TO STA. 11+04.83 & WATERLINE "B" PLAN & PROFILE			
APPROVALS	ENGINEER	DATE	APPROVALS
CITY ENGINEER	DATE: 1/23/85	LIQUID WASTE	DATE: 1/23/85
A.C.E. - Design	DATE: 1/23/85	TRAFFIC	DATE: 1/23/85
Hydrology	DATE: 1/23/85	WATER	DATE: 1/23/85

REVISIONS			
NO.	DATE	REMARKS	DESIGN
1	NOV. 1984		
2	NOV. 1984		
3	NOV. 1984		

DRAWING NO. 2336			
MAP NO. J-21			
SHEET 5 OF 5			