
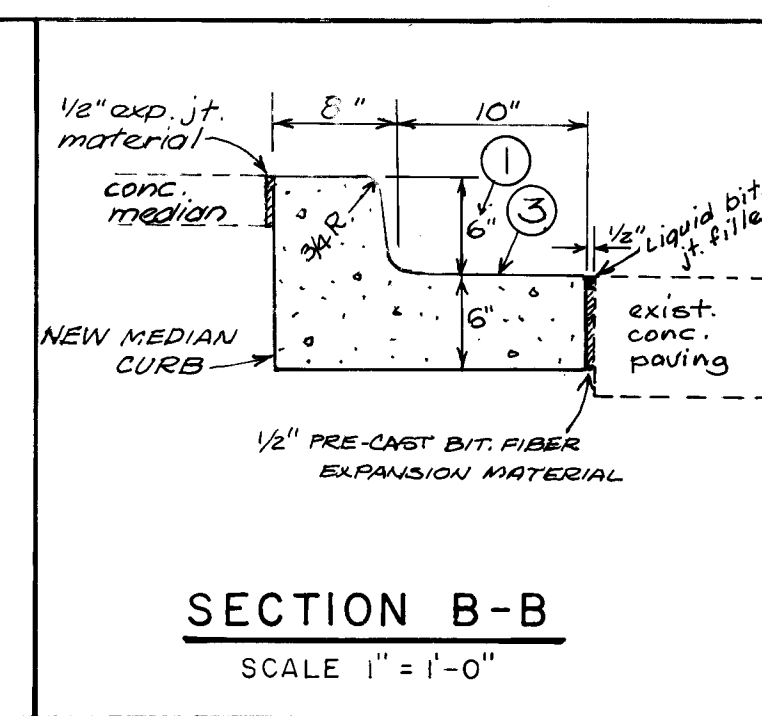
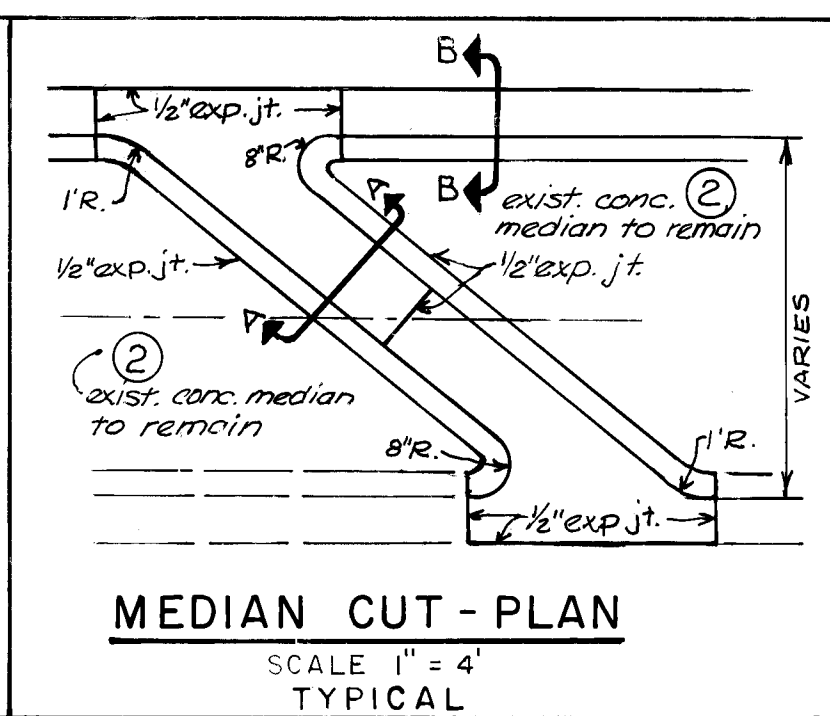
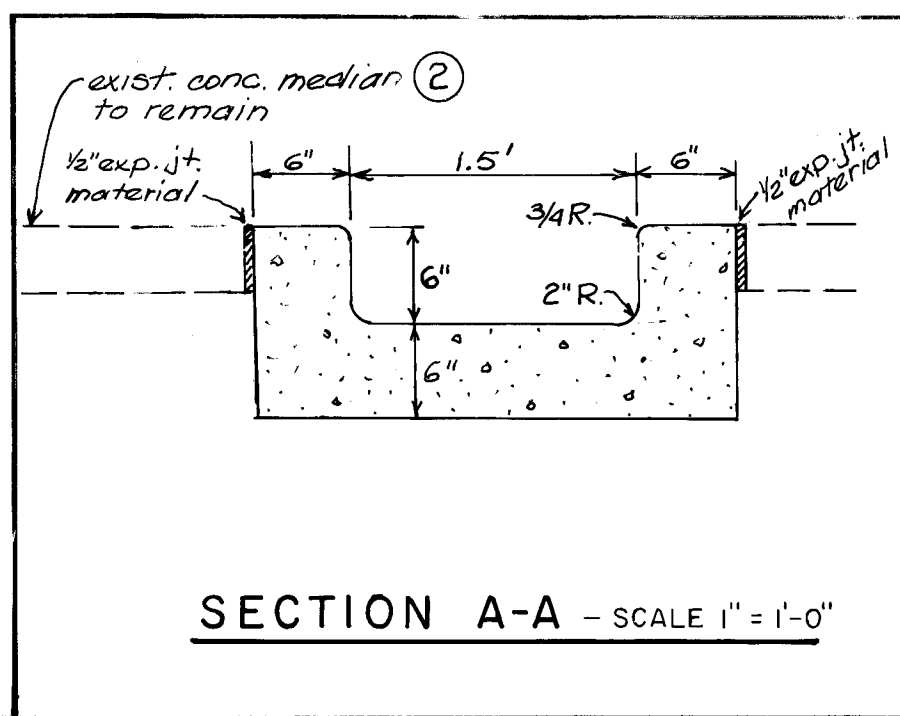


2425

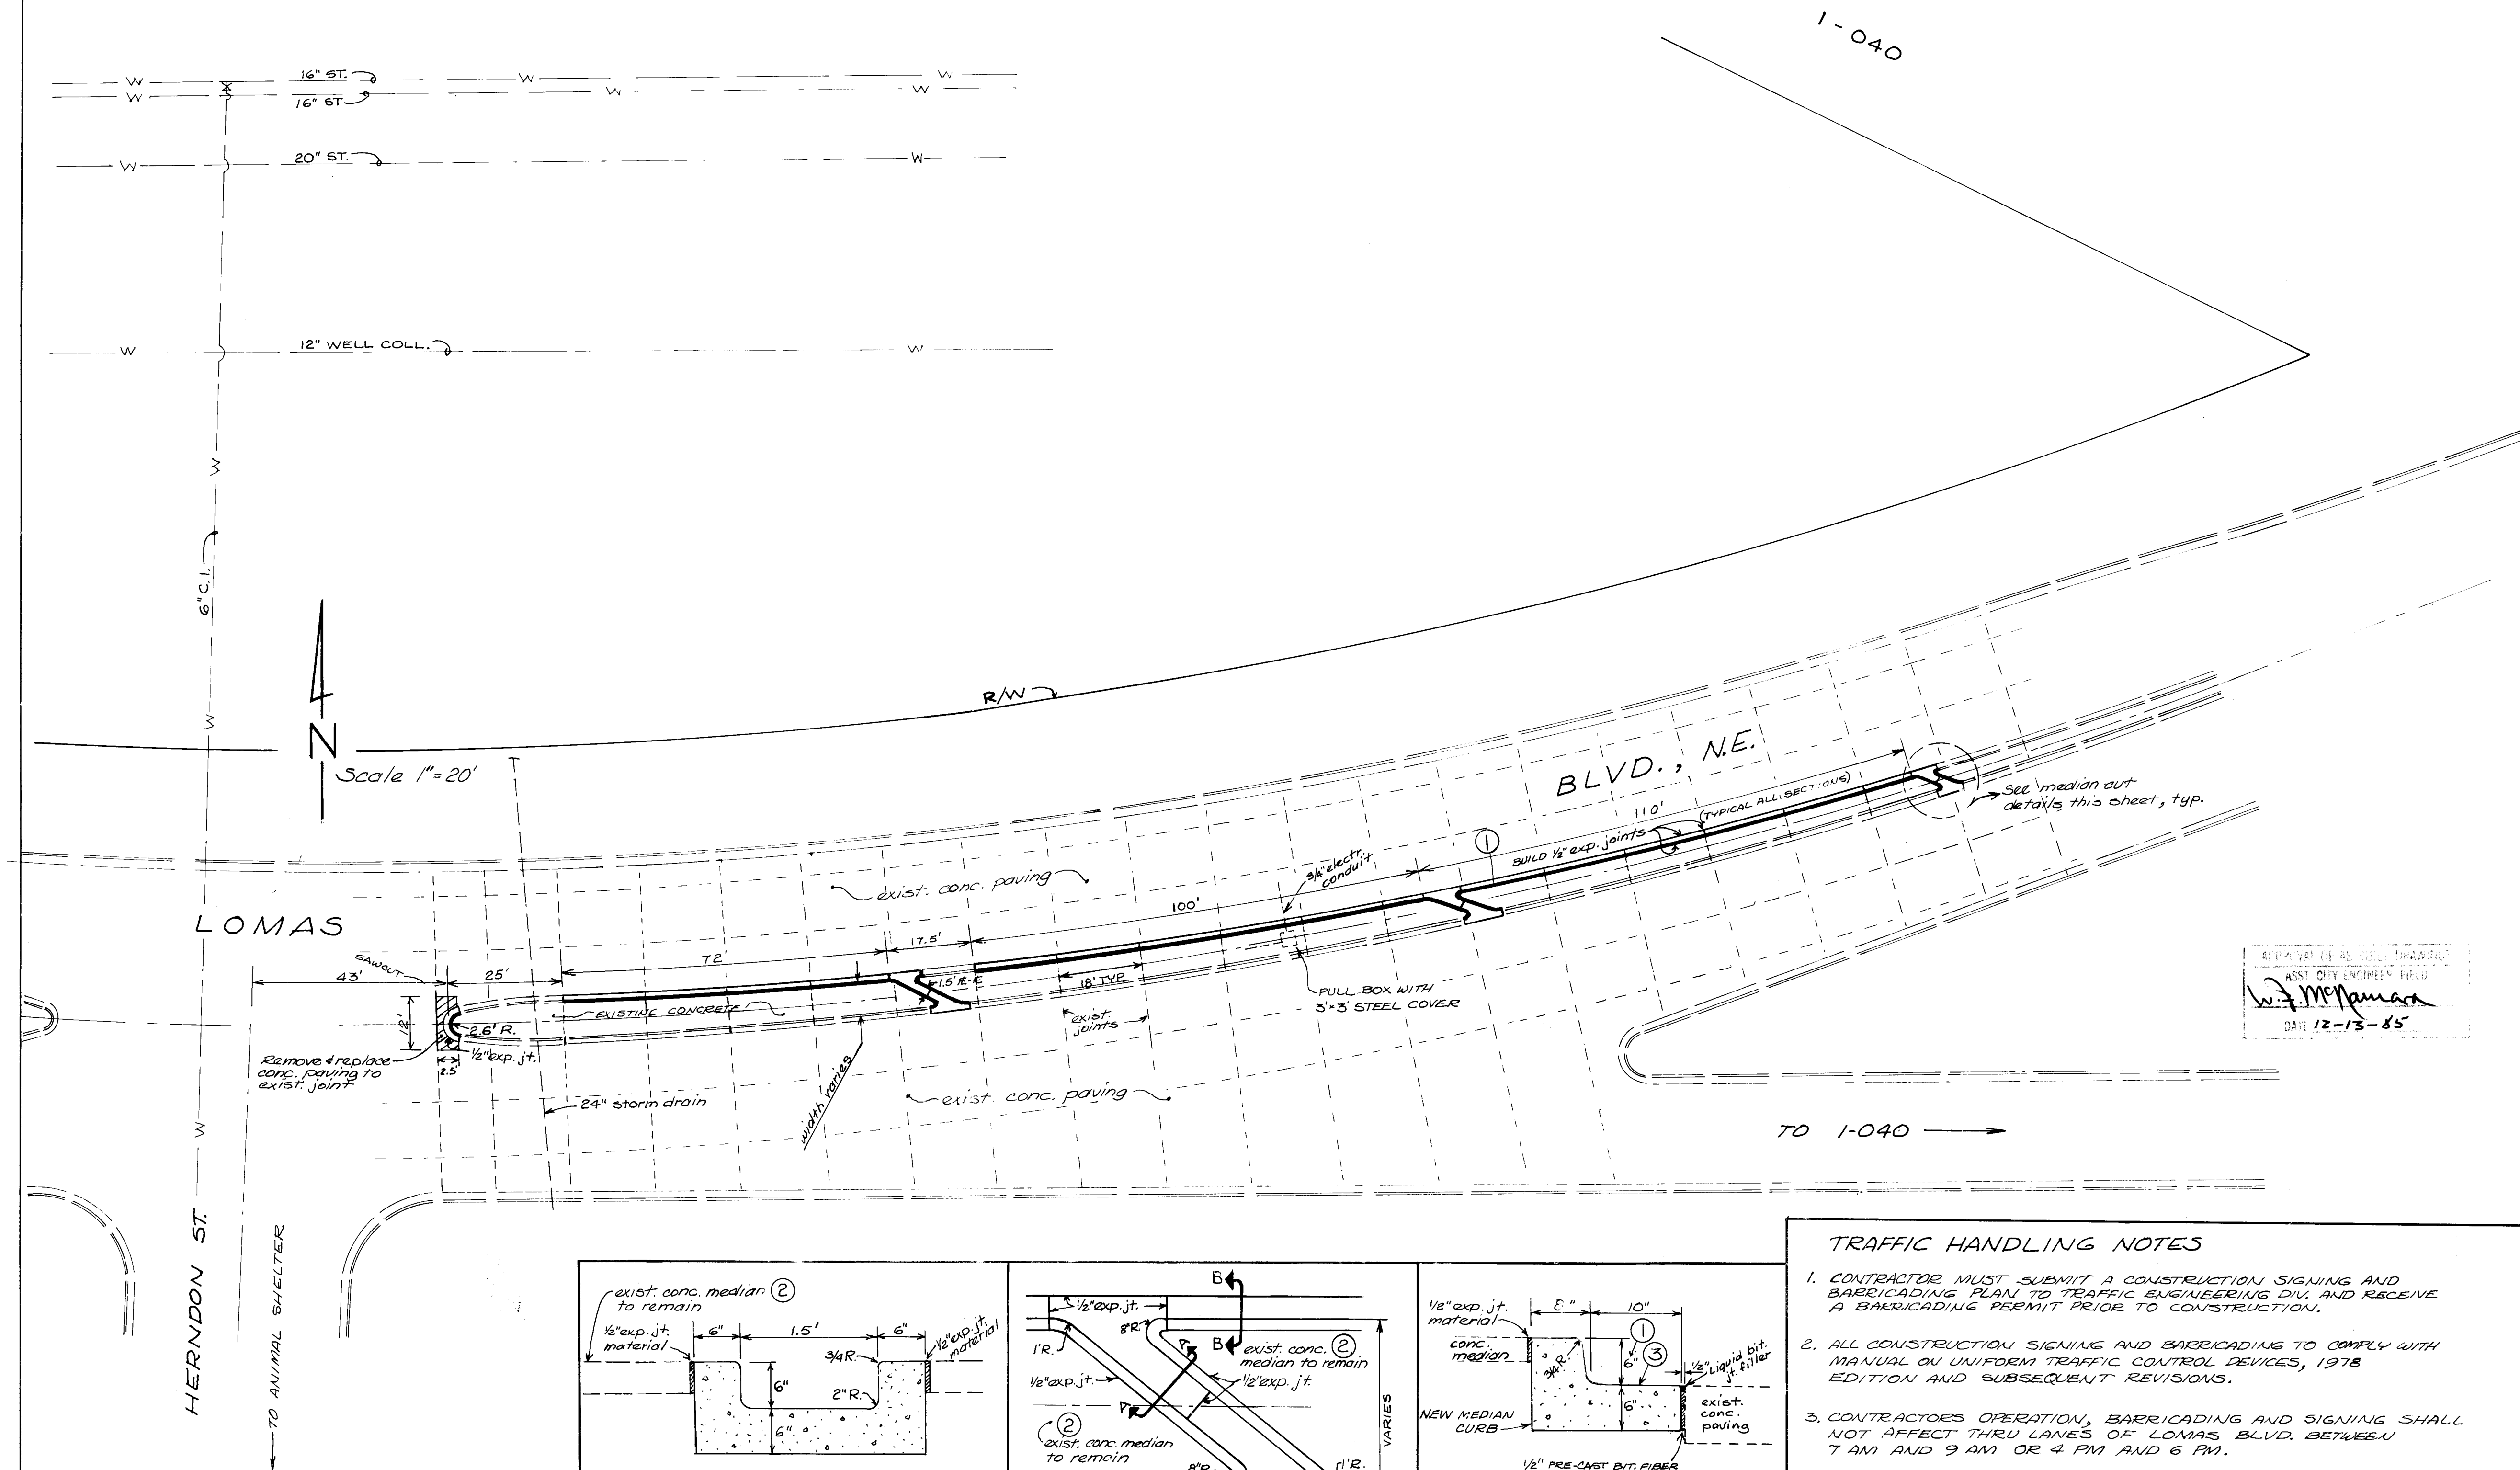

TRAFFIC HANDLING NOTES

1. CONTRACTOR MUST SUBMIT A CONSTRUCTION SIGNING AND BARRICADING PLAN TO TRAFFIC ENGINEERING DIV. AND RECEIVE A BARRICADING PERMIT PRIOR TO CONSTRUCTION.
2. ALL CONSTRUCTION SIGNING AND BARRICADING TO COMPLY WITH MANUAL ON UNIFORM TRAFFIC CONTROL DEVICES, 1978 EDITION AND SUBSEQUENT REVISIONS.
3. CONTRACTORS OPERATION, BARRICADING AND SIGNING SHALL NOT AFFECT THRU LANES OF LOMAS BLVD. BETWEEN 7 AM AND 9 AM OR 4 PM AND 6 PM.

BLVD.

LOMAS

PROJECT SITE

BLVD.

HERNDON ST.

LOCATION MAP

ZONE MAP J-20 M.A.

NOT TO SCALE

NOTICE TO CONTRACTORS

1. All work detailed on these plans to be performed under contract shall, except as otherwise stated or provided for hereon, be constructed in accordance with the City of Albuquerque Interim Std. Specifications Public Works Construction- 1985. (referred to herein as the Standard Specifications) and the Contract Documents for Public Works Contract 85-4.

2. Two (2) working days prior to any excavation, the contractor must contact Line Locating Service, 765-1234, for location of existing utilities.

3. Prior to construction, the contractor shall excavate and verify the horizontal and vertical locations of all obstructions. Should a conflict exist, the contractor shall notify the engineer or surveyor so that the conflict can be resolved with minimum amount of delay.

THE FOLLOWING NOTES ALSO APPLY WHEN CHECKED

☐ All utilities and utility service lines shall be installed prior to paving.

☒ Backfill compaction shall be according to specified street use. (Arterial)

☐ Tack coat requirements shall be determined by the City Engineer.

☐ Sidewalks and wheelchair ramps within the curb returns shall be constructed wherever a new curb return is constructed.

☐ If curb is depressed for a driveway or a handicap ramp, the driveway or ramp shall be constructed prior to acceptance of the curb and gutter.

☐ All storm drainage facilities shall be completed prior to final acceptance.

LEGEND

REMOVE & REPLACE EXIST. CURB

EXISTING CURB

NOTES

① REMOVE EXISTING CONC. MEDIAN CURB AS SHOWN ON PLAN. BUILD NEW CONC. MEDIAN CURB PER ALB. STD. DWG. P-8 TO MATCH EXISTING CONC. PAVING AND CONC. MEDIAN. INCREASE HEIGHT OF NEW CURB WHERE REQUIRED TO MATCH EXISTING MEDIAN.

② SAWCUT EXISTING CONC. MEDIAN IF REQUIRED FOR STD. 18" WIDE MEDIAN CURB. REMOVE AND REPLACE EXISTING MEDIAN IF DAMAGED.

③ SLOPE OF NEW GUTTER SHALL MATCH SLOPE OF EXISTING CONC. PAVING.

26 23430185

AS BUILT INFORMATION

CONTRACTOR: Cook Construction

INSPECTED BY: [Signature]

DATE: [Blank]

FILED: [Blank]

DATE: [Blank]

VERIFICATION BY: [Blank]

DATE: [Blank]

CORRECTED BY: [Blank]

DATE: [Blank]

RECORDED BY: [Blank]

NO: [Blank]

BENCH MARKS

DATE: [Blank]

BY: [Blank]

NO: [Blank]

SURVEY INFORMATION

FIELD NOTES

DATE: [Blank]

BY: [Blank]

NO: [Blank]

ENGINEER'S SEAL

DATE: [Blank]

BY: [Blank]

NO: [Blank]

REVISIONS

DATE: [Blank]

BY: [Blank]

NO: [Blank]

DESIGNED BY: P. FISCHER

DATE: [Blank]

DRAWN BY: B. EMMETT

DATE: [Blank]

CHECKED BY: G. ROLSON

DATE: 3/85

CITY OF ALBUQUERQUE

MUNICIPAL DEVELOPMENT DEPARTMENT

ENGINEERING DIVISION

TITLE: MEDIAN CURB REPLACEMENT ON LOMAS BLVD. EAST OF HERNDON ST.

APPROVALS

ENGINEER

DATE

APPROVALS

ENGINEER

DATE

City Engineer

[Signature]

4/1/85

Liquid Waste

N.A.

4/1/85

A.C.E. - Design

[Signature]

4/1/85

Traffic

[Signature]

2/24/85

A.C.E. - Hydrology

[Signature]

2/24/85

Water

N.A.

4/1/85

ST. ENGR.

[Signature]

3/6/85

DRAWING NO.

2343

MAP NO.

J20

SHEET

1

OF

1

2425