
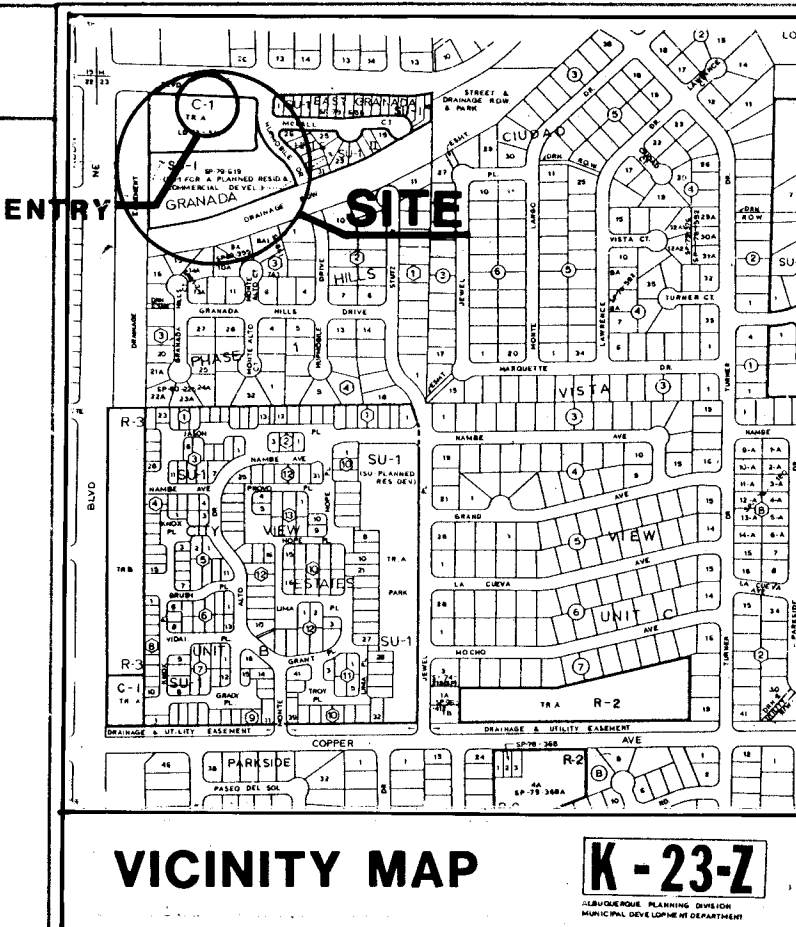


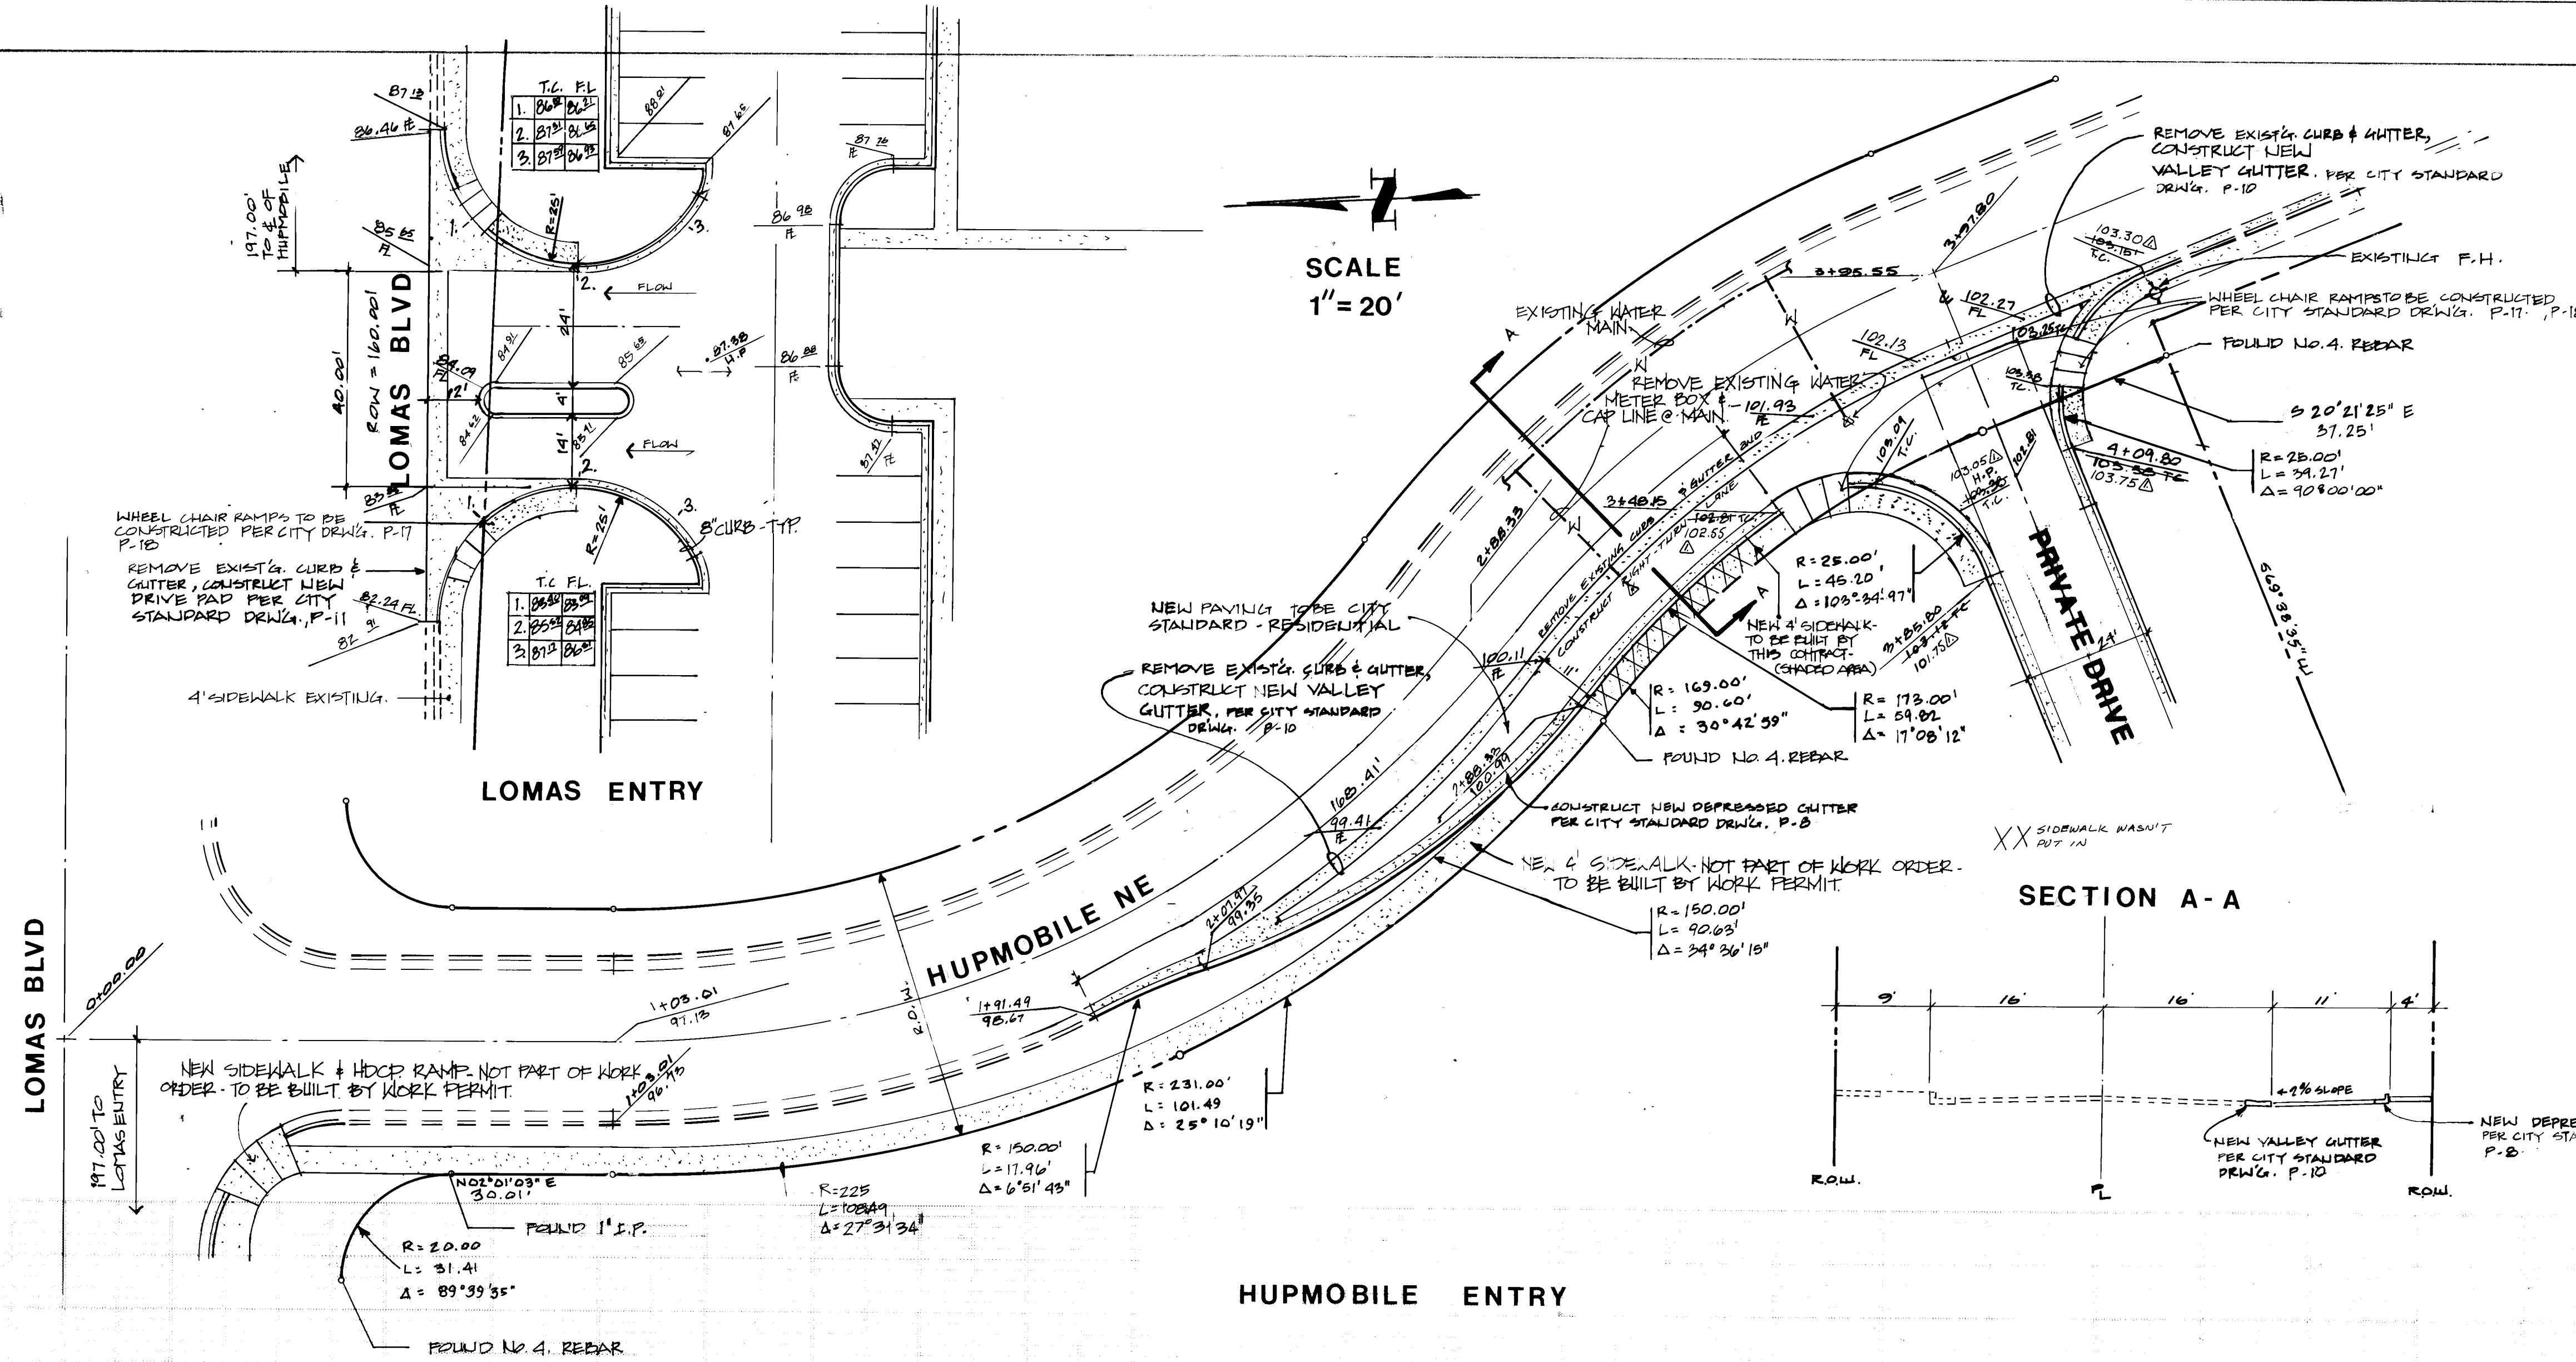

BENCH MARKS		SURVEY INFORMATION	
ACC. STATION	DATE	FIELD NOTES	DATE
LOMAS BLVD	1978	NO	NO
LOMAS BLVD	1978	NO	NO
GENERAL NOTES		REVISIONS	
NOTE:		NO	DATE
1. ALL ELEVATIONS ARE TOP OF CURB UNLESS OTHERWISE NOTED.		1	11-19-85
2. STATIONING IS BASED ON CENTER LINE STATIONING.		2	11-19-85
3. SHADE AREAS EQUAL NEW CURB & GUTTER AND VALLEY GUTTER CONSTRUCTION.		3	11-19-85
4. ENGINEER'S SEAL		4	11-19-85
5. DESIGNER'S SEAL		5	11-19-85
6. CHECKED BY		6	11-19-85
7. DRAWN BY		7	11-19-85
8. DATE		8	11-19-85
9. REMARKS		9	11-19-85
10. DESIGN		10	11-19-85

CITY OF ALBUQUERQUE		MUNICIPAL DEVELOPMENT DEPARTMENT	
ENGINEERING DIVISION		TITLE: SUNRISE APARTMENTS ENTRY WAYS	
APPROVALS	ENGINEER	DATE	APPROVALS
City Engineer	W.F. McManis	11/19/85	City Engineer
A.C.E. Design	W.F. McManis	11/19/85	A.C.E. Design
Hydrology	W.F. McManis	11/19/85	Hydrology
DRAWING NO.	2354	MAP NO.	K-23
SHEET	1	OF	1