
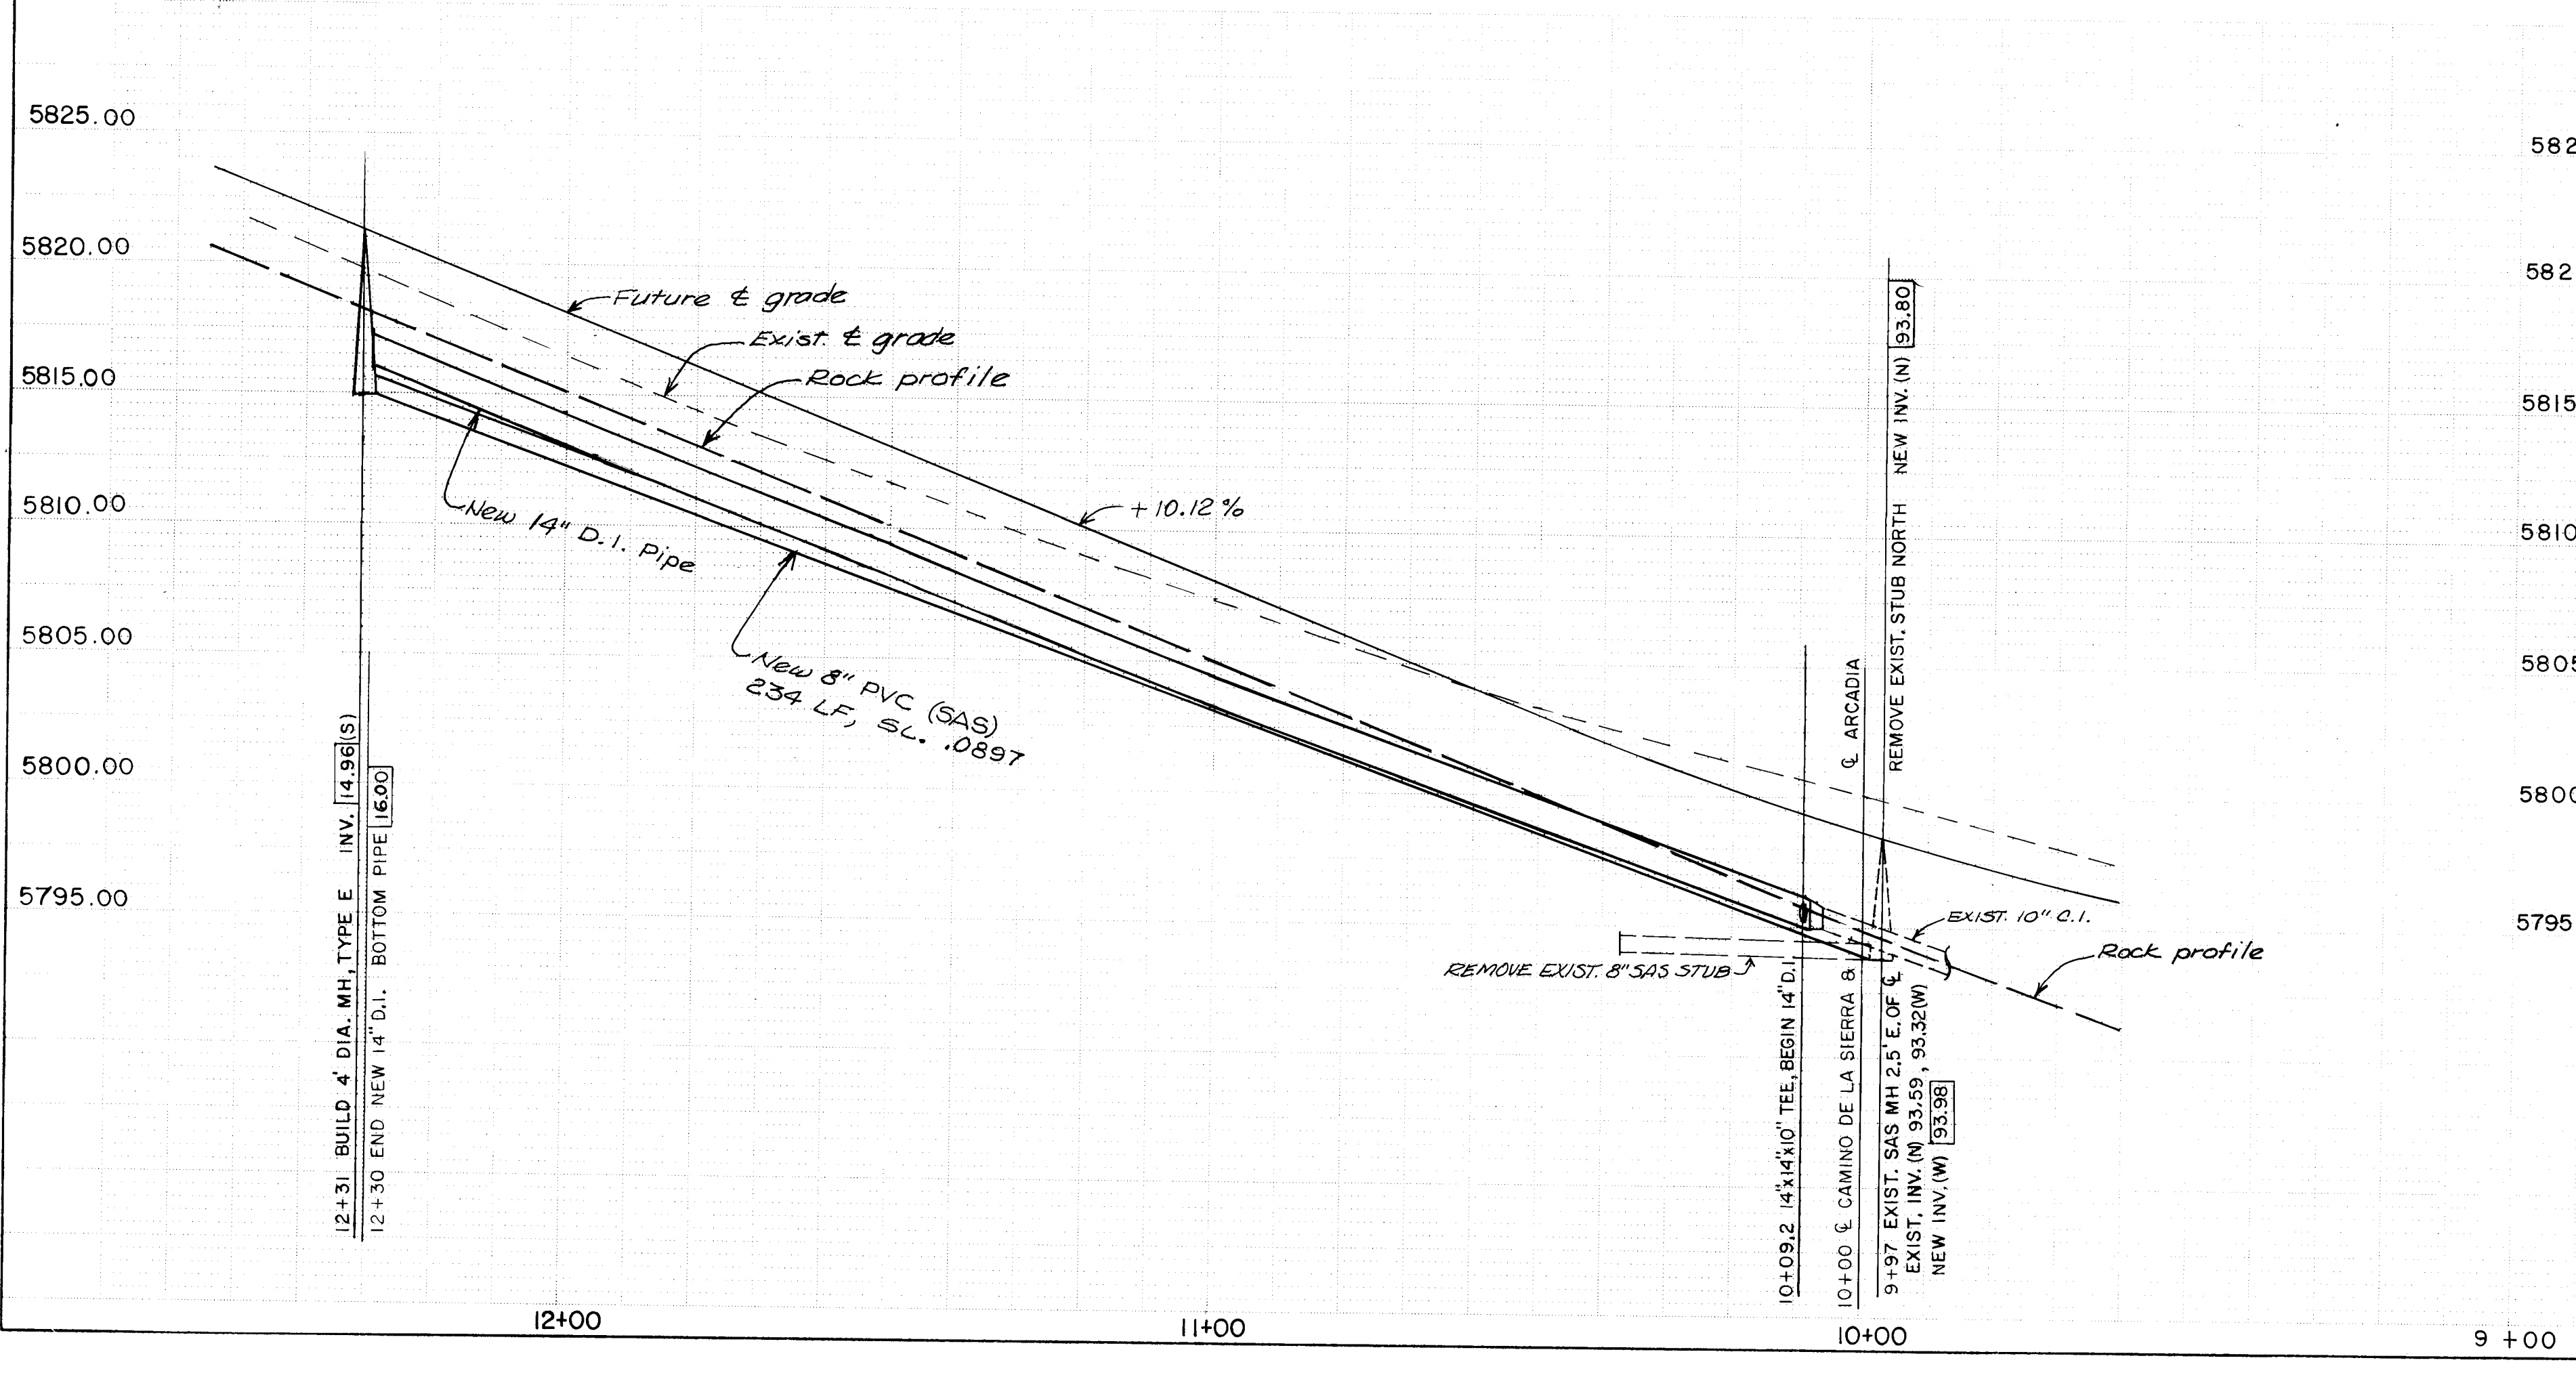


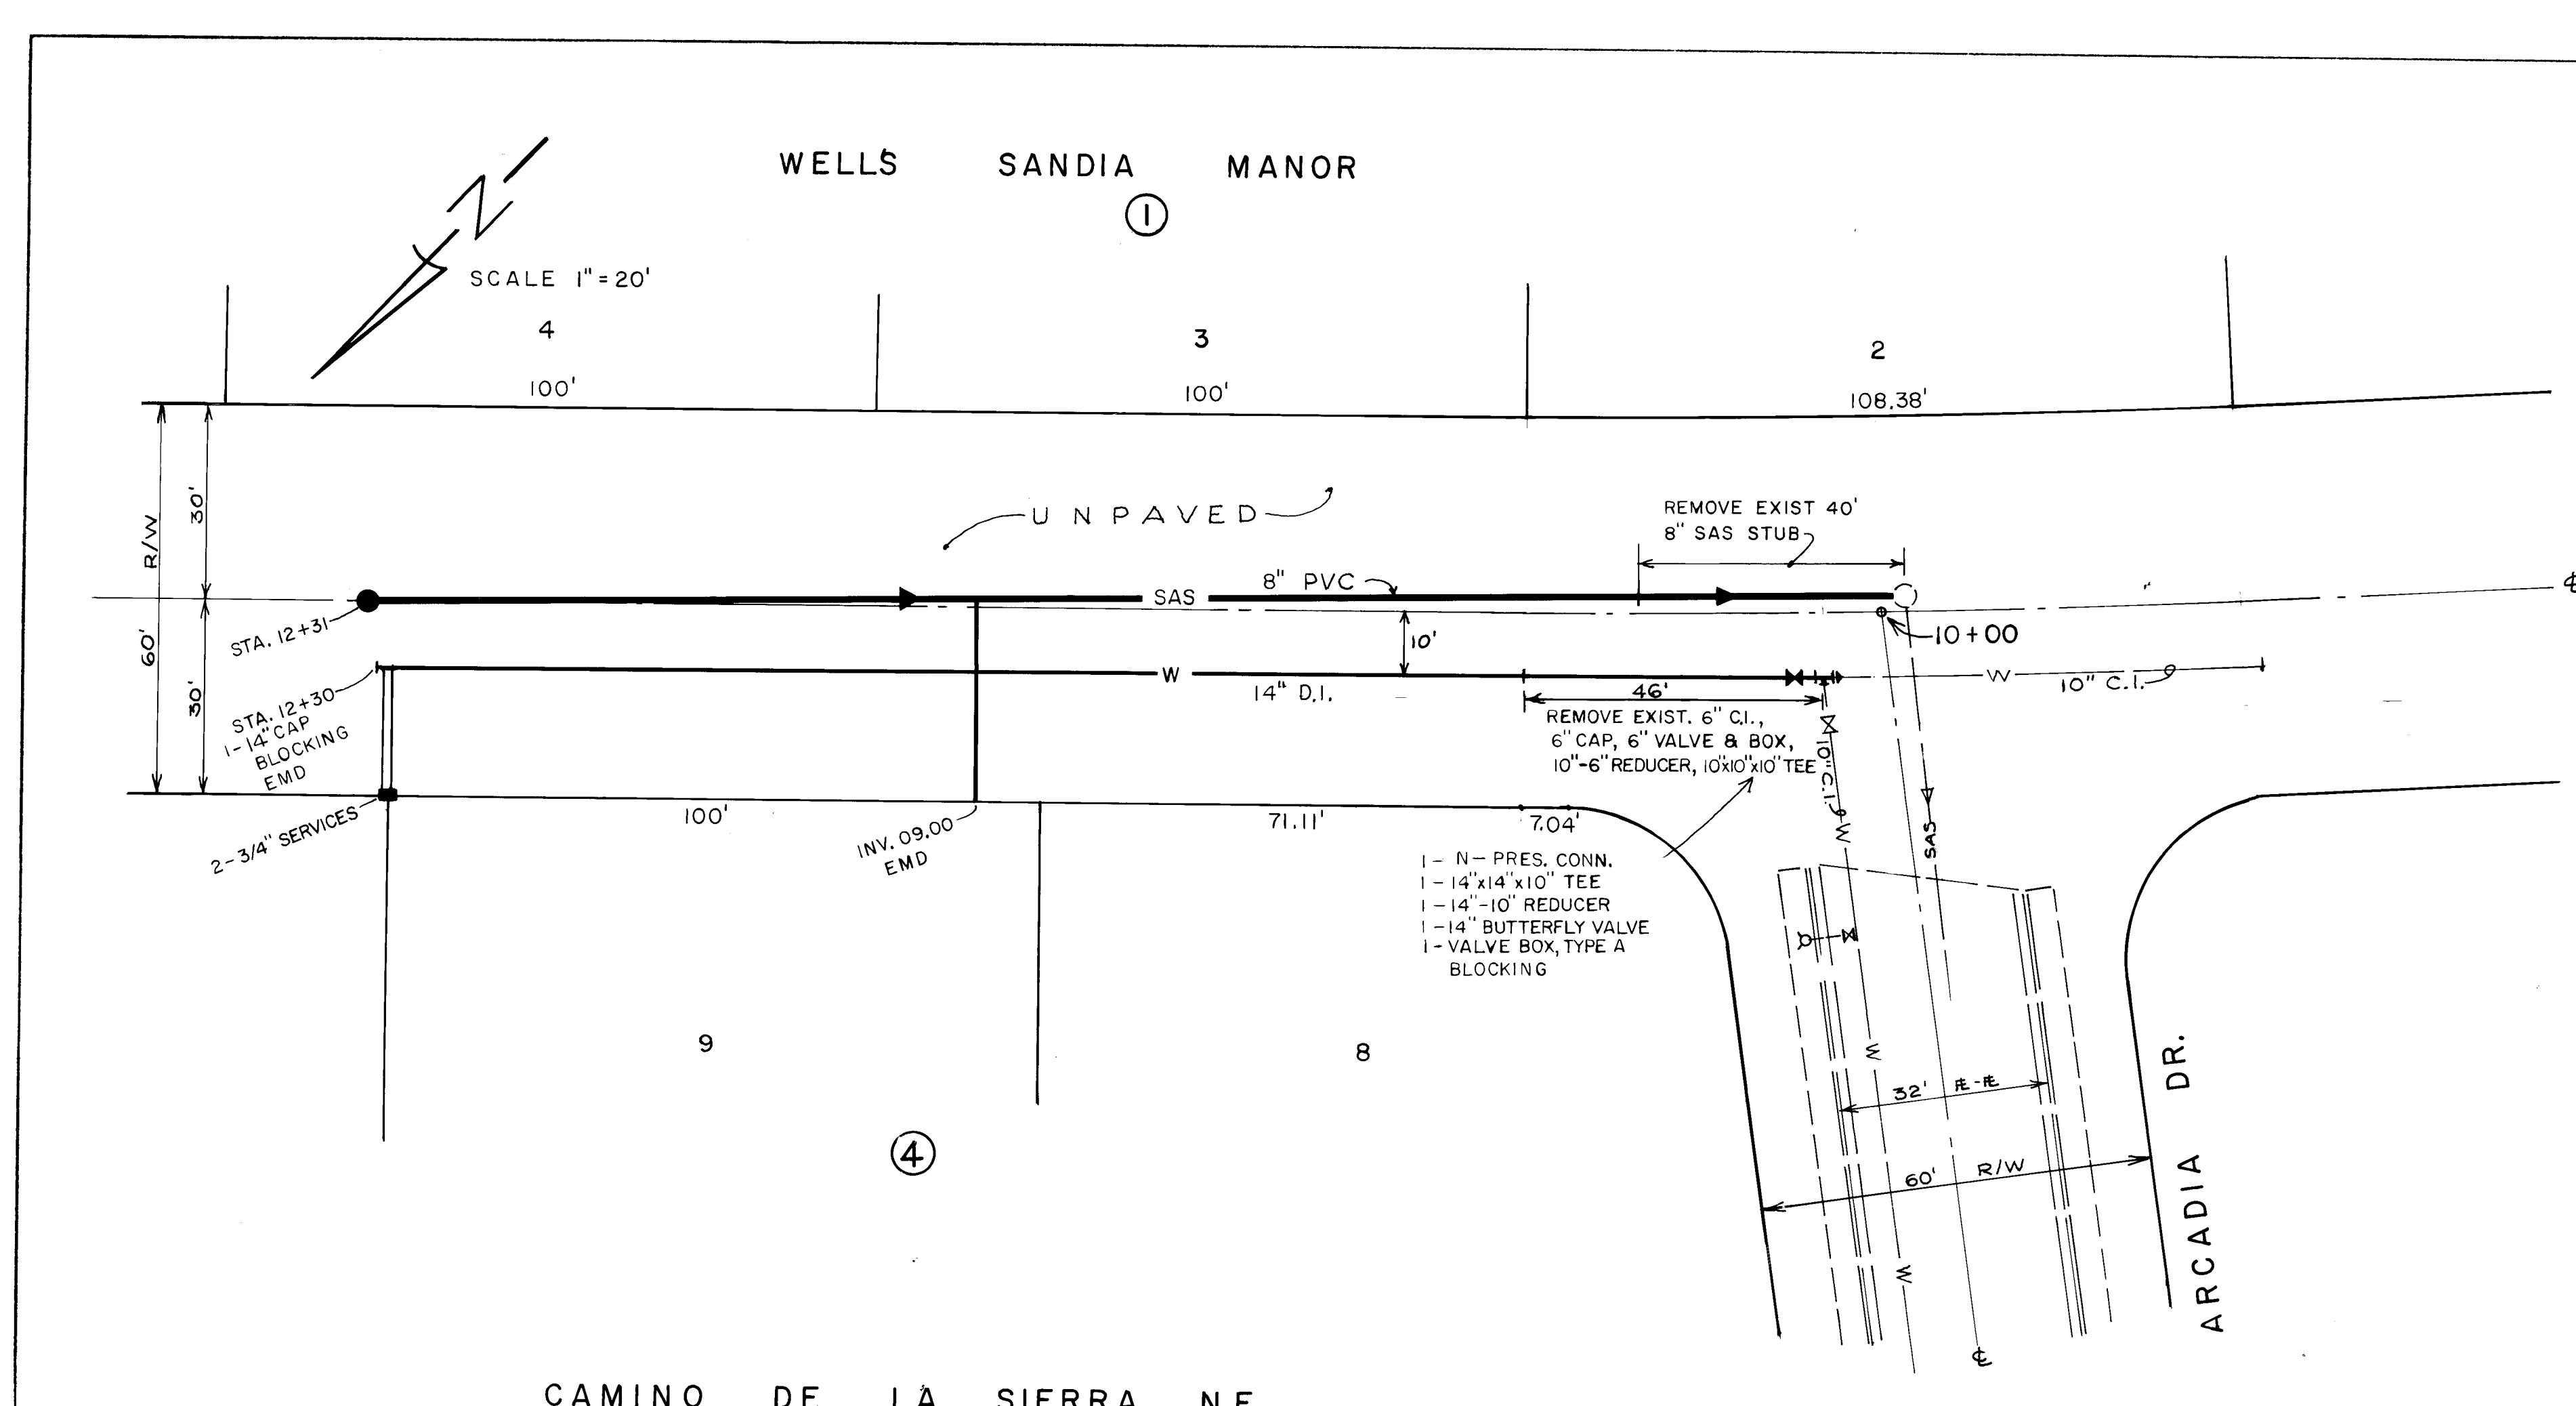

SCALE:
HORIZ: 1" = 20'
VERT: 1" = 5'

NOTICE TO CONTRACTORS

1. All work detailed on these plans to be performed under contract shall, except as otherwise stated or provided for herein, be constructed in accordance with the New Mexico Standard Specifications for Public Works Construction-1979 Edition (referred to herein as the Standard Specifications) and the Contract Documents for Public Works Contract 84-5.

2. Two (2) working days prior to any excavation, the contractor must contact Line Locating Service, 765-1234, for location of existing utilities.

3. Prior to construction, the contractor shall excavate and verify the horizontal and vertical locations of all obstructions. Should a conflict exist, the contractor shall notify the engineer or surveyor so that the conflict can be resolved with minimum amount of delay.

THE FOLLOWING NOTES ALSO APPLY WHEN CHECKED

☐	All utilities and utility service lines shall be installed prior to paving.
☒	Backfill compaction shall be according to specified street use. (Residential)
☐	Tack coat requirements shall be determined by the City Engineer.
☐	Sidewalks and wheelchair ramps within the curb returns shall be constructed wherever a new curb return is constructed.
☐	If curb is depressed for a driveway or a handicap ramp, the driveway or ramp shall be constructed prior to acceptance of the curb and gutter.
☐	All storm drainage facilities shall be completed prior to final acceptance.

LEGEND

— SAS —	NEW SANITARY LINE
— SAS —	EXIST. SANITARY LINE
— W —	NEW WATER LINE
— W —	EXISTING WATER
===	EXIST. CURB & GUTTER

SUPERCEDED BY SAD 217 & 3142

26	23	5	9	0	1	8	5
----	----	---	---	---	---	---	---

FOR INFORMATION ONLY

APPROVED FOR
CITY OF ALBUQUERQUE

AS BUILT INFORMATION	
CONTRACTOR	DATE
WORK BY	DATE
INSPECTOR'S	DATE
ACCEPTANCE BY	DATE
FIELD LOCATION BY	DATE
DRAWINGS	DATE
CORRECTED BY	DATE
MICRO-FILM INFORMATION	DATE
RECORDED BY	DATE
NO	NO

BENCH MARKS	
B.M. WINDY	DATE
A ACS BRASS TABLE LOCATED ON THE NORTH SIDE OF WINDSOR PL. & 380' EAST OF TRIMBLE BLVD.	DATE
ELEV. 5814.68	DATE

SURVEY INFORMATION	
FIELD NOTES	DATE
BY	DATE
NO.	DATE
NOTE:	DATE
ELEVATIONS USED	DATE
ARE TAKEN FROM	DATE
SAD 211	DATE

ENGINEER'S SEAL	
NO.	DATE
REMARKS	DATE
BY	DATE
DESIGN	DATE
DESIGNED BY P. FISCHER	DATE
DRAWN BY B. EMMETT	DATE
CHECKED BY	DATE

CITY OF ALBUQUERQUE
MUNICIPAL DEVELOPMENT DEPARTMENT
ENGINEERING DIVISION

TITLE:
WATER AND SAS EXTENSION ON CAMINO DE LA SIERRA, NORTH OF ARCADIA DR. N.E.

APPROVALS	ENGINEER	DATE	APPROVALS	ENGINEER	DATE
City Engineer	R. Pina	3/4/85	Liquid Waste	R. Pina	3/4/85
ACE - Design	NAD 914	2/26/85	Traffic	NAD 914	2/26/85
ACE - Hydrology	W. D. 11/85	11/85	Water	W. D. 11/85	11/85

DRAWING NO.	2359	MAP NO.	L-23	SHEET	OF
				1	1