


CORONA DEL SOL - TRACT 24

SANITARY SEWER AND ALLEY GRADES

(PROJECT NO. 2366)

INDEX

1. TITLE PAGE
2. SANITARY SEWER & ALLEY GRADES
3. GRADING PLAN

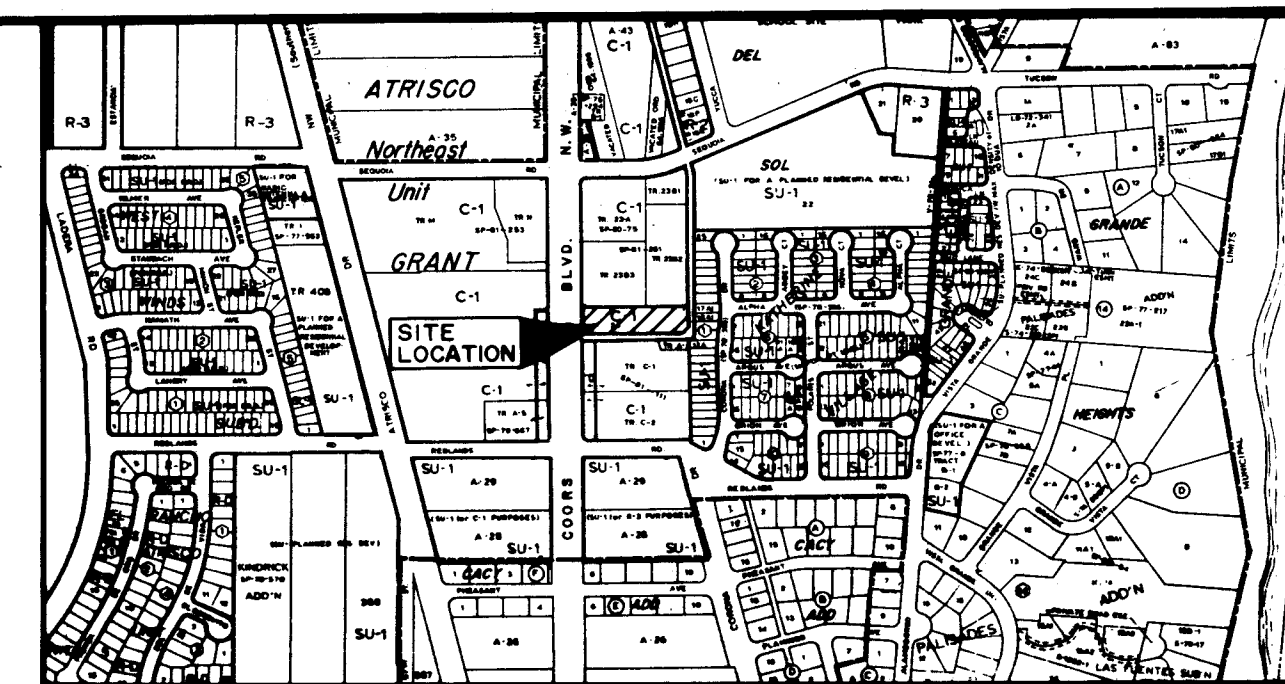

VICINITY MAP

ZONE ATLAS G-11-Z

GENERAL NOTES

1. All work detailed on these plans to be performed under contract shall, except as otherwise stated or provided for hereon, be constructed in accordance with the New Mexico Standard Specifications for Public Works Construction - 1979 Edition (referred to herein as the Standard Specifications) and the Contract Documents for City-Wide Utilities and Cash Paving No. 84-3.
2. Two (2) working days prior to any excavation, contractor must contact Line Locating Service, 765-1234, for location of existing utilities.
3. Prior to construction, the contractor shall excavate and verify the horizontal and vertical locations of all obstructions. Should a conflict exist, the contractor shall notify the engineer or surveyor so that the conflict can be resolved with minimum amount of delay.
4. All utilities and utility services shall be installed prior to paving.
5. Backfill compaction shall be according to specified street use.
6. Tack coat requirements shall be determined by the City Engineer.
7. All storm drainage facilities shall be completed prior to final acceptance.
8. This plan supercedes a portion of Project 2148, Alley Grades for Sequoia Square.
9. A future 72 inch RCP storm drain is proposed within the portion of the subject alley as part of SAD 198. This future storm drain will run down the East Alley and will drain the proposed pond at that time.

1 2 3 4 5 6 7 8 9 10 11 12
2 6 2 3 6 6 0 1 8 5




APPROVAL OF AS BUILT DRAWINGS
ASST. CITY ENGINEER - FIELD
W. F. McManis
DATE 10-10-85

APPROVED FOR
CONSTRUCTION
CITY ENGINEER
DATE 6/17/86

SHEET OF

2366

3

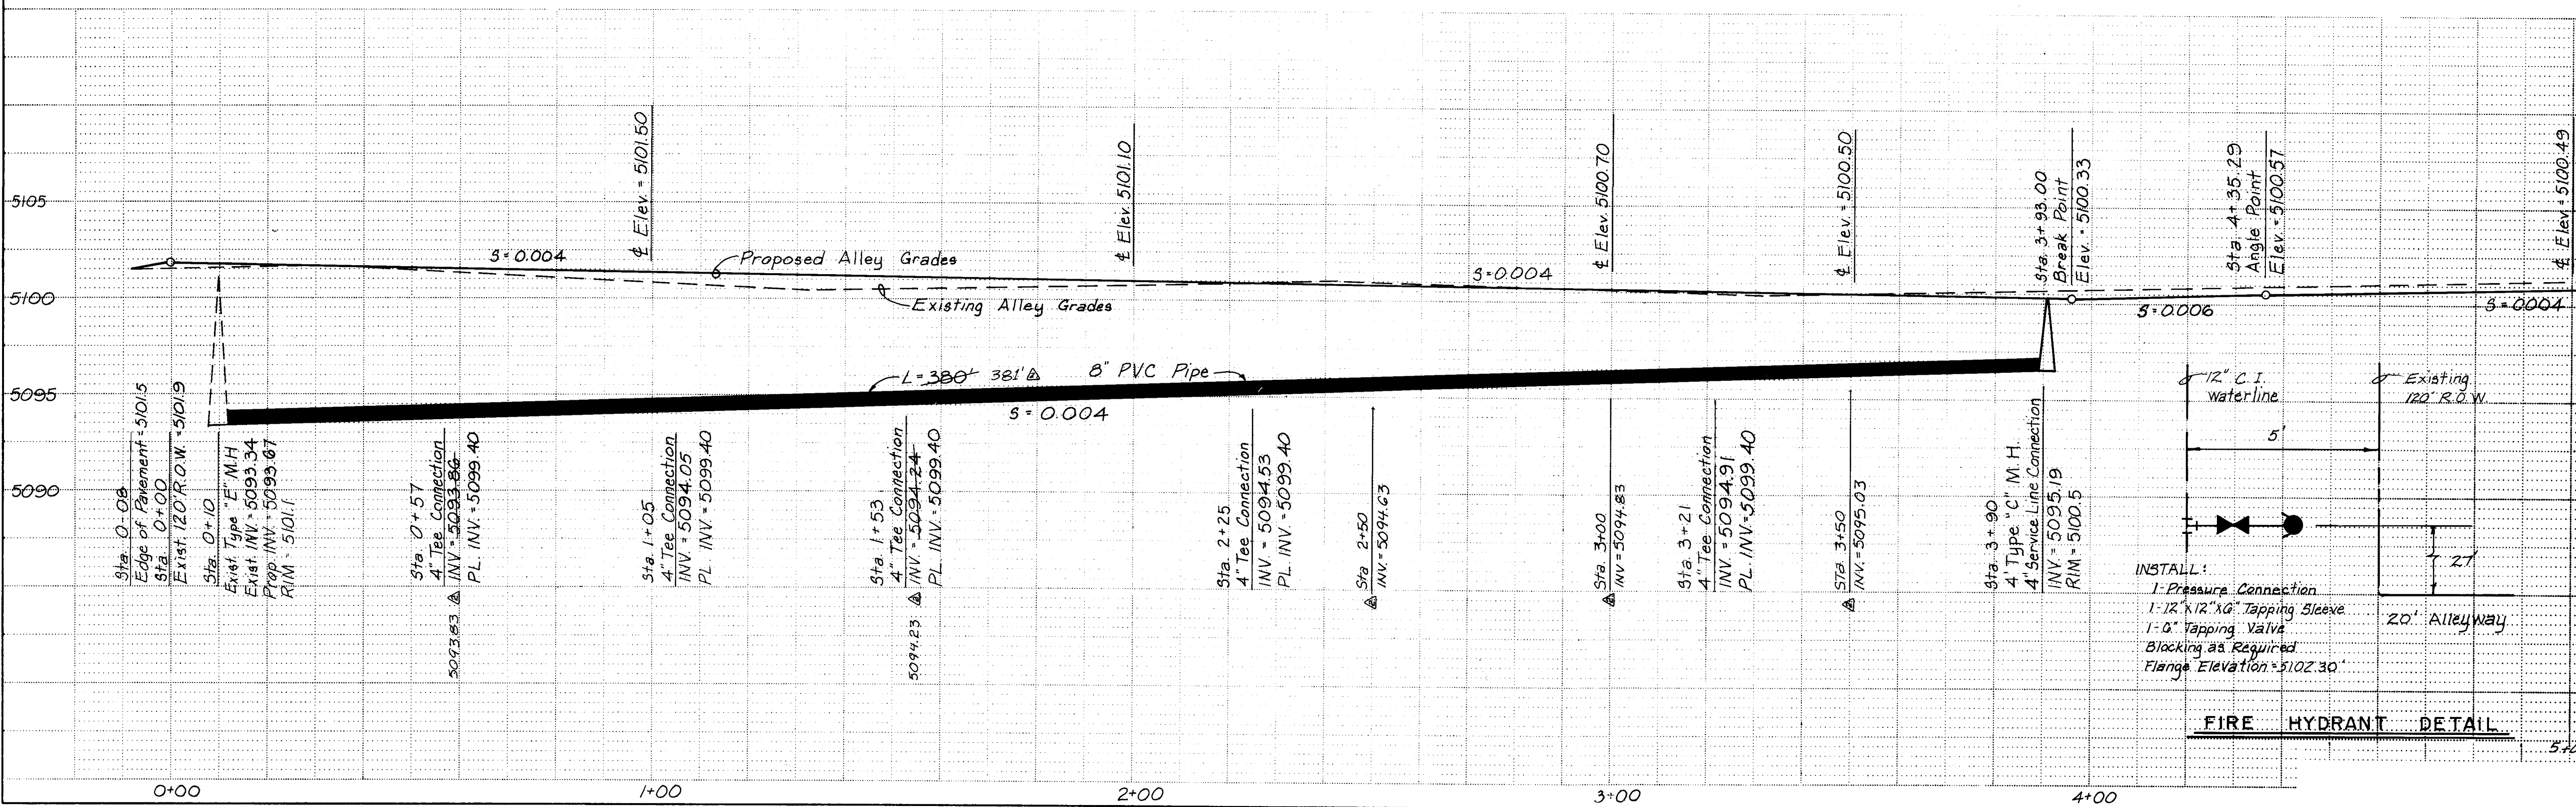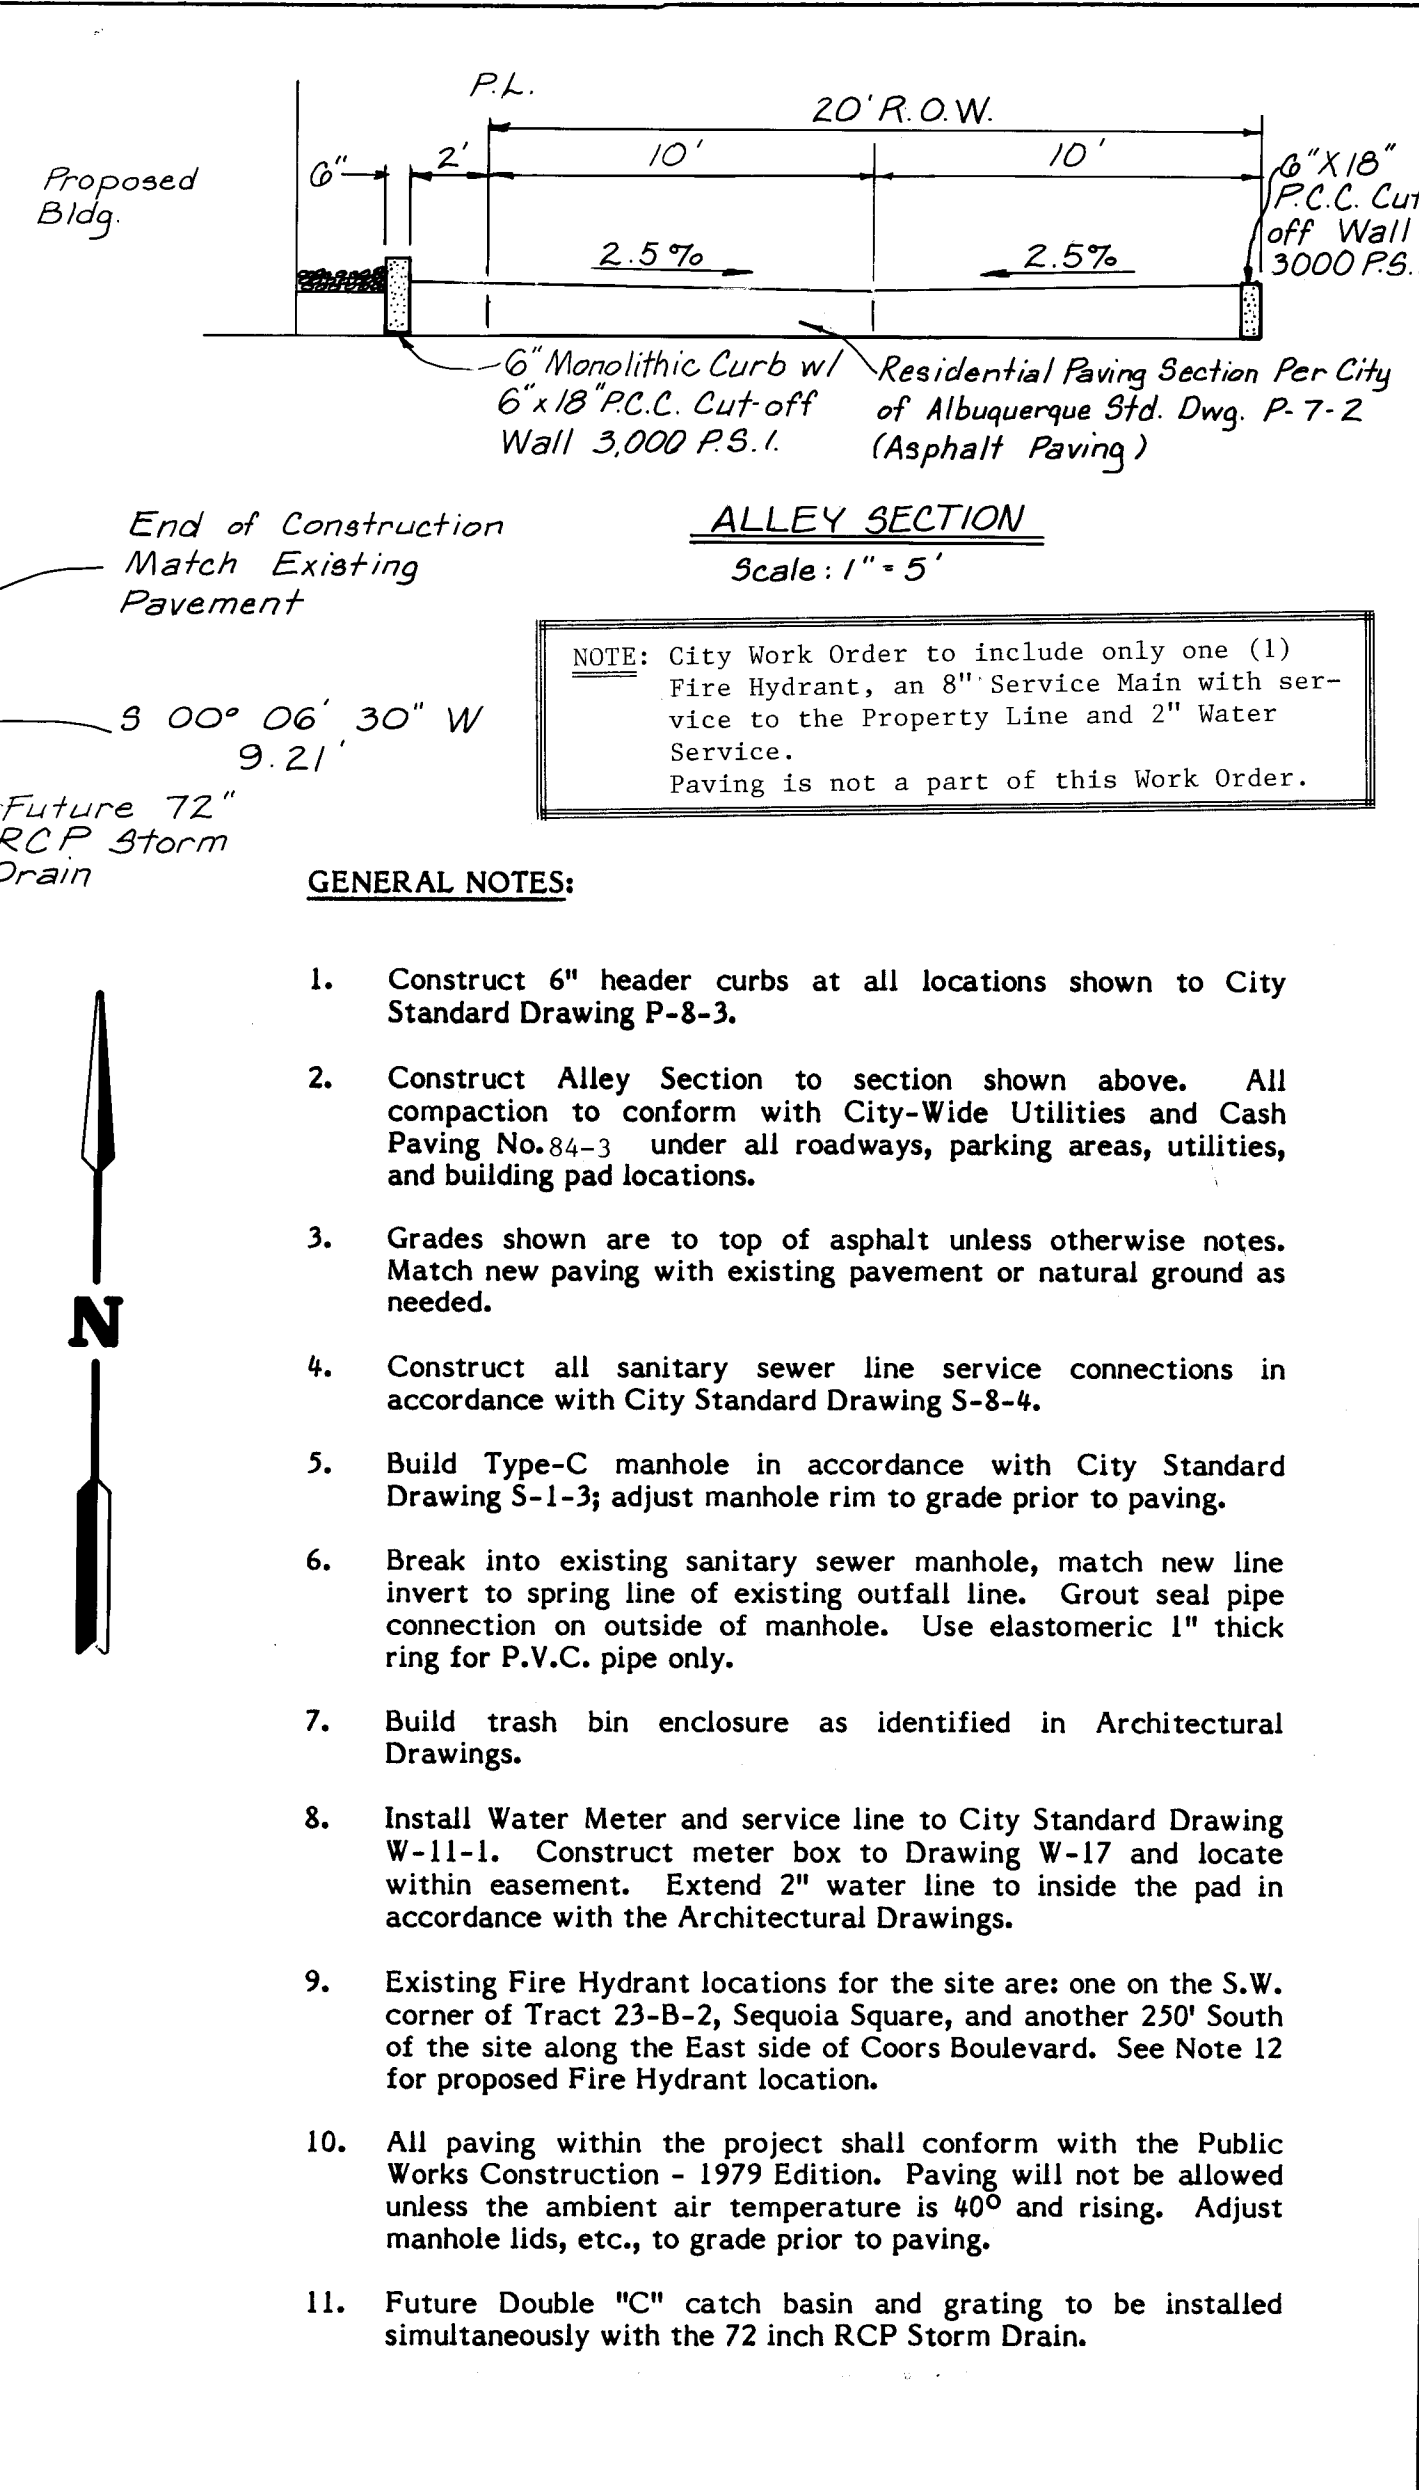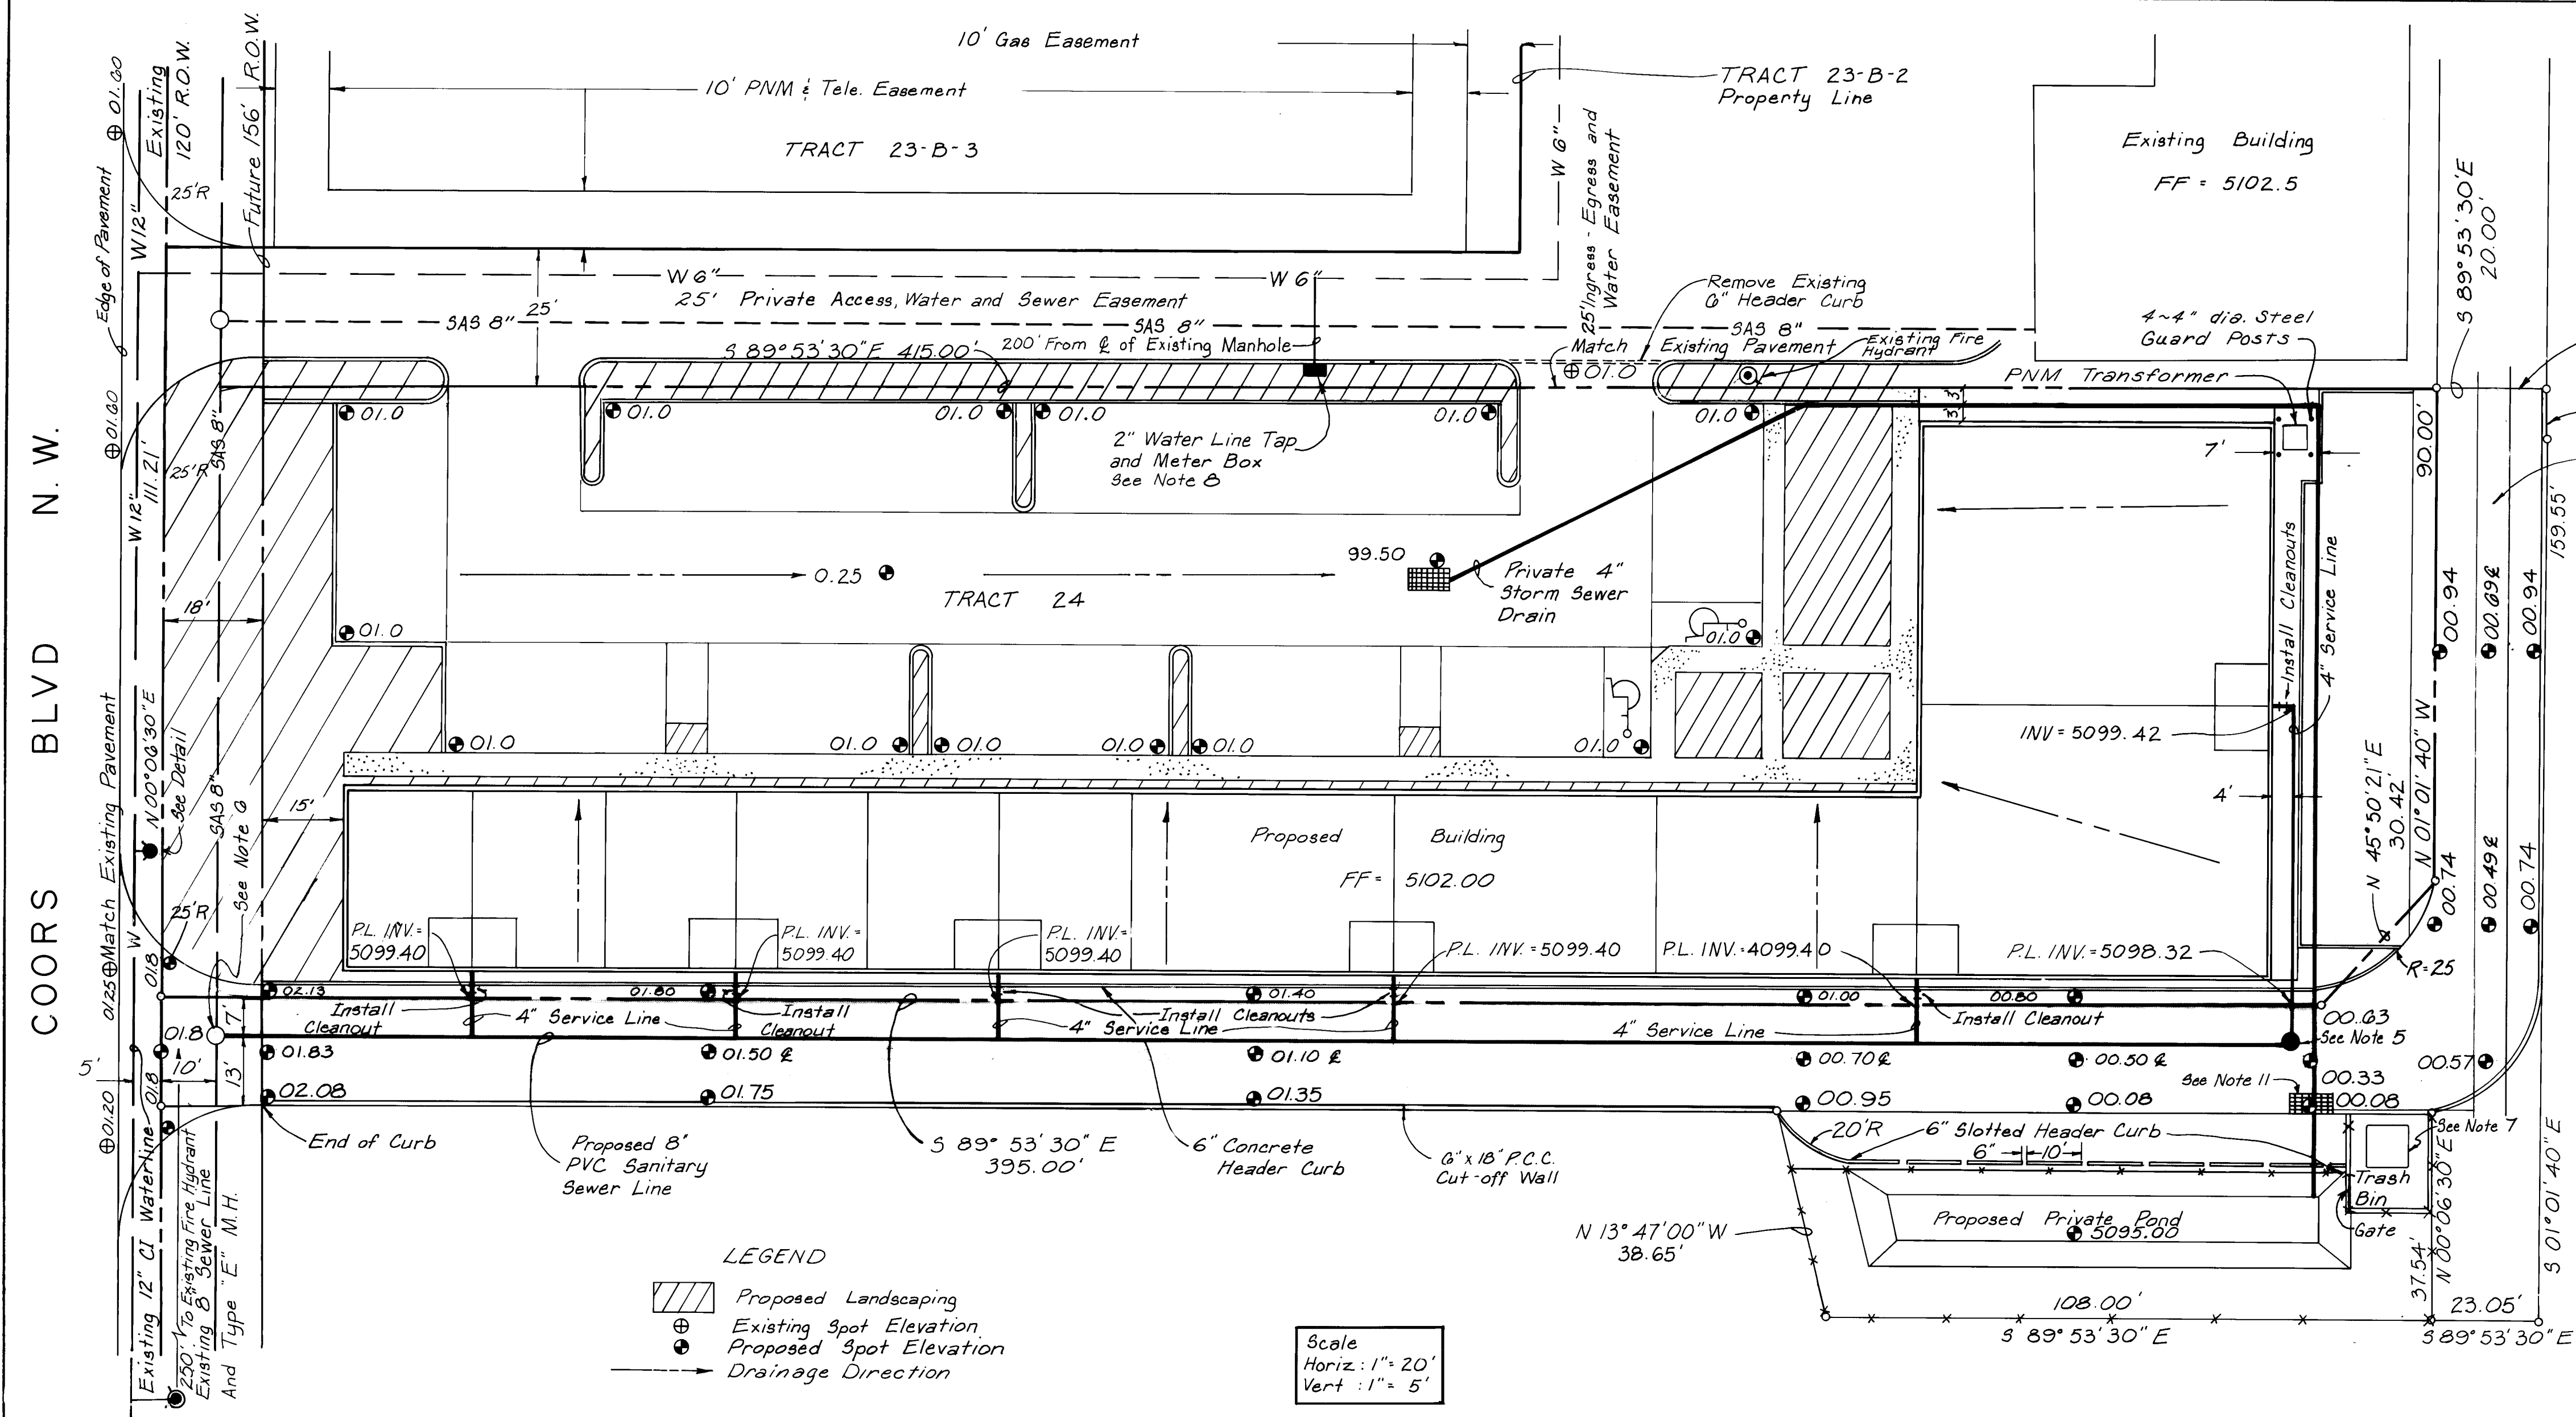

AS BUILT INFORMATION			BENCH MARKS			SURVEY INFORMATION			ENGINEER'S SEAL		
CONTRACTOR	DATE	BY	NO.	DATE	BY	NO.	DATE	BY	NO.	DATE	BY
N.M. S.H.C. / A.C.S. BRASS	CAP. NM 44B-N/3										
Station is located South of Redlands Rd. NW on the East side of State Road 44B (Coors Rd.) in the West edge of a parking lot at the "West Mesa Bowl" bowling alley.											
Elev = 5099.527 feet											

CITY OF ALBUQUERQUE MUNICIPAL DEVELOPMENT DEPARTMENT ENGINEERING DIVISION					
TITLE: CORONA DEL SOL SANITARY SEWER & ALLEY GRADES					
APPROVALS	ENGINEER	DATE	APPROVALS	ENGINEER	DATE
City Engineer	<i>[Signature]</i>	3/10/85	Liquid Waste	<i>[Signature]</i>	3/10/85
A.C.E. - Design	<i>[Signature]</i>	3/13/85	Traffic	<i>[Signature]</i>	3/13/85
Hydrology	<i>[Signature]</i>	3/13/85	Water	<i>[Signature]</i>	3/13/85

DRAWING NO.	MAP NO.	SHEET	OF
2366	G-11	2	3

