


CONSTRUCTION PLANS
FOR
THE HIGHLANDS AT TANOAN
ALBUQUERQUE, NEW MEXICO

Table with 2 columns: NO. and DESCRIPTION. Rows include: 1 TITLE SHEET, 2-5 PLAT, 6 PAVING LAYOUT, 7 WATER DISTRIBUTION PLAN, 8 SANITARY SEWER LAYOUT, 9-10 GRADING PLAN, 11 RETAINING WALL DETAILS, 12 PAVING PLAN & PROFILE - PRESTWICK DRIVE, 13 PAVING PLAN & PROFILE - PRESTWICK DRIVE (CONT.), 14 PAVING PLAN & PROFILE - ROYAL TROON, 15 PAVING PLAN & PROFILE - ROYAL BIRKDALE EAST, 16 PAVING PLAN & PROFILE - ROYAL BIRKDALE WEST, 17 PAVING PLAN & PROFILE - COUNTRY CLUB ROAD & BEAU CHENE, 18 UTILITY PLAN & PROFILE - PRESTWICK DRIVE, 19 UTILITY PLAN & PROFILE - PRESTWICK DRIVE (CONT.), 20 UTILITY PLAN & PROFILE - ROYAL TROON, 21 UTILITY PLAN & PROFILE - ROYAL BIRKDALE EAST, 22 UTILITY PLAN & PROFILE - ROYAL BIRKDALE WEST, 23 UTILITY PLAN & PROFILE - COUNTRY CLUB ROAD & BEAU CHENE

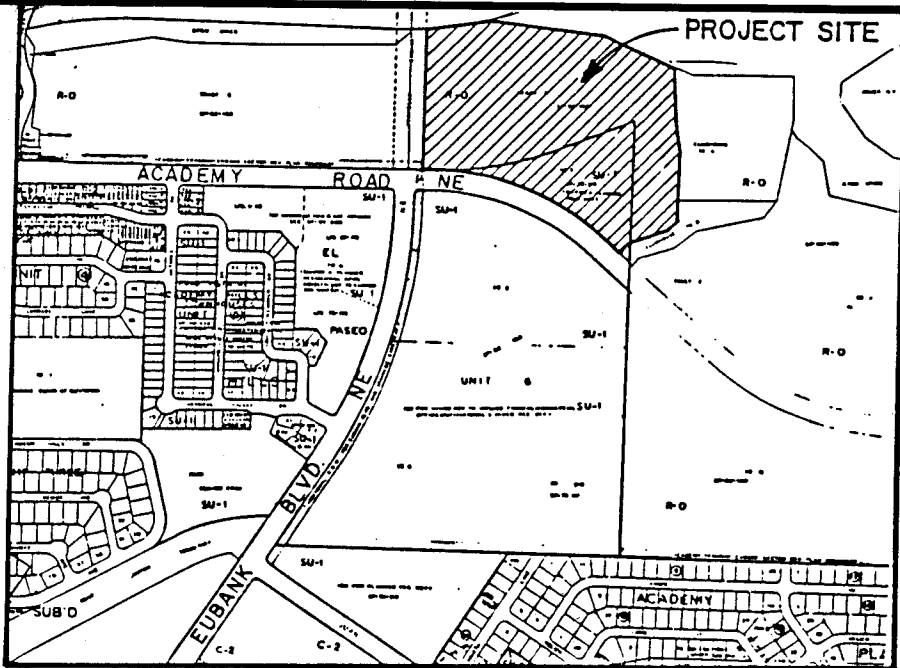

VICINITY MAP
NOT TO SCALE
ZONE ATLAS PAGE E 212

GENERAL NOTES

NOTICE TO CONTRACTORS

- 1. ALL WORK DETAILED ON THESE PLANS TO BE PERFORMED UNDER CONTRACT SHALL, EXCEPT AS OTHERWISE STATED OR PROVIDED FOR HEREON, BE CONSTRUCTED IN ACCORDANCE WITH CITY OF ALBUQUERQUE INTERIM STANDARD SPECIFICATIONS PUBLIC WORKS CONSTRUCTION, 1985 EDITION.
- 2. TWO WORKING DAYS PRIOR TO ANY EXCAVATION, CONTRACTOR MUST CONTACT LINE LOCATING SERVICE, 765-1234, FOR LOCATION OF EXISTING UTILITIES.
- 3. PRIOR TO CONSTRUCTION, THE CONTRACTOR SHALL EXCAVATE AND VERIFY THE HORIZONTAL AND VERTICAL LOCATIONS OF ALL OBSTRUCTIONS. SHOULD A CONFLICT EXIST, THE CONTRACTOR SHALL NOTIFY THE ENGINEER OR SURVEYOR SO THAT THE CONFLICT CAN BE RESOLVED WITH A MINIMUM AMOUNT OF DELAY.

THE FOLLOWING NOTES ALSO APPLY WHEN CHECKED

- [X] ALL UTILITIES AND UTILITY SERVICE LINES SHALL BE INSTALLED PRIOR TO PAVING.
- [X] BACKFILL COMPACTION SHALL BE ACCORDING TO SPECIFIED STREET USE.
- [X] TACK COAT REQUIREMENTS SHALL BE DETERMINED BY THE CITY ENGINEER.
- [X] SIDEWALKS AND WHEELCHAIR RAMPS WITHIN THE CURB RETURNS SHALL BE CONSTRUCTED WHEREVER A NEW CURB RETURN IS CONSTRUCTED.
- [X] IF CURB IS DEPRESSED FOR A DRIVEPAD, THE DRIVEPAD SHALL BE CONSTRUCTED PRIOR TO ACCEPTANCE OF CURB AND GUTTER.
- [X] ALL STORM DRAINAGE FACILITIES SHALL BE COMPLETED PRIOR TO FINAL ACCEPTANCE.
- [X] THE REQUESTOR OR DEVELOPER SHALL BE RESPONSIBLE FOR REPAIR OR REPLACEMENT OF ALL CURB AND GUTTER OR SIDEWALK DAMAGED AFTER APPROVAL BY THE CITY ENGINEER OF WORK COMPLETED BY THE CONTRACTOR.

APPROVAL OF AS BUILT DRAWINGS
ASST. CITY ENGINEER - FIELD
[Signature]
DATE: 6-29-87


1 2 3 4 5 6 7 8 9 10 11 12
26 23 68 01 87

Table with 8 columns: REV, SHEETS, CITY ENGINEER, DATE, USER, DEPT., DATE, USER, DEPT., DATE. Row 1: REV, SHEETS, CITY ENGINEER, DATE, USER, DEPT., DATE, USER, DEPT., DATE. Row 2: REV, SHEETS, CITY ENGINEER, DATE, USER, DEPT., DATE, USER, DEPT., DATE.

APPROVAL OF REVISIONS

BOHANNAN - HUSTON INC.
ALBUQUERQUE - SANTA FE - EL PASO
ENGINEERS PLANNERS PHOTOGRAMMETRISTS
PROJECT NUMBER 2368
SHEET 1 OF 23
APPROVED FOR CONSTRUCTION
[Signature]
1/29/87
C.E.

SP 01-15-1181

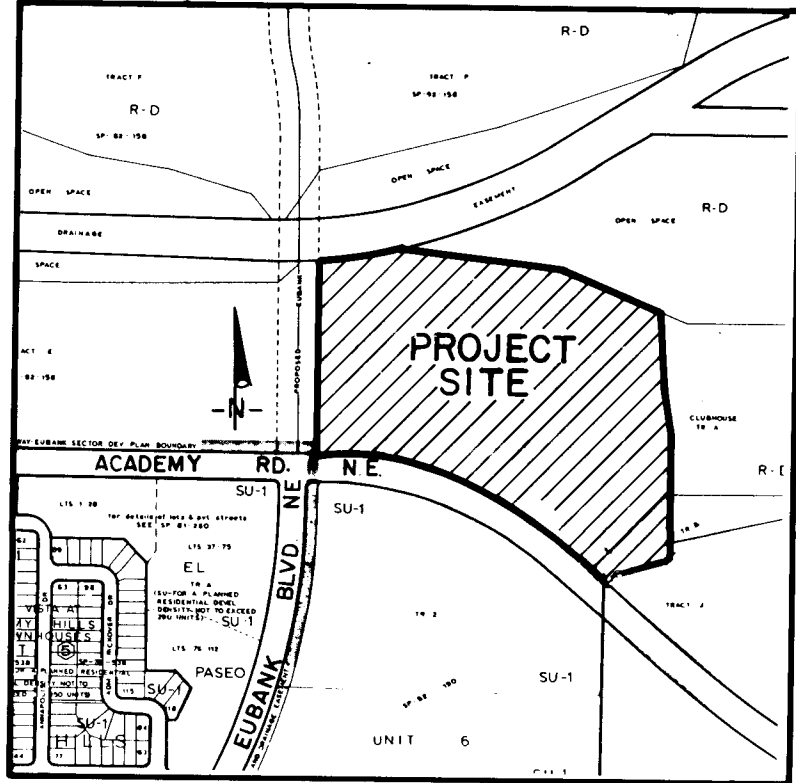

LOCATION MAP

NOT TO SCALE
ZONE ATLAS MAP NO. E-21-2

EASEMENTS

PUBLIC UTILITY EASEMENTS

PUBLIC UTILITY EASEMENTS shown on this plat are ten (10) feet wide and are granted for the common joint use of:

A. The Public Service Company of New Mexico for the installation, maintenance, and service of overhead and underground electrical lines, transformers, and other equipment and related facilities reasonably necessary to provide electrical service.

B. The Gas Company of New Mexico for installation, maintenance, and service of natural gas lines, valves and other equipment and facilities reasonably necessary to provide natural gas.

C. Mountain Bell for the installation, maintenance and service of all buried and aerial communication lines and other related equipment and facilities reasonably necessary to provide communication services, including but not limited to above ground pedestals and closures.

D. Jones Intercable for the installation, maintenance, and service of such lines, cable, and other related equipment and facilities reasonably necessary to provide Cable TV service.

Included is the right of ingress and egress for the construction and maintenance and the right to trim interfering trees and shrubs. Also included is the right to install and maintain service lines.

PRIVATE LANDSCAPE EASEMENTS

Tracts A, B, C, D, E, G, I, and the private landscape easements were designated on the plat are hereby granted as Private Landscape Easements to the Tanoan Community Association for use and maintenance.

Tract H is hereby granted to David and Dallas Price, owners of the Tanoan Country Club, as a Private Landscape Easement for the benefit of, use and maintenance by the Tanoan Country Club.

ACCESS EASEMENTS

Tract A, the private street system, and the 5' Public Waterline and Pedestrian Access easement are hereby granted for the common use and joint benefit of the Tanoan Community Association, Public Service Company of New Mexico, the Gas Company of New Mexico, Mountain Bell, Jones Intercable, and The City of Albuquerque for the purpose of allowing its various operating departments to provide service to the residents of the subdivision in the same manner and to the same extent as though the referenced tracts were dedicated public streets. "Operating departments" as referred to above shall include, but shall not be limited to the department of the City providing the following services: (1) Police protection; (2) Fire protection; (3) Water utilities; (4) Solid refuse and liquid waste disposal; (5) Animal control; (6) City planning functions.

All owners of lots within the subdivision are granted the right of access to their property over and across the referenced tracts and easements. The Tanoan Community Association shall be granted rights to these tracts and easements for the purpose of installation, maintenance, and service of community lighting, street paving, landscape irrigation and other private community utilities.

Tract E is hereby granted to the City of Albuquerque as an Emergency Access and Public Water and Sewer easement for the purpose of allowing its various operating departments to provide service to the residents of the subdivision only in the event of an emergency need for the service, when the lack of such service constitutes a threat to life, health, or property.

In Tract A and Tract E, the City of Albuquerque shall have the exclusive right to place underground utility lines within six (6) feet of the centerline of a water or sewer line except for perpendicular crossings or where written approval has been obtained from the City of Albuquerque. The Public Service Company of New Mexico, the Gas Company of New Mexico, Mountain Bell, and Jones Intercable are exempted from compliance with the requirements of the first sentence of this paragraph. Private irrigation requirements of the first sentence of this paragraph shall be maintained at the expense of the Tanoan Community Association in the event that the service and maintenance of public utilities requires their removal.

PRIVATE DRAINAGE EASEMENTS

Tracts D and F and the three (3') foot drainage easement where shown on the plat are hereby granted as Private Drainage Easements to the Tanoan Community Association for the purpose of conveying surface storm runoff to public facilities. The Tanoan Community Association shall have the right to enter said easements for the purpose of maintaining the private drainage facilities constructed within said easements.

DESCRIPTION

A certain tract of land situate within projected Section 28, T11N, R4E, N.M.P.M., within the Elena Gallegos Grant, City of Albuquerque, Bernalillo County, New Mexico, being THE HIGHLANDS AT TANOAN, THIRD REVISION PLAT OF TANOAN PROPERTIES, as the same is shown and designated on the plat filed in the Office of the County Clerk of Bernalillo County, New Mexico on June 20, 1986, in Volume C30, Folio 155, and being more particularly described by New Mexico State Plane Grid Bearings (Central Zone) and ground distances as follows:

BEGINNING at the northwest corner of the tract herein described, said corner being the southwest corner of Open Space 5-A-3-B as shown on said Third Revision Plat, and also being a point on the easterly right-of-way of Eubank Boulevard, N.E., whence ACS Survey monument "1-D22" (New Mexico State Plane Grid Coordinates for Central Zone: X= 420,728.02, Y= 1,513,437.51) bears N67°05'25"E, 2723.32 feet and from said point of beginning running thence along the northerly boundary of the tract herein described being also the southerly boundary of said Open Space 5-A-3-B, N79°16'33"E, 116.97 feet to a point, thence, S82°45'07"E, 838.42 feet to a point, thence, S66°48'17"E, 410.64 feet to the northeast corner of the tract herein described; thence continuing along the easterly boundary of the tract herein described, S02°32'11"E, 300.00 feet to a point; thence continuing along the easterly boundary of the tract herein described being also the westerly boundary of the CLUBHOUSE TRACT as shown on said Third Revision Plat, S11°39'21"E, 146.29 feet to a point; thence, S09°00'00"W, 159.58 feet to a point; thence, S36°04'10"E, 162.00 feet to a point; thence, S53°55'50"W, 132.06 feet to a point; thence, S77°43'00"W, 20.94 feet to a point on a curve; thence, 57.86 feet along the arc of a curve to the right having a radius of 318.05 feet and a chord bearing S61°37'46"W, 57.78 feet to a point; thence, S44°07'26"W, 24.65 feet to a point on a curve; thence, 13.49 feet along the arc of a curve to the right having a radius of 328.00 feet and a chord bearing S71°53'53"W, 13.49 feet to a point; thence, S73°44'38"W, 28.25 feet to a point of curvature; thence, 32.57 feet along the arc of a curve to the right having a radius of 140.00 feet and a chord bearing S80°24'34"W, 32.50 feet to a point of reverse curvature; thence, 66.60 feet along the arc of a curve to the left having a radius of 160.00 feet and a chord bearing S75°09'01"W, 66.12 feet to a point of compound curvature; thence, 94.15 feet along the arc of a curve to the left having a radius of 234.00 feet and a chord bearing S51°41'59"W, 93.51 feet to a point of tangency; thence, S40°10'12"W, 12.79 feet to a point on a curve; thence, 31.42 feet along the arc of a curve to the right having a radius of 20.00 feet and a chord bearing S85°10'12"W, 28.28 feet to a point on the northerly right-of-way of Academy Road, N.E.; thence continuing along said northerly right-of-way being the southerly boundary of the tract herein described, N49°49'48"W, 57.75 feet to a point of curvature; thence, 736.31 feet along the arc of a curve to the left having a radius of 1485.40 feet and a chord bearing N64°01'50"W, 728.79 feet to a point of reverse curvature; thence, 35.94 feet along the arc of a curve to the right having a radius of 140.00 feet and a chord bearing N70°52'40"W, 35.84 feet to a point of reverse curvature; thence, 50.19 feet along the arc of a curve to the left having a radius of 160.00 feet and a chord bearing N72°30'37"W, 49.98 feet to a point of compound curvature; thence, 186.91 feet along the arc of a curve to the left having a radius of 1497.40 feet and a chord bearing N85°04'20"W, 186.79 feet to a point of reverse curvature; thence, 64.73 feet along the arc of a curve to the right having a radius of 50.00 feet and a chord bearing N51°33'35"W, 60.30 feet to a point of compound curvature; thence, 74.62 feet along the arc of a curve to the right having a radius of 292.00 feet and a chord bearing N07°09'02"W, 74.41 feet to a point of tangency on the said easterly right-of-way of Eubank Boulevard, N.E.; thence continuing along said easterly right-of-way being the westerly boundary of the tract herein described, N00°10'12"E, 700.67 feet to the point and place of beginning.

Tract contains 28.6673 acres, more or less.

APPROVALS

PLAT NUMBER _____

PLANNING DIRECTOR _____

DATE _____

CITY ENGINEER _____

DATE _____

A.M.A.P.C.A. _____

DATE _____

TRAFFIC ENGINEER _____

DATE _____

CITY SURVEYOR _____

DATE _____

PROPERTY MANAGEMENT _____

DATE _____

WATER RESOURCES _____

DATE _____

PARKS AND RECREATION _____

DATE _____

PUBLIC SERVICE COMPANY OF NEW MEXICO _____

DATE _____

MOUNTAIN BELL _____

DATE _____

GAS COMPANY OF NEW MEXICO _____

DATE _____

SUBDIVISION PLAT MAP

FOR

THE HIGHLANDS AT TANOAN

ALBUQUERQUE, NEW MEXICO

NOVEMBER 1986

NOTES

- Bearings are New Mexico State Plane Grid Bearings (Central Zone) and are the same as shown on the THIRD REVISION PLAT OF TANOAN PROPERTIES filed June 20, 1986 in Book C30, Folio 155.
- Distances are ground distances.
- Centerline (in lieu of R/W) Monumentation to be installed at centerline PC's, PT's, angle points and street intersections prior to acceptance of subdivision street improvements and will consist of a four-inch (4") aluminum alloy cap (with magnet attached) stamped "City of Albuquerque Centerline Monument", "Do Not Disturb".

SUBDIVISION DATA

- DRB Number 86-466, S-86-55
- Zone Atlas Index Number: E-21
- Gross Subdivision Acreage: 28.6673 Acres.
- Total Number of lots created: 104 lots, 6 tracts.
- This plat was compiled from Plats of Record, field work and corners set are from previous surveys.
- Site is located within projected Section 28, T11N, R4E, N.M.P.M.
- This plat shows existing easements.
- The purpose for filing this replat is to subdivide the HIGHLANDS AT TANOAN TRACT, THIRD REVISION PLAT OF TANOAN PROPERTIES.
- 0.0108 acre(s) of public street right of way, dedicated

FREE CONSENT AND DEDICATION

The foregoing Replat of that certain tract of land situate within the Elena Gallegos Grant, City of Albuquerque, Bernalillo County, New Mexico, being and comprising THE HIGHLANDS AT TANOAN, THIRD REVISION PLAT OF TANOAN PROPERTIES, as the same is shown and designated on the plat filed in the County Clerk of Bernalillo County, New Mexico on June 20, 1986 in Volume C30, Folio 155, and now hereon shown and comprising THE HIGHLANDS AT TANOAN, is with free consent and in accordance with the desires of the undersigned owner(s) and/or proprietor(s) do hereby dedicate all public rights-of-way where noted and grant all easements shown on this plat. Electrical Power and Communication easements are reserved for overhead distribution lines, conduits, and pipes for underground utilities, and other related equipment where shown or indicated, including the right of ingress and egress for construction and maintenance, and the right to trim interfering trees and shrubs.

HIGHLANDS/CHAMPIONS JOINT VENTURE

Christopher C. Inman
Christopher C. Inman
President, Inman Enterprises, Inc.

State of New Mexico)
County of Bernalillo) ss

The foregoing instrument was acknowledged before me this 6th day of January, 1986, by Christopher C. Inman, President, Inman Enterprises, a New Mexico Corporation on behalf of said Corporation.

My commission Expires: 2-21-90 *Loa Van Lam Lam*
Notary public

SURVEYOR'S CERTIFICATION

I, A. Dwain Weaver, a registered Professional New Mexico Land Surveyor, certify that this plat was prepared by me or under my supervision, shows all easements of record, meets the minimum requirements for monumentation and surveys contained in the Albuquerque Subdivision Ordinance, and is true and accurate to the best of my knowledge and belief.

A. Dwain Weaver
A. Dwain Weaver
P.L.S. No. 6544

Bohannon-Huston, Inc.
Court yard I
7500 Jefferson N.E.
Albuquerque, N.M. 87109

OFFICIAL SEAL


State of New Mexico)
County of Bernalillo) ss

JANET E. SPEAKMAN
NOTARY PUBLIC - STATE OF NEW MEXICO
Notary Bond Filed with Secretary of State 05-16-90
My Commission Expires 10-08-93

The foregoing instrument was acknowledged before me this 6 day of January, 1986, by A. Dwain Weaver.

My Commission Expires: March 16, 1990 *Janet E. Speakman*
Notary Public

SHEET 1 OF 4

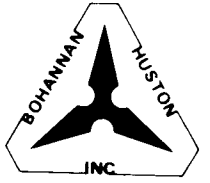

1 2 3 4 5 6 7 8 9 10 11 12
26 23680287

SHEET 2 OF 23

PROJECT NO. 2368


TANGENT DATA		
NUMBER	BEARING	DISTANCE
T1	N00°10'12"E	84.49
T2	N00°47'18"E	83.50
T3	N05°34'10"W	50.00
T4	S77°43'00"W	20.94
T5	S44°07'26"W	24.65
T6	S73°44'38"W	28.25
T7	S40°10'12"W	12.79
T8	S49°49'48"E	38.22
T9	N82°45'07"W	11.00
T10	N02°54'01"E	22.80
T11	N 02°54'01"E	4.11
T12	S79°16'33"W	17.00
T13	N82°45'07"W	20.00
T14	N82°45'07"W	27.42
T15	N66°48'17"W	25.00
T16	N02°32'11"W	20.00
T17	S82°45'07"E	4.04
T18	S82°45'07"E	20.00
T19	S82°45'07"E	19.00
T20	N82°45'07"W	7.50
T21	S37°17'06"E	35.51
T22	S82°45'07"E	22.23
T23	S07°14'53"W	28.37
T24	S26°35'18"E	36.41
T25	S70°22'32"E	17.19
T26	S24°11'02"E	16.00
T27	N05°15'31"E	24.00
T28	S05°15'31"E	8.00
T29	N11°39'21"W	30.91
T30	N00°00'00"E	15.41
T31	N73°44'38"E	15.25
T32	N73°44'38"E	13.00
T33	N05°15'31"W	15.00
T34	S18°51'44"W	36.70
T35	N70°41'10"E	6.50
T36	N70°41'10"E	49.96
T37	S70°41'10"W	31.00
T38	S70°41'10"W	18.96
T39	S76°36'59"E	35.43
T40	S29°17'04"W	5.49
T41	N29°17'04"E	21.85
T42	N17°29'25"E	45.00
T43	S85°38'06"E	9.96
T44	S60°55'38"W	18.77
T45	N60°55'38"E	20.00
T46	S60°55'38"E	19.23
T47	N60°55'38"E	17.00
T48	S12°52'45"E	16.22
T49	S11°21'46"W	7.33
T50	S11°21'46"W	10.00
T51	S42°07'18"E	10.00
T52	N70°22'32"W	10.95
T53	N70°22'32"E	6.24
T54	N44°19'26"W	7.00
T55	S45°40'34"W	39.14
T56	N44°07'55"W	23.00
T57	S70°22'32"E	17.19
T58	S82°45'07"E	5.29
T59	N05°24'32"E	10.00
T60	S07°24'25"E	24.30
T61	N50°05'46"E	21.63
T62	S60°42'56"E	20.38
T63	S47°52'42"W	15.00
T64	N68°39'44"W	14.63
T65	S07°04'53"W	29.13
T66	S89°30'05"E	51.36
T67	S49°49'48"E	19.53
T68	S02°32'11"E	30.76
T69	S02°32'11"E	65.07
T70	S21°54'30"E	67.84
T71	S54°40'15"E	14.11
T72	S88°08'25"E	70.73
T73	S61°39'44"E	52.48
T74	S00°27'56"W	34.74
T75	S89°30'05"E	13.51
T76	S89°30'05"E	37.85
T77	S82°45'07"E	33.16
T78	S82°45'07"E	57.57
T79	S82°45'07"E	50.38

CURVE DATA					
NUMBER	ARC	RADIUS	DELTA	CHORD	TANGENT
C1	57.86	318.05	10°25'22"	57.78	29.01
C2	13.49	328.00	2°21'24"	13.49	6.75
C3	32.57	140.00	13°19'50"	32.50	16.36
C4	66.60	160.00	23°03'56"	66.12	33.79
C5	94.15	234.00	23°03'09"	93.51	47.72
C6	31.42	20.00	90°00'00"	28.28	20.00
C7	736.31	1485.40	28°24'03"	728.79	375.88
C8	35.94	140.00	14°42'28"	35.84	18.07
C9	50.19	160.00	17°58'20"	49.98	25.30
C10	172.02	1497.40	6°34'55"	171.92	86.10
C11	14.90	1497.40	0°34'12"	14.90	7.45
C12	38.16	140.00	15°36'60"	38.04	19.20
C13	23.60	50.00	27°02'53"	23.39	12.03
C14	41.13	50.00	47°07'44"	39.98	21.81
C15	25.64	292.00	5°01'48"	25.63	12.83
C16	48.98	292.00	9°36'40"	48.92	24.55
C17	35.44	25.00	81°12'54"	32.54	21.43
C18	96.60	43.75	126°30'23"	78.14	86.81
C19	22.27	43.75	29°10'12"	22.03	11.38
C20	80.59	43.75	105°32'19"	69.67	57.57
C21	202.41	366.39	31°39'11"	199.85	103.86
C22	178.61	300.00	34°06'43"	175.98	92.04
C23	52.50	381.01	7°53'44"	52.46	26.29
C24	63.57	381.01	9°33'35"	63.50	31.86
C25	66.00	381.01	9°56'14"	66.00	33.12
C26	27.60	381.01	44°09'01"	27.59	13.80
C27	30.28	25.00	69°24'23"	28.47	17.31
C28	13.42	45.62	16°51'22"	13.37	6.76
C29	57.50	45.62	72°12'43"	53.77	33.28
C30	50.34	45.62	63°13'01"	47.83	28.08
C31	6.74	45.62	8°27'44"	6.73	3.38
C32	16.40	25.00	37°34'48"	16.11	8.51
C33	13.17	25.00	30°11'38"	13.02	6.74
C34	66.42	316.62	12°01'08"	66.30	33.33
C35	57.28	316.62	10°21'53"	57.20	28.72
C36	40.03	283.38	8°05'40"	40.00	20.05
C37	98.63	283.38	18°56'28"	98.13	49.82
C38	39.77	25.00	91°08'38"	35.71	25.50
C39	46.50	25.00	106°34'05"	40.08	33.52
C40	109.24	351.76	17°47'37"	108.80	55.06
C41	69.71	351.76	11°21'16"	69.60	34.97
C42	16.00	351.76	2°36'23"	16.00	8.00
C43	40.46	19.57	118°27'01"	33.63	32.86
C44	21.33	10.00	122°31'03"	17.51	18.12
C45	15.94	316.63	2°53'06"	15.94	7.97
C46	21.33	10.00	122°31'03"	17.51	18.12
C47	216.01	1000.00	12°22'34"	215.59	108.42
C48	59.35	1014.63	3°21'05"	59.34	29.68
C49	64.36	1014.63	3°38'04"	64.35	32.19
C50	64.58	1014.63	3°38'50"	64.57	32.30
C51	30.87	1014.63	1°44'36"	30.87	15.44
C52	59.76	985.37	3°28'29"	59.75	29.89
C53	70.96	985.37	4°07'34"	70.95	35.50
C54	70.43	985.37	4°05'43"	70.42	35.23
C55	11.70	985.37	0°40'48"	11.70	5.85
C56	54.60	115.73	27°01'53"	54.10	27.82
C57	15.01	101.11	8°30'29"	15.00	7.52
C58	80.39	101.11	45°33'16"	78.29	42.45
C59	28.06	25.00	64°18'07"	26.61	15.71
C60	19.14	45.62	24°02'00"	19.00	9.71
C61	75.77	45.62	95°09'20"	67.36	49.93
C62	50.55	45.62	63°28'30"	48.00	28.22
C63	28.06	25.00	64°18'07"	26.61	15.71
C64	17.43	130.36	7°39'35"	17.41	8.73
C65	16.40	10.00	93°56'22"	14.62	10.71
C66	83.88	151.35	3°46'16"	82.81	43.05
C67	15.40	10.00	93°56'22"	14.62	10.71
C68	13.59	176.78	4°24'18"	13.59	6.80
C69	33.06	25.00	75°45'45"	30.70	19.45
C70	14.11	182.60	4°25'15"	14.10	7.06
C71	61.16	182.60	19°11'28"	60.88	30.87
C72	26.17	25.00	59°57'59"	24.99	14.42
C73	17.42	28.50	35°10'19"	17.15	8.99
C74	54.97	133.35	21°57'02"	54.58	27.88
C75	33.06	25.00	75°45'45"	30.70	19.45
C76	65.12	157.98	21°37'00"	64.66	33.03
C77	112.28	160.15	75°56'41"	107.08	25.00
C78	73.81	143.53	29°27'55"	73.66	37.74
C79	116.43	143.53	46°28'47"	113.27	61.63
C80	41.87	176.78	13°34'13"	41.77	21.03
C81	59.96	176.78	19°28'04"	59.67	30.27
C82	31.04	176.78	10°03'38"	31.00	15.56
C83	97.00	100.00	55°34'31"	93.24	52.70
C84	80.87	83.37	55°34'31"	77.74	43.94
C85	34.12	116.62	16°45'48"	34.00	17.18
C86	52.88	116.62	25°58'48"	52.43	26.90
C87	26.12	116.62	12°49'55"	26.06	13.11
C88	34.89	1610.40	1°14'28"	34.89	17.44
C89	64.10	1643.65	2°14'04"	64.09	32.05
C90	122.40	1627.03	4°18'37"	122.37	61.23
C91	198.12	1627.03	6°58'37"	198.00	99.18
C92	84.62	1643.65	2°16'59"	84.61	42.32
C93	38.68	25.00	88°38'21"	34.93	24.41
C94	38.68	25.00	88°38'21"	34.93	24.41



CURVE DATA					
NUMBER	ARC	RADIUS	DELTA	CHORD	TANGENT
C95	97.01	1643.65	3°22'54"	97.00	48.52
C96	69.21	1610.40	2°27'44"	69.20	34.61
C97	72.61	1610.40	2°35'00"	72.60	36.31
C98	71.54	1610.40	2°32'43"	71.53	35.78
C99	67.01	1610.40	2°23'02"	67.00	33.52
C100	2.00	1610.40	0°04'16"	2.00	1.00
C101	20.16	46.62	24°46'11"	20.00	10.24
C102	46.31	46.62	56°54'13"	44.43	25.26
C103	44.49	46.62	54°40'07"	42.82	24.08
C104	44.46	46.62	54°38'11"	42.80	24.08
C105	59.33	46.62	72°54'38"	55.41	34.44
C106	36.60	25.00	83°53'20"	33.42	22.47
C107	126.26	474.35	15°15'03"	125.89	63.51
C108	182.09	218.00	42°36'00"	158.38	84.99
C109	60.05	234.62	14°39'55"	59.89	30.19
C110	20.64	25.00	47°17'55"	20.06	10.95
C111	44.29	45.62	55°37'21"	42.57	24.06
C112	10.24	45.62	12°51'29"	10.22	5.14
C113	42.72	45.62	53°38'04"	41.17	23.07
C114	20.36	25.00	46°39'48"	19.80	10.78
C115	6.88	457.73	0°51'39"	6.88	3.44
C116	66.07	457.73	8°18'14"	66.01	33.09
C117	76.86	457.73	9°37'17"	76.77	38.52
C118	27.00	457.73	3°22'49"	27.00	13.51
C119	63.27	490.98	7°23'02"	63.23	31.68
C120	35.84	25.00	82°07'58"	32.85	21.78
C121	9.01	45.62	11°19'14"	9.00	4.52
C122	40.22	45.62	50°30'44"	38.93	21.52
C123	40.22	45.62	50°30'44"	38.93	21.52
C124	40.22	45.62	50°30'44"	38.93	21.52
C125	13.65	45.62	17°08'32"	13.60	6.88
C126	60.87	19.38	180°00'00"	38.75	0.00
C127	60.87	19.37	180°00'00"	38.75	0.00
C128	37.92	25.00	86°54'25"	34.39	23.69
C129	126.13	201.37	35°53'12"	124.08	65.21
C130	11.10	201.37	3°09'33"	11.10	5.55
C131	254.17	201.37	35°53'02"	11.10	0.00
C132	167.09	1485.40	6°26'42"	167.00	83.63
C133	81.73	1485.40	3°03'09"	81.72	40.88
C134	81.38	1485.40	3°08'20"	81.37	40.70
C135	67.59	1485.40	2°36'11"	67.50	33.76
C136	65.83	1485.40	2°32'21"	65.82	32.92
C137	65.20	1485.40	2°30'53"	65.19	32.60
C138	66.10	1485.40	2°32'59"	66.10	33.06
C139	82.04	1485.40	3°09'52"	82.03	41.03
C140	49.00	1485.40	3°09'05"	48.99	24.05
C141	24.38	20.00	69°54'28"	22.90	13.96
C142	19.01	160.00	6°48'28"	19.00	9.52
C143	47.59	160.00	17°02'28"	47.41	23.97
C144	21.48	160.00	28°05'57"	20.27	9.66
C145	20.08	40.00	8°13'00"	20.07	10.08
C146	16.31	25.00	37°23'16"	16.03	8.46
C147	57.08	25.00	74°44'26"	53.12	33.42
C148	55.10	43.75	72°09'44"	51.53	31.88
C149	85.02	43.75	111°20'50"	72.26	64.07
C150	30.11	25.00	69°00'41"	28.32	17.19
C151	15.33	140.00	1°10'00"	15.33	7.67
C152	91.08	125.00	41°14'54"	89.08	47.67
C153	59.58	125.00	27°18'27"	59.01	30.36
C154	80.88	1497.40	3°05'41"	80.87	40.45
C155	34.26	125.00	16°16'18"	34.26	17.28
C156	66.36	84.45	45°01'19"	64.67	35.00
C157	54.87	68.83	45°01'19"	53.47	28.94
C158	25.07	99.08	14°29'46"	25.00	12.60
C159	50.29	99.08	28°04'48"	49.75	25.70
C160	2.50	99.08	1°26'45"	2.50	1.25
C161	86.28	75.00	65°54'38"	81.60	48.62
C162	60.92	60.92	94°20'52"	88.56	65.14
C163	25.97	25.00	59°31'52"	24.82	12.80
C164	47.43	45.62	59°33'33"	45.32	26.11
C165	35.60	45.62	44°42'08"	34.70	28.26
C166	38.65	45.62	45°52'15"	37.44	28.77
C167	20.12	45.62	25°15'48"	19.95	10.22
C168	22.44	25.00	51°25'54"	21.70	12.04
C169	43.61	89.62	27°52'40"	43.18	22.24
C170	48.33	89.62	28°01'37"	47.44	24.44
C171	41.90	25.00	96°01'37"	37.17	27.88
C172	105.05	132.15	45°32'42"	102.30	55.48
C173	54.24	165.40	18°17'25"	54.00	27.37
C174	34.30	165.40	11°52'31"	34.17	22.24
C175	50.56	165.40	17°30'47"	50.29	25.58
C176	37.79	25.00	86°36'45"	34.36	23.46
C177	7.04	20.00	20°09'36"	6.99	3.55
C178	91.14	1497.40	3°29'14"	91.12	45.78
C179	9.99	5.00	114°29'37"	8.41	7.97
C180	26.26	89.63	16°47'07"	26.16	13.22
C181	9.89	5.00	114°29'37"	8.41	7.97
C182	49.98	19.37	147°47'54"	37.23	67.12
C183	10.96	1485.40	0°25'22"	10.96	5.48
C184	50.79	160.00	7°05'07"	49.77	9.81
C185	50.69	160.00	10°03'48"	49.62	10.77
C186	54.60	115.73	27°01'52"	54.10	27.52
C187	55.03	474.35	6°38'49"	55.00	28.85
C188	75.37	25.00	28°06'15"	75.36	19.00
C189	81.42	1507.40	3°06'01"	81.41	40.72
C190	8.72	300.00	1°39'54"	8.72	4.36

THE HIGHLANDS AT TANOAN
ALBUQUERQUE, NEW MEXICO

NOVEMBER, 1986

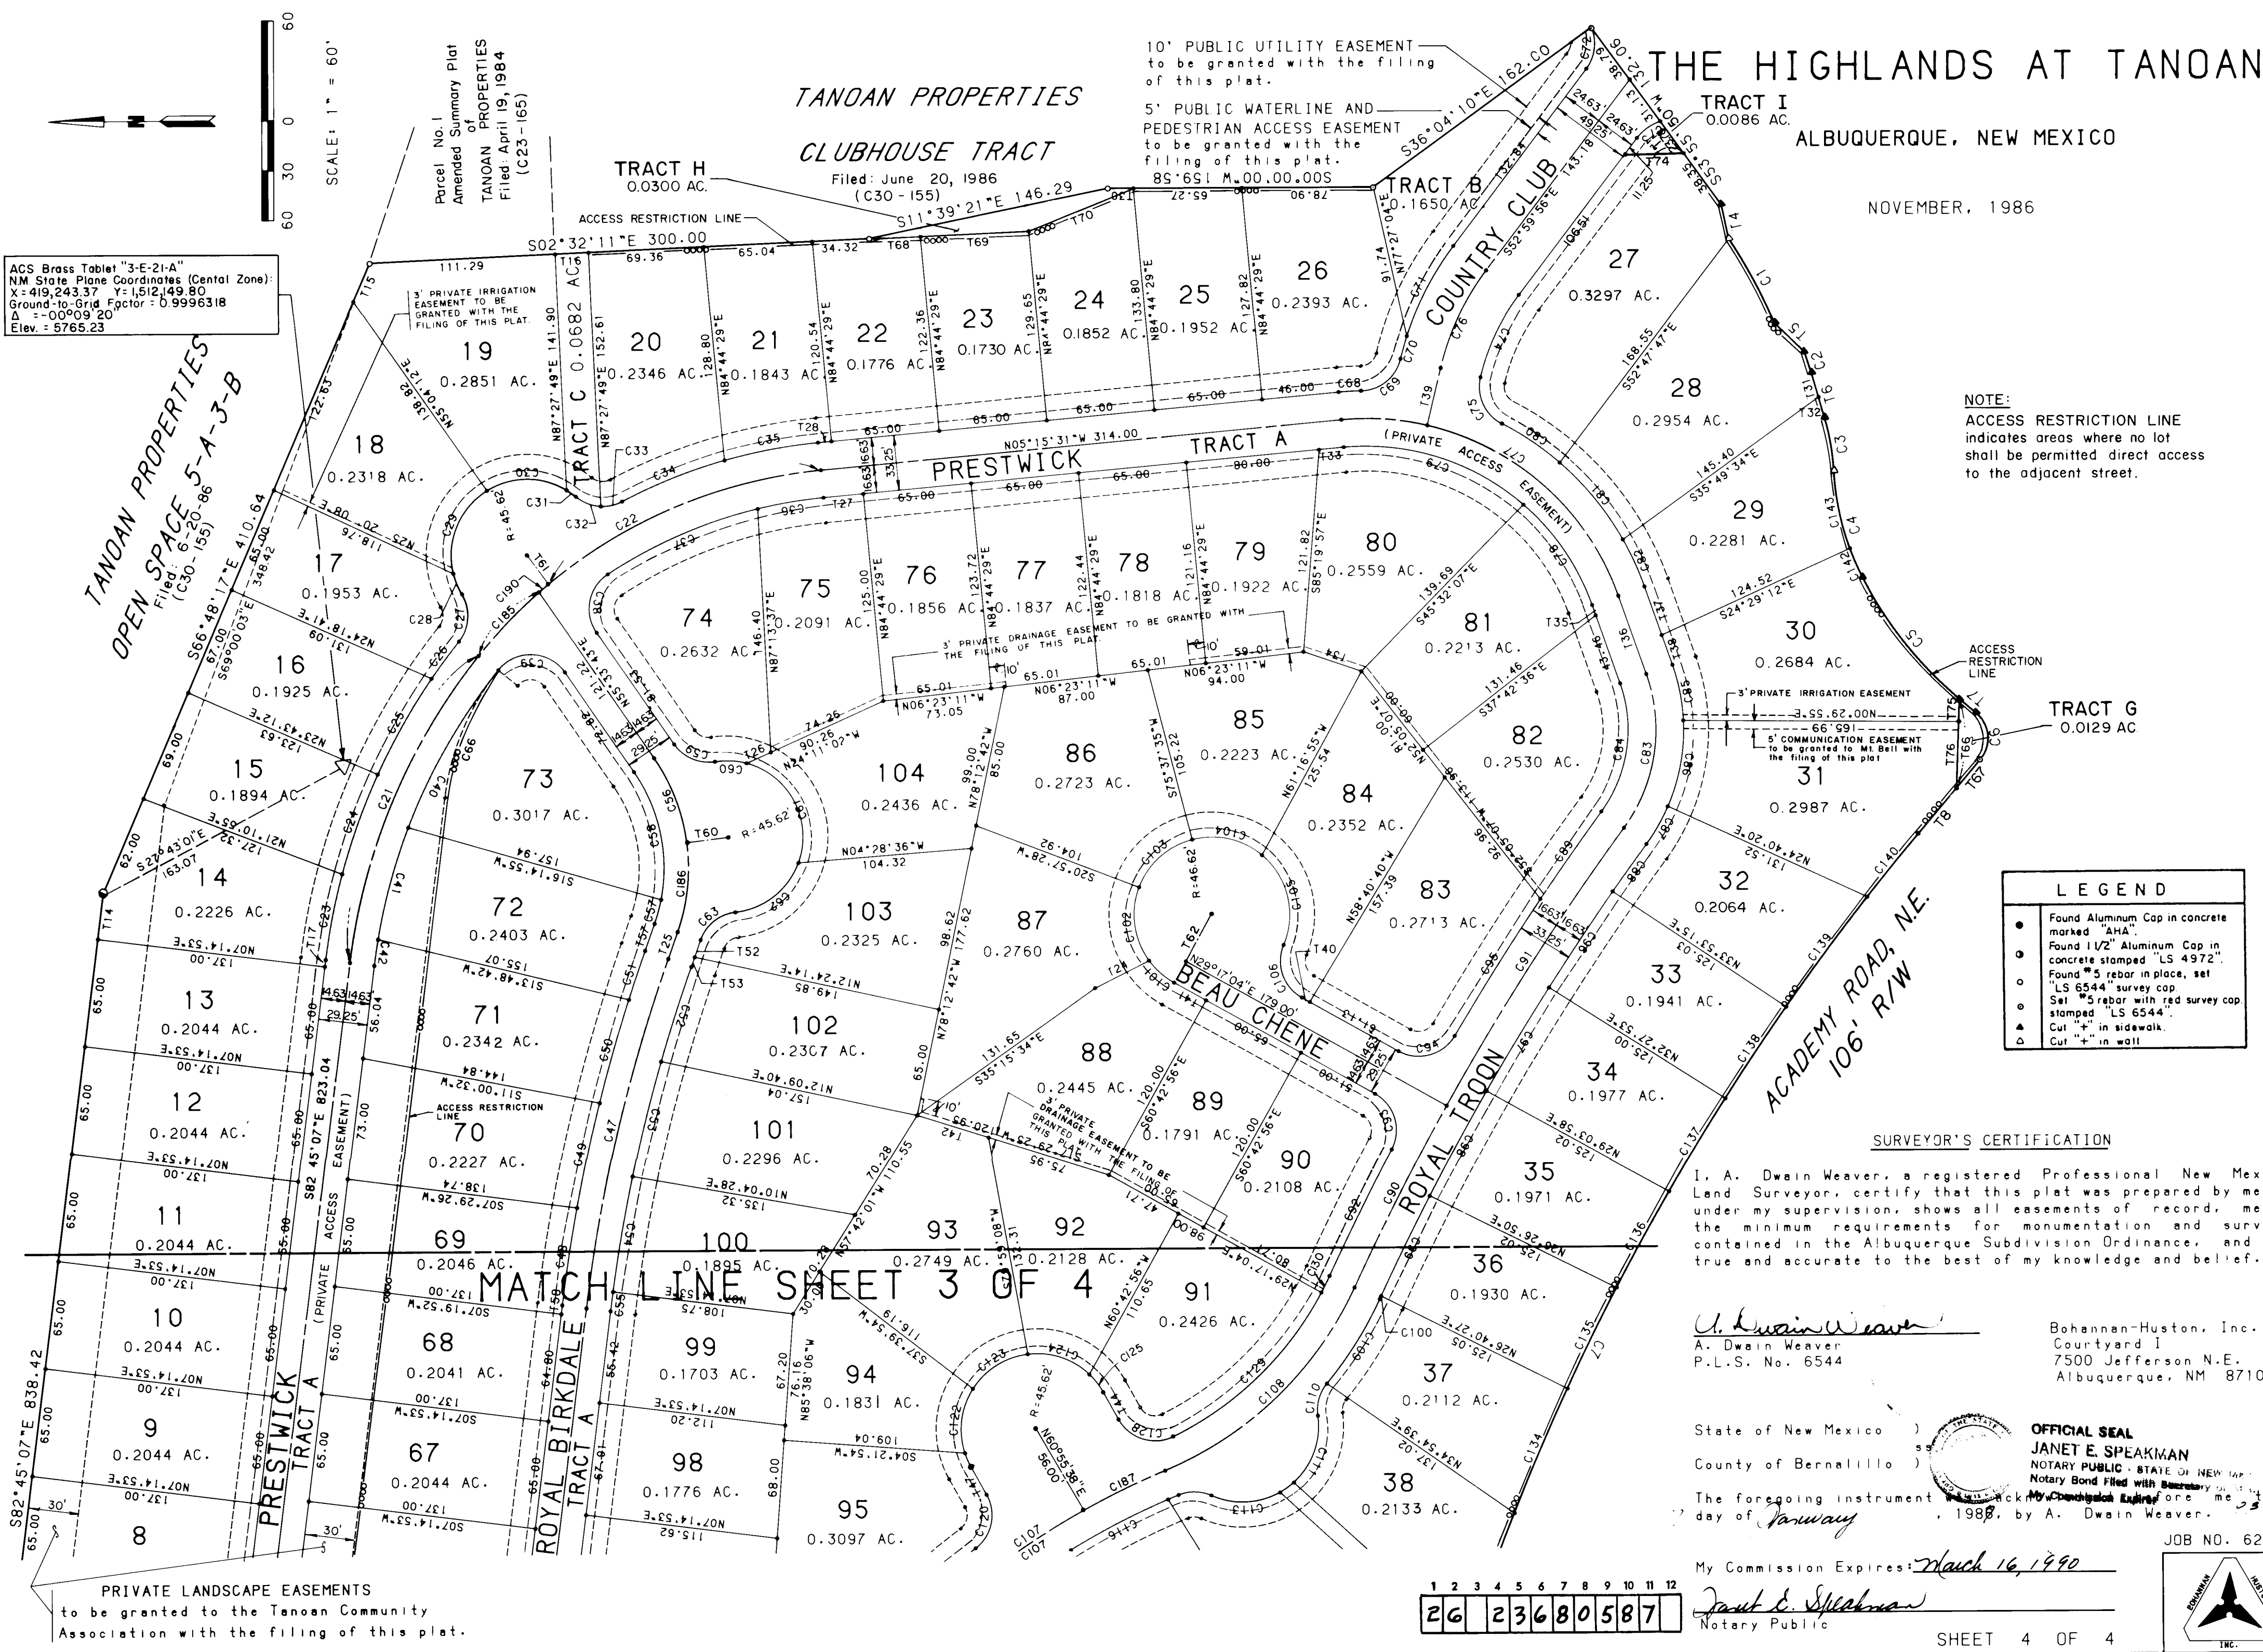

BRUNING 44-232

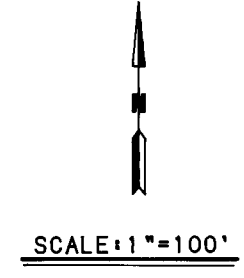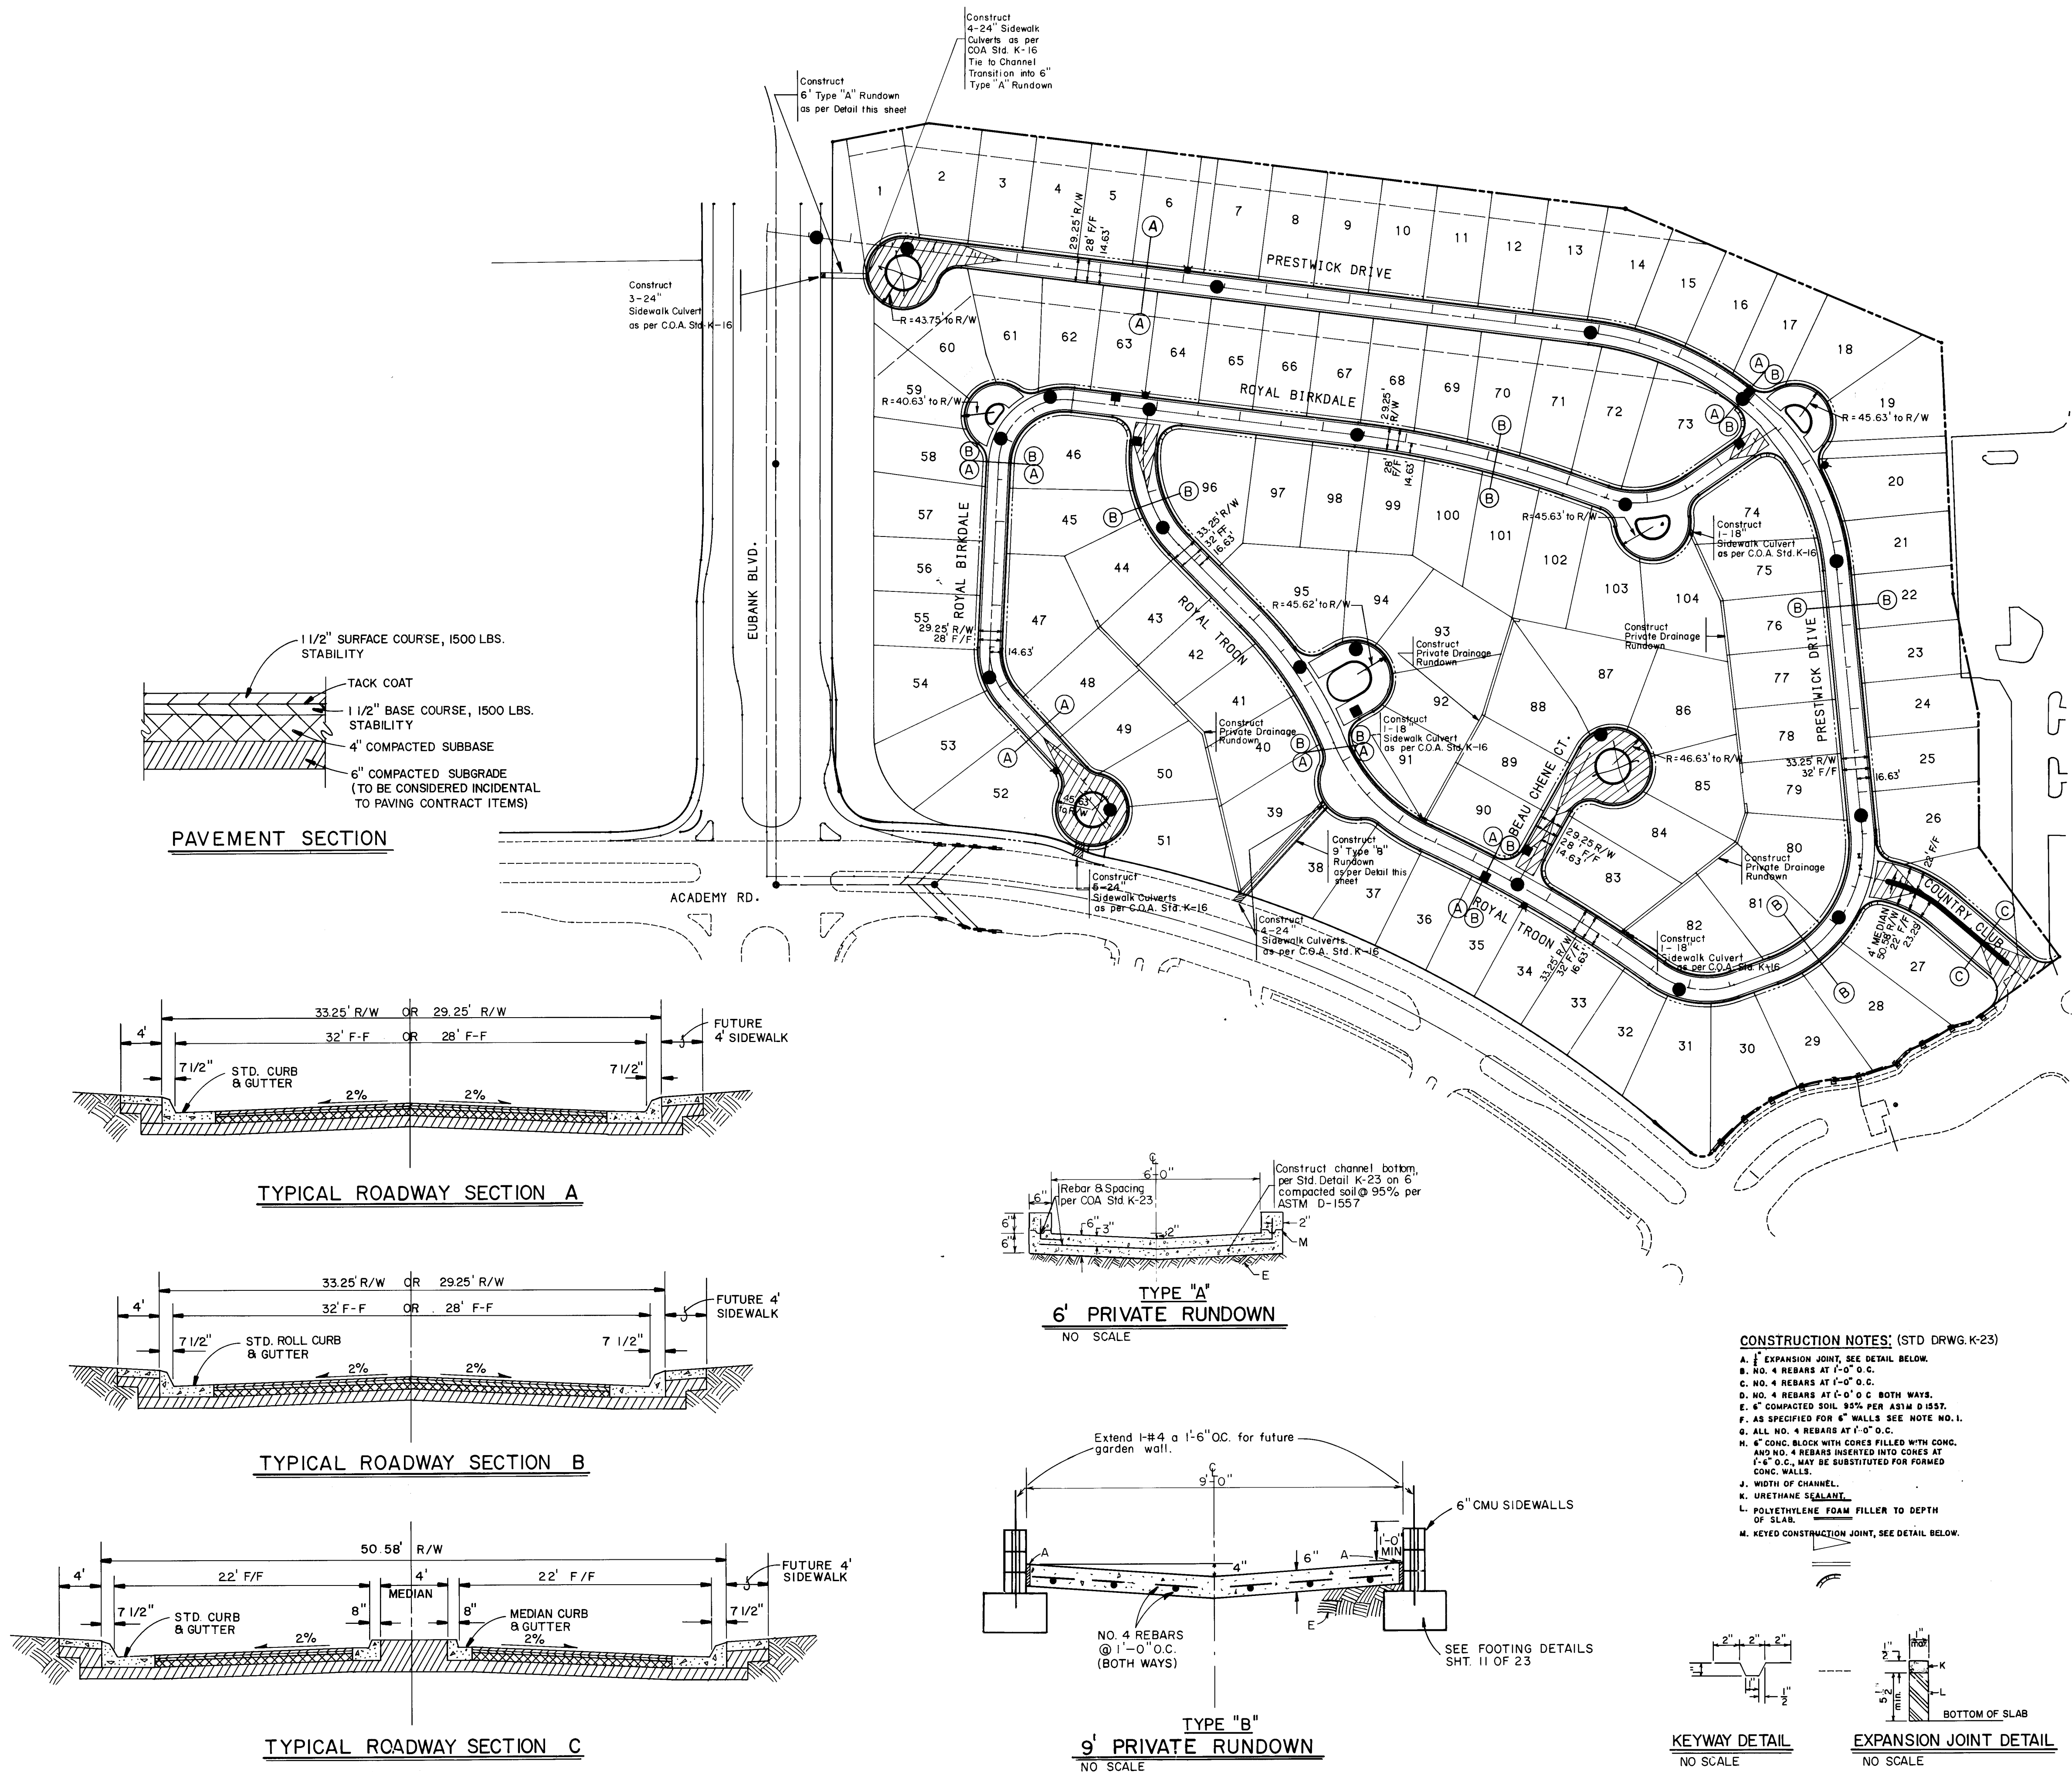


- NOTES**
1. ALL CURB RETURN RADII SHALL BE 25' TO BACK OF CURB UNLESS OTHERWISE SPECIFIED.
 2. ALL ISLAND CONSTRUCTION SHALL CONSIST OF STANDARD MEDIAN CURB AND GUTTER.
 3. THE CONTRACTOR IS TO FIELD VERIFY ALL EXISTING UTILITY LOCATIONS AND NOTIFY THE ENGINEER OF ANY DISCREPANCIES.

- LEGEND**
- PROJECT BOUNDARY
 - PROPOSED CURB AND GUTTER
 - PROPOSED CROWN TO NO CROWN TRANSITION
 - FUTURE SIDEWALK
 - PROPOSED HANDICAP RAMP
 - PROPOSED SANITARY MANHOLE
 - PROPOSED VALVE BOX
 - EXISTING STORM DRAIN INLET
 - EXISTING STORM DRAIN MANHOLE
 - EXISTING CURB & GUTTER
 - VALLEY GUTTER

1 2 3 4 5 6 7 8 9 10 11 12
26 23 68 06 87

CITY OF ALBUQUERQUE PUBLIC WORKS ENGINEERING					
TITLE: THE HIGHLANDS AT TANOAN PAVING PLAN					
APPROVALS	ENGINEER	DATE	APPROVALS	ENGINEER	DATE
JRC	WJW	1/14/88	TRANS	WJW	1/14/88
DRAWING NO. 2368			MAP NO. E-21		
SHEET 6			OF 23		

ENGINEER'S SEAL		SURVEY INFORMATION		BENCH MARKS		AS-BUILT INFORMATION	
BY		FIELD NOTES		A STANDARD ACS BRASS TABLET STAMPED		CONTRACTOR	
DATE		DATE		"4E21A" SET IN TOP OF A CONCRETE POST. THE BENCHMARK IS "300' WEST AND "560' NORTH FROM INTERSECTION OF EUBANK BLVD. AND ACADEMY RD. ELEVATION = 5698.12 FEET		WORK	
REVISIONS		NO.		NO.		STAMPED BY	
DESIGN		DATE		DATE		DATE	
BY		BY		BY		DATE	
KLD		KLD		KLD		DATE	
10/86		10/86		10/86		DATE	
10/86		10/86		10/86		DATE	
10/86		10/86		10/86		DATE	

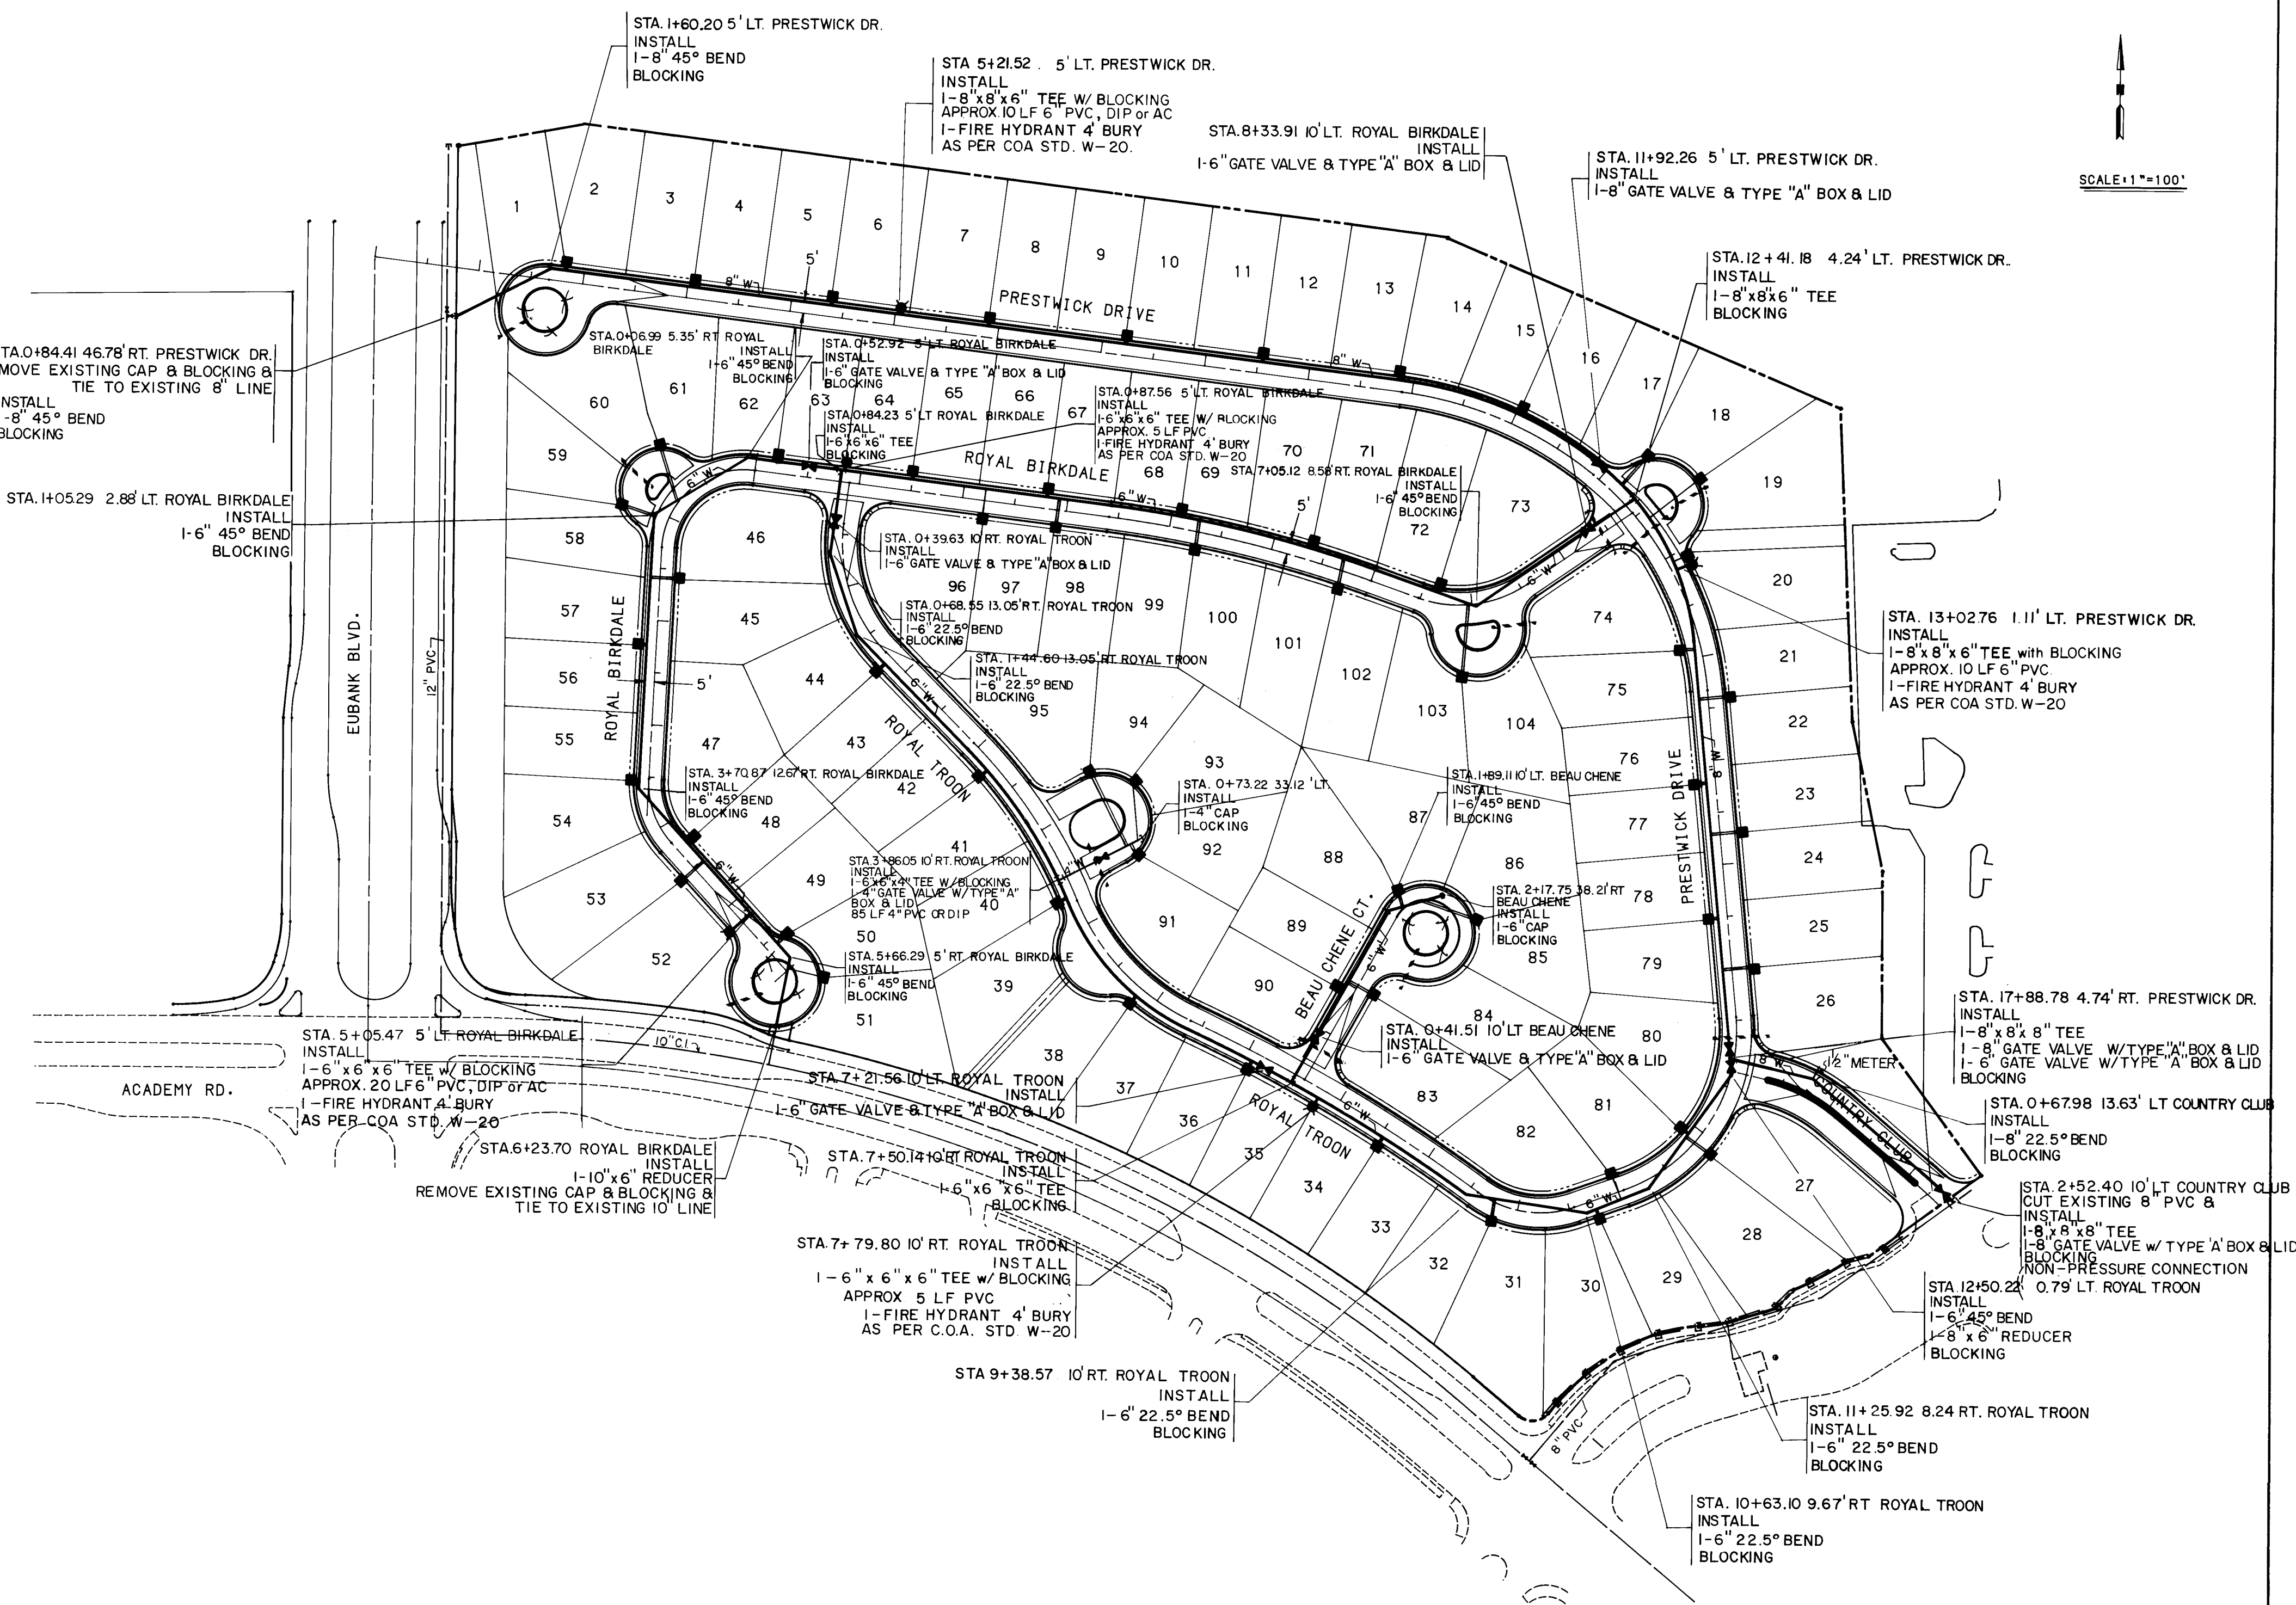

NOTES

1. THE CONTRACTOR IS TO FIELD VERIFY ALL EXISTING UTILITY LOCATIONS AND NOTIFY THE ENGINEER IMMEDIATELY OF ANY DISCREPANCIES.

SCALE: 1"=100'


LEGEND

- PROJECT BOUNDARY
- EXISTING CURB AND GUTTER
- PROPOSED CURB AND GUTTER
- PROPOSED WATER LINE
- PROPOSED FIRE HYDRANT
- PROPOSED GATE VALVE
- DOUBLE WATER SERVICE CONNECTION
- SINGLE WATER SERVICE CONNECTION
- PROPOSED CAP
- PROPOSED 4" SLEEVE FOR LANDSCAPING MARK CURB WITH PAINT BOTH ENDS EXTEND 1' BEYOND CONCRETE CURB OR SIDEWALK

1 2 3 4 5 6 7 8 9 10 11 12
26 1 6 8 0 7 8 7

CITY OF ALBUQUERQUE PUBLIC WORKS ENGINEERING					
TITLE: THE HIGHLANDS AT TANOAN WATER SYSTEM LAYOUT					
APPROVALS	ENGINEER	DATE	APPROVALS	ENGINEER	DATE
D.R.C. Chairperson	<i>[Signature]</i>	1/22/87	Parks & Rec. Dept.		
Trans. Dev.	<i>[Signature]</i>	1/14/87	User Dept.		
Utility Dev.	<i>[Signature]</i>	1/14/87	User Dept.		
DRAWING NO. 2368		MAP NO. E-21		SHEET 7 OF 23	

--	--	
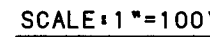

1. THE CONTRACTOR IS TO FIELD VERIFY ALL EXISTING UTILITY LOCATIONS AND NOTIFY THE ENGINEER IMMEDIATELY OF ANY DISCREPANCIES.

ENGINEER'S SEAL

[illegible]

1	2	3	4	5	6	7	8	9	10	11	12
2	6			2	3	6	8	0	8	8	7



CITY OF ALBUQUERQUE
PUBLIC WORKS
ENGINEERING




TITLE: THE HIGHLANDS AT TANOAN
SANITARY SEWER LAYOUT

APPROVALS	ENGINEER	DATE	APPROVALS	ENGINEER	DATE
D.R.C. Chairperson	<i>[Signature]</i>	1/27/87	Parks & Rec. Dept.		
Trans. Dev.	<i>[Signature]</i>	1/14/87	User Dept.		
Utility Dev.	<i>[Signature]</i>	1/14/87	User Dept.		

DRAWING NO. 2368	MAP NO. E-21	SHEET 8 OF 23
---------------------	-----------------	---------------

 PROJECT BOUNDARY
 EXISTING CURB AND GUTTER
 PROPOSED CURB AND GUTTER
 PROPOSED SANITARY SEWER LINE
 PROPOSED SANITARY SEWER MANHOLE
 PROPOSED SANITARY SEWER SERVICE CONNECTION
 SANITARY SEWER DIRECTION OF FLOW ARROW

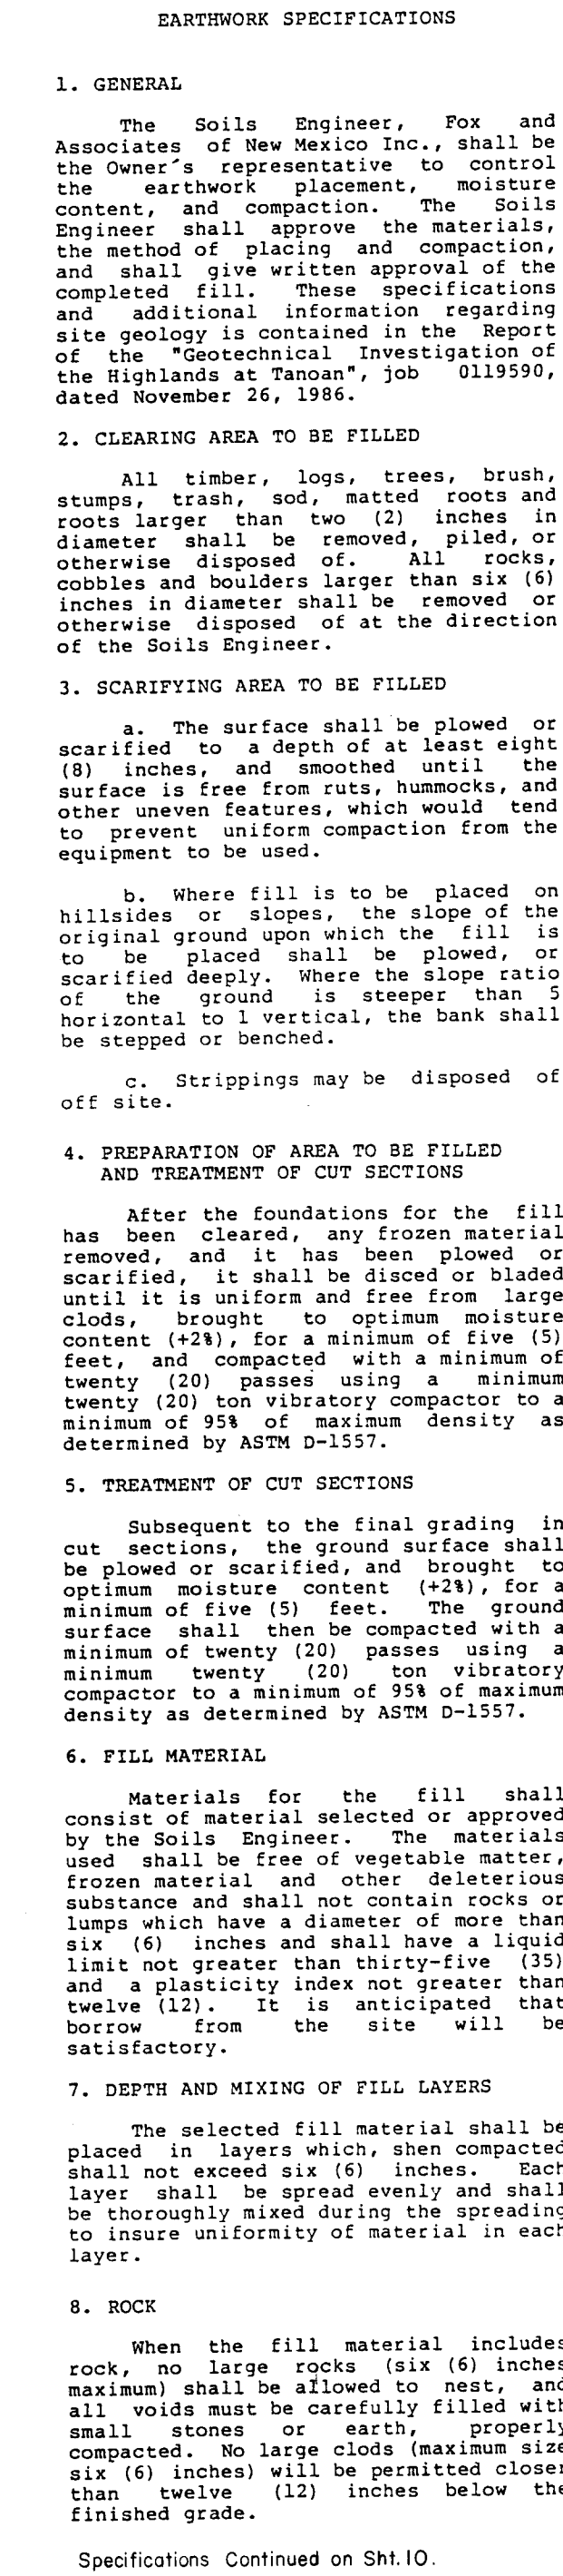

APPROVED FOR ROUGH GRADING $\pm 1'$;

Billy G. Aoolshy 1/5/87
HYDROLOGY ENGINEER DATE

NOTE: ALL NUISANCE WATER SHALL BE CONTAINED ON SITE
OR CONTAINED WITHIN PROPOSED DRAINAGE FACILITY.
 NO NUISANCE WATER SHALL BE DISCHARGED ACROSS
SIDEWALK SURFACES, IN ACCORDANCE WITH ORDINANCE
56-1978.

CITY OF ALBUQUERQUE
PUBLIC WORKS
ENGINEERING

TITLE: THE HIGHLANDS AT TANOAN
GRADING PLAN

APPROVALS	ENGINEER	DATE	APPROVALS	ENGINEER	DATE
City Engineer	<i>[Signature]</i>	1/7/87	Liquid Waste	WJW	1/14/87
A C E - Design	<i>[Signature]</i>	1/7/87	Traffic	WJW DWH	1/14/87
A C E -Hydrology	<i>[Signature]</i>	1/16/87	Water	WJW	1/14/87

DRAWING NO. 2368	MAP NO. E-21	SHEET 9 OF 23
---------------------	-----------------	---------------



9. MOISTURE CONTENT

The fill material shall be compacted at the optimum moisture content (+2%) specified for soils. Sufficient laboratory moisture density relationship tests will be made to determine the optimum moisture content for the various soils encountered in the borrow area. The Contractor may be required to add the necessary moisture to the fill material in the borrow area if, in the opinion of the Soils Engineer, it is not possible to obtain uniform moisture content by adding water to the fill surface.

10. AMOUNT OF COMPACTION

After each layer has been placed, mixed and spread evenly, it shall be thoroughly compacted to not less than 95% of maximum density as determined by ASTM D-1557.

11. COMPACTION OF FILL LAYERS

Compaction shall be by sheepfoot rollers, segmented steel wheeled rollers, multiple wheel pneumatic tired rollers, or other types of suitable compaction equipment. Compaction equipment shall be of such design that it will be able to compact the fill to the specified density. Compaction shall be accomplished while the fill material is at the specified moisture content. Compaction of each layer shall be continuous over its entire area and the equipment shall make sufficient trips to insure that the required density has been obtained.

12. UTILITY PLACEMENT

Trenches for utility lines shall be a minimum of sixteen (16) inches wide. Backfill for utility trenches may not be flooded or jetted. Backfill shall be placed and compacted as specified for structural backfill. Particular care shall be taken to compact the backfill below the "springline" of pipes.

13. COMPACTION OF SLOPES

Fill slopes shall be compacted by means of sheepfoot or vibratory rollers or other suitable equipment. Compacting operations shall be continued until the slopes are stable, but not too dense for planting and until there is not appreciable amount of loose soil on the slopes. Compacting of the slopes may be done progressively in increments of three (3) to five (5) feet in fill height, or after the fill is brought to its total height if approved by the Soils Engineer.

14. DENSITY TESTS

Field density tests shall be made by the Soils Engineer on each layer of fill. Sufficient tests will be made to determine the adequacy of the fill. The frequency of testing will be determined by the Soils Engineer in the field depending on the conditions encountered. Density tests shall be performed by ASTM Method D-1556 with four (4) or six (6) inch sand cone, ASTM Method D-2167 (water balloon) or approved Nuclear Density Devices and Methods.

15. FINISHED SLOPES AND BUILDING PADS

The fill operation shall be continued in six (6) inch compacted layers as specified above, until the fill has been brought to the finished slopes and elevations shown on the accepted plans. Slopes steeper than three (3) horizontal to one (1) vertical should be protected from erosion.

16. SUPERVISION

Supervision by the Soils Engineer shall be continuous during the fill and compacting operations so that he can certify that the fill was made in accordance with accepted specifications.

17. SEASONAL LIMITS

No fill material shall be placed upon frozen subgrade nor placed, spread, or rolled while it is frozen or thawing or during unfavorable weather conditions. When the work is interrupted by heavy rain, snow or frost penetration, fill operations shall not be resumed until the previously placed fill is as specified.

18. NOTICE REGARDING START OF GRADING

Notification shall be submitted to the Owner, the Soils Engineer, and the City Engineer of the start of grading operations at least three (3) days in advance of the starting date, and of any resumption dates when grading operations have been stopped for any reason other than adverse weather conditions.

APPROVED FOR ROUGH GRADING $\pm 1'$:*Silly G. Sordley* 1/5/87

HYDROLOGICAL ENGINEER DATE

NOTE: ALL NUISANCE WATER SHALL BE CONTAINED ON SITE,

OR CONTAINED WITHIN PROPOSED DRAINAGE FACILITIES.

NO NUISANCE WATER SHALL BE DISCHARGED ACROSS

SIDEWALK SURFACES, IN ACCORDANCE WITH ORDINANCE

56-1978.

CITY OF ALBUQUERQUE

PUBLIC WORKS

ENGINEERING


TITLE: THE HIGHLANDS AT TANOAN

GRADING PLAN


APPROVALS ENGINEER DATE APPROVALS ENGINEER DATE

City Engineer *[Signature]* 1/27/87 Liquid Waste *[Signature]* 1/14/87A C E - Design *[Signature]* 1/16/87 Traffic *[Signature]* 1/14/87A C E - Hydrology *[Signature]* 1/16/87 Water *[Signature]* 1/14/87


DRAWING NO. 2368 MAP NO. E-21 SHEET 10 OF 23

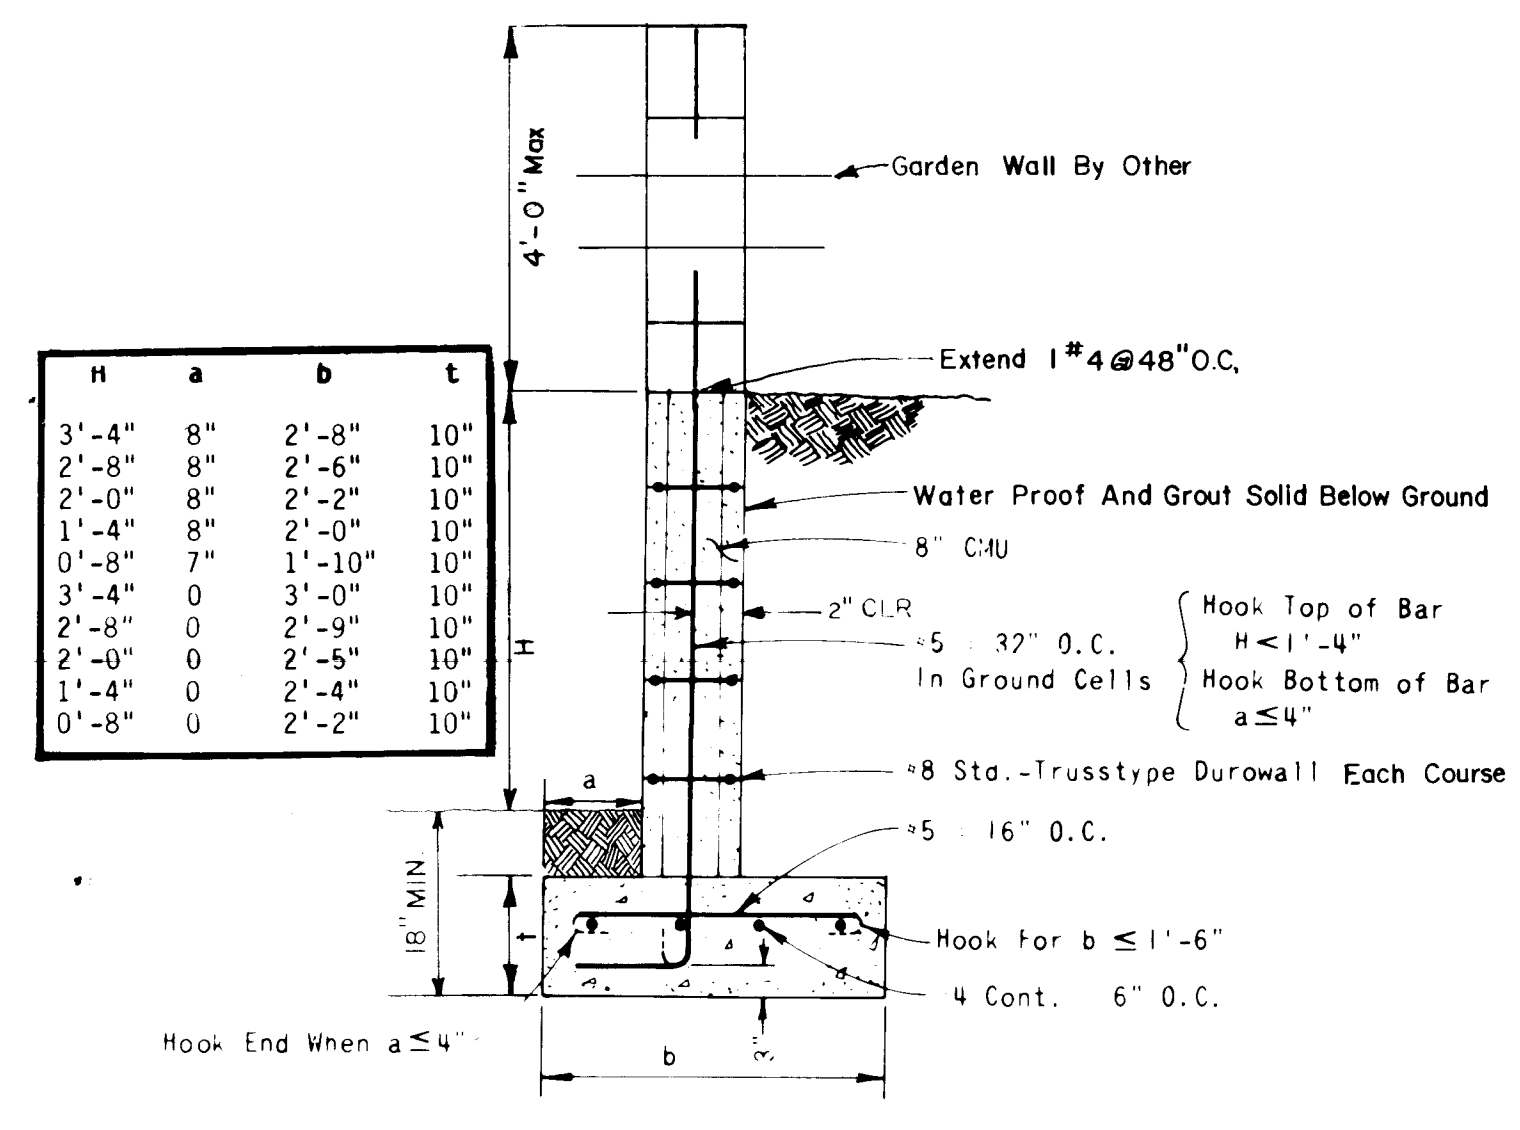

WALL #1
REINFORCED CONCRETE MASONRY WALL
0 to 3'-4"

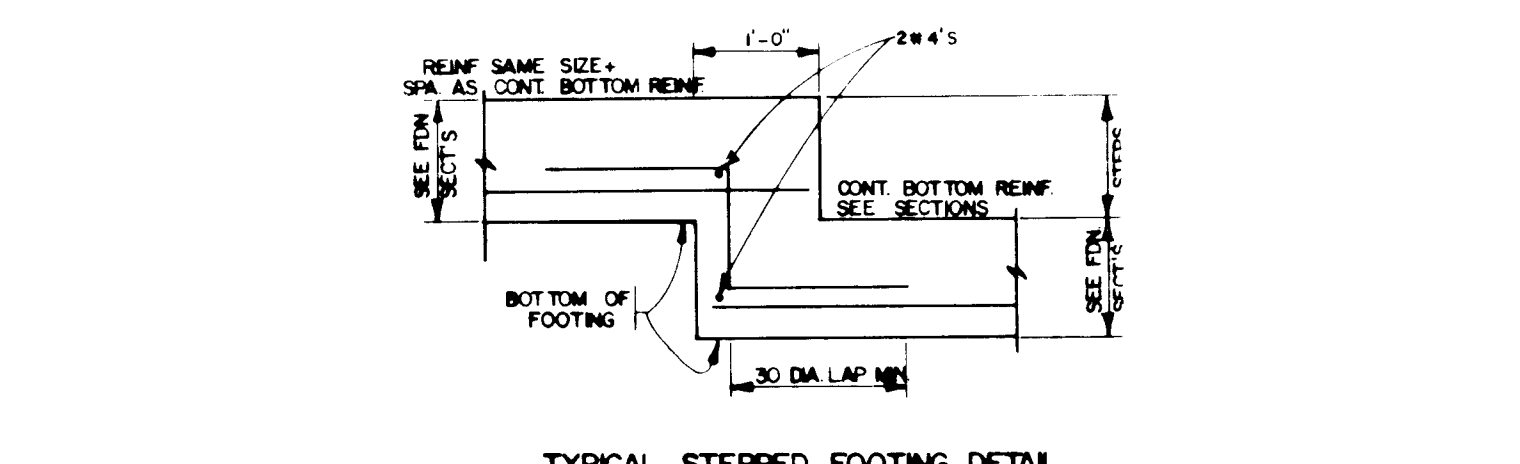


COPYRIGHT © 1986, BOHANNAN-HUSTON, INC. These documents are instruments of service and remain the property of the Engineer. No use or reuse of the documents shall be permitted unless authorized in writing by Bohannan-Huston, Inc. with proper compensation.

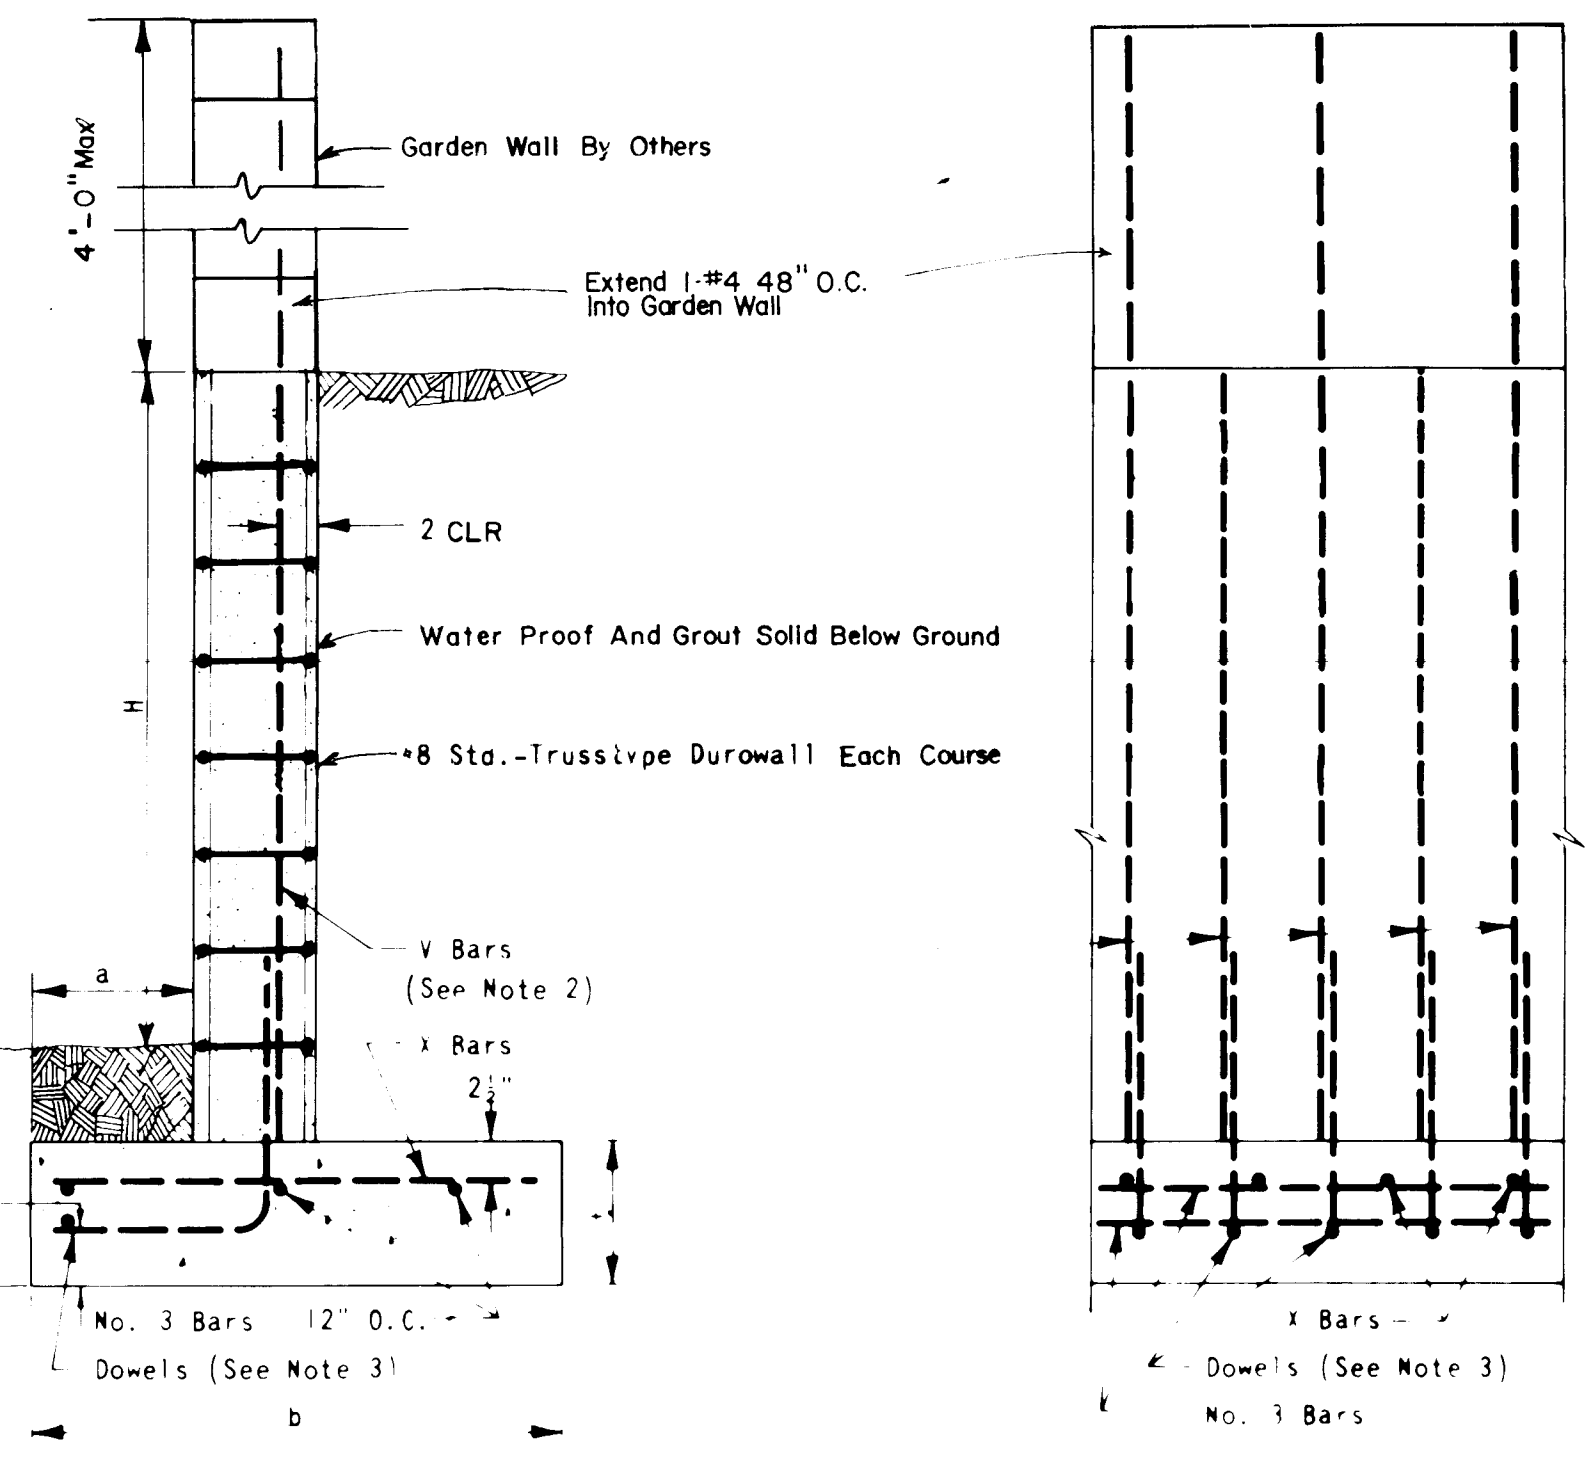

WALL #2
REINFORCED CONCRETE MASONRY WALLS
3'-4" to 6'-0"





H	a	b	t	V Bars	X Bars
ft.-in.	in.	ft.-in.	in.	(See Note 2)	
3'-4"	8"	2'-8"	10"	No. 4 @ 32"	No. 4 @ 27"
4'-0"	10"	2'-11"	10"	No. 5 @ 32"	No. 4 @ 27"
4'-8"	12"	3'-3"	10"	No. 5 @ 32"	No. 4 @ 27"
5'-4"	14"	3'-8"	10"	No. 5 @ 24"	No. 4 @ 30"
6'-0"	15"	4'-2"	12"	No. 5 @ 16"	No. 4 @ 25"

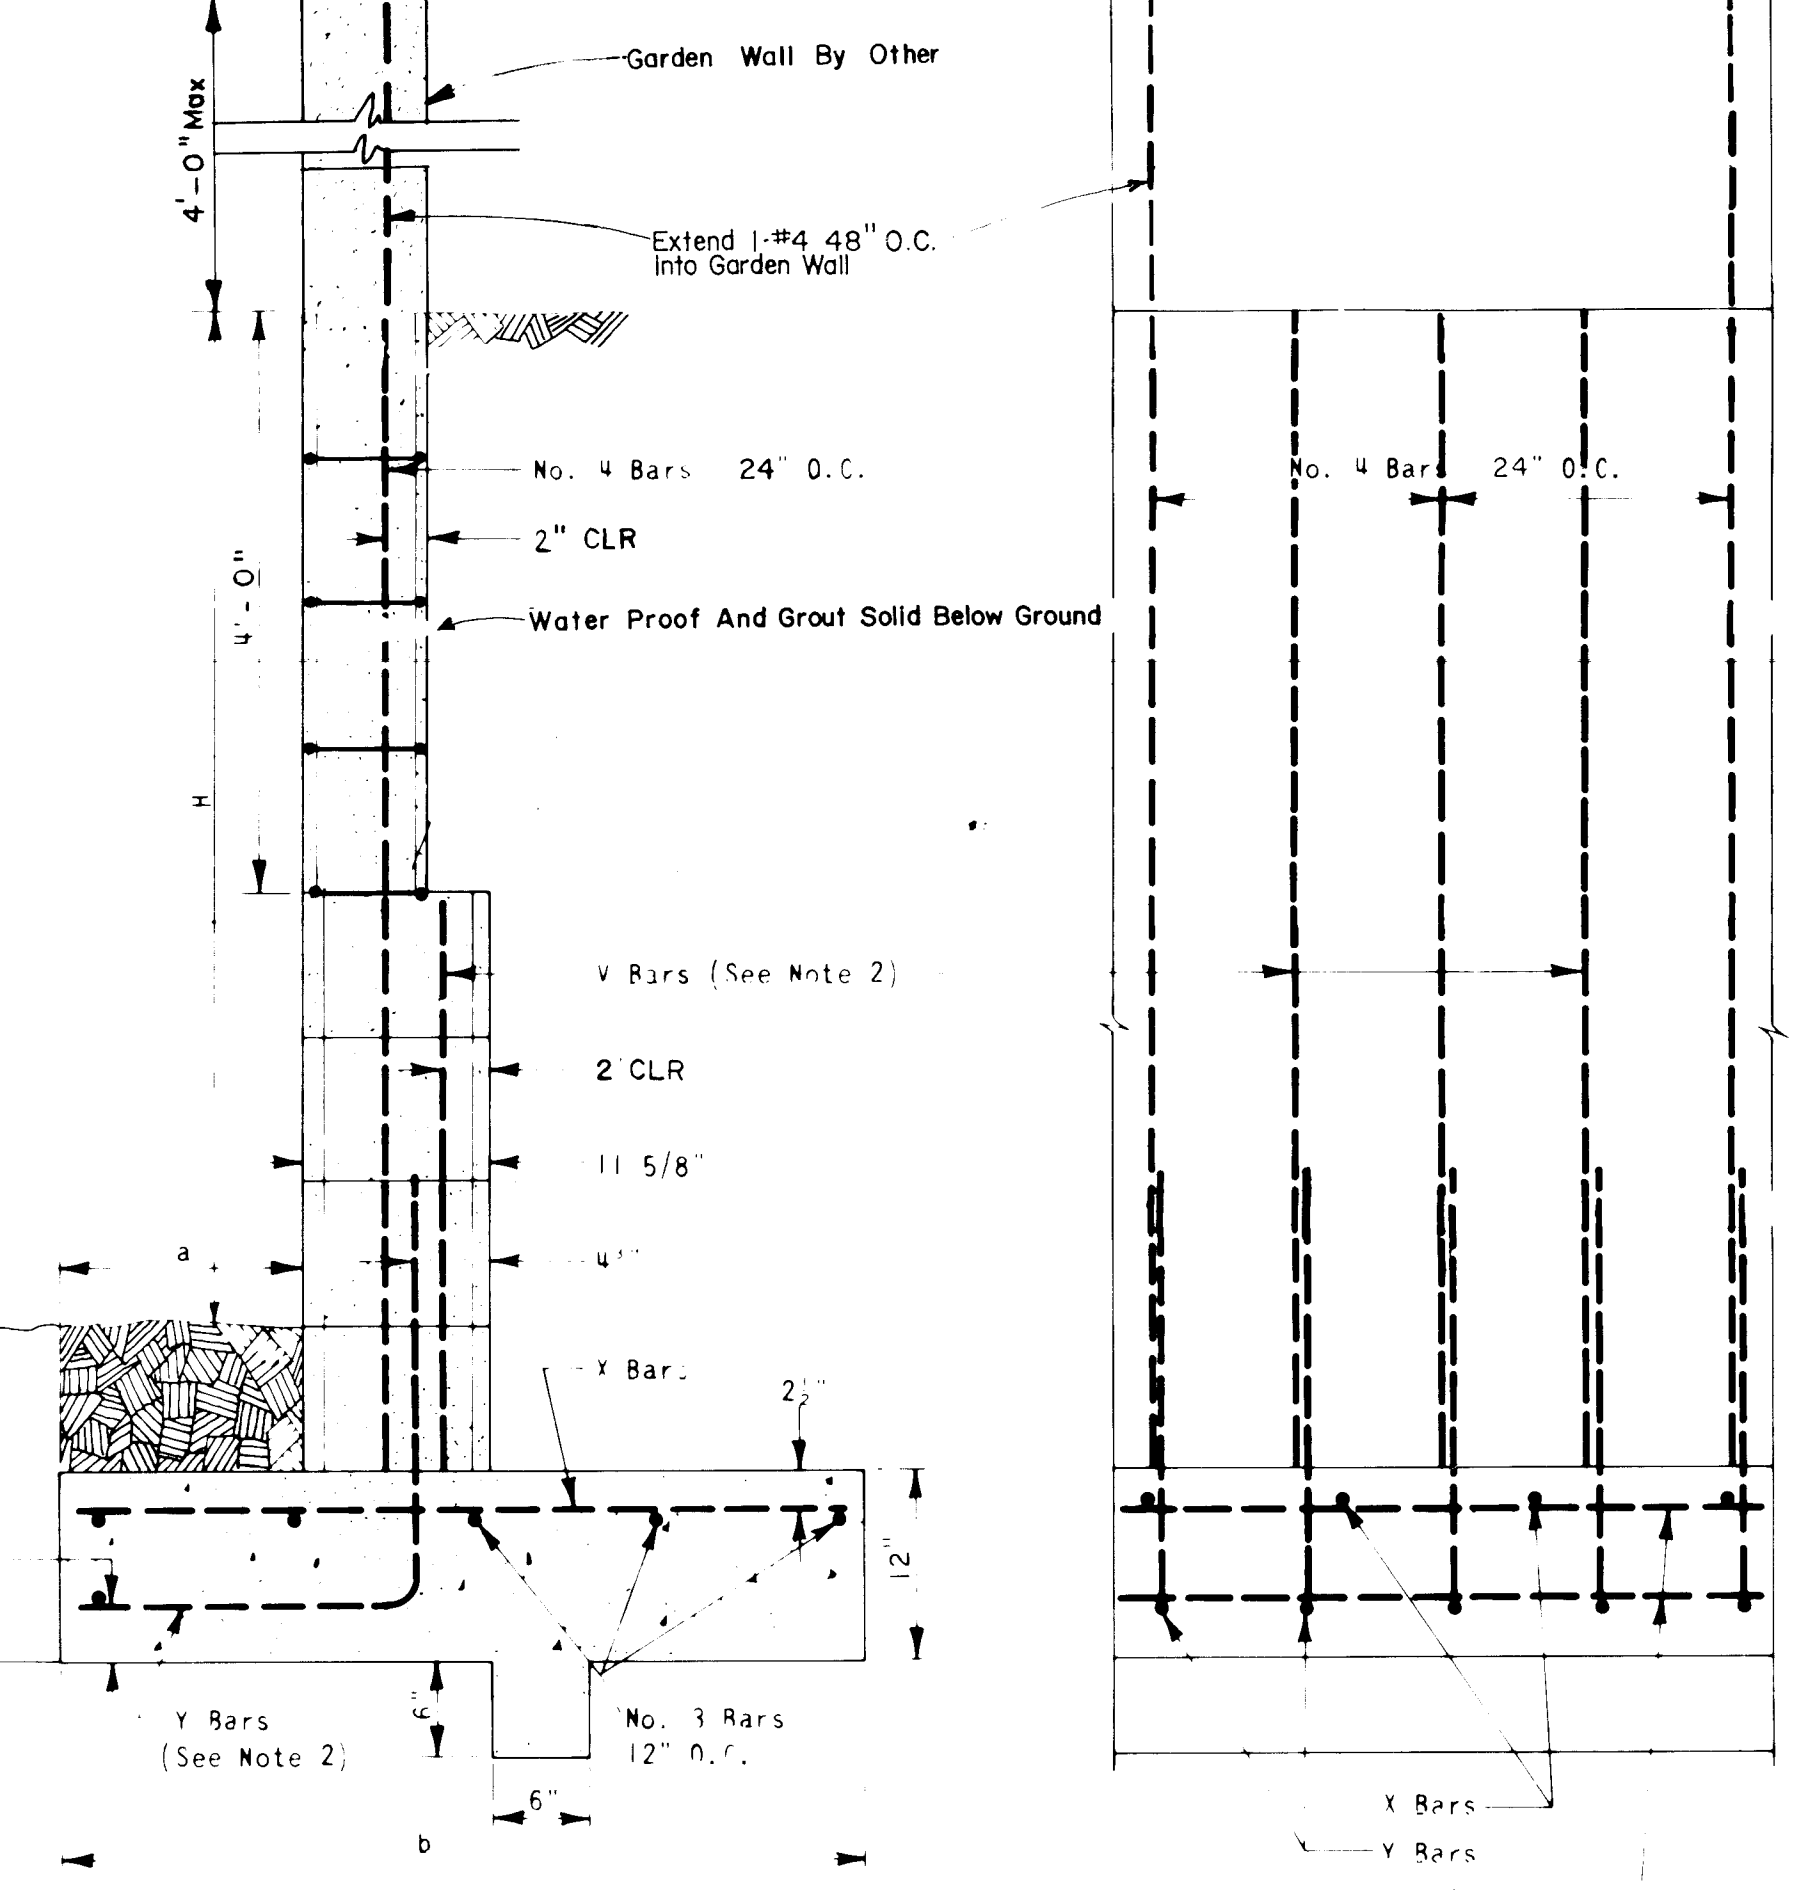


WALL #3
REINFORCED CONCRETE MASONRY - 8" & 12" WALLS

H	a	b	V & Y Bars	X Bars
6'	15"	4'-4"	#4 @ 24"	#4 @ 18"
8'	20"	5'-6"	#5 @ 18"	#5 @ 12"

THIS SHEET FOR INFORMATION ONLY. A SEPARATE BUILDING PERMIT IS REQUIRED FOR RETAINING WALL CONSTRUCTION.

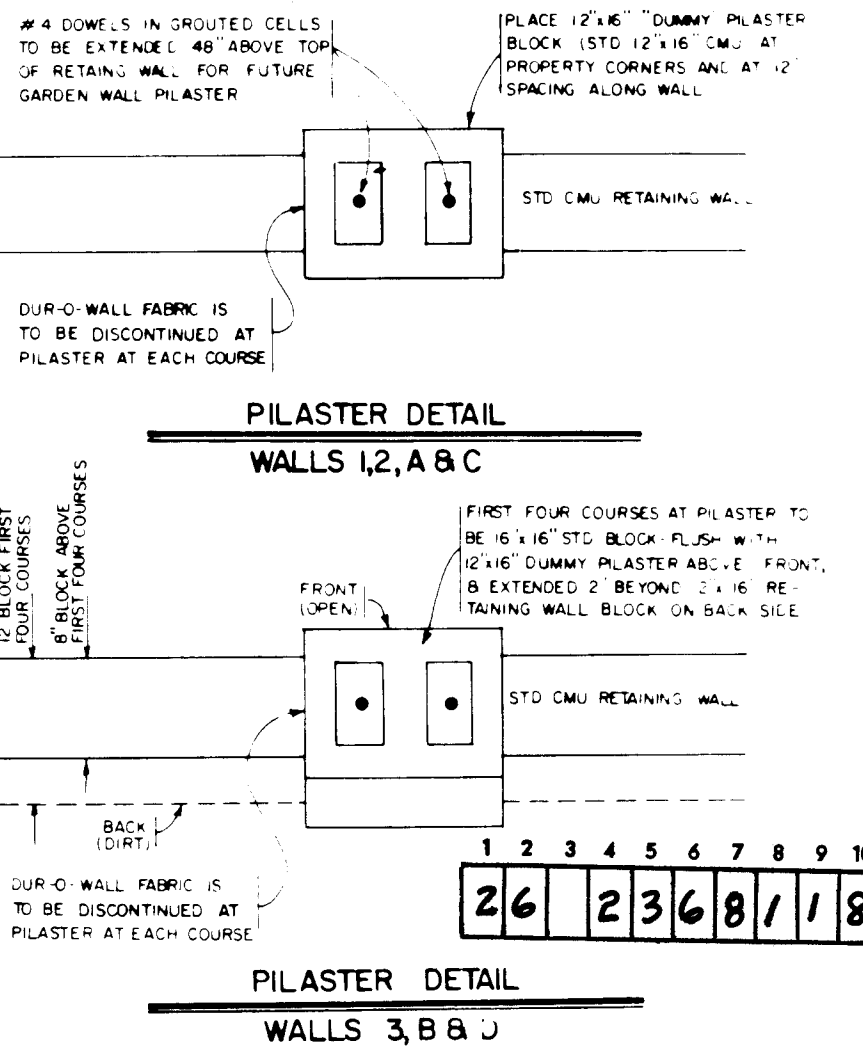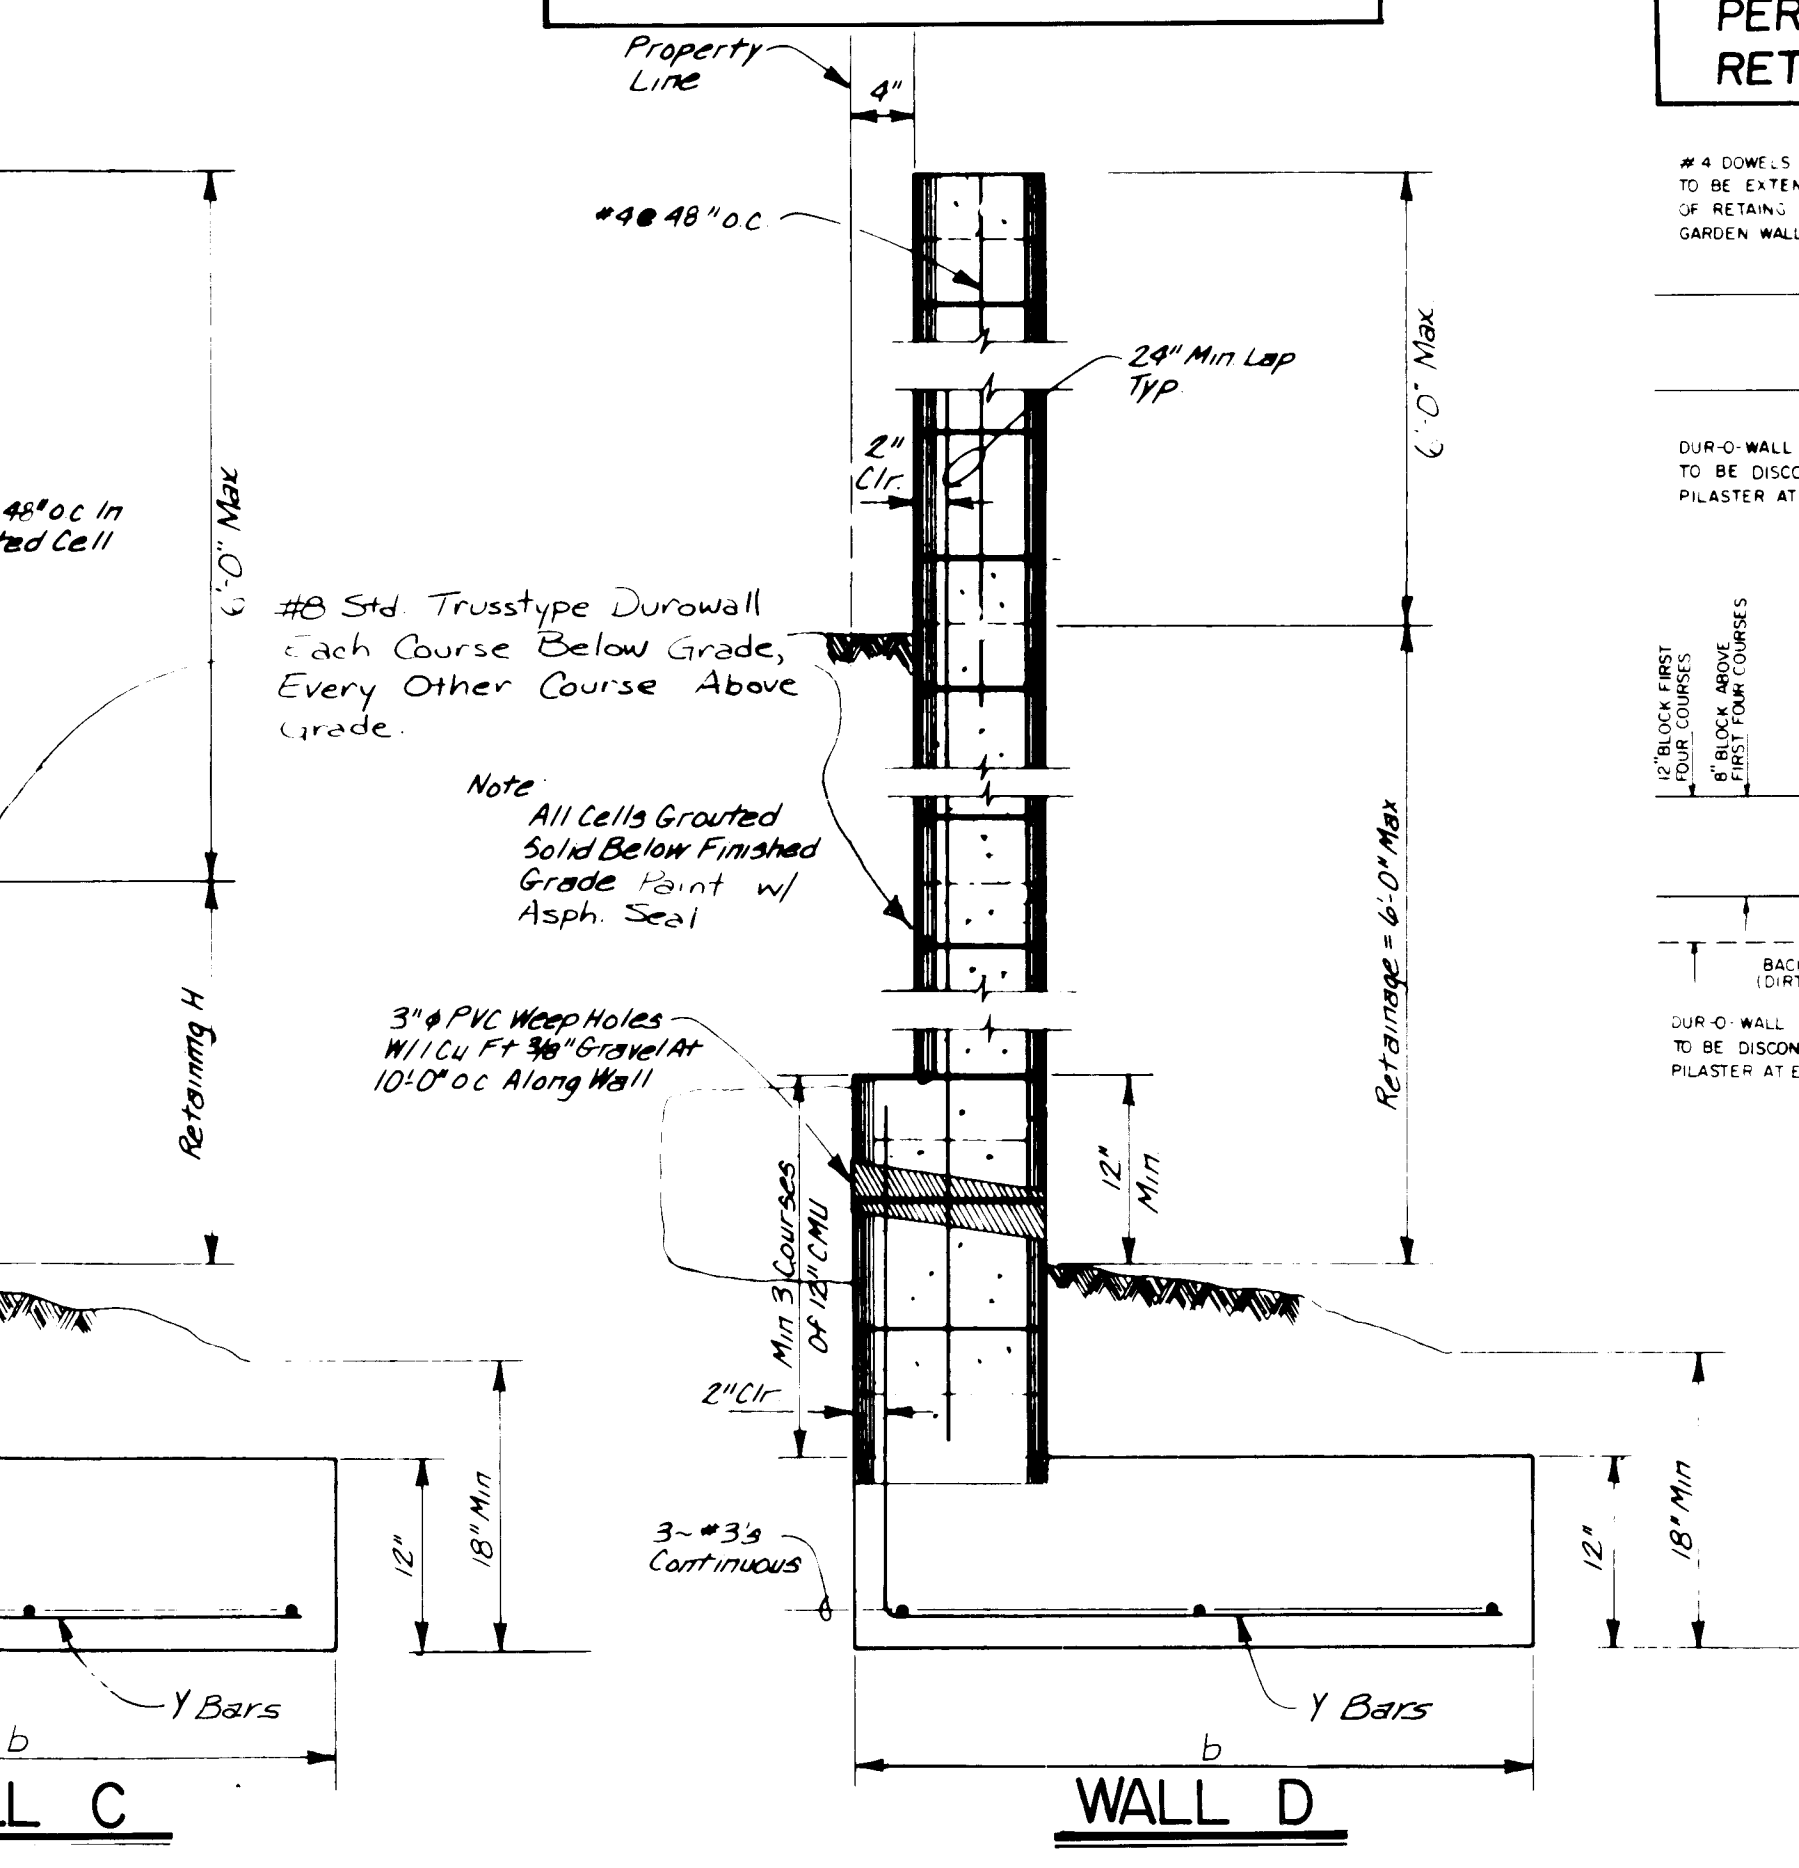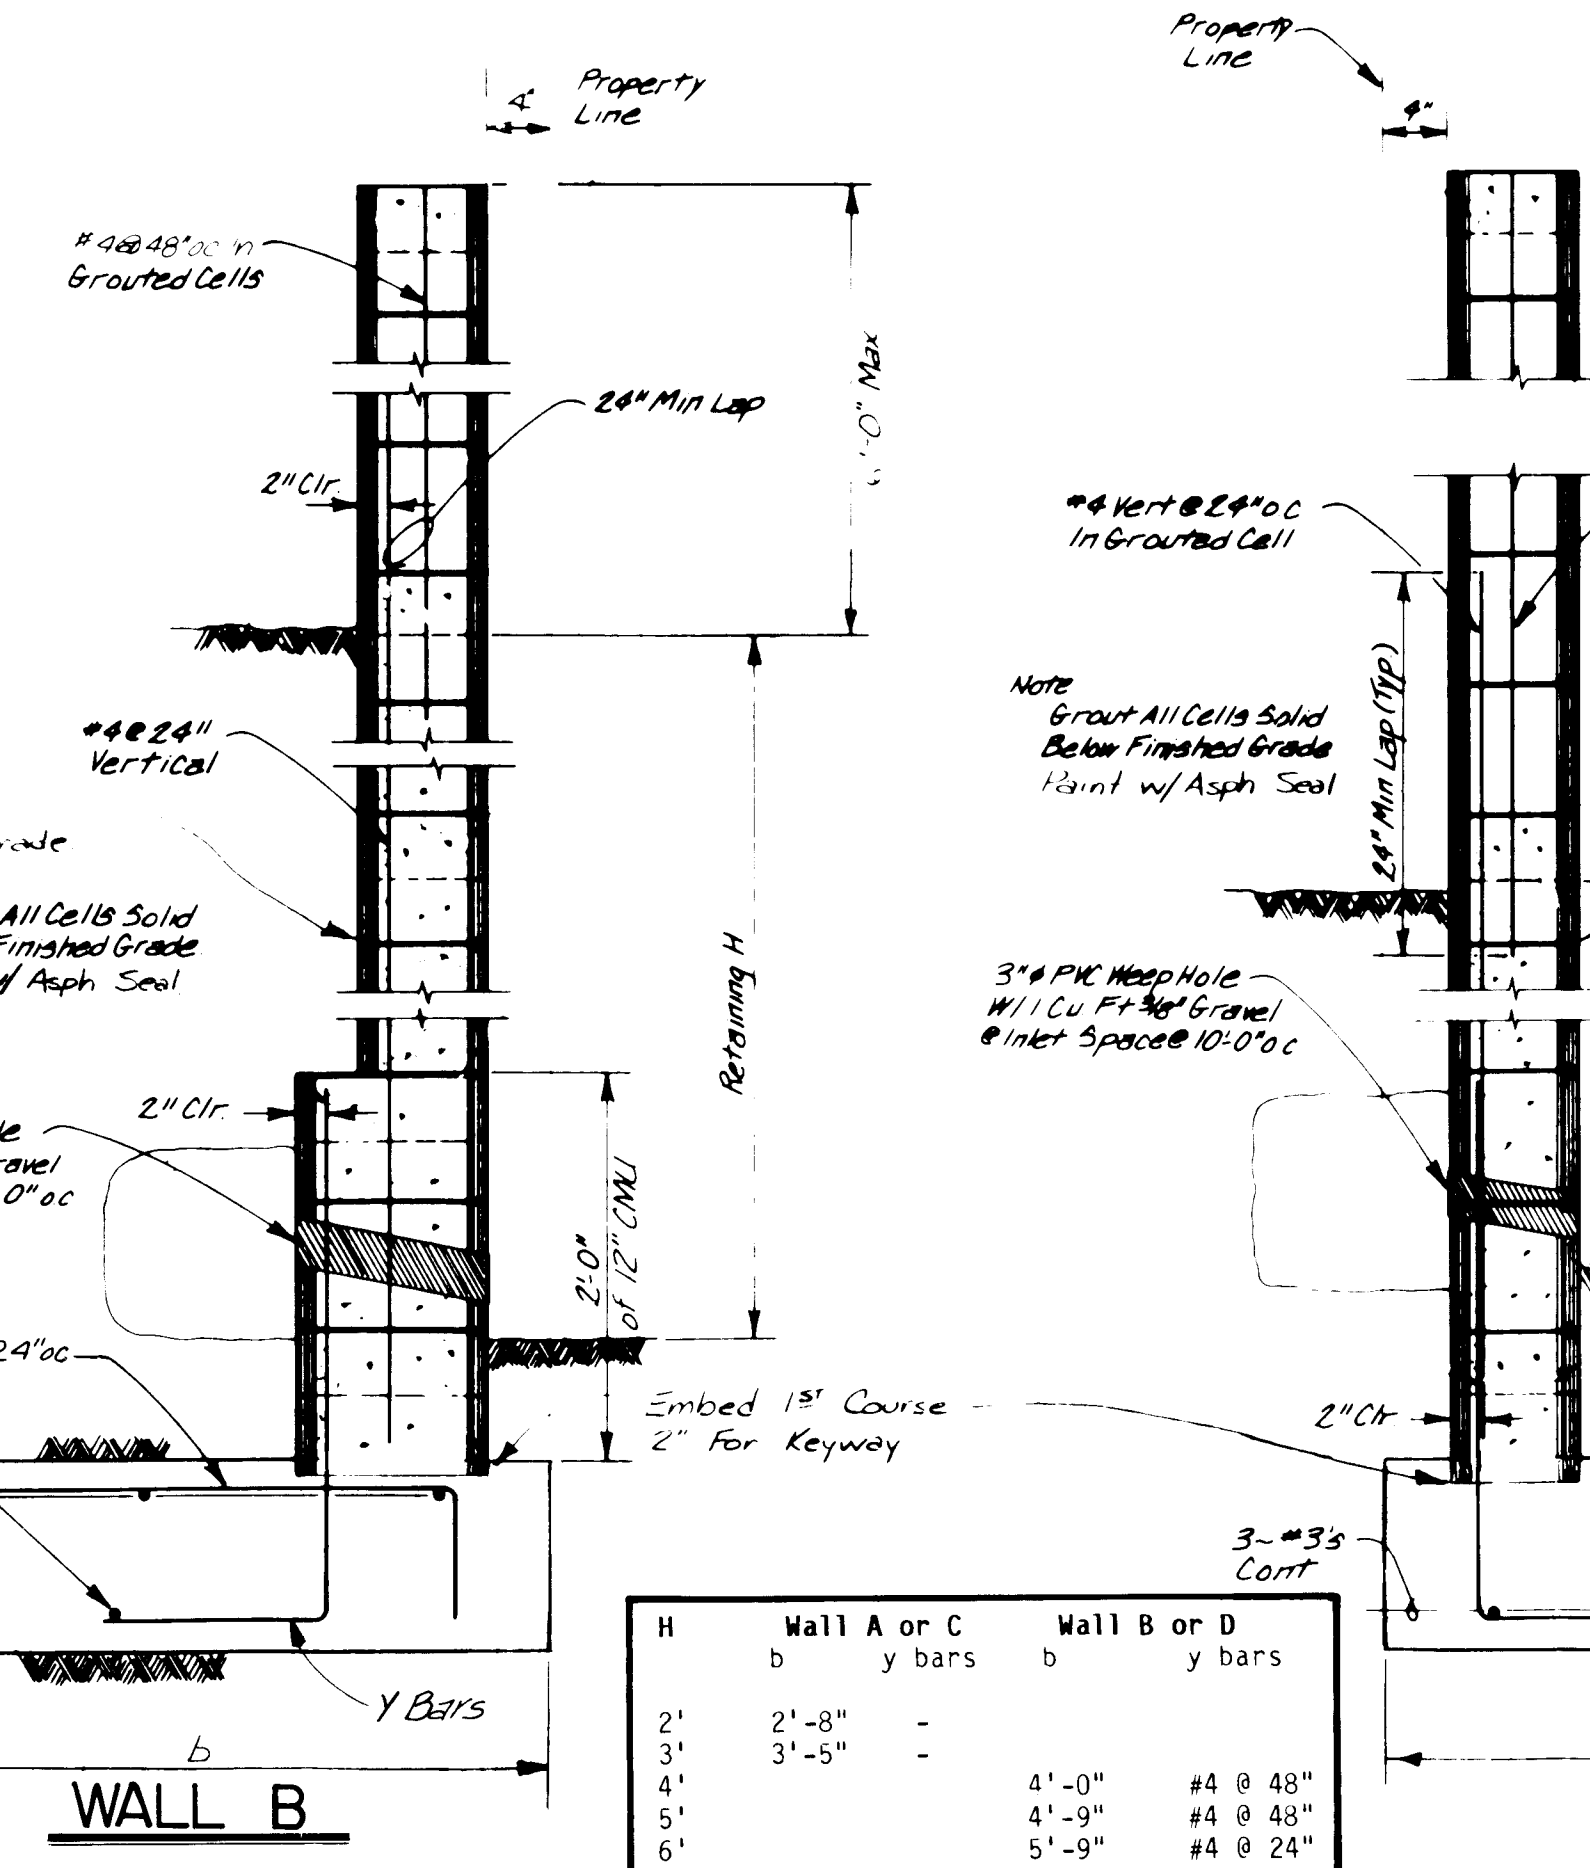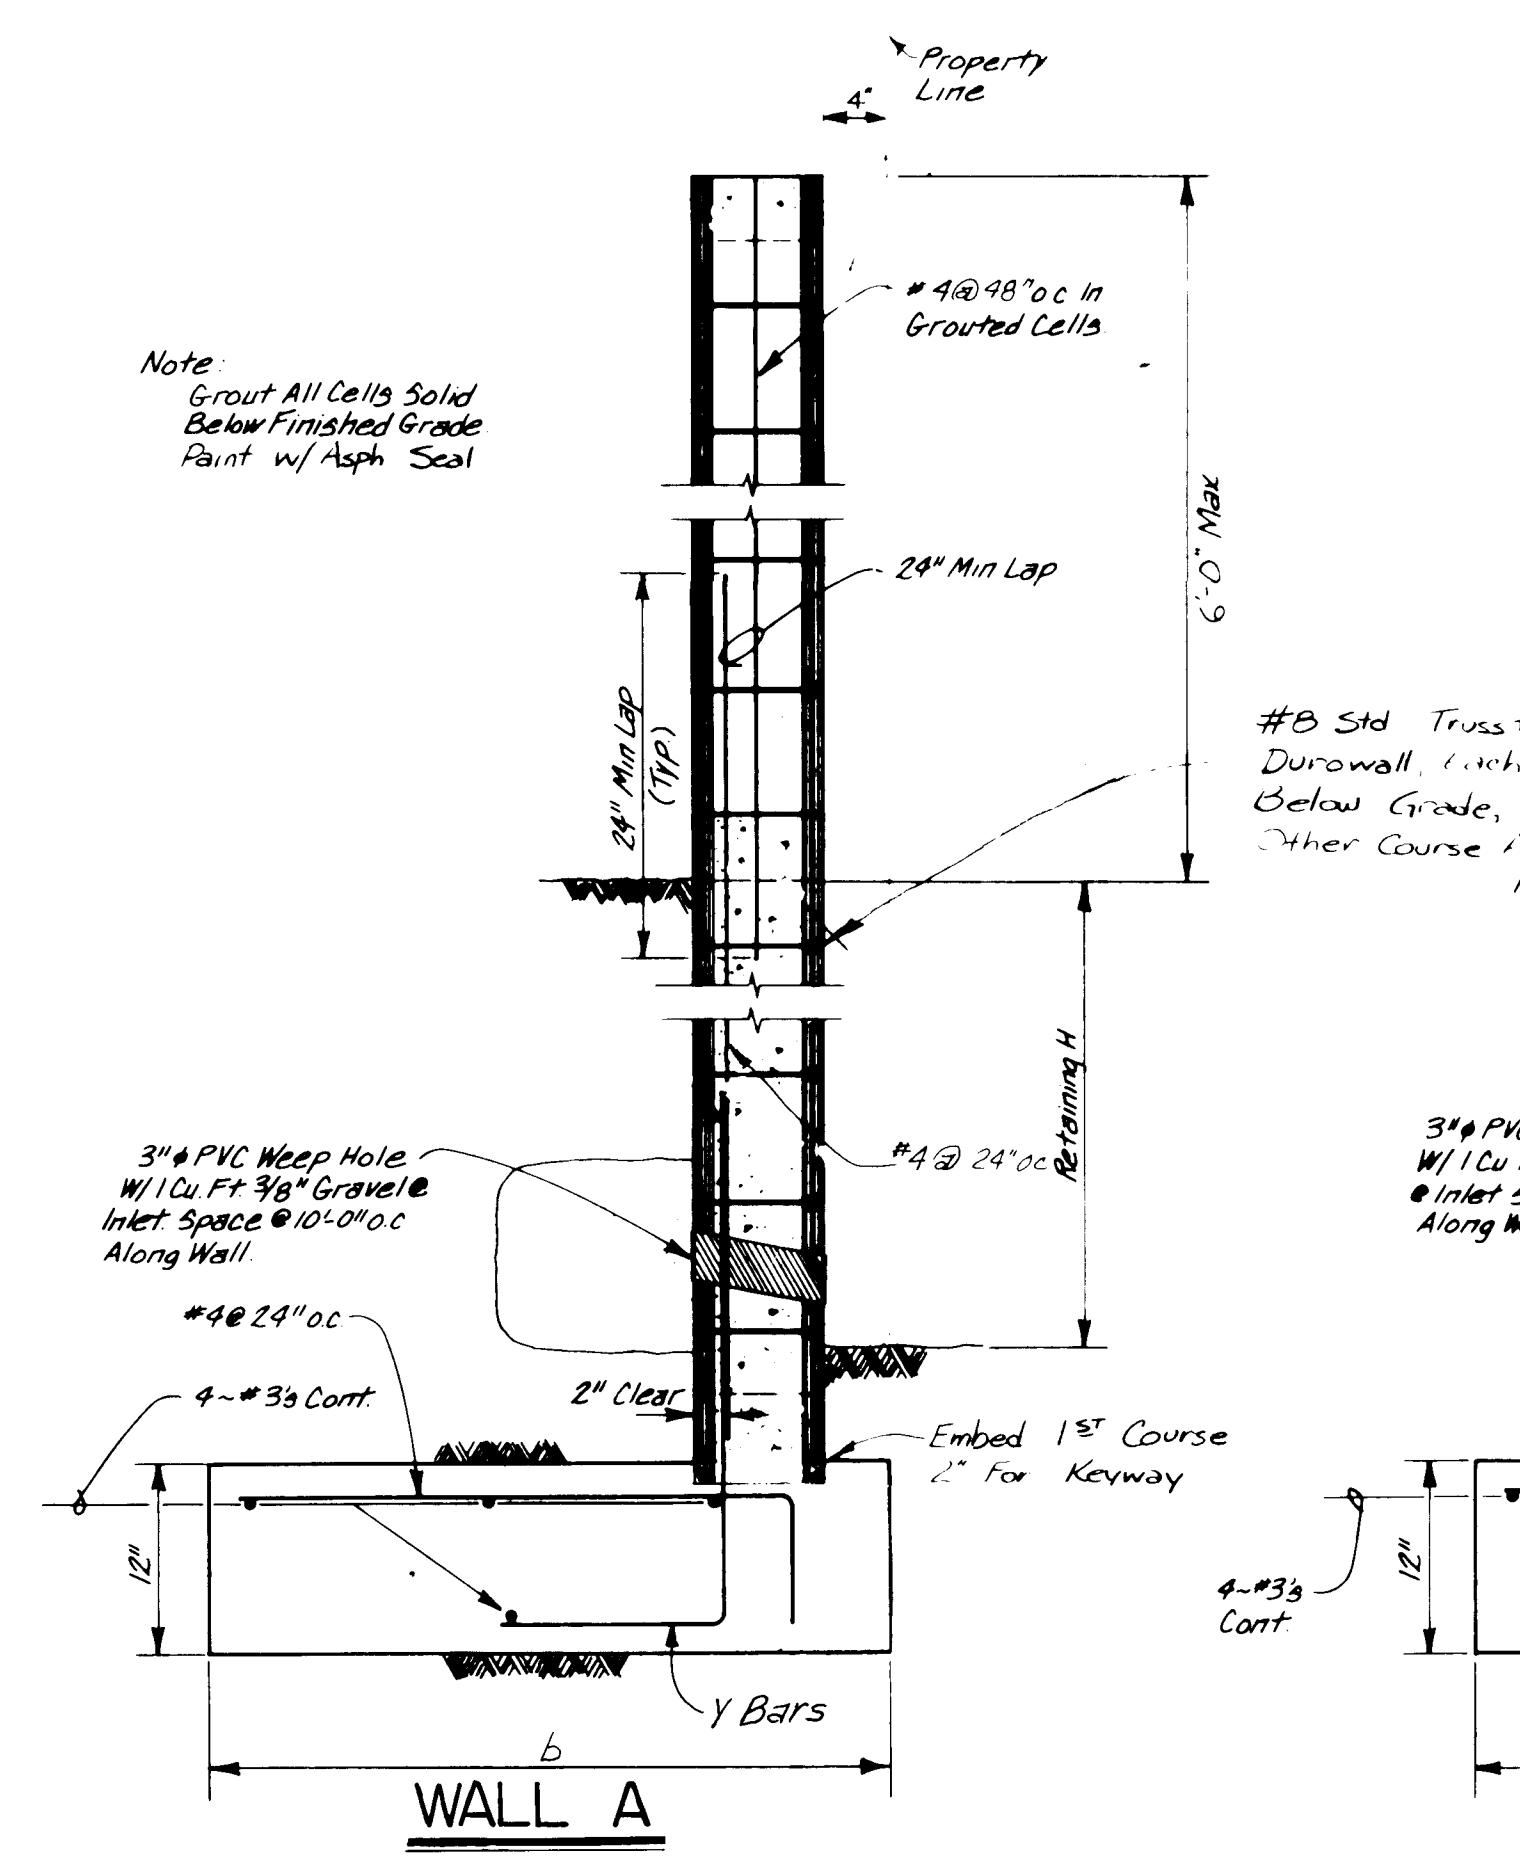

CITY OF ALBUQUERQUE MUNICIPAL DEVELOPMENT DEPARTMENT ENGINEERING DIVISION					
TITLE THE HIGHLANDS AT TANOAN RETAINING WALL DETAILS					
APPROVALS	ENGINEER	DATE	APPROVALS	ENGINEER	DATE
D.R.C. Chairperson	<i>[Signature]</i>	1/27/87	Parks & Rec. Dept.		
Trans. Dev.	<i>[Signature]</i>	1/14/87	User Dept.		
Utility Dev.	<i>[Signature]</i>	1/14/87	User Dept.		
DRAWING NO.	2368	MAP NO.	E-21	SHEET	11 OF 23

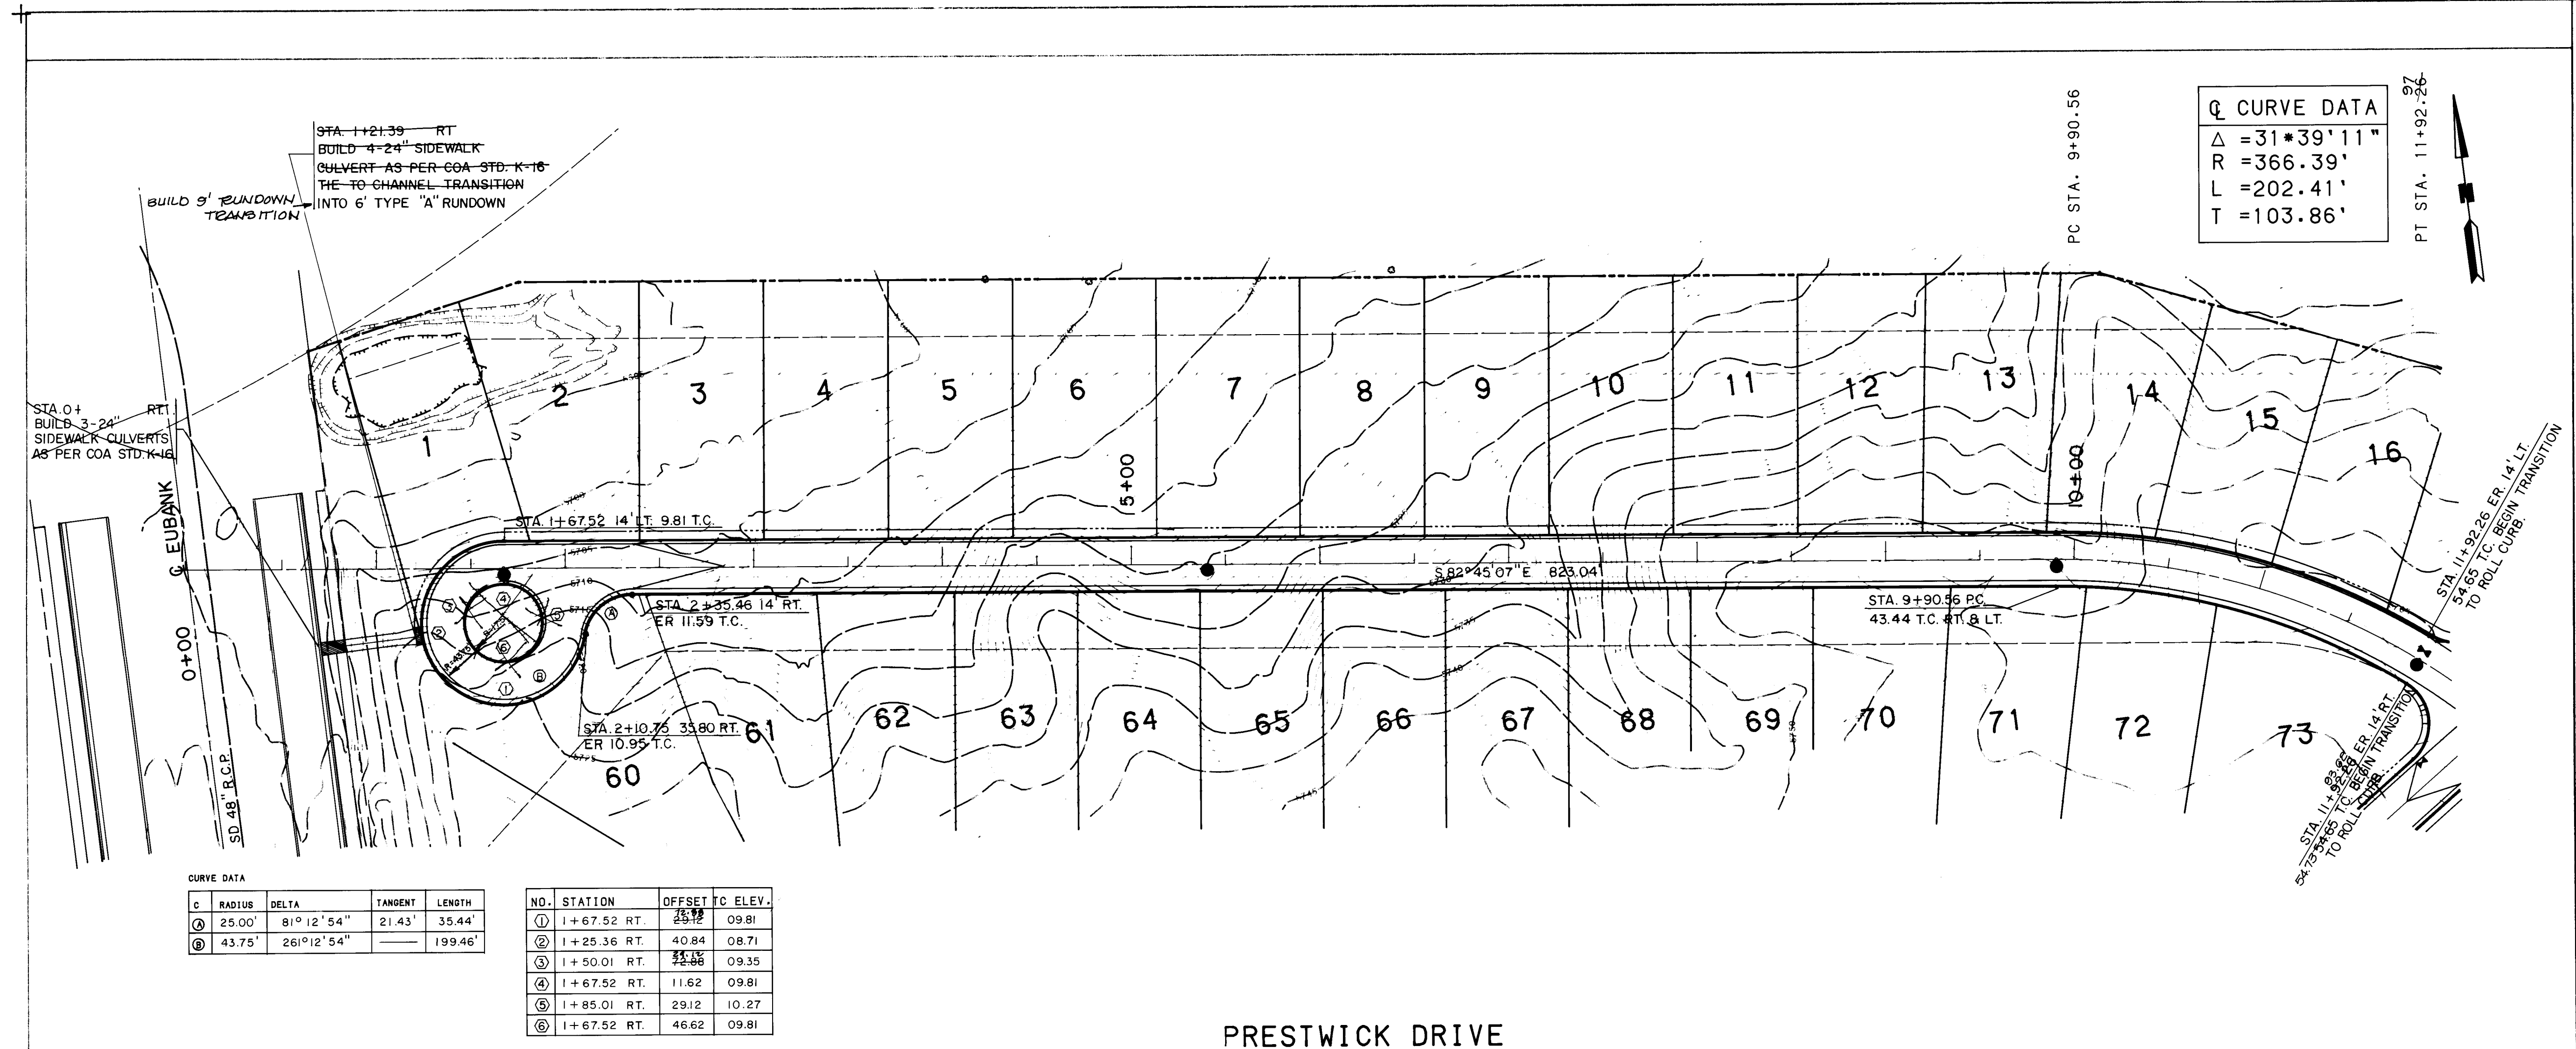


- NOTES
1. ALL CURB RETURN RADII SHALL BE 25' TO BACK OF CURB UNLESS OTHERWISE SPECIFIED.
 2. THE CONTRACTOR IS TO FIELD VERIFY ALL EXISTING UTILITY LOCATIONS AND NOTIFY THE ENGINEER OF ANY DISCREPANCIES.

RECORD DRAWING

This drawing as modified shows public improvements as constructed. These modifications have been made using information and measurements obtained by EHA's field survey team. The contractor is responsible for verifying that the construction conforms to the minimum requirements for record drawing criteria as required by the City of Albuquerque per Manual Section 27.4 to the best of my knowledge and belief.

William F. Coleman, P.E. 5945
6/17/87

ENGINEER'S SEAL		REVISIONS		DESIGN	
NO.	DATE	REMARKS	BY	DATE	DATE
1	6/24/87	DESIGN	William F. Coleman	10/86	10/86
2	6/24/87	DESIGN	William F. Coleman	10/86	10/86
3	6/24/87	DESIGN	William F. Coleman	10/86	10/86
4	6/24/87	DESIGN	William F. Coleman	10/86	10/86
5	6/24/87	DESIGN	William F. Coleman	10/86	10/86
6	6/24/87	DESIGN	William F. Coleman	10/86	10/86
7	6/24/87	DESIGN	William F. Coleman	10/86	10/86
8	6/24/87	DESIGN	William F. Coleman	10/86	10/86
9	6/24/87	DESIGN	William F. Coleman	10/86	10/86
10	6/24/87	DESIGN	William F. Coleman	10/86	10/86
11	6/24/87	DESIGN	William F. Coleman	10/86	10/86
12	6/24/87	DESIGN	William F. Coleman	10/86	10/86

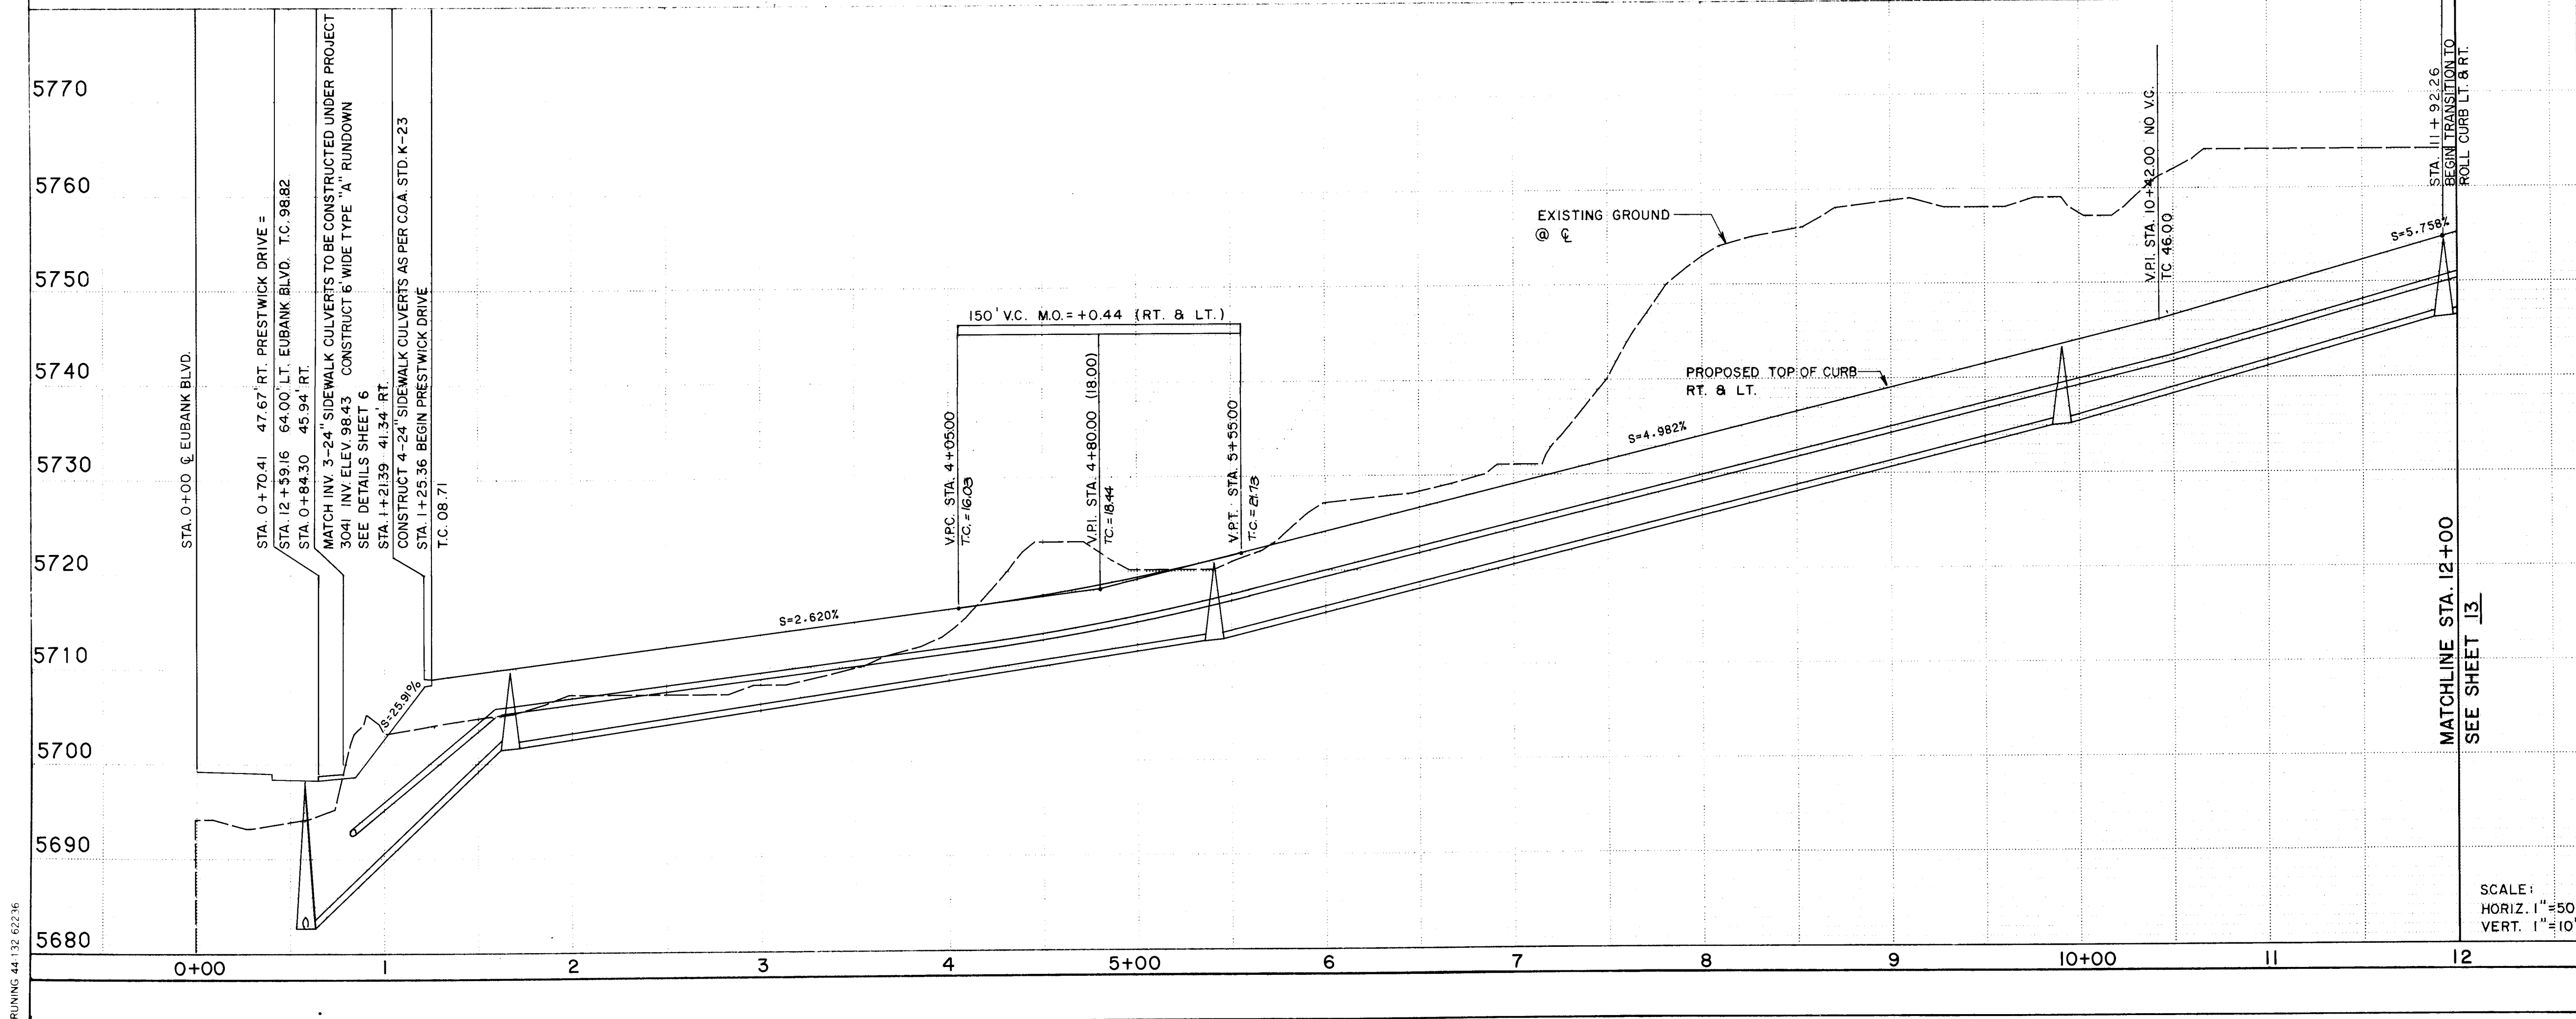



CITY OF ALBUQUERQUE
PUBLIC WORKS
ENGINEERING

TITLE: THE HIGHLANDS AT TANDAN
PRESTWICK DRIVE PAVING PLAN AND PROFILE

APPROVALS	ENGINEER	DATE	APPROVALS	ENGINEER	DATE
D.R.C. Chairperson	William F. Coleman	6/24/87	Parks & Rec. Dept.		
Trans. Dev.	William F. Coleman	6/24/87	User Dept.		
Utility Dev.	William F. Coleman	6/24/87	User Dept.		

SCALE: HORIZ. 1"=50' VERT. 1"=10'

DRAWING NO. 2368 MAP NO. E-21 SHEET 12 OF 23

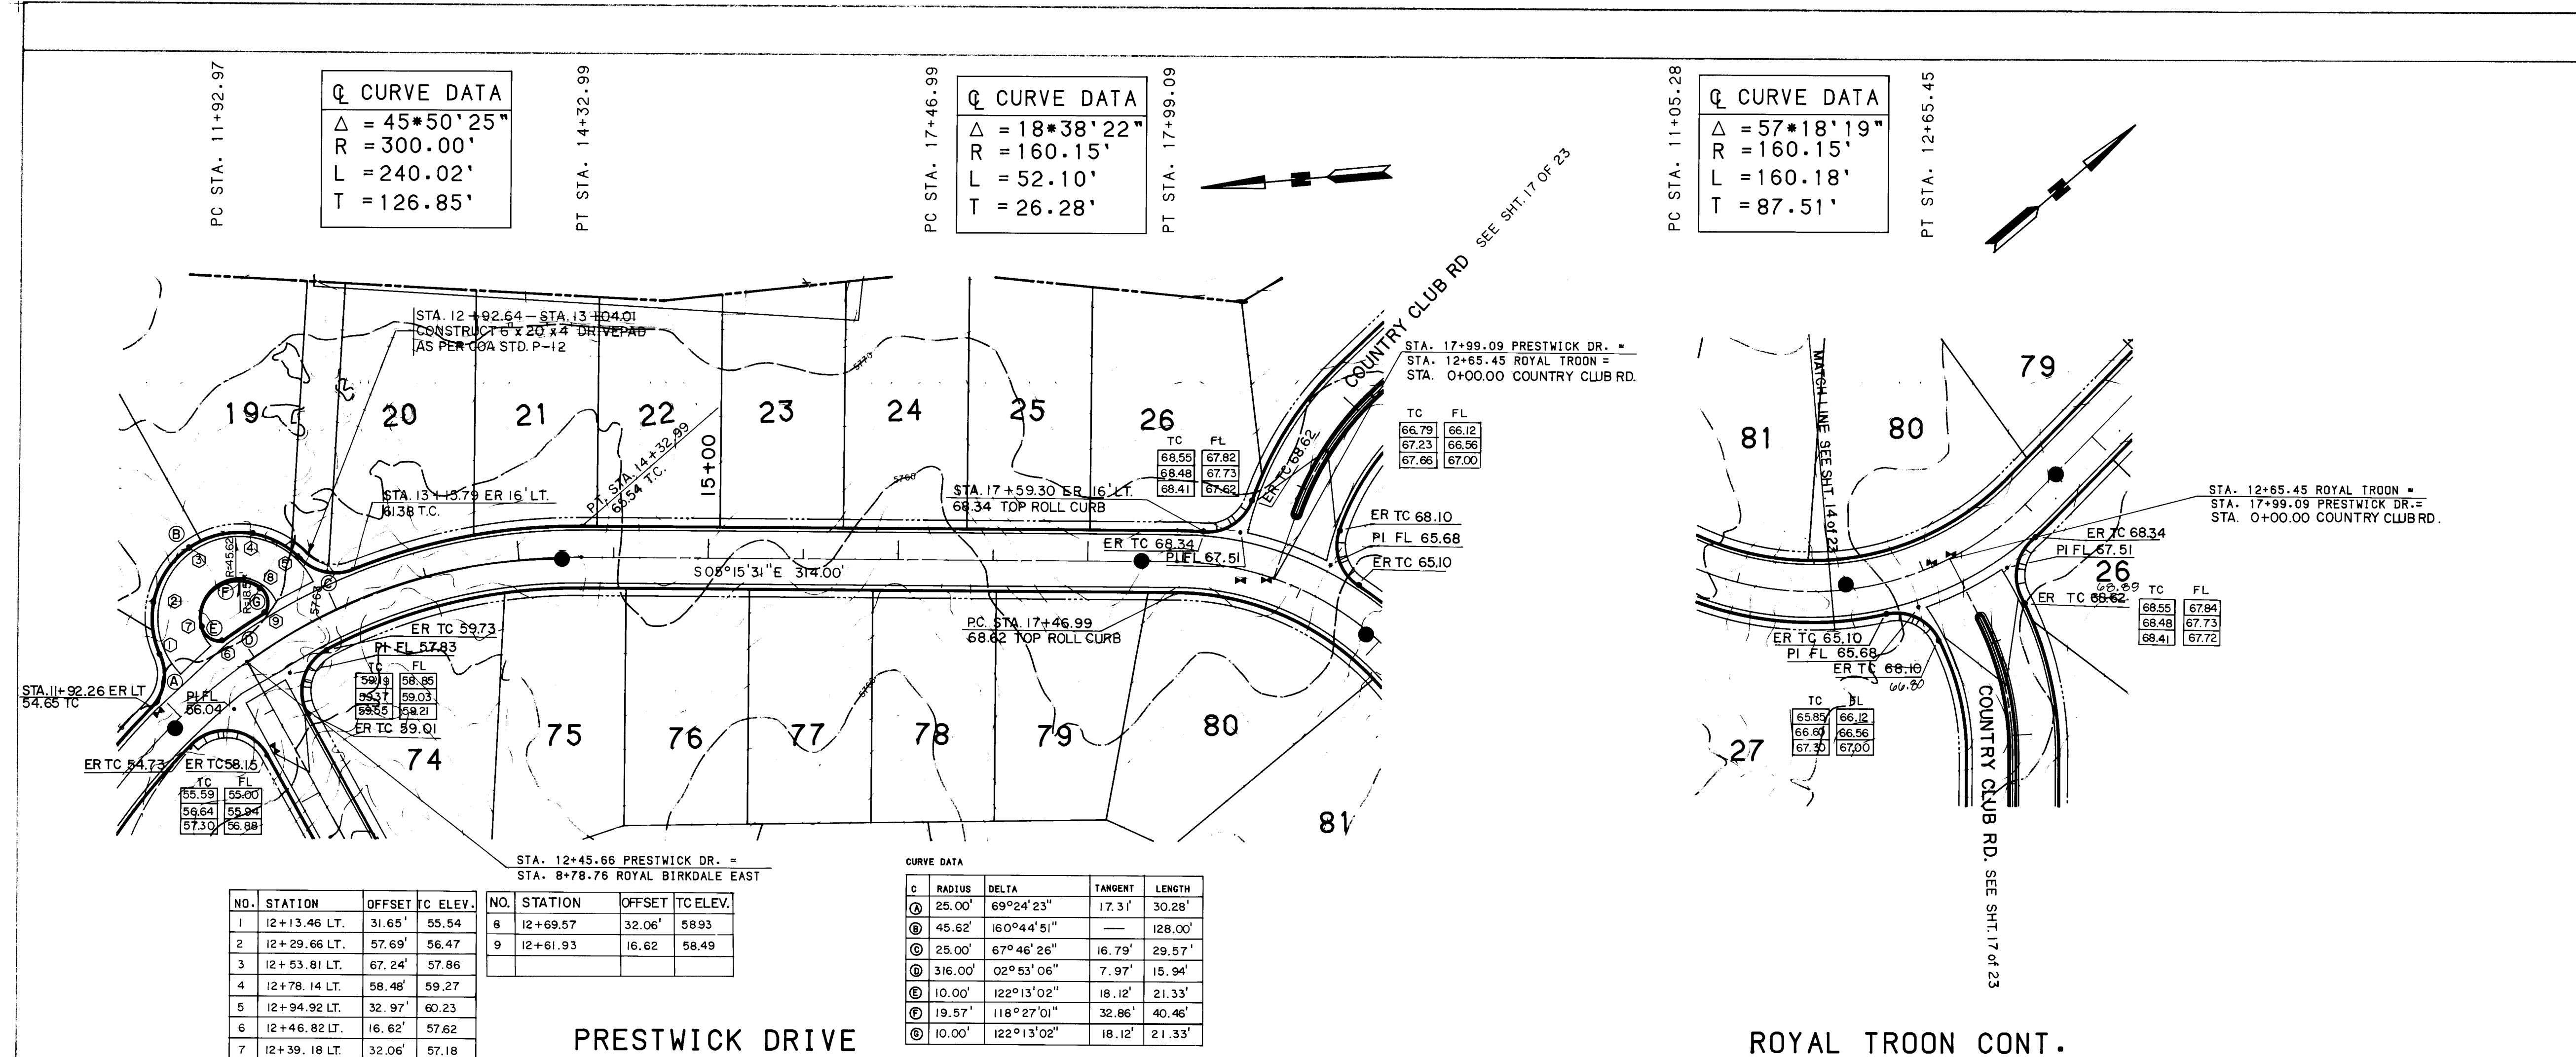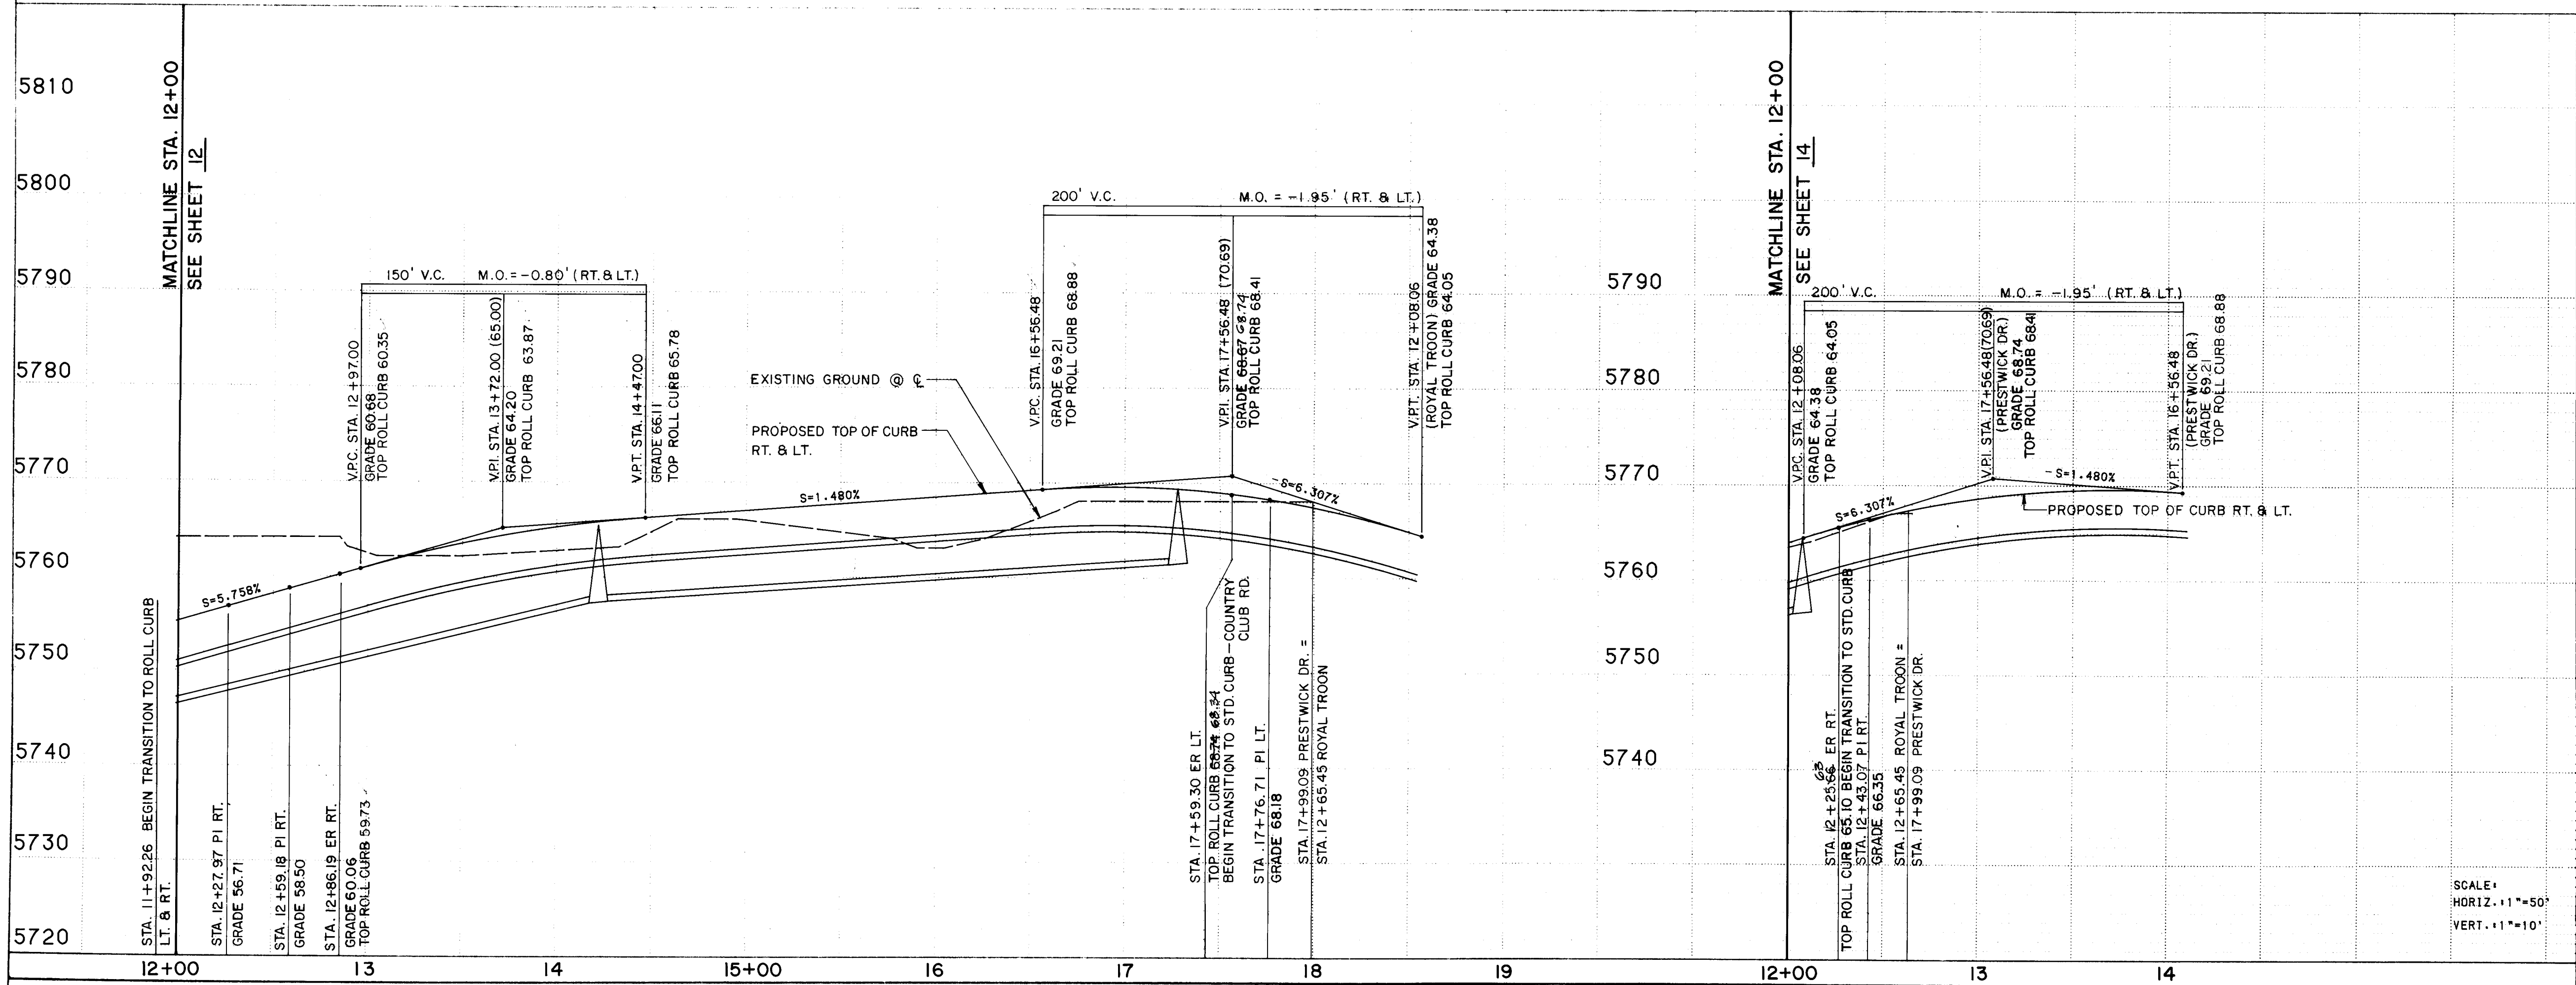

RECORD DRAWING

This drawing as modified shows public improvements as constructed. These modifications have been made using the latest available data and field survey. The engineer, the Contractor and City Inspector shall be responsible for the minimum requirements for the record drawing. The City of Albuquerque, New Mexico, is not responsible for the accuracy of the data or the results of the survey. The City of Albuquerque, New Mexico, is not responsible for the accuracy of the data or the results of the survey.


William F. Coleman P.E. 5945
6/17/07



NOTES

1. ALL CURB RETURN RADII SHALL BE 25' TO BACK OF CURB UNLESS OTHERWISE SPECIFIED.
2. THE CONTRACTOR IS TO FIELD VERIFY ALL EXISTING UTILITY LOCATIONS AND NOTIFY THE ENGINEER OF ANY DISCREPANCIES.

1	2	3	4	5	6	7	8	9	10	11	12
2	6	2	3	6	8	1	3	8	7		

CITY OF ALBUQUERQUE PUBLIC WORKS ENGINEERING					
TITLE: THE HIGHLANDS AT TANOAN PRESTWICK DR. & ROYAL TROON (CONT.) PAVING PLAN & PROFILE					
APPROVALS	ENGINEER	DATE	APPROVALS	ENGINEER	DATE
D.R.C. Chairperson	<i>[Signature]</i>	1/27/07	Parks & Rec. Dept.		
Trans. Dev.	<i>[Signature]</i>	1/14/07	User Dept.		
Utility Dev.	<i>[Signature]</i>	1/14/07	User Dept.		
DRAWING NO.	2368	MAP NO.	E-21	SHEET	13 OF 23

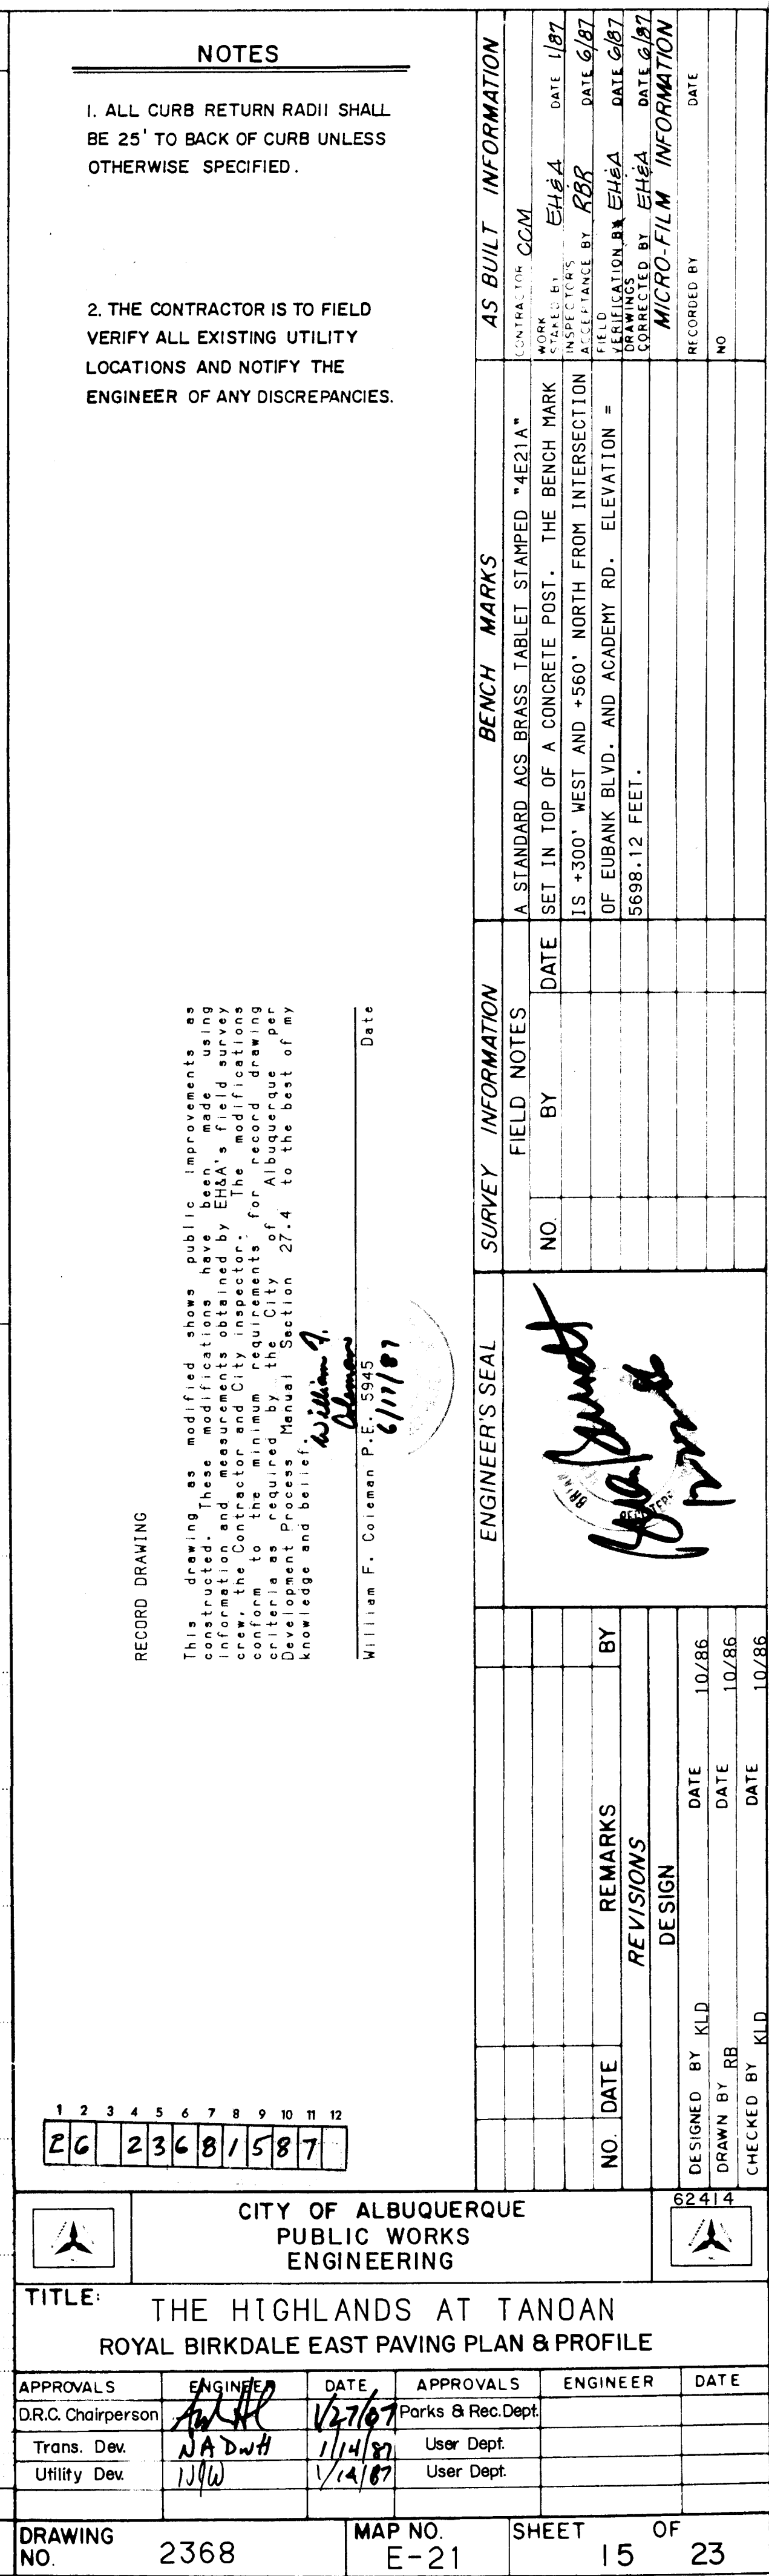

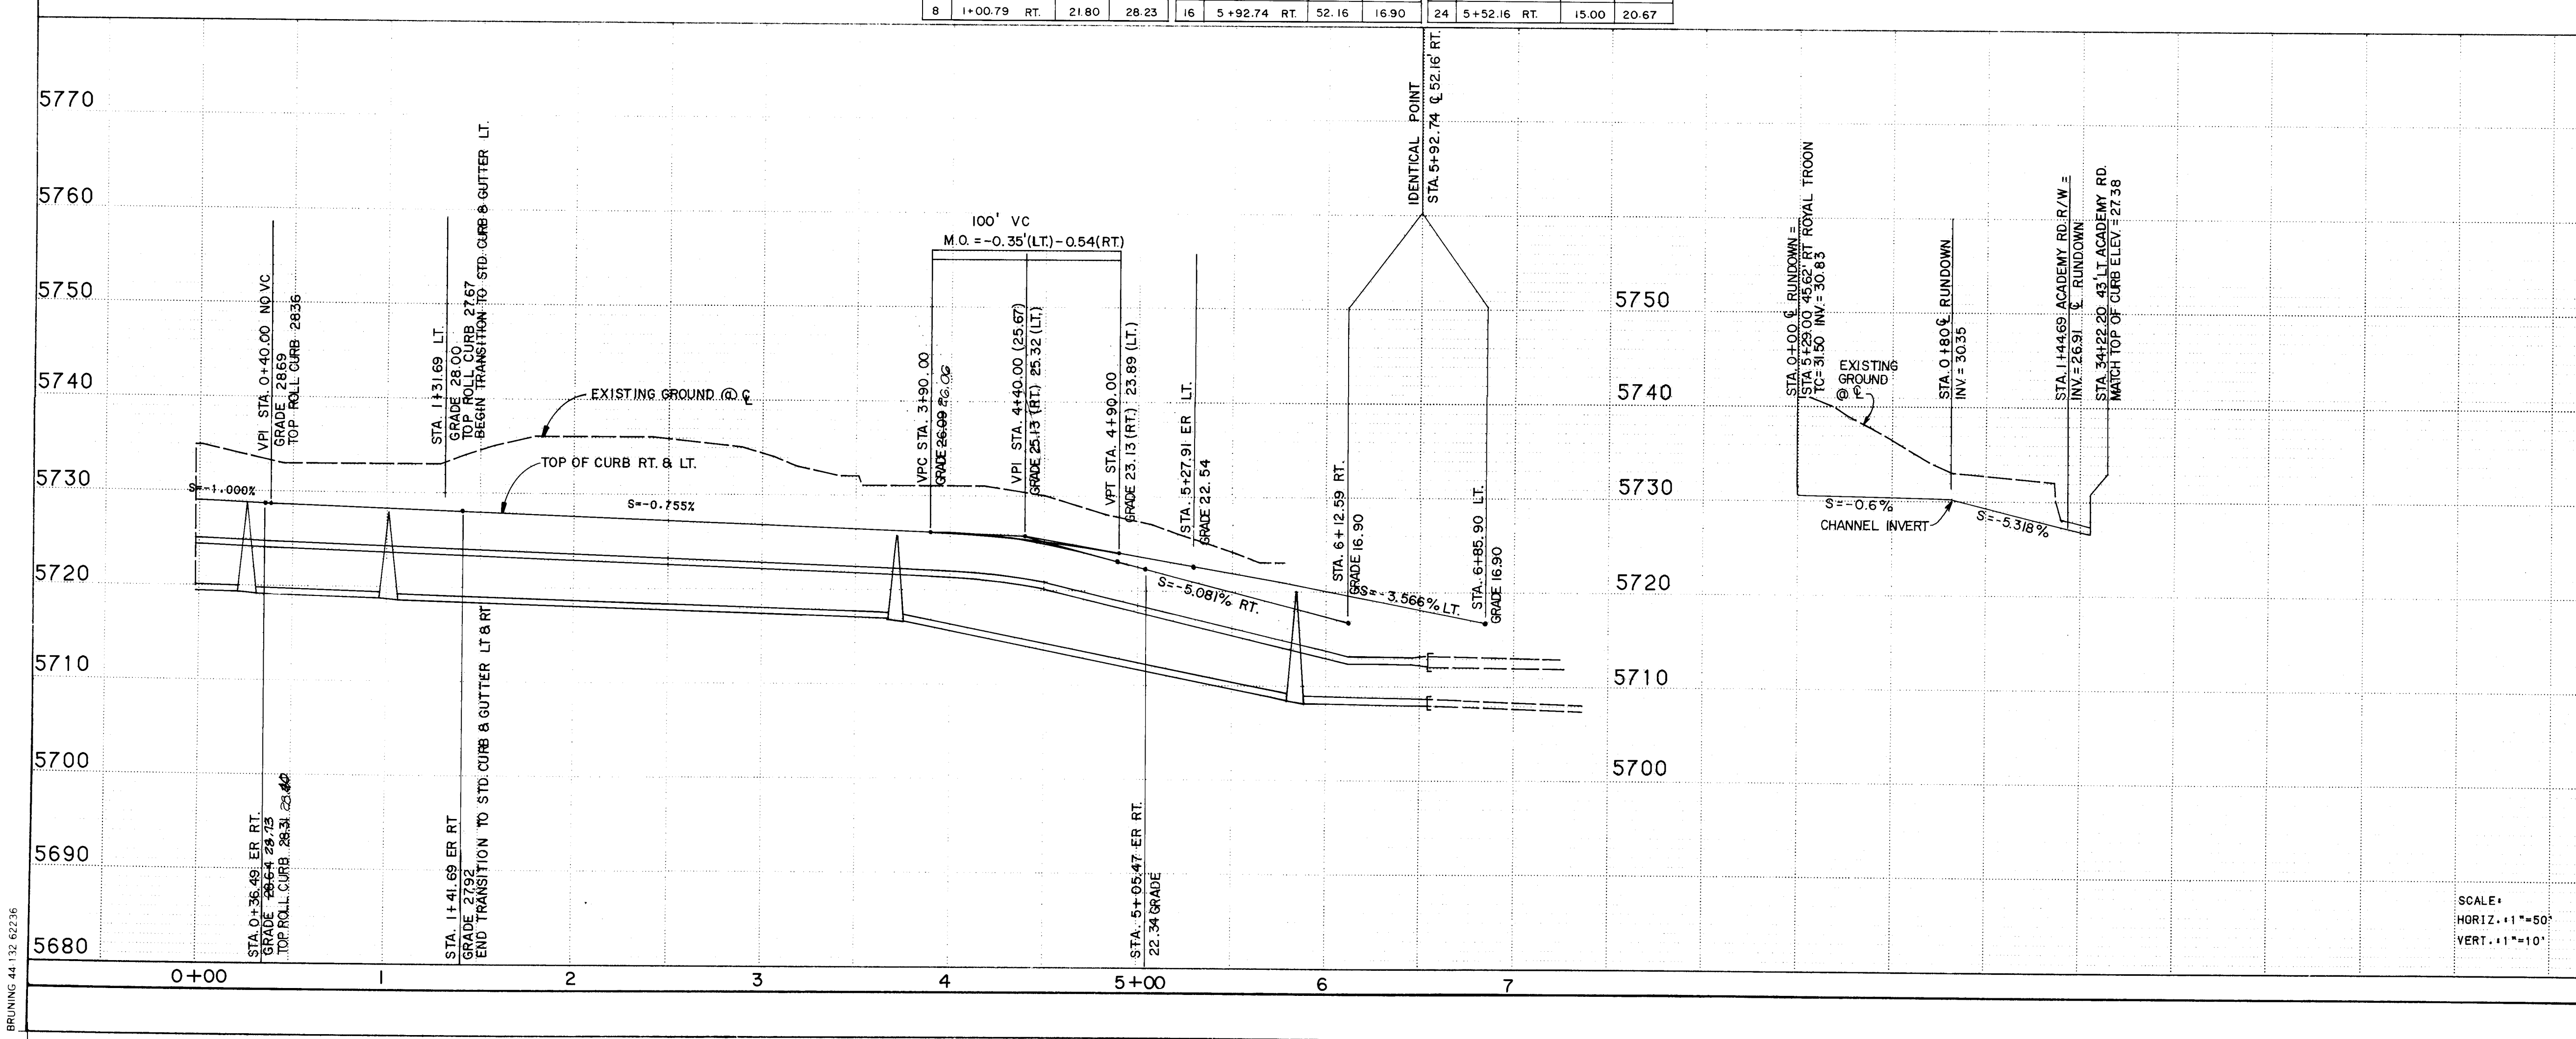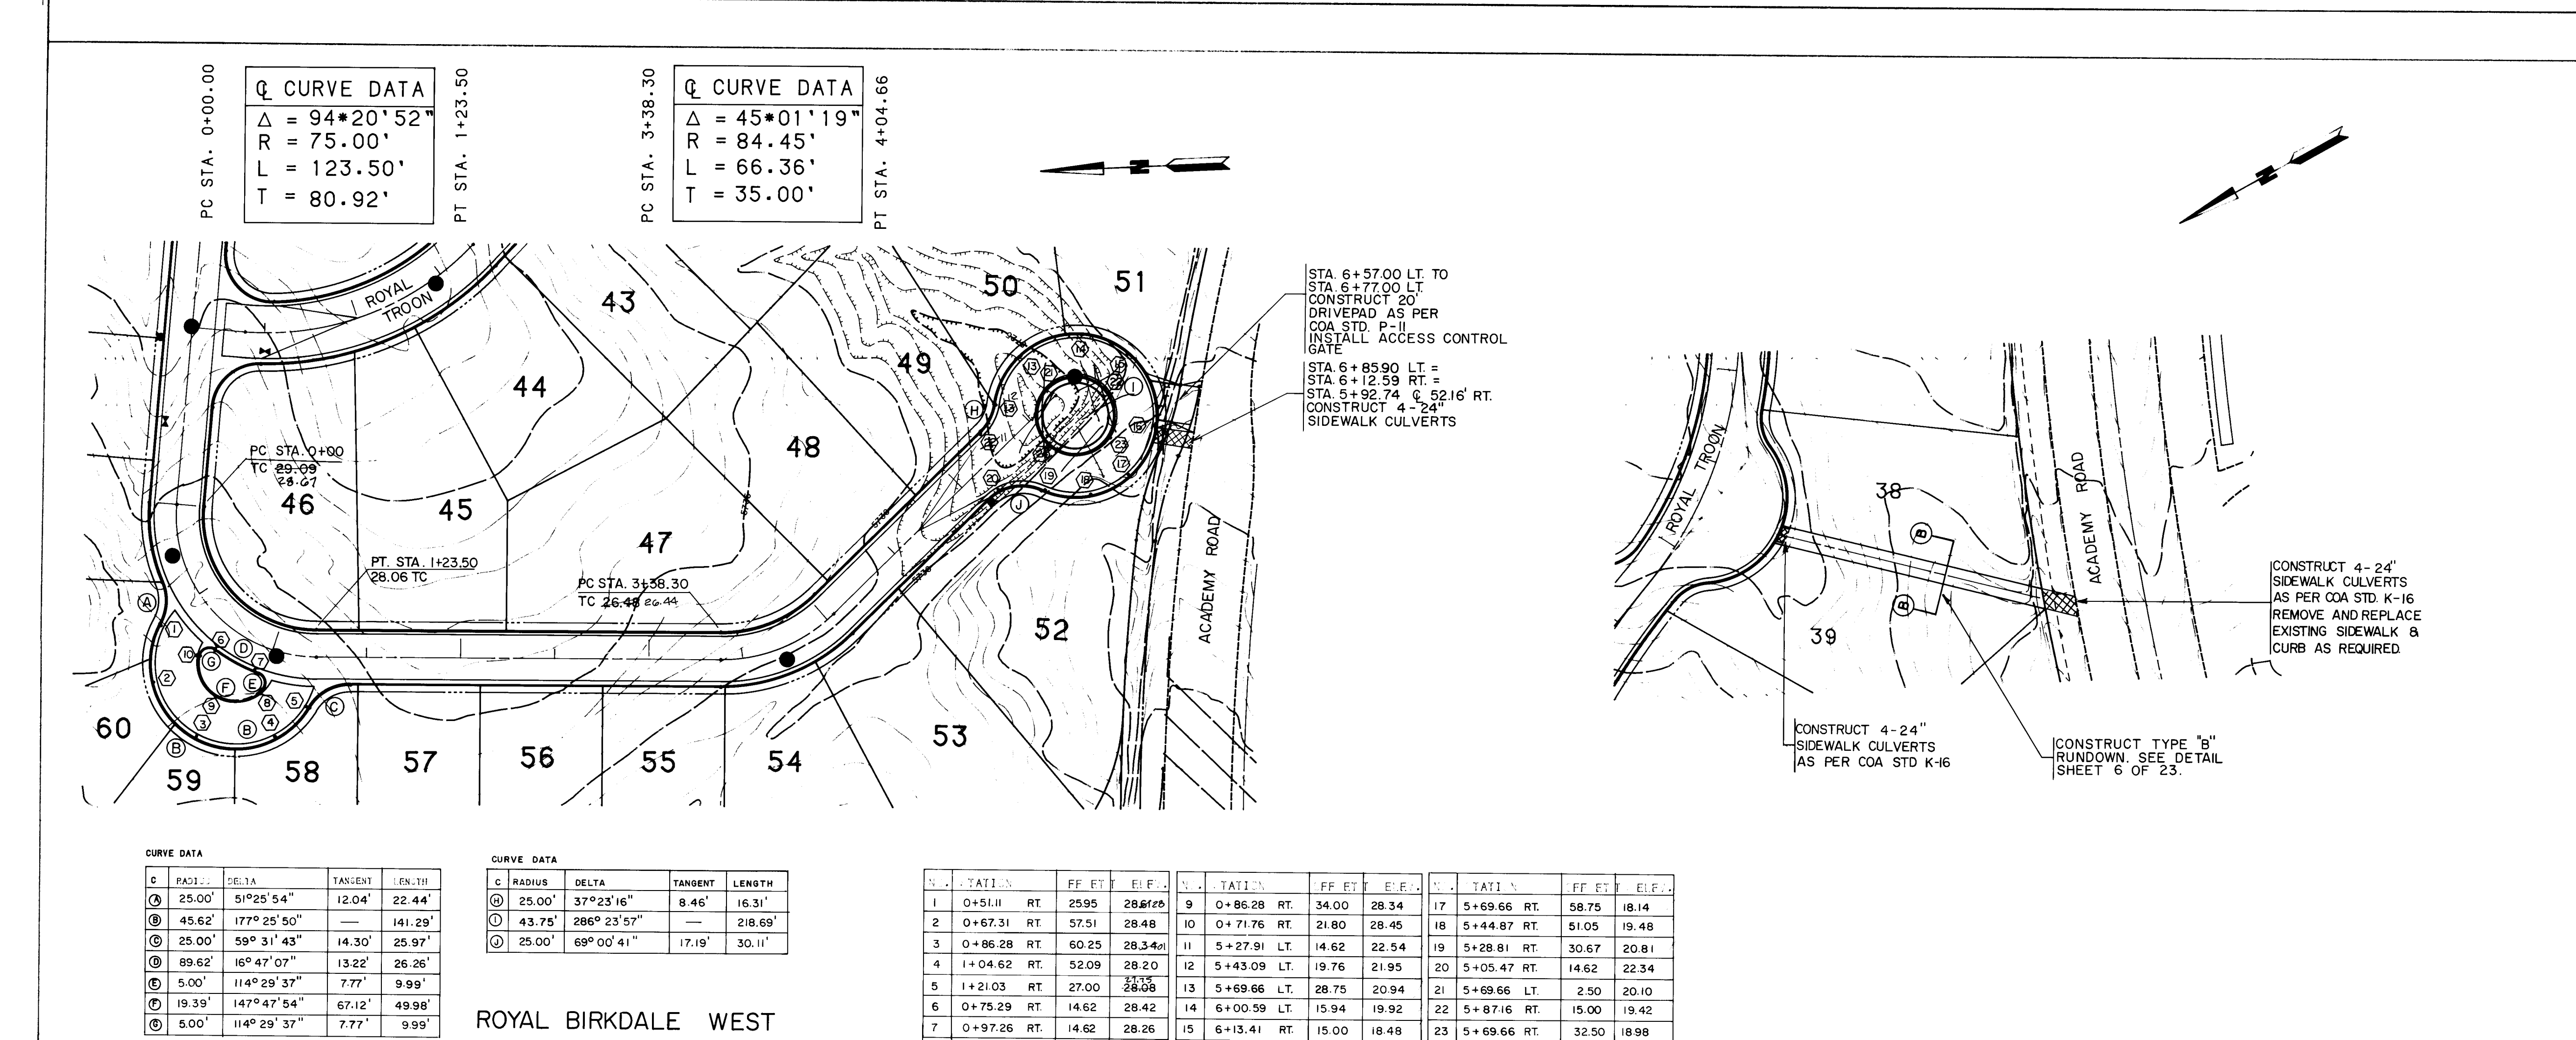

NOTES

1. ALL CURB RETURN RADII SHALL BE 25' TO BACK OF CURB UNLESS OTHERWISE SPECIFIED.

2. THE CONTRACTOR IS TO FIELD VERIFY ALL EXISTING UTILITY LOCATIONS AND NOTIFY THE ENGINEER OF ANY DISCREPANCIES.

RECORD DRAWING

This drawing, as modified, shows public improvements as constructed. These modifications have been made by the City of Albuquerque Engineering Department. The contractor is responsible for the accuracy of the field survey data. The City of Albuquerque Engineering Department is not responsible for the accuracy of the field survey data. The City of Albuquerque Engineering Department is not responsible for the accuracy of the field survey data.

William F. Coiman P.E. 5945
 6/17/07

ENGINEER'S SEAL

[Signature]

REVISIONS

NO.	DATE	REMARKS
1	10/86	DESIGN
2	10/86	DESIGN
3	10/86	DESIGN

APPROVALS

ENGINEER	DATE	APPROVALS	ENGINEER	DATE
D.R.C. Chairperson	1/27/07	Parks & Rec. Dept.		
Trans. Dev.	1/14/07	User Dept.		
Utility Dev.	1-14-07	User Dept.		

TITLE: THE HIGHLANDS AT TANOAN
 ROYAL BIRKDALE WEST PAVING PLAN & PROFILE

DRAWING NO. 2368 **MAP NO.** E-21 **SHEET** 16 **OF** 23

PC STA. 0+35.43


Q CURVE DATA	
$\Delta = 27^\circ 13' 24''$	
$R = 157.98'$	
$L = 75.06'$	
$T = 38.25'$	

PT STA. 1+10.49

PC STA. 2+09.31

Q CURVE DATA	
$\Delta = 4^\circ 28' 04''$	
$R = 408.08'$	
$L = 31.82'$	
$T = 15.92'$	


PT STA. 2+41.13

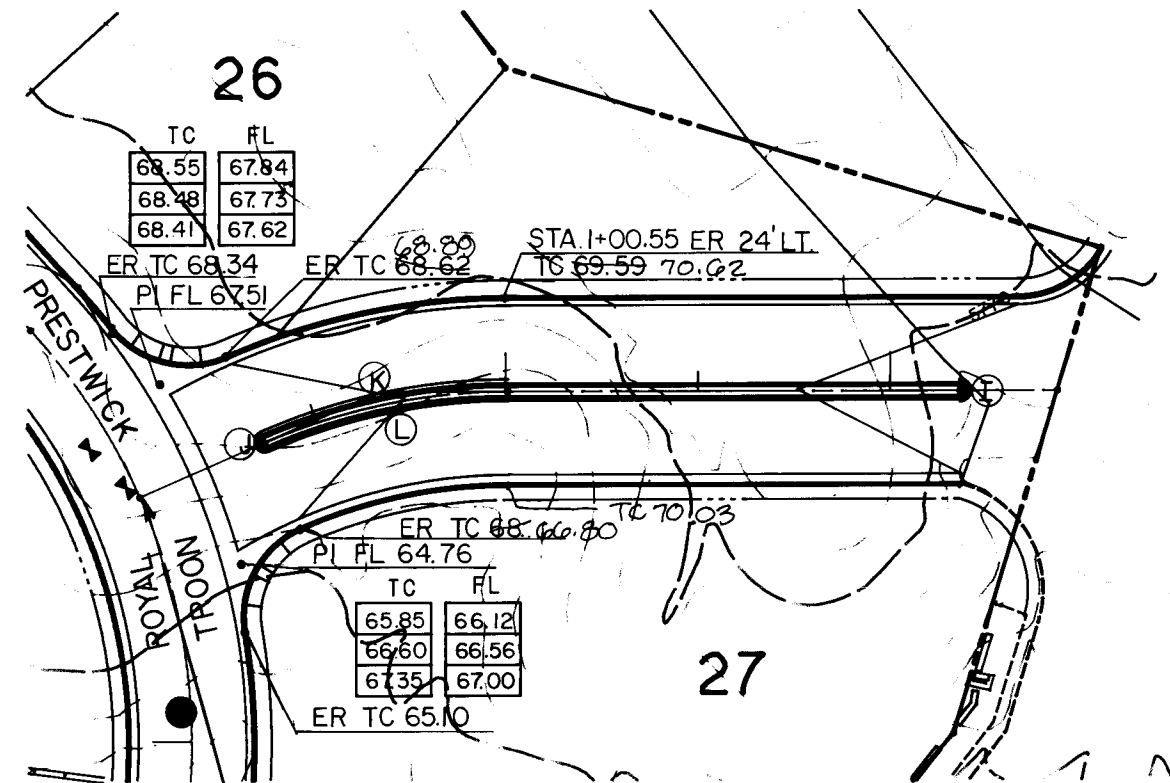

STA. 0+00 COUNTRY CLUB RD. =
STA. 17+99.09 PRESTWICK DR.

NO.	STATION	OFFSET	ELEV.
1	1+02.29 RT	14.62	46.77
2	1+32.64 RT	49.74	45.41
3	1+79.00 RT	78.63	54.38
4	2+25.13 RT	59.00	
5	1+79.00 LT	14.62	54.02
6	1+79.00 RT	14.62	54.13
7	1+79.00 RT	52.38	54.28


COUNTRY CLUB ROAD

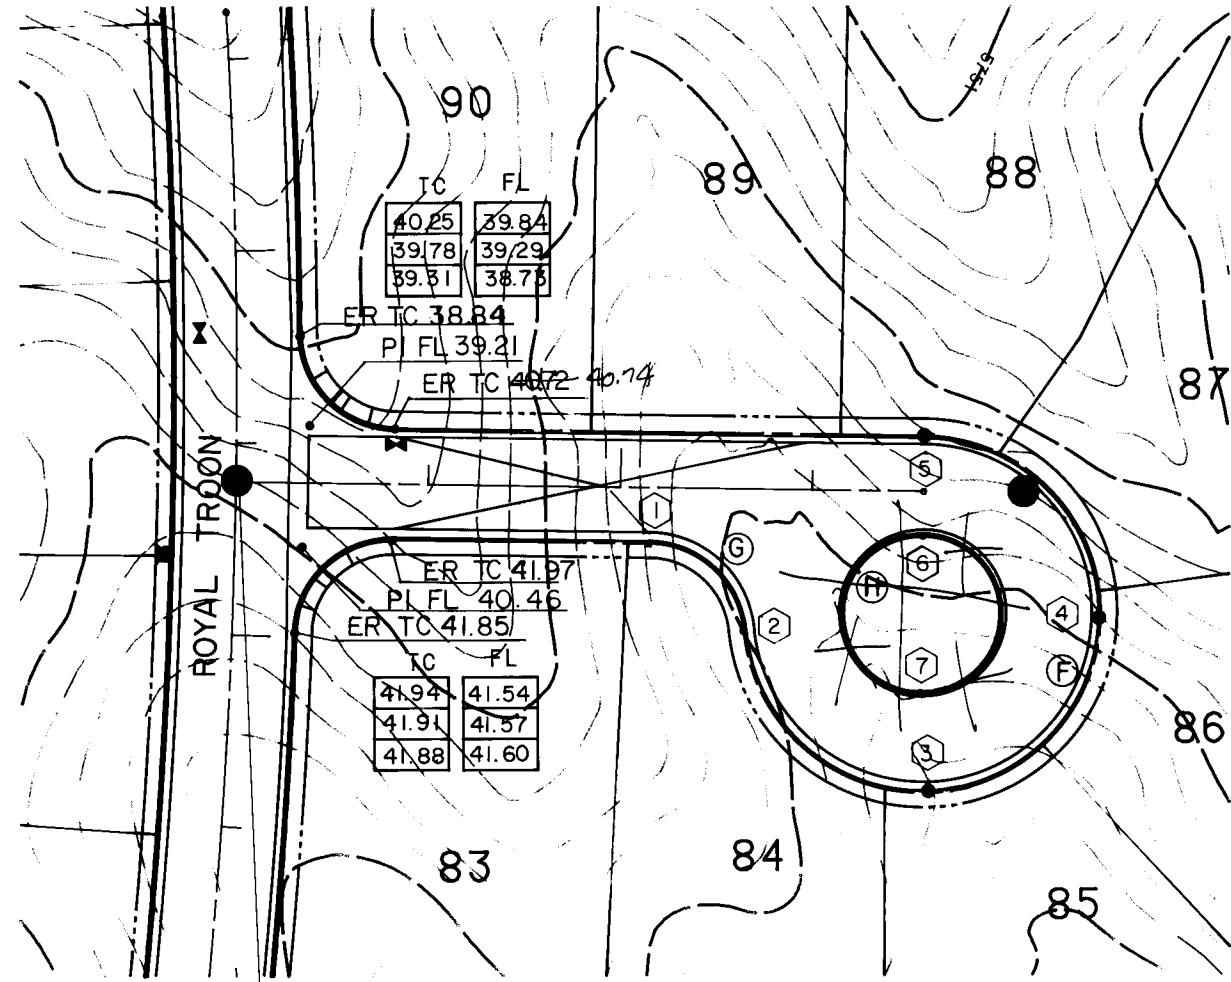

STA. 0+00 BEAU CHENE CT. =
STA. 7+60.20 ROYAL TROON




NO.	STATION	OFFSET	ELEV.
1	0+56.00 LT	45.63	35.37
2	0+88.96 LT	31.55	37.52
3	1+01.63	0.00	39.67
4	0+88.96 RT	31.55	37.16
5	0+56.00 RT	45.63	34.66
6	0+41.00 LT	19.38	34.13
7	0+56.00 LT	19.38	35.33
8	0+75.38	0.00	37.59
9	0+56.00 RT	19.38	35.02
10	0+41.00 RT	19.38	33.76
11	0+21.63	0.00	32.56

BEAU CHENE COURT

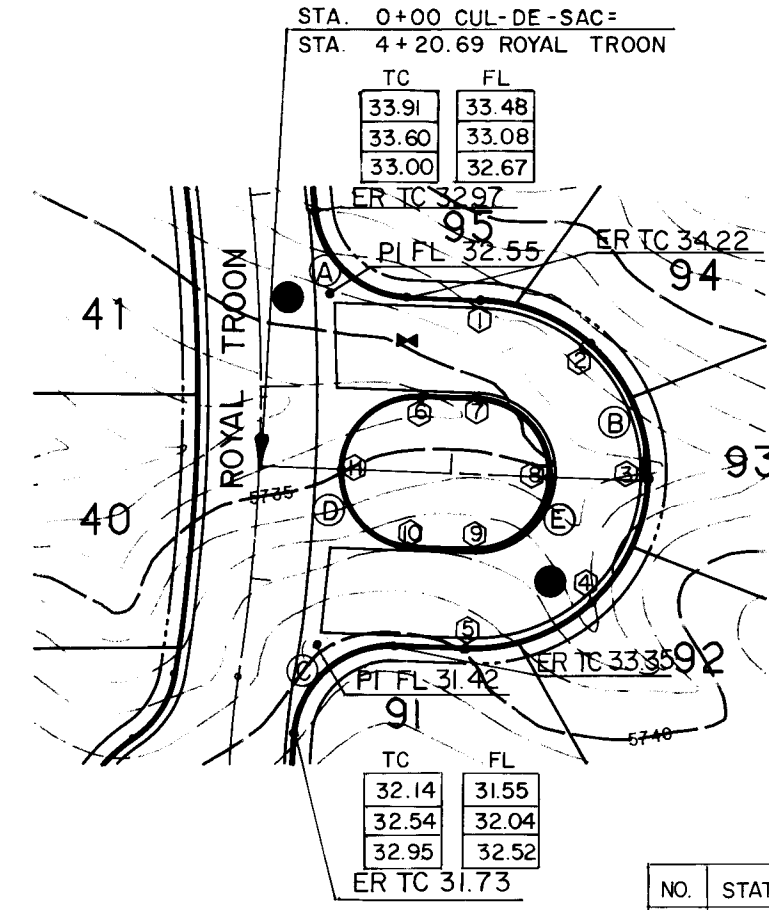

NO.	STATION	OFFSET	ELEV.
1	0+56.00 LT	45.63	35.37
2	0+88.96 LT	31.55	37.52
3	1+01.63	0.00	39.67
4	0+88.96 RT	31.55	37.16
5	0+56.00 RT	45.63	34.66
6	0+41.00 LT	19.38	34.13
7	0+56.00 LT	19.38	35.33
8	0+75.38	0.00	37.59
9	0+56.00 RT	19.38	35.02
10	0+41.00 RT	19.38	33.76
11	0+21.63	0.00	32.56

ROYAL TROON CUL-DE-SAC

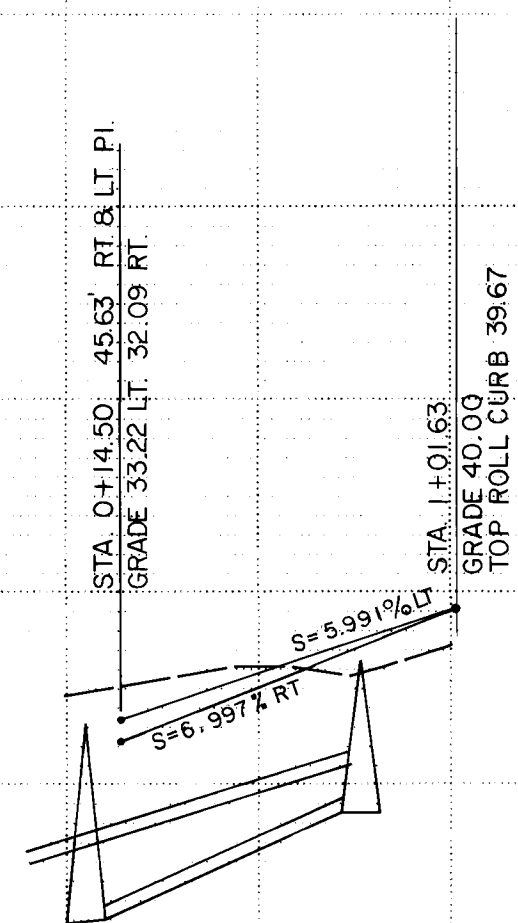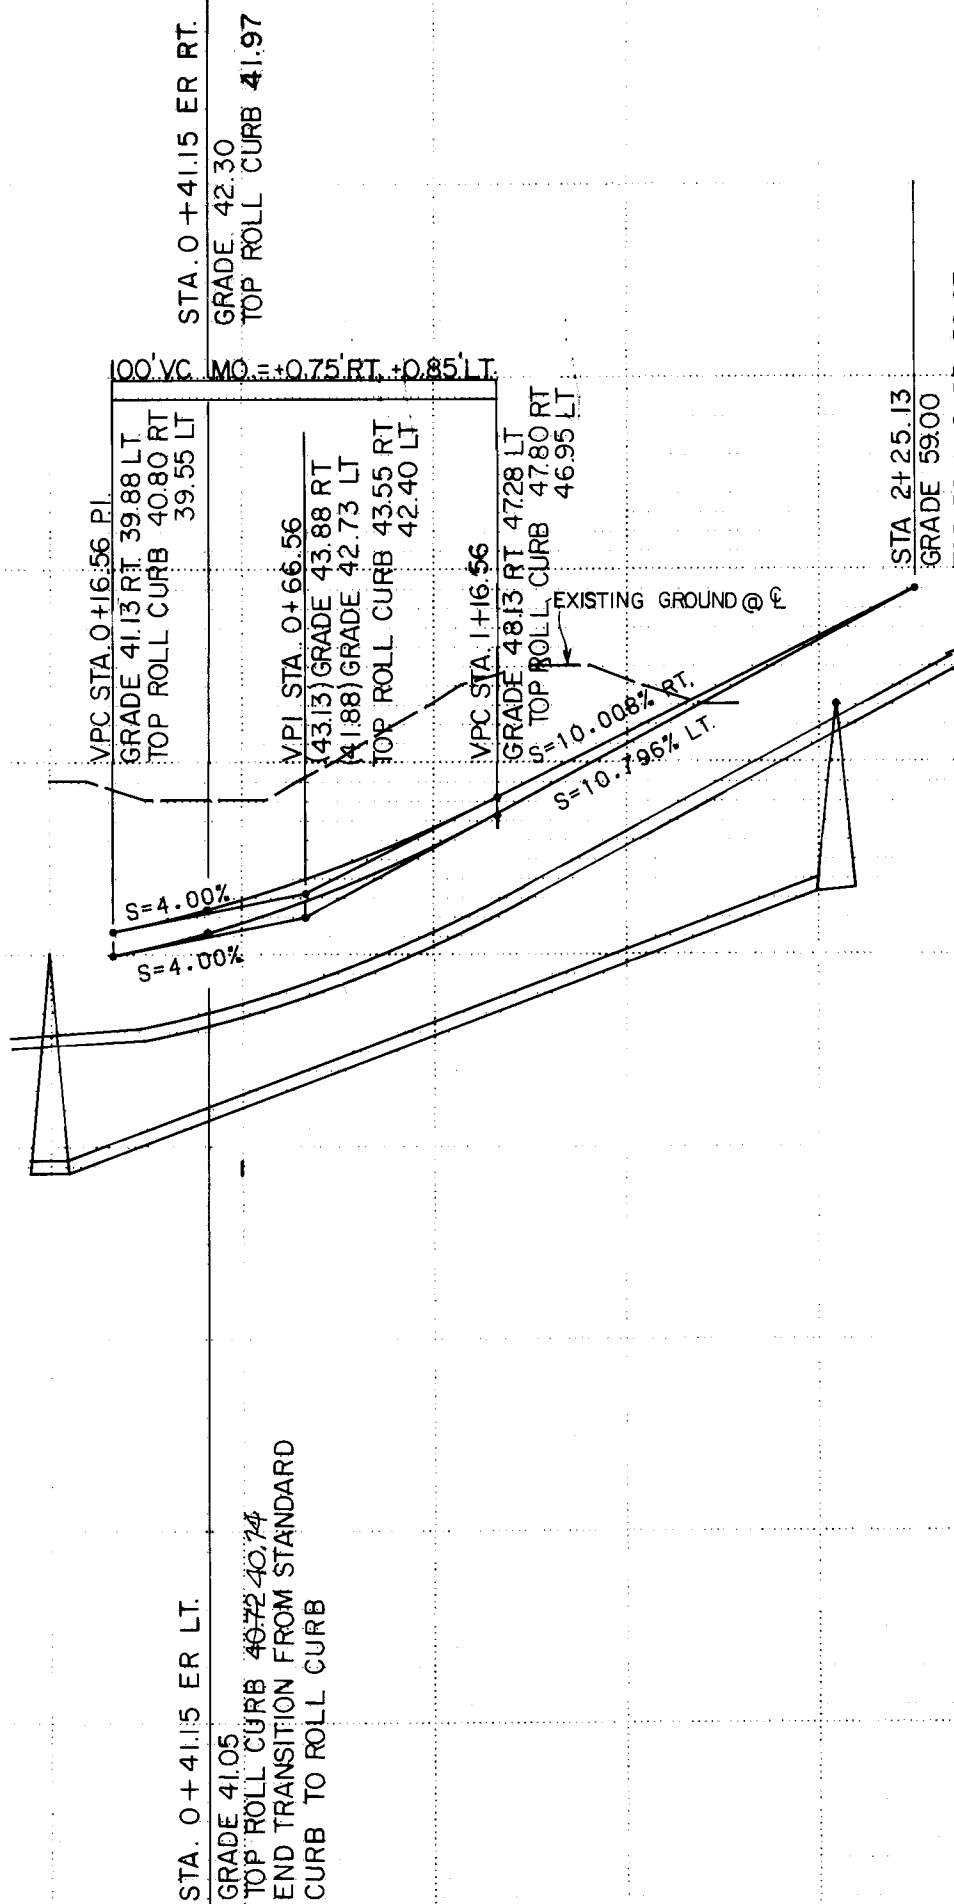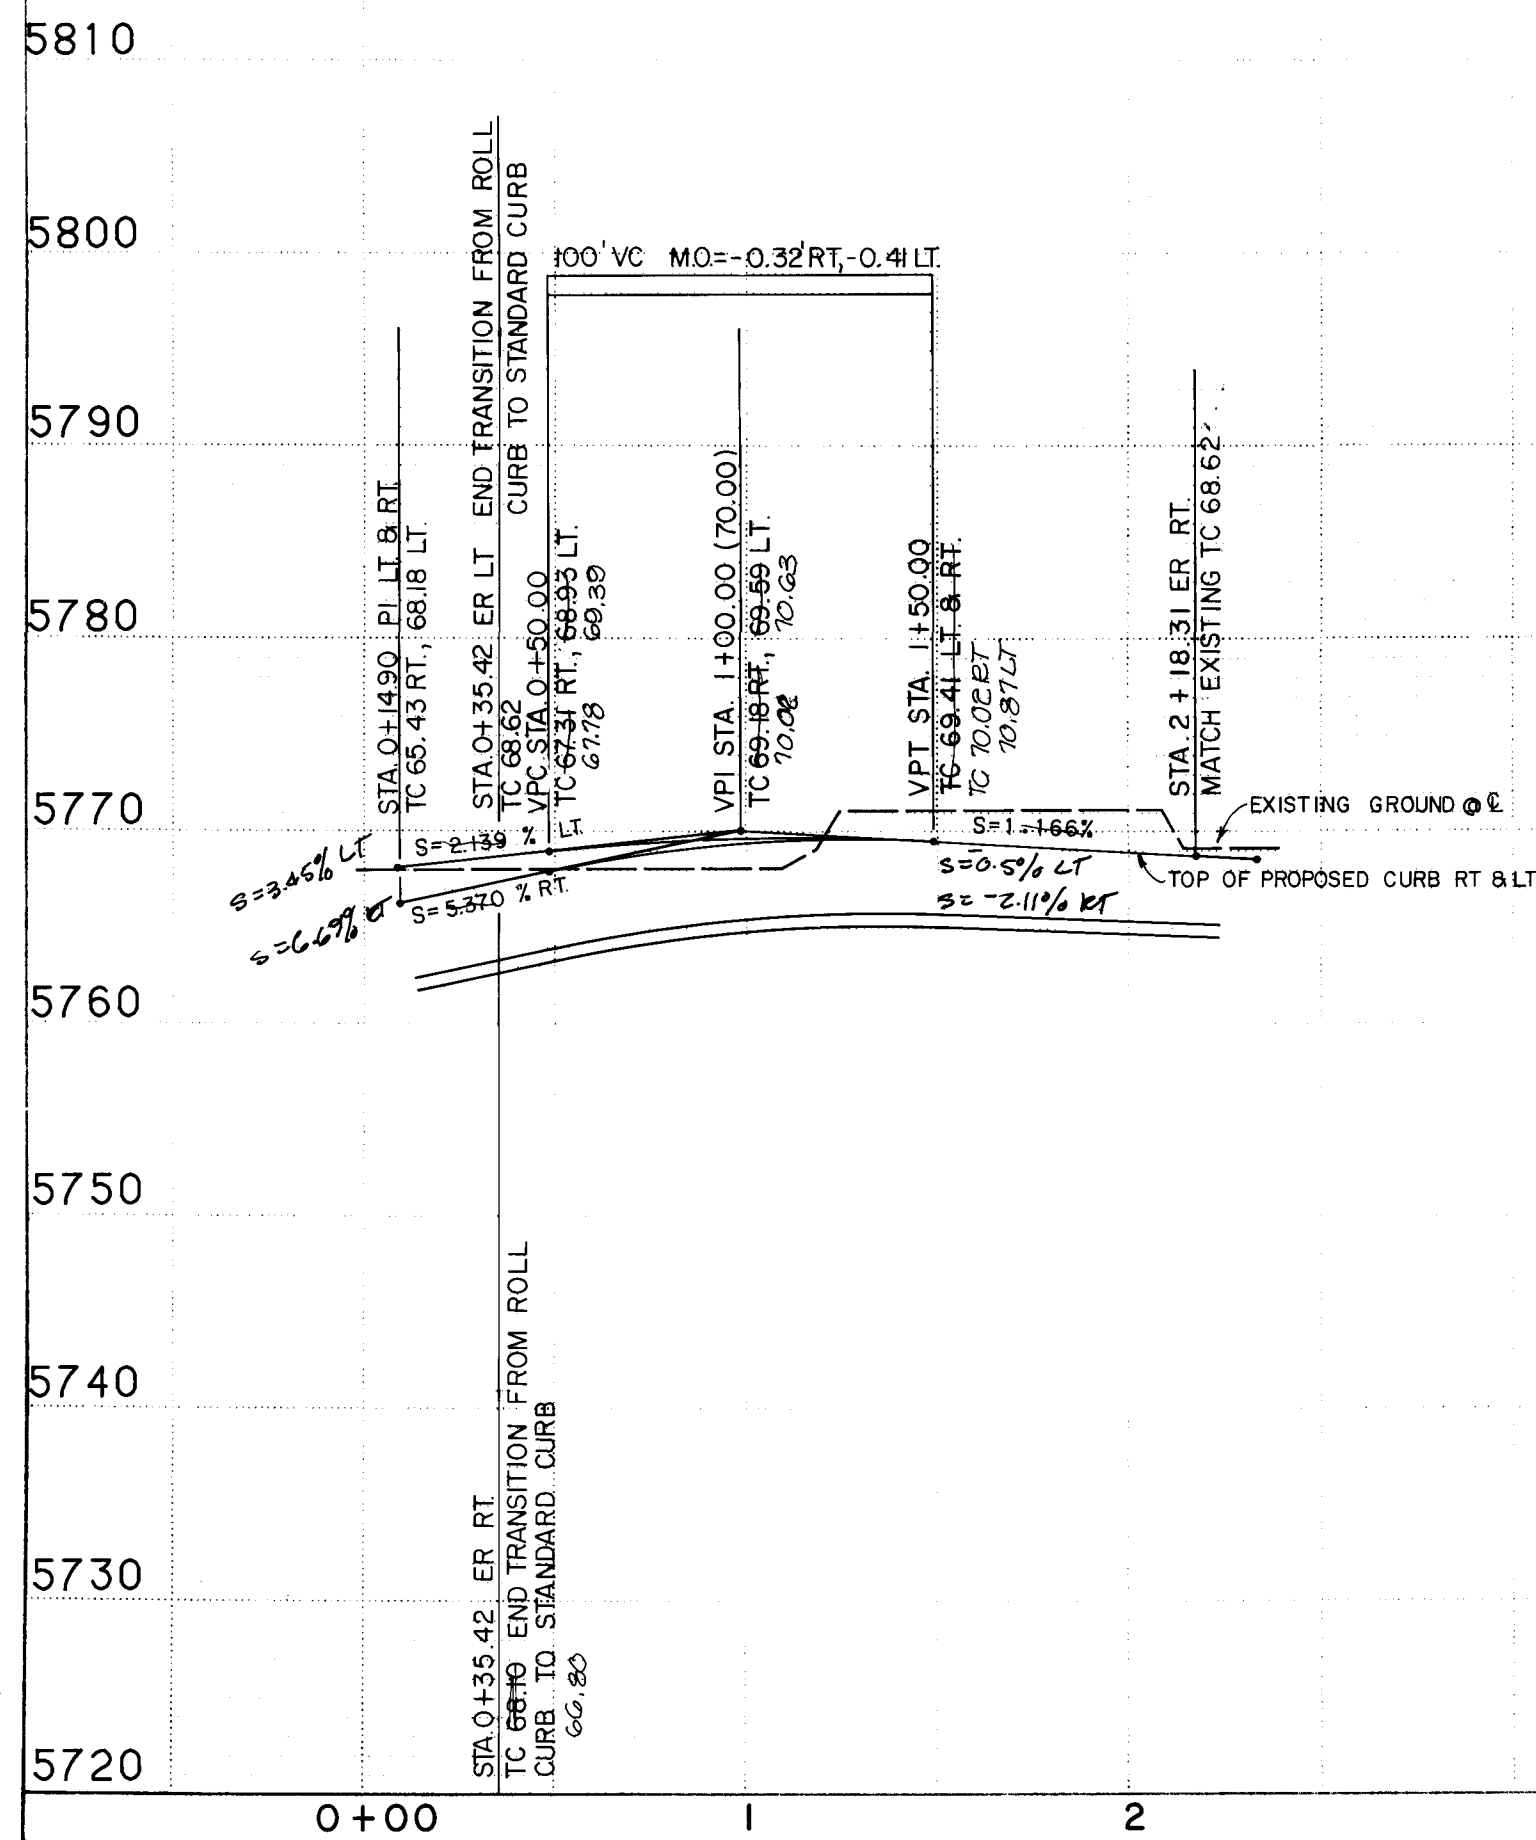

SCALE:
HORIZ. 1" = 50'
VERT. 1" = 10'

NOTES

1. ALL CURB RETURN RADII SHALL BE 25' TO BACK OF CURB UNLESS OTHERWISE SPECIFIED.

2. THE CONTRACTOR IS TO FIELD VERIFY ALL EXISTING UTILITY LOCATIONS AND NOTIFY THE ENGINEER OF ANY DISCREPANCIES.

RECORD DRAWING

This drawing as modified shows public improvements as constructed. These modifications have been made using information and measurements obtained by EHA's field survey information and the City Engineer's Office. The modifications conform to the minimum standards of the City of Albuquerque Development Process Manual, Section 27.4 to the best of my knowledge and belief.

William F. Coleman P.E. 5945
6/17/87

ENGINEER'S SEAL

BY

REVISIONS

DESIGN

DATE

DATE

1 2 3 4 5 6 7 8 9 10 11 12
26 23 6 8 1 7 8 7

CITY OF ALBUQUERQUE PUBLIC WORKS ENGINEERING	
TITLE: THE HIGHLANDS AT TANOAN COUNTRY CLUB RD. AND BEAU CHENE CT. PAVING PLAN & PROFILE	
APPROVALS	ENGINEER
D.R.C. Chairperson	1/1/87
Trans. Dev.	1/1/87
Utility Dev.	1/1/87
DATE	1/1/87
APPROVALS	ENGINEER
Parks & Rec. Dept.	
User Dept.	
User Dept.	
DESIGNED BY	DATE
DRAWN BY	DATE
CHECKED BY	DATE
DRAWING NO. 2368	
MAP NO. E-21	
SHEET 17 OF 23	

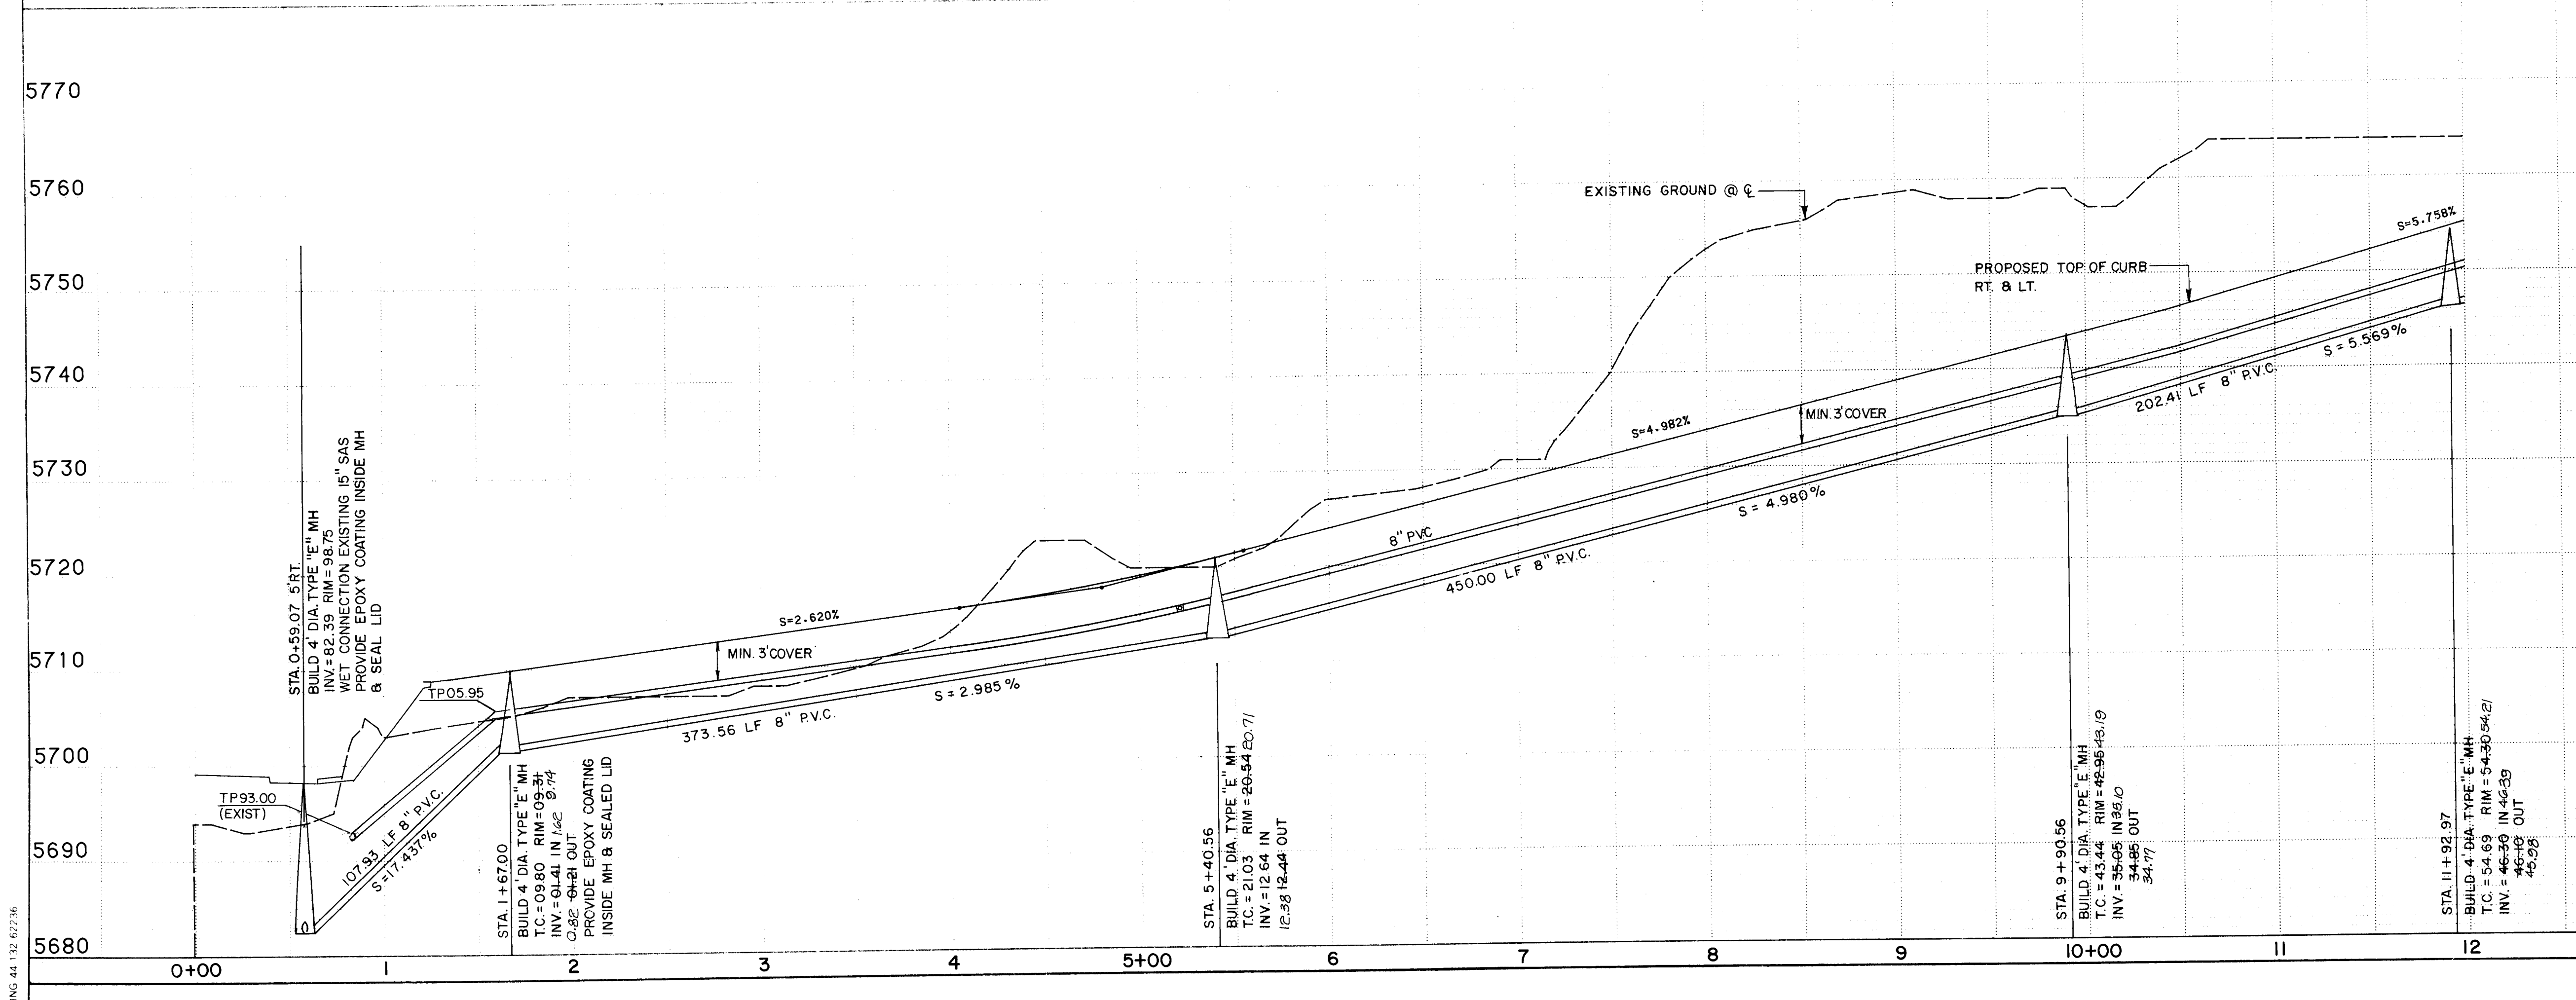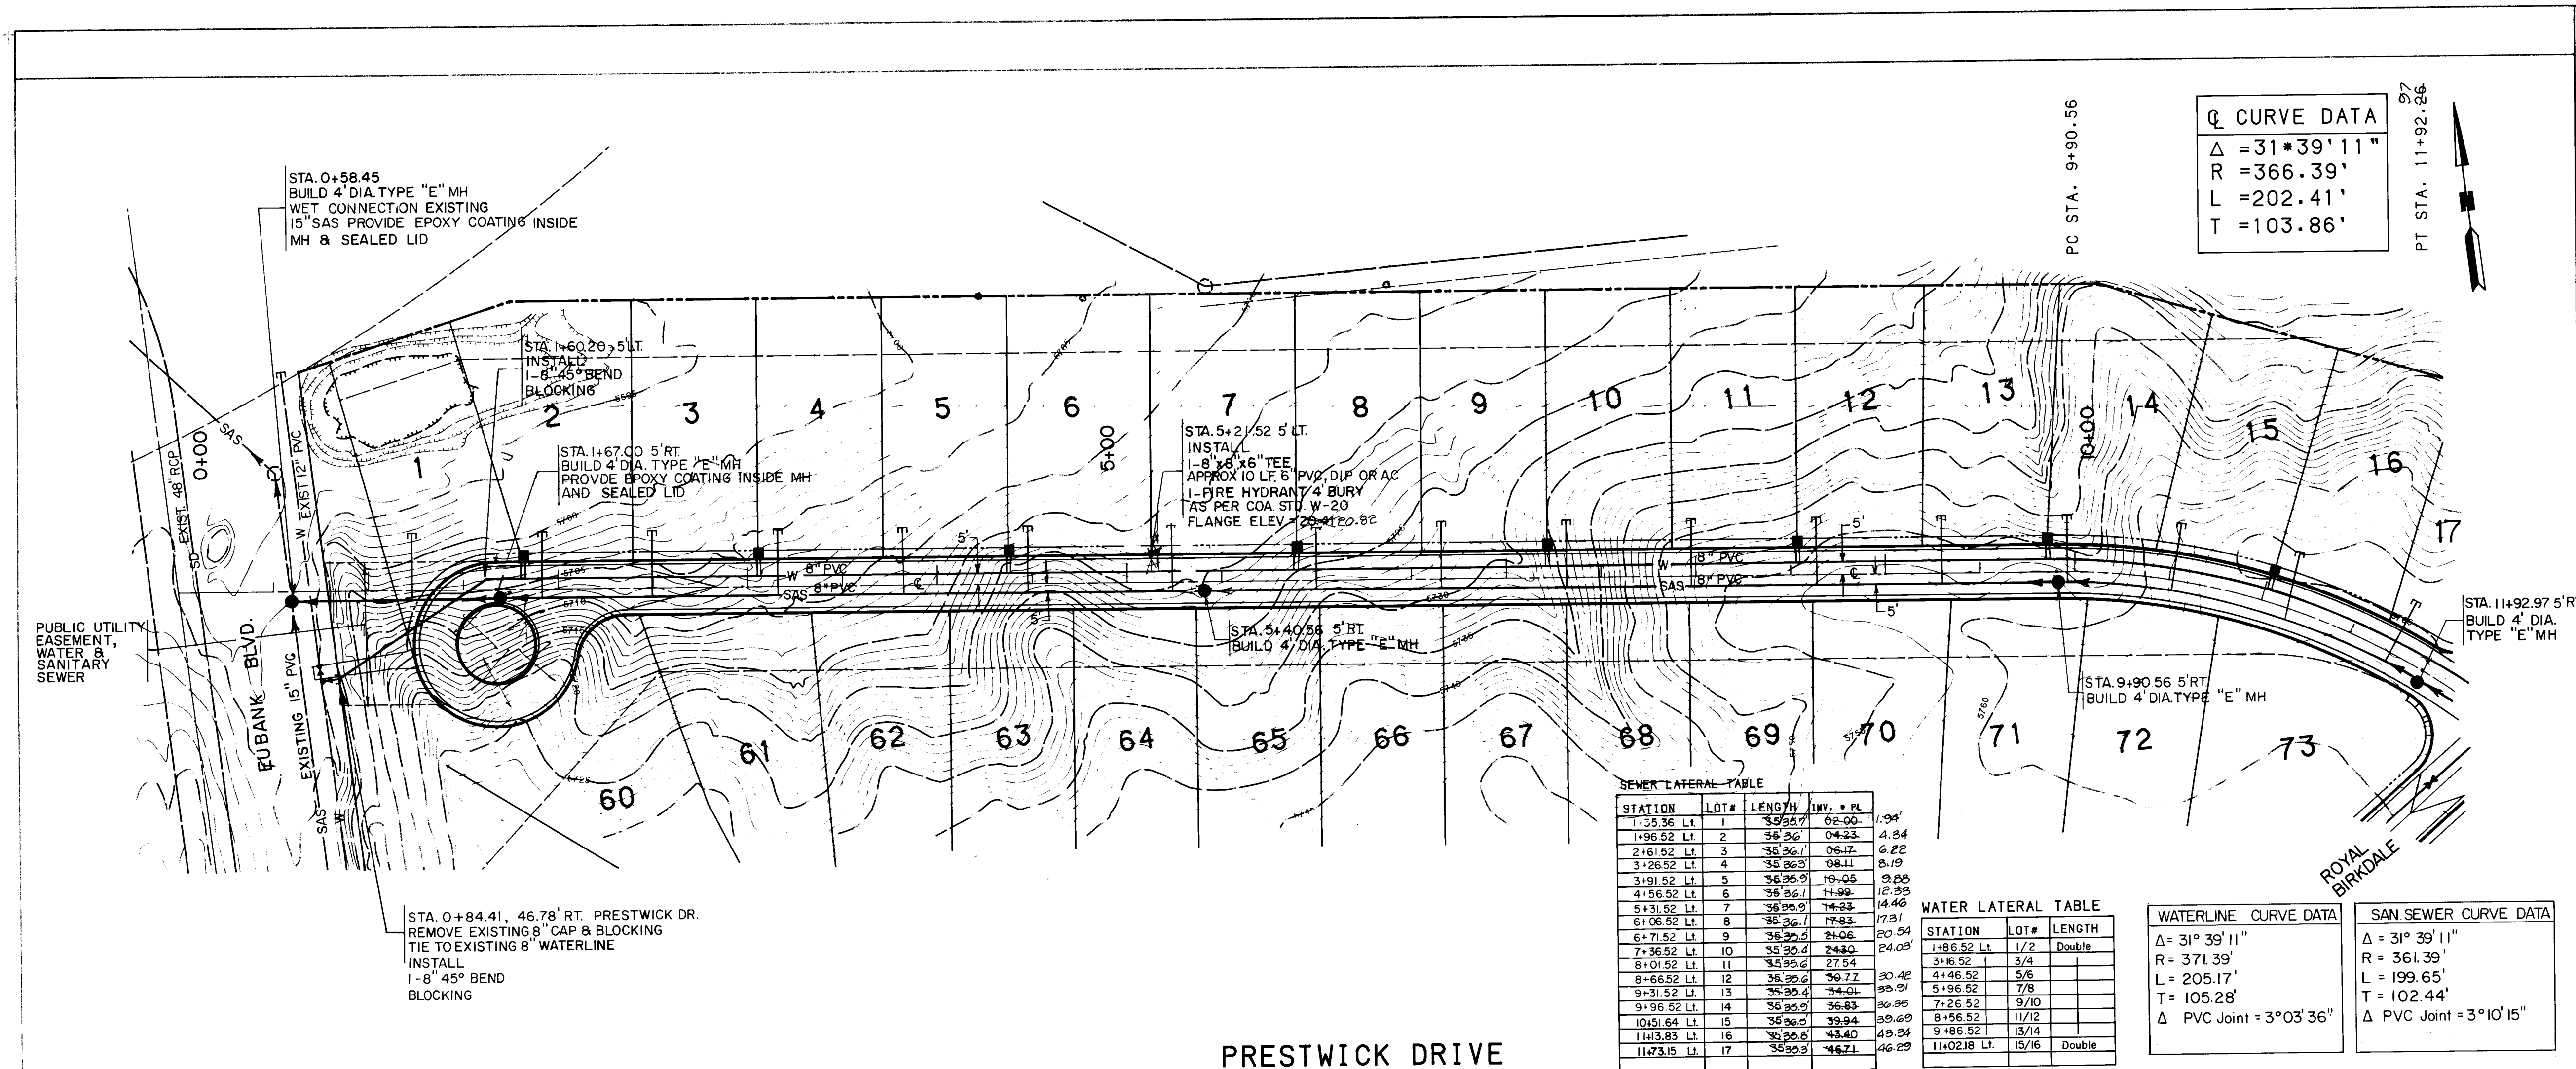

NOTES

1. THE CONTRACTOR IS TO FIELD VERIFY ALL EXISTING UTILITY LOCATIONS AND NOTIFY THE ENGINEER IMMEDIATELY OF ANY DISCREPANCIES.

RECORD DRAWING

This drawing as modified shows public improvements as constructed. These modifications have been made using information and measurements obtained by EHA's field survey team. The modifications are for informational purposes only and do not constitute a change to the minimum requirements for the City of Albuquerque sewer development process. Manual Section 27.4 to the best of my knowledge and belief.

William F. Coleman P.E. 5945
6/17/07

AS BUILT INFORMATION

CONTRACTOR	DATE
CCM	1/87

BENCH MARKS

A STANDARD ACS BRASS TABLE STAMPED "421A" SET IN TOP OF A CONCRETE POST. THE BENCH MARK IS +300' WEST AND +560' NORTH FROM INTERSECTION OF EUBANK BLVD. AND ACADEMY RD. ELEVATION = 5698.12 FEET.

SURVEY INFORMATION

DATE	BY	NO.
1/87	EHA	1/87

ENGINEER'S SEAL

Signature
6/17/07

REVISIONS

NO.	DATE	REMARKS
1	10/86	DESIGN

DESIGNED BY

KLD

DRAWN BY

RB

CHECKED BY

KLD

CITY OF ALBUQUERQUE

PUBLIC WORKS
ENGINEERING

TITLE

THE HIGHLANDS AT TANOAN
PRESTWICK DRIVE UTILITY PLAN AND PROFILE

APPROVALS

ENGINEER	DATE	APPROVALS	ENGINEER	DATE
DRG Chairperson	1/27/07	Parks & Rec Dept.		
Trans. Dev.	1/14/07	User Dept.		
Utility Dev.	1-14-07	User Dept.		

DRAWING NO.

2368

MAP NO.


E-21

SHEET

18

OF

23

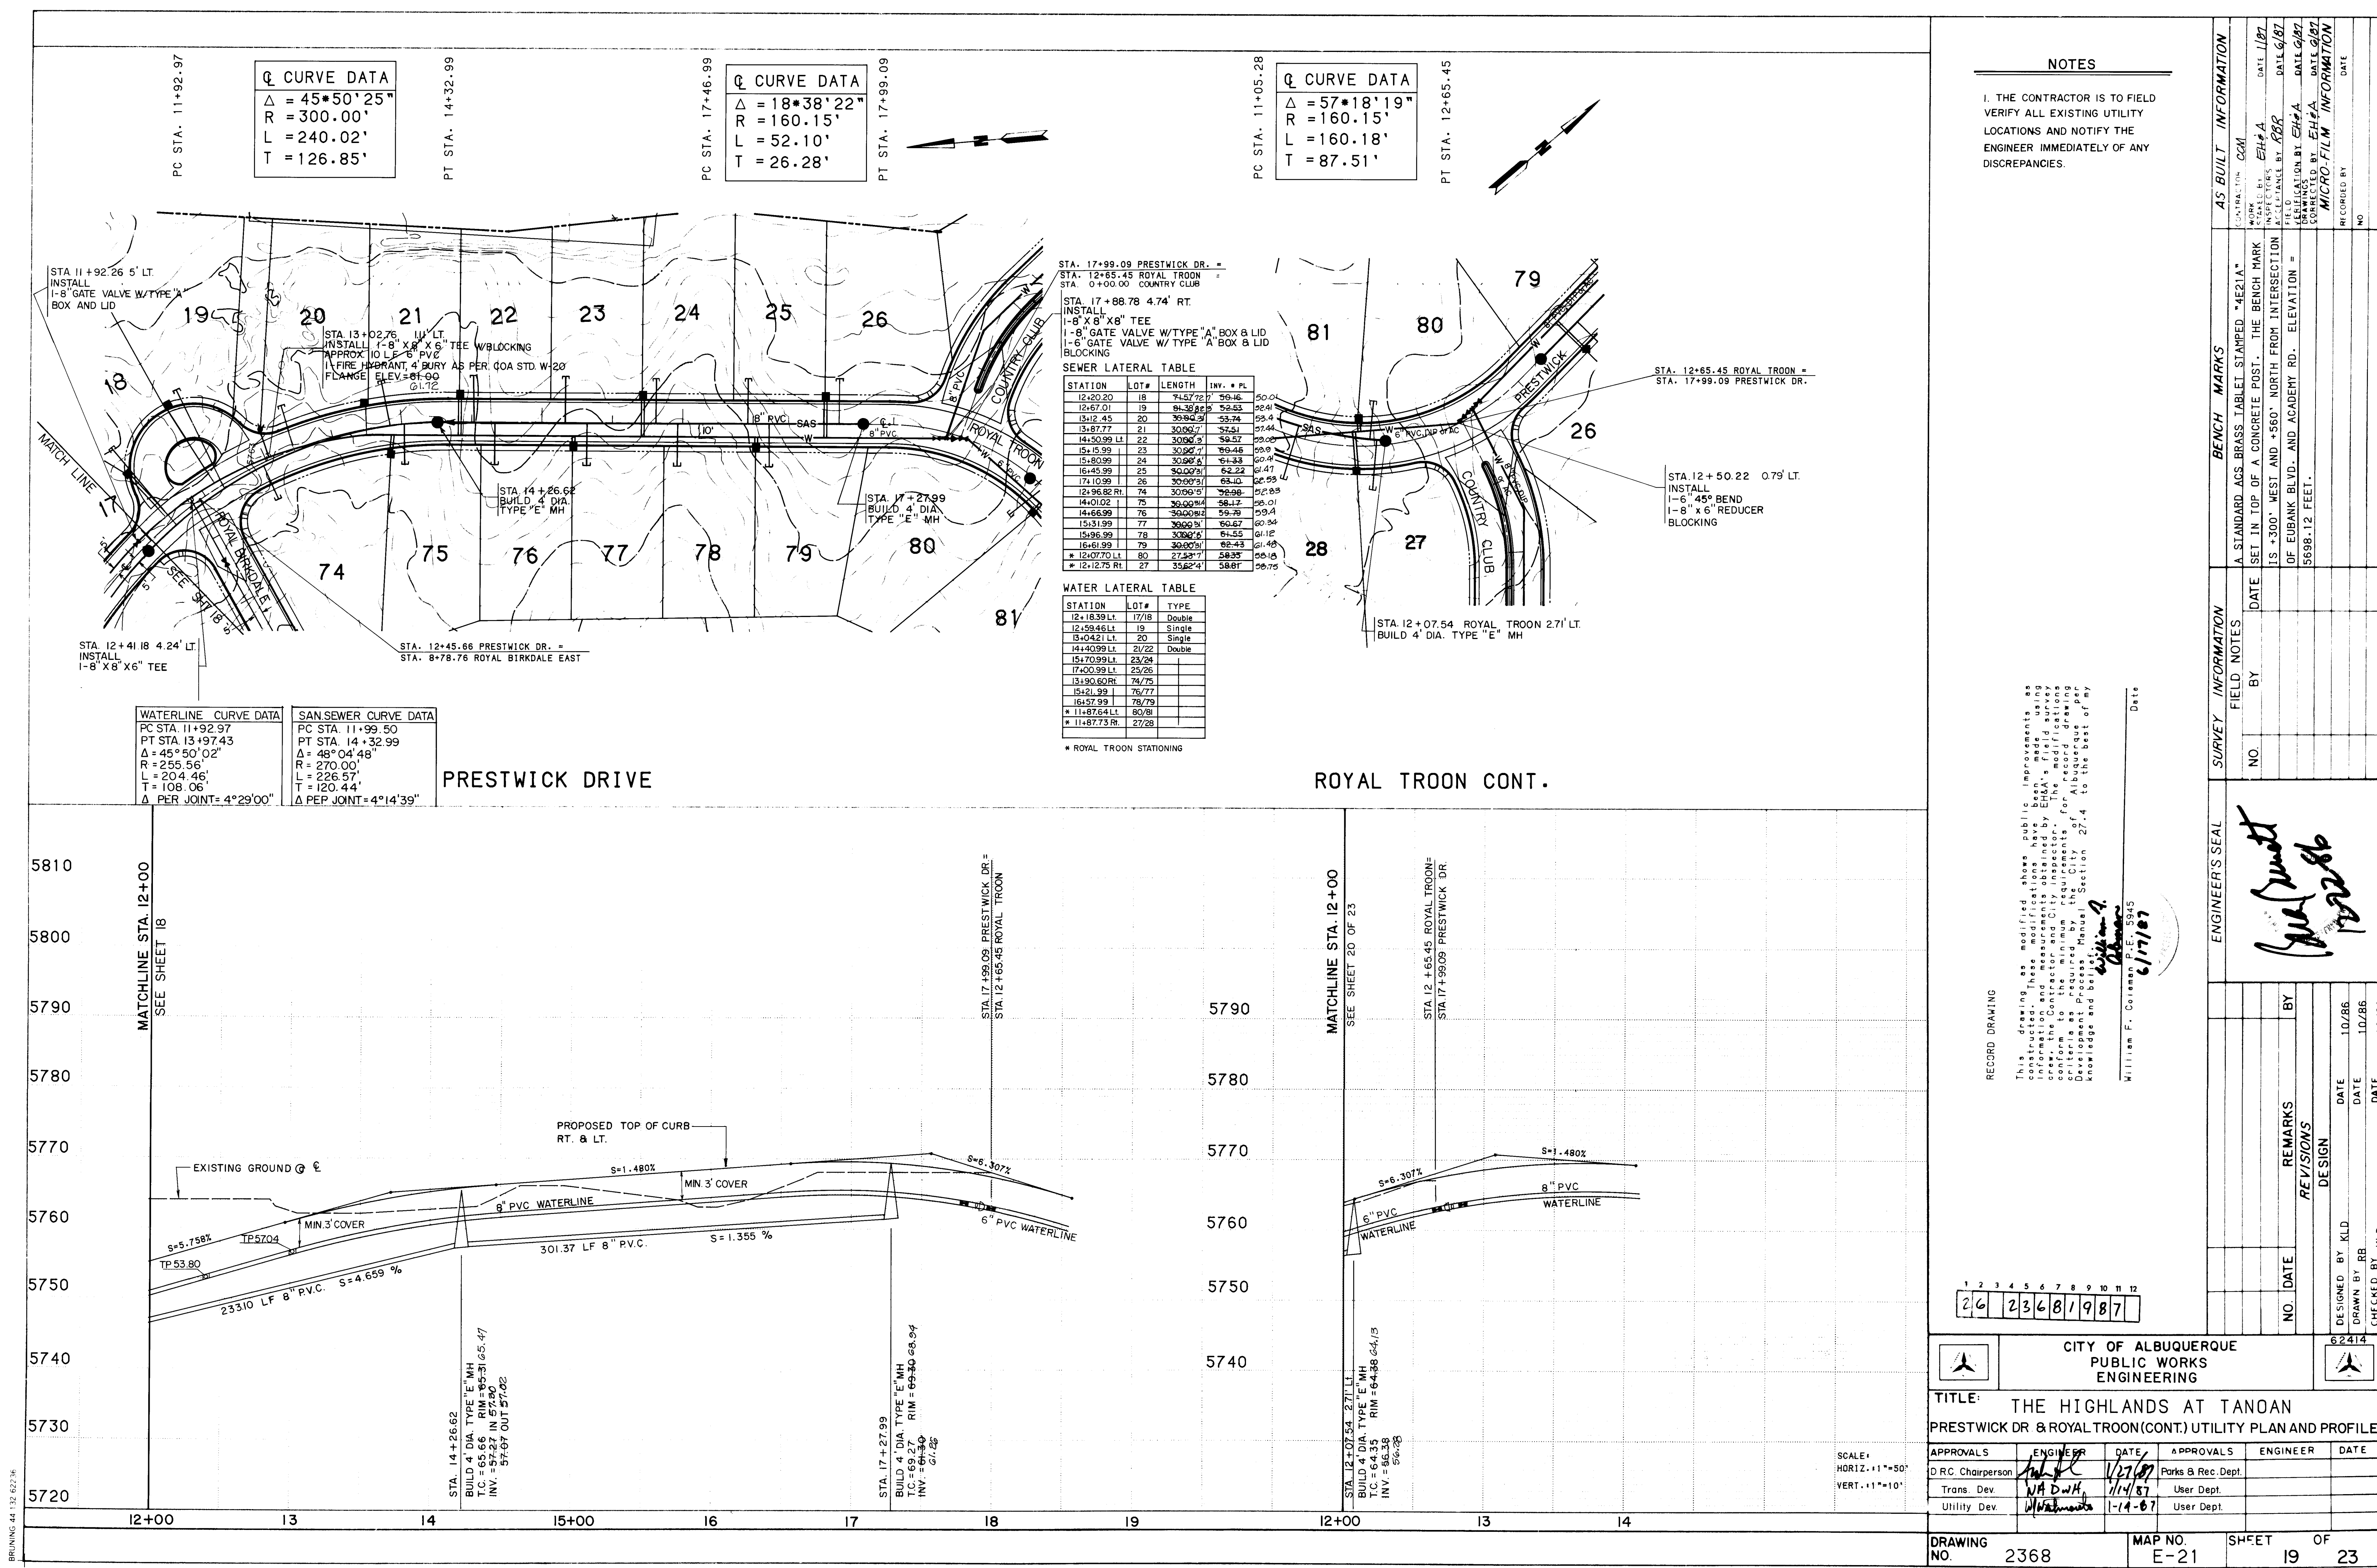

NOTES

1. THE CONTRACTOR IS TO FIELD VERIFY ALL EXISTING UTILITY LOCATIONS AND NOTIFY THE ENGINEER IMMEDIATELY OF ANY DISCREPANCIES.


RECORD DRAWING

This drawing as modified shows public improvements as constructed. These modifications have been made using the field survey data obtained by the City of Albuquerque. The Contractor is responsible for verifying the field data and for making any necessary modifications to the drawing to conform to the minimum requirements for the project. The City of Albuquerque is not responsible for any errors or omissions in this drawing.

William F. Coleman P.E. 5945
6/17/87

1	2	3	4	5	6	7	8	9	10	11	12
26	23	68	19	87							

CITY OF ALBUQUERQUE PUBLIC WORKS ENGINEERING		
TITLE: THE HIGHLANDS AT TANOAN PRESTWICK DR & ROYAL TROON (CONT.) UTILITY PLAN AND PROFILE		
APPROVALS	ENGINEER	DATE
D.R.C. Chairperson	WADW	1/27/87
Trans. Dev.	WADW	1/14/87
Utility Dev.	WADW	1/14/87
APPROVALS	ENGINEER	DATE
DESIGNED BY KLD	DATE 10/86	
DRAWN BY RB	DATE 10/86	
CHECKED BY KLD	DATE 10/86	
DRAWING NO. 2368	MAP NO. E-21	SHEET 19 OF 23

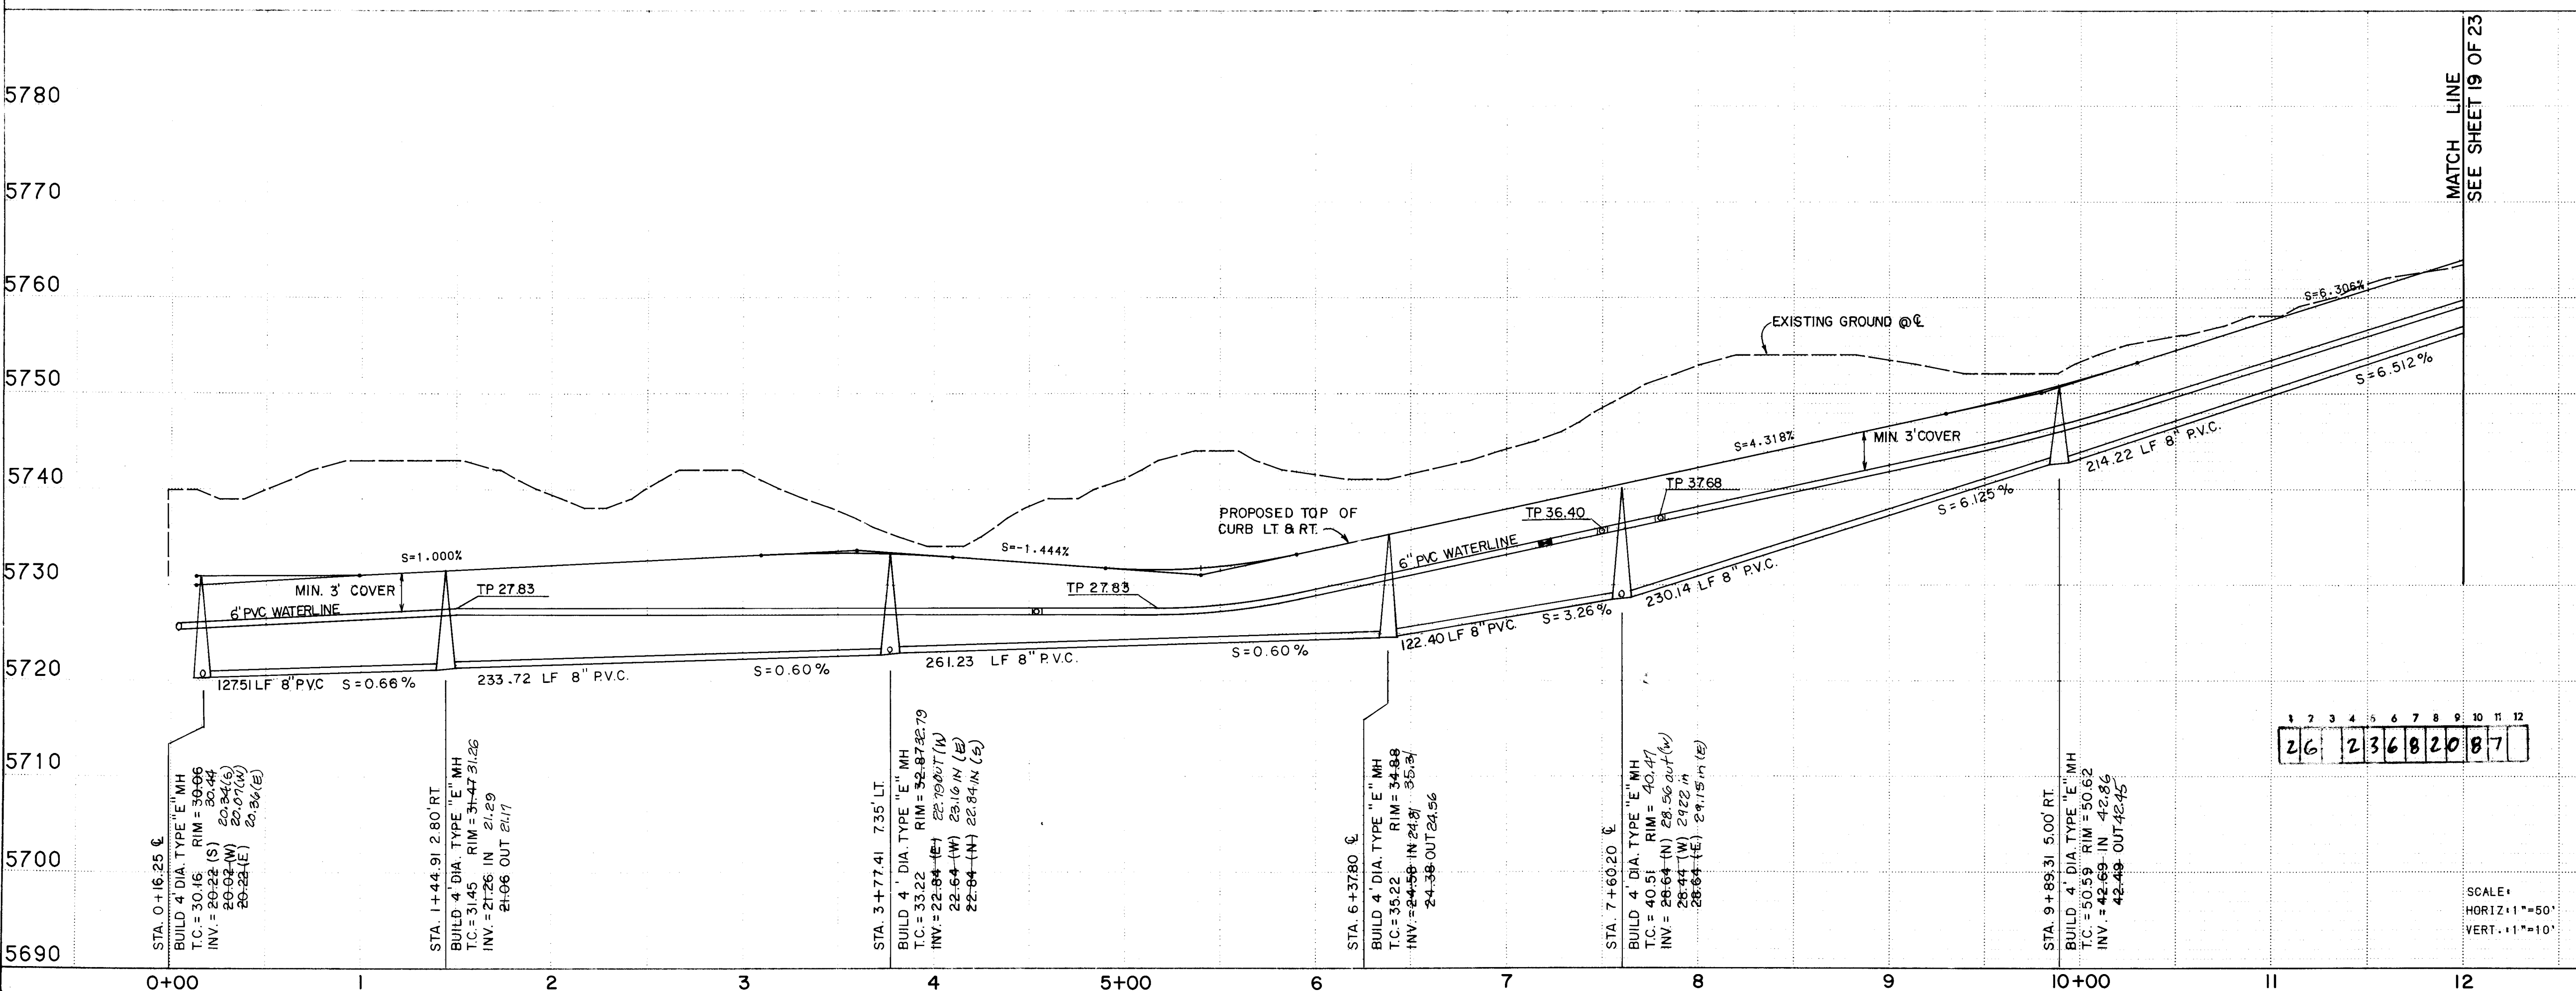

(A) $\Delta = 21^{\circ}53'53''$
 $R = 464.35'$
 $L = 17747'$
 $T = 89.83'$
 $\Delta \text{ per joint} = 2^{\circ}28'04''$

(B) $\Delta = 42^{\circ}36'00''$
 $R = 228.00'$
 $L = 169.52'$
 $T = 88.89'$
 $\Delta \text{ per joint} = 5^{\circ}01'33''$


(C) $\Delta = 11^{\circ}17'14''$
 $R = 1617.03'$
 $L = 318.55'$
 $T = 159.79'$
 $\Delta \text{ per joint} = 0^{\circ}42'31''$

Coleman


William F. Coleman P.E. 5945
Date _____

Wb. Smith
2-22-8

DRAWING NO.	2368	MAP NO.	E-21	SHEET	OF	20	23
-------------	------	---------	------	-------	----	----	----

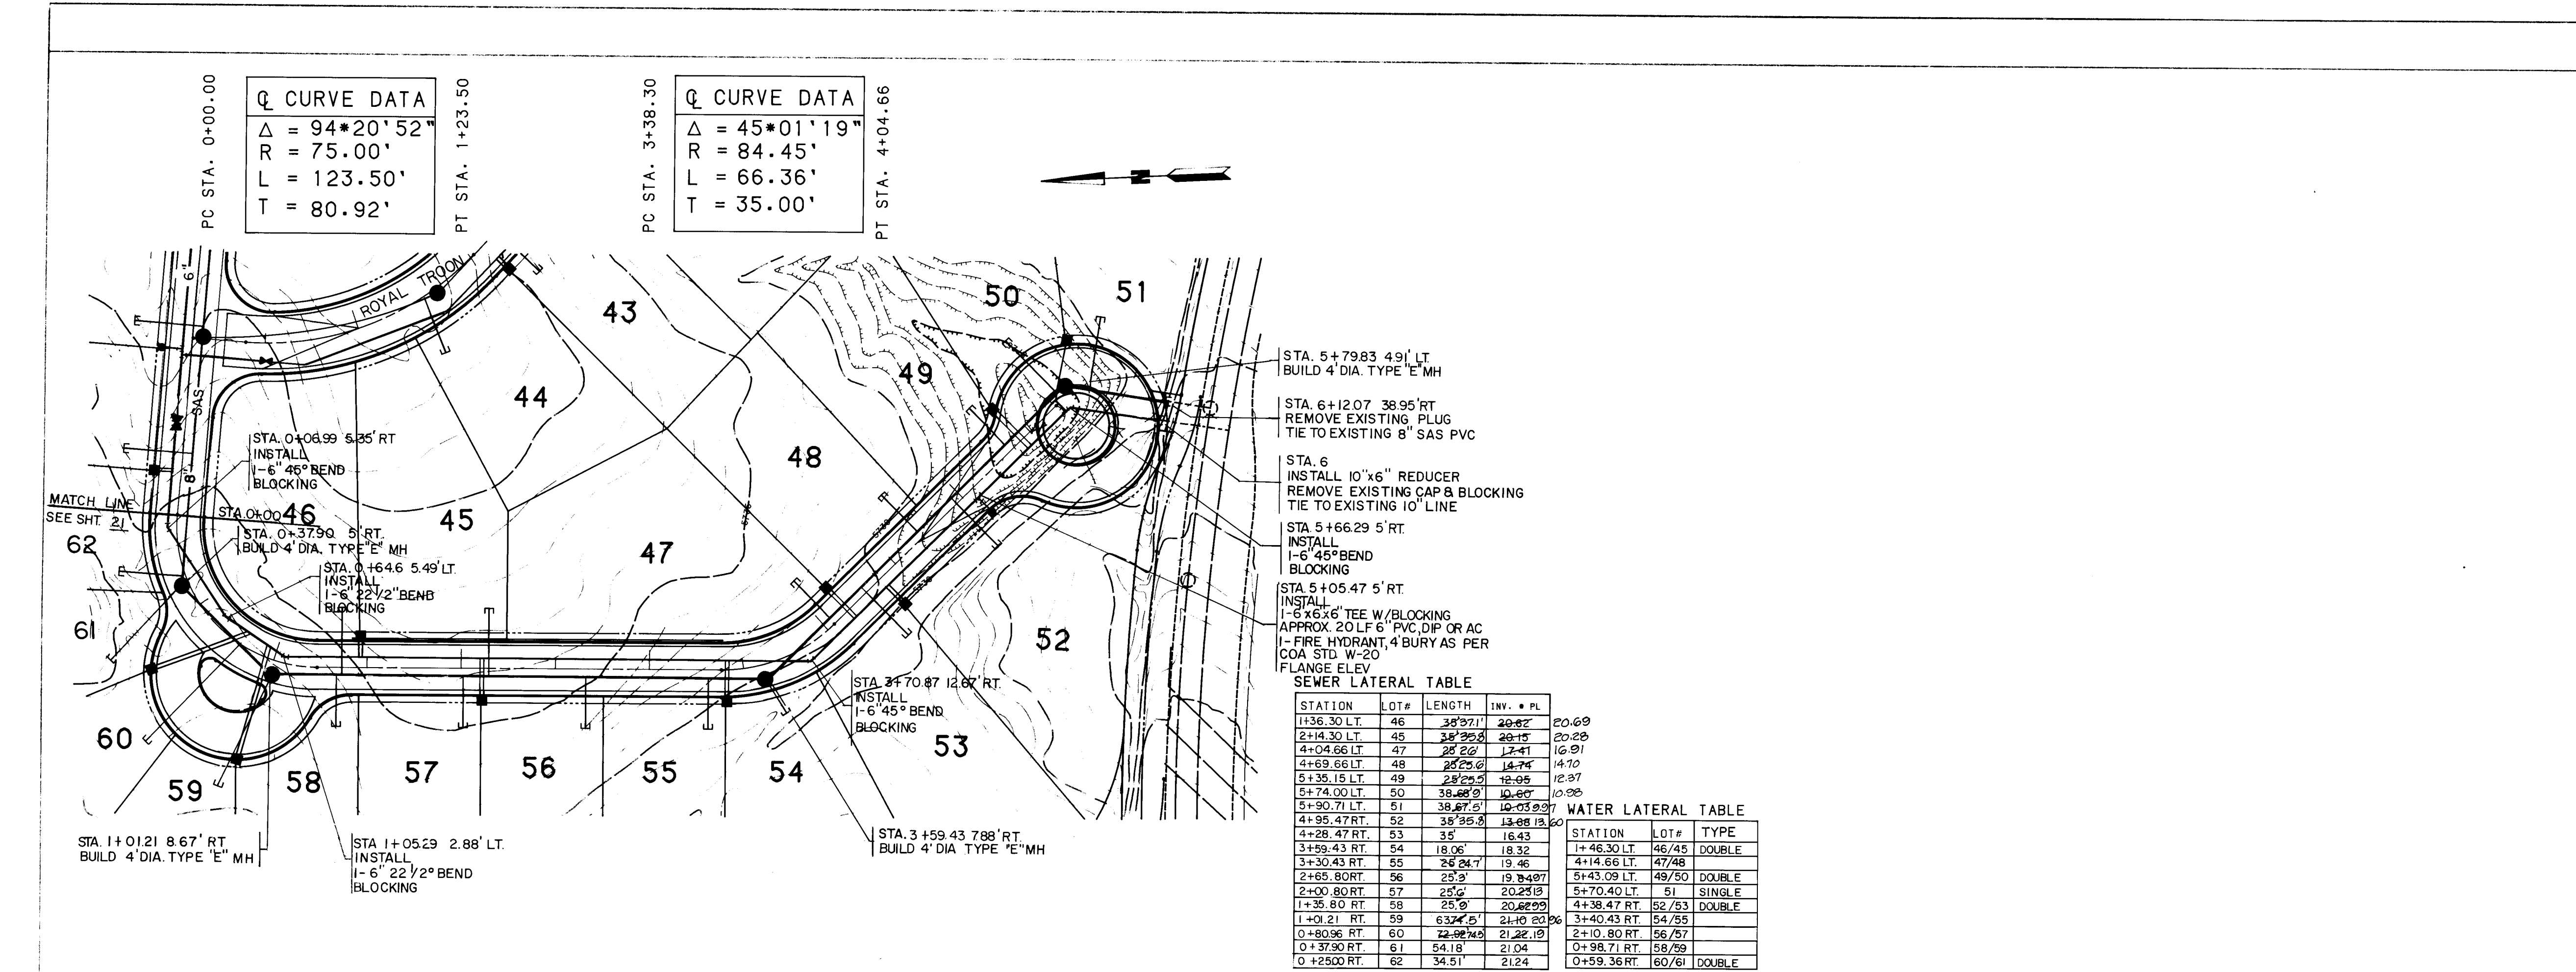

ROYAL BIRKDALE WEST

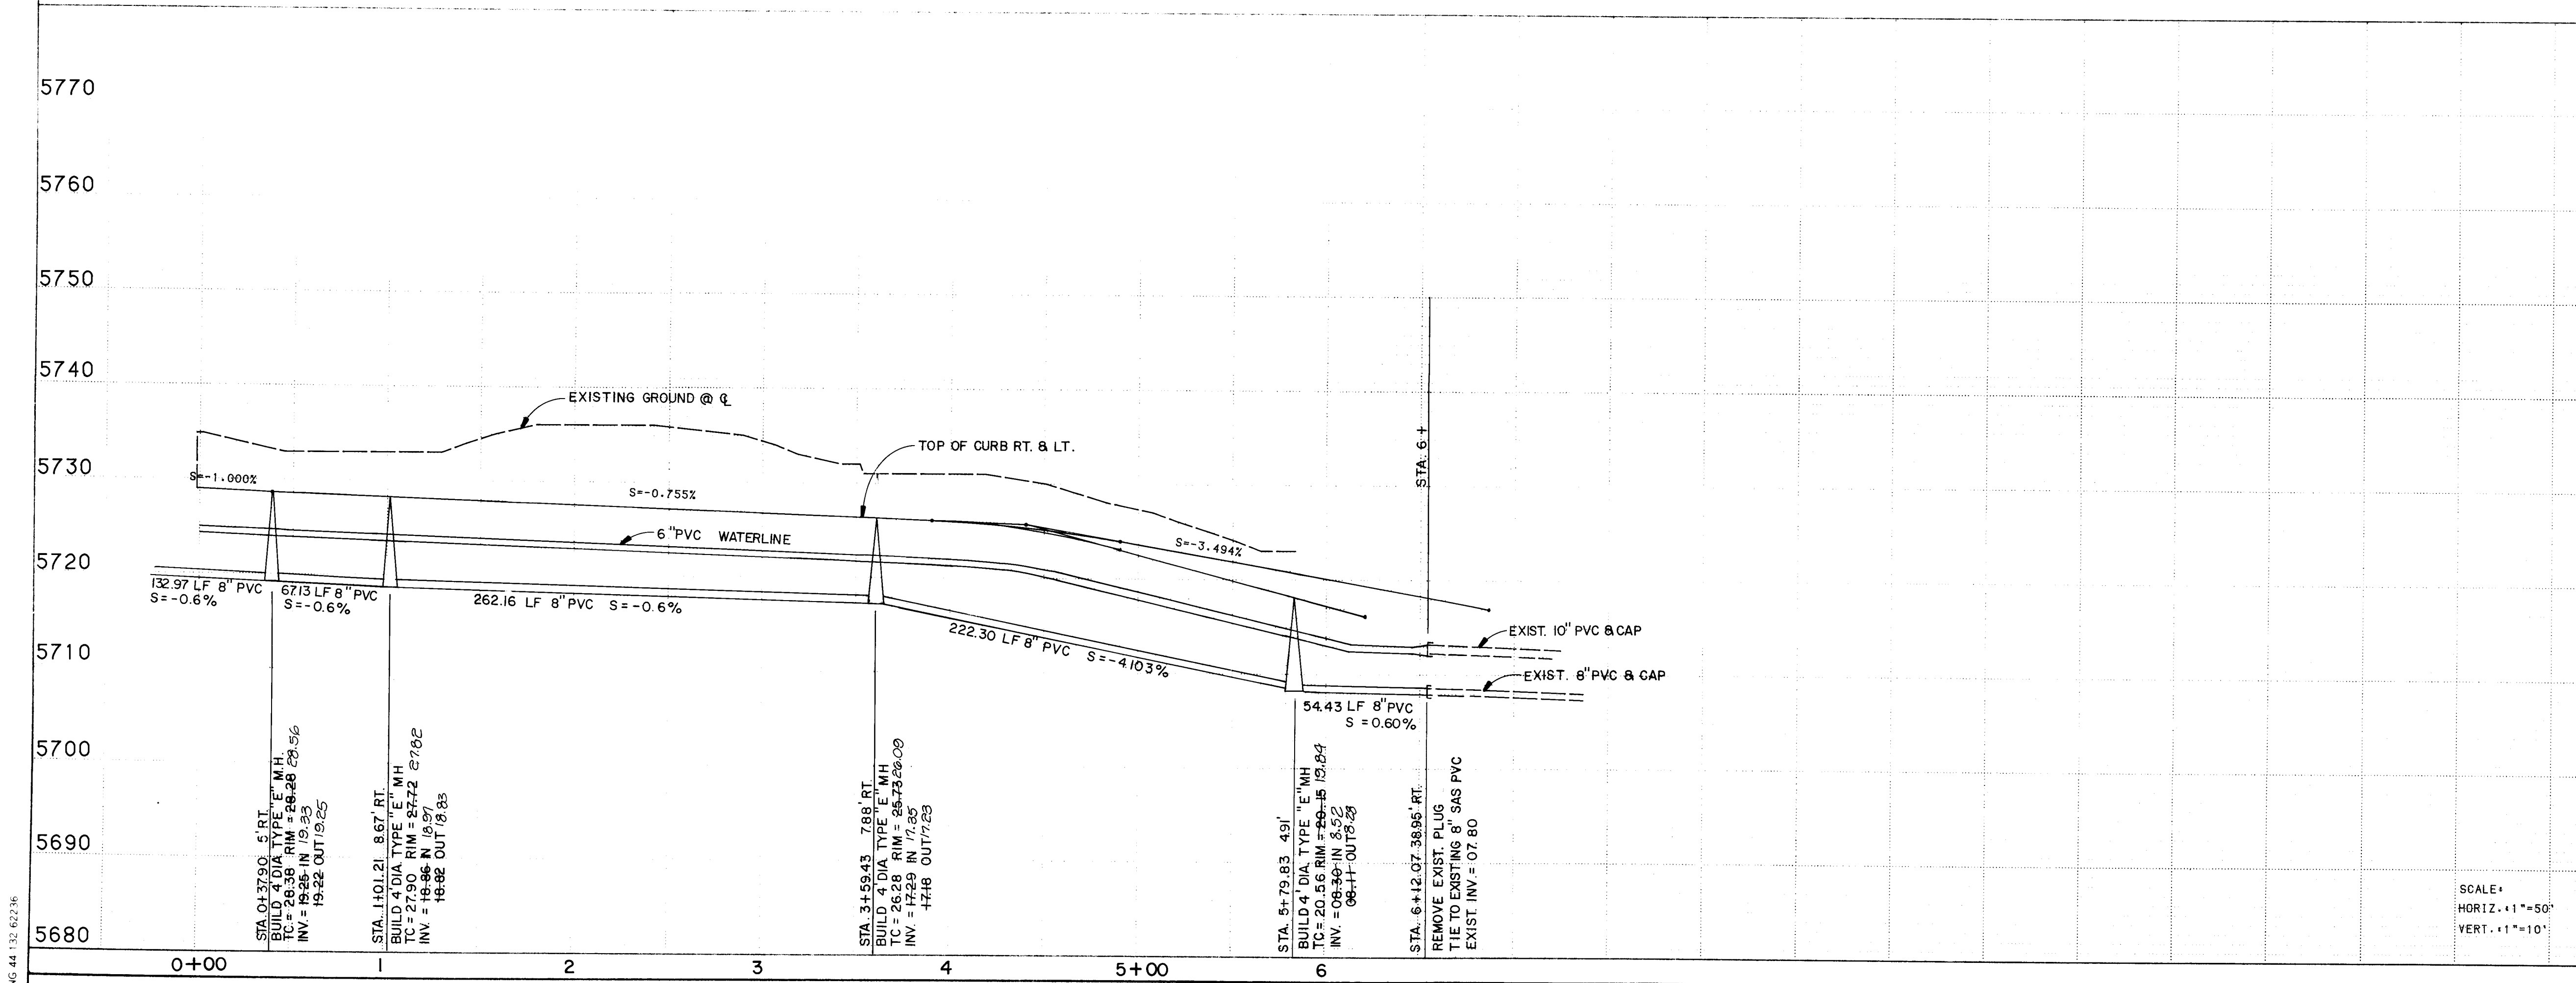

NOTES

I. THE CONTRACTOR IS TO FIELD VERIFY ALL EXISTING UTILITY LOCATIONS AND NOTIFY THE ENGINEER IMMEDIATELY OF ANY DISCREPANCIES.

RECORD DRAWING

This drawing as modified shows public improvements as constructed. These modifications have been made using information and measurements obtained by EHA's field survey information. The City Engineer's Office has reviewed and approved the modifications. The modifications conform to the minimum requirements for engineering drawings as required by the City of Albuquerque Engineering Department. Manual Section 27.4 to the best of my knowledge and belief.

William F. Coleman P.E. 5945
6/17/87

AS BUILT INFORMATION

A STANDARD ACS BRASS TABLE STAMPED "4E21A" SET IN TOP OF A CONCRETE POST. THE BENCH MARK IS +300' WEST AND +560' NORTH FROM INTERSECTION OF EUBANK BLVD. AND ACADEMY RD. ELEVATION = 5688.12 FEET.

SURVEY INFORMATION

FIELD NOTES

NO. BY DATE

ENGINEER'S SEAL

DESIGNED BY KLD
DRAWN BY RB
CHECKED BY KLD

DATE 10/86
DATE 10/86
DATE 10/86

REVIEWS

NO. DATE REMARKS

1 2 3 4 5 6 7 8 9 10 11 12

26 23 6 8 2 2 8 7

CITY OF ALBUQUERQUE
PUBLIC WORKS
ENGINEERING

62414

TITLE: THE HIGHLANDS AT TANOAN
ROYAL BIRKDALE WEST UTILITY PLAN AND PROFILE

APPROVALS

ENGINEER DATE 1/27/87
D.R.C. Chairperson 1/27/87
Trans. Dev. 1/14/87
Utility Dev. 1-14-87

APPROVALS

ENGINEER DATE
Parks & Rec. Dept.
User Dept.
User Dept.

DRAWING NO. 2368

MAP NO. E-21

SHEET 22 OF 23

BRUNING 44-132 62236