


20-50-531

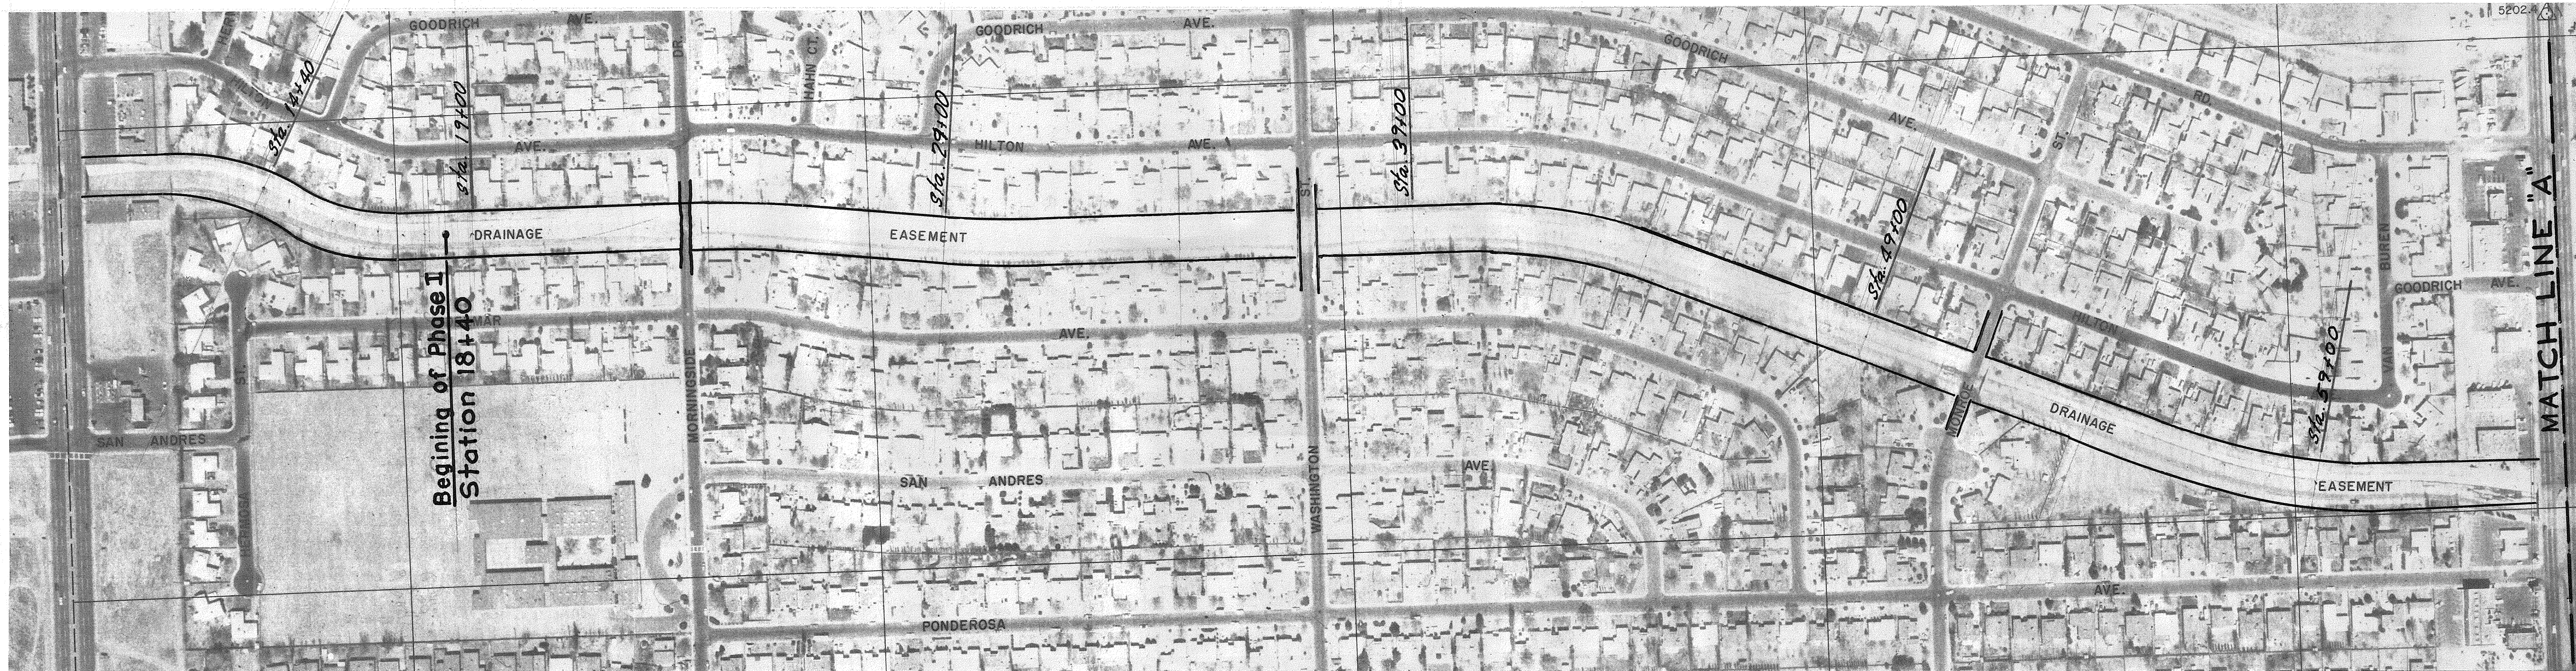

Scale: 1" = 200'

Scale: 1" = 200'


ALL SHEETS
APPROVAL OF AS BUILT DRAWINGS
ASST. CITY ENGINEER - FIELD
DATE 2-23-82

APPROVED FOR
CONSTRUCTION
DATE 4/12/80
CITY ENGINEER


1 2 3 4 5 6 7 8 9 10 11 12
20 237 0129

CITY OF ALBUQUERQUE PUBLIC WORKS DEPARTMENT ENGINEERING DIVISION					
TITLE: HAHN ARROYO CHANNEL REPAIR PHASE I					
APPROVALS	ENGINEER	DATE	APPROVALS	ENGINEER	DATE
City Engineer	<i>[Signature]</i>	6/12/80	Liquid Waste		
A.C.E.-Design	<i>[Signature]</i>	11/26/80	Traffic		
A.C.E.-Hydrology			Water		
DRAWING NO.	SD-29-237		SHEET	1 OF 7	


REFERENCES		SURVEY INFORMATION		BENCH MARKS		AS BUILT INFORMATION	
MAP NO.	617/9-18 AM	FIELD NOTES				CONTRACTOR	
EST. NO.	W.O. NO.	NO.	BY	DATE	WORK ORDERED BY INSPECTOR'S DATE		
					ACCEPTANCE BY DATE		
					FIELD INVESTIGATION BY DATE		
					DRAWINGS CORRECTED BY DATE		
					MICRO-FILM INFORMATION		
					RECORDED BY DATE		
					NO.		

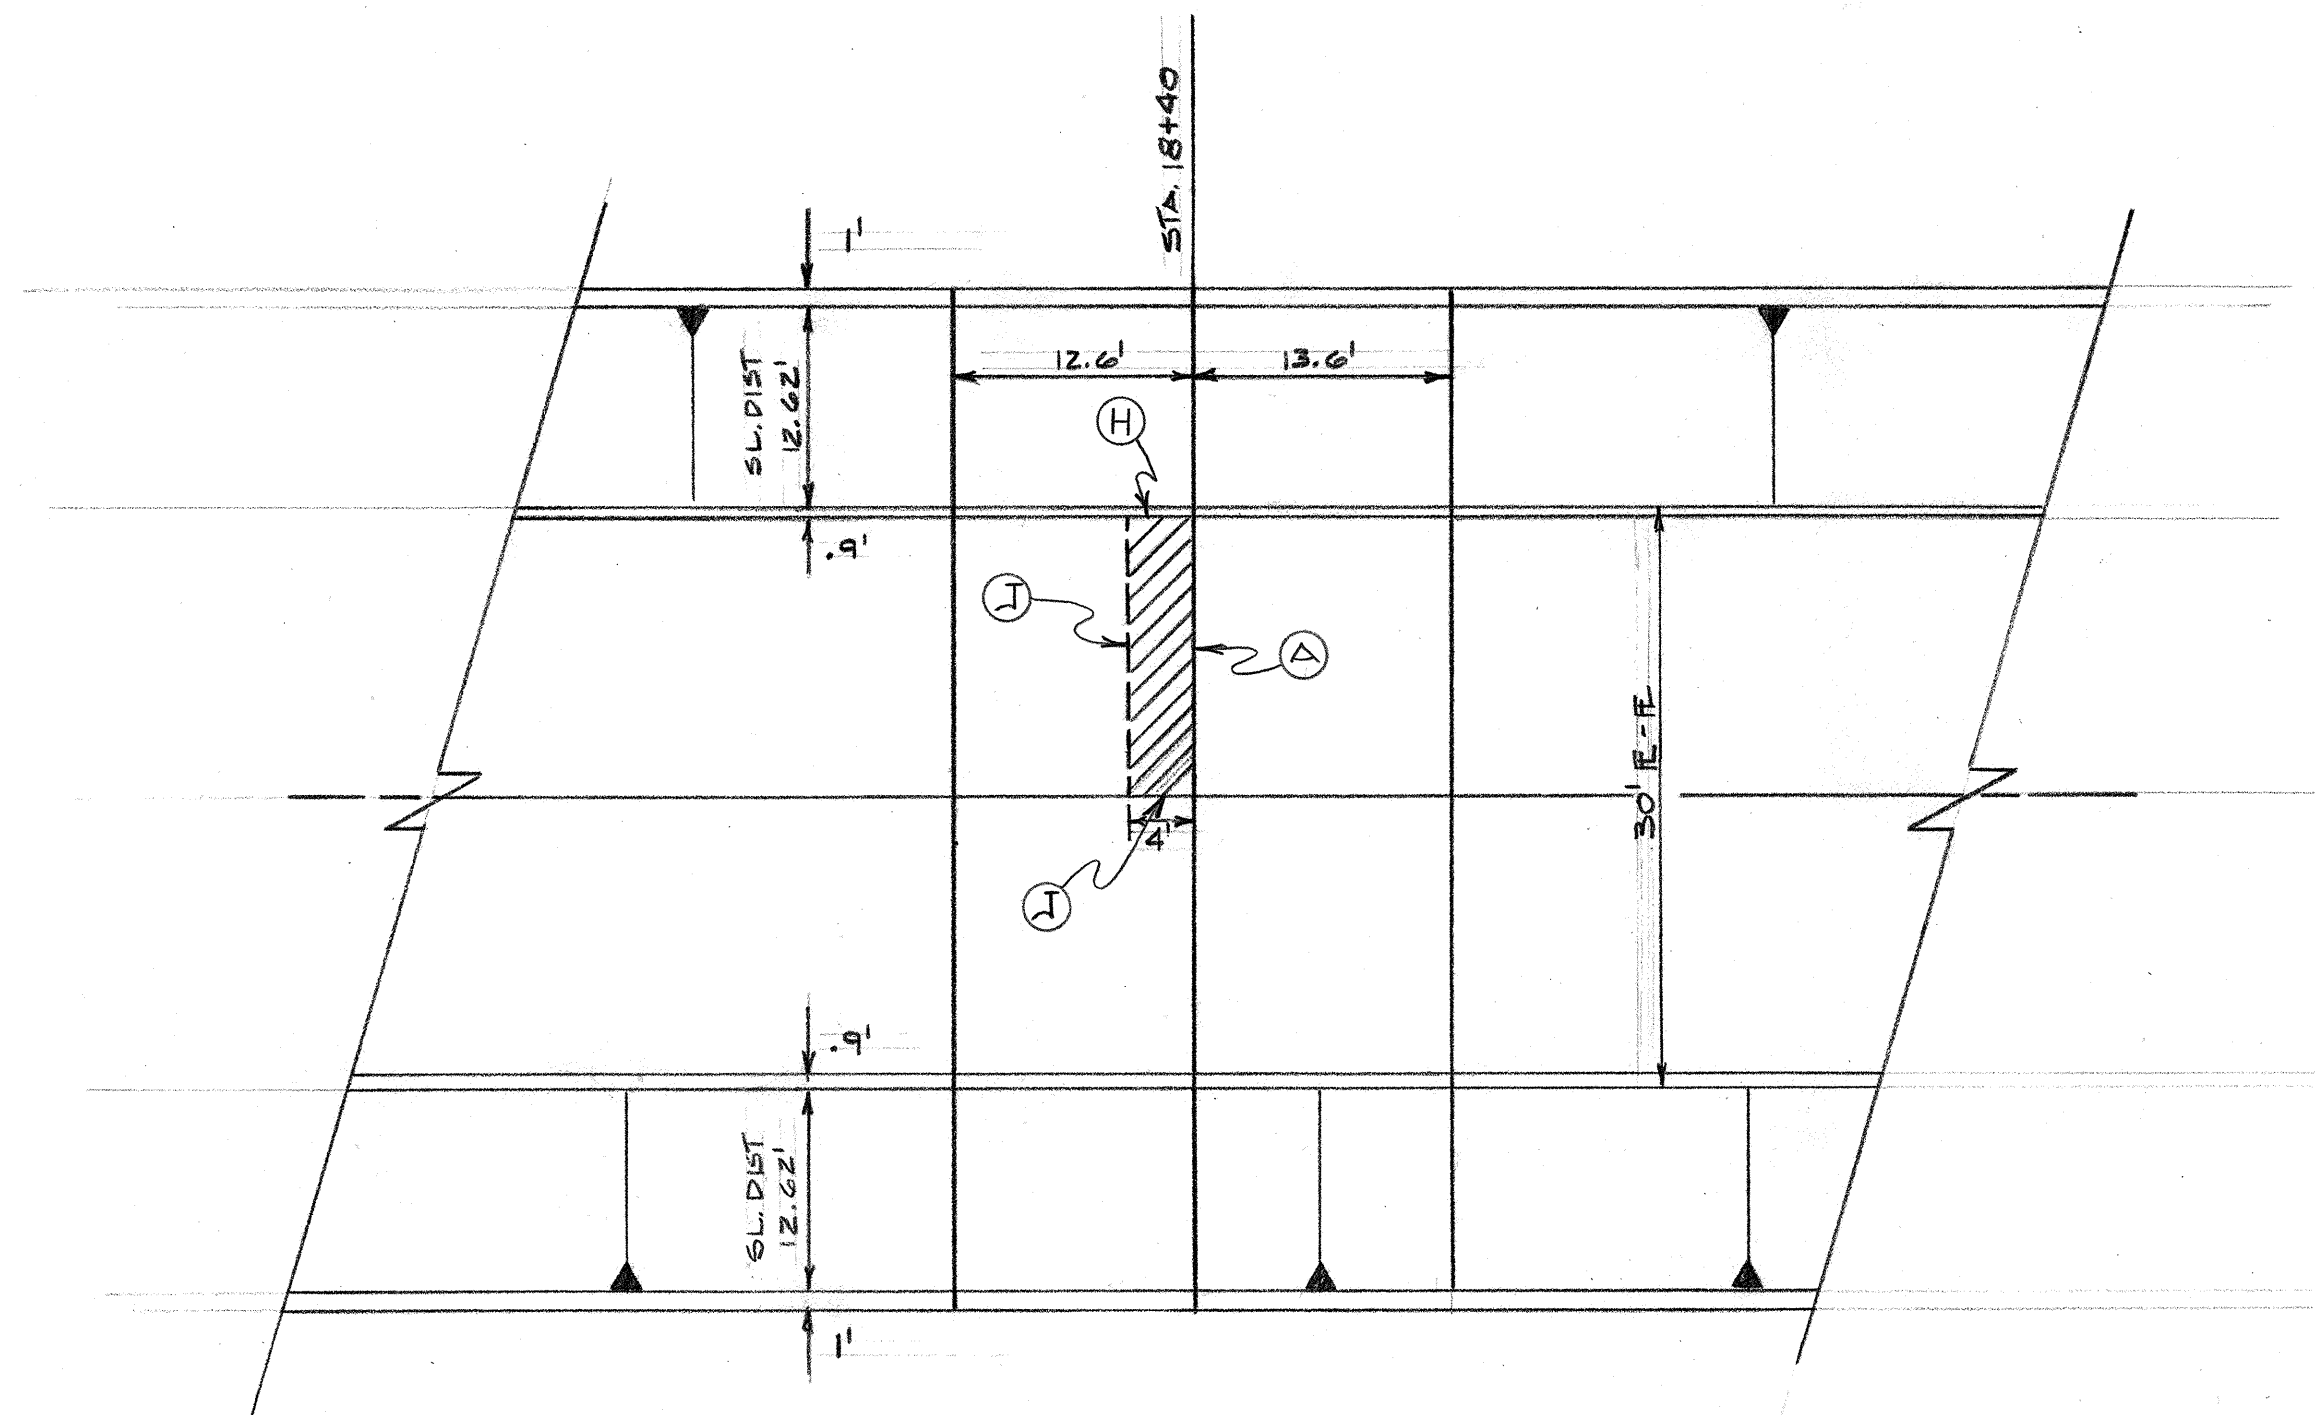


PLAN REPAIR AREA
STATION 18+40

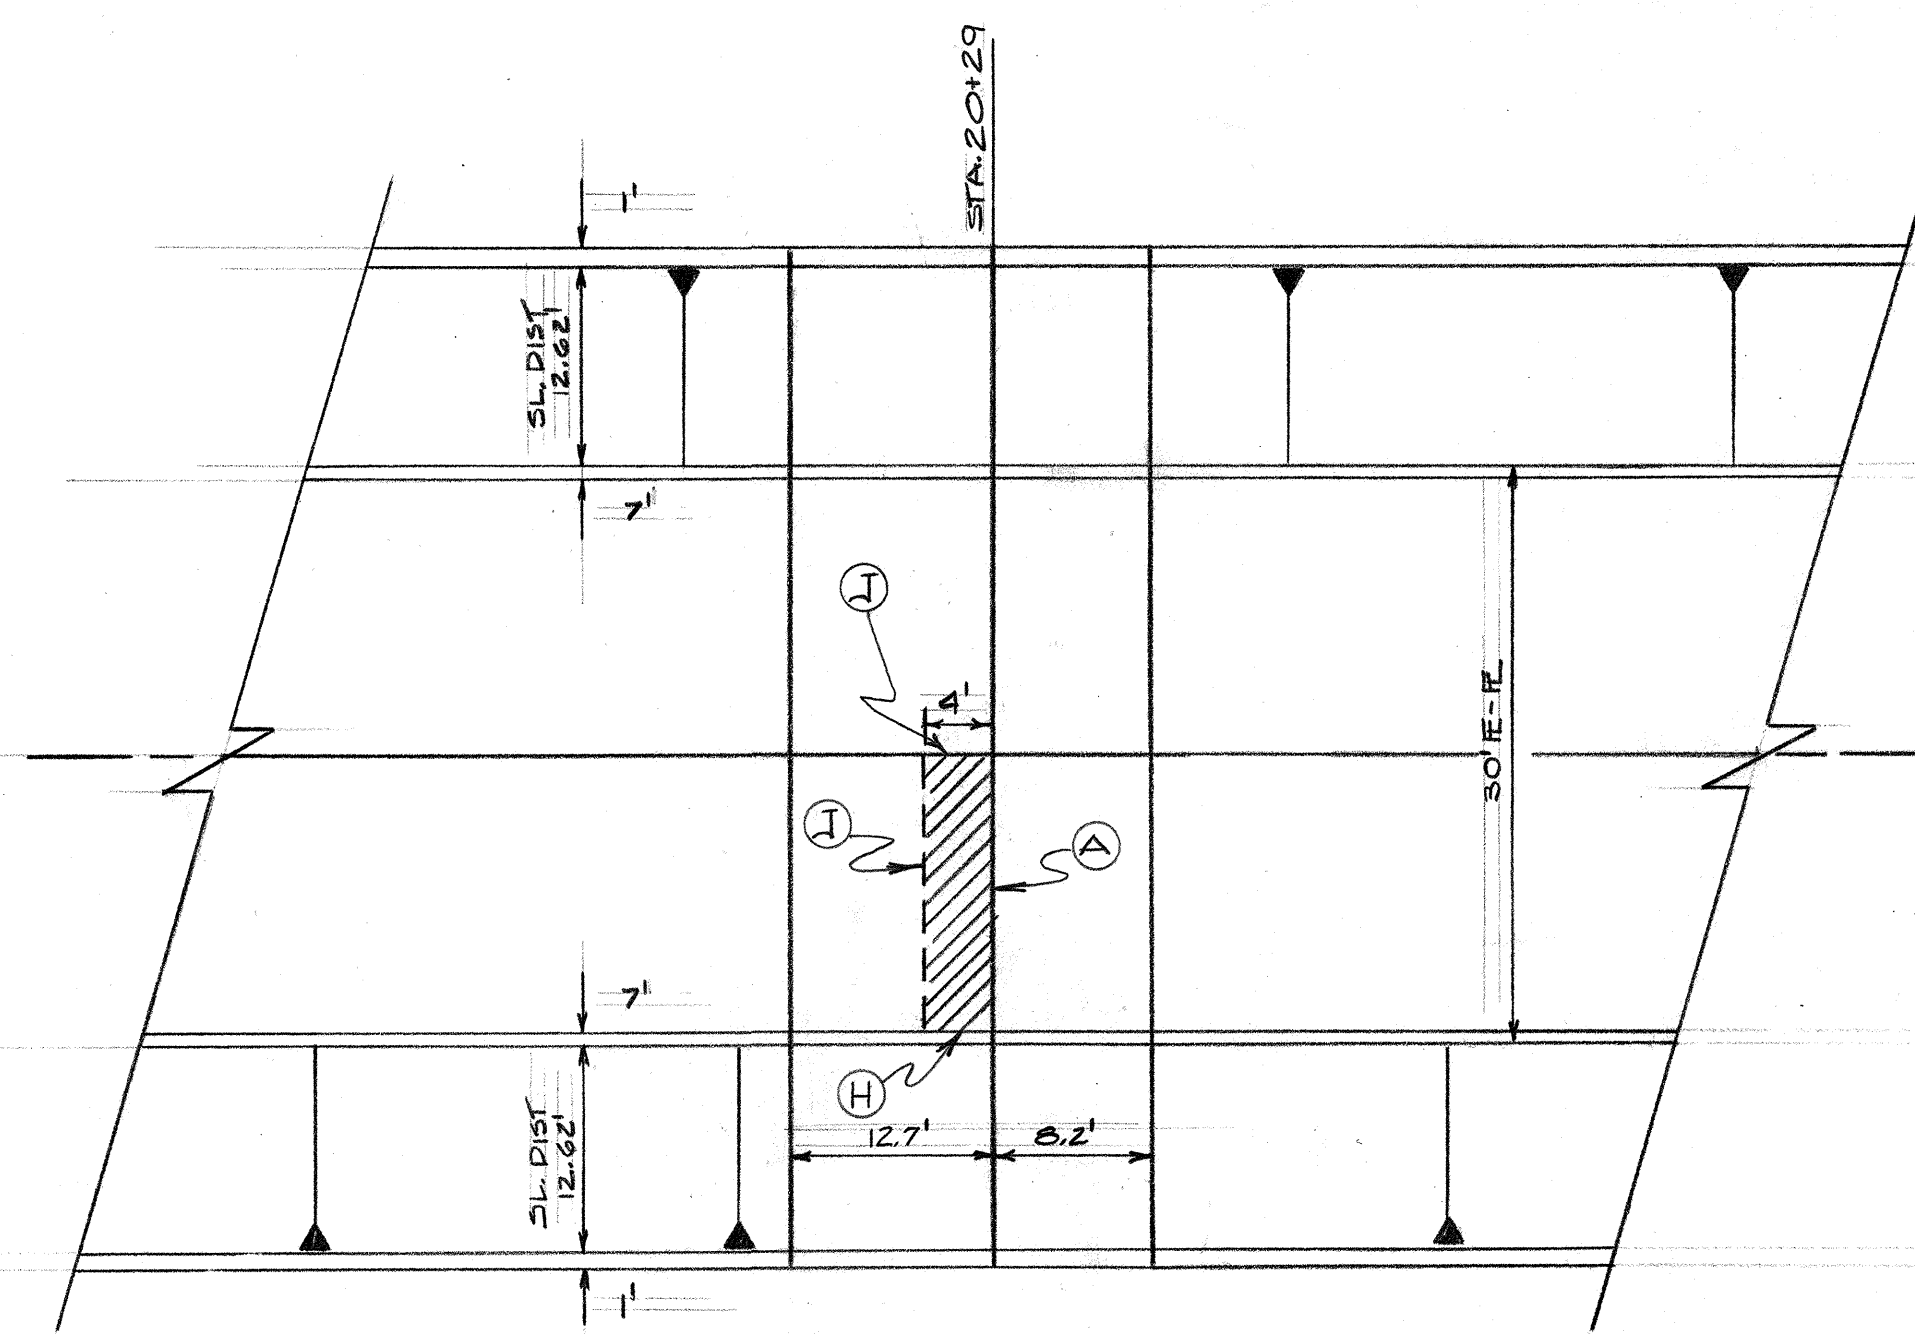

PLAN REPAIR AREA
STATION 20+29

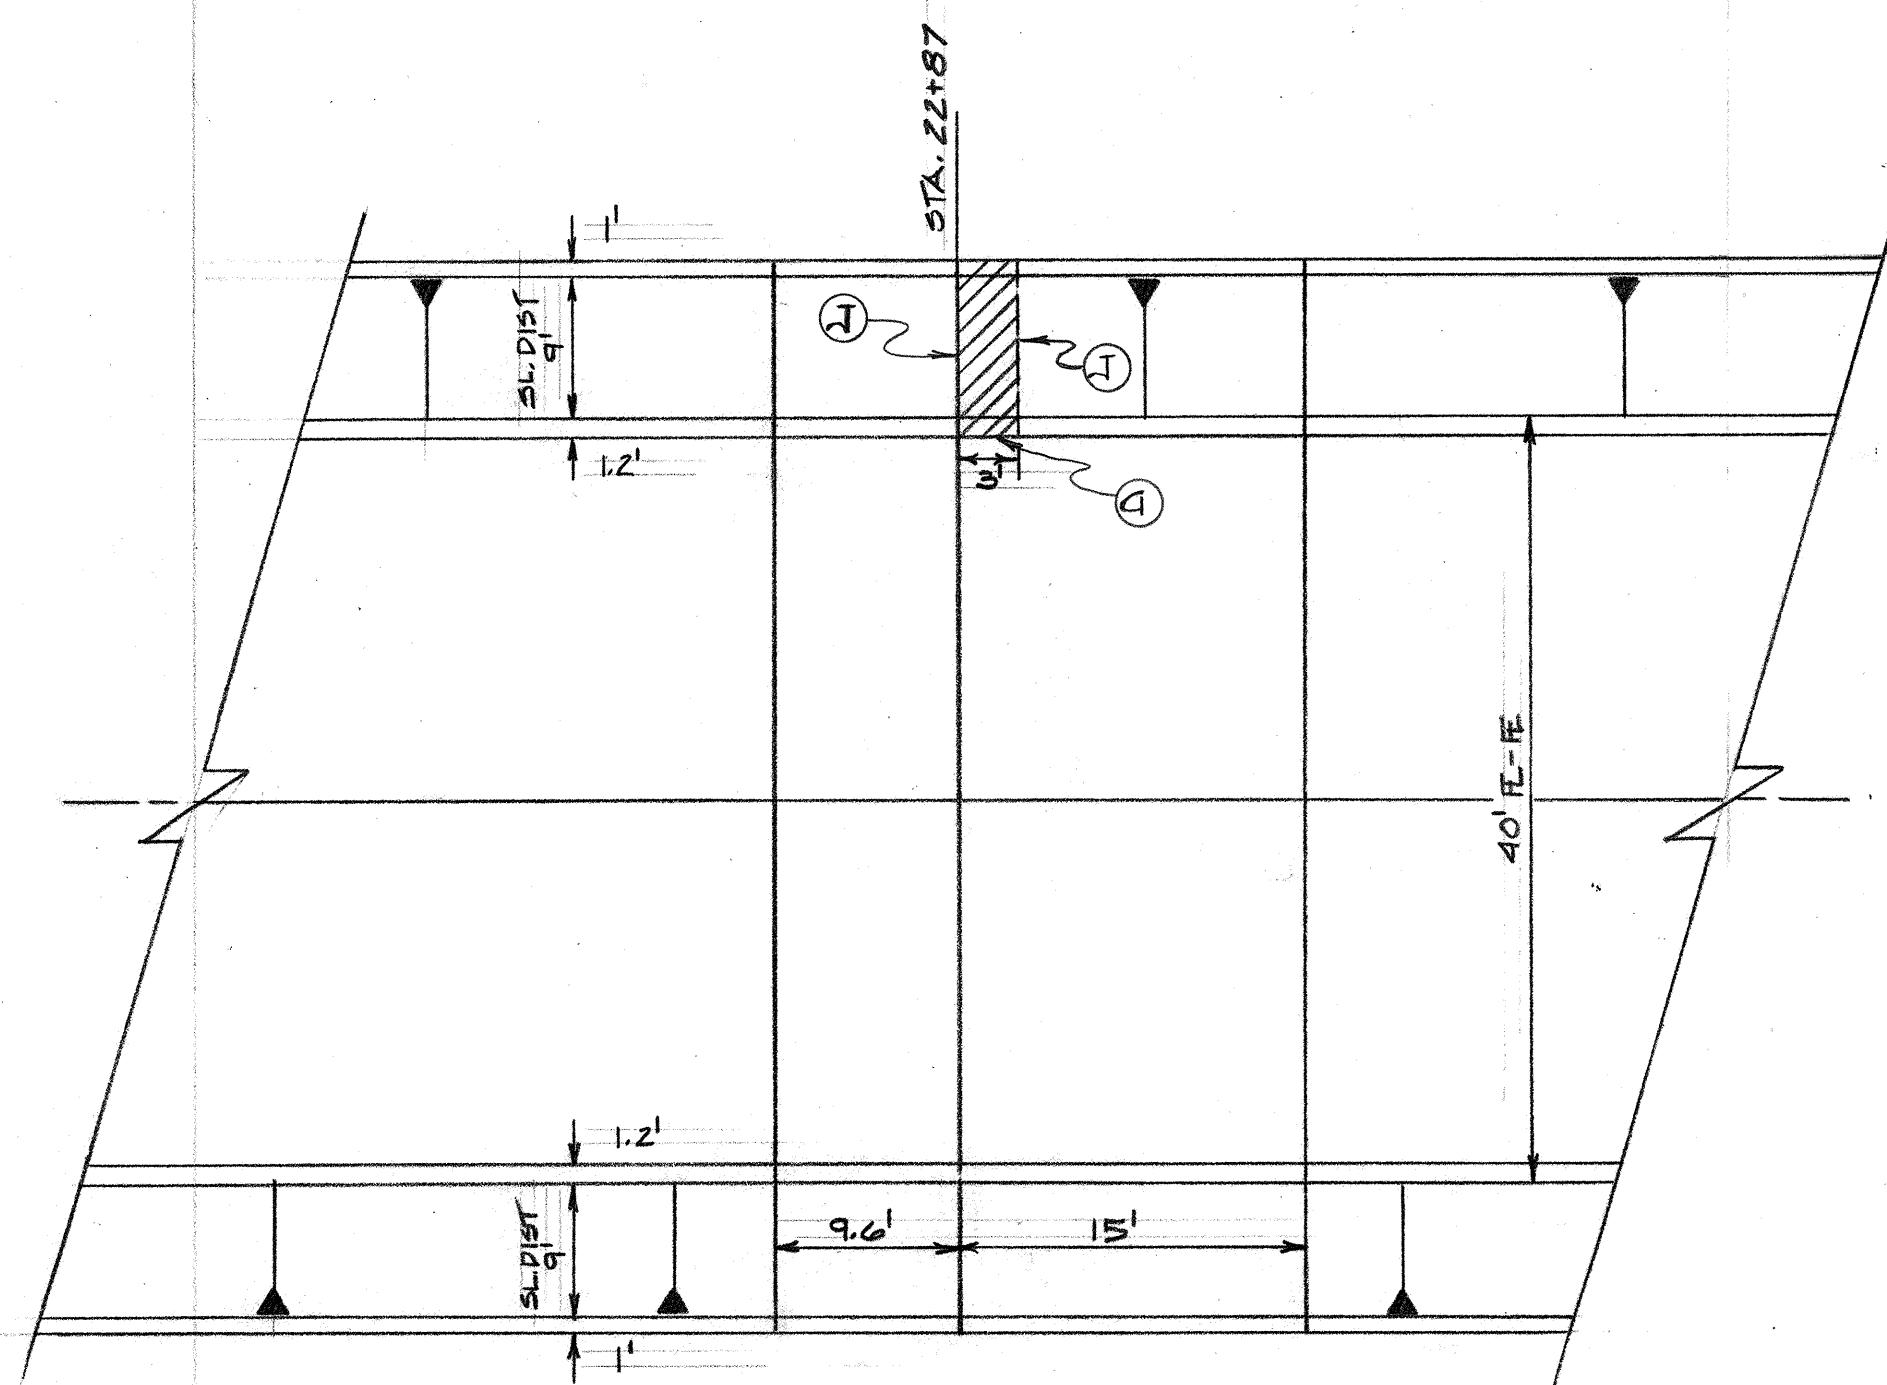

PLAN REPAIR AREA
STATION 22+87

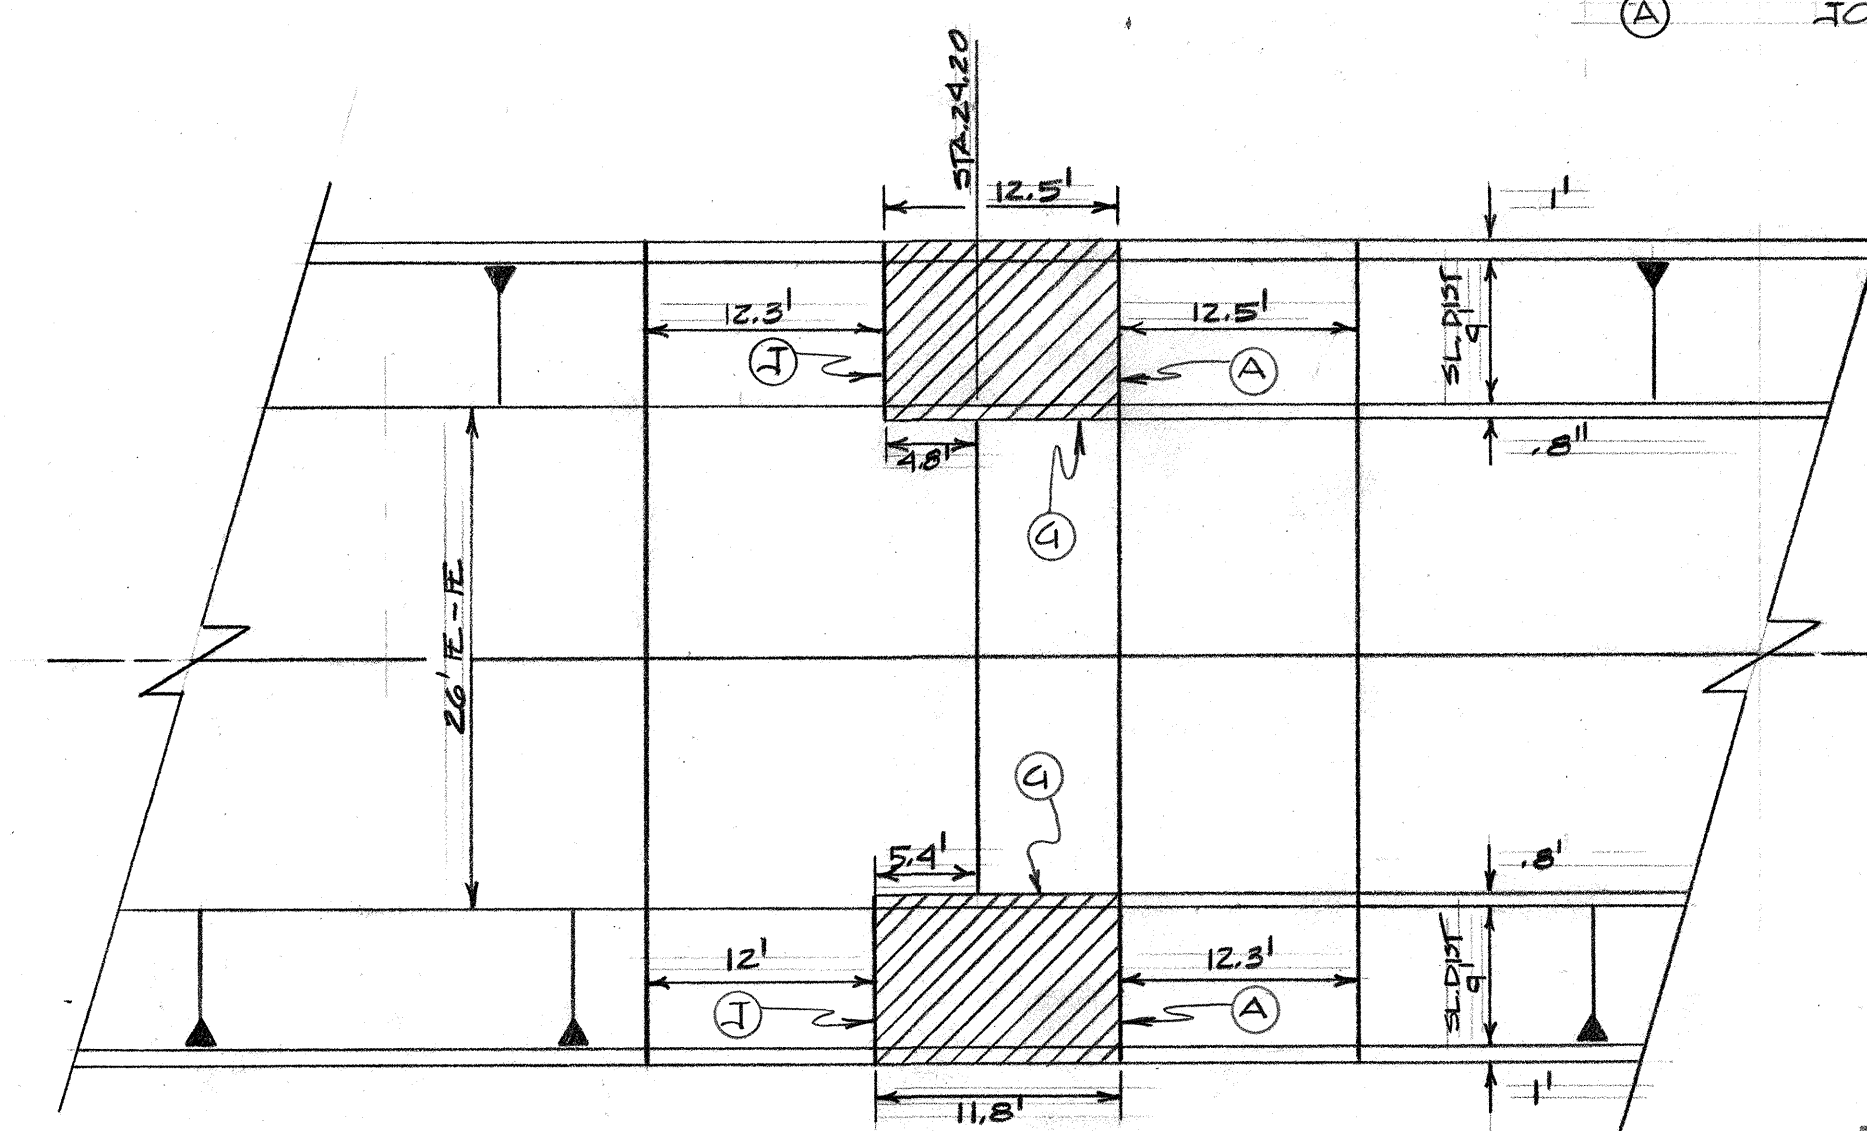

PLAN REPAIR AREA
STATION 24+20

LEGEND:

-  AREA TO BE REMOVE & REPLACED
-  EXISTING SLABS
-  SAW CUT
-  SLOPED LINING JOINT TYPE





1	2	3	4	5	6	7	8	9	10	11	12
20	23	7	0	2	2	9					

APPROVED FOR
CONSTRUCTION
CITY ENGINEER
DATE 6/12/80

CITY OF ALBUQUERQUE PUBLIC WORKS DEPARTMENT ENGINEERING DIVISION					
TITLE: HAHN ARROYO CHANNEL REPAIR PHASE I					
APPROVALS	ENGINEER	DATE	APPROVALS	ENGINEER	DATE
City Engineer	<i>[Signature]</i>	6/12/80	Liquid Waste		
A.C.E.-Design	<i>[Signature]</i>	11/26/80	Traffic		
A.C.E.-Hydrology			Water		
DESIGNED BY SERGIO MIRANDA DATE 5/28/80			DRAWN BY CHAVEZ/J. ZARAGOZA DATE 5/28/80		
DRAWING NO. SD-29-237			SHEET 2 OF 7		

REFERENCES				SURVEY INFORMATION		BENCH MARKS		AS BUILT INFORMATION	
EST. NO.		W/O. NO.		FIELD NOTES				CONTRACTOR	
				NO.	BY	DATE			WORK ORDERED BY
									INSPECTED BY
									ACCEPTANCE BY
				BY					DATE
									FIELD VERIFICATION BY
									DRAWINGS
									CORRECTED BY
									DATE
									MICRO-FILM INFORMATION
									RECORDED BY
									DATE
									NO.

2D-50-531

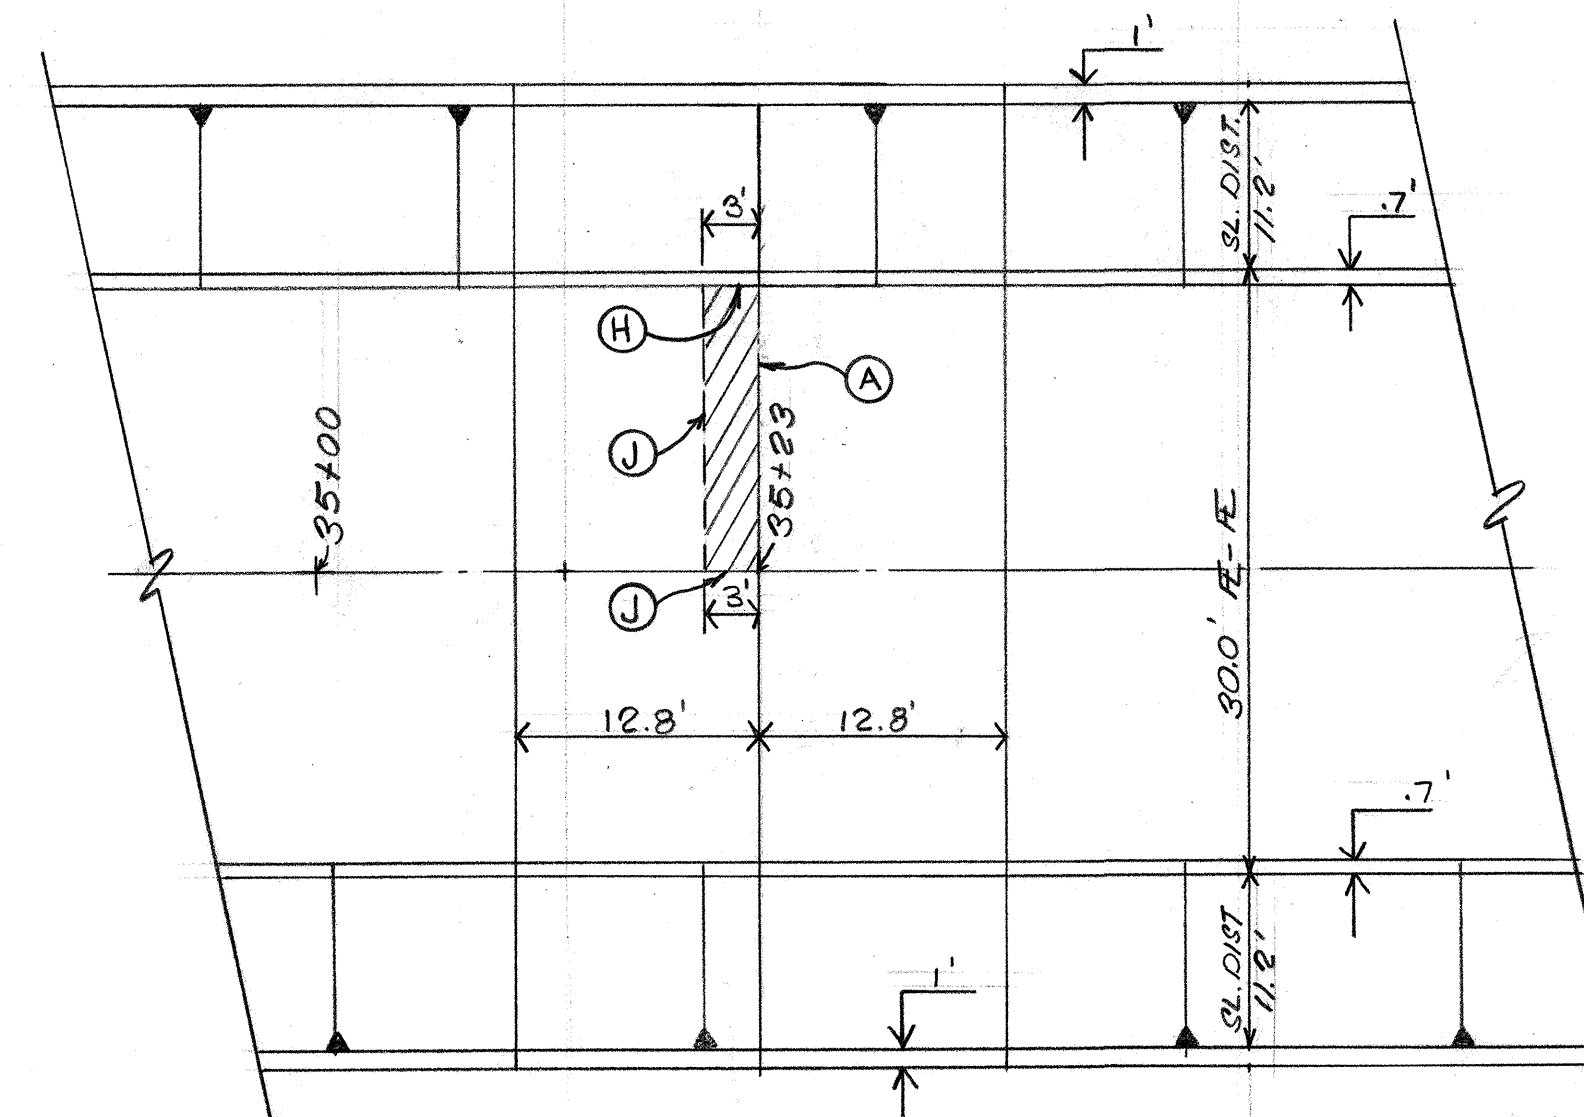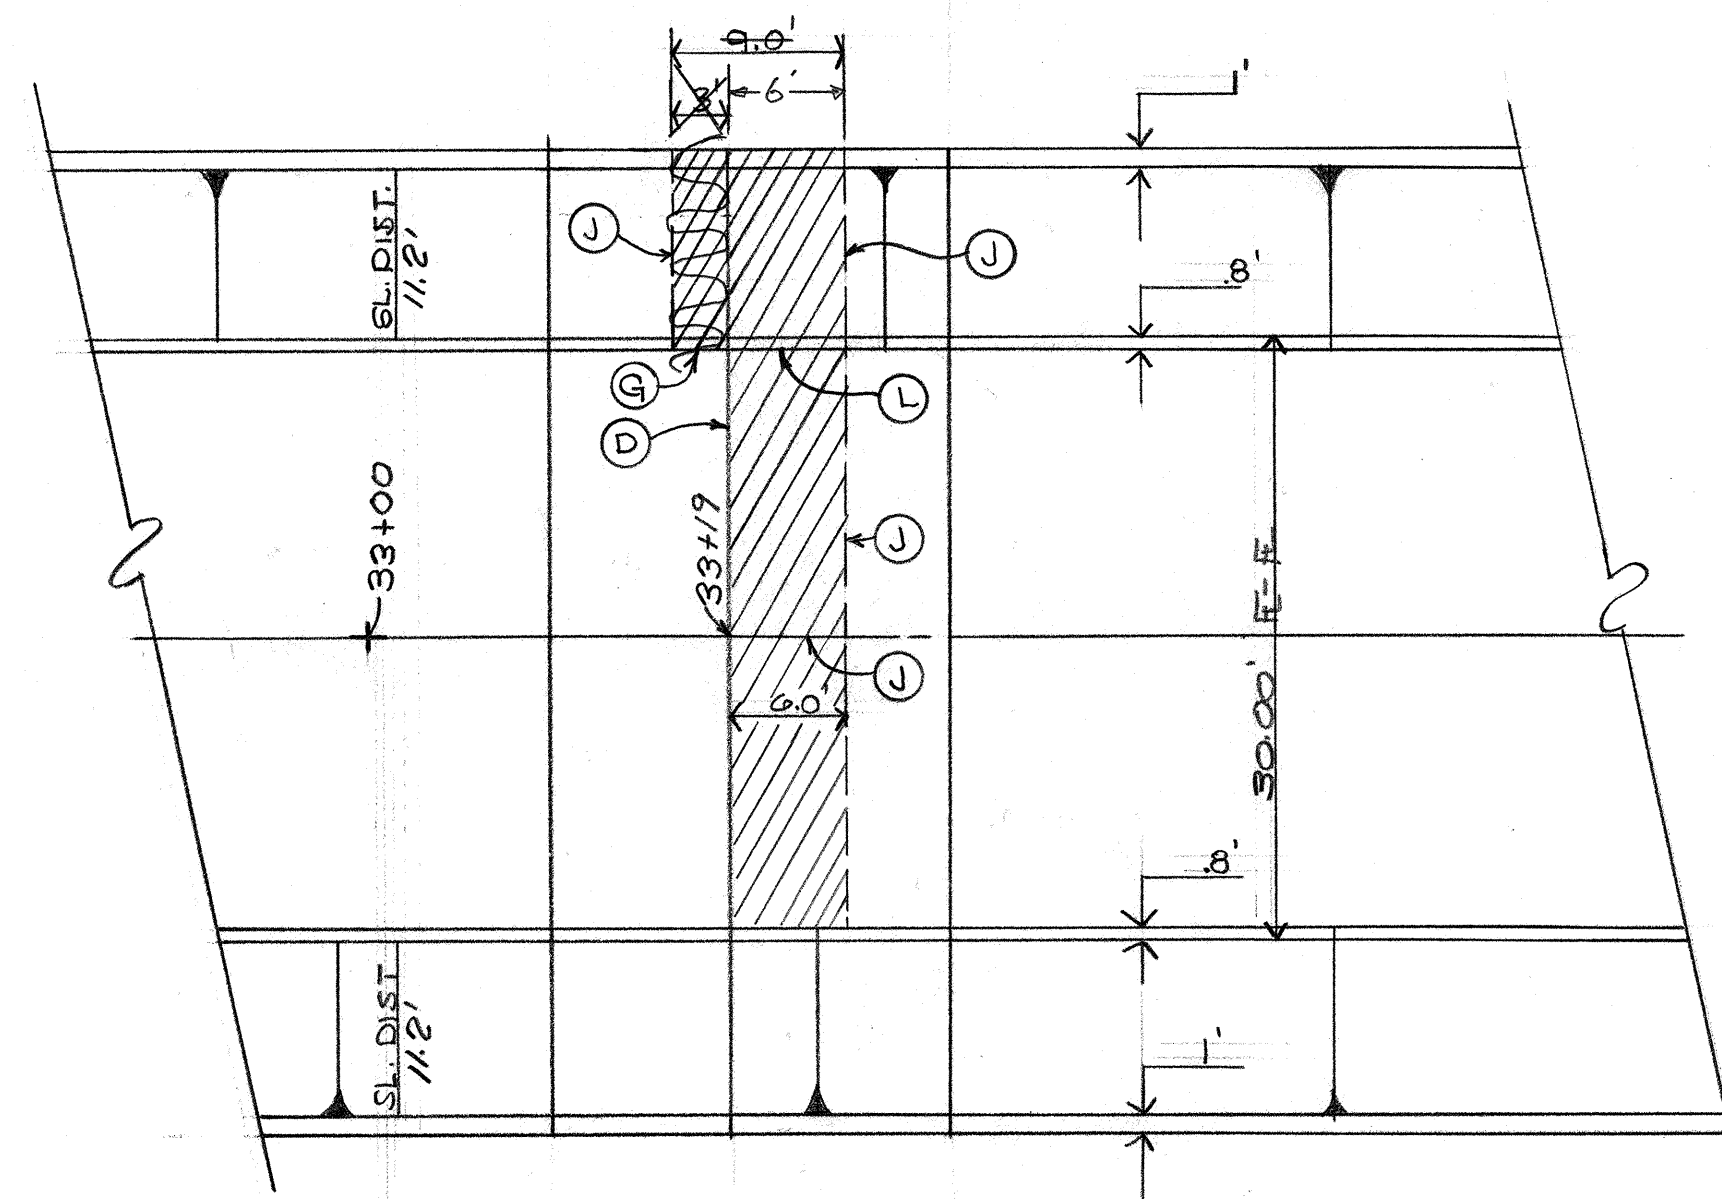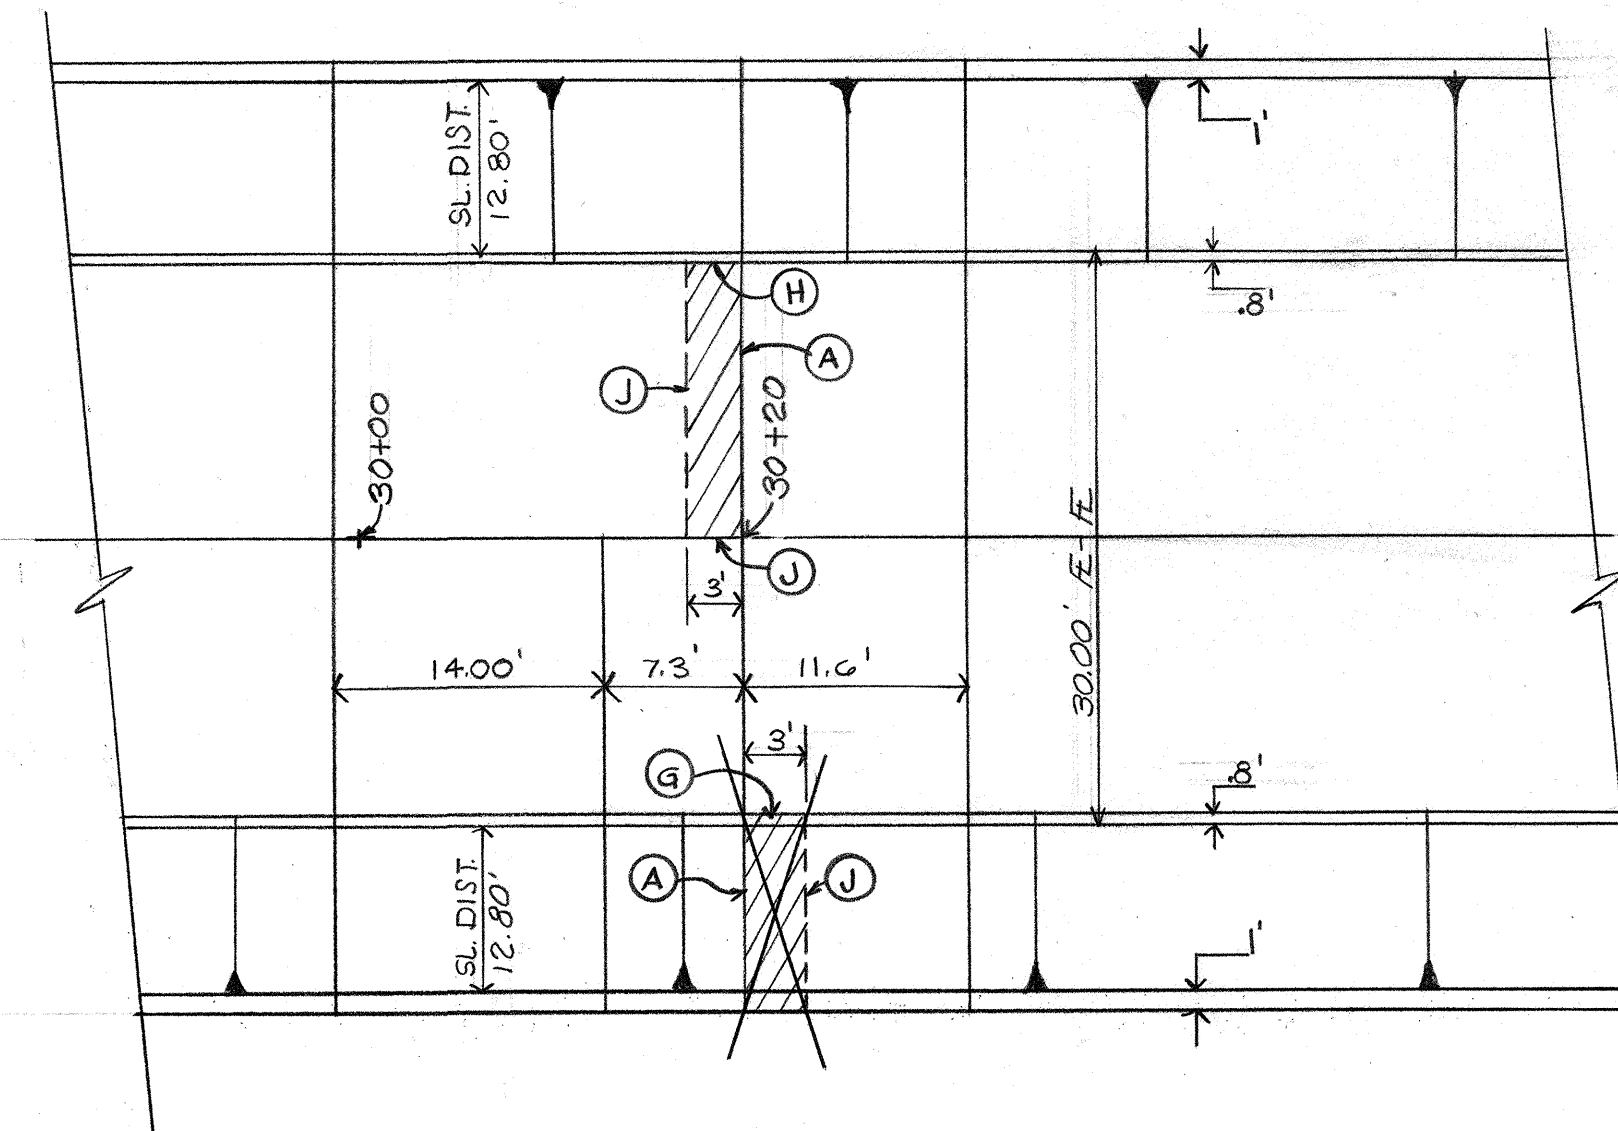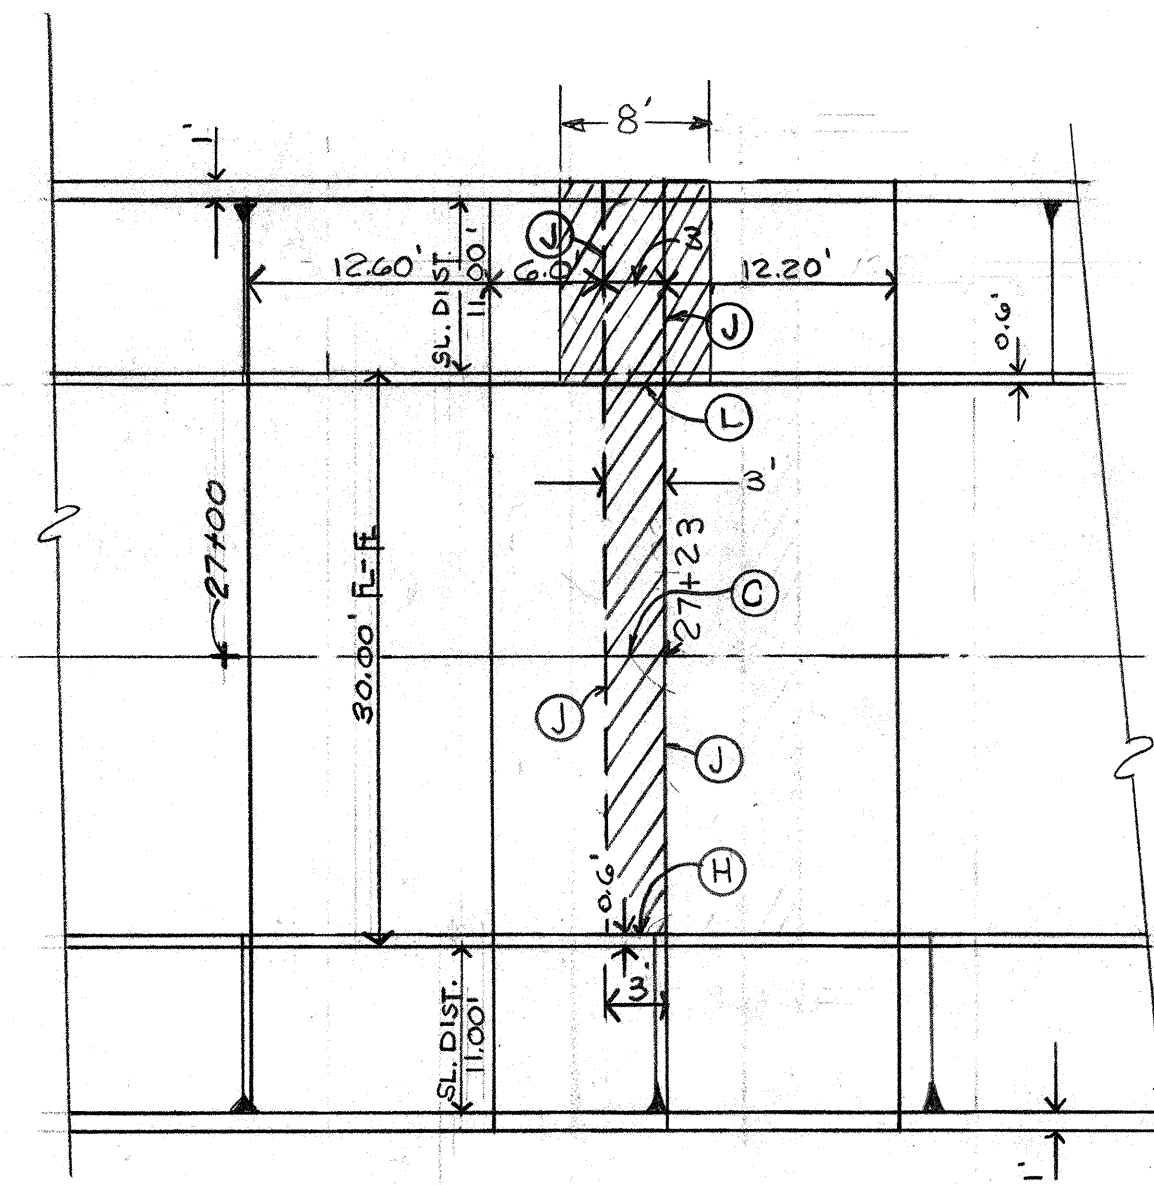

LEGEND

 AREA TO BE REMOVE & REPLACE

☐ EXISTING SLAB

----- SAW CUT







→ SLOPED LINING

① JOINT TYPE

1	2	3	4	5	6	7	8	9	10	11	12
2	0		2	3	7		0	3	2	9	

APPROVED FOR
CONSTRUCTION
RSN 6/12/80
CITY ENGINEER DATE

CITY OF ALBUQUERQUE PUBLIC WORKS DEPARTMENT ENGINEERING DIVISION					
TITLE: HAHN ARROYO CHANNEL REPAIR PHASE I					
APPROVALS	ENGINEER	DATE	APPROVALS	ENGINEER	DATE
City Engineer	<i>[Signature]</i>	<i>6/12/80</i>	Liquid Waste		
A.C.E.'s Design	<i>[Signature]</i>	<i>11/16/80</i>	Traffic		
A.C.E.'s Hydrology	<i>[Signature]</i>		Water		
DRAWING NO. SD-209-237			SHEET 3 OF 7		

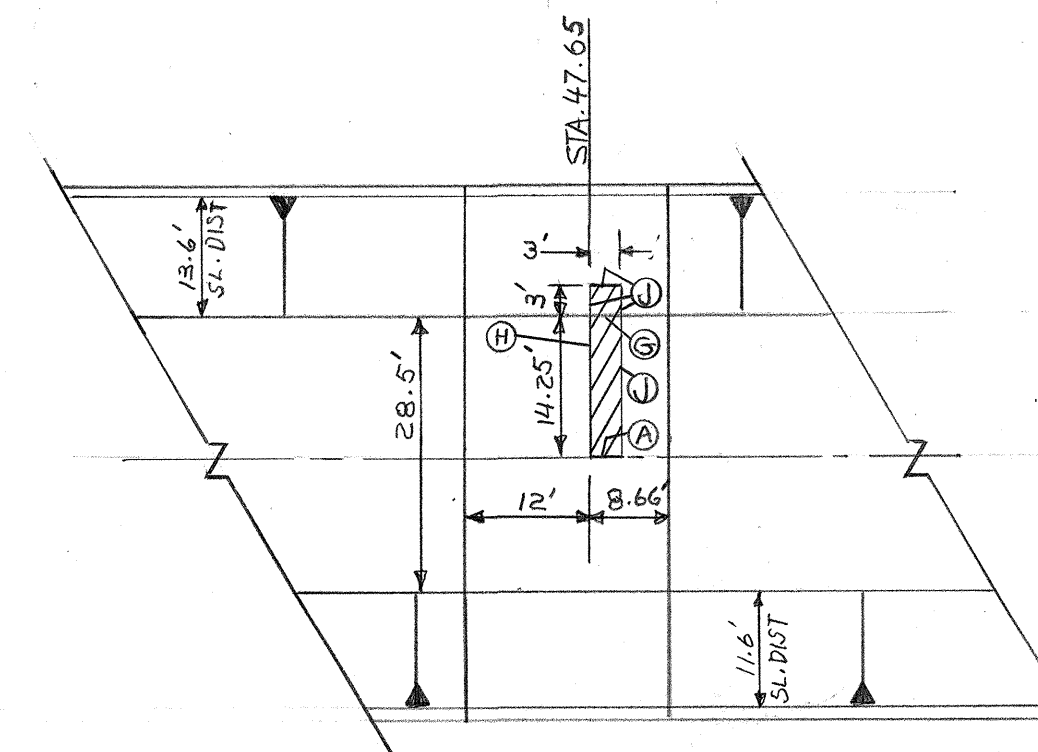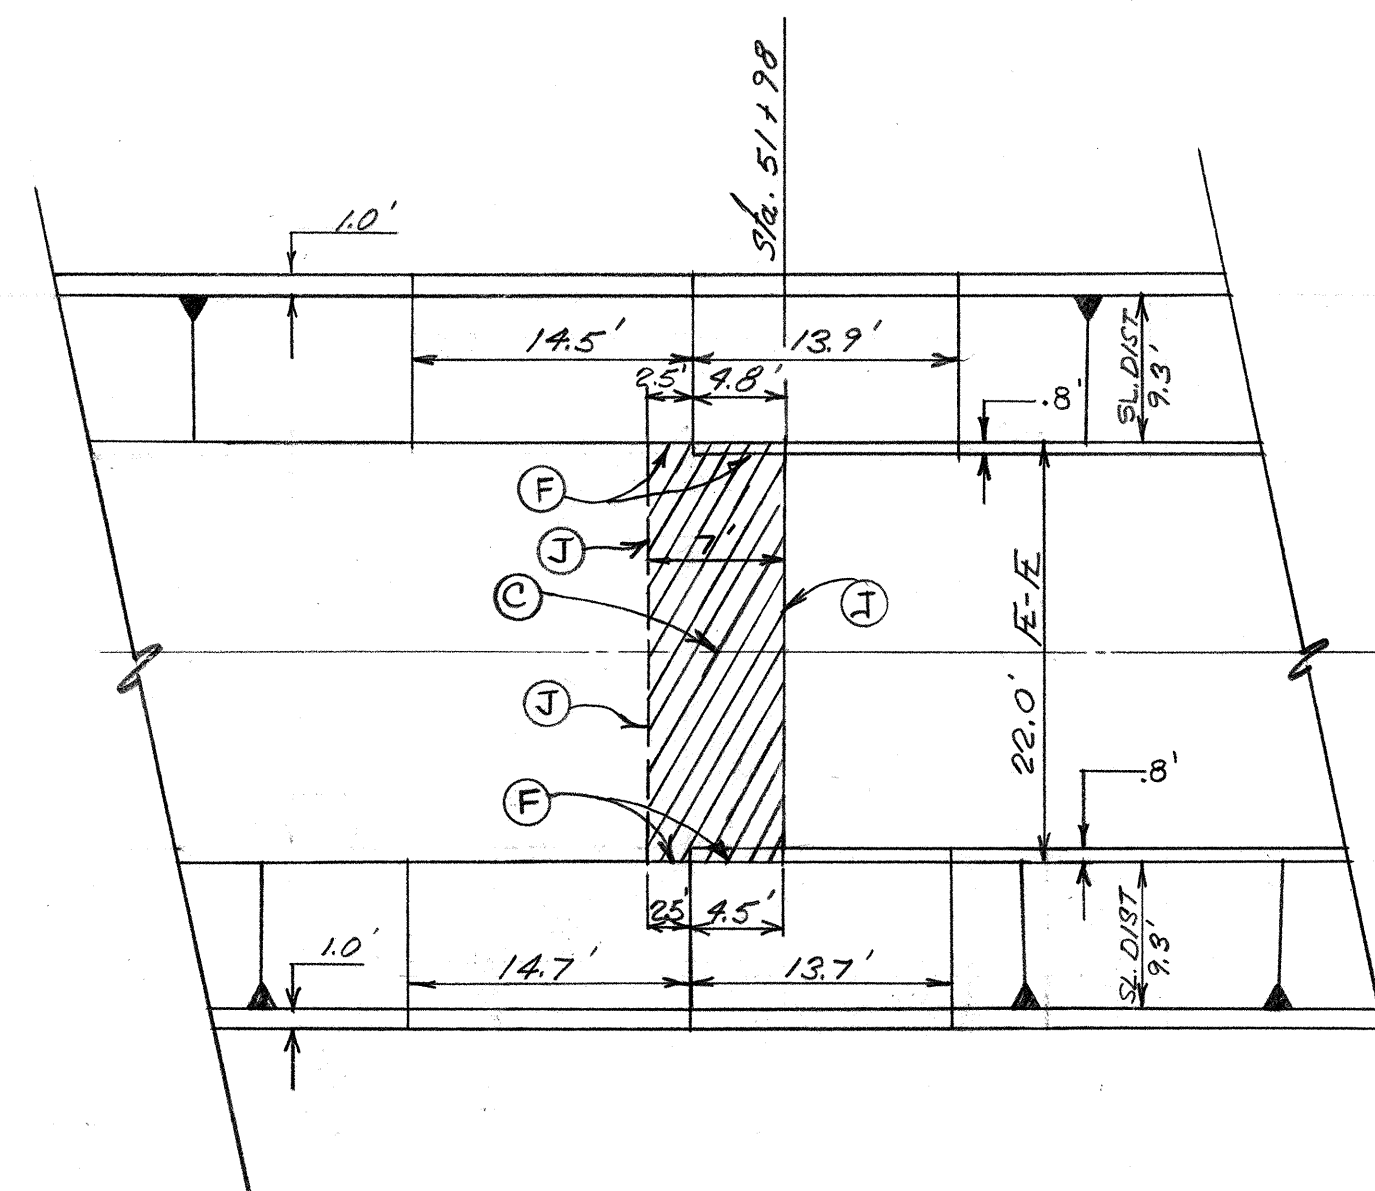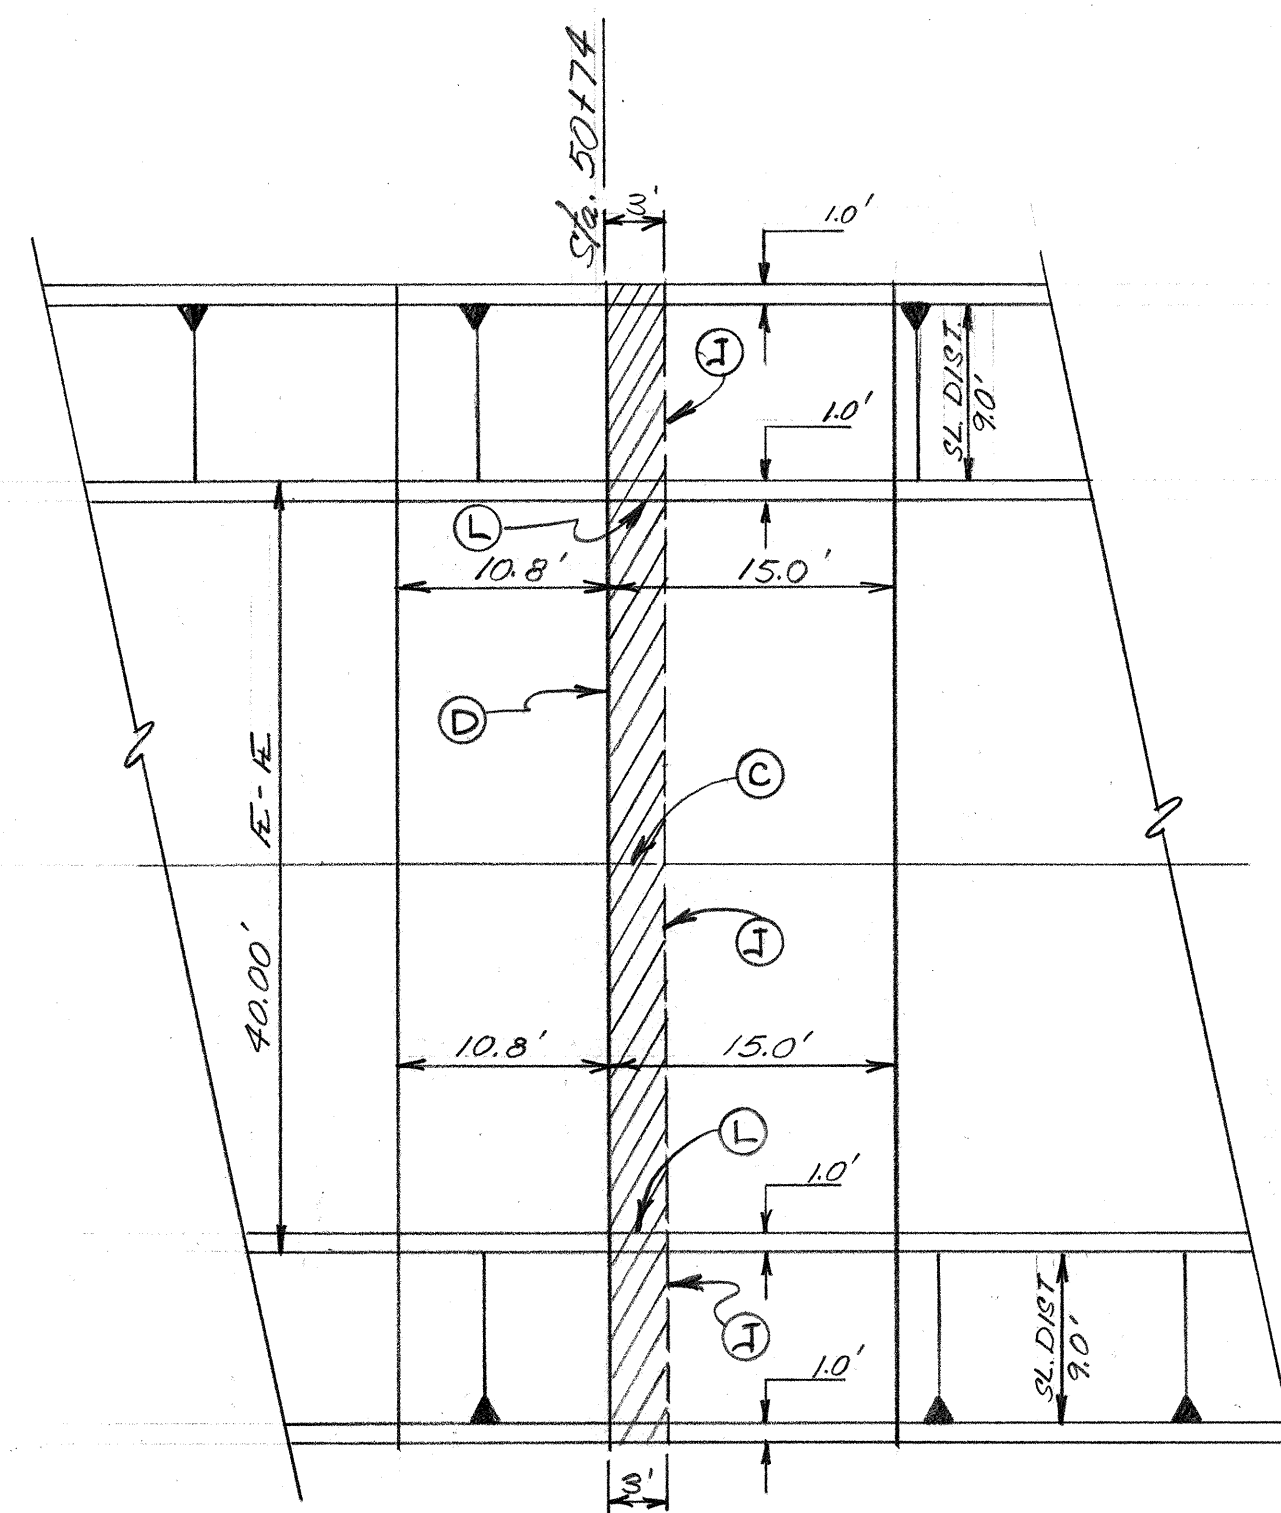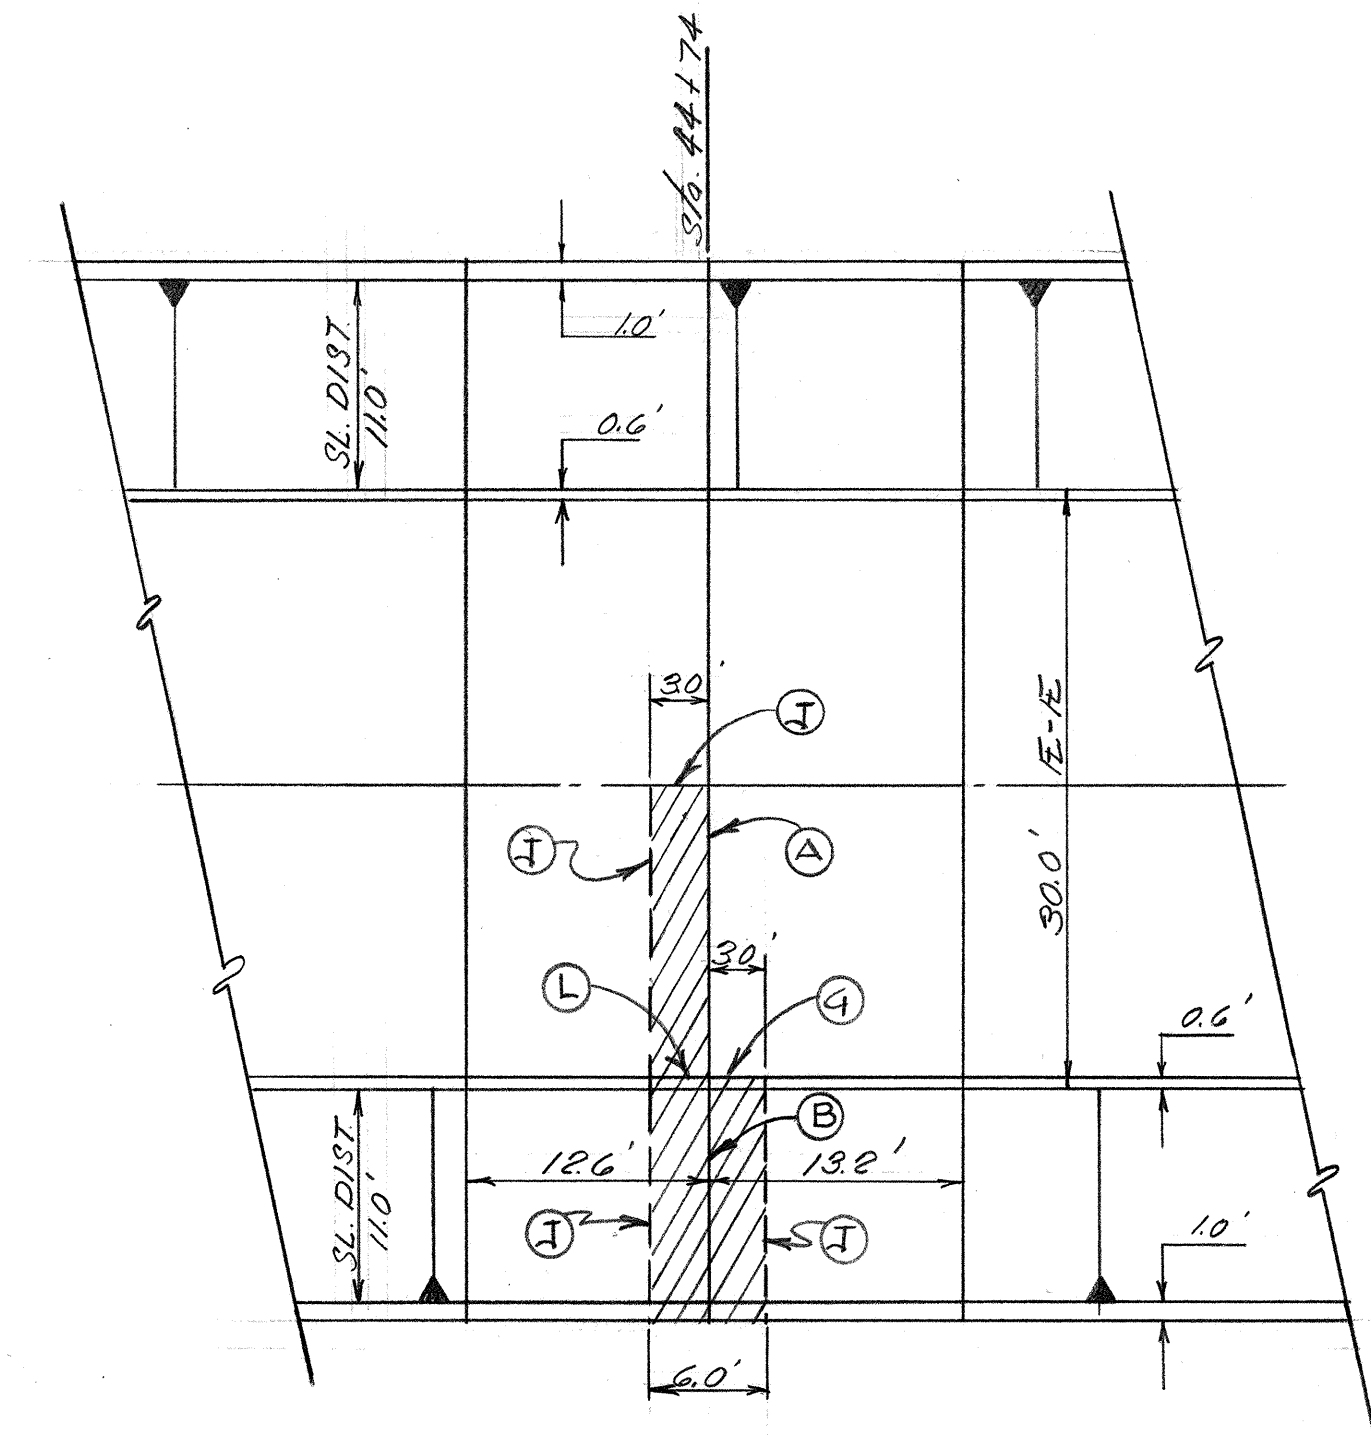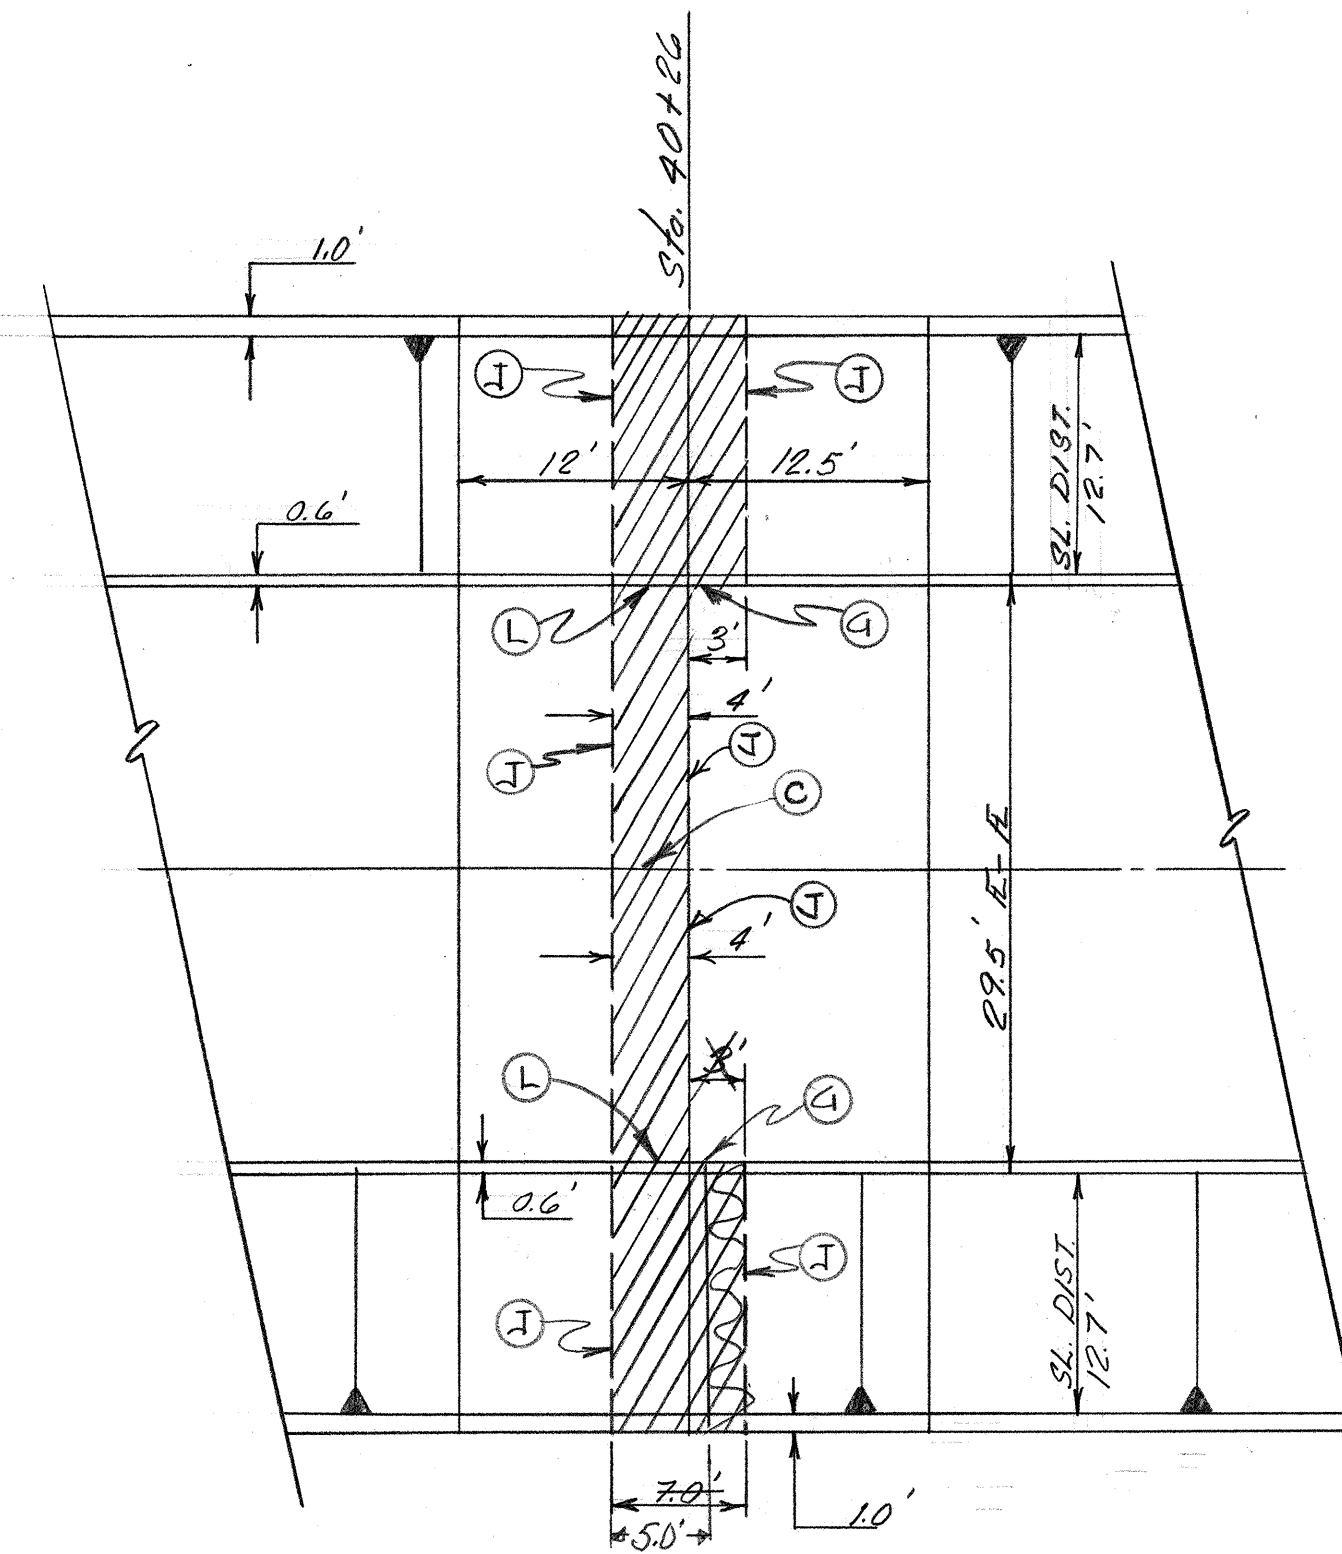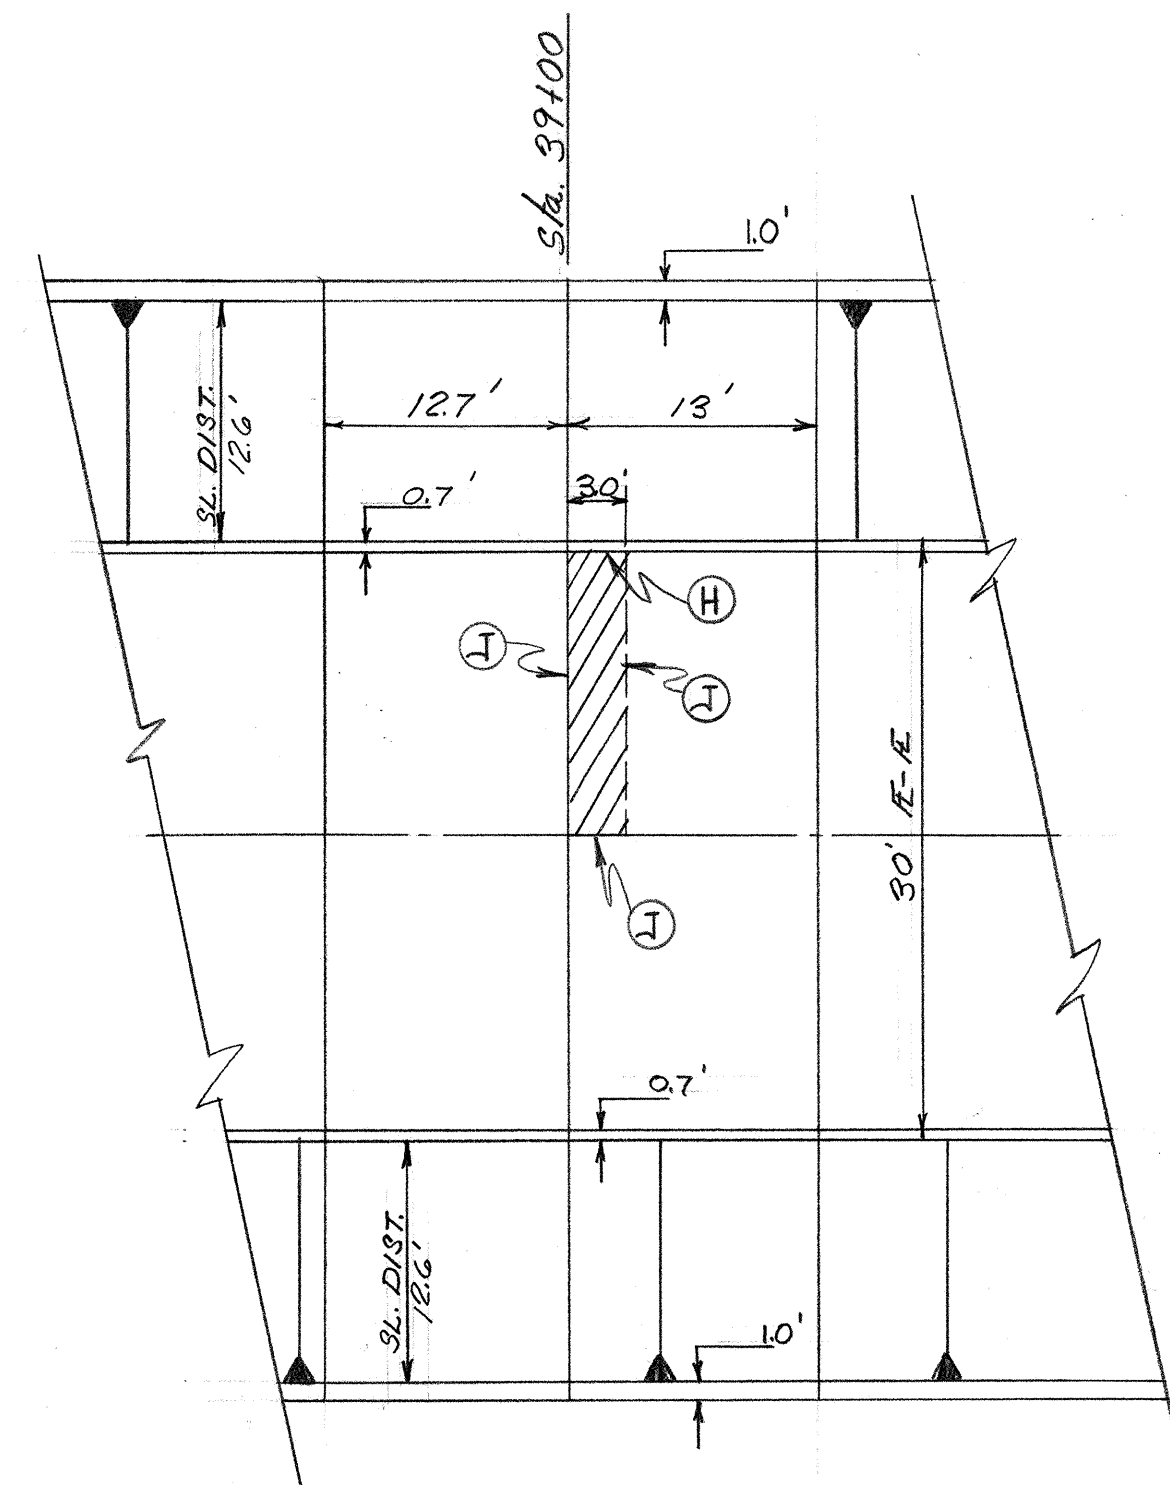

LEGEND

AREA TO BE REMOVE & REPLACE

EXISTING SLABS


SAW CUT

SLOPED LINING JOINT TYPE

1	2	3	4	5	6	7	8	9	10	11	12
2	0		2	3	7		0	4	2	9	

APPROVED FOR
CONSTRUCTION
R. S. Allen 6/12/80
CITY ENGINEER DATE

CITY OF ALBUQUERQUE PUBLIC WORKS DEPARTMENT ENGINEERING DIVISION					
TITLE:					
HAHN ARROYO CHANNEL REPAIR PHASE I					
APPROVALS	ENGINEER	DATE	APPROVALS	ENGINEER	DATE
City Engineer	<i>[Signature]</i>	6/17/80	Liquid Waste		
A.C.E. - Design	<i>[Signature]</i>	11 Jun 80	Traffic		
A.C.E. - Hydrology			Water		
DRAWING NO. SD - 20 - 237			SHEET 4 OF 7		

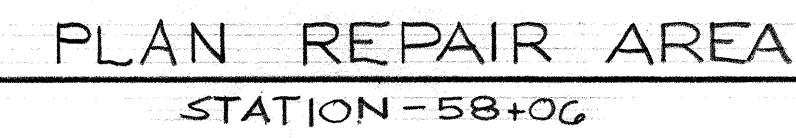

LEGEND


-
- Diagram illustrating the components of a concrete slab joint:
- AREA TO BE REMOVE & REPLACE
 - EXISTING SLABS
 - SAW CUT
 - SLOPED LINING
 - (A) JOINT TYPE

1	2	3	4	5	6	7	8	9	10	11	12
2	0		2	3	7		0	5	2	9	


APPROVED FOR
CONSTRUCTION
RSA 6/12/00
CITY ENGINEER DATE

CITY OF ALBUQUERQUE PUBLIC WORKS DEPARTMENT ENGINEERING DIVISION					
TITLE:					
HAHN ARROYO CHANNEL REPAIR PHASE I					
APPROVALS	ENGINEER	DATE	APPROVALS	ENGINEER	DATE
City Engineer	<i>RSSD</i>	6/12/80	Liquid Waste		
A.C.E.'s Design	<i>JKH</i>	11 Jun 80	Traffic		
A.C.E.'s Hydrology			Water		
DRAWING NO.			SHEET 5 OF 7		
SD - 20 - 237					


REFERENCES				SURVEY INFORMATION		BENCH MARKS	AS BUILT INFORMATION
EST. NO.	MAP NO.	W.O. NO.	NO.	FIELD NOTES	BY		
							CONTRACTOR
							WORK COMPLETED BY
							INSPECTOR'S
							ACCEPTANCE BY
							DATE
							FIELD INVESTIGATION BY
							DRAWINGS
							CORRECTED BY
							DATE
REVISIONS				MICRO-FILM INFORMATION			
				RECORDED BY			
DESIGNED BY S. MIRAN				NO.			
DATE 5-30-80							
DRAWN BY J. ZARAGOZA							
DATE 5-30-80							
CHECKED BY							
DATE							

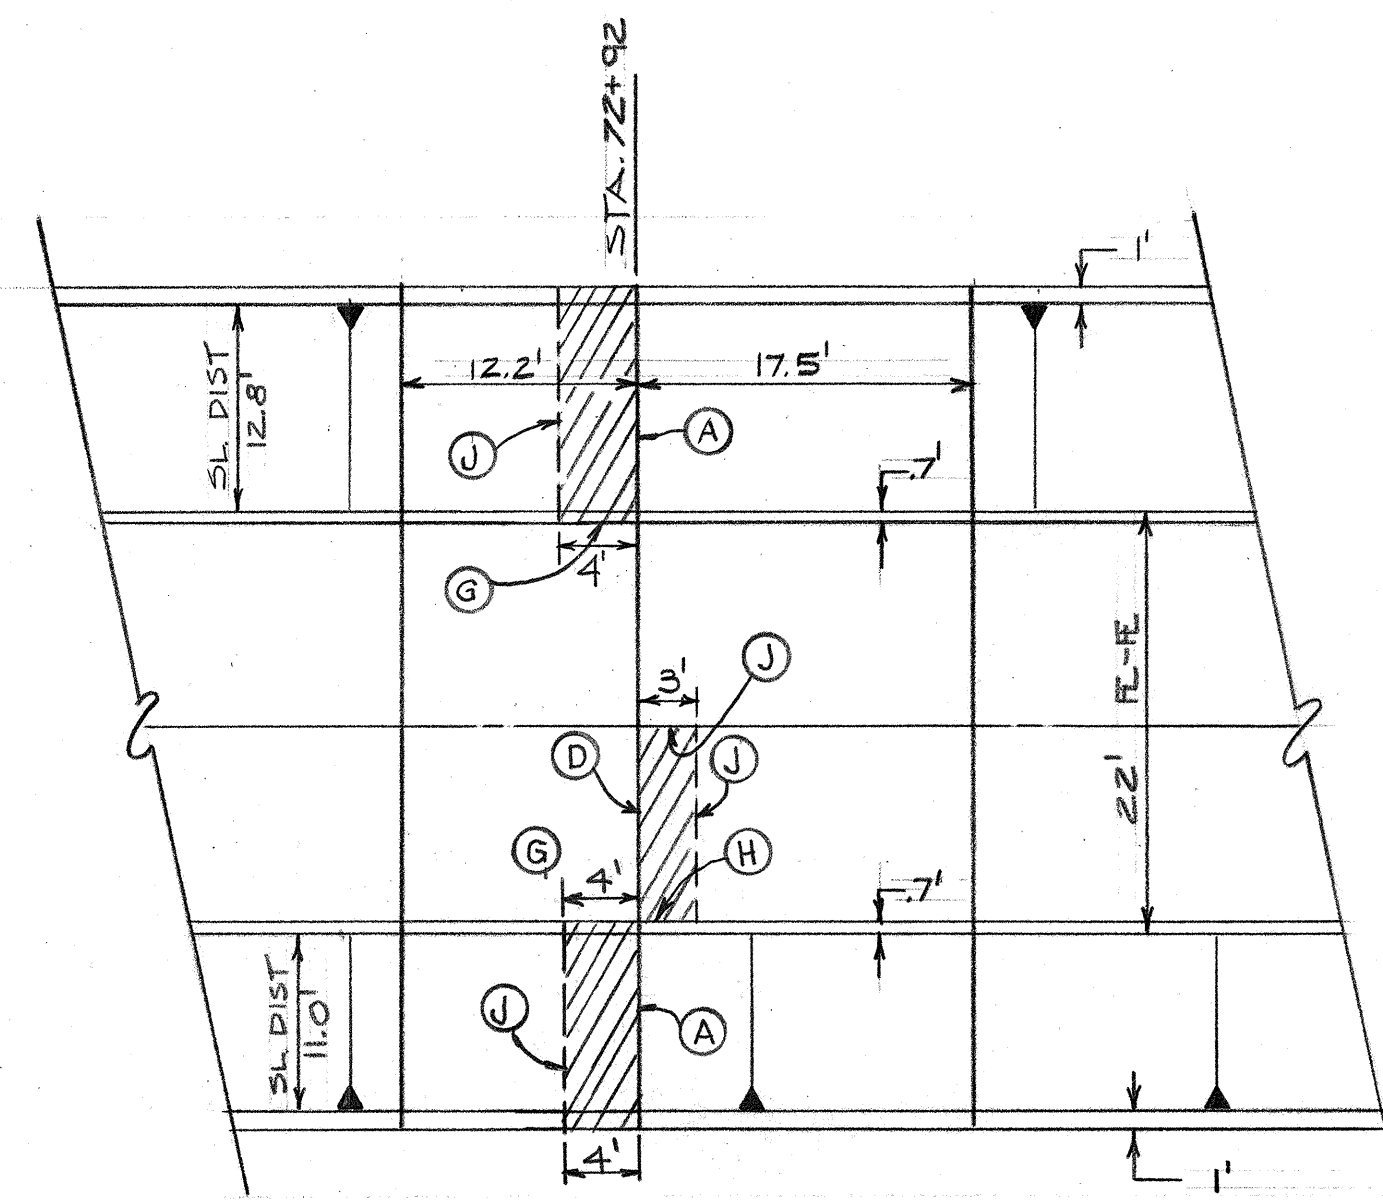


PLAN REPAIR AREA
STATION 72+92

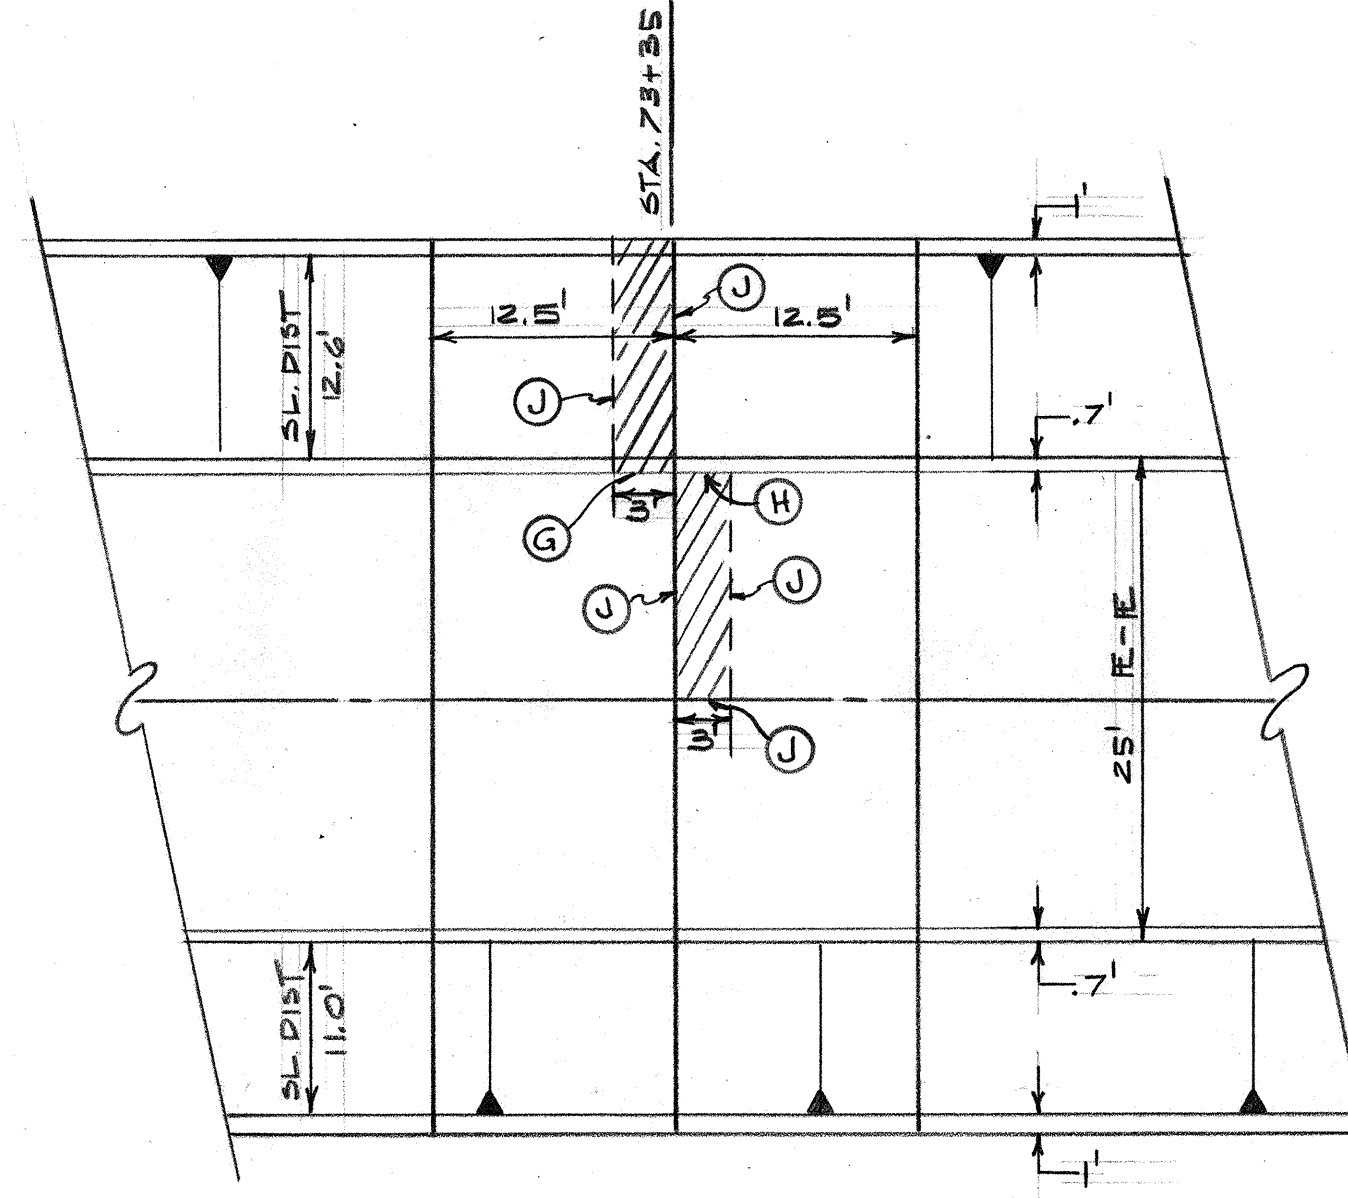


PLAN REPAIR AREA
SECTION 73+35

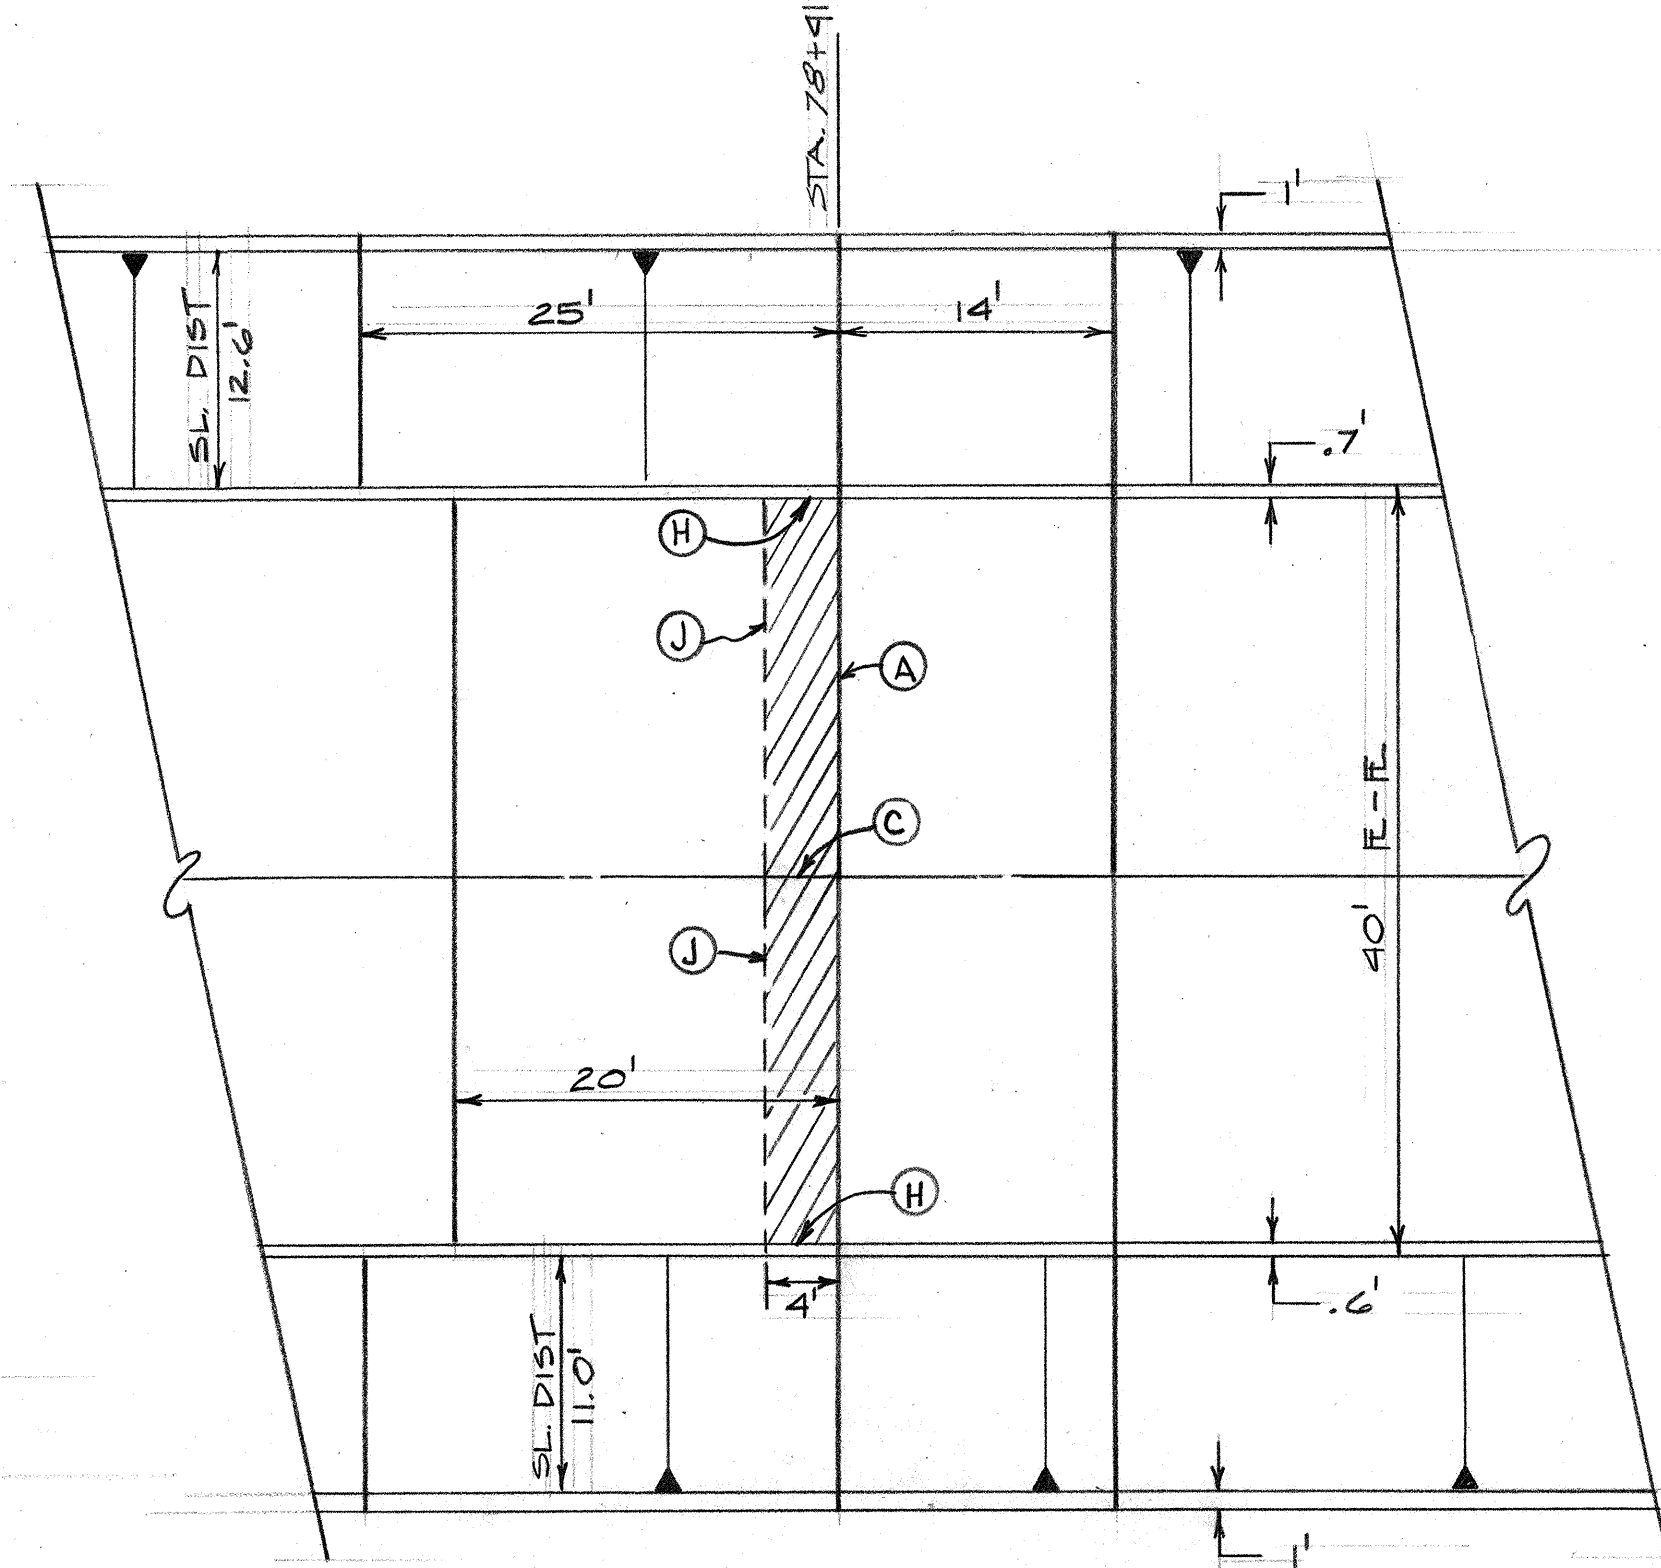

PLAN REPAIR AREA
STATION 78+41

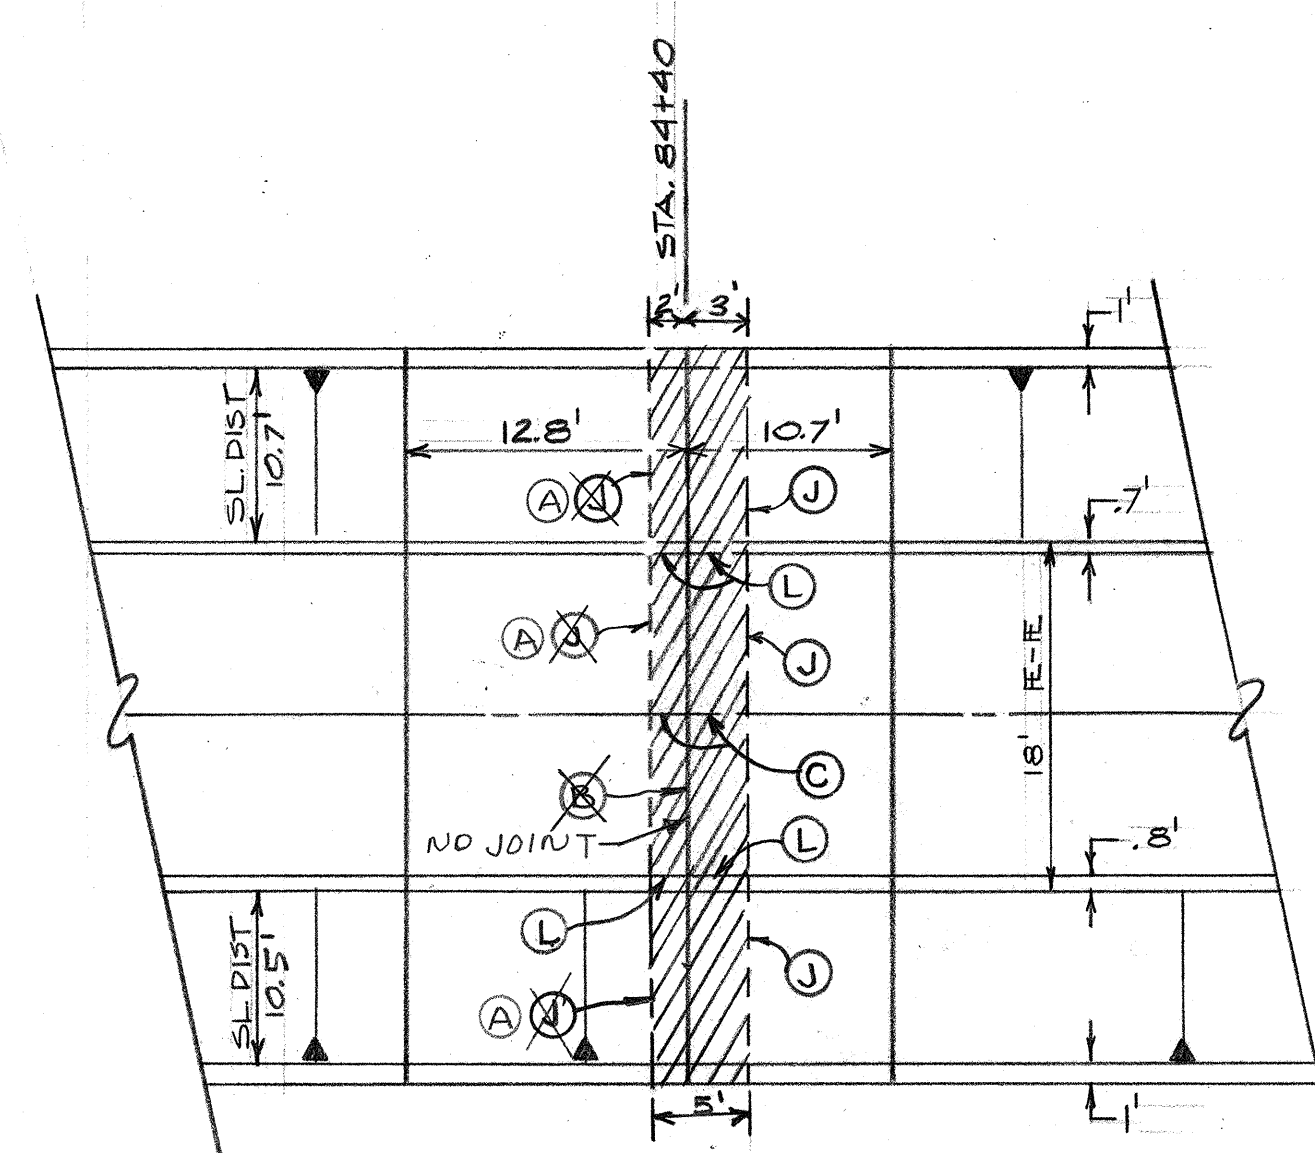

PLAN REPAIR AREA
STATION 84+40

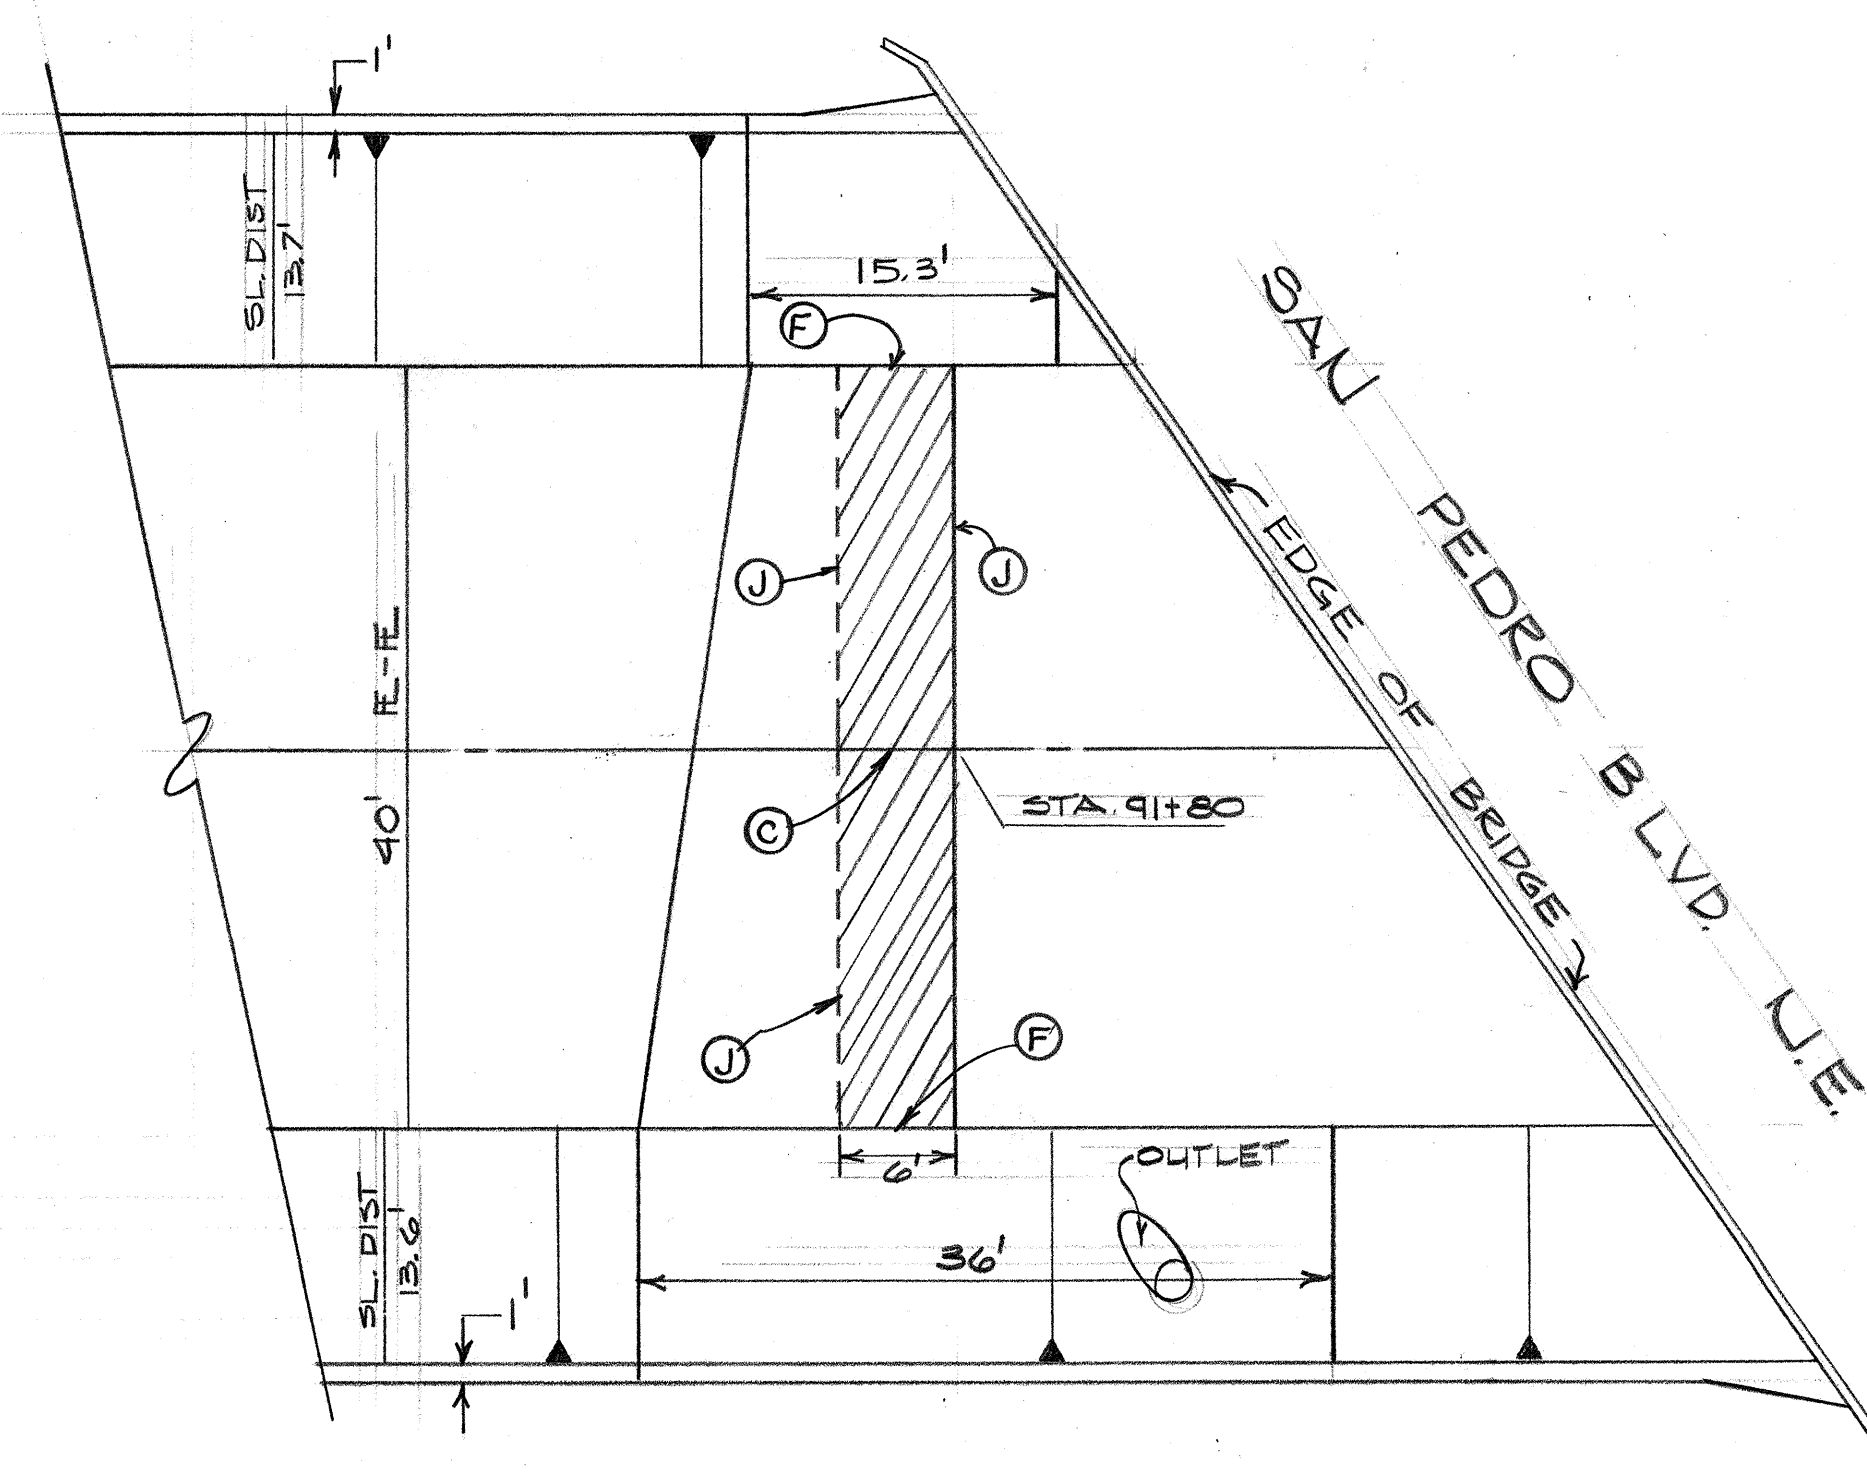

PLAN REPAIR AREA
STATION 91+80

LEGEND:

- AREA TO BE REMOVED & REPLACED
- EXISTING SLABS
- SAW CUT
- SLOPE LINING

1	2	3	4	5	6	7	8	9	10	11	12
20	23	37	06	29							

APPROVED FOR
CONSTRUCTION
RSN 6/12/80
CITY ENGINEER DATE

CITY OF ALBUQUERQUE PUBLIC WORKS DEPARTMENT ENGINEERING DIVISION					
TITLE: HAHN ARRYO CHANNEL REPAIR PHASE I					
APPROVALS	ENGINEER	DATE	APPROVALS	ENGINEER	DATE
City Engineer	<i>RSN</i>	6/12/80	Liquid Waste		
A.C.E.-Design	<i>RSN</i>	11/1/80	Traffic		
A.C.E.-Hydrology			Water		
DRAWING NO. SD-29-237			SHEET 6 OF 7		

REFERENCES			SURVEY INFORMATION		BENCH MARKS		AS BUILT INFORMATION	
MAP NO.	G17/G18-111	EST. NO.	NO.	BY	DATE		CONTRACTOR	DATE
							INSPECTOR'S	DATE
							FIELD OFFICE BY	DATE
							VERIFICATION BY	DATE
							CORRECTED BY	DATE
							RECORDED BY	DATE
							NO.	

