

2D-50-538



1	2	3	4	5	6	7	8	9	10	11	12
2	2	3	8	0	1	2	9				


APPROVED FOR
CONSTRUCTION
[Signature]
CITY ENGINEER
DATE 6/19/80

APPROVAL OF AS-BUILT DRAWINGS
ASST. CITY ENGINEER - FIELD
[Signature]
DATE 9-16-80


CITY OF ALBUQUERQUE PUBLIC WORKS DEPARTMENT ENGINEERING DIVISION					
TITLE: HAHN ARROYO CHANNEL REPAIR PHASE II					
APPROVALS	ENGINEER	DATE	APPROVALS	ENGINEER	DATE
City Engineer	<i>[Signature]</i>	6/12/80	Liquid Waste		
A.C.E. - Design	<i>[Signature]</i>	6/12/80	Traffic		
A.C.E. - Hydrology			Water		
DRAWING NO.	SD-29-238			SHEET	1 OF 7

REFERENCES		SURVEY INFORMATION		BENCH MARKS		AS BUILT INFORMATION	
MAP NO. G-18/G-19-477		FIELD NOTES				CONTRACTOR	
EST. NO.		NO.	BY	DATE		WORK STARTED BY	DATE
						INSPECTOR'S FIELD CHANGE BY	DATE
						VERIFICATION BY	DATE
						CORRECTED BY	DATE
						MICRO-FILM INFORMATION	
						RECORDED BY	DATE
						NO.	


2D-50-538

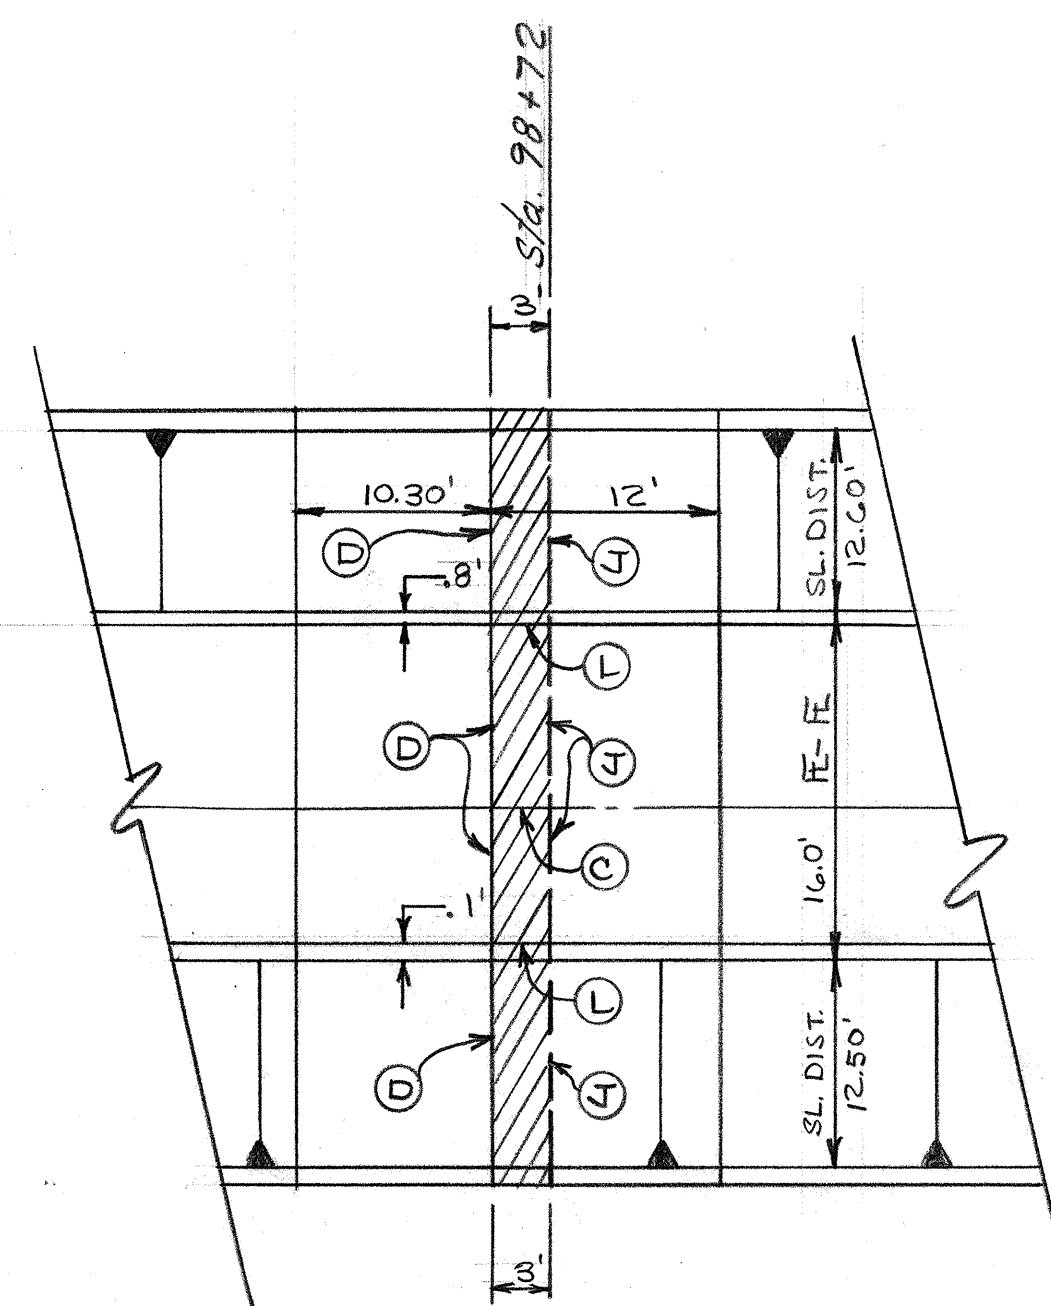


PLAN REPAIR AREA
STATION-98+72

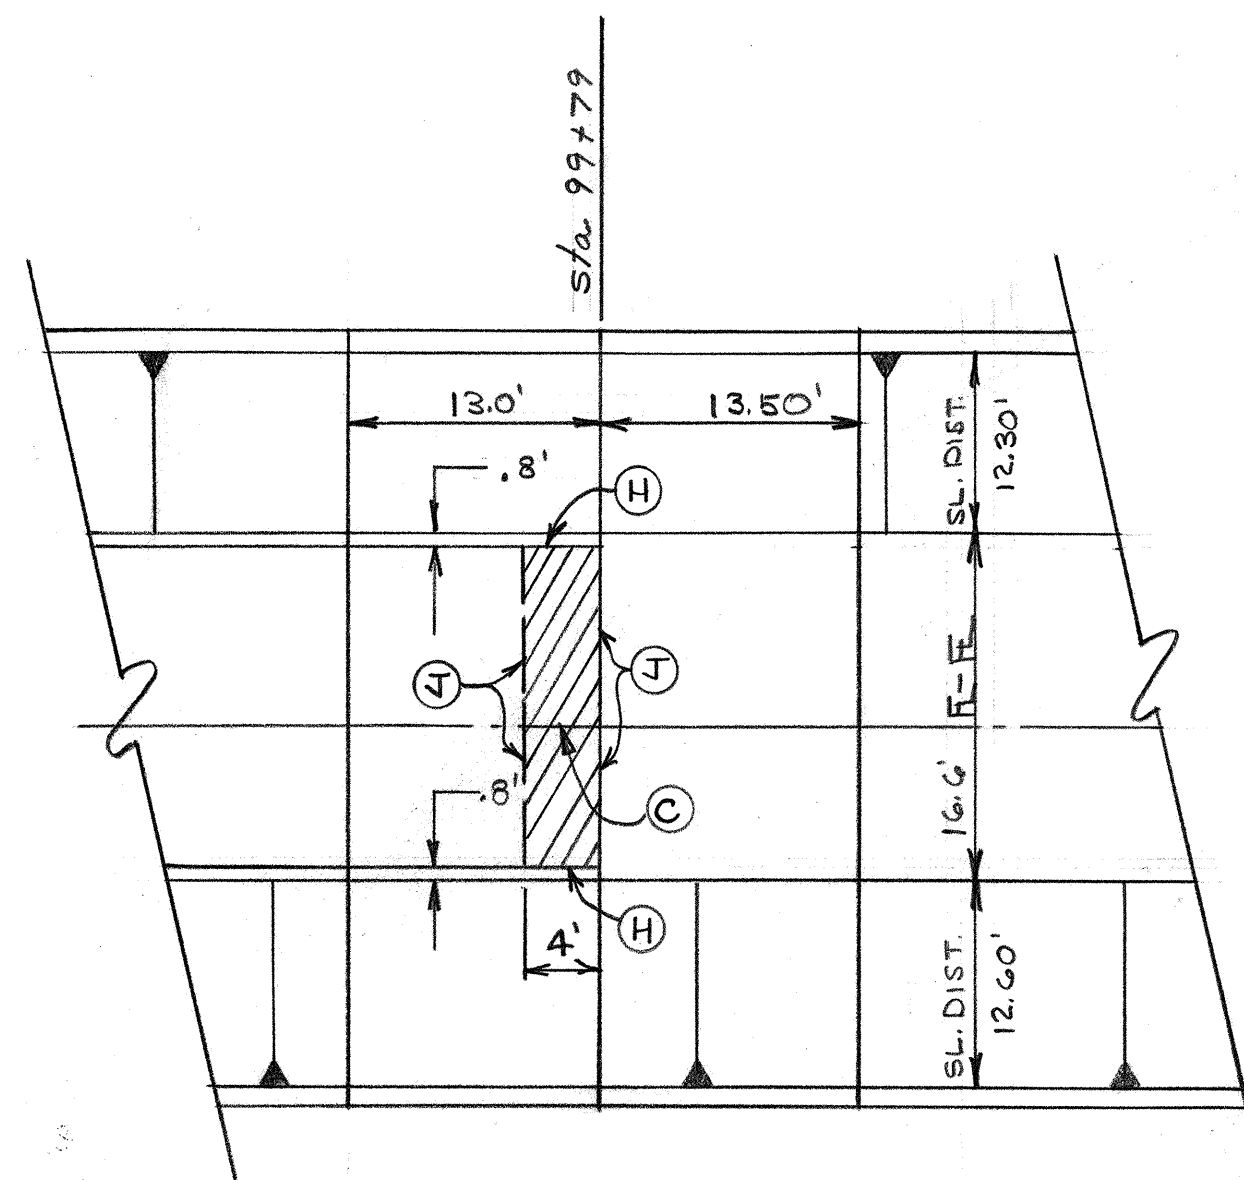


PLAN REPAIR AREA
STATION-99+79

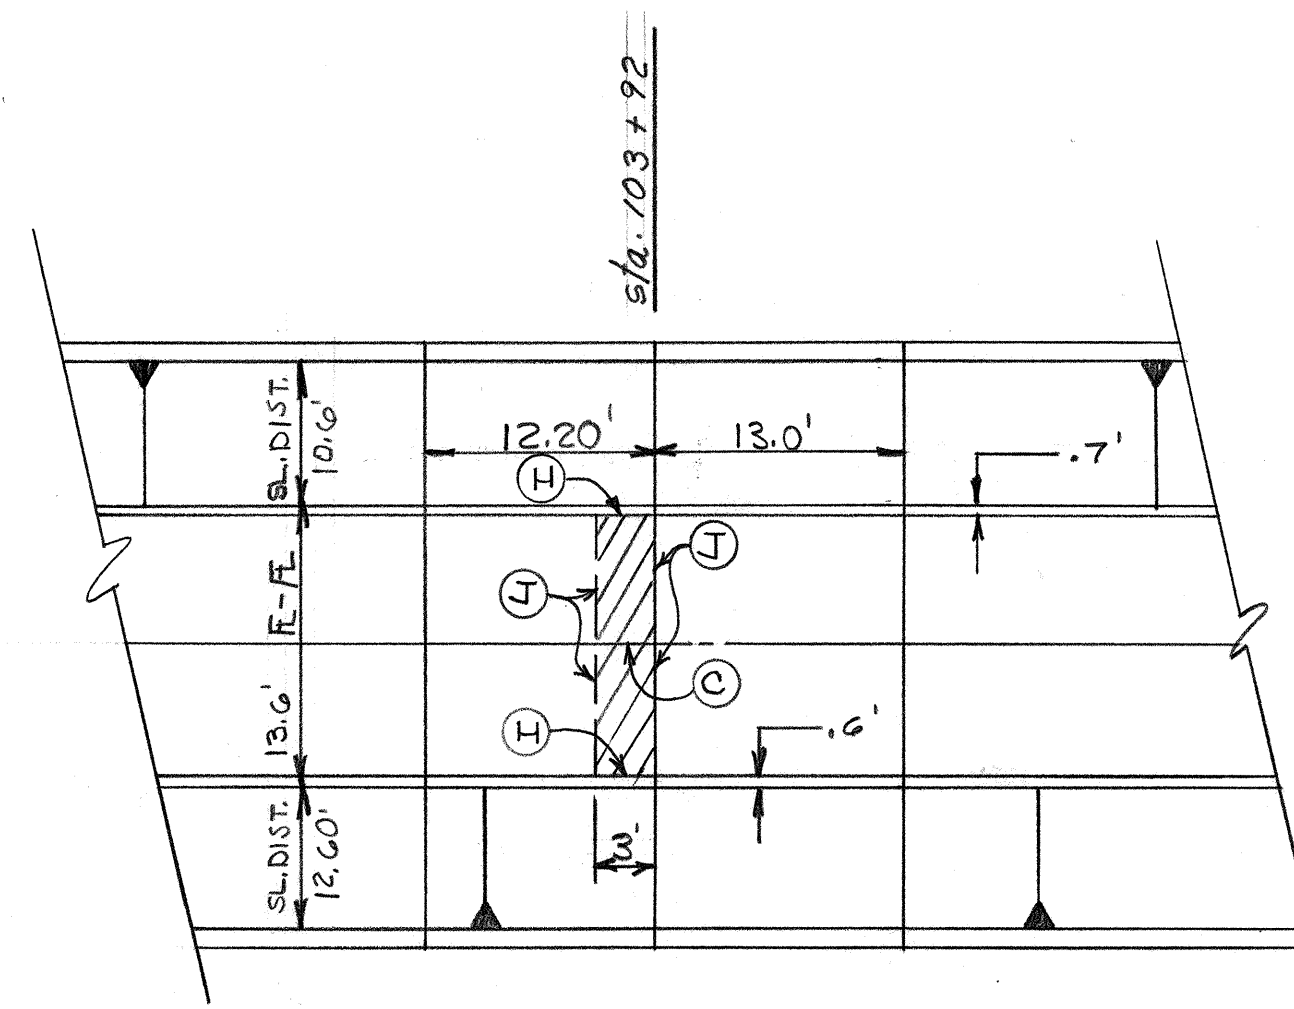


PLAN REPAIR AREA
STATION-103+92

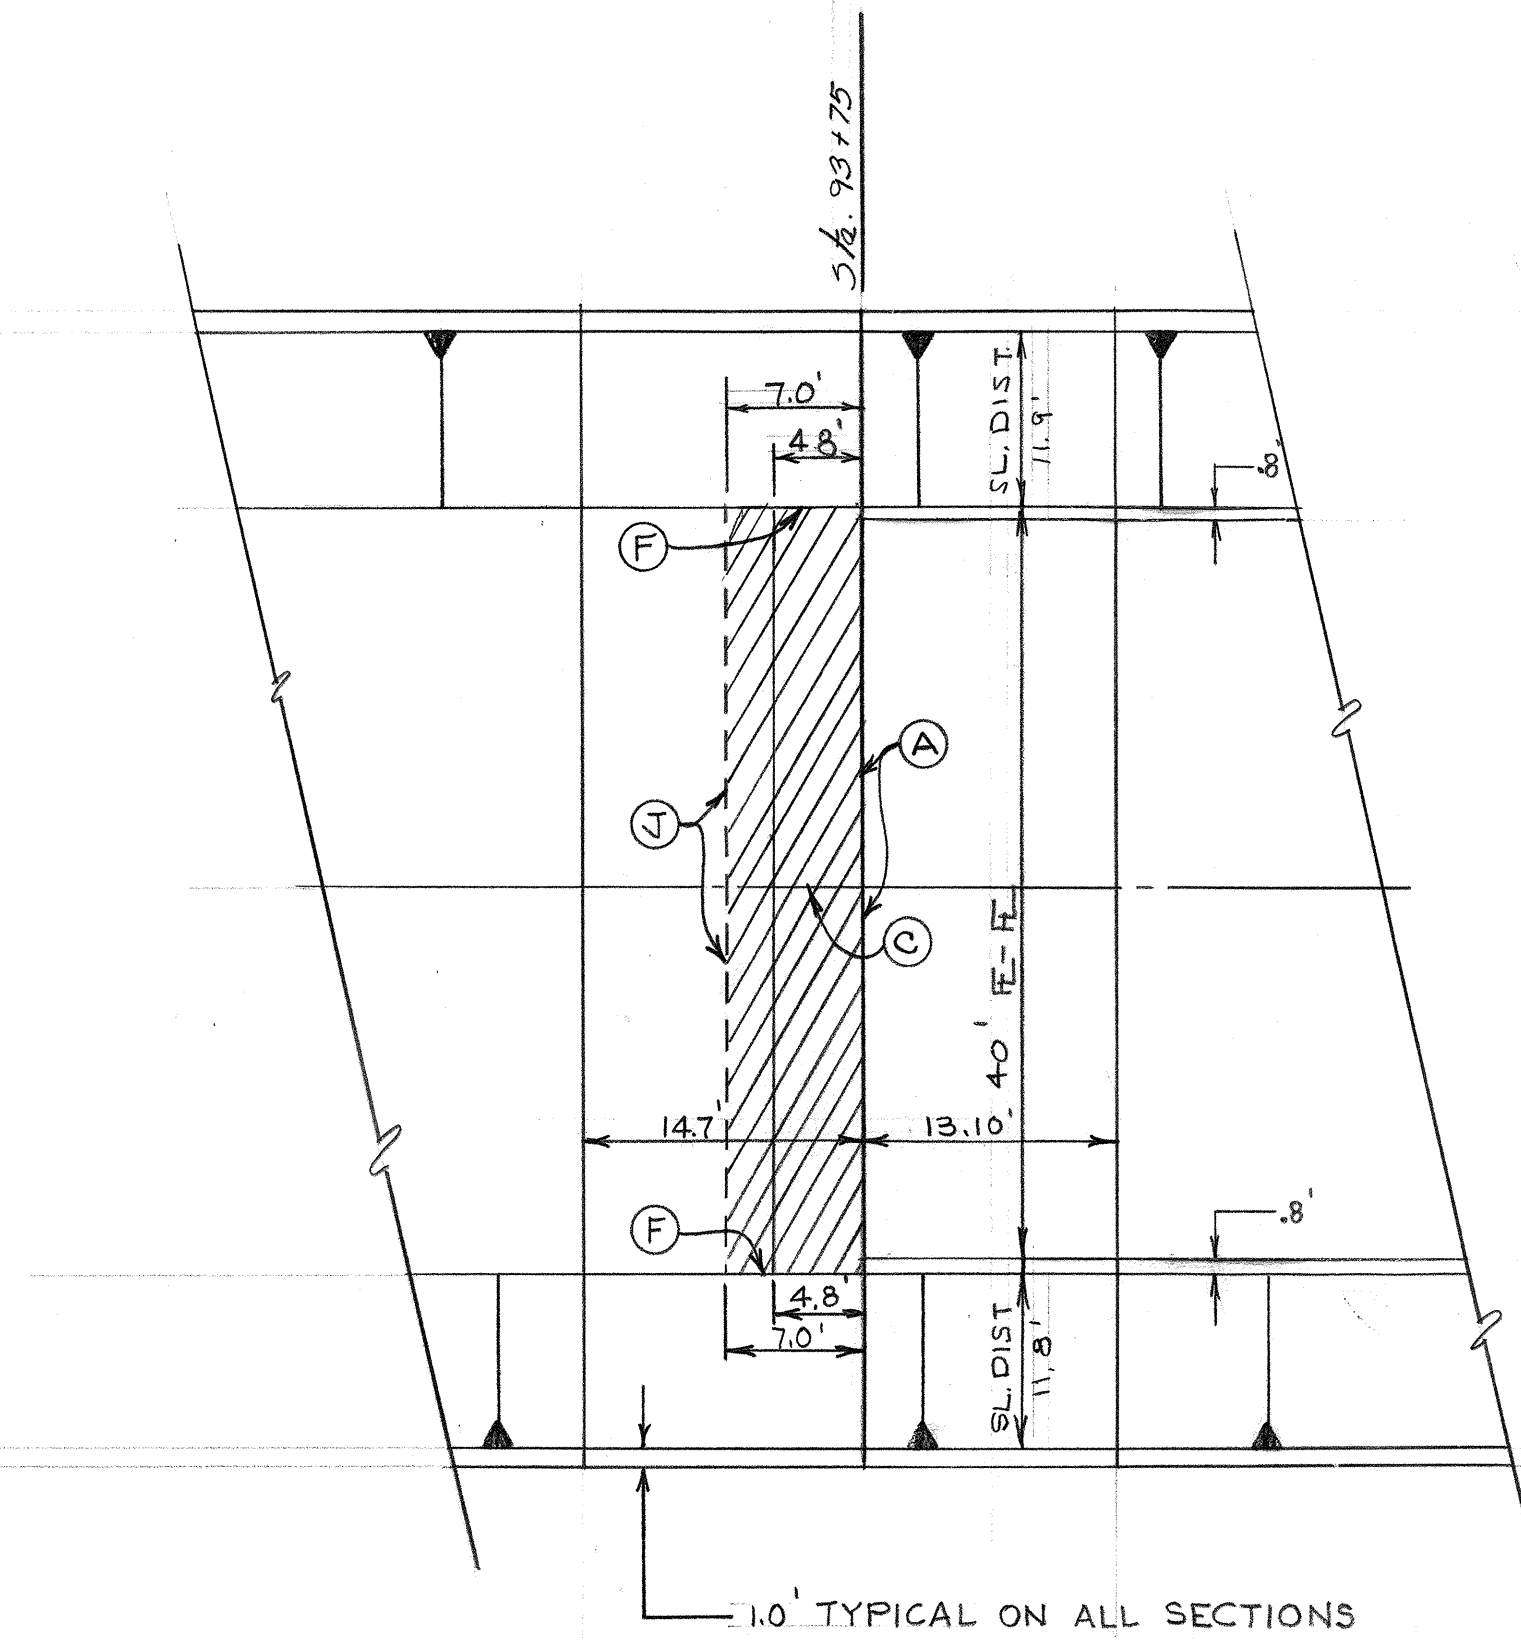

PLAN REPAIR AREA
STATION-93+75

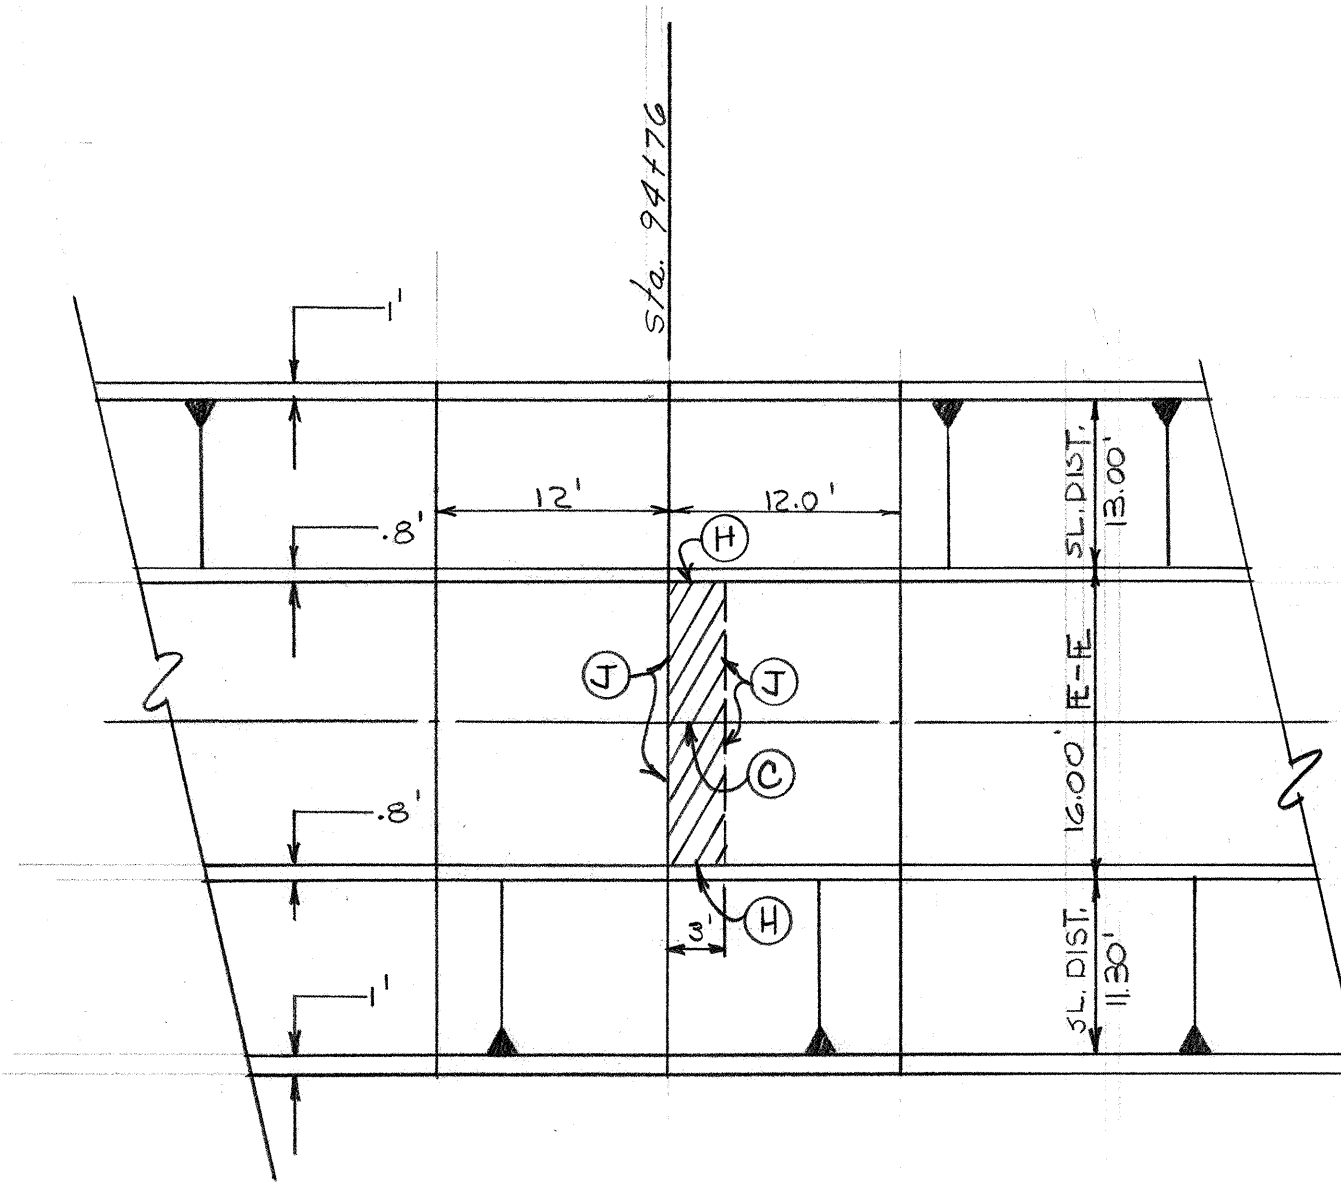


PLAN REPAIR AREA
STATION-94+76

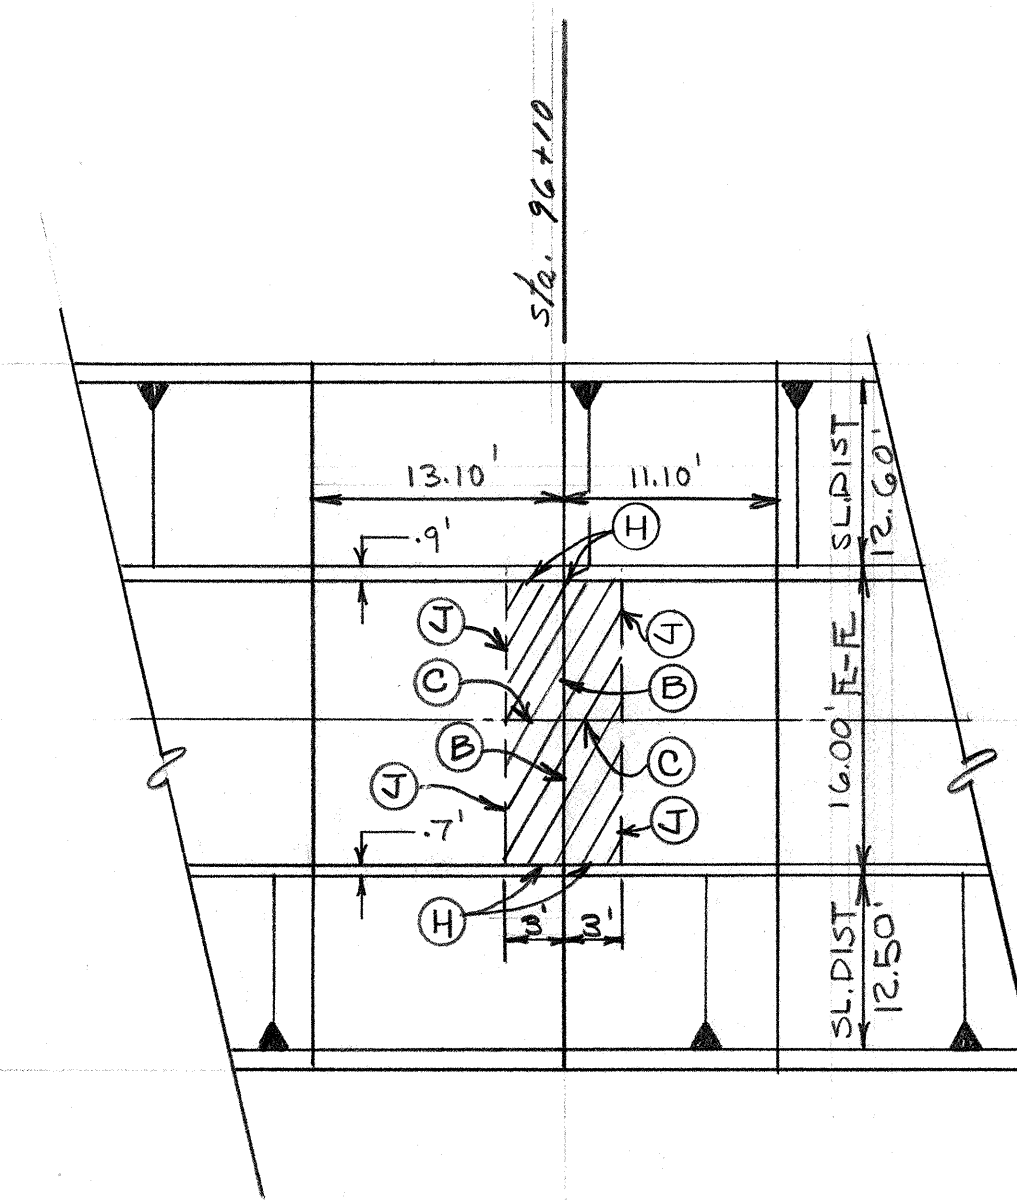

PLAN REPAIR AREA
STATION-96+10

LEGEND

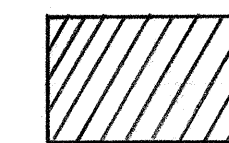

AREA TO BE REMOVED & REPLACED



EXISTING SLABS



SAW CUT



SLOPED LINING







JOINT TYPE

1 2 3 4 5 6 7 8 9 10 11 12
20 238 0229

APPROVED FOR
CONSTRUCTION
CITY ENGINEER
DATE 6/19/80

CITY OF ALBUQUERQUE PUBLIC WORKS DEPARTMENT ENGINEERING DIVISION					
TITLE: HAHN ARROYO CHANNEL REPAIR PHASE II					
APPROVALS	ENGINEER	DATE	APPROVALS	ENGINEER	DATE
City Engineer	<i>[Signature]</i>	6/12/80	Liquid Waste		
A.C.E.-Design	<i>[Signature]</i>	6/12/80	Traffic		
A.C.E.-Hydrology			Water		
DESIGNED BY J. MIRANDA DATE 6-3-80			DRAWN BY J. Z. / S.C. DATE 6-3-80		
DRAWING NO. SD - 29 - 238			SHEET 2 OF 7		

REFERENCES		SURVEY INFORMATION		BENCH MARKS		AS BUILT INFORMATION	
MAP NO.	EST. NO.	W.O. NO.	NO.	BY	DATE	CONTRACTOR	NO.
MAP NO. 618/G19-77							
REVISIONS		REVISIONS		REVISIONS		REVISIONS	
NO.	DATE	REMARKS	BY	NO.	DATE	REMARKS	BY
DESIGNED BY J. MIRANDA DATE 6-3-80		DRAWN BY J. Z. / S.C. DATE 6-3-80		CHECKED BY		RECORDED BY	

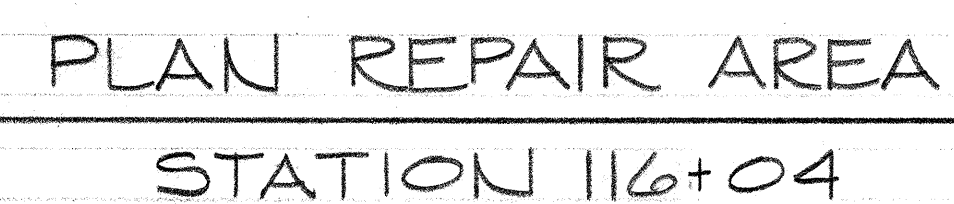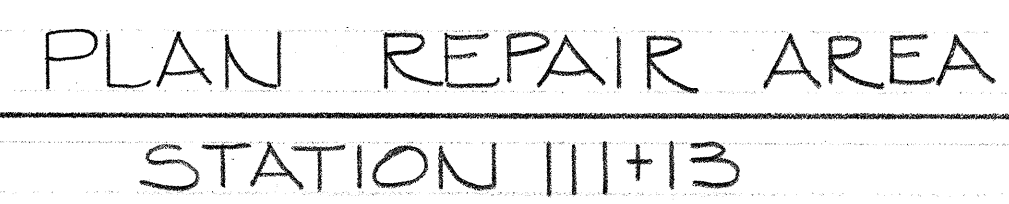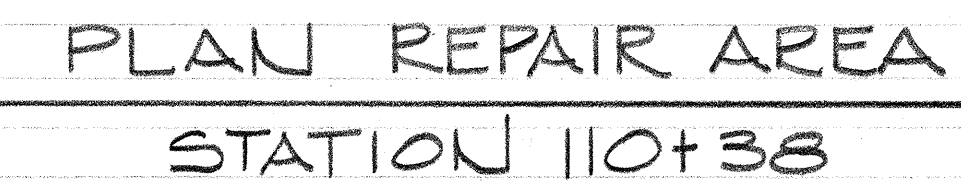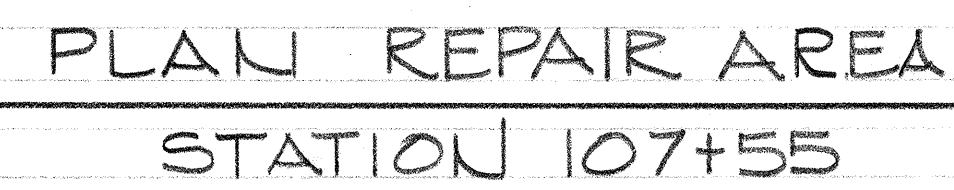


 AREA TO BE REMOVED & REPLACED
 EXISTING SLABS
 --- SAW CUT
 SLOPED LINING
 (A) JOINT TYPE


APPROVED FOR
CONSTRUCTION
ESM 6/19/80
CITY ENGINEER DATE

CITY OF ALBUQUERQUE					
PUBLIC WORKS DEPARTMENT					
ENGINEERING DIVISION					
TITLE:					
HAHN ARROYO CHANNEL REPAIR					
PHASE II					
APPROVALS	ENGINEER	DATE	APPROVALS	ENGINEER	DATE
City Engineer	<i>[Signature]</i>	4/12/80	Liquid Waste		
A.C.E.'s Design	<i>[Signature]</i>	12 Jan 80	Traffic		
A.C.E.'s Hydrology			Water		
DRAWING NO.			SHEET		
SD - 29 - 238			3 OF 7		


[illegible]

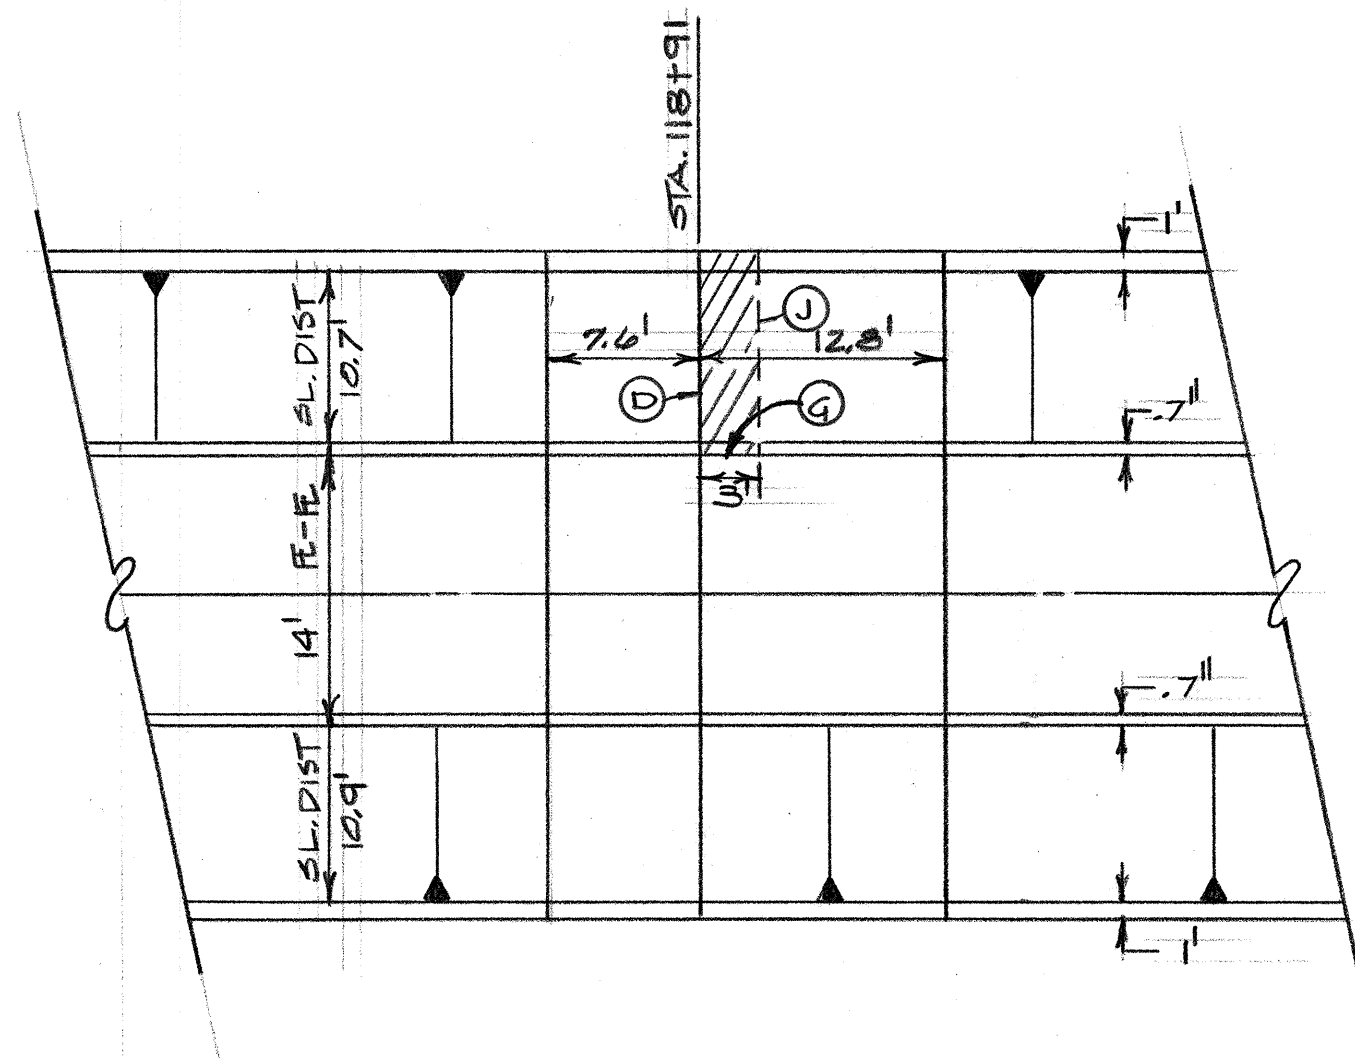


PLAN REPAIR AREA
STATION 118+91

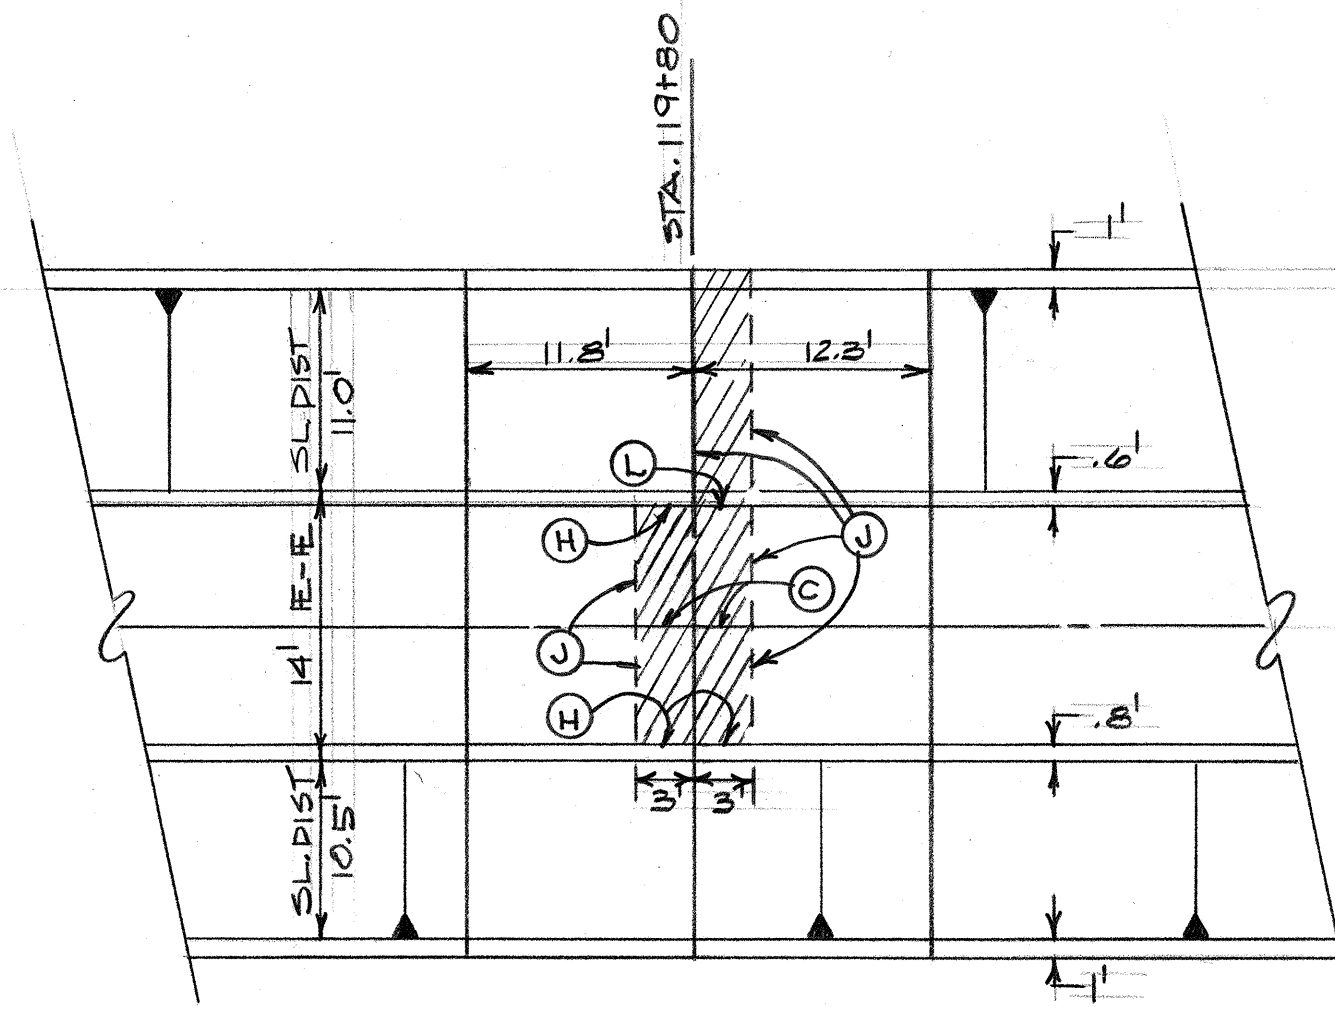


PLAN REPAIR AREA
STATION 119+80

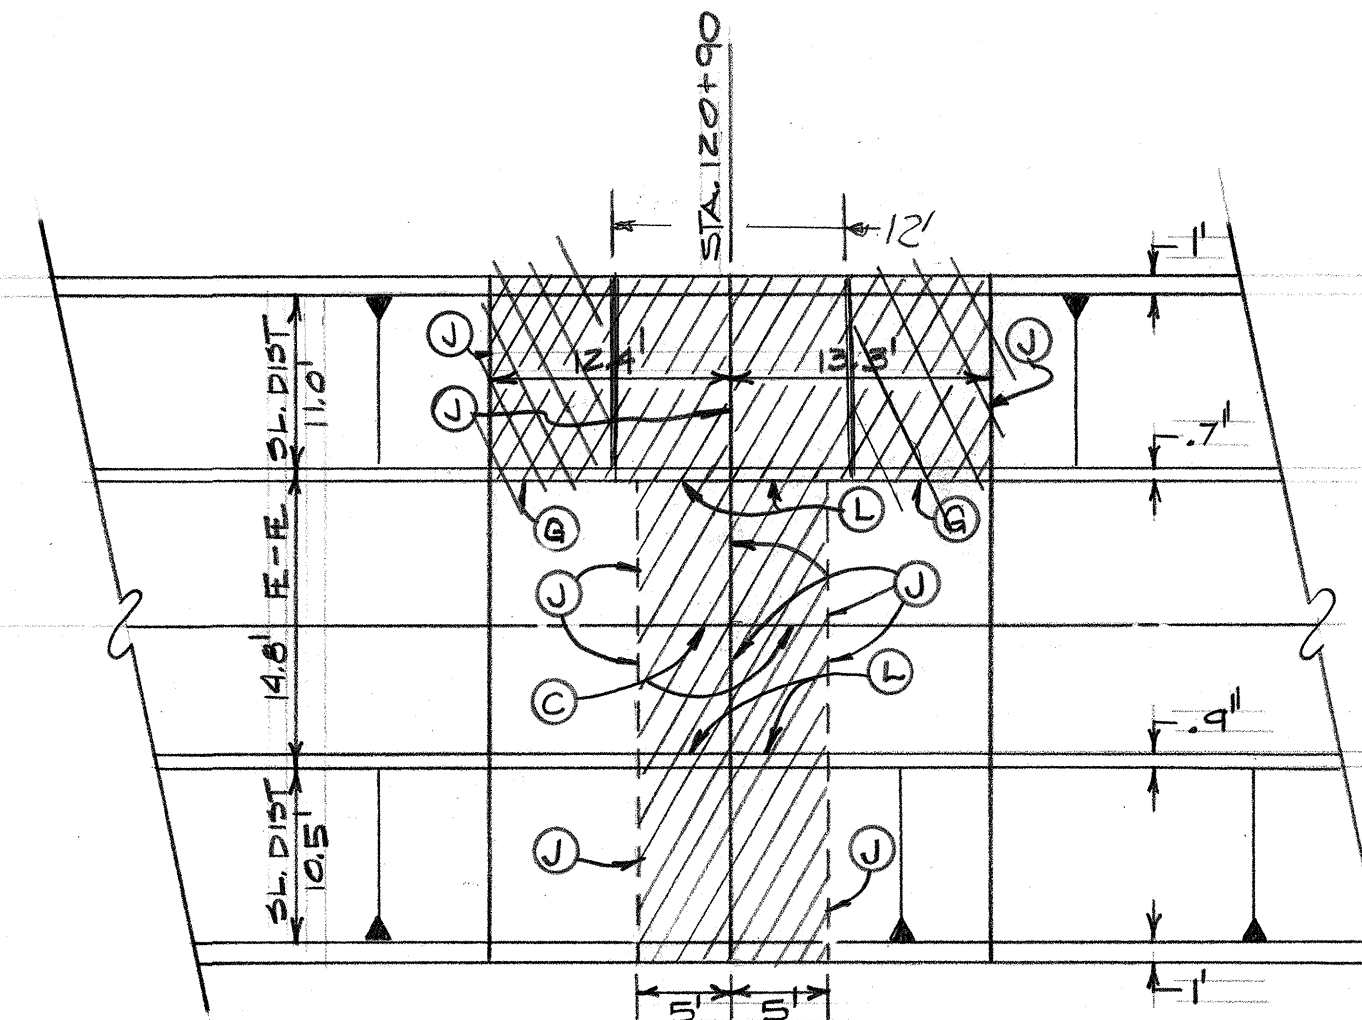

PLAN REPAIR AREA
STATION 120+90

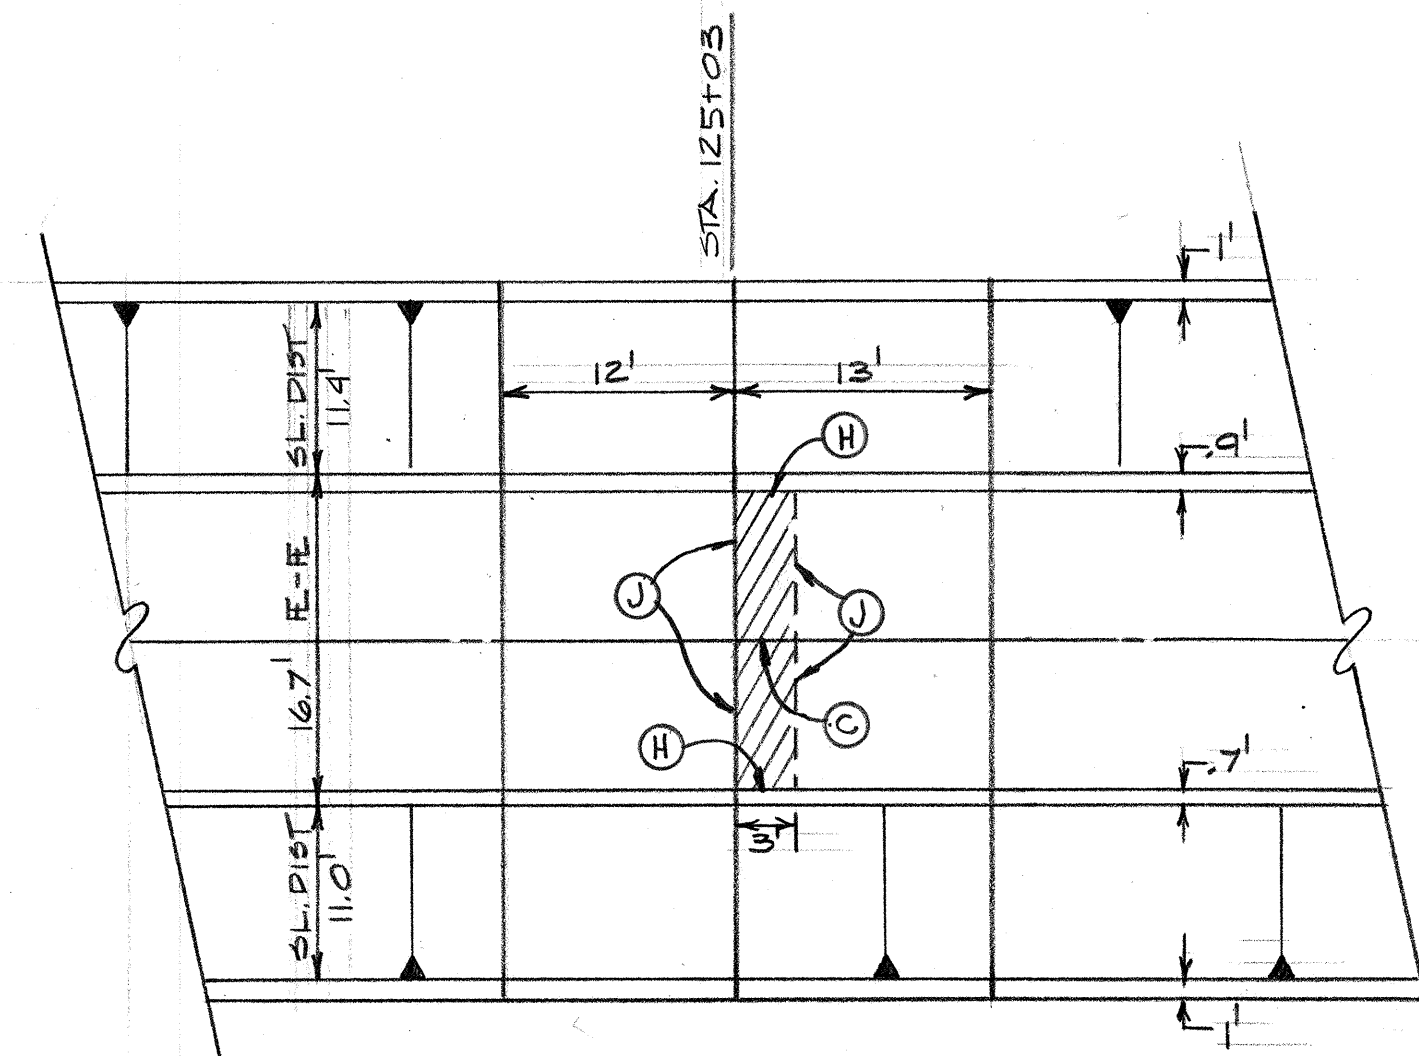

PLAN REPAIR AREA
STATION 125+03

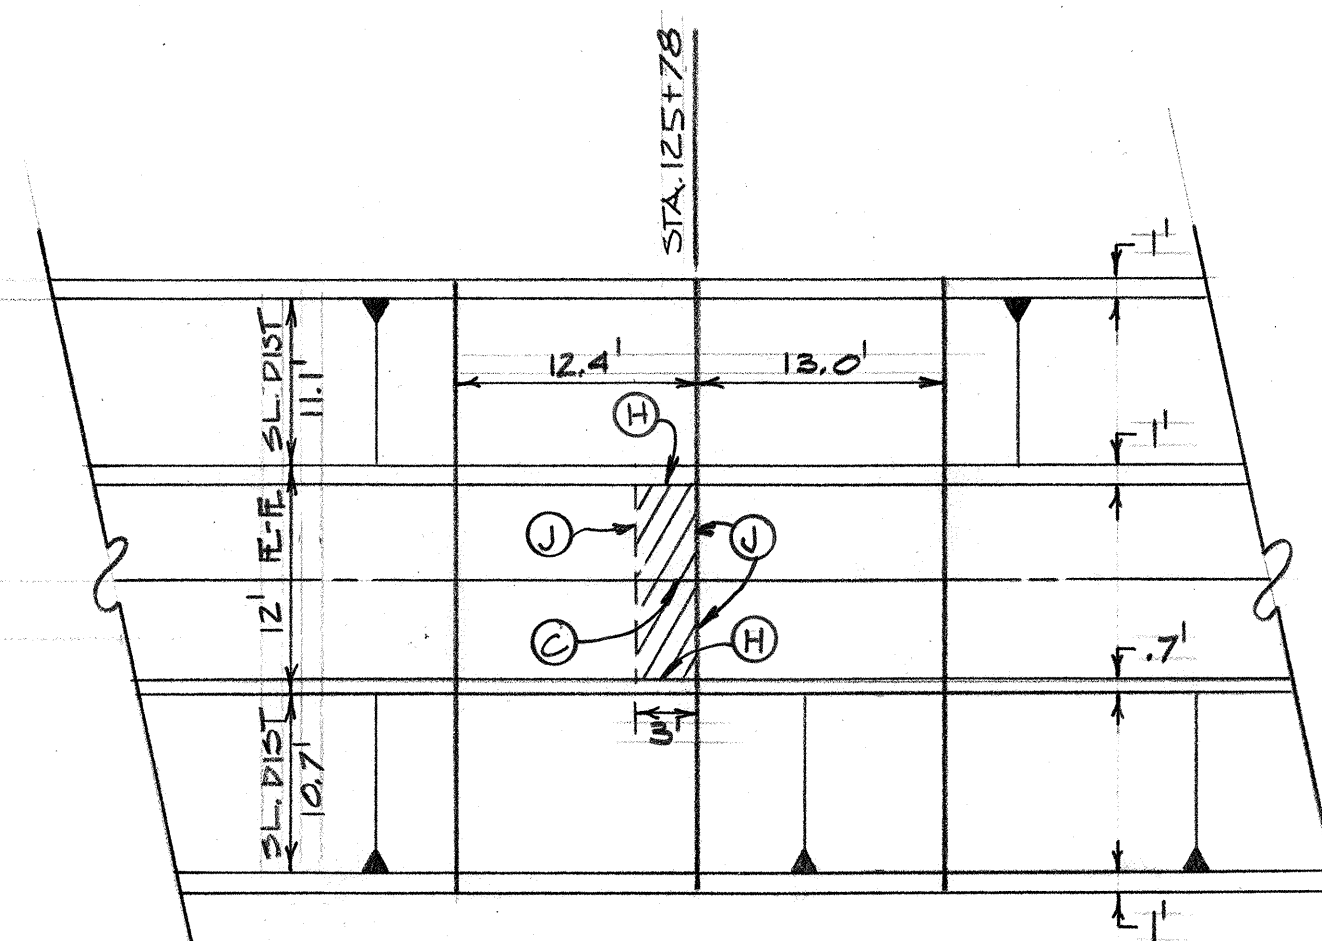

PLAN REPAIR AREA
STATION 125+78

LEGEND:

- AREA TO BE REMOVED & REPLACED
- EXISTING SLABS
- SAW CUT
- SLOPED LINING
- JOINT TYPE

1	2	3	4	5	6	7	8	9	10	11	12
22	23	28	04	29							


1	2	3	4	5	6	7	8	9	10	11	12
00	03	8	04	29							

APPROVED FOR
CONSTRUCTION


CITY ENGINEER
6/19/80
DATE

CITY OF ALBUQUERQUE PUBLIC WORKS DEPARTMENT ENGINEERING DIVISION					
TITLE: HAHN ARROYO CHANNEL REPAIR PHASE II					
APPROVALS	ENGINEER	DATE	APPROVALS	ENGINEER	DATE
City Engineer		6/12/80	Liquid Waste		
A.C.E. - Design		6/12/80	Traffic		
A.C.E. - Hydrology			Water		
DESIGNED BY S. MIRANDA DATE 6-3-80			DRAWN BY S.C./J.Z. DATE 6-3-80		
CHECKED BY			DATE		
DRAWING NO. SD - 29 - 238			SHEET 4 OF 7		


REFERENCES		SURVEY INFORMATION		BENCH MARKS		AS BUILT INFORMATION	
MAP NO. G-18/G-19 PM	EST. NO.	W.O. NO.	NO.	BY	DATE	CONTRACTOR	DATE
						WORK	DATE
						INSPECTOR'S	DATE
						FIELD	DATE
						VERIFICATION BY	DATE
						CORRECTED BY	DATE
						MICRO-FILM	DATE
						RECORDED BY	DATE
						NO.	DATE

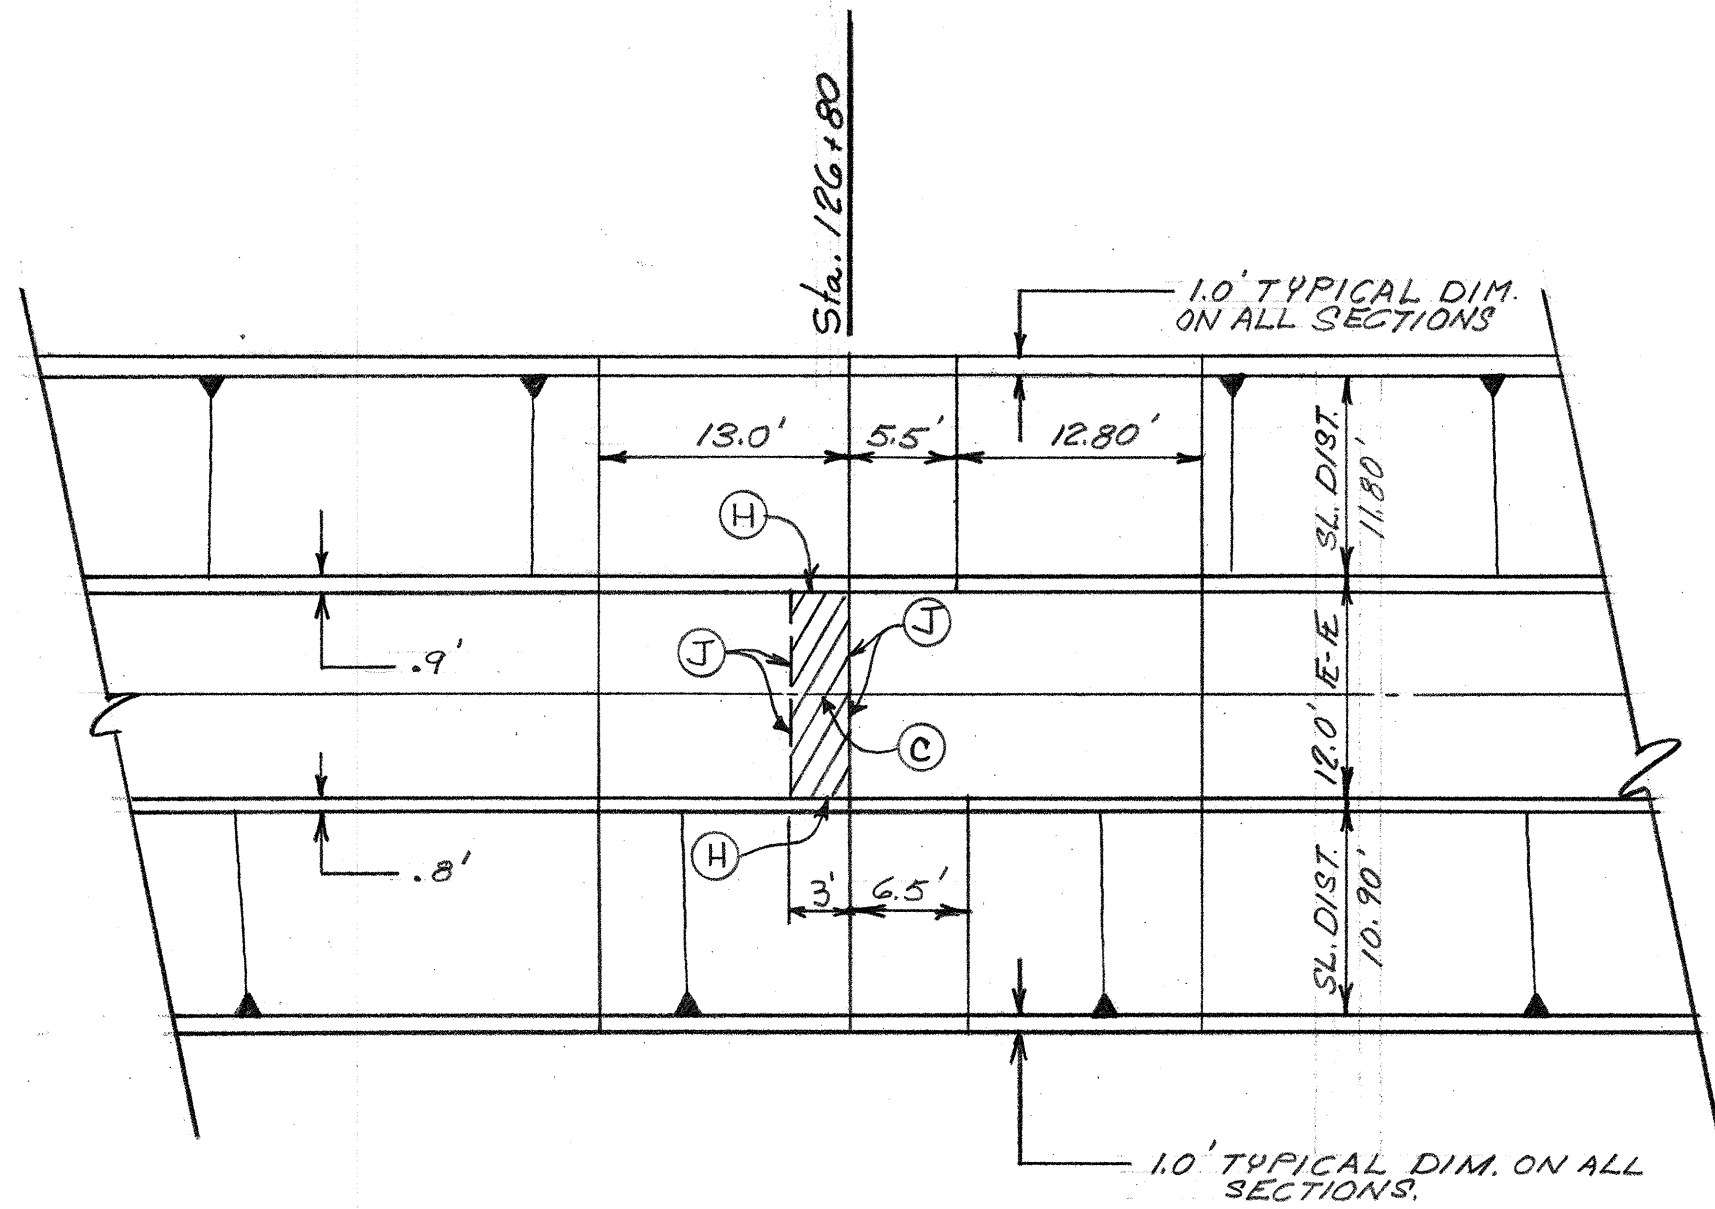


PLAN REPAIR AREA
STATION - 126+80

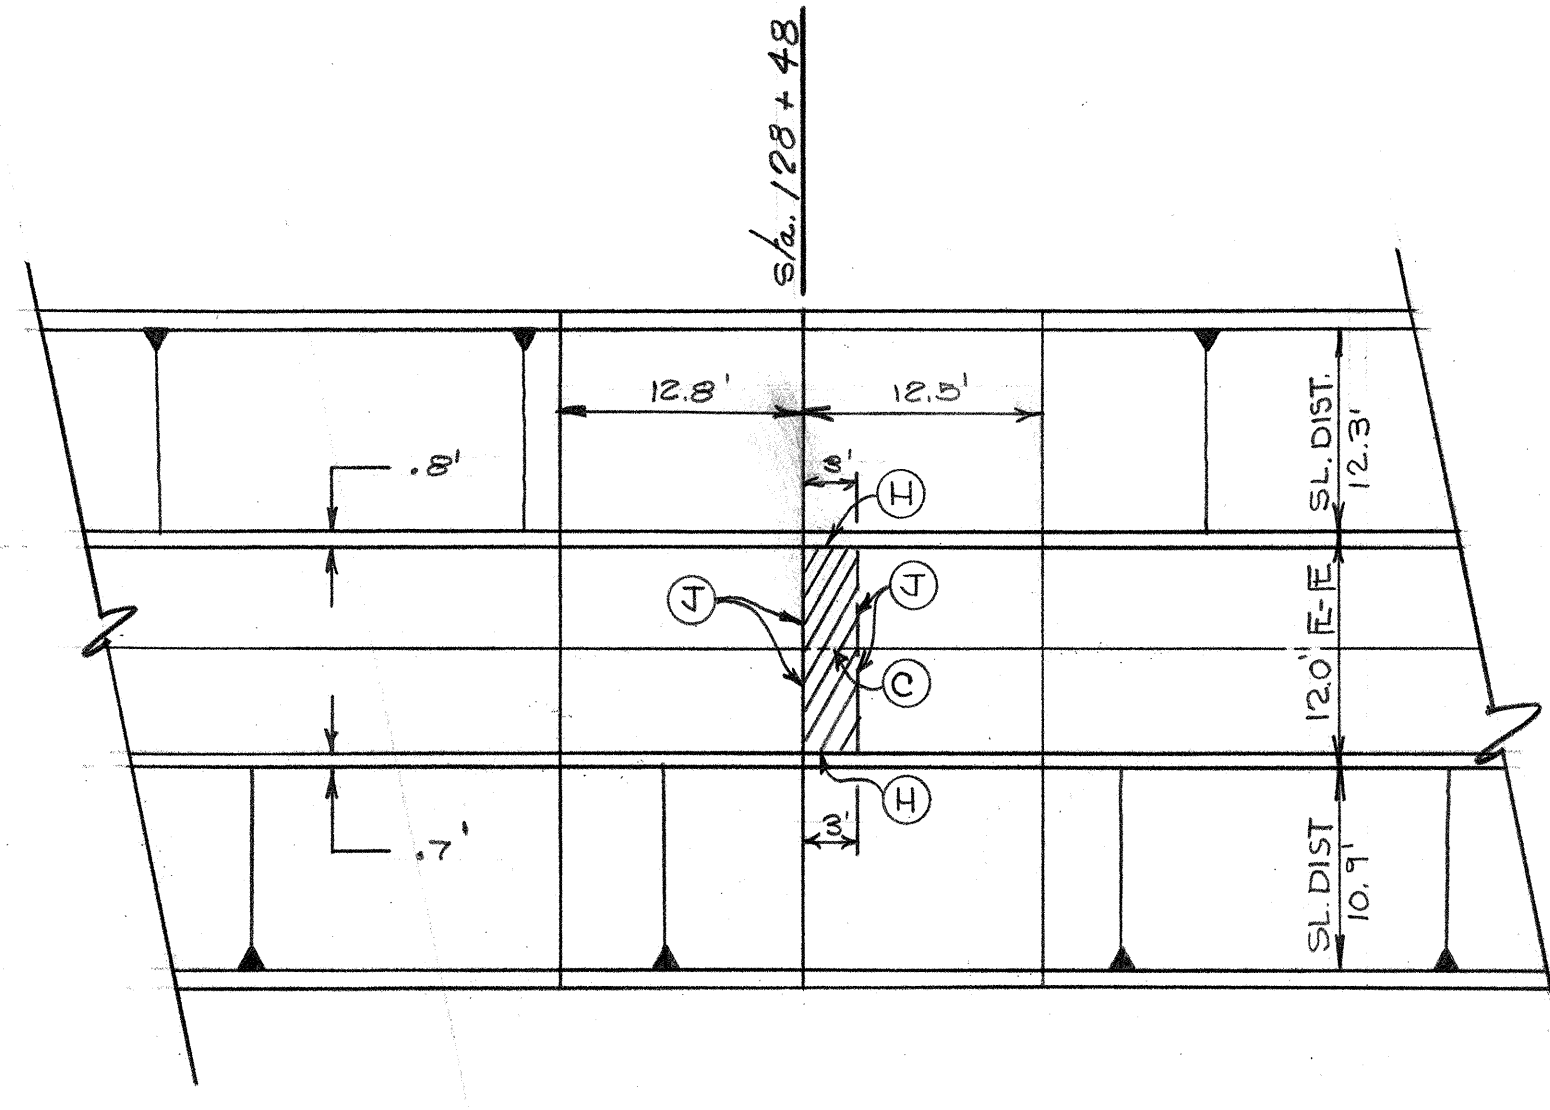


PLAN REPAIR AREA
STATION - 128+48

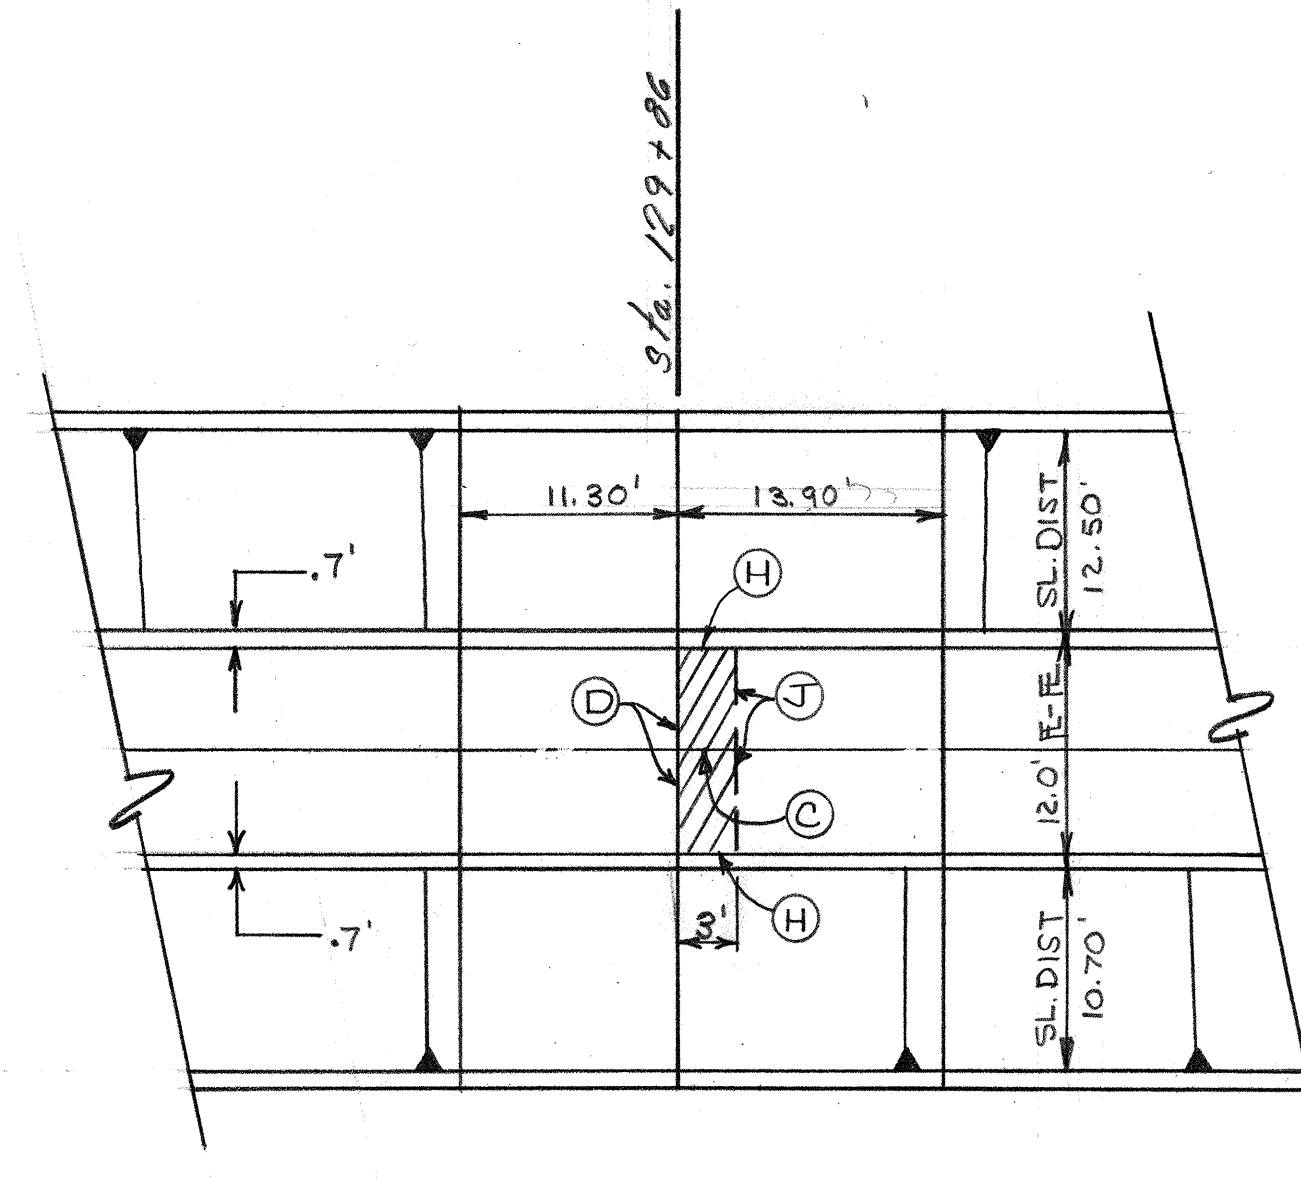

PLAN REPAIR AREA
STATION - 129+86

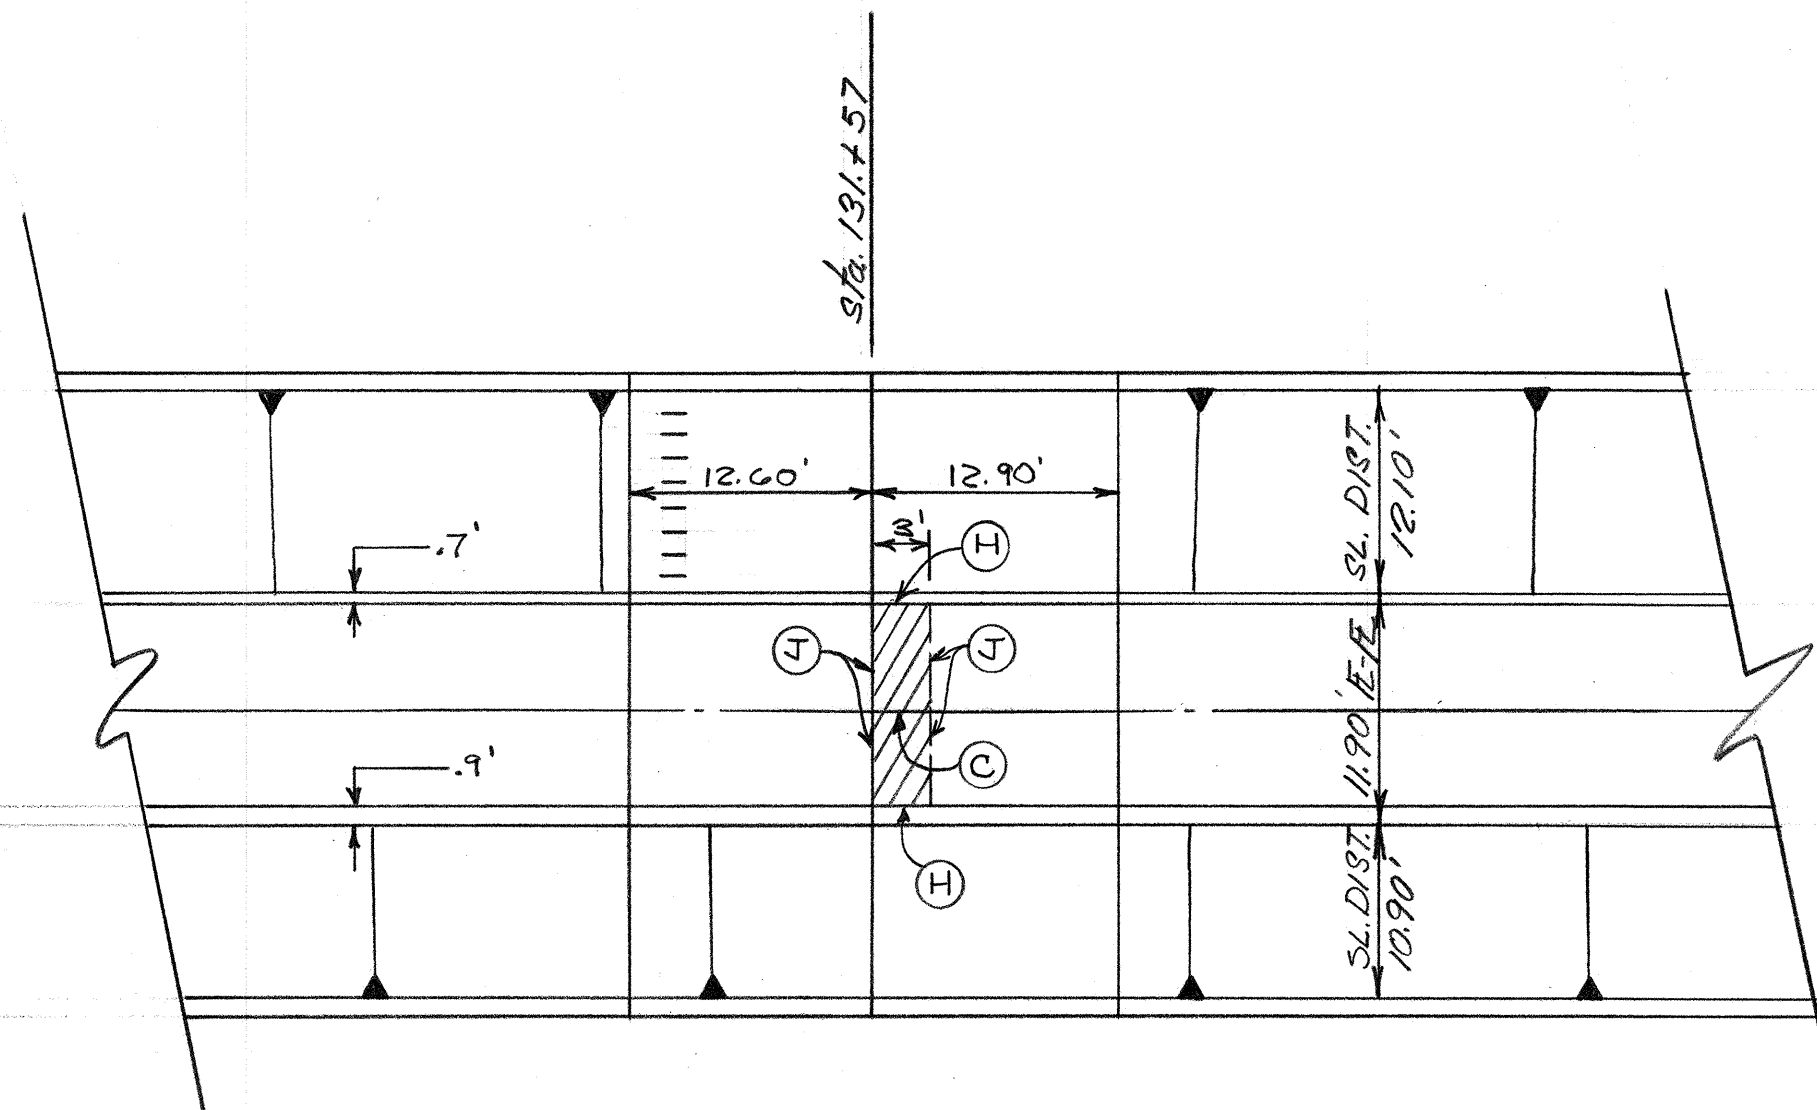


PLAN REPAIR AREA
STATION - 131+57

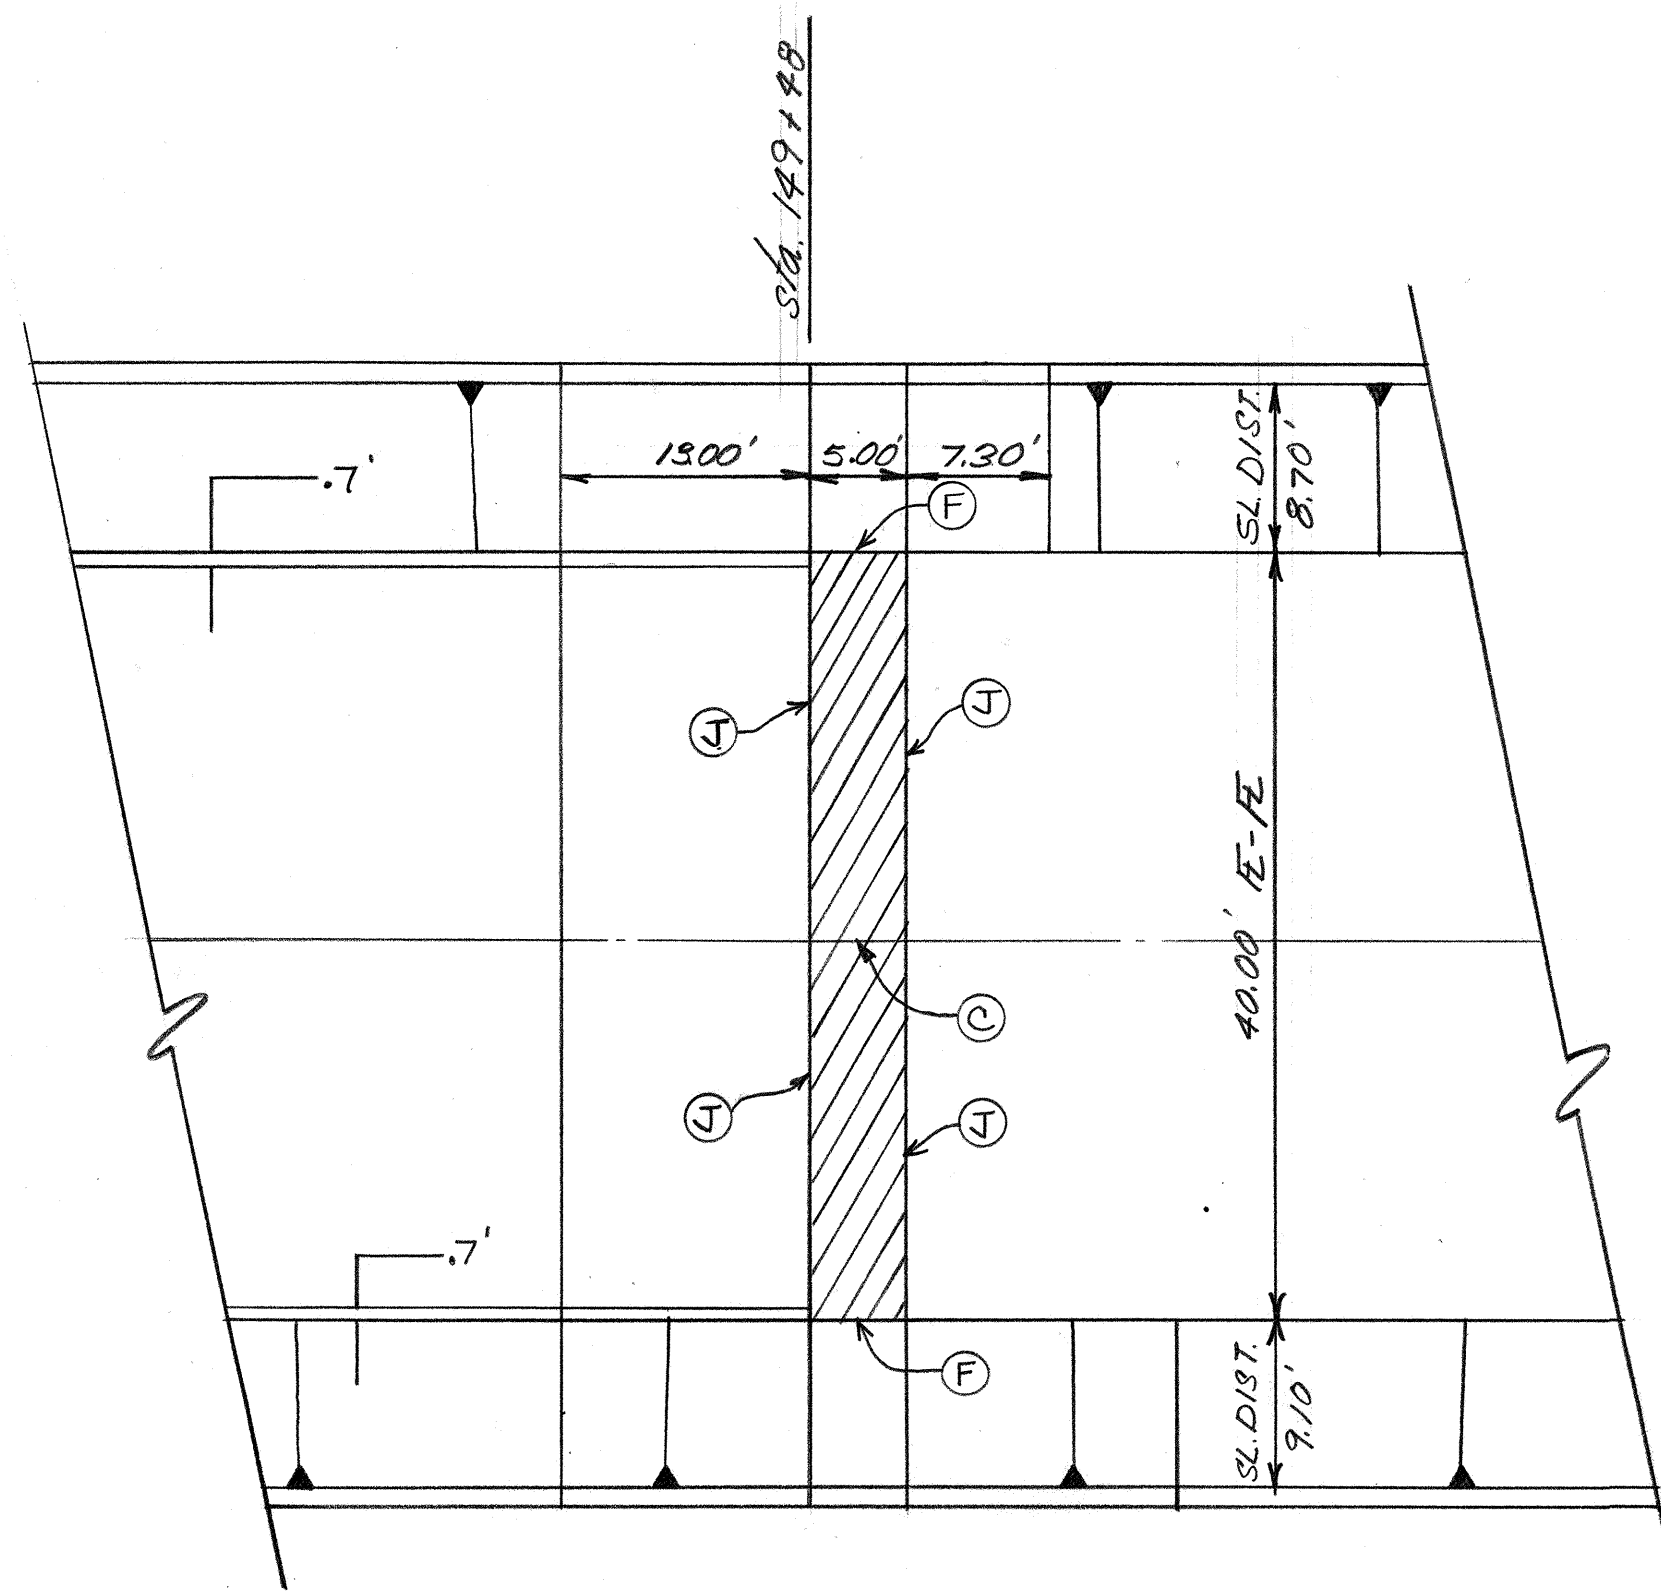


PLAN REPAIR AREA
STATION - 149+48

LEGEND

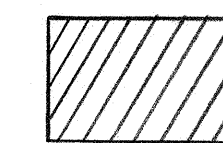

AREA TO BE REMOVED & REPLACED

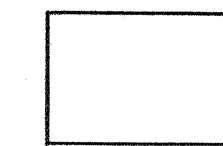

EXISTING SLABS



SAW CUT



SLOPED LINING



JOINT TYPE




1	2	3	4	5	6	7	8	9	10	11	12
2	2	3	8	0	5	2	9				

2	0	2	3	8	0	5	2	9
---	---	---	---	---	---	---	---	---

APPROVED FOR
CONSTRUCTION
RSM
CITY ENGINEER
6/19/80
DATE

CITY OF ALBUQUERQUE PUBLIC WORKS DEPARTMENT ENGINEERING DIVISION				
TITLE: HAHN ARROYO CHANNEL REPAIR PHASE II				
APPROVALS	ENGINEER	DATE	APPROVALS	ENGINEER
City Engineer	RSM	6/19/80	Liquid Waste	
A.C.E.-Design	SM	6/19/80	Traffic	
A.C.E.-Hydrology			Water	
DRAWING NO.	SD - 29 - 238			SHEET 5 OF 7

REFERENCES		SURVEY INFORMATION		BENCH MARKS		AS BUILT INFORMATION	
MAP NO.	EST. NO.	NO.	BY	DATE		CONTRACTOR	DATE
418/19-97						INSPECTOR'S	DATE
						FIELD	DATE
						VERIFICATION BY	DATE
						CORRECTED BY	DATE
						RECORDED BY	DATE
						NO.	

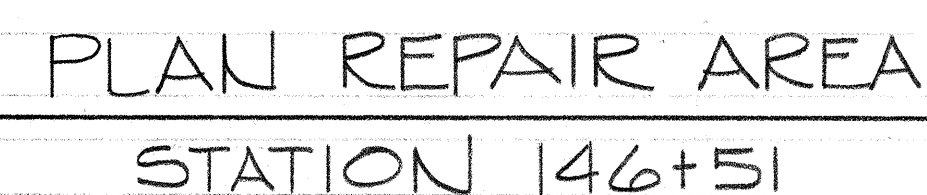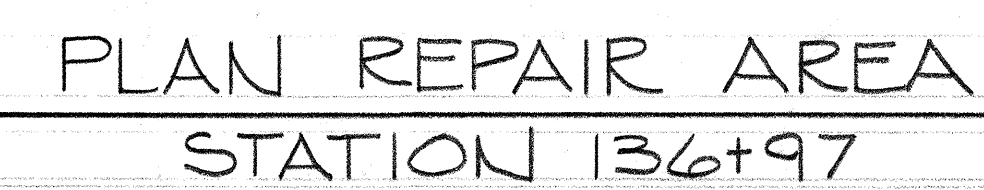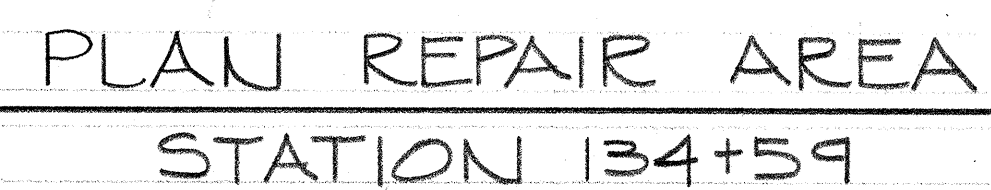


JOINT TYPE

[illegible]


CITY OF ALBUQUERQUE PUBLIC WORKS DEPARTMENT ENGINEERING DIVISION					
TITLE:					
HAHN ARROYO CHANNEL REPAIR PHASE II					
APPROVALS	ENGINEER	DATE	APPROVALS	ENGINEER	DATE
City Engineer	<i>R. Smith</i>	6/14/82	Liquid Waste		
A.C.E.- Design	<i>Richard</i>	<i>Richard</i>	Traffic		
A.C.E.-Hydrology			Water		
DRAWING NO.			SHEET		
SD - 29 - 238			6 OF 7		

1	2	3	4	5	6	7	8	9	10	11	12
20			238				0629				



APPROVED FOR
CONSTRUCTION
R. Schuler 4/19/80
CITY ENGINEER DATE

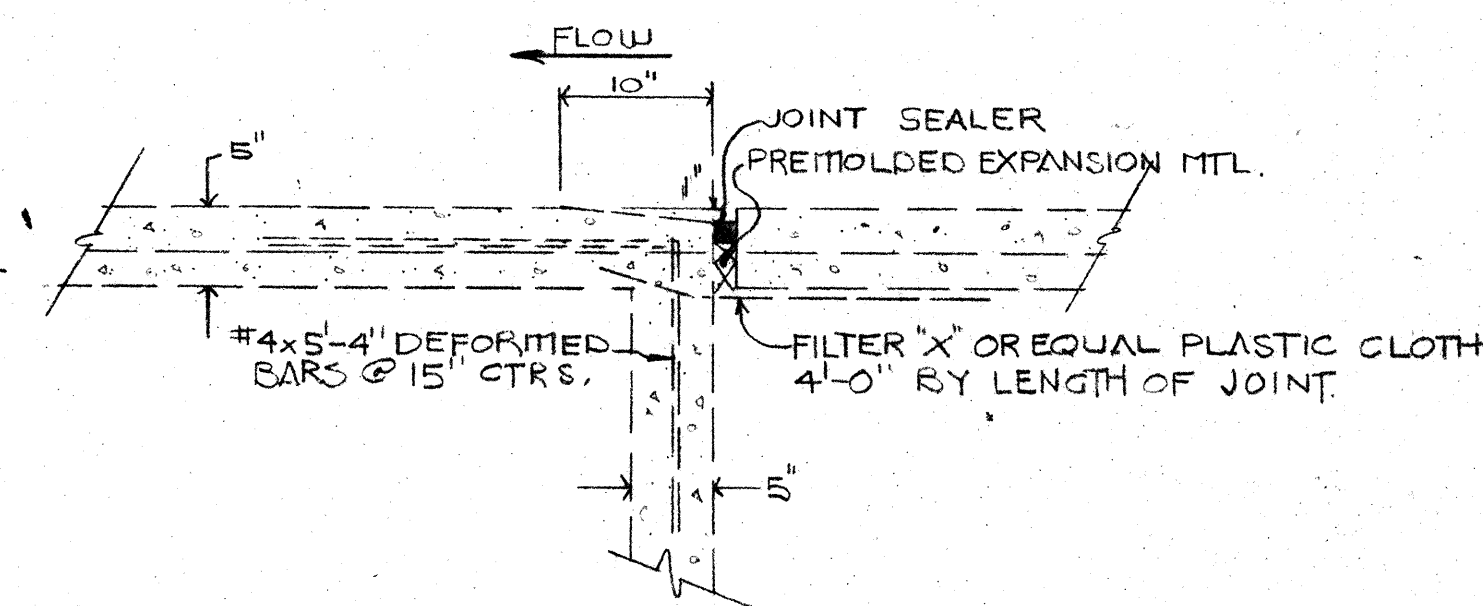


FREE TRANSVERSE EXPANSION JOINT @ 300± STRS.

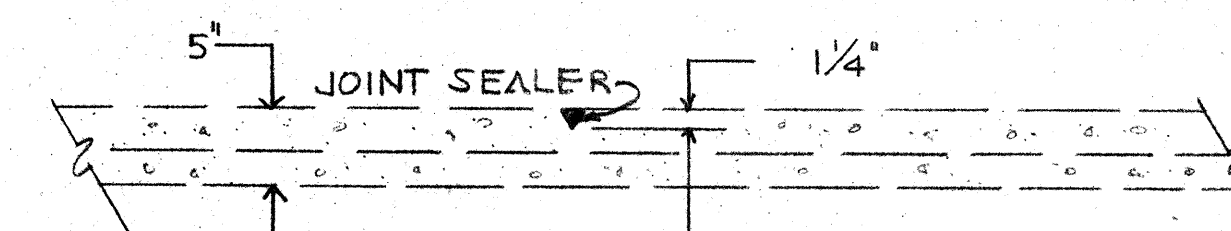


DUMMY GROOVE CONTRACTION JOINT.

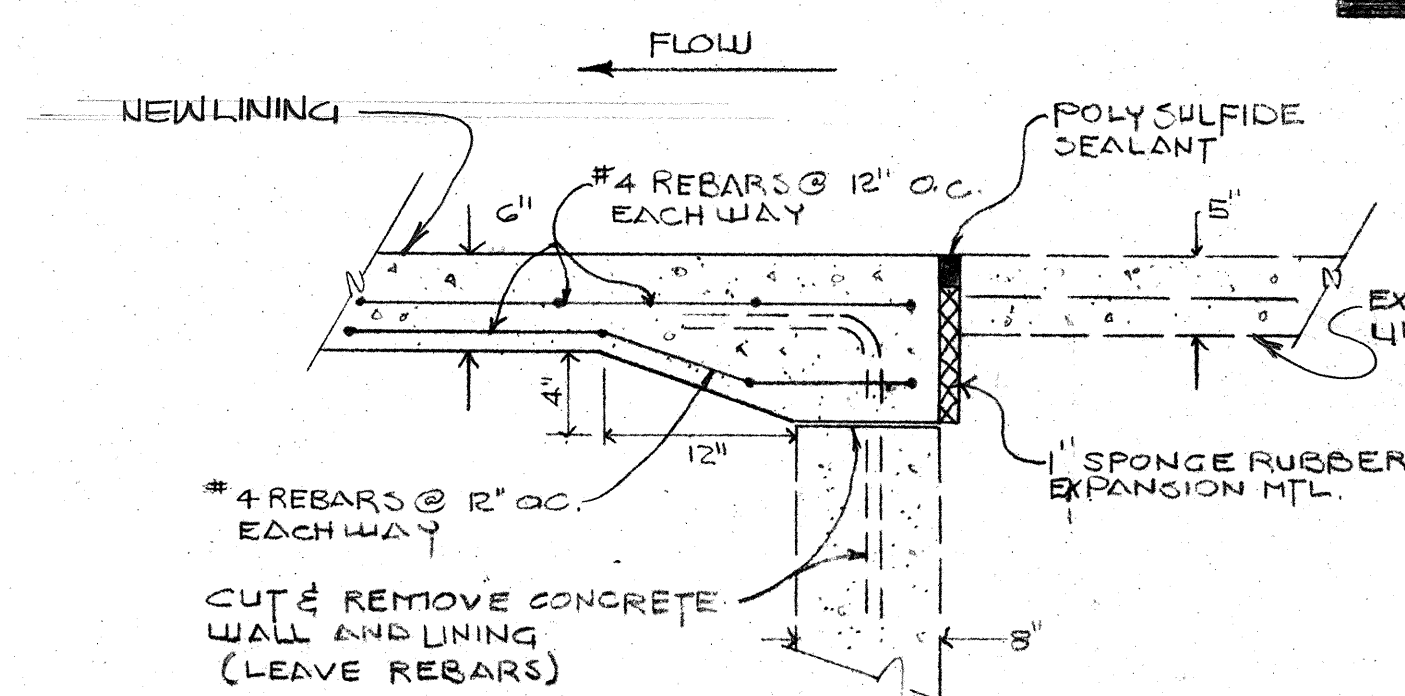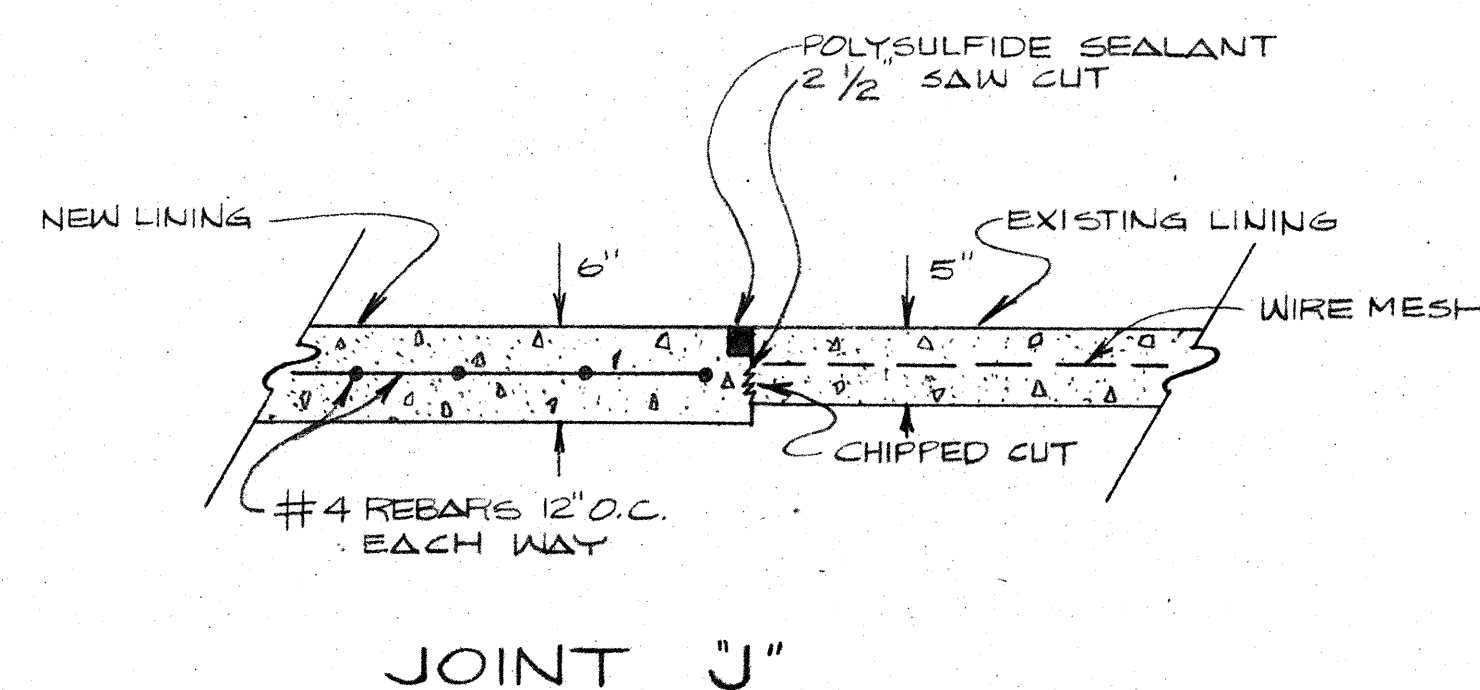


JOINT "A"

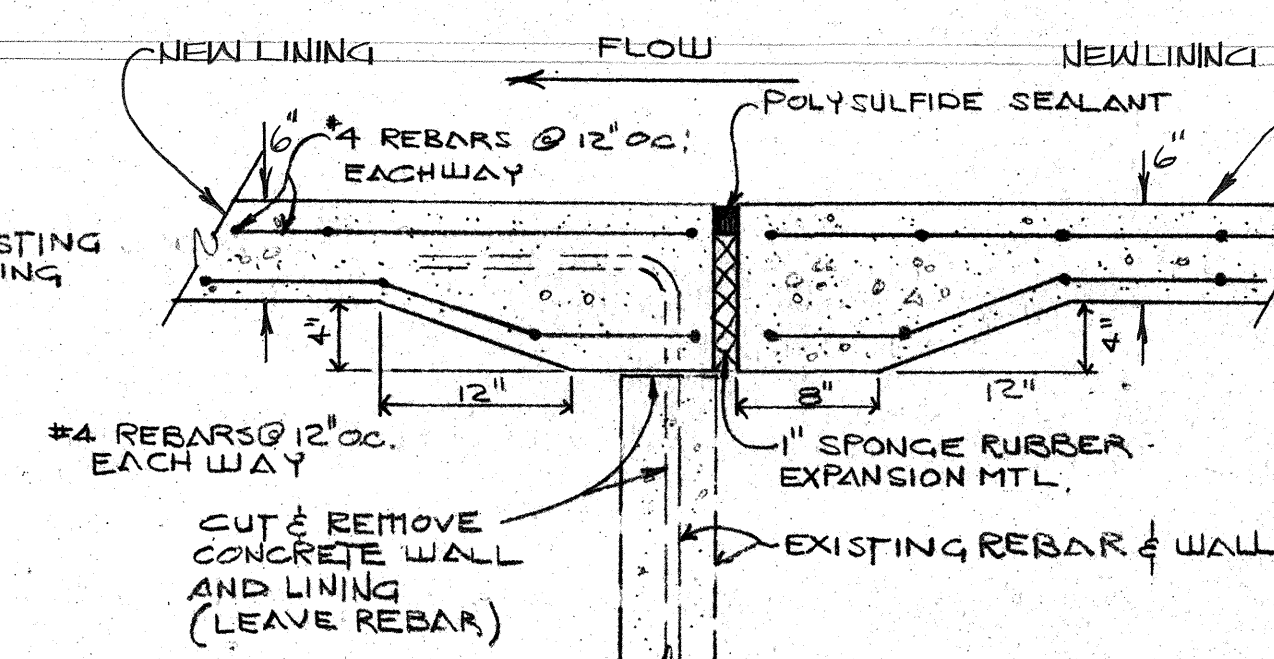


JOINT "B"

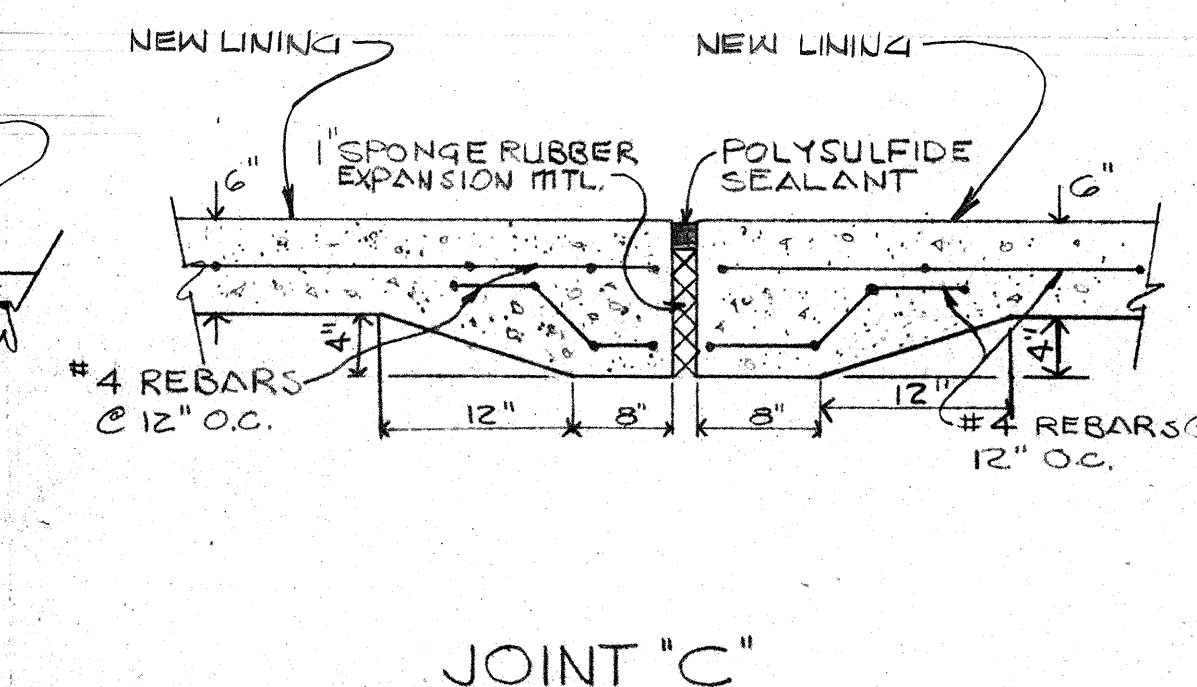


JOINT "C"

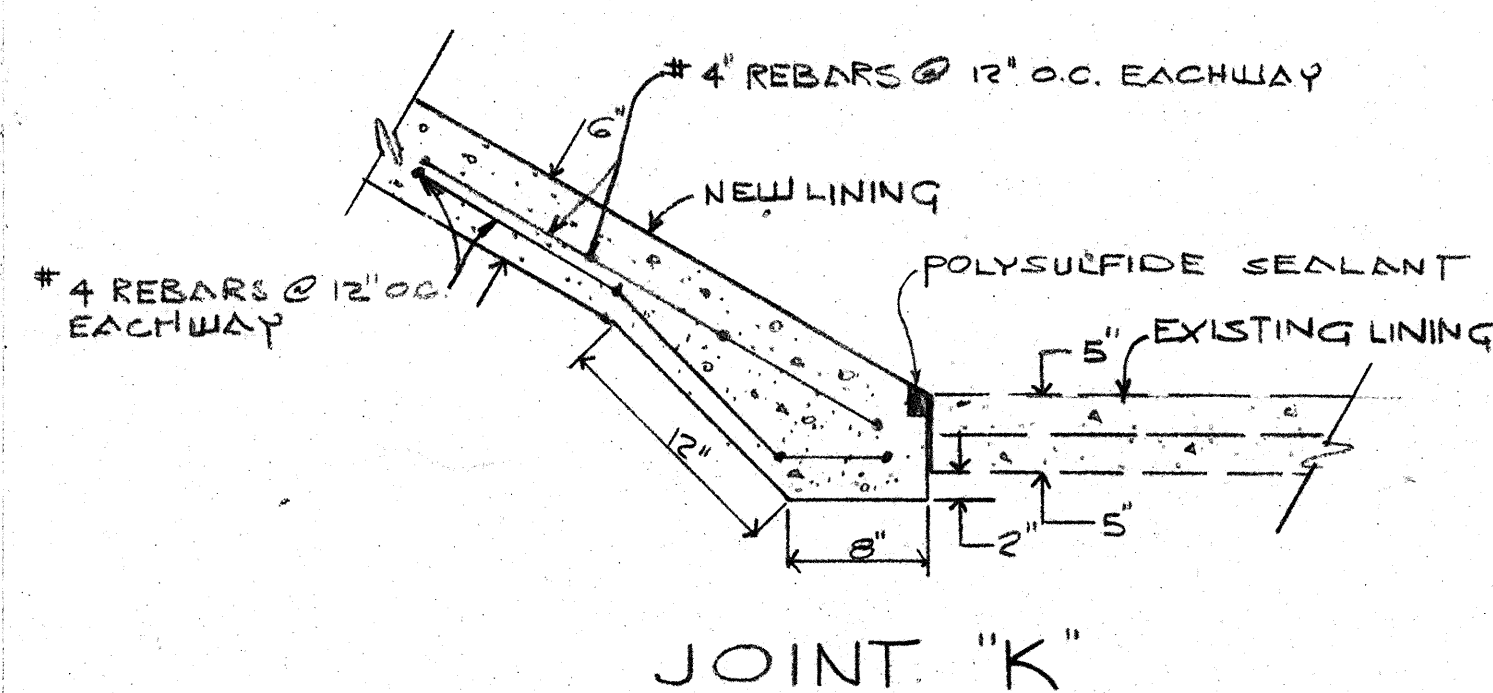


JOINT "K"

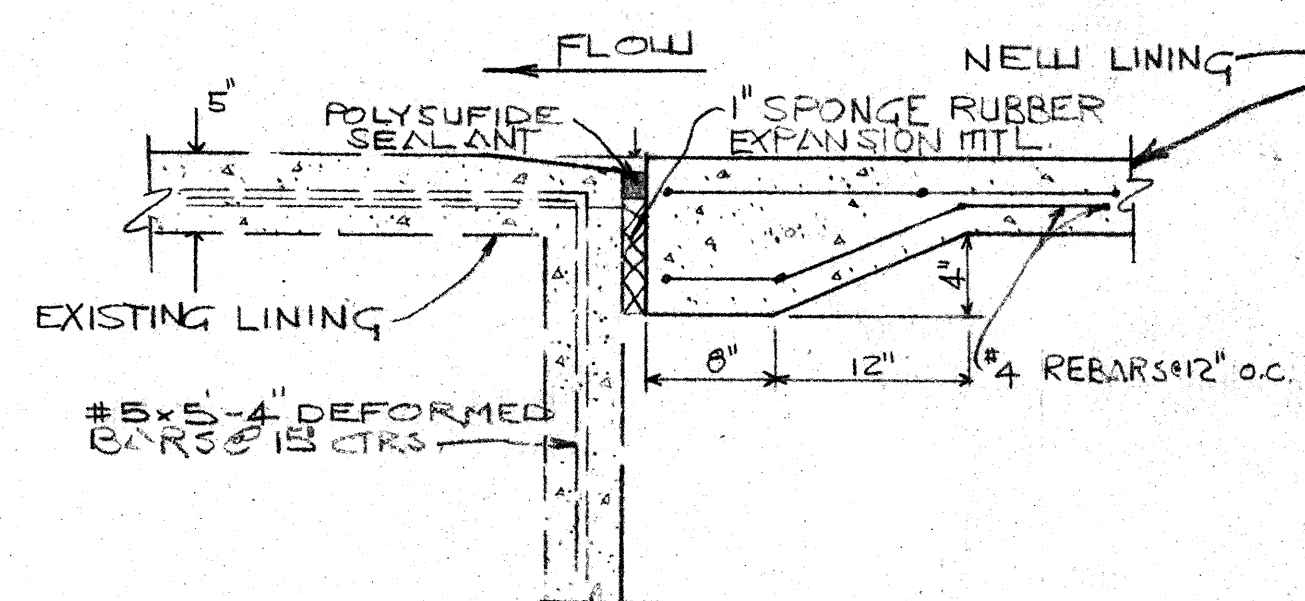


JOINT "D"

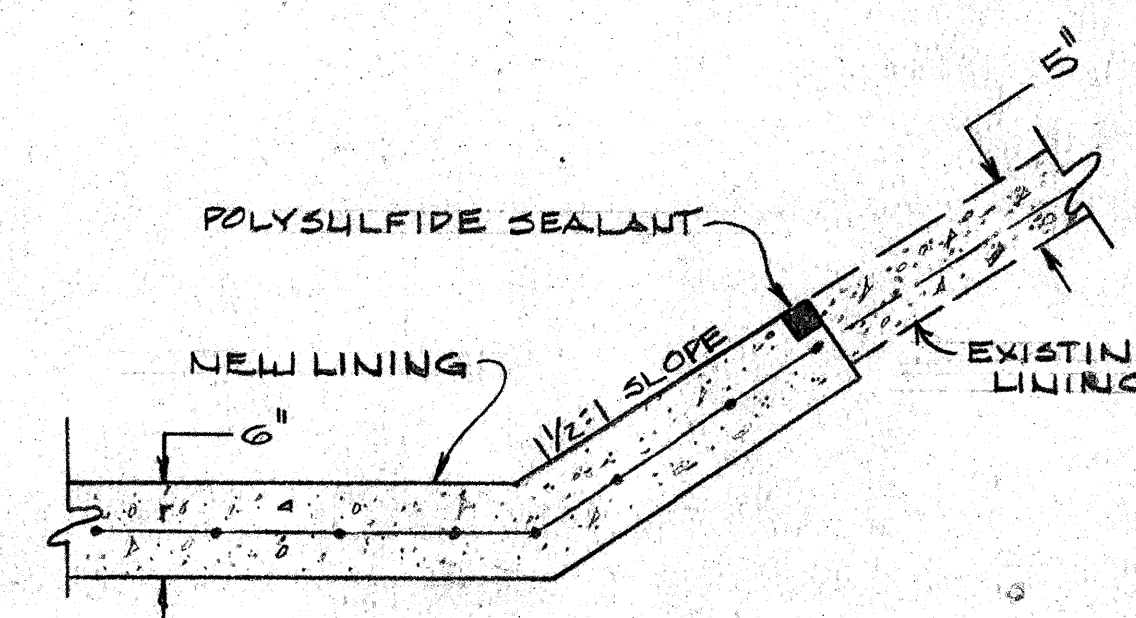


JOINT "E"

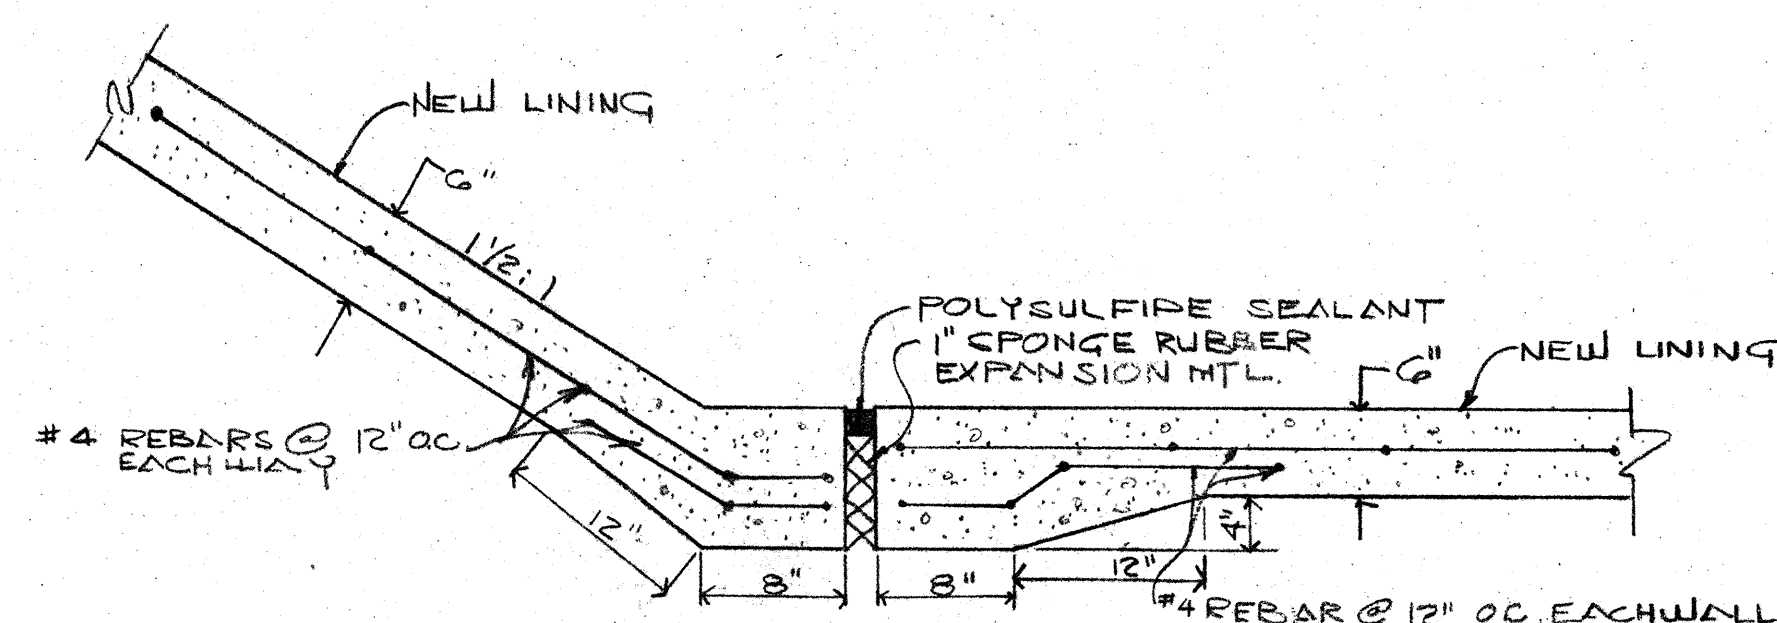


JOINT L

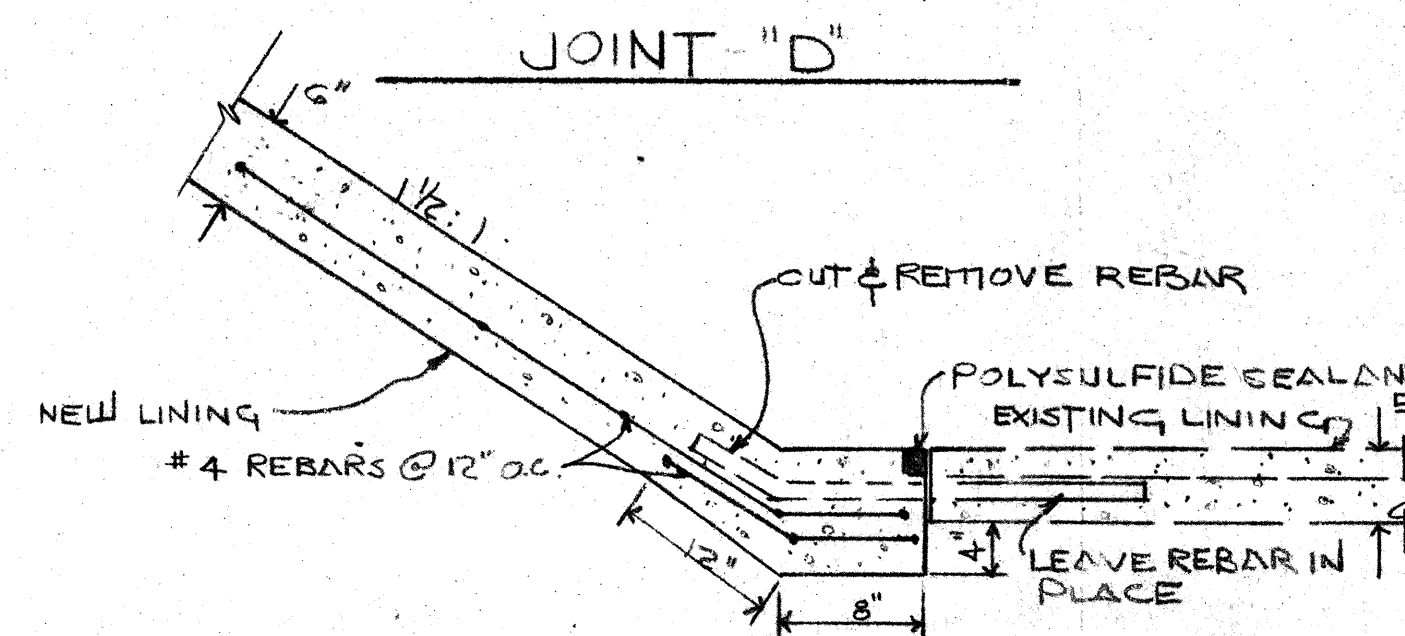

JOINT "G"

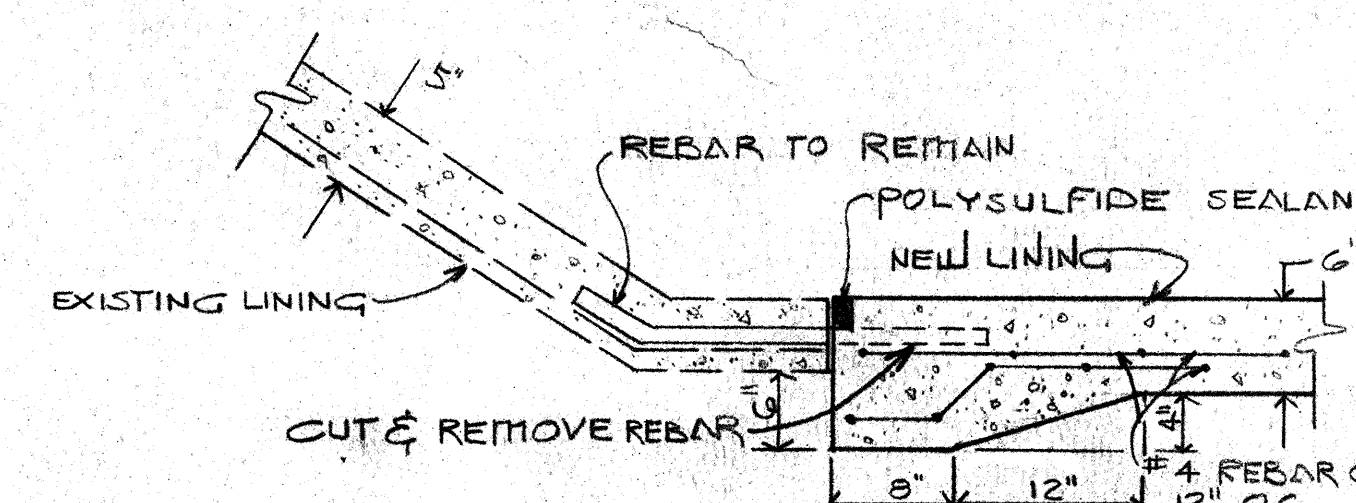

JOINT "H"

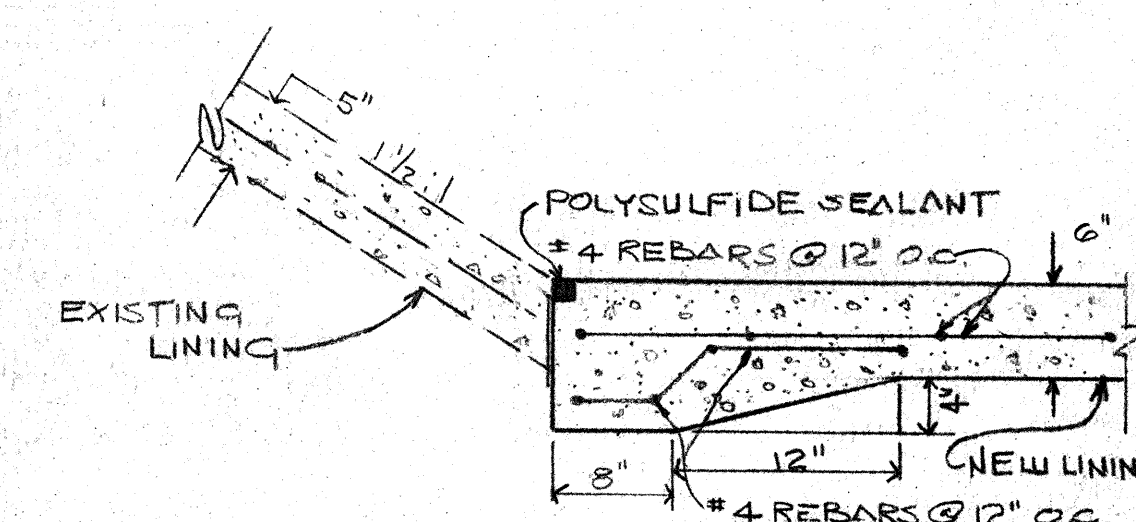

JOINT "F"

1	2	3	4	5	6	7	8	9	10	11	12
20		238					0729				

1	2	3	4	5	6	7	8	9	10	11
22			238				0729			

CITY OF ALBUQUERQUE
PUBLIC WORKS DEPARTMENT
ENGINEERING DIVISION

TITLE: HAHN ARROYO CHANNEL REPAIR
PHASE II

APPROVALS		ENGINEER	DATE	APPROVALS	ENGINEER	DATE
City Engineer	<i>[Signature]</i>		6/12/80	Liquid Waste		
A.C.E. - Design	<i>[Signature]</i>		12/26/80	Traffic		
A.C.E. - Hydrology				Water		

DRAWING NO. SD-29-238

SHEET 7 OF 7

APPROVED FOR
CONSTRUCTION
PSM 6/19/80
CITY ENGINEER DATE

AS BUILT INFORMATION	
CONTRACTOR	
WORK	
STAKED BY	DATE
INSPECTORS	
ACCEPTANCE BY	DATE
VERIFICATION BY	DATE
DRAWINGS	
CORRECTED BY	DATE
MICRO-FILM INFORMATION	
RECORDED BY	DATE

BENCH MARKS

SURVEY INFORMATION

REFERENCES

--	--

[illegible]

ERQL
ARTI
VISC

LINE

Waste

10

1